

APPENDIX D

QRA KAPUNI WELLSITES ADDENDUM – WORLEY

TODD ENERGY LTD

Kapuni Wellsites

Quantitative Risk Assessment – Addendum

610114-RPT-S0001

November 2022

Worley New Zealand Ltd
 25 Gill Street, New Plymouth 4310
 PO Box 705, New Plymouth 4340
 New Zealand

Telephone +64-6-759 6300
 Facsimile +64-6-759 6301

www.worley.com

Rev	Description	Originator	Reviewer	Worley Approver	Date	Client Approval	Date
A	Issued for Review/Comment	Y Lee	T Millen	Y Lee	10/2022		
0	Approved for Use	Y Lee	O Kilian	Y Lee	11/2022		

TABLE OF CONTENTS

1.	ABBREVIATIONS.....	1
2.	INTRODUCTION.....	2
2.1	Scope of Work	2
2.2	QRA Study Cases.....	2
3.	KA-1/7/19/20 WELLSITE.....	4
3.1	Release Scenarios	4
3.2	Release Frequency.....	8
3.3	Risk Results	10
4.	KA-4/14 WELLSITE.....	12
4.1	Release Scenarios	12
4.2	Release Frequency.....	15
4.3	Risk Results	16
5.	REFERENCES.....	18

APPENDICES

APPENDIX 1. P&ID SECTIONALISATION FOR KA-19

APPENDIX 2. P&ID SECTIONALISATION FOR KA-4 AND KA-14

1. ABBREVIATIONS

FTHP	Flowing Tubing Head Pressure
HIPAP4	NSW Hazardous Industry Planning Advisory Paper No. 4
LTS	Low Temperature Separator
P&ID	Piping and Instrumentation Diagram
QRA	Quantitative Risk Assessment

2. INTRODUCTION

A Quantitative Risk Assessment (QRA) has previously been completed for the Todd Energy Kapuni Wellsites [Ref. 1]. This report is an addendum to that QRA report to capture updates required for the KA-1/7/19/20 and KA-4/14 wellsites. The risk contours presented in this addendum update where relevant replace the contours presented for the KA-1/7/19/20 and KA-4/14 wellsites in the existing QRA [Ref. 1].

All inputs and assumptions are consistent with the existing QRA and the model for the existing QRA is updated to calculate the risks in the addendum. This report should be read in parallel with the existing QRA report and Assumptions Register [Ref. 3].

2.1 Scope of Work

The addendum captures the following two (2) changes:

1. For the KA-1/7/19/20 wellsite, the Low Temperature Separator (LTS) 7 skid is currently suspended and not in operation, hence the LTS 7 skid is not included in the current QRA. A sensitivity case is conducted to assess the incremental risk with the LTS 7 in operation.

Note that currently the Flowing Tubing Head Pressure (FTHP) of the wells is not sufficient to be able to flow via the LTS 7. LTS-7 operating conditions used for the sensitivity case are based on the best estimation provided by Todd.

2. For the KA-4/14 wellsite, plant modification was conducted to connect three (3) pipelines from the new Kapuni J wellsite to the KA-4/14 wellsite and install three (3) new pig receivers. These modifications were not completed when the QRA study commenced in May 2020 and hence were not captured in the QRA. The KA-4/14 wellsite QRA is updated to include these modifications and the result will be used as the new base case.

2.2 QRA Study Cases

It is noted that the existing QRA study includes the base case and sensitivity cases to study the impact of different modelling input / assumption on the risk results as per the existing QRA. The QRA base case includes the current operations of the Kapuni wellsites with wellsites' equipment up to the pipeline isolation valves (if available) or when the pipelines go underground. Underground pipelines passing through the wellsites are not included in the base case.

The sensitivity case considered in the Kapuni Wellsites QRA which include the aboveground gathering pipeline sections downstream of the pipeline isolation valves. The pipeline sections contain the entire pipeline inventory. The pipeline inventories are referenced from the Kapuni Safety Case [Ref. 1]. For the KA-1/7/19/20 wellsite, a new sensitivity case is now added as per the scope of work.

The details of the base case and sensitivity cases are summarised in Table 2-1. Note that at KA-1/7/19/20, results with both sensitivities considered concurrently will also be produced.

Table 2-1: Kapuni Wellsites QRA Base Case and Sensitivity Cases

QRA Case	Details	Potential Impact of the sensitivity case to the QRA
Base case	Current wellsites' operation up to the gathering pipeline isolation valves (if available) or when the pipelines go underground	Noted that for KA-4/14, the base case is being updated to include additional pig receivers
Sensitivity case 1	Include the aboveground gathering pipeline sections downstream of the pipeline isolation valves.	Addition QRA sections for the pipeline sections with the entire pipeline inventory. Changes to sensitivity modelling at KA-4/14 only in this addendum document.
Sensitivity case 2	Include the LTS 7 skid where is currently suspended. This is only applicable for KA-1/7/19/20 wellsite.	Addition QRA sections for the LTS 7 equipment at KA-1/7/19/20 wellsite.

KAPUNI WELLSITES
QUANTITATIVE RISK ASSESSMENT - ADDENDUM

QRA Case	Details	Potential Impact of the sensitivity case to the QRA
Sensitivity case 3	Include the risks from the aboveground gathering pipeline sections downstream of the pipeline isolation valves and LTS7 skid, i.e., the total risks from sensitivity cases 1 and 2 above for KA-1/7/19/20 wellsite.	Addition QRA sections for the pipeline sections with the entire pipeline inventory and the LTS 7 equipment at KA-1/7/19/20 (i.e., cumulative of sensitivity case 1 and 2).

3. KA-1/7/19/20 WELLSITE

3.1 Release Scenarios

Table 3-1 details the section description and the respective operating conditions that are used in the QRA. The Piping and Instrumentation Diagrams (P&IDs) showing the isolatable sections for the KA-1/7/19/20 wellsite are presented in Appendix 1. There is no change to the previously reported base case release scenarios and operating conditions.

Table 3-1: Release Scenarios and Operating Conditions for KA-1/7/19/20 Wellsite

No.	Section ID	Description	Material / Stream ^{Note 1}	Pressure (barg)	Temperature (°C)	Largest Connection Size (mm)	Section Inventory (m³)	Isolatable Inventory (m³)
1	01_KA19_01_WLHEAD_V	Wellstream fluid from KA-19 wellhead to SDV-2140A	15	33.8	40.29	150	<i>Unlimited</i> ^{Note 2}	
2	02_KA19_02_FLWLNE_V	Wellstream fluid from wellhead SDV-2140A to choke valve HCV-2140X	15	33.8	40.29	150	0.8	6.6
3	03_KA19_02_CHKLNE_V	Wellstream fluid from choke valve HCV-2140X to Wellstream Cooler (E-2153)	16	23.1	33.6	150	1.3	6.6
4	04_KA19_02_WSCOOL_V	Wellstream fluid from Wellstream Cooler (E-2153) to Wellhead Knockout (V-2154)	17	22.8	24	150	1.2	6.6
5	05_KA19_02_WLHKOT_V	Hydrocarbon gas from Wellhead Knockout (V-2154) to SDV-2154A and manual valve 150V385	19	22.8	24	80	3.3	6.6
6	06_KA19_02_WLHKOB_L	Hydrocarbon liquid from Wellhead Knockout (V-2154) to SDV-2154B	18	22.8	24	150	2.1	2.1
16	16_KA19_04_CONPIP_L	Hydrocarbon liquid from SDV-2154B and SDV-2853A to Condensate Pipeline	18	22.8	24	100	38.2	38.2
17	17_KA19_05_GASPP1_V	Hydrocarbon gas from SDV-2154A mix with wet gas from A-5002 to XSV-2165A on the Gas Pipeline to KA-8 via KA-4/14	19	22.8	24	250	15.9	18.0
18	18_KA19_05_GPIG65_V	Scraper Trap (A-2165)	19	22.8	24	250	1.1	18.0
19	19_KA19_05_GPIG63_V	Scraper Trap (A-2163)	19	22.8	24	200	1.0	18.0
20	20_KA19_06_GASPP2_V	Hydrocarbon gas from SDV-2852C mix with dry gas from KA-4/14 wellsite to Gas Pipeline to KPS	8	28.2	23.11	250	7.2	8.3

No.	Section ID	Description	Material / Stream <small>Note 1</small>	Pressure (barg)	Temperature (°C)	Largest Connection Size (mm)	Section Inventory (m³)	Isolatable Inventory (m³)
21	21_KA19_06_GPIG67_V	Scraper Trap (A-2167)	8	28.2	23.11	250	1.1	8.3
22	22_KA19_06_GPIG66_V	Scraper Trap (A-2166)	8	28.2	23.11	150	1.0	8.3
23	23_KA19_07_VECGAS_V	KGTP Treated Gas to XSV-2169A for export pipeline (to Kiwi Dairy Co. & Taranaki Byproduct Co.)	Kiwi GC	21.1	38.9	250	7.7	15.4
24	24_KA19_07_PG2169_V	Scraper Trap (A-2169)	Kiwi GC	21.1	38.9	250	7.7	15.4
25	25_KA19_07_PG2164_V	Scraper Trap (A-2164)	Kiwi GC	21.1	38.9	150	7.7	15.4
26	26_KA19_08_METTNK_L	Methanol Tank (T-2191) to Methanol Pumps	Methanol	Atm	Atm	50	5.0	5.0
<i>Sensitivity Case 1 – Export Pipelines</i>								
27	27_KA19_09_KA4GPL_V	Dry gas from KA-4/14 to XSV-2167A	8	28.2	23.11	250	97.3	97.3
28	28_KA19_10_KA8GPL_V	Wet gas from XSV-2165A to KA-8/18	19	22.8	24	250	38.7	38.7
29	29_KA19_11_KIWICO_V	KGTP Treated Gas from XSV-2169A to export pipeline (to Kiwi Dairy Co. & Taranaki Byproduct Co.)	Kiwi GC	21.1	38.9	250	1100.0	1100.0
<i>Sensitivity Case 2 – LTS 7 Skid</i>								
7	07_KA19_03_CLASSF_V	Wellstream fluid from valve 150V385 through Low Temperature Separator (V-2852) to Wellhead Knockout (V-2854)	19	22.8	24	150	0.2	16.0
8	08_KA19_03_WHDKOT_V	Top product from the Wellhead Knockout (V-2854) to Gas/Gas Exchanger (E-2855/6/7)	19	26	20	150	2.2	16.0
9	09_KA19_03_WHDKOB_L	Bottom product from the Wellhead Knockout (V-2854) to SDV-2854A	18	26	20	100	2.1	7.6
10	10_KA19_03_GGEXCH_V	Hydrocarbon gas from Gas/Gas Exchanger (E-2855/6/7) to Low Temperature Separator (V-2852)	19	26	16.4	150	1.8	16.0
11	11_KA19_03_WHDKOB_L	Hydrocarbon liquid from Wellhead Knockout (V-2854) SDV-2854A to Classifier (V-2853)	18	22	20	80	0.0	7.6

No.	Section ID	Description	Material / Stream <small>Note 1</small>	Pressure (barg)	Temperature (°C)	Largest Connection Size (mm)	Section Inventory (m³)	Isolatable Inventory (m³)
12	12_KA19_03_CLSFRT_V	Top product from the Classifier (V-2853) to Low Temperature Separator (V-2852)	19	22	20	150	1.1	16.0
13	13_KA19_03_CLSFRB_L	Bottom product from the Classifier (V-2853) to Condensate pipeline	18	22	20	50	1.1	7.6
14	14_KA19_03_LTSEPT_V	Top product from the Low Temperature Separator (V-2852) through the Gas/Gas Exchanger to the Gas Pipeline	19	22	20	150	10.7	16.0
15	15_KA19_03_LTSEPB_L	Bottom product from the Low Temperature Separator (V-2852) to SDV-2853A	18	22	20	150	4.5	7.6

Notes:

1. Stream compositions for the stream numbers are given in Table 3-2.
2. Inventory from the wellhead section is considered to be unlimited because they can be supplied from the downhole reservoir.

Table 3-2: Material Composition for KA-1/7/19/20

	8	15	16	17	18	19	Kiwi GC
Name	KA-05_KA-06/17_Combined	KA-19_Wellfluid_to_KA-19_Choke	KA-19_Choke-to_E-2153	E-2153_to_V-2154	V-2154_Liquid_to_Liquid Manifold	V-2154_Gas_to_Wet_Gas_Network	
Mole Fraction							
WATER	0.2858	0.0338	0.0338	0.0338	0.6021	0.0016	-
CARBON DIOXIDE	0.3163	0.4380	0.4380	0.4380	0.0581	0.4596	0.0316
METHANE	0.2897	0.4130	0.4130	0.4130	0.0188	0.4354	0.9005
ETHANE	0.0373	0.0521	0.0521	0.0521	0.0122	0.0543	0.0580
PROPANE	0.0225	0.0271	0.0271	0.0271	0.0205	0.0275	0.0086
n-BUTANE	0.0132	0.0128	0.0128	0.0128	0.0254	0.0122	0.0013
n-PENTANE	0.0051	0.0038	0.0038	0.0038	0.0193	0.0030	0.0001
n-HEPTANE (C7)	0.0210	0.0144	0.0144	0.0144	0.1542	0.0065	-
n-DECANE (C10)	0.0091	0.0050	0.0050	0.0050	0.0892	-	-
n-EICOSANE (C20)	-	-	-	-	0.0001	-	-

3.2 Release Frequency

The leak frequencies for the process releases are estimated for each representative hole size using parts count results and the historical leak frequencies. The leak frequencies for the KA-1/7/19/20 wellsite for the base case are shown in Table 3-3. There values are unchanged from the previous base case modelling.

Table 3-3: Hydrocarbon Release Frequencies for KA-1/7/19/20 Wellsite (Base Case)

No	QRA Event	1 - 3 mm	3 - 10 mm	10 - 50 mm	50 - 150 mm	> 150 mm	TOTAL	% Contrib.
1	01_KA19_01_WLHEAD_V	3.37E-05	1.38E-05	5.67E-06	1.13E-06	7.09E-07	5.50E-05	0.3%
	KA-19 Blowout					4.20E-05	4.20E-05	0.2%
2	02_KA19_02_FLWLNE_V	9.10E-04	3.85E-04	2.06E-04	7.36E-06	1.58E-06	1.51E-03	7.9%
3	03_KA19_02_CHKLNE_V	1.88E-03	8.15E-04	4.43E-04	3.27E-05	3.77E-06	3.18E-03	16.6%
4	04_KA19_02_WSCOOL_V	1.25E-03	4.67E-04	1.93E-04	4.23E-05	7.70E-07	1.95E-03	10.2%
5	05_KA19_02_WLHKOT_V	1.21E-03	5.38E-04	2.88E-04	4.71E-05		2.08E-03	10.8%
6	06_KA19_02_WLHKOB_L	7.25E-04	3.42E-04	1.88E-04	5.65E-05	1.41E-06	1.31E-03	6.8%
16	16_KA19_04_CONPIP_L	1.28E-03	5.68E-04	2.99E-04	5.02E-05		2.20E-03	11.5%
17	17_KA19_05_GASPP1_V	7.89E-04	3.47E-04	1.85E-04	2.45E-05	5.30E-06	1.35E-03	7.0%
18	18_KA19_05_GPIG65_V	7.94E-07	4.05E-07	2.24E-07	5.42E-08	1.77E-08	1.49E-06	0.01%
19	19_KA19_05_GPIG63_V	3.75E-07	1.94E-07	1.08E-07	2.83E-08	8.83E-09	7.15E-07	0.004%
20	20_KA19_06_GASPP2_V	1.11E-03	4.89E-04	2.60E-04	3.01E-05	5.67E-06	1.90E-03	9.9%
21	21_KA19_06_GPIG67_V	1.84E-07	9.52E-08	5.28E-08	1.35E-08	4.42E-09	3.50E-07	0.002%
22	22_KA19_06_GPIG66_V	9.29E-08	4.81E-08	2.67E-08	1.32E-08	4.39E-12	1.81E-07	0.001%
23	23_KA19_07_VECGAS_V	1.60E-03	6.89E-04	3.71E-04	3.38E-05	3.59E-06	2.70E-03	14.1%
24	24_KA19_07_PG2169_V	1.17E-06	5.96E-07	3.30E-07	7.64E-08	2.67E-08	2.20E-06	0.011%
25	25_KA19_07_PG2164_V	1.01E-07	5.17E-08	2.86E-08	1.35E-08	4.39E-12	1.95E-07	0.001%
26	26_KA19_08_METTNK_L	4.64E-04	3.03E-04	1.12E-04	1.85E-05	5.00E-06	9.03E-04	4.7%
TOTAL		1.13E-02	4.96E-03	2.55E-03	3.44E-04	6.99E-05	1.92E-02	
% Contribution		59%	26%	13%	2%	0.4%		

The total leak frequency for the KA-1/7/19/20 wellsite (for the base case) is 1.92E-02 per year, which is equivalent to one leak every 52.1 years. Most of the leaks are predicted to be from small leaks, where 85% of the leaks are from hole sizes less than 10 mm diameter.

The leak frequencies for the KA-1/7/19/20 wellsite for the sensitivity case 1 are shown in Table 3-4. There is no change from the previous sensitivity case modelling.

Table 3-4: Hydrocarbon Release Frequencies for KA-1/7/19/20 wellsite (Sensitivity Case 1)

No	QRA Event	1 - 3 mm	3 - 10 mm	10 - 50 mm	50 - 150 mm	> 150 mm	TOTAL	% Contrib.
27	27_KA19_09_KA4GPL_V	3.19E-05	1.42E-05	7.35E-06	1.14E-06	3.54E-07	5.50E-05	0.3%
28	28_KA19_10_KA8GPL_V	3.19E-05	1.42E-05	7.35E-06	1.14E-06	3.54E-07	5.50E-05	0.3%
29	29_KA19_11_KIWICO_V	3.19E-05	1.42E-05	7.35E-06	1.14E-06	3.54E-07	5.50E-05	0.3%
TOTAL		1.14E-02	5.00E-03	2.57E-03	3.48E-04	7.09E-05	1.93E-02	
% Contribution		59%	26%	13%	2%	0.4%		

The total leak frequency for the KA-1/7/19/20 wellsite (including the sensitivity case 1) is 1.93E-02 per year, which is equivalent to one leak every 51.7 years.

The leak frequencies for the KA-1/7/19/20 wellsite for the sensitivity case 2 are shown in Table 3-5.

Table 3-5: Hydrocarbon Release Frequencies for KA-1/7/19/20 wellsite (Sensitivity Case 2)

No	QRA Event	1 - 3 mm	3 - 10 mm	10 - 50 mm	50 - 150 mm	> 150 mm	TOTAL	% Contrib.
7	07_KA19_03_CLASSF_V	1.17E-03	5.02E-04	2.68E-04	1.48E-05	3.29E-06	1.96E-03	4.7%
8	08_KA19_03_WHDKOT_V	9.66E-04	4.25E-04	2.20E-04	4.08E-05	1.53E-06	1.65E-03	4.0%
9	09_KA19_03_WHDKOB_L	8.27E-04	3.68E-04	1.86E-04	4.81E-05		1.43E-03	3.5%
10	10_KA19_03_GGEXCH_V	2.11E-03	1.09E-03	6.58E-04	3.40E-04	2.42E-06	4.19E-03	10.1%
11	11_KA19_03_WHDKOB_L	1.97E-04	8.46E-05	3.98E-05	1.10E-05		3.32E-04	0.8%
12	12_KA19_03_CLSFRT_V	7.72E-04	3.22E-04	1.62E-04	1.08E-05	7.70E-07	1.27E-03	3.1%
13	13_KA19_03_CLSFRB_L	6.74E-04	3.12E-04	1.62E-04	5.62E-05		1.20E-03	2.9%
14	14_KA19_03_LTSEPT_V	4.45E-03	2.06E-03	1.05E-03	3.47E-04	4.18E-06	7.91E-03	19.1%
15	15_KA19_03_LTSEPB_L	1.30E-03	5.82E-04	3.03E-04	6.60E-05	2.02E-06	2.26E-03	5.4%
TOTAL		2.37E-02	1.07E-02	5.60E-03	1.28E-03	8.41E-05	4.14E-02	
% Contribution		57%	26%	14%	3%	0.2%		

The total leak frequency for the KA-1/7/19/20 wellsite (including the sensitivity case 2) is 4.14E-02 per year, which is equivalent to one leak every 24.2 years.

The total leak frequency for the KA-1/7/19/20 wellsite for sensitivity case 3 (includes the base case and both sensitivity cases) is 7.99E-2 per year, which is equivalent to one leak every 12.5 years.

3.3 Risk Results

The risk results are presented in this section. The risk contours are contributed from both flammable and toxic risks from all release scenarios based on all the hazardous materials onsite. The risk contour for the KA-1/7/19/20 wellsite for sensitivity case 2 is presented in Figure 4-1.

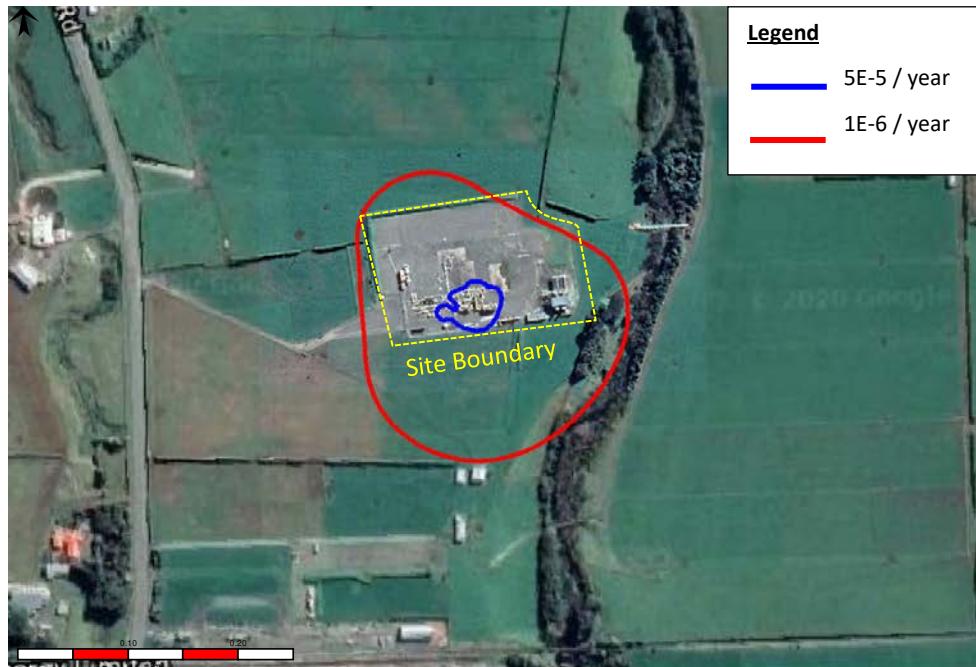


Figure 3-1: Risk Contour for KA-1/7/19/20 Wellsite (Sensitivity Case 2)

The risk assessed against the NSW Hazardous Industry Planning Advisory Paper No. 4 (HIPAP4) criteria are summarised in Table 3-6.

Table 3-6: LSIR Results Assessed Against the HIPAP4 Land Use Criteria for KA-1/7/19/20 Wellsite (Sensitivity Case 2)

LSIR	Risk Contour	HIPAP4 Land Use Criteria	Result
5E-05 / year	Blue	5E-5 / year risk contour should, as a target, be contained within the boundaries of the industrial site where applicable.	Criteria met. The 5E-05 / year risk contour is within the site boundary.
1E-6 / year	Red	1E-6 / year risk contour should not extend to residential developments, hotels, tourist resorts.	Criteria met. There are no residential developments, hotels, tourist resorts within the contour.

For comparison, the risk contour for the base case from the existing QRA [Ref. 1] is presented in Figure 3-2.

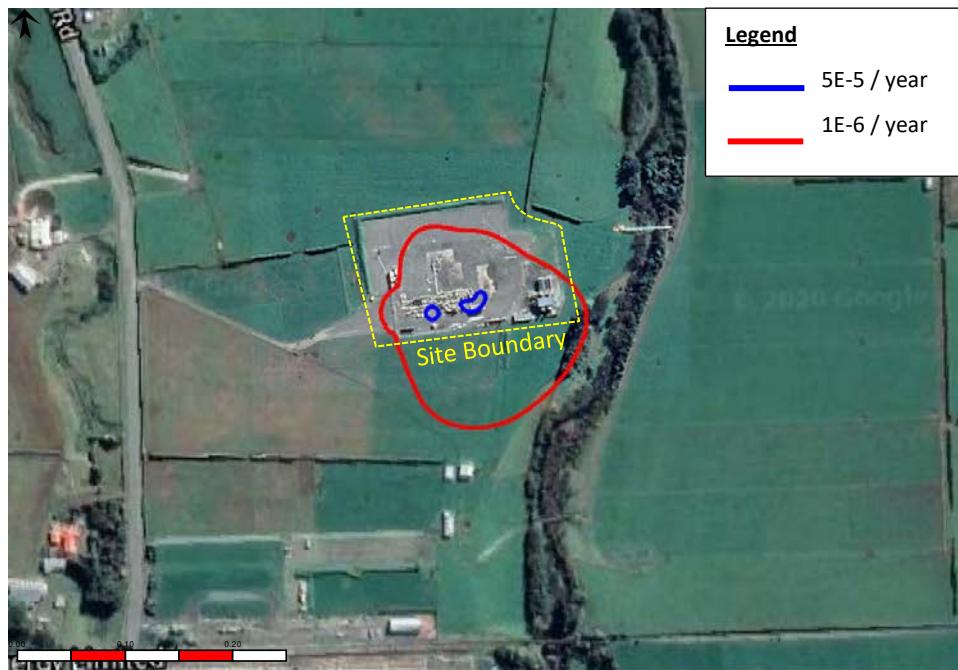


Figure 3-2: Risk Contour for KA-1/7/19/20 Wellsite (Base Case)

Figure 3-3 shows the risk contour for sensitivity case 3 (i.e., the aboveground pipelines and LTS 7 skid are included).

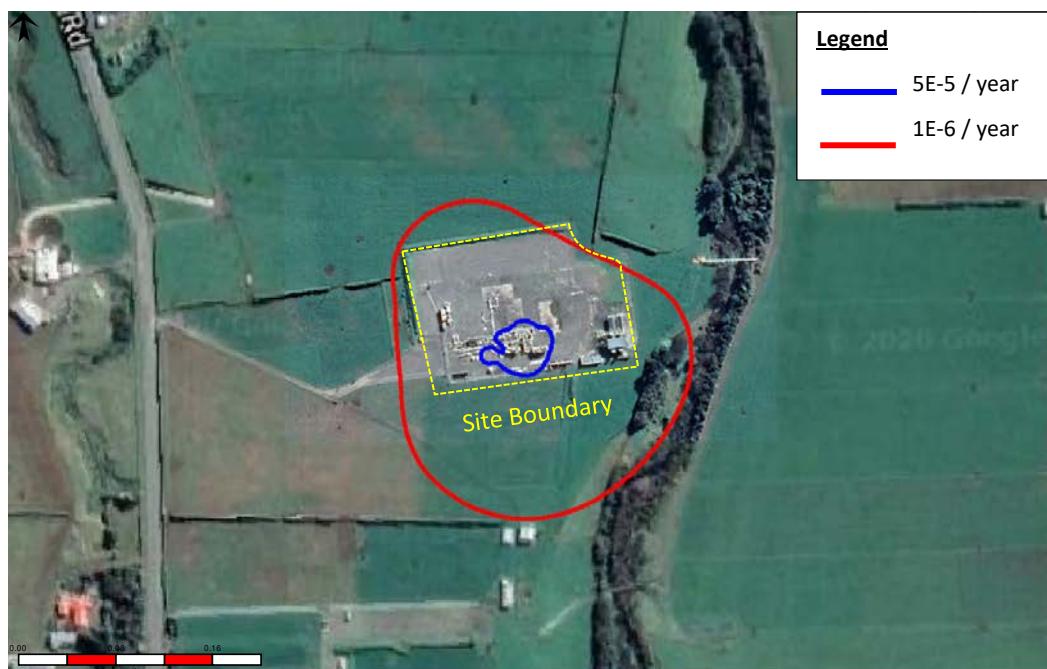


Figure 3-3: Risk Contour for KA-1/7/19/20 Wellsite (Sensitivity Case 3)

4. KA-4/14 WELLSITE

4.1 Release Scenarios

Table 4-1 details the section description and the respective operating conditions that are used in the QRA. The P&IDs showing the isolatable sections for the KA-4/14 wellsite are presented in Appendix 2. In updating the facility base case, the following changes from the previous base case are noted:

- Sections 10 and 11 have been removed, and Sections 16-21 are now included in the base case.
- New sensitivity cases 22-25 are now included.
- Process conditions for sections 13-15 in the sensitivity case have been revised.
- Reference material has been amended for streams 11, 13, 14 and 15.

Table 4-1: Release Scenarios and Operating Conditions for KA-4/14 Wellsite

No.	Section ID	Description	Material / Stream ^{Note 1}	Pressure (barg)	Temperature (°C)	Largest Connection Size (mm)	Section Inventory (m³)	Isolatable Inventory (m³)
1	01_KA04_01_KA4WHD_V	KA-04 wellhead	37	18	17.6	100	<i>Unlimited</i> ^{Note 2}	
3	03_KA04_03_KA14WH_V	KA-14 wellhead	40	19.2	18.6	100	<i>Unlimited</i> ^{Note 2}	
5	05_KA04_05_KA14FW_V	Wellfluid from KA-14 wellhead to SDV-2430B	40	19.2	18.6	100	0.6	0.6
6	06_KA04_06_KA14CK_V	Wellfluid from SDV-2430B to the commingled line	41	18.5	18.1	150	0.0	1.4
7	07_KA04_06_KA4FLW_V	Wellfluid from KA-4 wellhead to the commingled line	38	16.2	16.1	150	1.0	1.4
8	08_KA04_06_MIXFLW_V	KA-4 and 14 commingled flow to SDV-2404A and XSV-2441	39	18.3	13.5	100	0.4	1.4
9	09_KA04_07_METTNK_L	Methanol Tank (T-2429) to Methanol Pumps	Methanol	Amb.	Atm.	50	4.7	4.7
11	11_KA04_10_GASPIG_V	Scraper Launcher (A-2440)	33(2)	39.05	26.4	250	1.0	88.7
16	16_KA04_10_KAPJDG_V	HP dry gas from Kapuni J Wellsite from XSV-4002 feed to gas pipeline from KA-8 (A-2813)	J7	48.1	38.7	300	0.8	88.7
17	17_KA04_10_PIG400_V	KA-4/14 HP Dry Gas Pipeline Pig Receiver (941-V-400)	J7	48.1	38.7	300	1.1	88.7

No.	Section ID	Description	Material / Stream ^{Note 1}	Pressure (barg)	Temperature (°C)	Largest Connection Size (mm)	Section Inventory (m³)	Isolatable Inventory (m³)
18	18_KA04_08_CONKpj_L	Condensate/water from Kapuni J Wellsite from XSV-4102 feed to condensate pipeline from KA-8 (A-2814) and condensate pipeline from KA-12	J16	18	16.1	150	0.2	45.5
19	19_KA04_08_PIG410_L	KA-4/14 Condensate/Water Pipeline Pig Receiver (941-V-410)	J16	18	16.1	150	1.0	45.5
20	20_KA04_08_CONKpj_L	Condensate/water or flowback water from Kapuni J Wellsite from XSV-4202 feed to condensate pipeline from KA-8 (A-2814) and condensate pipeline from KA-12	J16	18	16.1	100	0.1	45.5
21	21_KA04_08_PIG420_L	KA-4/14 Condensate or Flowback Water Pipeline Pig Receiver (941-V-420)	J16	18	16.1	100	1.0	45.5
<i>Sensitivity Cases</i>								
13	13_KA04_10_GASPLN_V	Gas pipeline from KA-8 A-2813 to KPS Receiver A-502D	33(2)	39.05	26.4	150	85.8 ^{Note 3}	88.7
14	14_KA04_11_GASKA7_V	From XSV-2440A to Dry Gas Pipeline to KA-7	33(2)	39.05	26.4	250	97.3 ^{Note 3}	97.3
15	15_KA04_08_GASPPL_V	Condensate pipeline from KA-8 Launcher A-2814 to KA-4/14	33(2)	39.05	26.4	100	43.2 ^{Note 3}	45.5
22	22_KA04_12_HPDRYG_V	HP dry gas from Kapuni J Wellsite to XSV-4002	J7	48.1	38.7	300	99.0 ^{Note 3}	99.0
23	23_KA04_13_CONKpj_L	Condensate/water from Kapuni J Wellsite to XSV-4102	J16	18	16.1	150	24.7 ^{Note 3}	24.7
24	24_KA04_14_CONKpj_L	Condensate/water or flowback water from Kapuni J Wellsite to XSV-4202	J16	18	16.1	100	11.0 ^{Note 3}	11.0
25	25_KA04_15_LPMPHV_V	KA-4 and 14 commingled flow from XSV-2441 to LP Multiphase pipeline from KA-1&7 and KPS (A-2165)	39	18.3	13.5	100	250.3 ^{Note 3}	250.3

Notes:

1. Stream compositions for the stream numbers are given in Table 4-2.
2. Inventory from the wellhead section is considered to be unlimited because they can be supplied from the downhole reservoir.
3. Sections connecting to the pipeline inventories due to the lack of isolation valve.

Table 4-2: Material Composition for KA-4/14 Wellsite

Stream Number	33(2)	37	38	39	40	41	J7	J16
Name / Description	LTS-8_Gas_to_Dry_Gas_Pipeline	KA-4_Wellfluid_to_KA-4_Choke	KA-4_Choke_to_KA4/14_Combined	KA-4/14_Combined_to_Liquid_Manifold	KA-14_Wellfluid_to_KA-14_Choke	KA-14_Choke_to_KA-4/14_Combined	Dry gas from Kapuni J [Ref. 4]	Condensate from Kapuni J [Ref. 4]
Mole Fraction								
WATER	0.0006	0.0437	0.0437	0.0352	0.0299	0.0299	0.0003	-
CARBON DIOXIDE	0.4435	0.4224	0.4224	0.4278	0.4312	0.4312	0.4073	0.2155
METHANE	0.4528	0.4102	0.4102	0.4158	0.4193	0.4193	0.4857	-
ETHANE	0.0543	0.0511	0.0511	0.0517	0.0521	0.0521	0.0589	0.0962
PROPANE	0.0278	0.0290	0.0290	0.0292	0.0293	0.0293	0.0297	0.1289
n-BUTANE	0.0125	0.0153	0.0153	0.0152	0.0151	0.0151	0.0131	0.1524
n-PENTANE	0.0028	0.0048	0.0048	0.0046	0.0045	0.0045	0.0024	0.0845
n-HEXANE	-	-	-	-	-	-	0.0026	0.3599
n-HEPTANE (C7)	0.0057	0.0196	0.0196	0.0174	0.0161	0.0161	-	-
n-DECANE (C10)	-	0.0038	0.0038	0.0031	0.0026	0.0026	-	-
n-TRIDECANE (C13)	-	-	-	-	-	-	-	0.1951

4.2 Release Frequency

The leak frequencies for the process releases are estimated for each representative hole size using parts count results and the historical leak frequencies. The leak frequencies for the KA-4/14 wellsites for the base case are shown in Table 4-3. The KA-14 well is only in operation for 24 hours every 10 days. Note, with the exception of Section 8, all base case frequencies from the previous QRA revision (Sections 1-11) remain unchanged.

Table 4-3: Hydrocarbon Release Frequencies for KA-4/14 Wellsite (Base Case)

No	QRA Event	1 - 3 mm	3 - 10 mm	10 - 50 mm	50 - 150 mm	> 150 mm	TOTAL	% Contrib.
1	01_KA04_01_KA4WHD_V	3.37E-05	1.38E-05	5.67E-06	1.84E-06		5.50E-05	0.6%
	KA-4 Blowout				4.20E-05		4.20E-05	0.4%
3	03_KA04_03_KA14WH_V	3.37E-06	1.38E-06	5.67E-07	1.84E-07		5.50E-06	0.1%
	KA-14 Blowout				4.20E-06		4.20E-06	0.0%
5	05_KA04_05_KA14FW_V	3.06E-05	1.33E-05	6.71E-06	1.13E-06		5.17E-05	0.5%
6	06_KA04_06_KA14CK_V	1.40E-04	5.92E-05	3.22E-05	4.30E-07	1.26E-07	2.32E-04	2.4%
7	07_KA04_06_KA4FLW_V	1.33E-03	5.66E-04	2.98E-04	1.78E-05	2.14E-06	2.21E-03	22.8%
8	08_KA04_06_MIXFLW_V	1.27E-03	5.57E-04	2.76E-04	5.44E-05		2.16E-03	22.2%
9	09_KA04_07_METTNK_L	2.49E-04	2.18E-04	6.64E-05	2.66E-05	5.00E-06	5.65E-04	5.8%
11	11_KA04_10_GASPIG_V	1.83E-07	9.46E-08	5.25E-08	1.35E-08	4.39E-09	3.48E-07	0.0%
16	16_KA04_10_KAPJDG_V	1.12E-03	5.01E-04	2.66E-04	3.51E-05	8.45E-06	1.93E-03	19.9%
17	17_KA04_10_PIG400_V	4.85E-06	2.47E-06	1.37E-06	3.28E-07	1.07E-07	9.12E-06	0.1%
18	18_KA04_08_CONKPJ_L	8.91E-04	3.89E-04	2.05E-04	1.87E-05	4.30E-06	1.51E-03	15.5%
19	19_KA04_08_PIG410_L	9.67E-06	4.93E-06	2.73E-06	1.26E-06	1.80E-09	1.86E-05	0.2%
20	20_KA04_08_CONKPJ_L	5.30E-04	2.34E-04	1.20E-04	1.95E-05		9.04E-04	9.3%
21	21_KA04_08_PIG420_L	9.67E-06	4.93E-06	2.73E-06	1.26E-06		1.86E-05	0.2%
TOTAL		5.62E-03	2.56E-03	1.28E-03	2.25E-04	2.01E-05	9.72E-03	
% Contribution		58%	26%	13%	2%	0.2%		

The total leak frequency for the KA-4/14 wellsites (for the base case) is 9.72E-03 per year, which is equivalent to one leak every 103 years. Most of the leaks are predicted to be from small leaks, where 84% of the leaks are from hole sizes less than 10 mm diameter.

The leak frequencies for the KA-4/14 wellsites for the sensitivity case are shown in Table 4-4. Note, with the exception of Section 13, all base case frequencies from the previous QRA revision (Sections 14 & 15) remain unchanged.

Table 4-4: Hydrocarbon Release Frequencies for KA-4/14 Wellsite (Sensitivity Case)

No	QRA Event	1 - 3 mm	3 - 10 mm	10 - 50 mm	50 - 150 mm	> 150 mm	TOTAL	% Contrib.
13	13_KA04_10_GASPLN_V	5.11E-04	2.19E-04	1.17E-04	6.49E-06	9.87E-07	8.54E-04	7.4%
14	14_KA04_11_GASKA7_V	6.03E-05	2.81E-05	1.43E-05	2.86E-06	8.86E-07	1.06E-04	0.9%
15	15_KA04_08_GASPPL_L	4.64E-04	2.03E-04	1.10E-04	1.13E-05		7.88E-04	6.9%
22	22_KA04_12_HPDRYG_V	1.93E-04	8.22E-05	4.44E-05	3.84E-06	3.54E-07	3.24E-04	2.8%
23	23_KA04_13_CONKPJ_L	1.92E-04	8.39E-05	4.55E-05	6.10E-06	1.54E-07	3.28E-04	2.9%

No	QRA Event	1 - 3 mm	3 - 10 mm	10 - 50 mm	50 - 150 mm	> 150 mm	TOTAL	% Contrib.
24	24_KA04_14_CONKpj_L	1.92E-04	8.39E-05	4.55E-05	6.26E-06		3.28E-04	2.9%
25	25_KA04_15_LPMPHV_V	2.12E-04	9.21E-05	4.98E-05	4.72E-06		3.59E-04	3.1%
	TOTAL	7.45E-03	3.36E-03	1.71E-03	2.66E-04	2.25E-05	1.28E-02	
	% Contribution	58%	26%	13%	2%	0.2%		

The total leak frequency for the KA-4/14 wellsite (including the sensitivity cases) is 1.28E-02 per year, which is equivalent to one leak every 78.1 years.

4.3 Risk Results

The risk results are presented in this section. The risk contours are contributed from both flammable and toxic risks from all release scenarios based on all the hazardous materials onsite.

4.3.1 Base Case

The new base case risk contour for the KA-4/14 wellsite is presented in Figure 4-1.



Figure 4-1: Risk Contour for KA-4/14 Wellsite (New Base Case)

The risk assessed against the HIPAP4 criteria for the base case are summarised in Table 4-5.

Table 4-5: LSIR Results Assessed Against the HIPAP4 Land Use Criteria for KA-4/14 Wellsite (Base Case)

LSIR	Risk Contour	HIPAP4 Land Use Criteria	Result
5E-05 / year	Blue	5E-5 / year risk contour should, as a target, be contained within the boundaries of the industrial site where applicable.	Criteria met. The 5E-05 / year risk contour is within the site boundary.
1E-6 / year	Red	1E-6 / year risk contour should not extend to residential developments, hotels, tourist resorts.	Criteria met. There are no residential developments, hotels, tourist resorts within the contour.

4.3.2 Sensitivity Case

The risk contour for the KA-4/14 wellsite sensitivity case 1, which includes the aboveground gathering pipeline sections is presented in Figure 4-2.

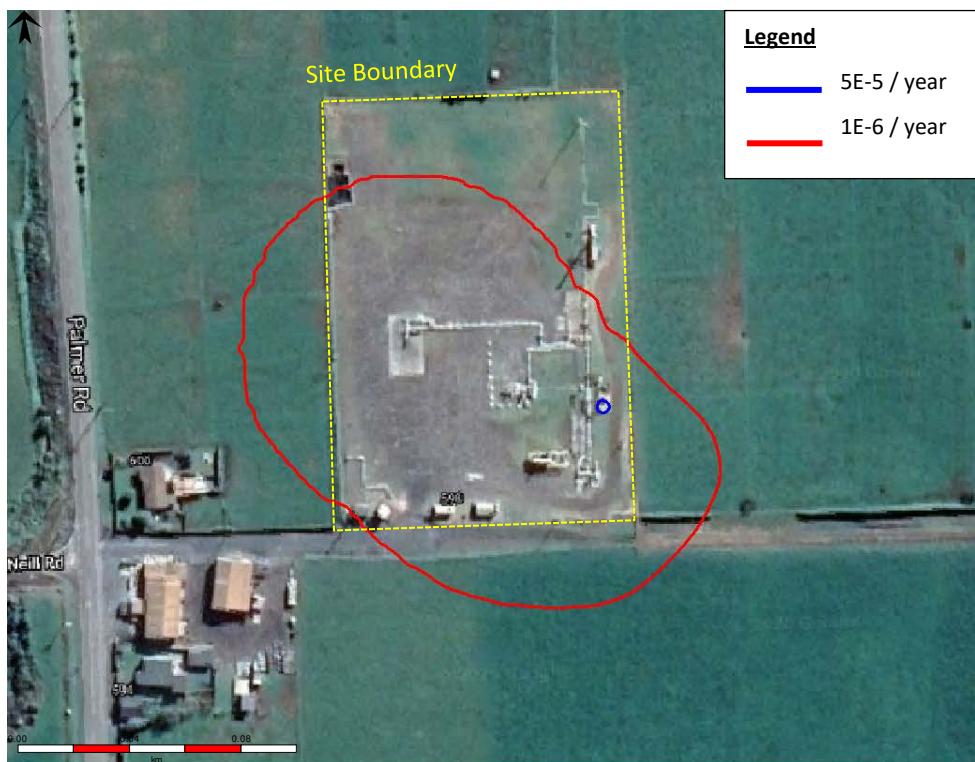



Figure 4-2: Risk Contour for KA-4/14 Wellsite (Sensitivity Case 1)


The risk contours for the sensitivity case similar to the base case and the assessment against the HIPAP4 criteria is the same, hence is it not repeated.

5. REFERENCES

1. Todd Energy, Safety Case – Kapuni Production Station, Doc. No. NOL649981, Rev 1, January 2018
2. Kapuni Wellsites, Quantitative Risk Assessment, 610114-RPT-R0002, Rev. 1, July 2022
3. Kapuni Wellsites QRA, Assumptions Register, 610114-RPT-R0001, Rev. 1, July 2022
4. Kapuni J Wellsite, Quantitative Risk Assessment, 620035-RPT-R0002, Rev. 0, May 2019

Appendix 1.
P&ID Sectionalisation for KA-19

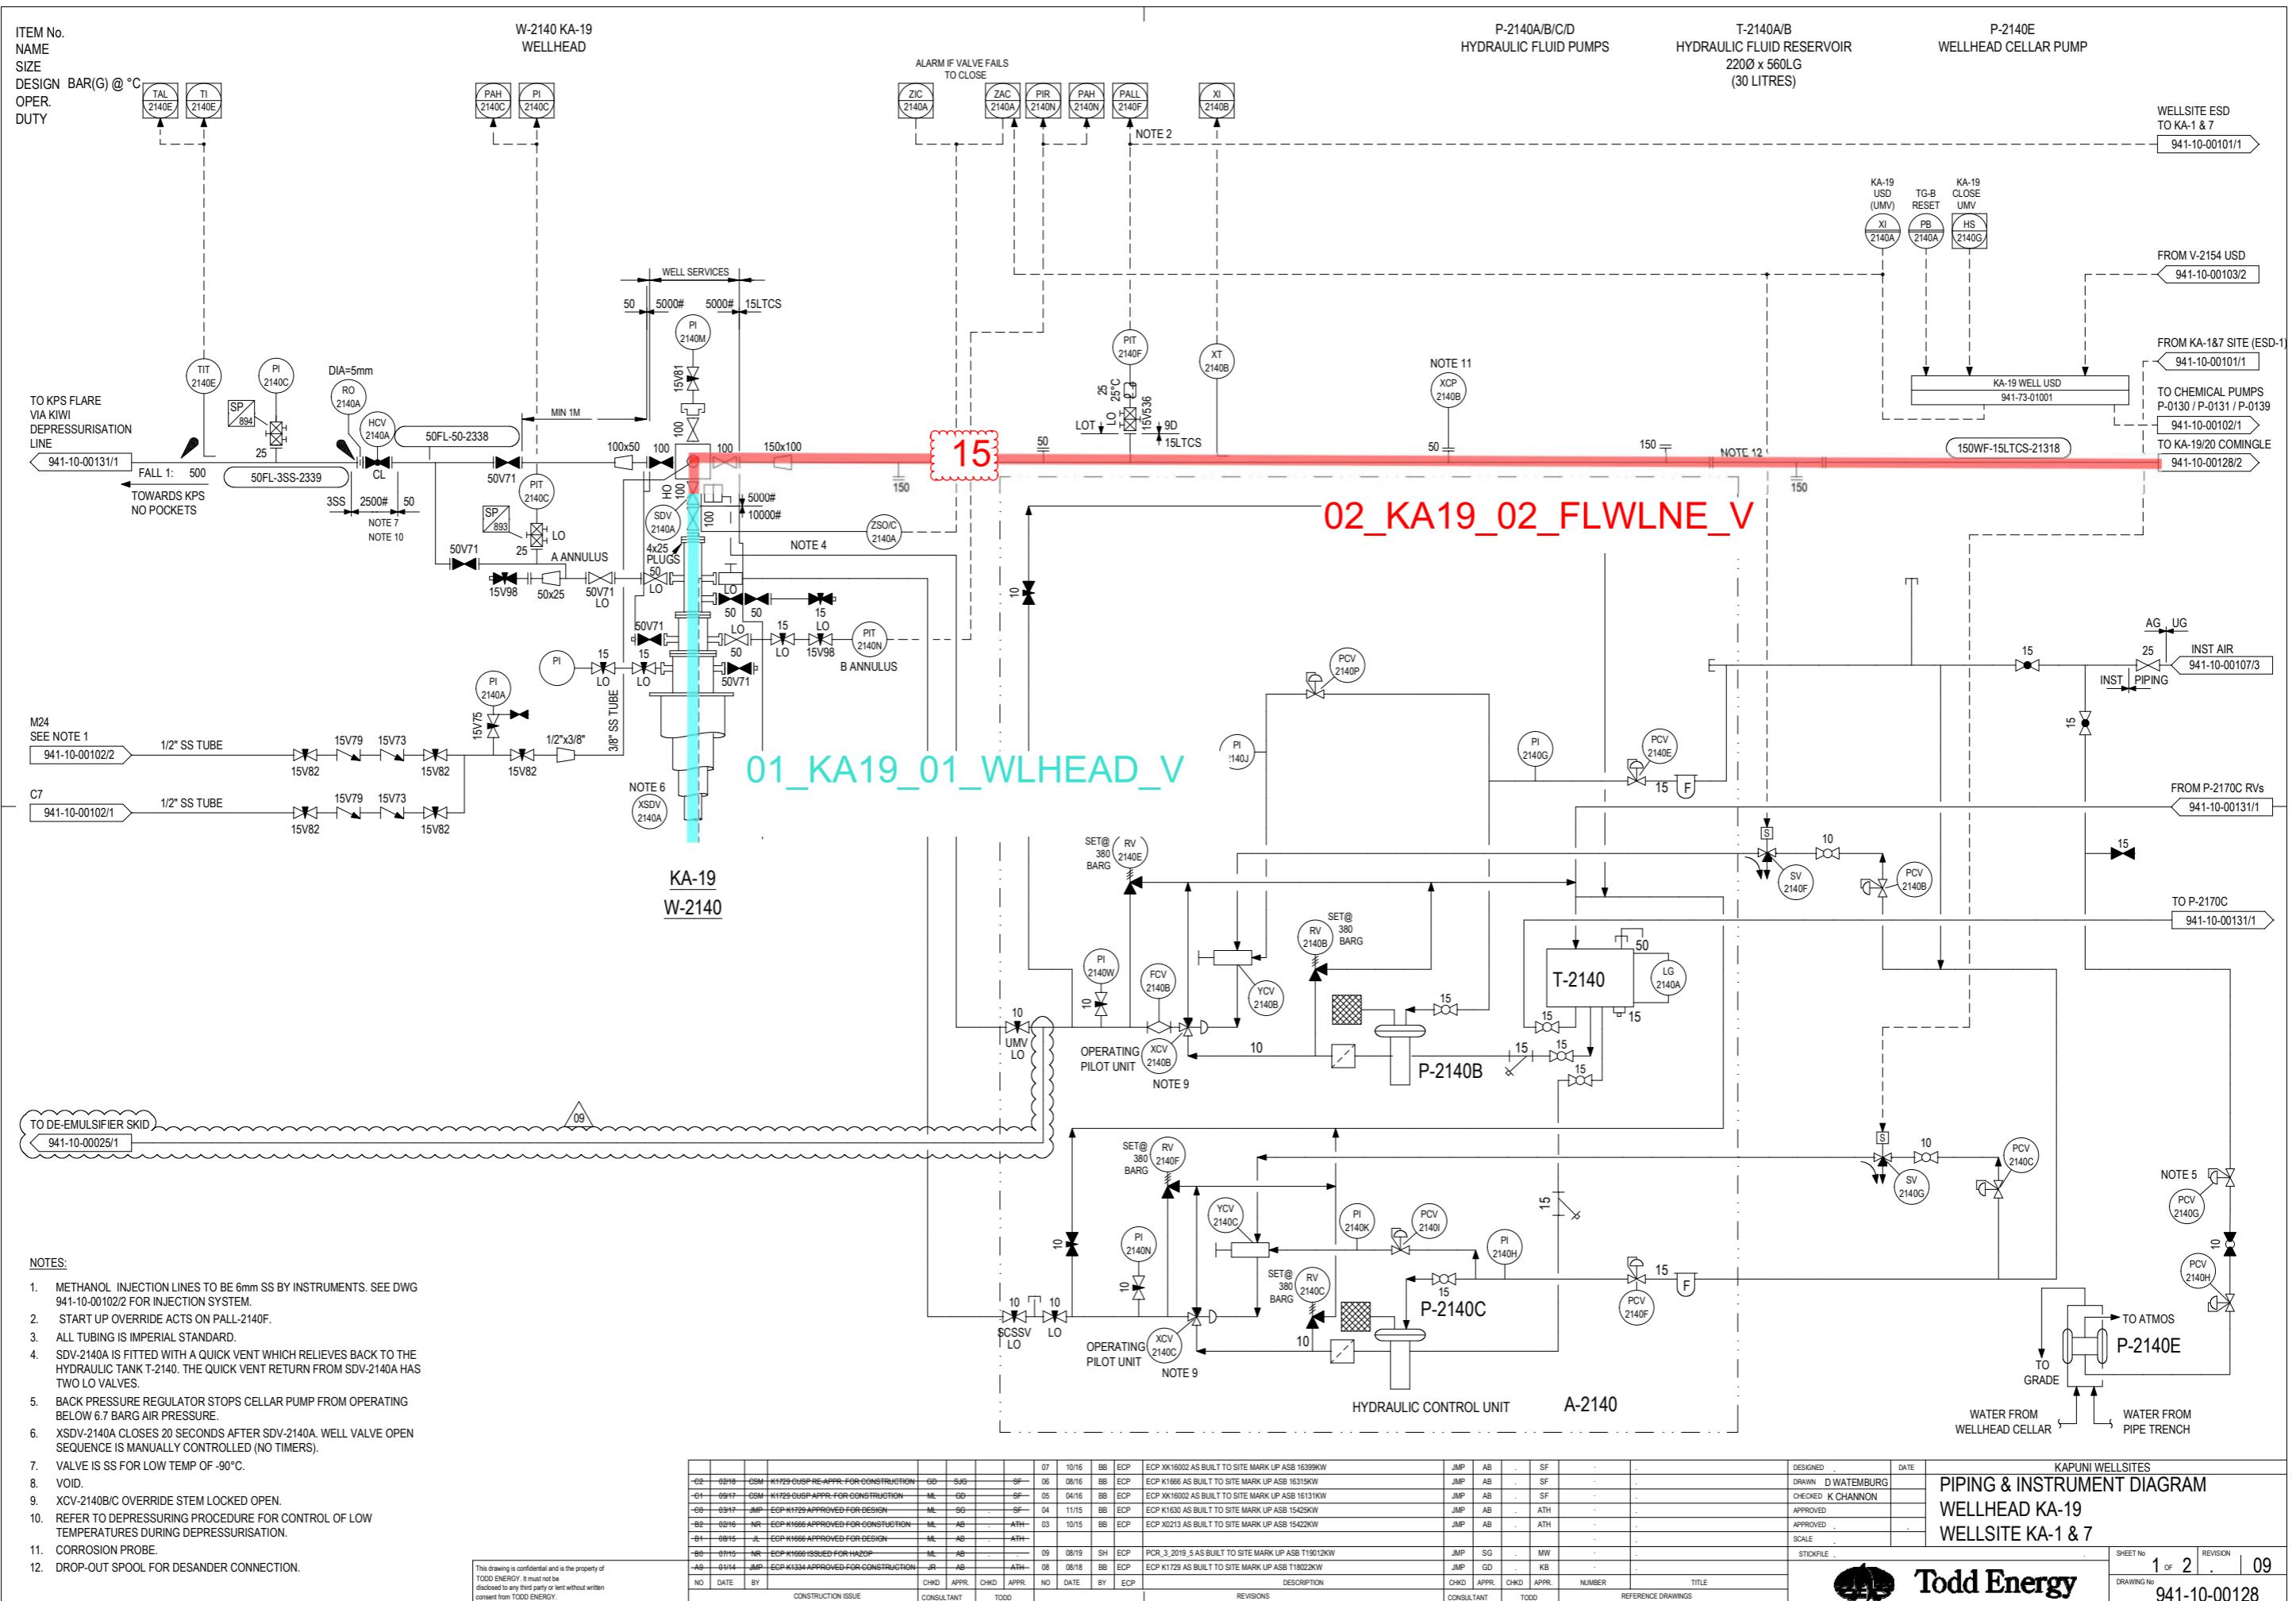


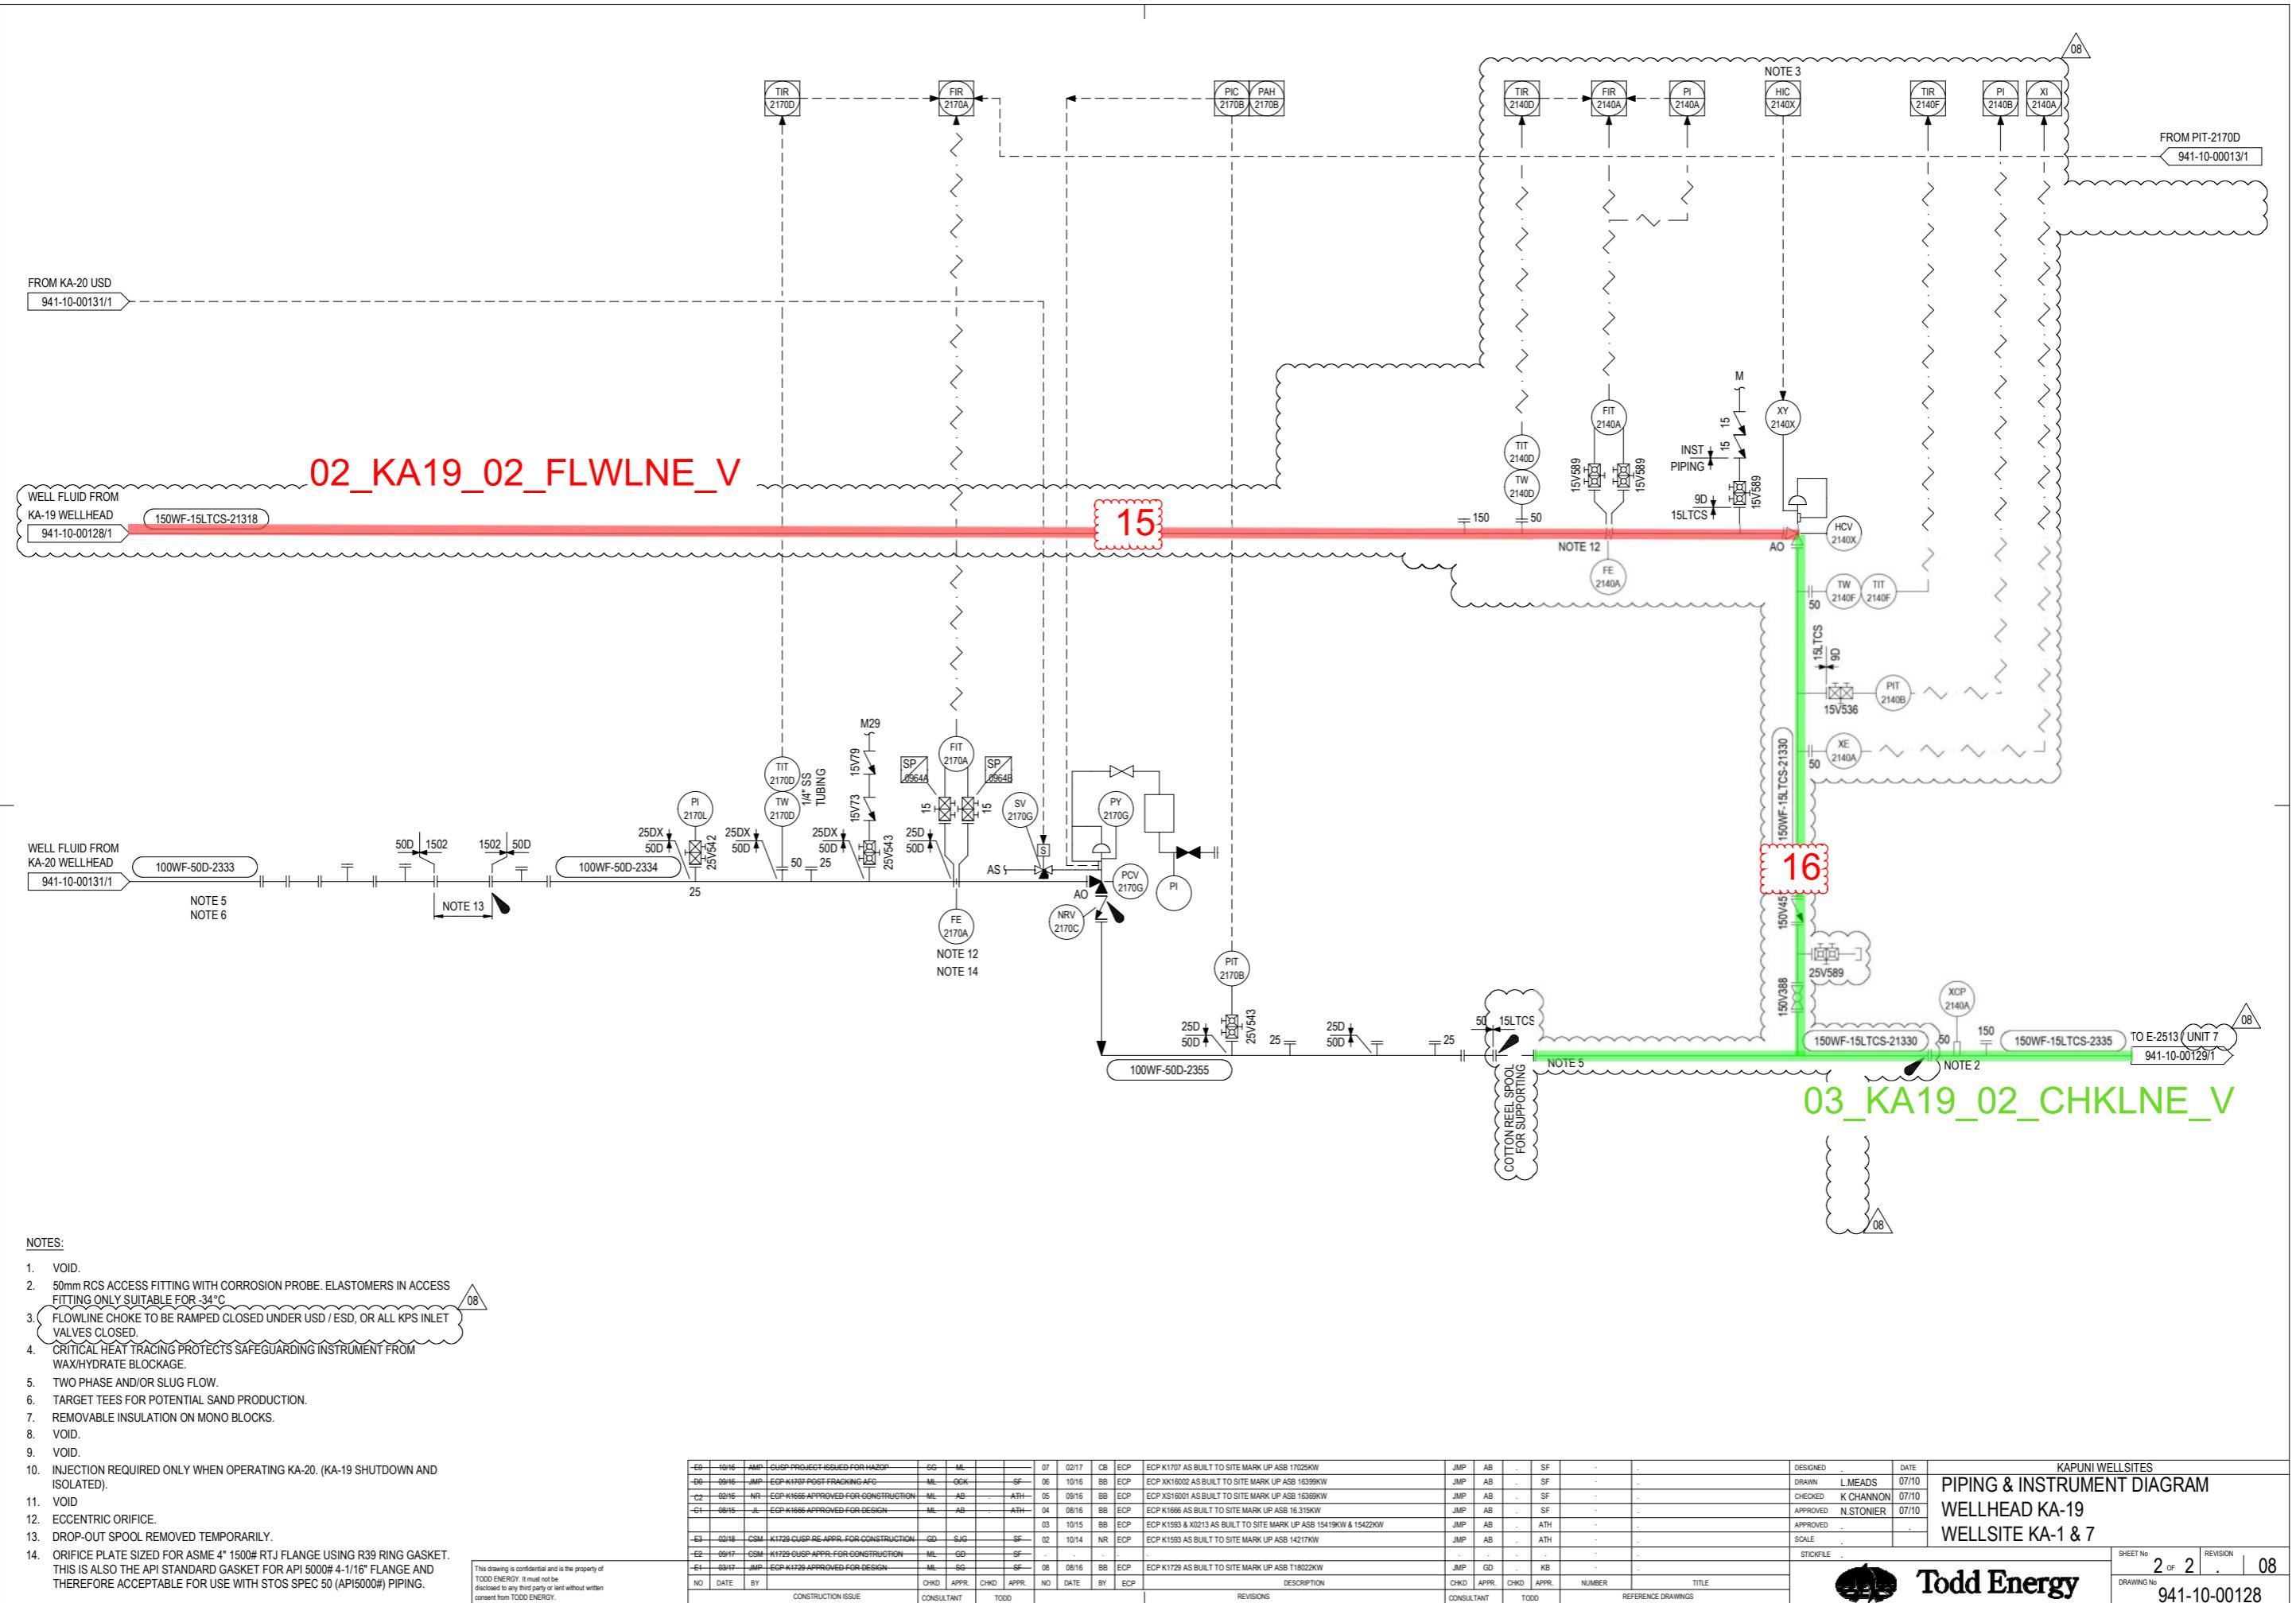

ITEM No.
NAME
SIZE
DESIGN
OPER.
DUTY

H-2194
UNIT 7 WELLSTREAM HEATER

Base Case - without LTS 7

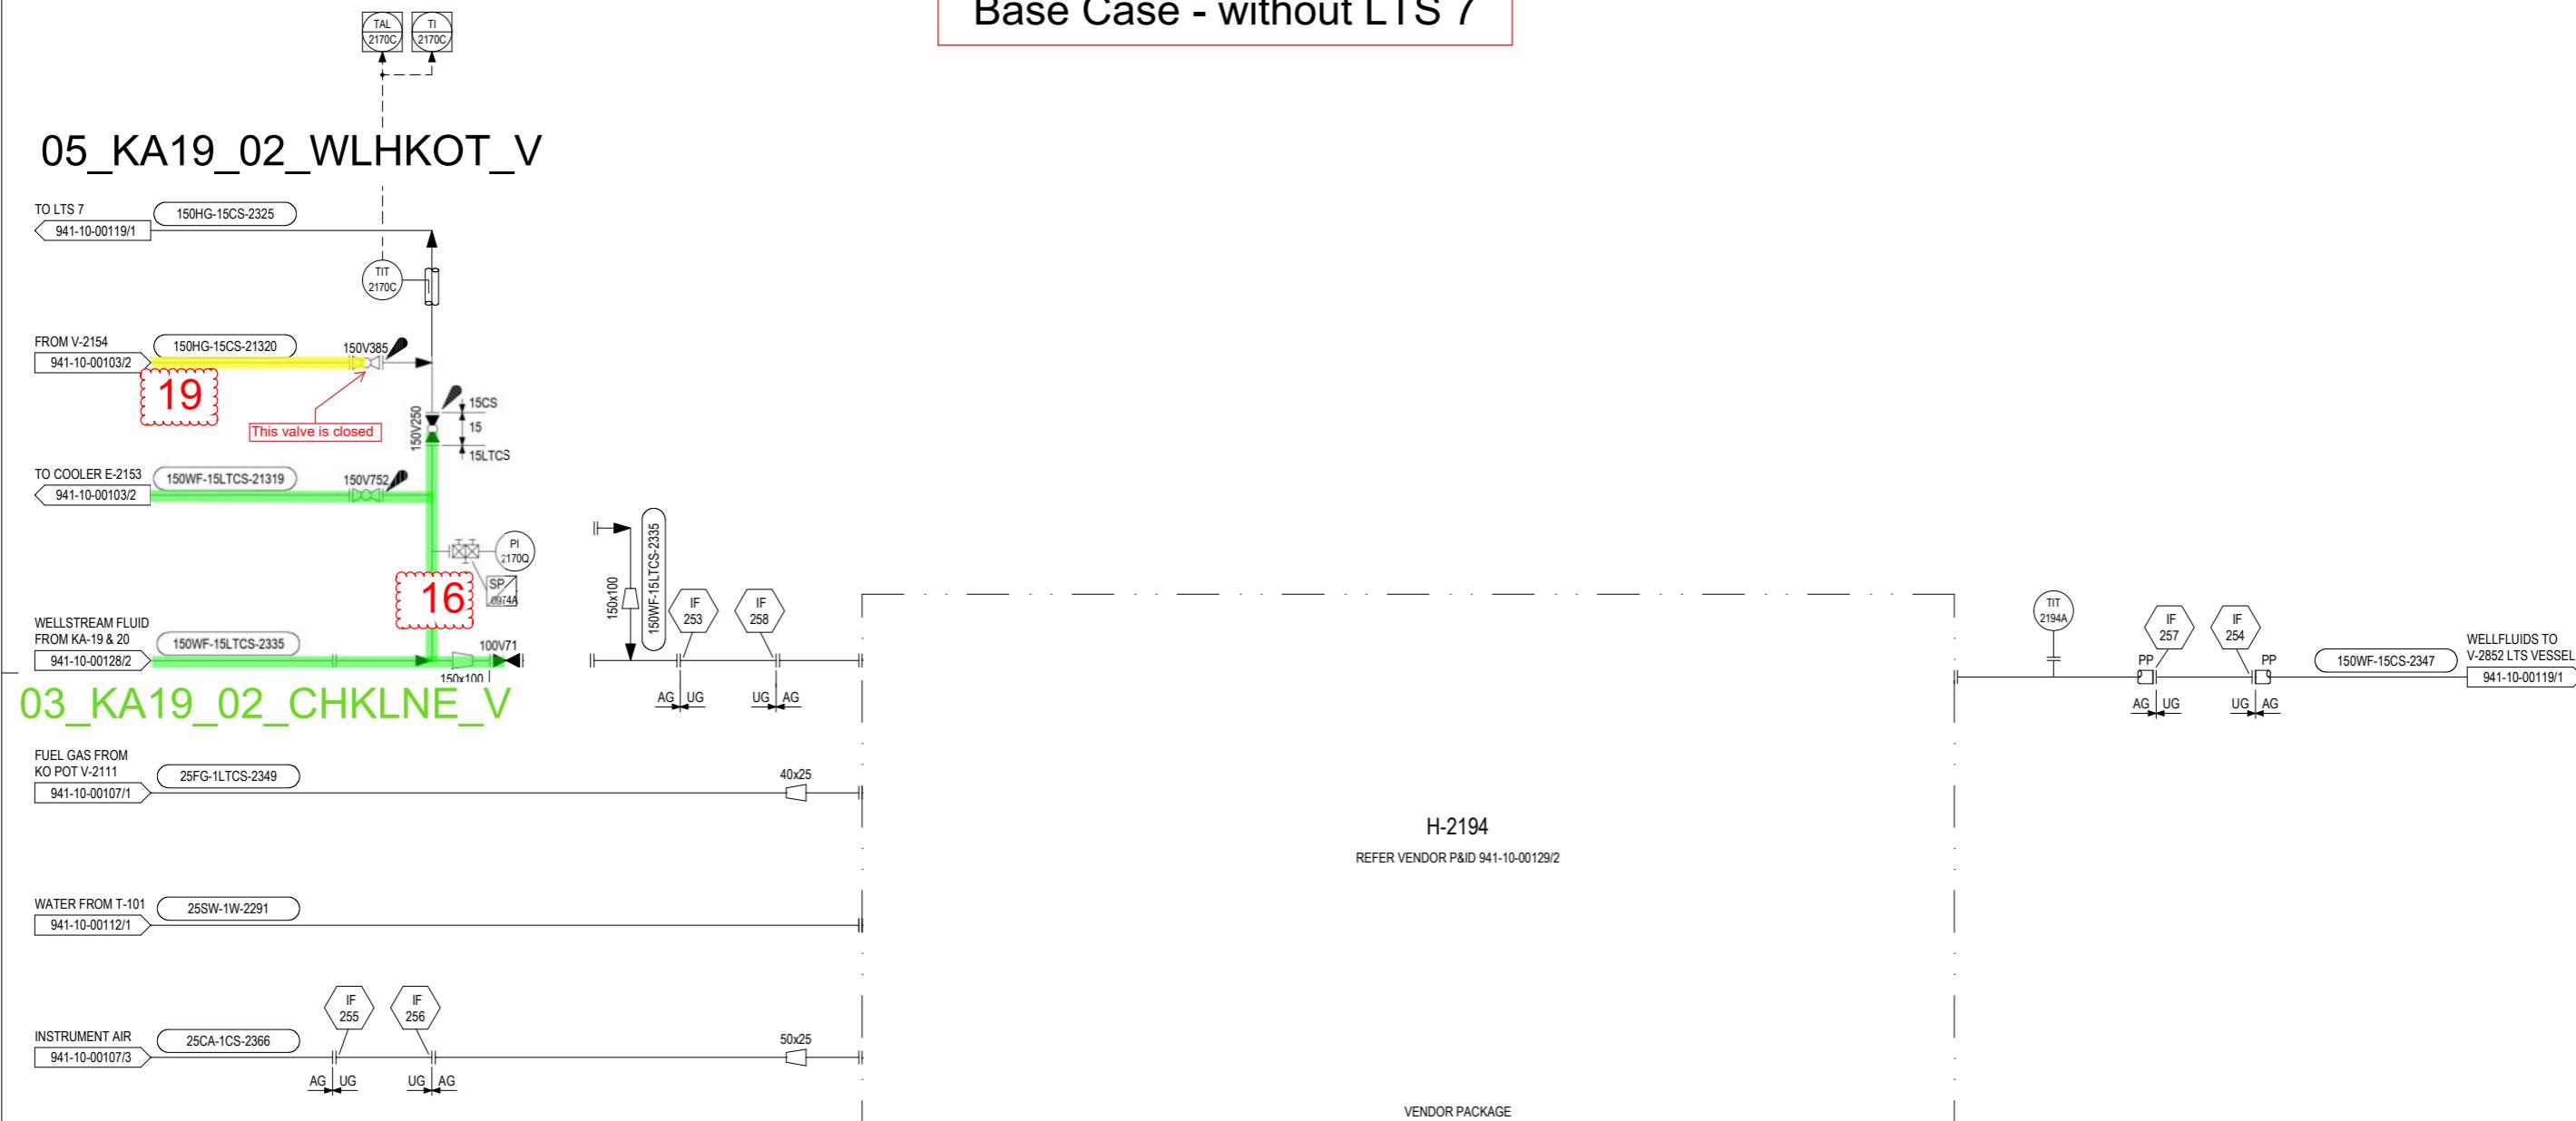

This drawing is confidential and is the property of
TODD ENERGY. It must not be
disclosed to any third party or lent without written
consent from TODD ENERGY.

KAPUNI WELLSITES												PIPING & INSTRUMENT DIAGRAM					
												WELLSTREAM HEATER					
												WELLSITE KA-1 & 7					
NO	DATE	BY	CHKD	APPR.	CHKD	APPR.	NO	DATE	BY	ECP	DESCRIPTION	CHKD	APPR.	CHKD	APPR.	NUMBER	TITLE
CONSTRUCTION ISSUE												REVISIONS					
CONSULTANT												CONSULTANT					
TODD												REFERENCE DRAWINGS					
D9	02/18	GBM	K1729 GUSP RE-APPR FOR CONSTRUCTION	GB	S6	SF	06	11/19	JUP	ECP	ECP K1827 AS BUILT TO SITE MARK UP ASB T19019KW	JMP	SG	-	MW	-	DRAWN D WATEMBURG
D9	09/17	GBM	K1729 GUSP ATTR FOR CONSTRUCTION	ML	GG	SF	05	08/18	BB	ECP	ECP K1729 AS BUILT TO SITE MARK UP T18022KW	JMP	GD	-	KB	-	CHECKED
D1	03/17	IMP	ECP K1729 APPROVED FOR DESIGN	ML	GG	SF	04	06/17	BB	ECP	ECP XX17172 AS BUILT TO SITE MARK UP ASB 17187KW	JMP	TD	-	SF	-	APPROVED
D0	10/18	IMP	ECP PROJECT ISSUED FOR HAZOP	SIG	ML	-	03	08/16	BB	ECP	ECP K1666 AS BUILT TO SITE MARK UP ASB 16315KW	JMP	AB	-	SF	-	APPROVED
C1	09/16	IMP	ECP K1707 FRACK FLOWBACK AFC	-	-	ATH	02	11/15	BB	ECP	ECP K1630 AS BUILT TO SITE MARK UP ASB 15425KW	JMP	AB	-	ATH	-	SCALE
C9	09/16	IMP	ECP K1707 ISSUED FOR HAZOP	-	-	-	01	04/14	DG	ECP	ECP K1334 AS BUILT TO SITE MARK UP ASB 14036KW	JMP	AB	-	ATH	-	STICKFILE
NO DATE BY												REFERENCE DRAWINGS					
CONSTRUCTION ISSUE												REVISIONS					
CONSULTANT												CONSULTANT					
TODD												REFERENCE DRAWINGS					


Todd Energy

1 of 2 | REVISION | 06
DRAWING No 941-10-00129

ITEM No.
NAME
SIZE
DESIGN
OPER.
DUTY

H-2194
UNIT 7 WELLSTREAM HEATER

Sensitivity Case - with LTS 7

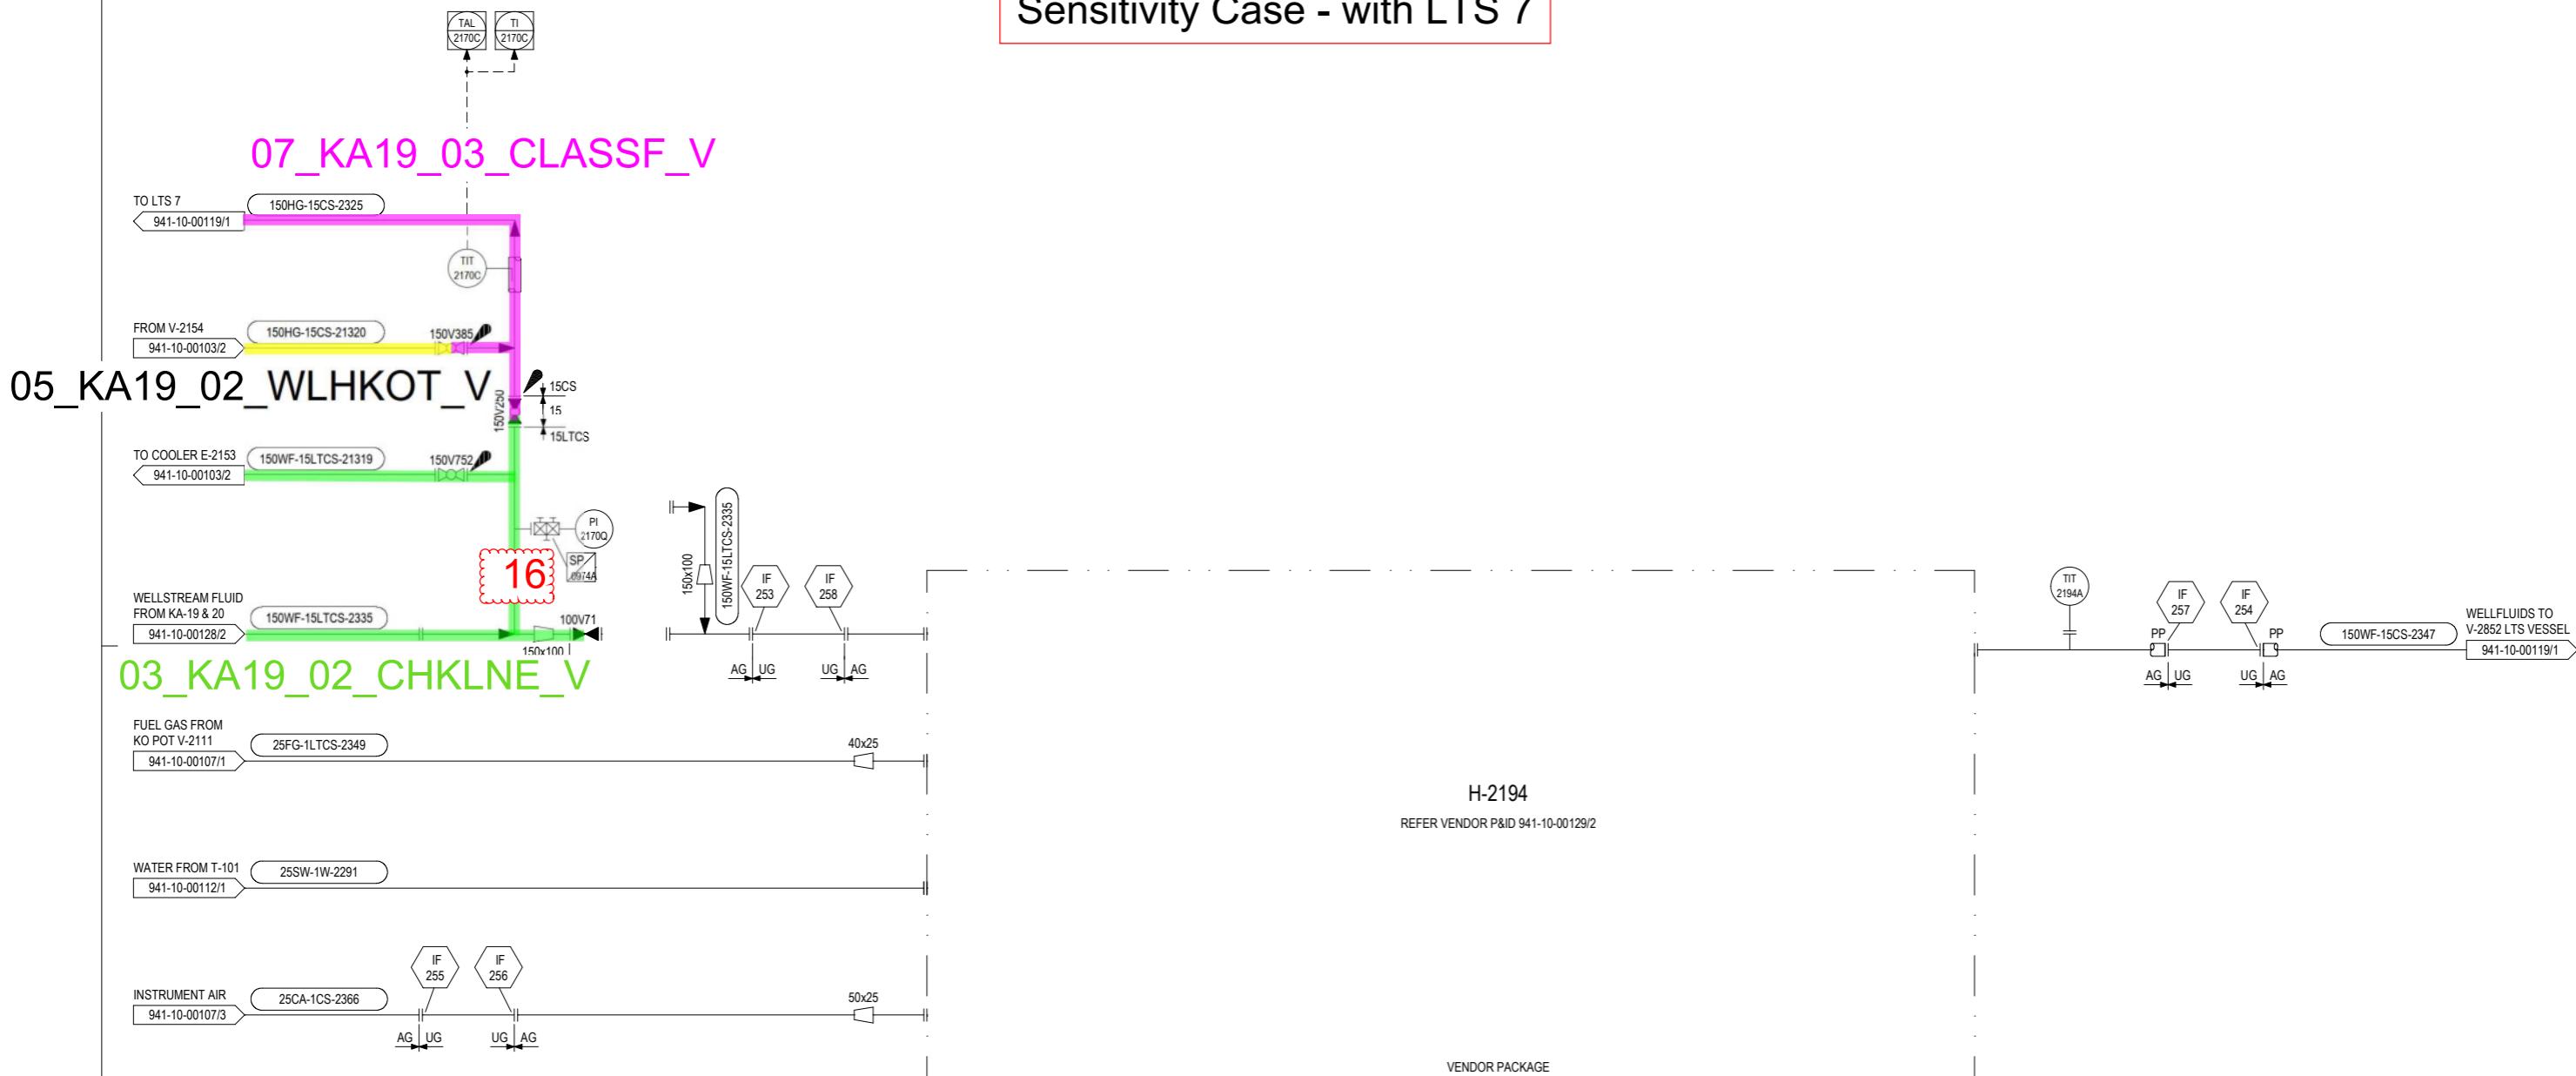



This drawing is confidential and is the property of
TODD ENERGY. It must not be
disclosed to any third party or lent without written
consent from TODD ENERGY.

KAPUNI WELLSITES												PIPING & INSTRUMENT DIAGRAM					
												WELLSTREAM HEATER					
												WELLSITE KA-1 & 7					
NO	DATE	BY	CONSTRUCTION ISSUE	CONSULTANT	CHKD	APPR.	CHKD	APPR.	NO	DATE	BY	ECP	DESCRIPTION	CHKD	APPR.	CHKD	APPR.
													REVISIONS	CONSULTANT	TODD	NUMBER	TITLE
D9	02/18	GBM	K1729 CUSP RE-APPR FOR CONSTRUCTION	GB	S6	SF	05	08/18	JUP	ECP	ECP K1827 AS BUILT TO SITE MARK UP ASB T19019KW	JMP	SG	MW	-	-	DESIGNED . DATE . DRAWN D WATEMBURG . CHECKED . APPROVED . APPROVED . SCALE . STICKFILE .
D9	09/17	GBM	K1729 CUSP ATTR FOR CONSTRUCTION	ML	G9	SF	04	06/17	BB	ECP	ECP K1729 AS BUILT TO SITE MARK UP T18022KW	JMP	GD	KB	-	-	
D1	03/17	IMP	ECP K1729 APPROVED FOR DESIGN	ML	S9	SF	03	08/16	BB	ECP	ECP K1666 AS BUILT TO SITE MARK UP ASB 17187KW	JMP	TD	SF	-	-	
D0	10/16	IMP	ECP PROJECT ISSUED FOR HAZOP	SIG	ML		02	11/15	BB	ECP	ECP K1630 AS BUILT TO SITE MARK UP ASB 15425KW	JMP	AB	ATH	-	-	
C1	09/16	IMP	ECP K1707 FROCK FLOWBACK AFC			ATH	01	04/14	DG	ECP	ECP K1334 AS BUILT TO SITE MARK UP ASB 14036KW	JMP	AB	ATH	-	-	
C9	09/16	IMP	ECP K1707 ISSUED FOR HAZOP				00	DW	ECP	ECP K1334 FIRST ISSUE	-	-	-	-	-		


Todd Energy

1 of 2 | REVISION | 06
DRAWING No 941-10-00129

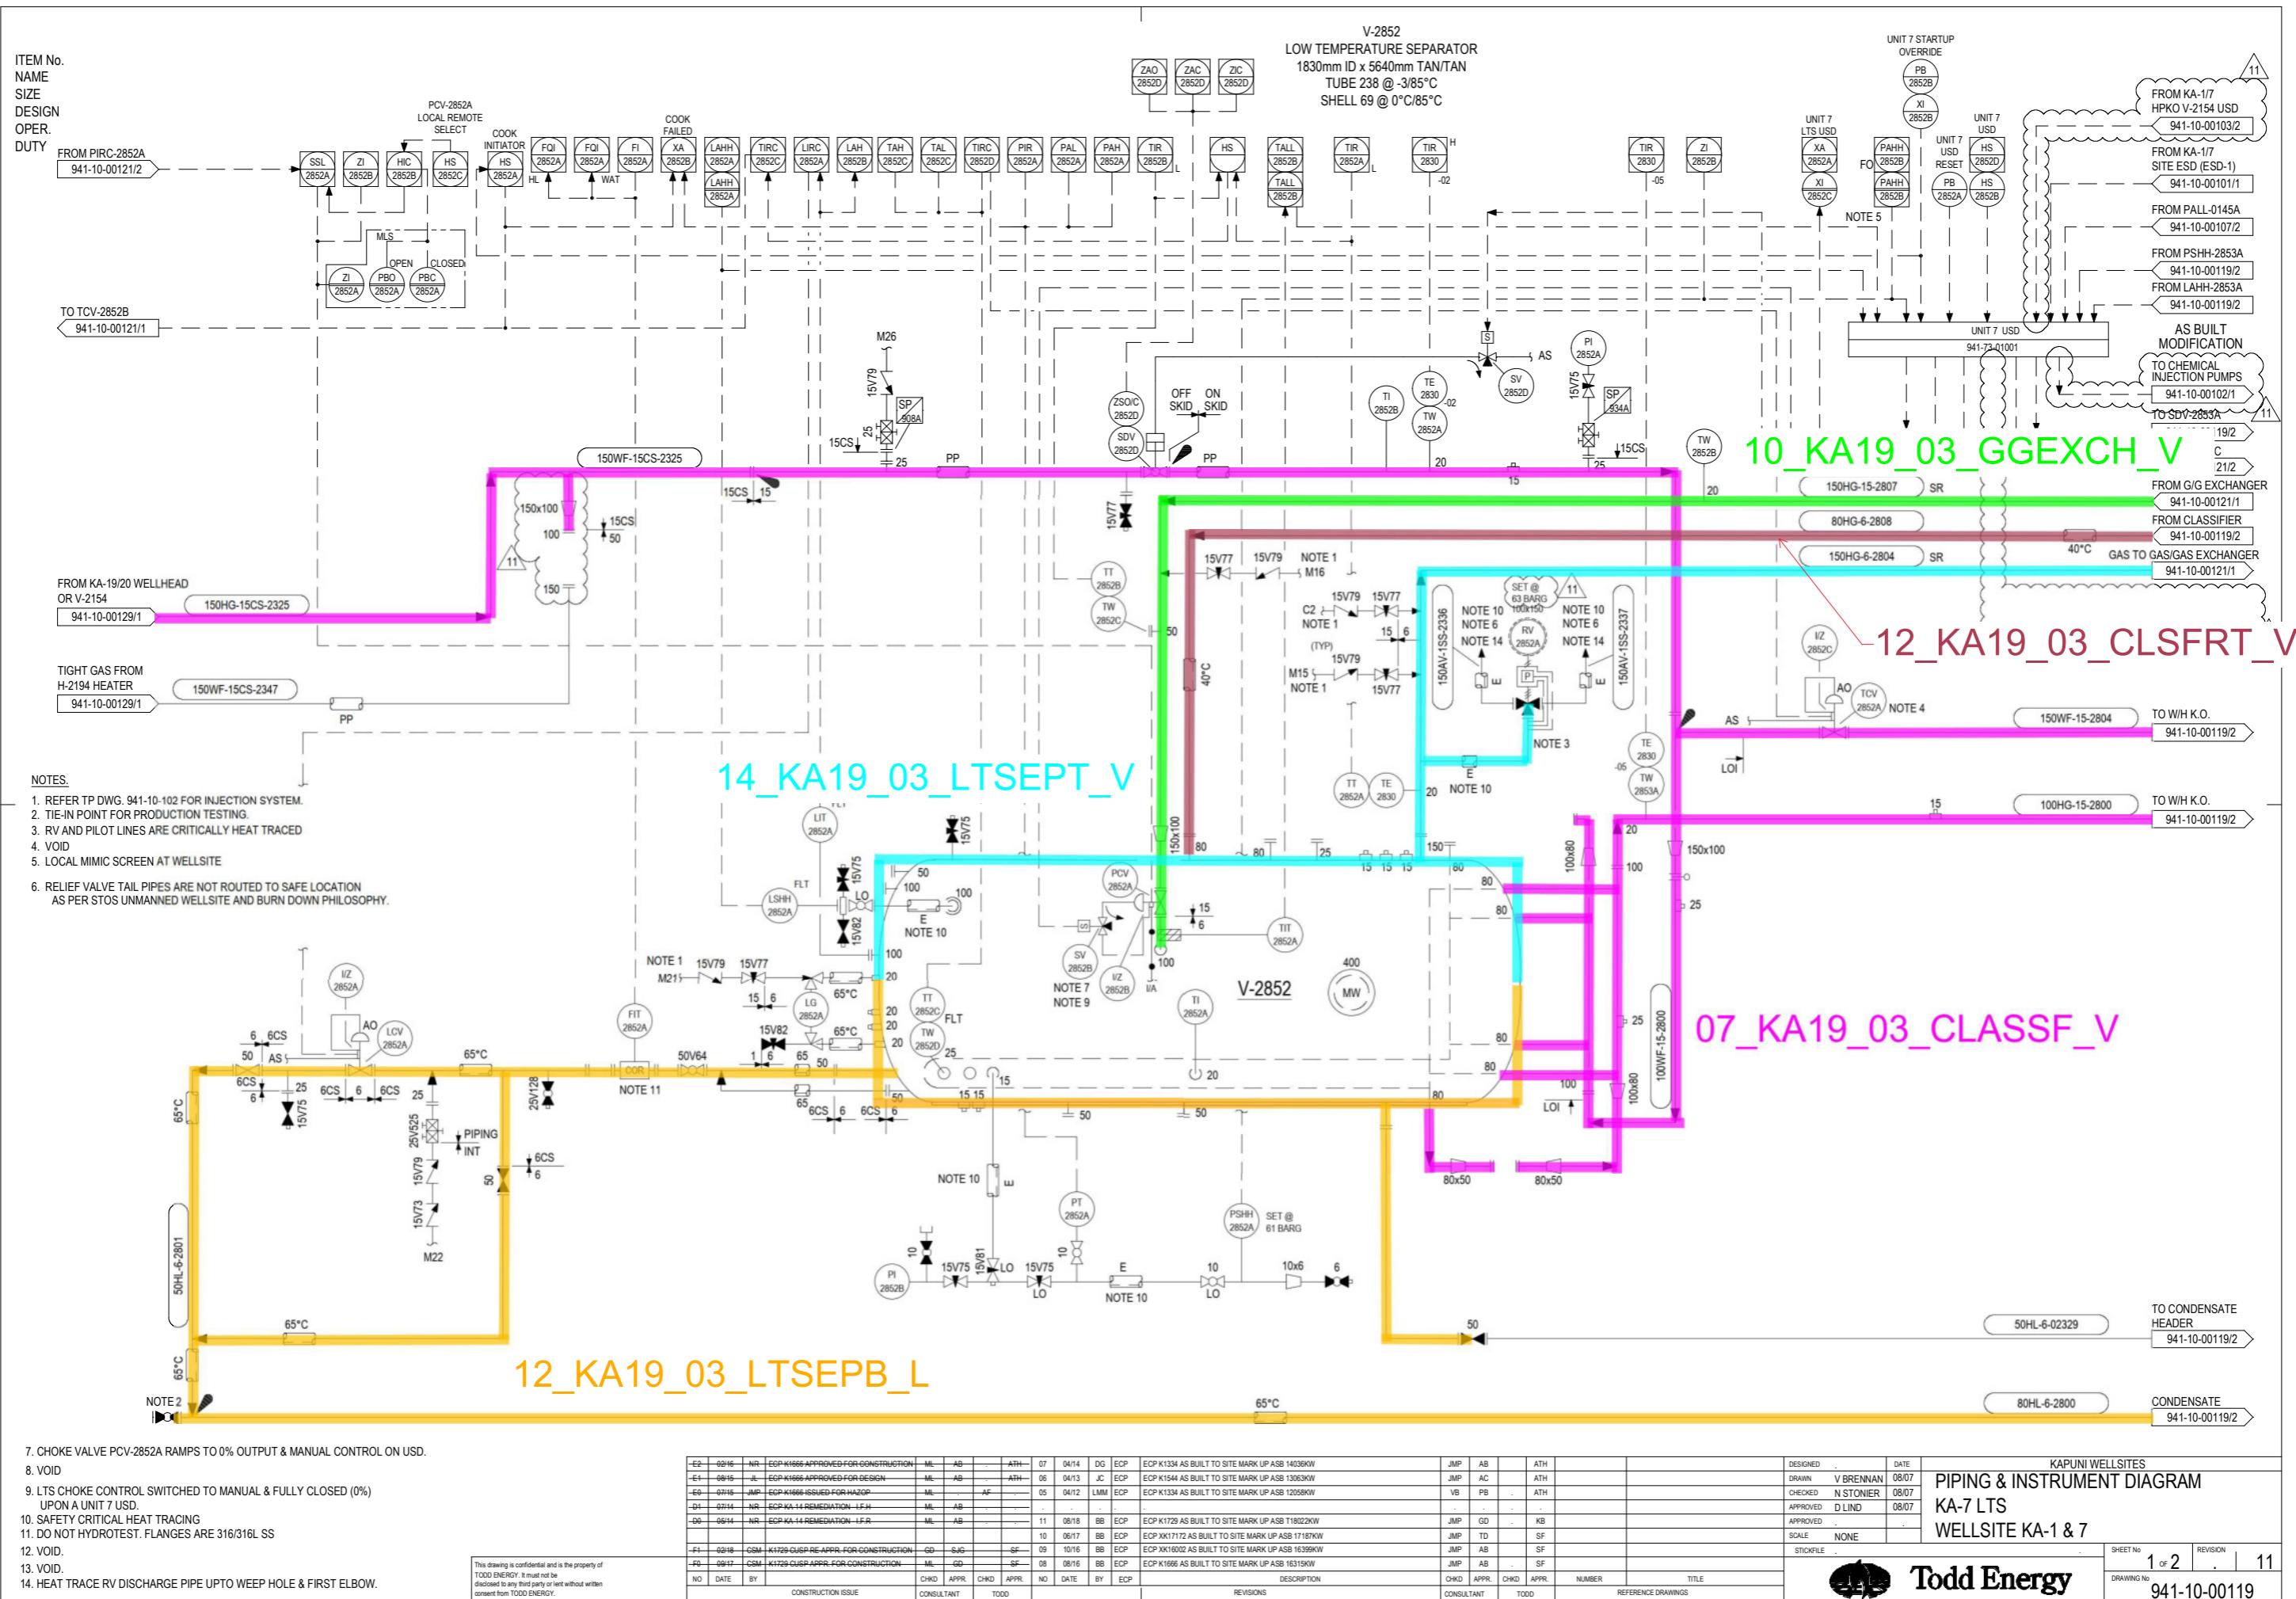

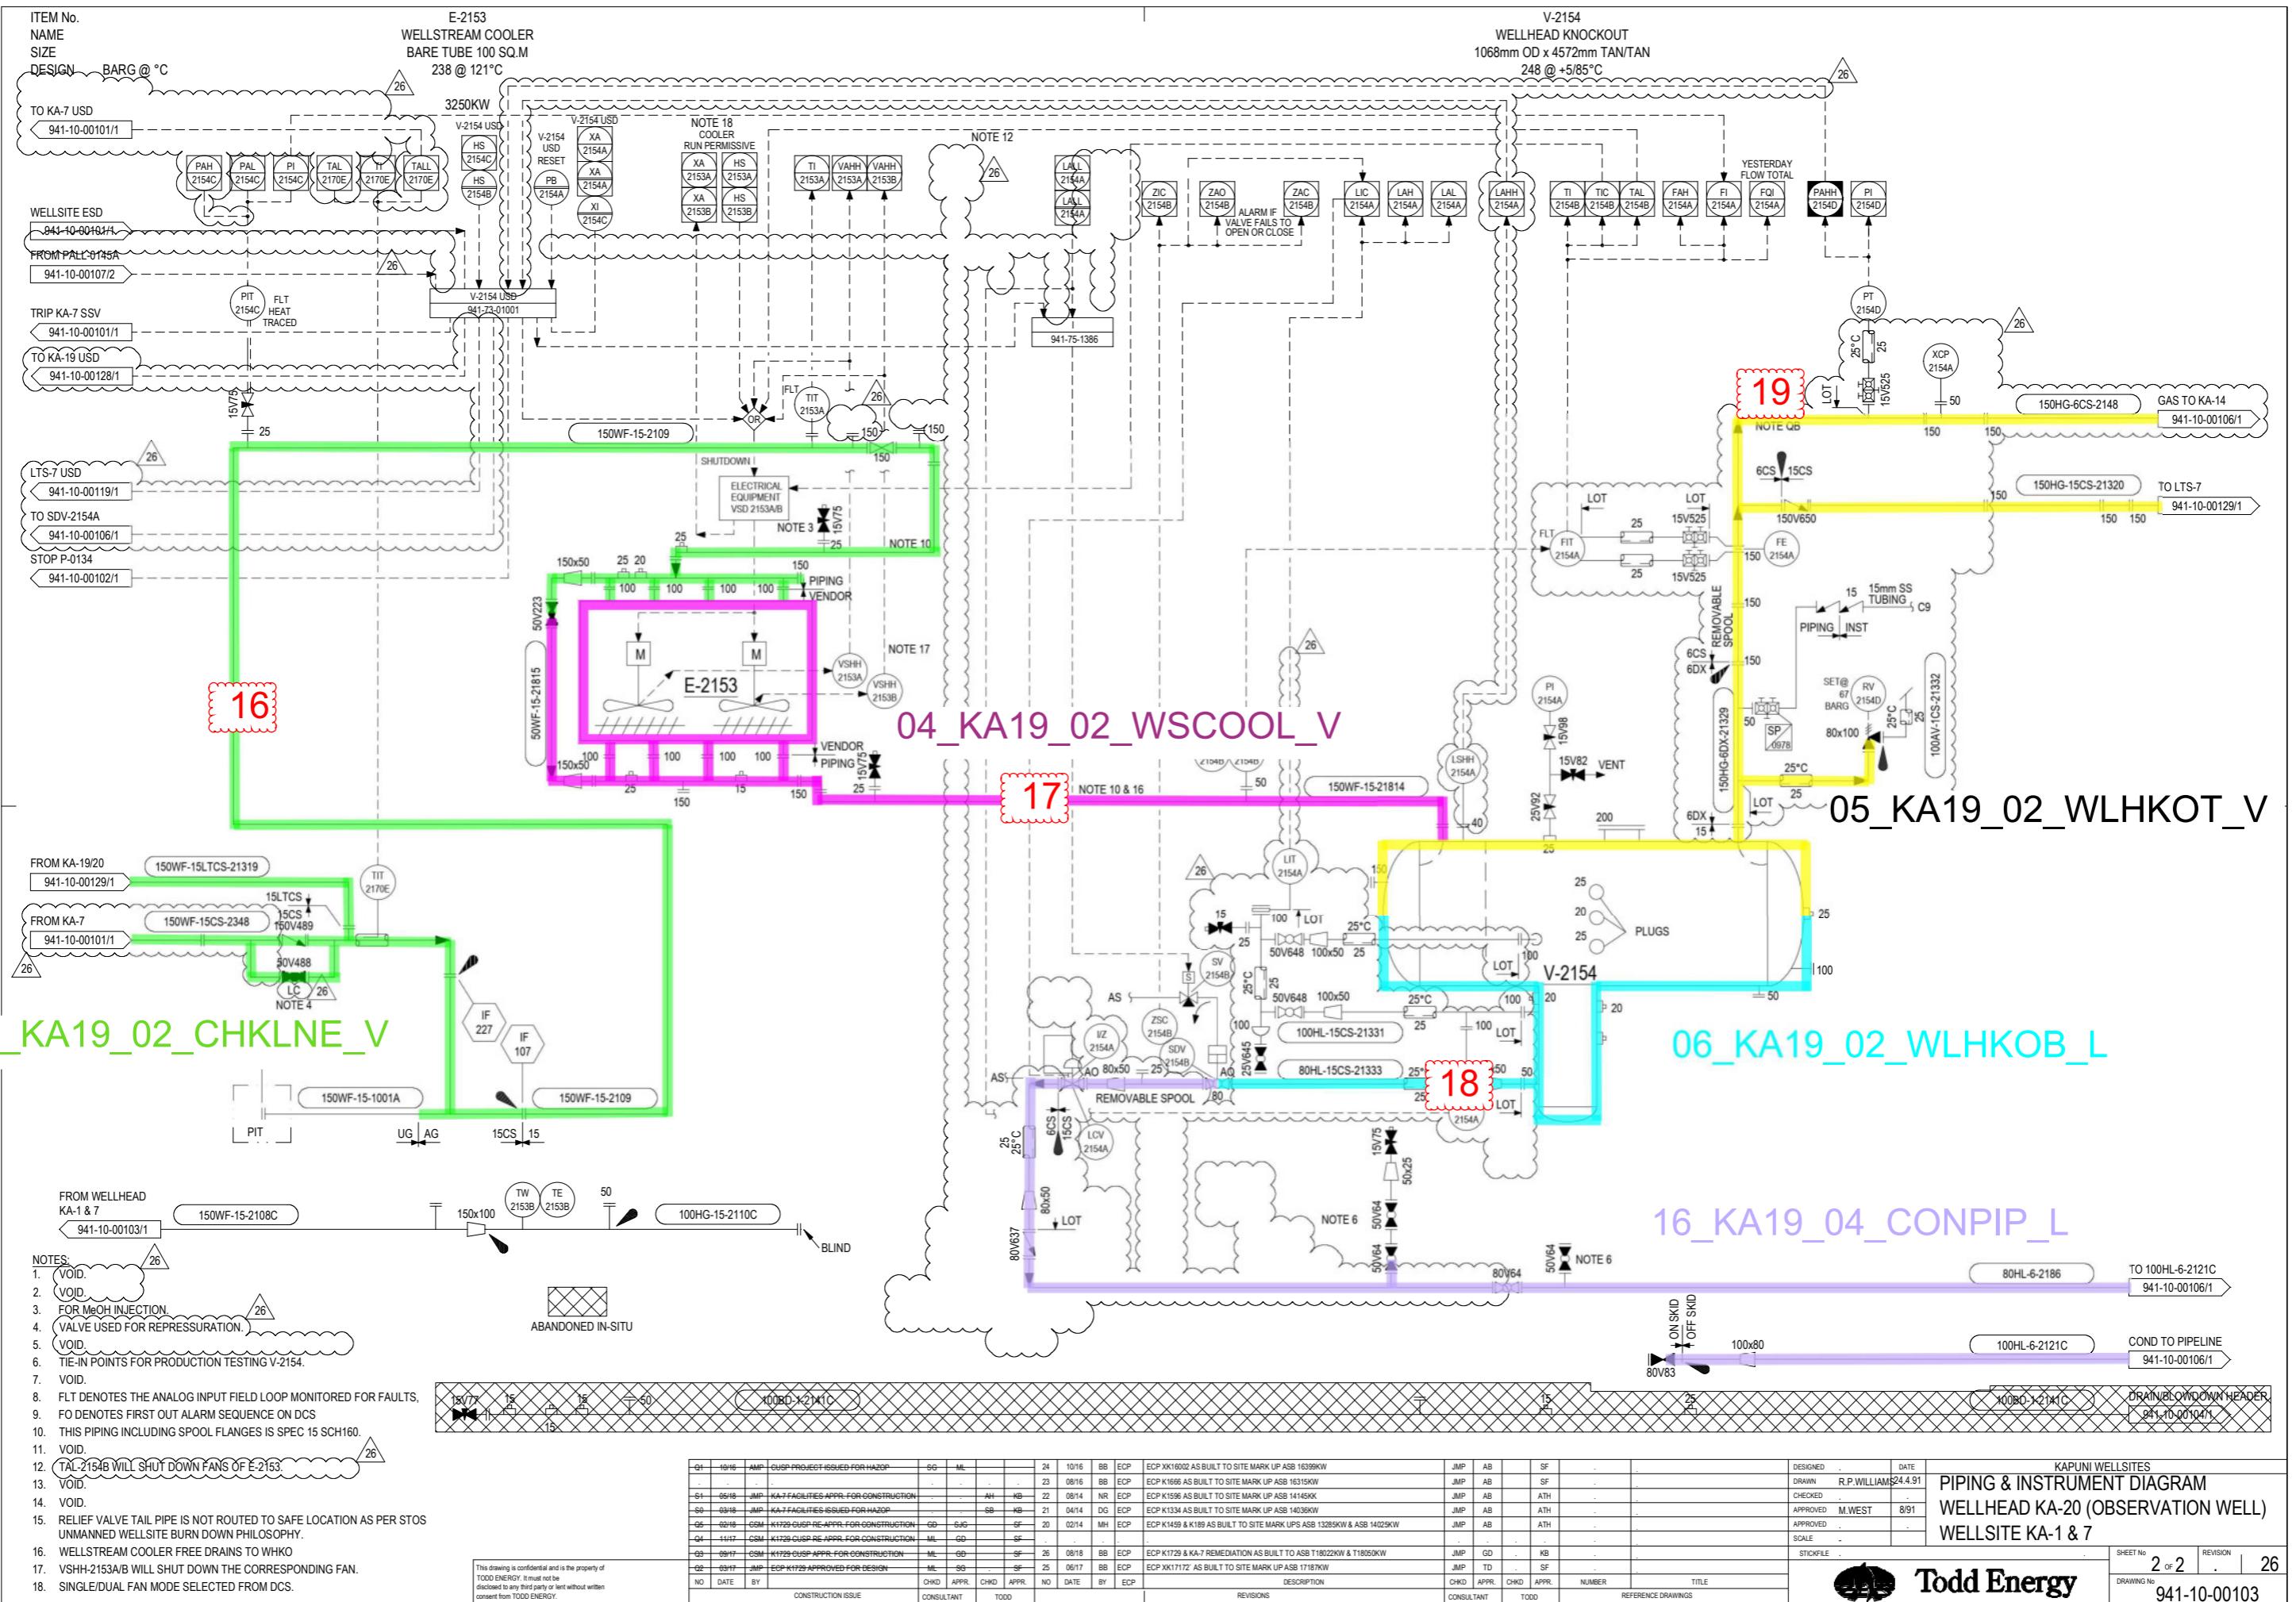


ITEM No.
NAME
SIZE
DESIGN BAR(G) @ °C
OPER.
DUTY

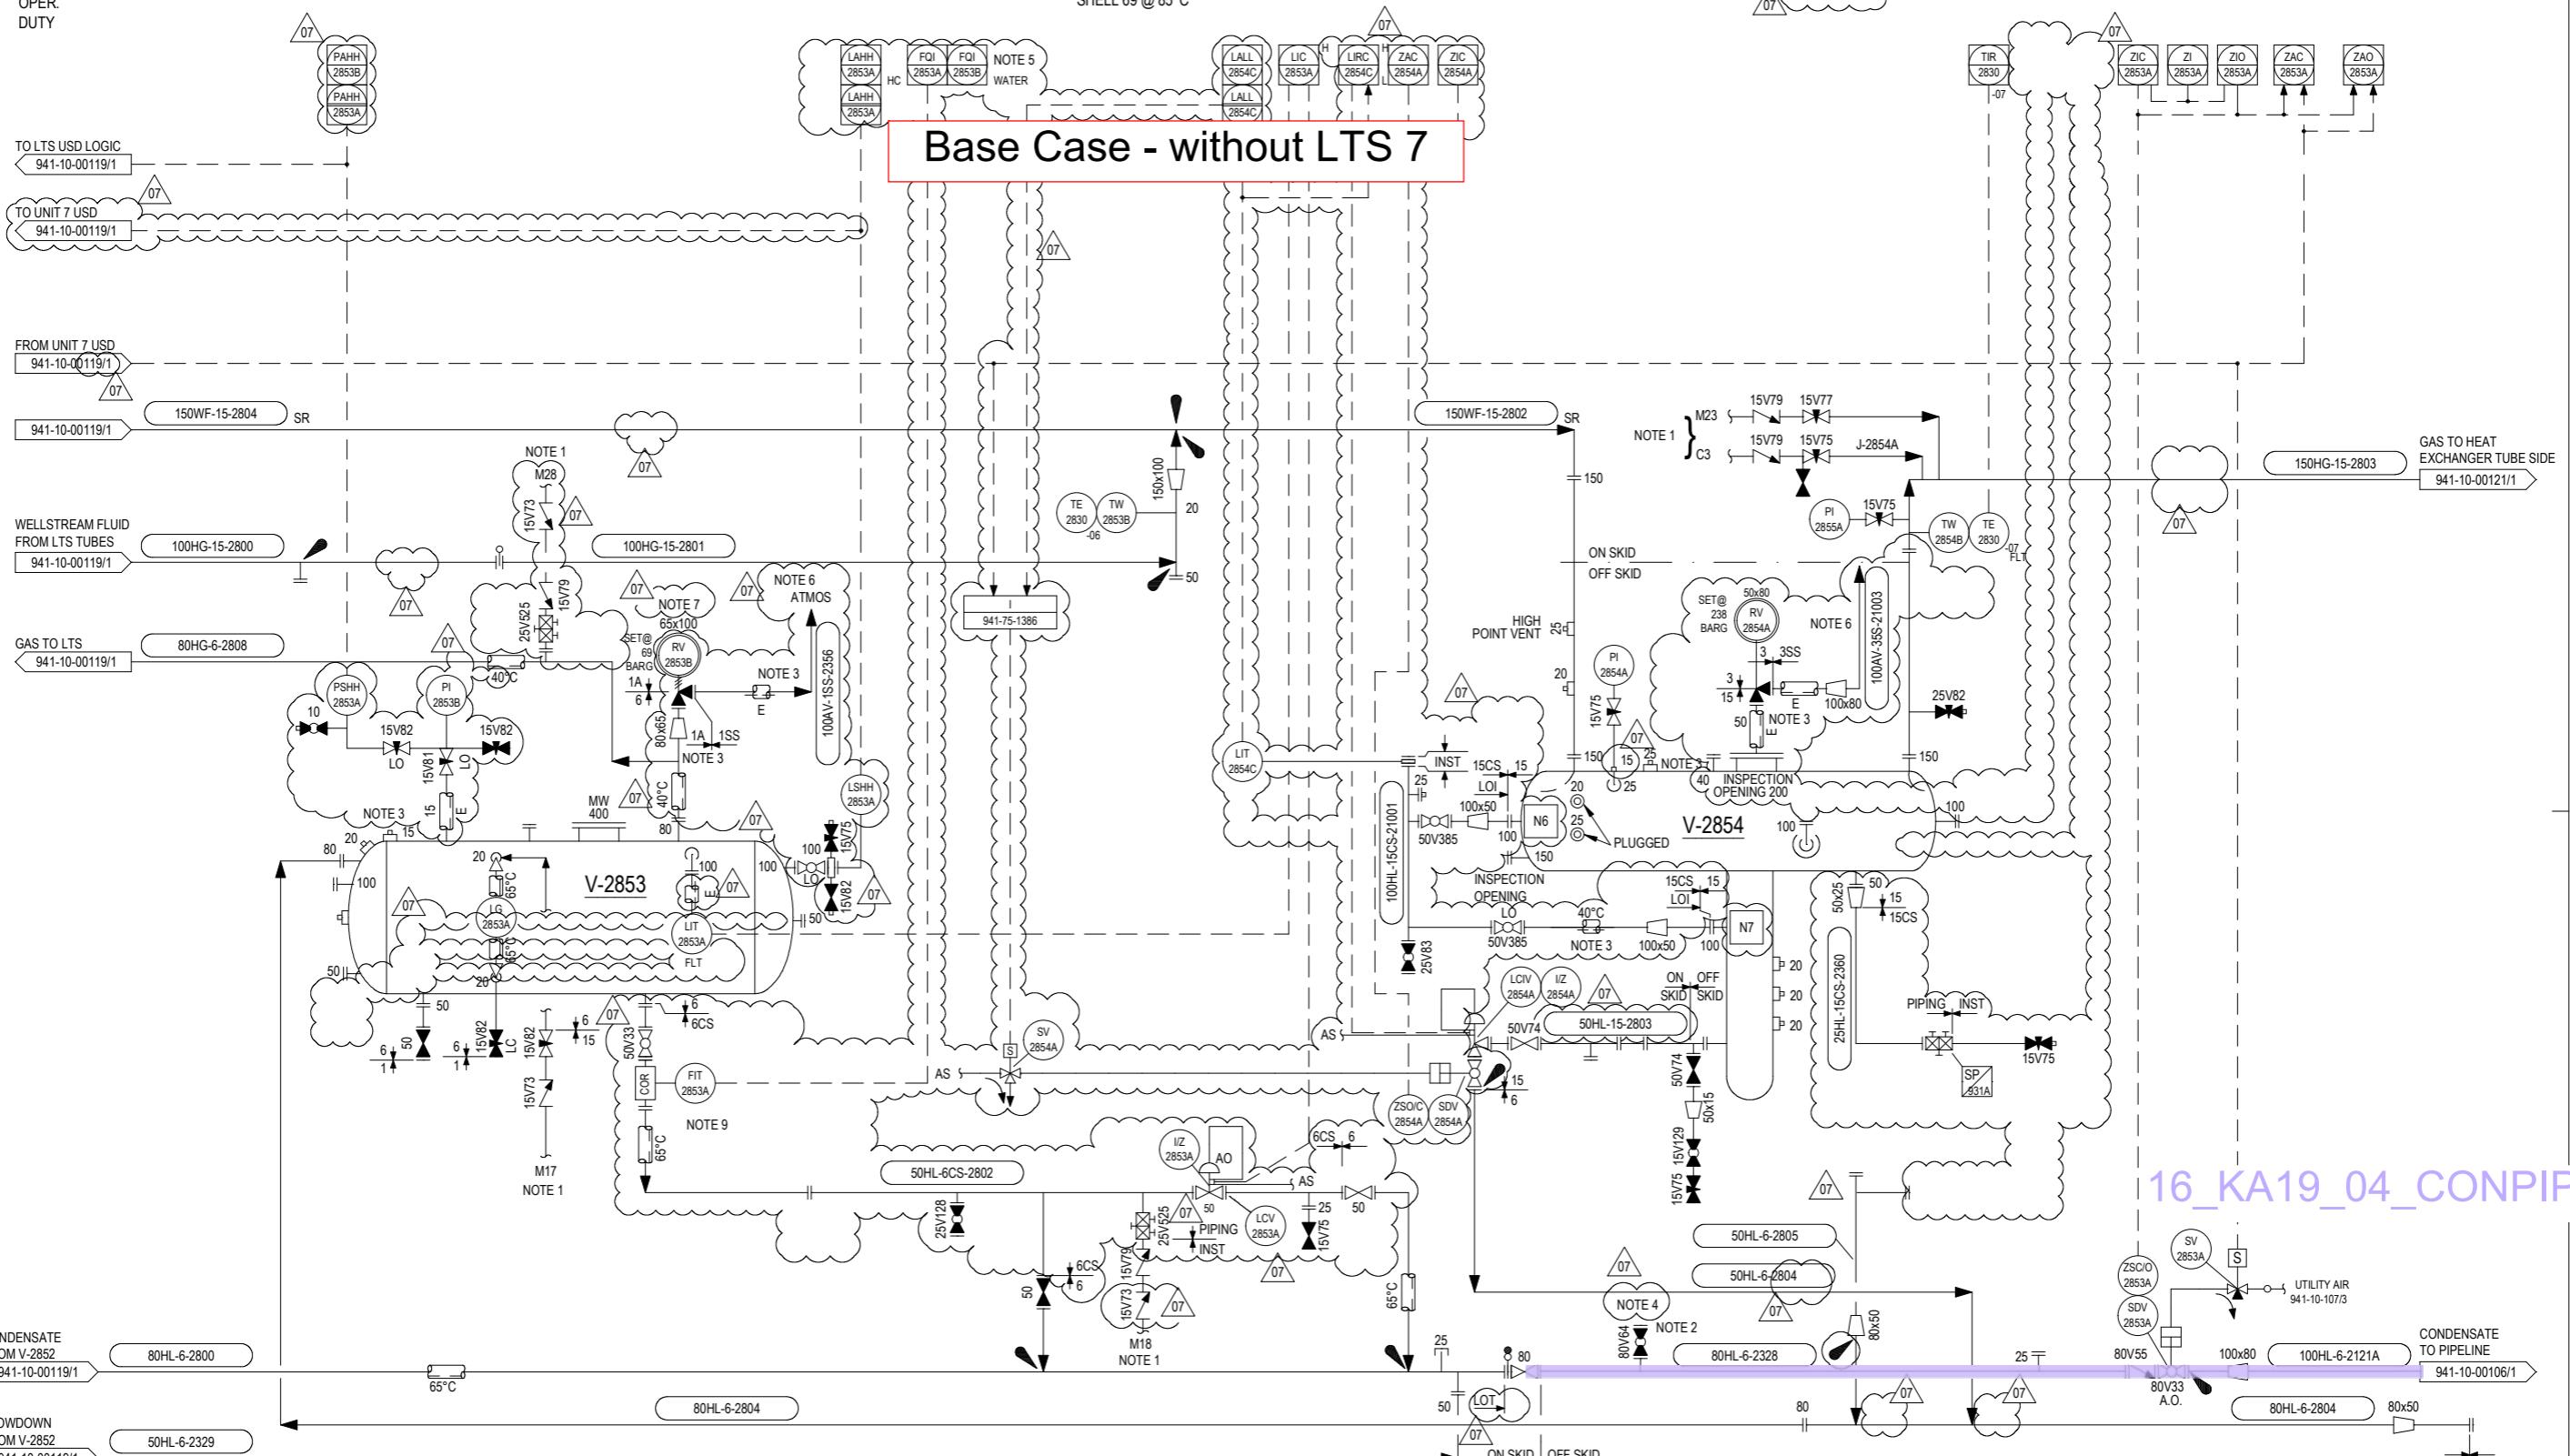

KAPUNI WELLSITES												PIPING & INSTRUMENT DIAGRAM								
UNIT 7 HPKO & CLASSIFIER												KAPUNI WELLSITE No 1 & 7								
												W0100299 SHEET No 2 of 2 REVISION 07								
NO	DATE	BY	CHKD APPR.	CHKD APPR.	NO	DATE	BY	EWR	DESCRIPTION	CHKD APPR.	CHKD APPR.	NUMBER	TITLE	STICKFILE						
CONSTRUCTION ISSUE	CONSULTANT	STOS			REVISIONS				CONSULTANT	STOS		REFERENCE DRAWINGS		SHELL TODD OIL SERVICES LIMITED						
C6	01/14	JMP	ECP	K1334 APPROVED FOR CONSTRUCTION	JR	AB	ATH	-	07	04/14	DG	ECP	ECP K1334 AS BUILT TO SITE MARK UP ASB 14036KW	JMP	AB	ATH	-	-	DESIGNED	DATE
C7	09/13	MH	ECP	K1334 RE ISSUED APPROVED FOR CONSTRUCTION	R	AB	ATH	-	06	04/13	JC	ECP	ECP K1344 AS BUILT TO SITE MARK UP ASB 13063KW	JMP	AC	ATH	-	-	DRAWN	R SHEARSTON 08/82
C8	09/12	SG	ECP	K1334 RE ISSUED APPROVED FOR CONSTRUCTION	R	MK	ATH	-	05	09/11	SG	ECP	ECP K1392 AS BUILT TO SITE MARK UP ASB 11199KW	VB	JS	-	AJ	-	CHECKED	M L SHWER 23.10.82
C9	09/11	MF	ECP	K1334 RE ISSUED APPROVED FOR CONSTRUCTION	MF	PB	ATH	-	04	01/11	KP	ECP	ECP K1379 AS BUILT TO SITE MARK UP ASB 10250KW	VB	LM	-	AJ	-	APPROVED	M L SHWER 23.10.82
C10	09/11	LMM	ECP	K1334 RE ISSUED APPROVED FOR CONSTRUCTION	K	K	AI	-	03	10/10	MH	ECP	ECP K1400 AS BUILT TO SITE MARK UP ASB 10222KW	VB	AP	-	AJ	-	APPROVED	P BARRON 26.10.82
C11	07/11	BA	ECP	K1334 RE ISSUED FOR HAZOP	MK	K	AI	-	02	05/10	BA	ECP	ECP K1379 AS BUILT TO SITE MARK UP ASB 10094KW	VB	AP	-	AJ	-	SCALE	NONE
C12	09/10	LMM	ECP	K1334 RE ISSUED FOR HAZOP	KG	NS	AI	-	01	12/08	DW	ECP	ECP K1152 AS BUILT TO SITE MARK UP ASB 8198KW	VB	PWM	-	AJ	-	STICKFILE	
G1	07/08	VB	ECP	FIRST ISSUE					00	07/08	VB	ECP	FIRST ISSUE	CSM					W0100299	SHEET No
NO	DATE	BY	CHKD APPR.	CHKD APPR.	NO	DATE	BY	EWR	DESCRIPTION	CHKD APPR.	CHKD APPR.	NUMBER	TITLE	STICKFILE					2 of 2	REVISION
									CONSULTANT	STOS			REFERENCE DRAWINGS						07	

This drawing is confidential and is the property of SHELL TODD OIL SERVICES LTD. It must not be disposed to any third party or lent without written consent from Shell Todd Oil Services Ltd

DRAWING No 941-10-00119

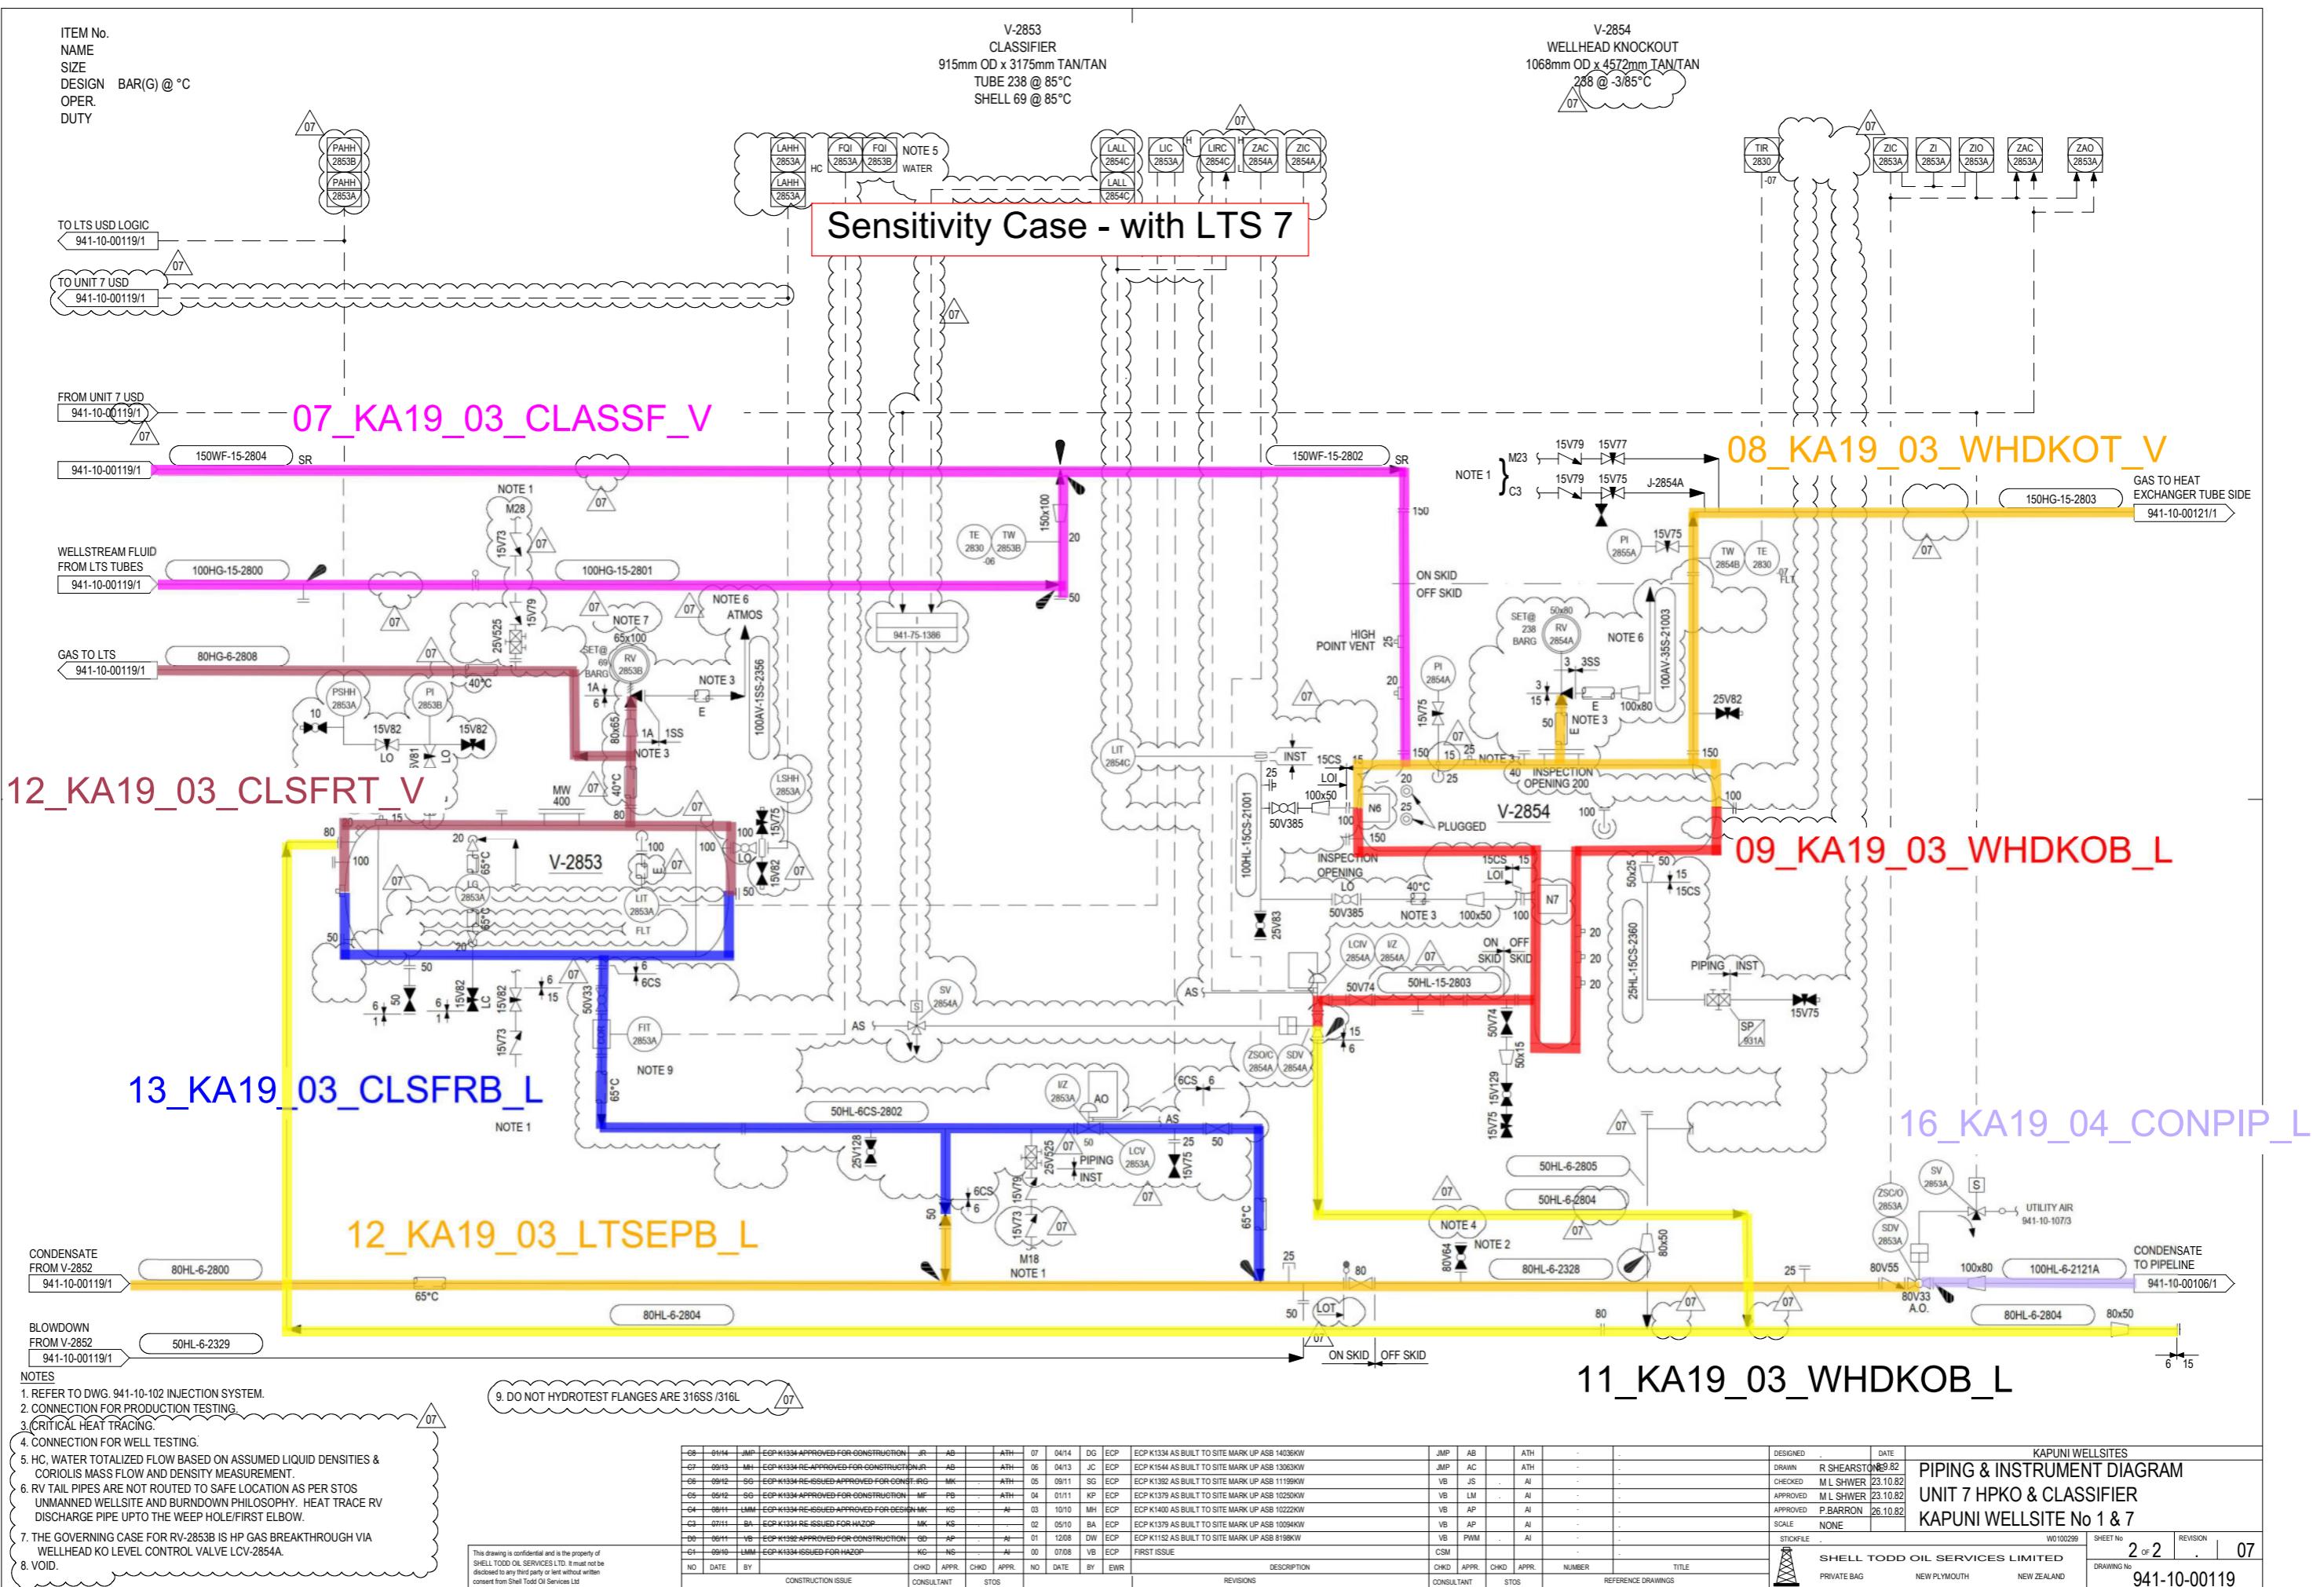

ITEM No.
NAME
SIZE
DESIGN BARG @ °C


FROM TIC-2852C
941-10-00119/1

14_KA19_03_LTSEPT_V

L.T.S. GAS FROM V-2852
941-10-00119/1
TO L.T.S.

941-10-00119/1

E-2855, E-2856, E-2857
GAS/GAS EXCHANGERS
TUBE: 238 @ -3/85°C
SHELL: 69 @ -29/93°C

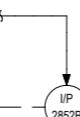


150HG-6-2804

GAS TO PIPELINE
941-10-00121/2

GAS FROM W.H.K.O
941-10-00119/2

08_KA19_03_WHDKOT_V

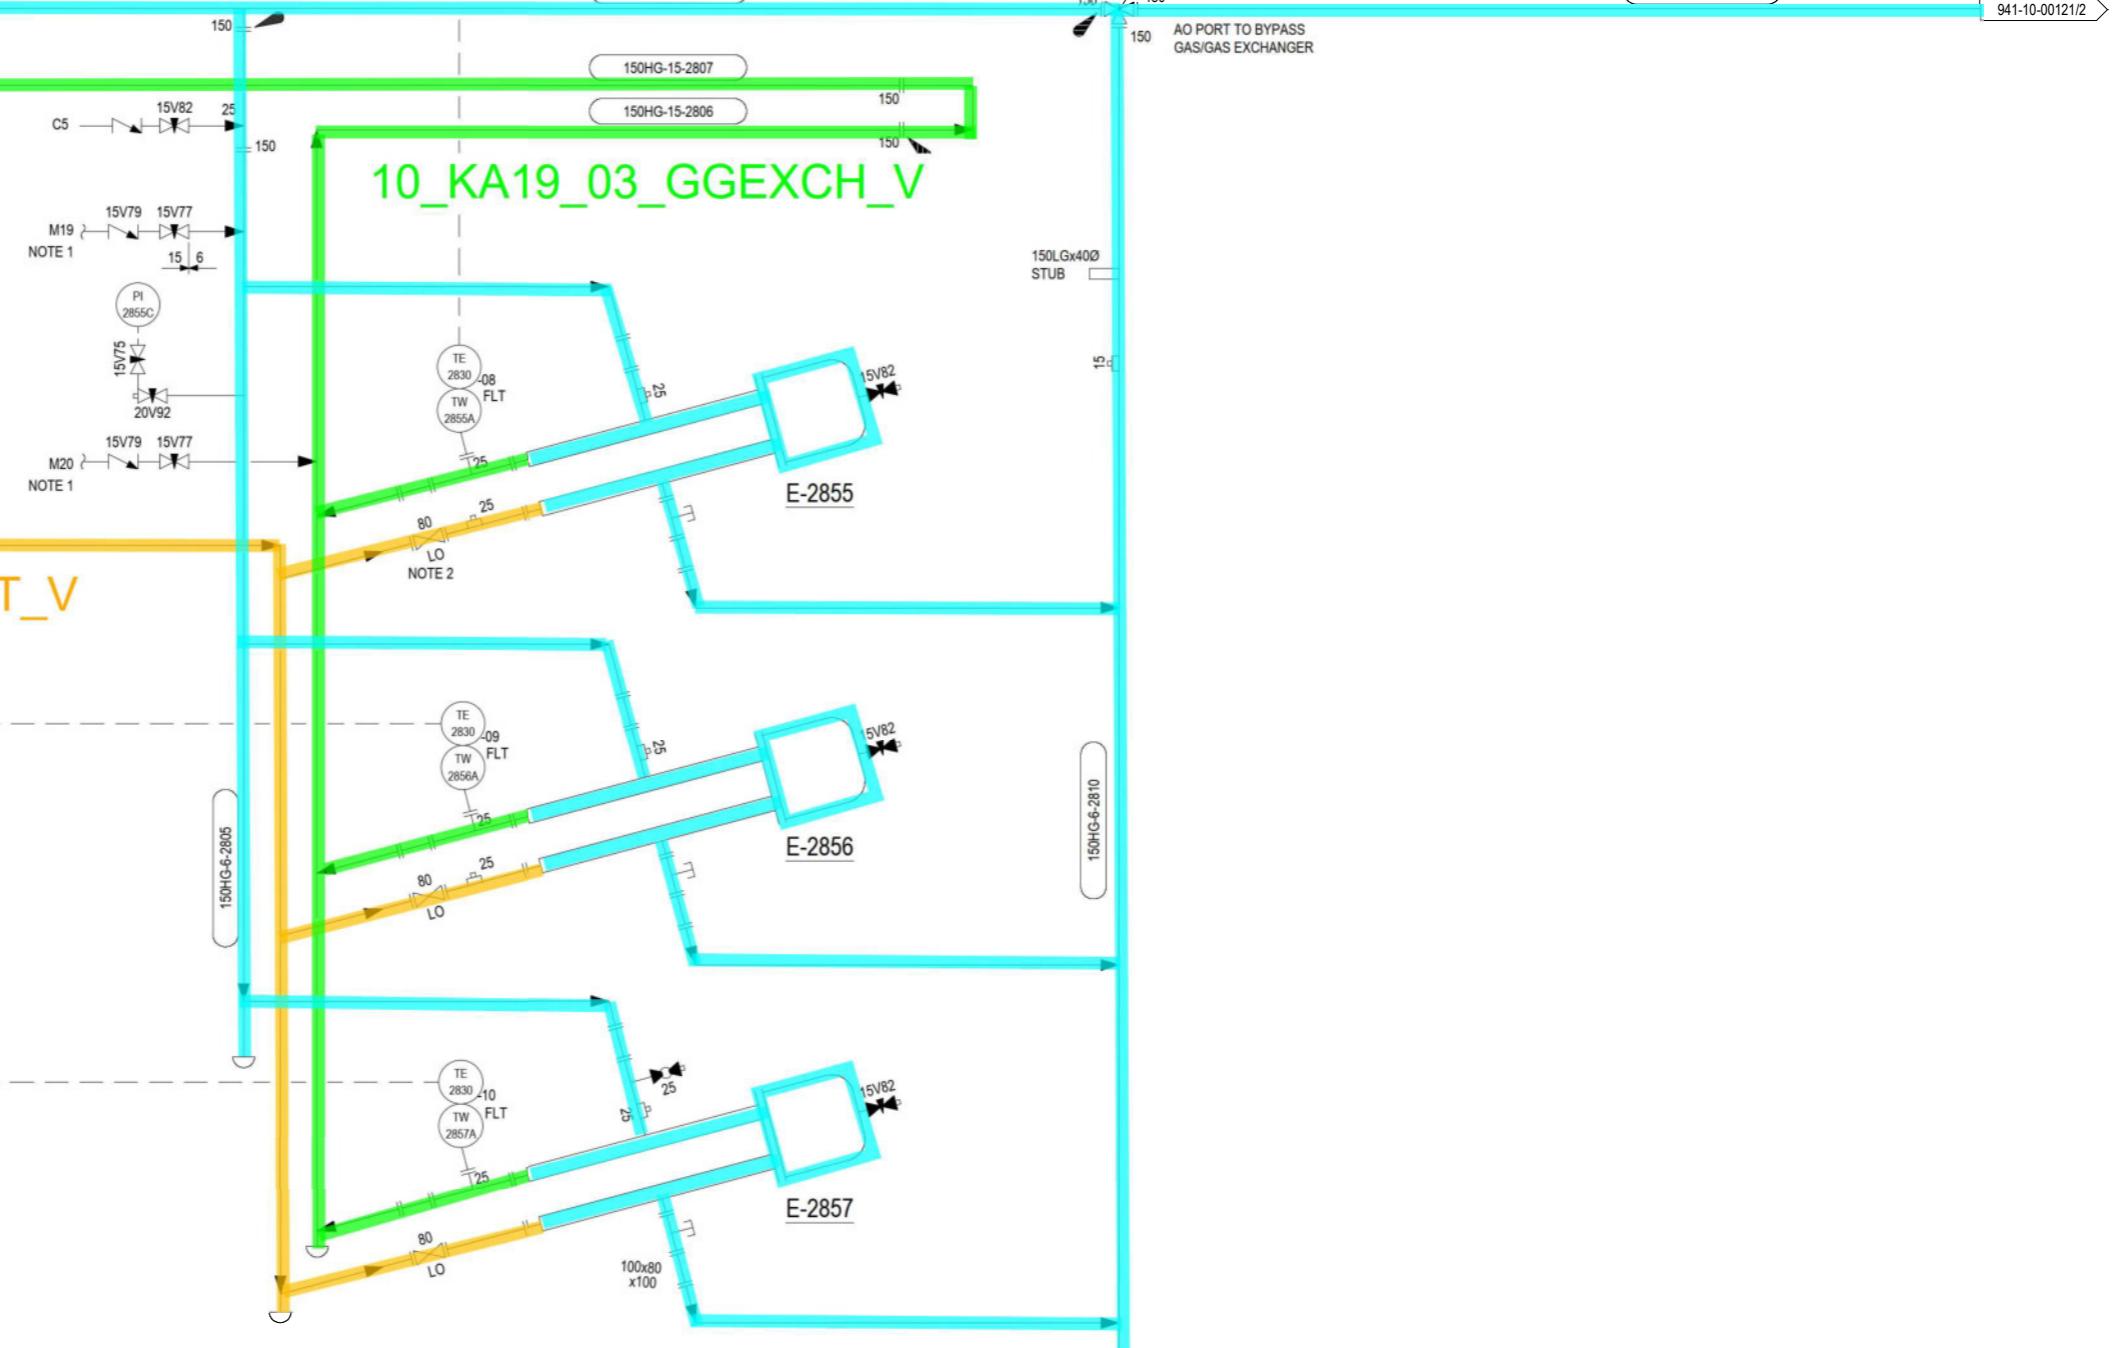

NOTES

1: REFER TO DWG. 941-10-102 FOR INJECTION SYSTEM.

2: AS BUILT MODIFICATION.


This drawing is confidential and is the property of TODD ENERGY. It must not be disclosed to any third party or lent without written consent from TODD ENERGY.


NO	DATE	BY	CONSTRUCTION ISSUE	CONSULTANT	TODD	CHKD APPR.	CHKD APPR.	NO	DATE	BY	ECP	DESCRIPTION	CHKD APPR.	CHKD APPR.	NUMBER	TITLE	DESIGNED	DATE	KAPUNI WELLSITES		
												REVISIONS	CONSULTANT	TODD	REFERENCE DRAWINGS	STICKFILE	W010300	SHEET No	REVISION	1 OF 1	05
C3	07/11	LMM	ECP K1334 RE-ISSUED FOR HAZOP	MK	K5	-	-												DRAWN	B MORE	10.9.82
C4	11/10	BA	ECP K1334 APPROVED FOR DESIGN	K5	N5	-	-												CHECKED	M L SHWER	23.10.82
C5	09/10	LMM	ECP K1334 ISSUED FOR HAZOP	K5	N5	-	-	05	11/19	CL	ECP	ECP XK1802 AS BUILT TO SITE MARK UP ASB T19010KW	JMP	SG	-	MW					
C6	09/10	SG	ECP K1334 APPROVED FOR CONSTRUCTION	MF	PB	-	-	04	09/18	GRP	ECP	AS BUILT TO SITE MARK UP H0678 (1924)	MAW	KK	-	KB					
C7	09/12	LMM	ECP K1334 RE-ISSUED APP FOR CONSTRUCTION	MK	-	ATH	03	04/14	DG	ECP	ECP K1334 AS BUILT TO SITE MARK UP ASB 14036KW	JMP	AB	ATH	-						
C8	09/12	SG	ECP K1334 APPROVED FOR CONSTRUCTION	MF	PB	ATH	02	01/11	KP	ECP	ECP K1379 AS BUILT TO SITE MARK UP ASB 10250KW	VB	LM	-	AI						
C9	09/11	SG	ECP K1334 RE-ISSUED APPROVED FOR DESIGN	MK	K5	-	-	01	12/08	DW	ECP	ECP K1152 AS BUILT TO SITE MARK UP ASB 8198KW	VB	PWM	-	AI					
C10	09/11	LMM	ECP K1334 RE-ISSUED FOR HAZOP	MK	K5	-	-	A0	08/07	VB	FIRST ISSUE							SCALE	-		
																		STICKFILE	-		
																		W010300	SHEET No		
																			1 OF 1	REVISION	05


Todd Energy


PIPING & INSTRUMENT DIAGRAM
UNIT 7 GAS/GAS EXCHANGERS
KAPUNI WELLSITE KA-1 & 7


W010300 SHEET No 1 OF 1 REVISION 05
DRAWING No 941-10-00121

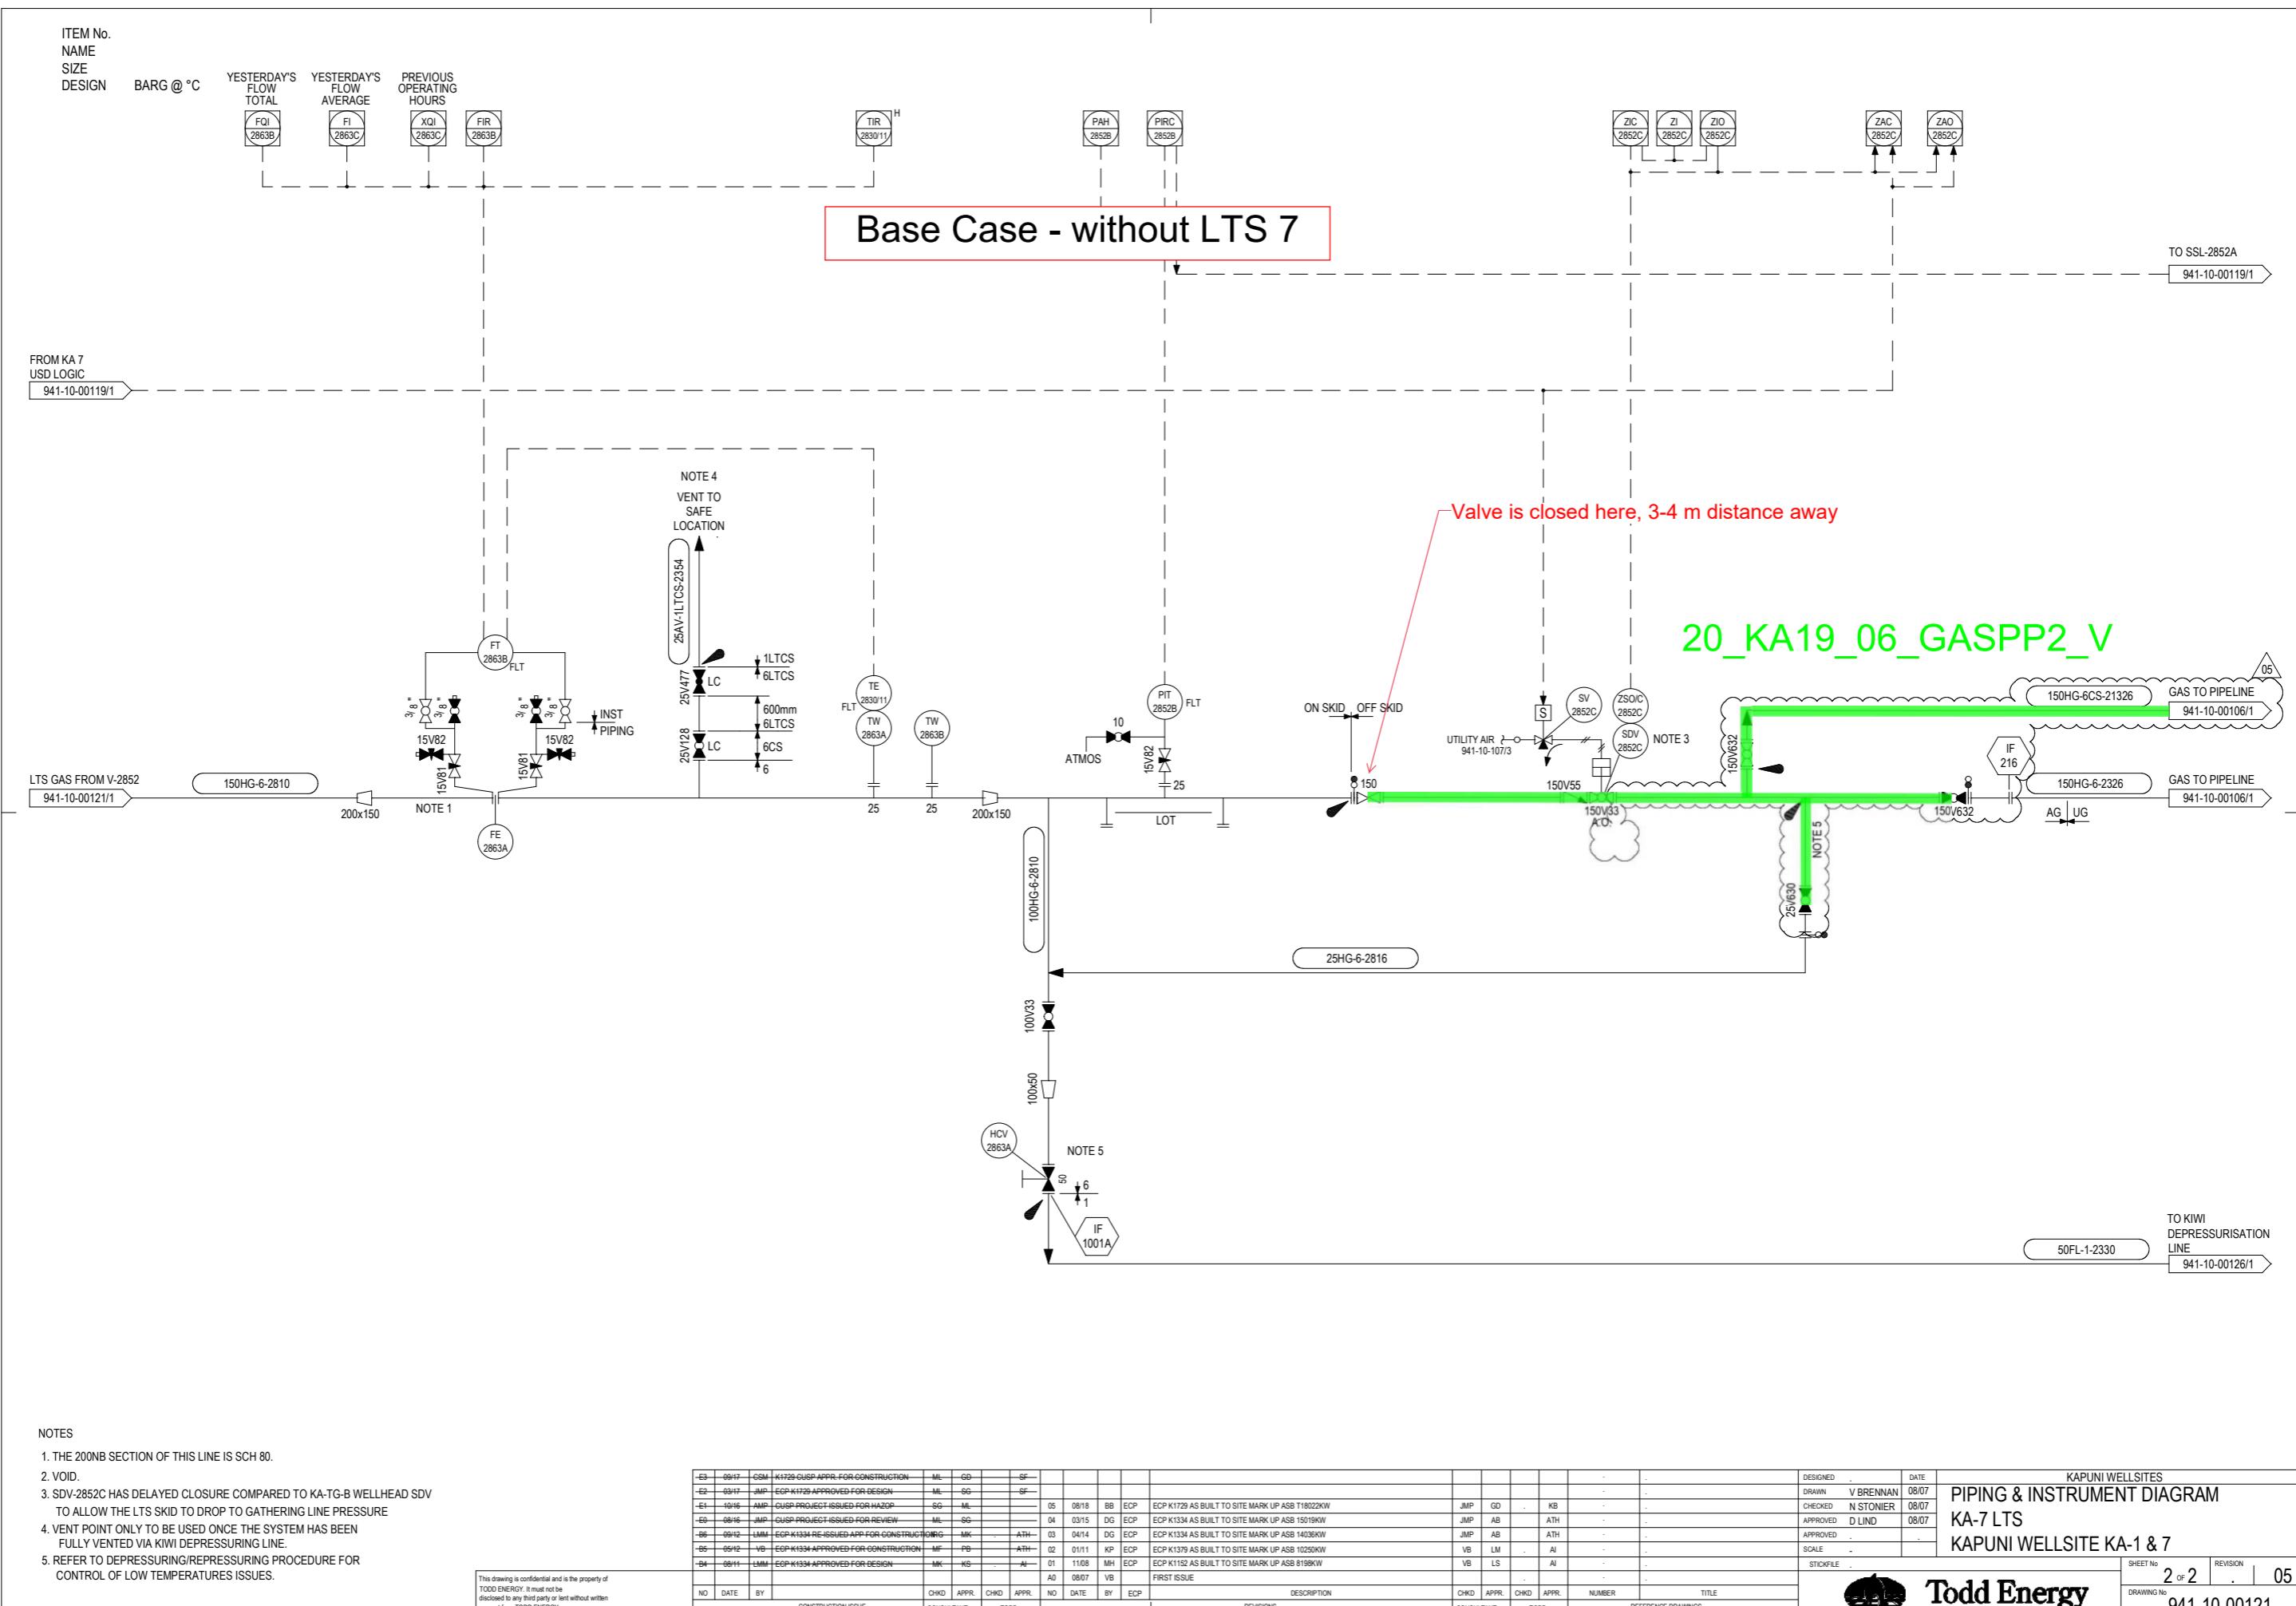


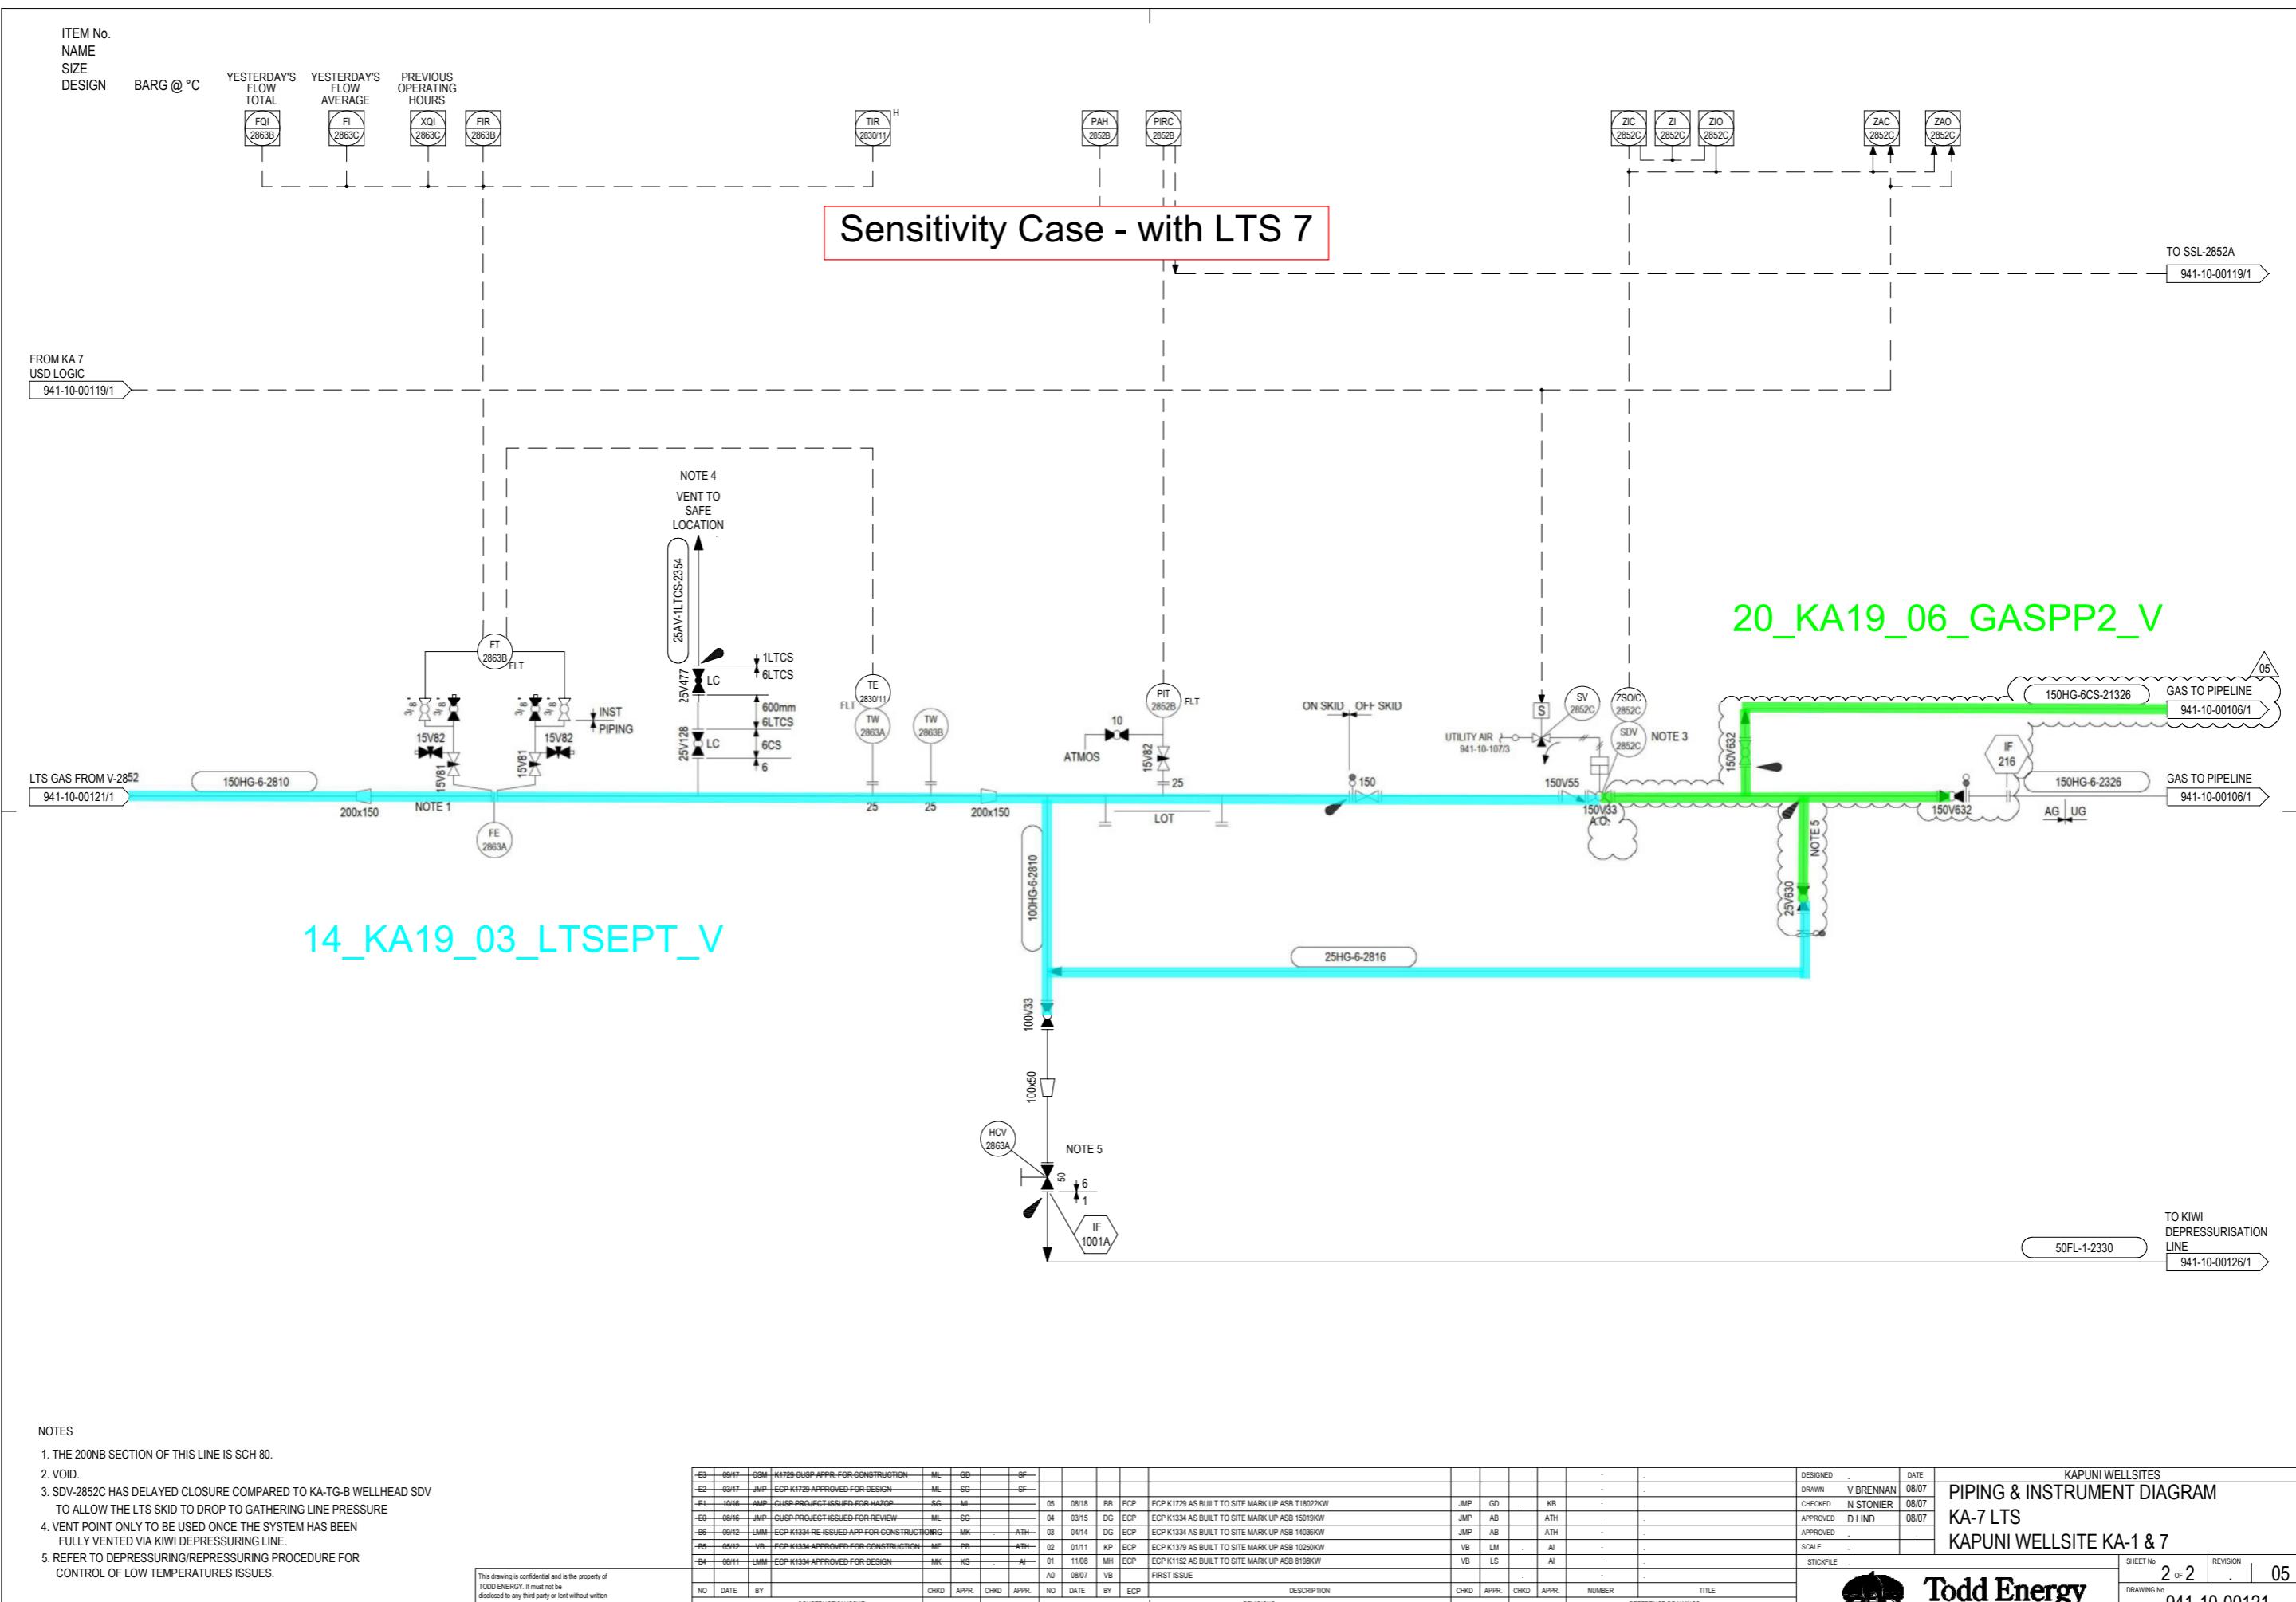


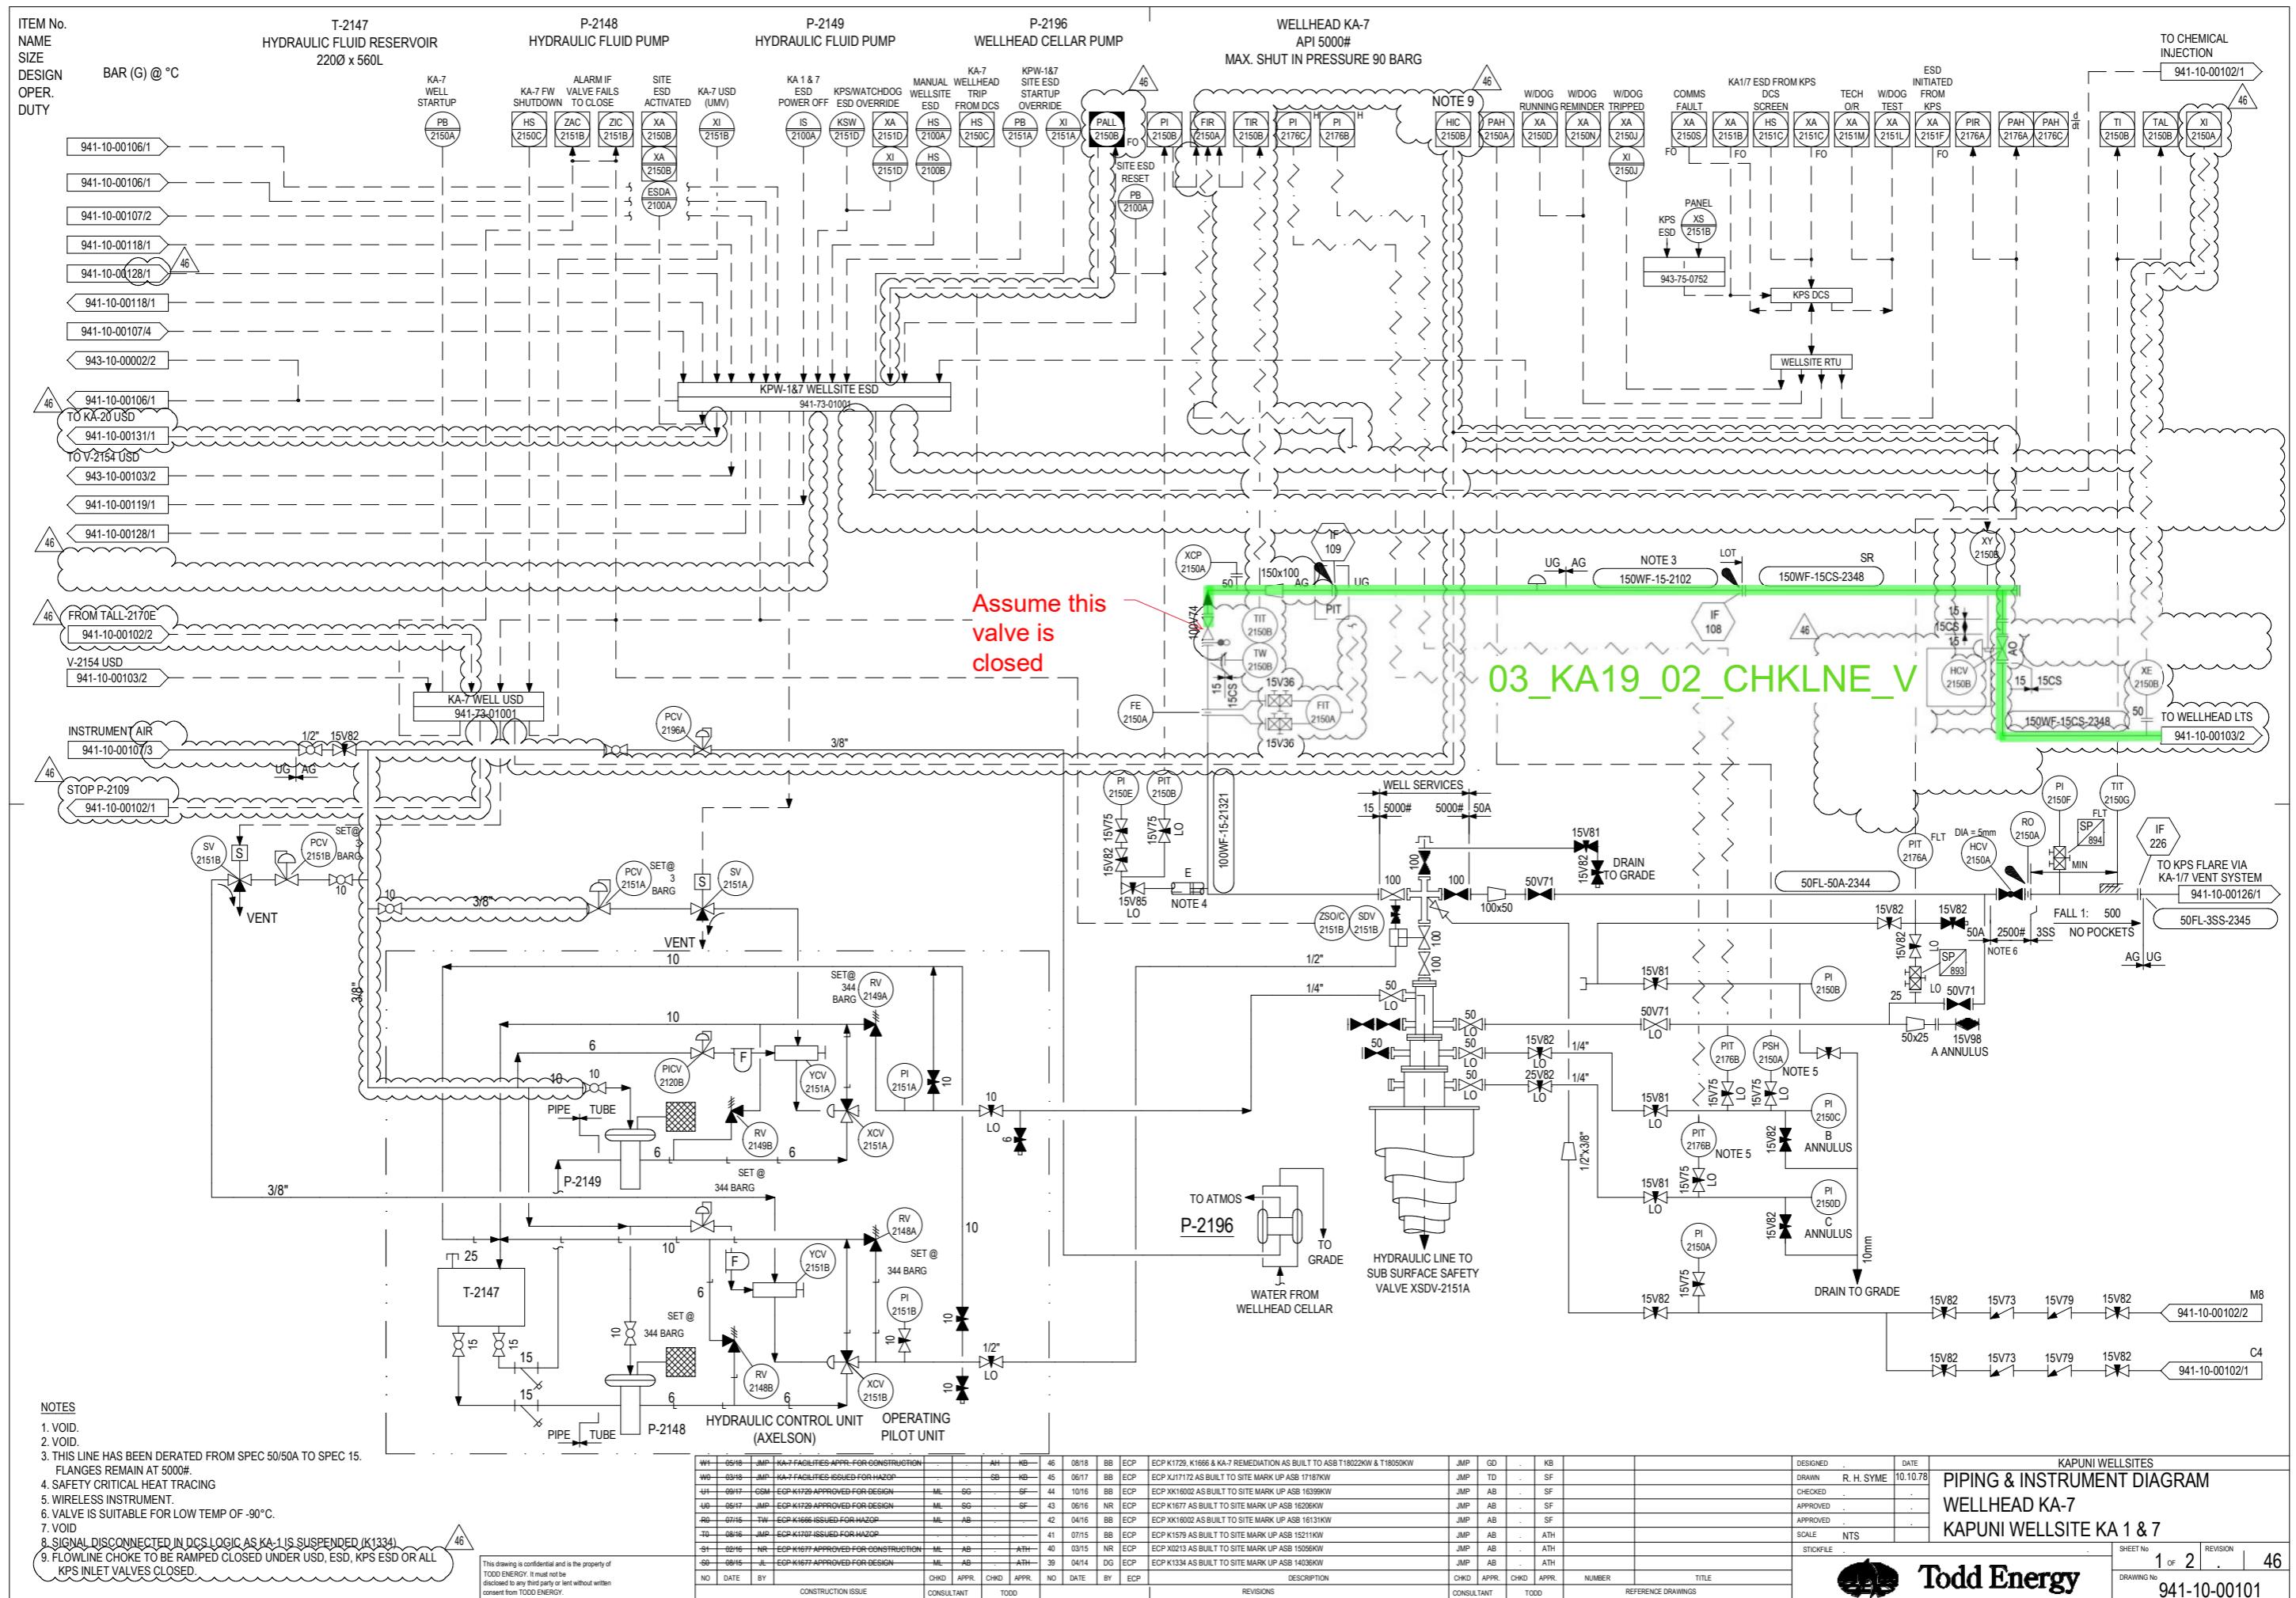

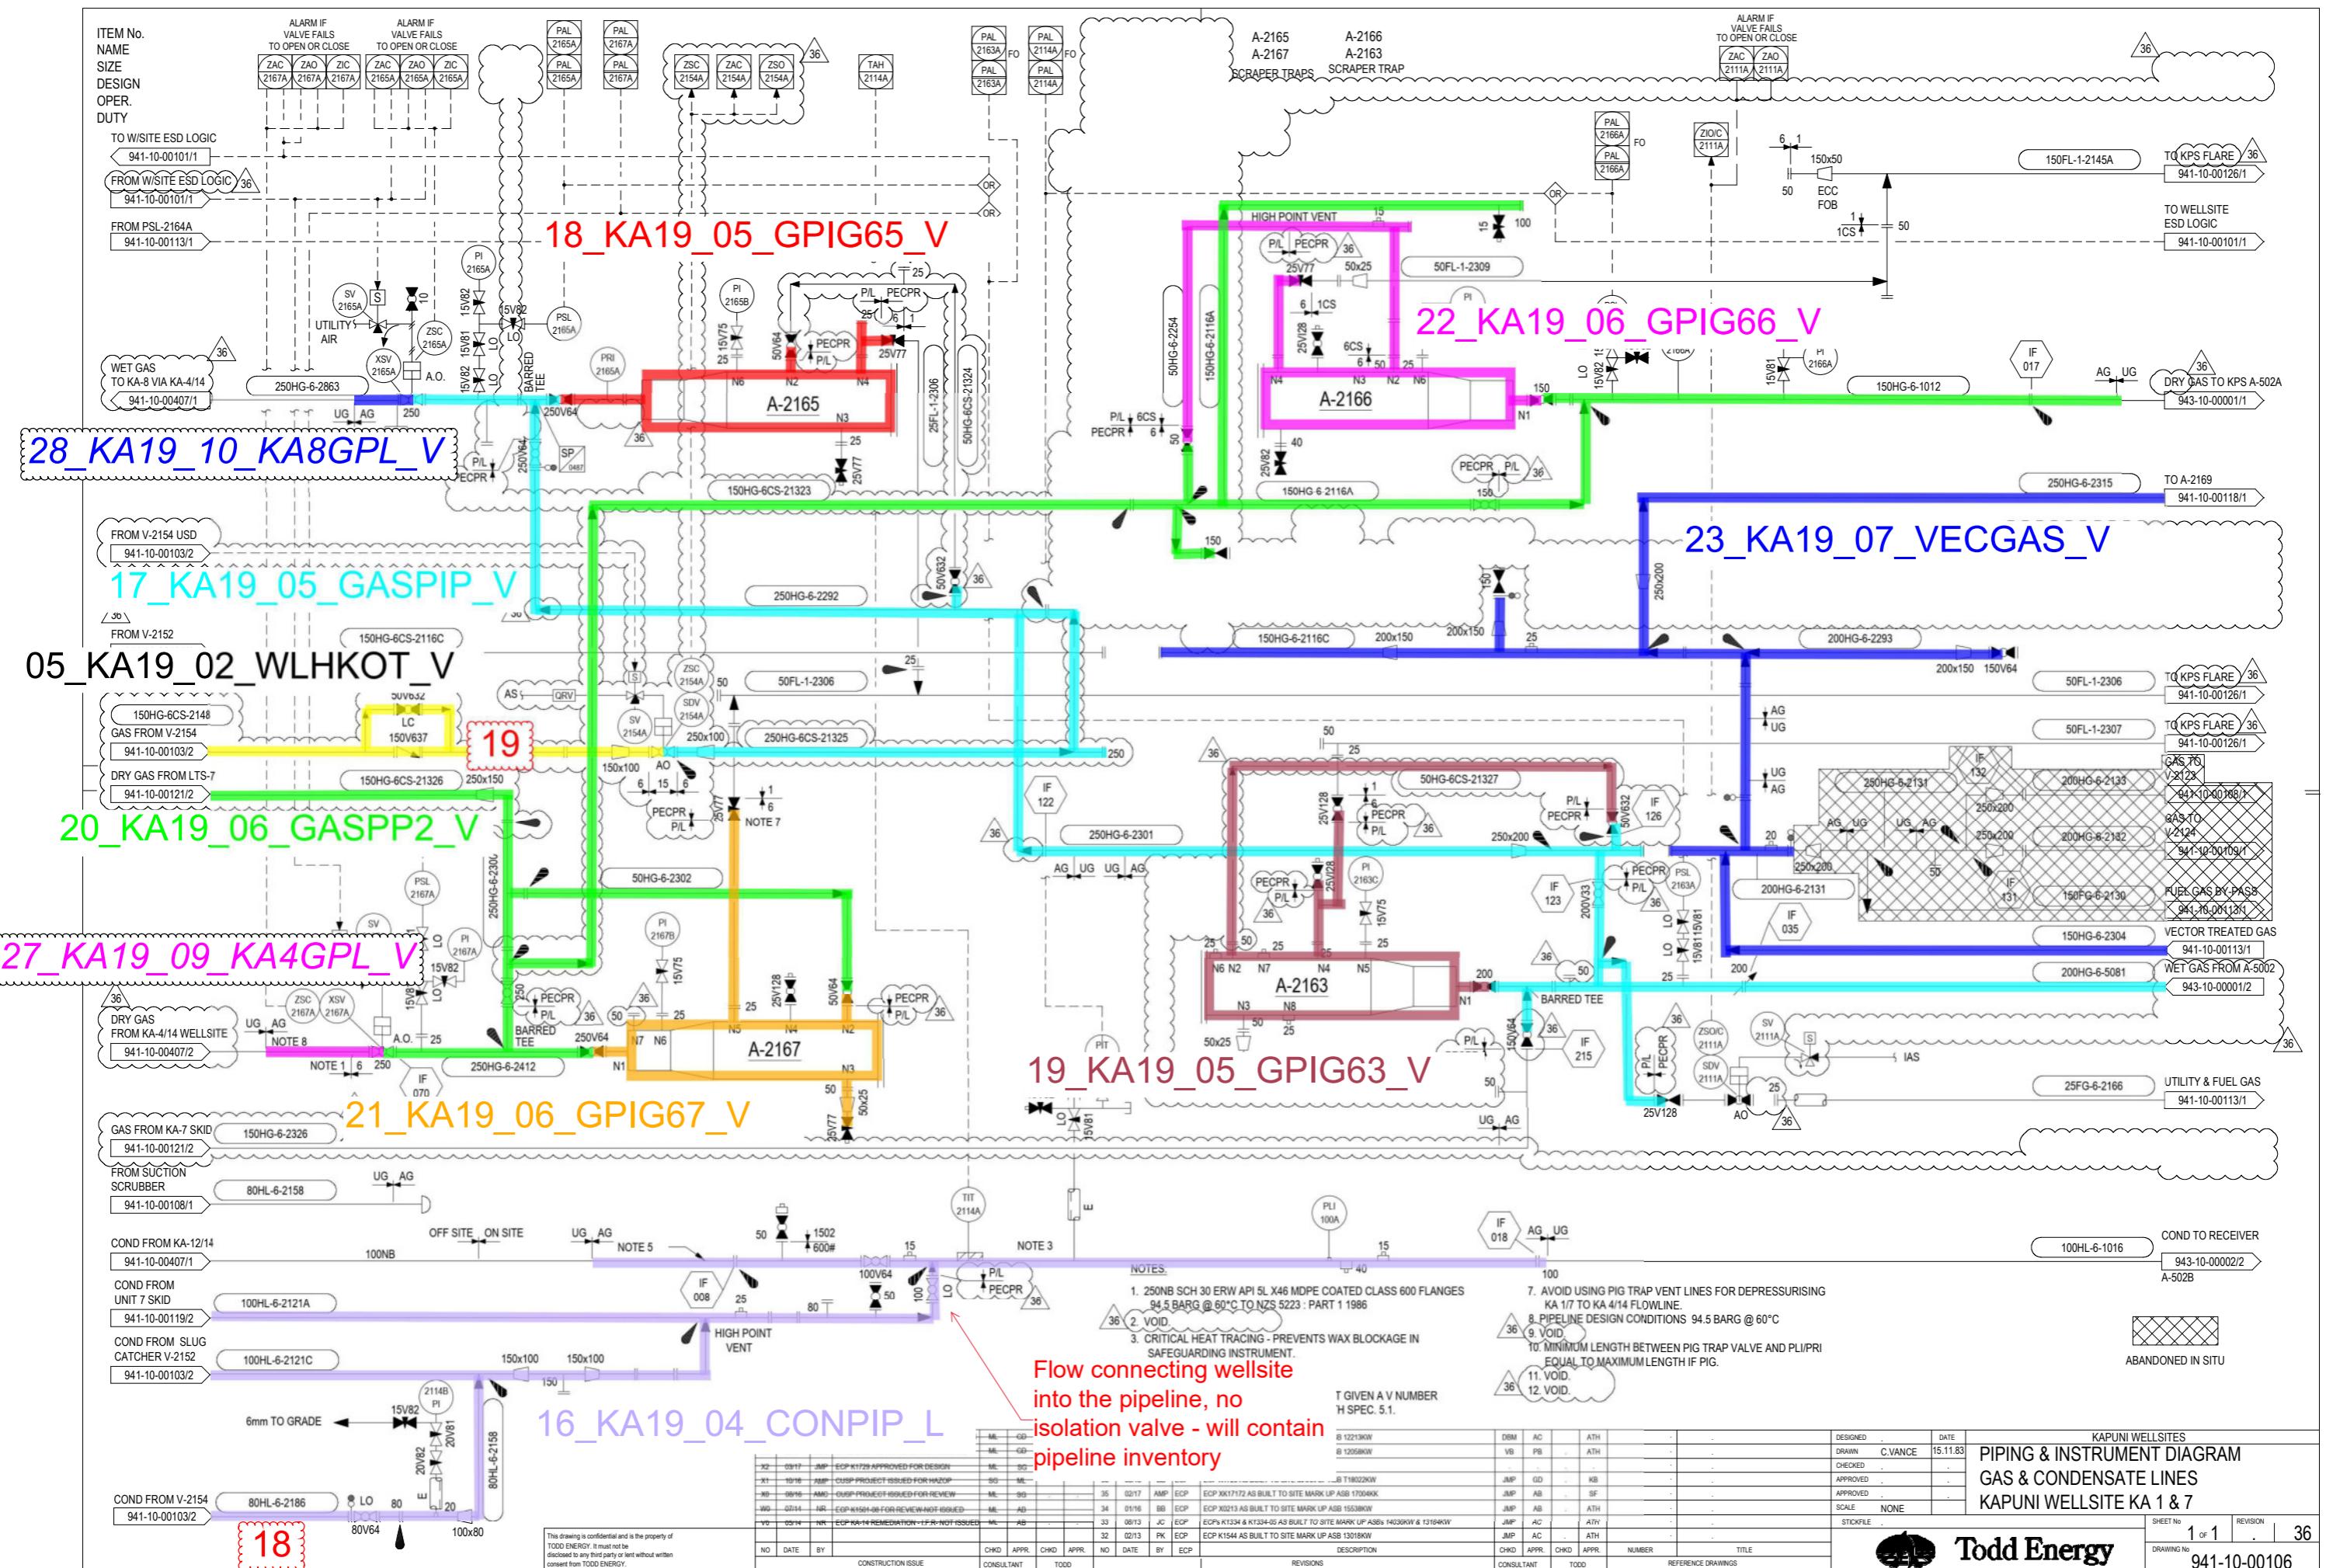

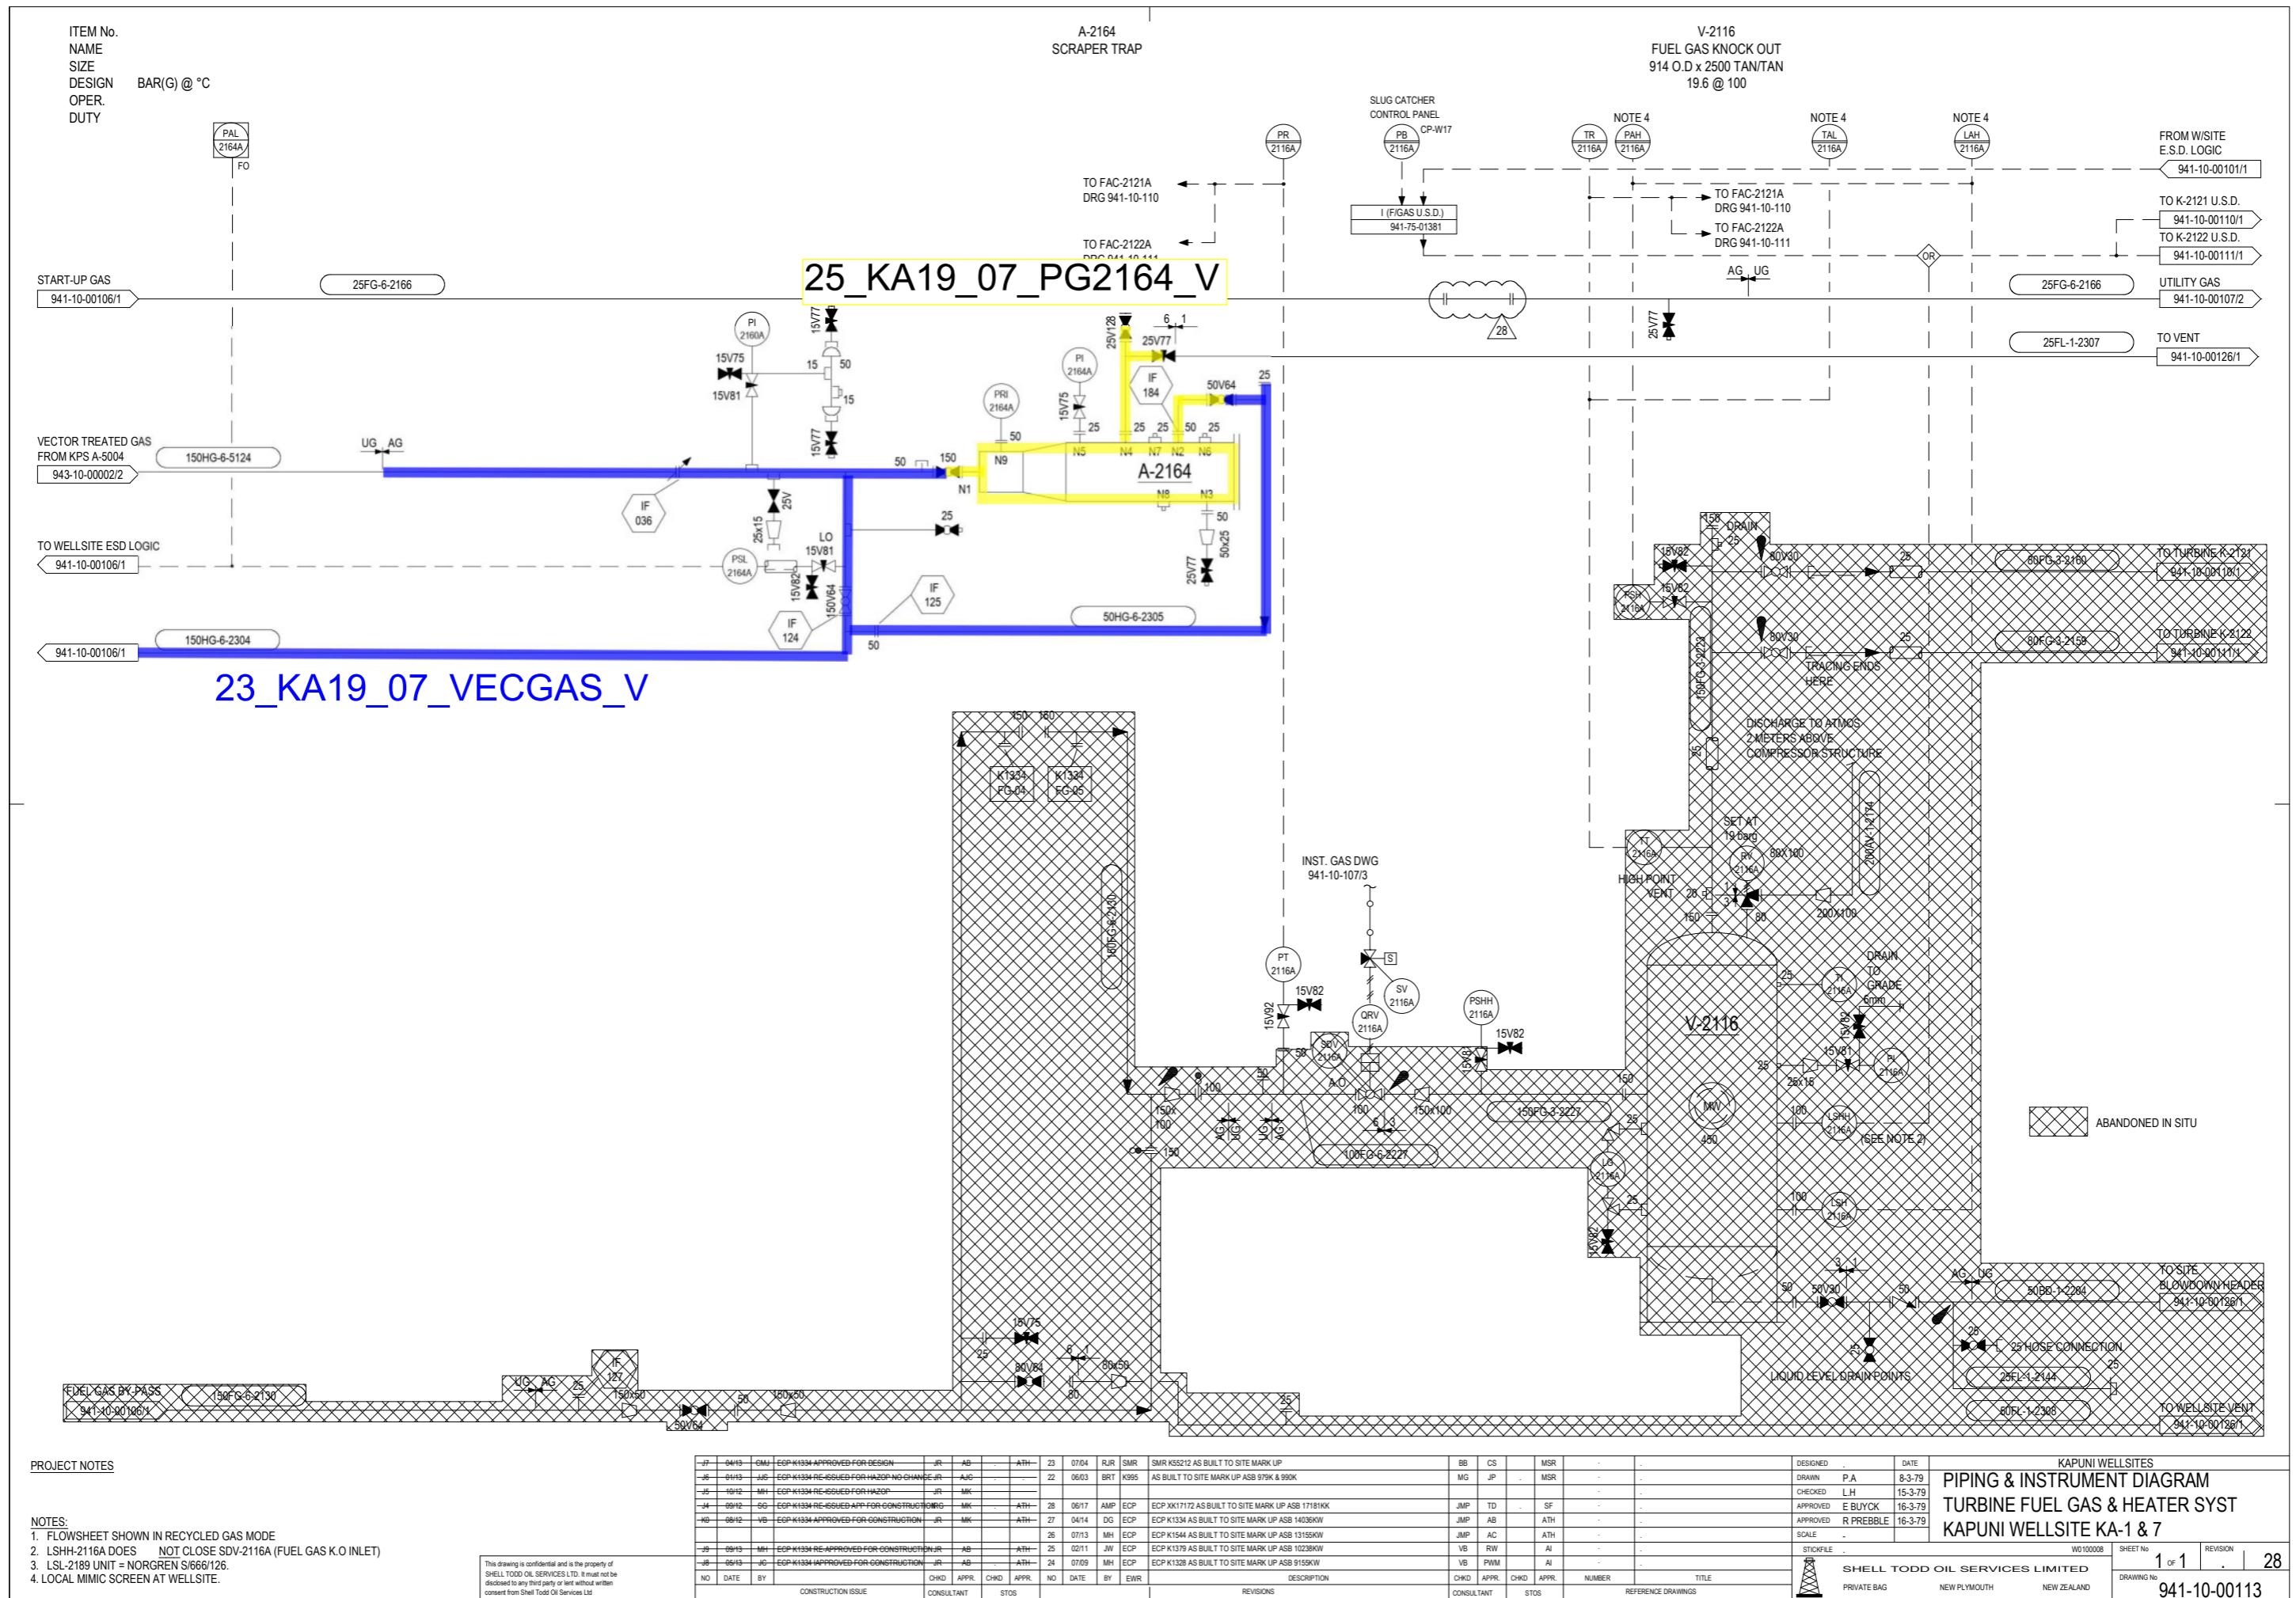

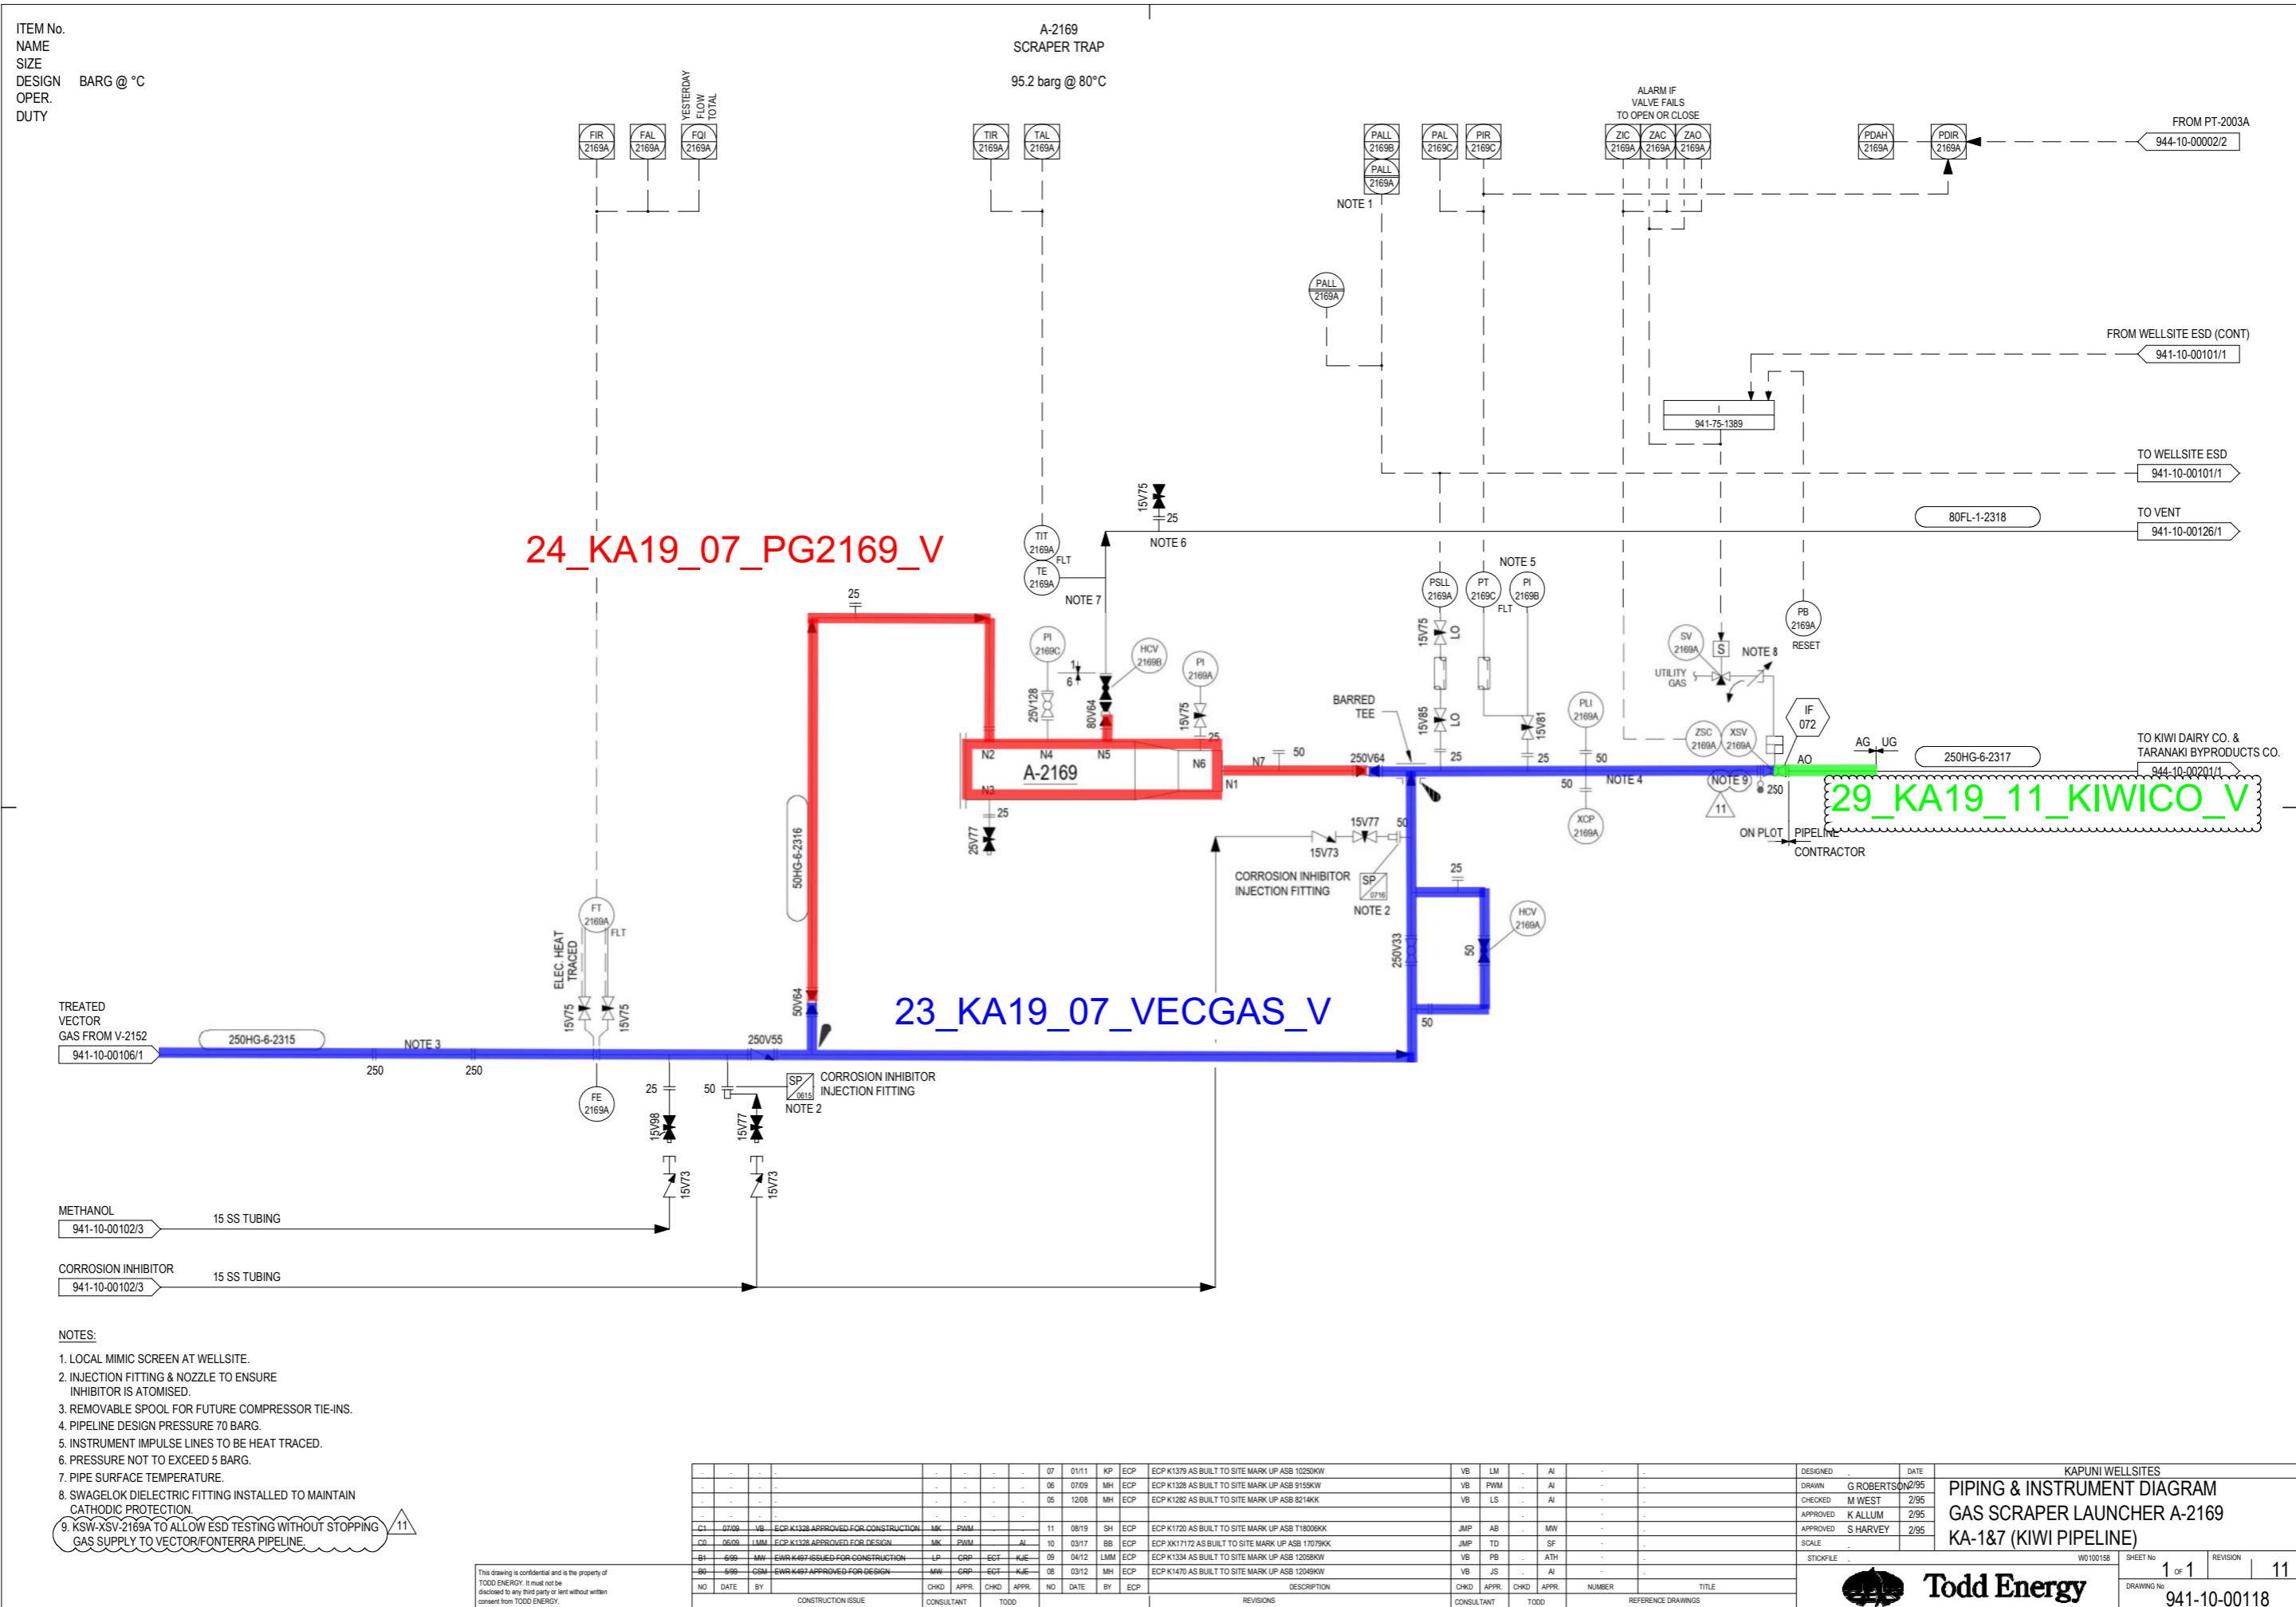

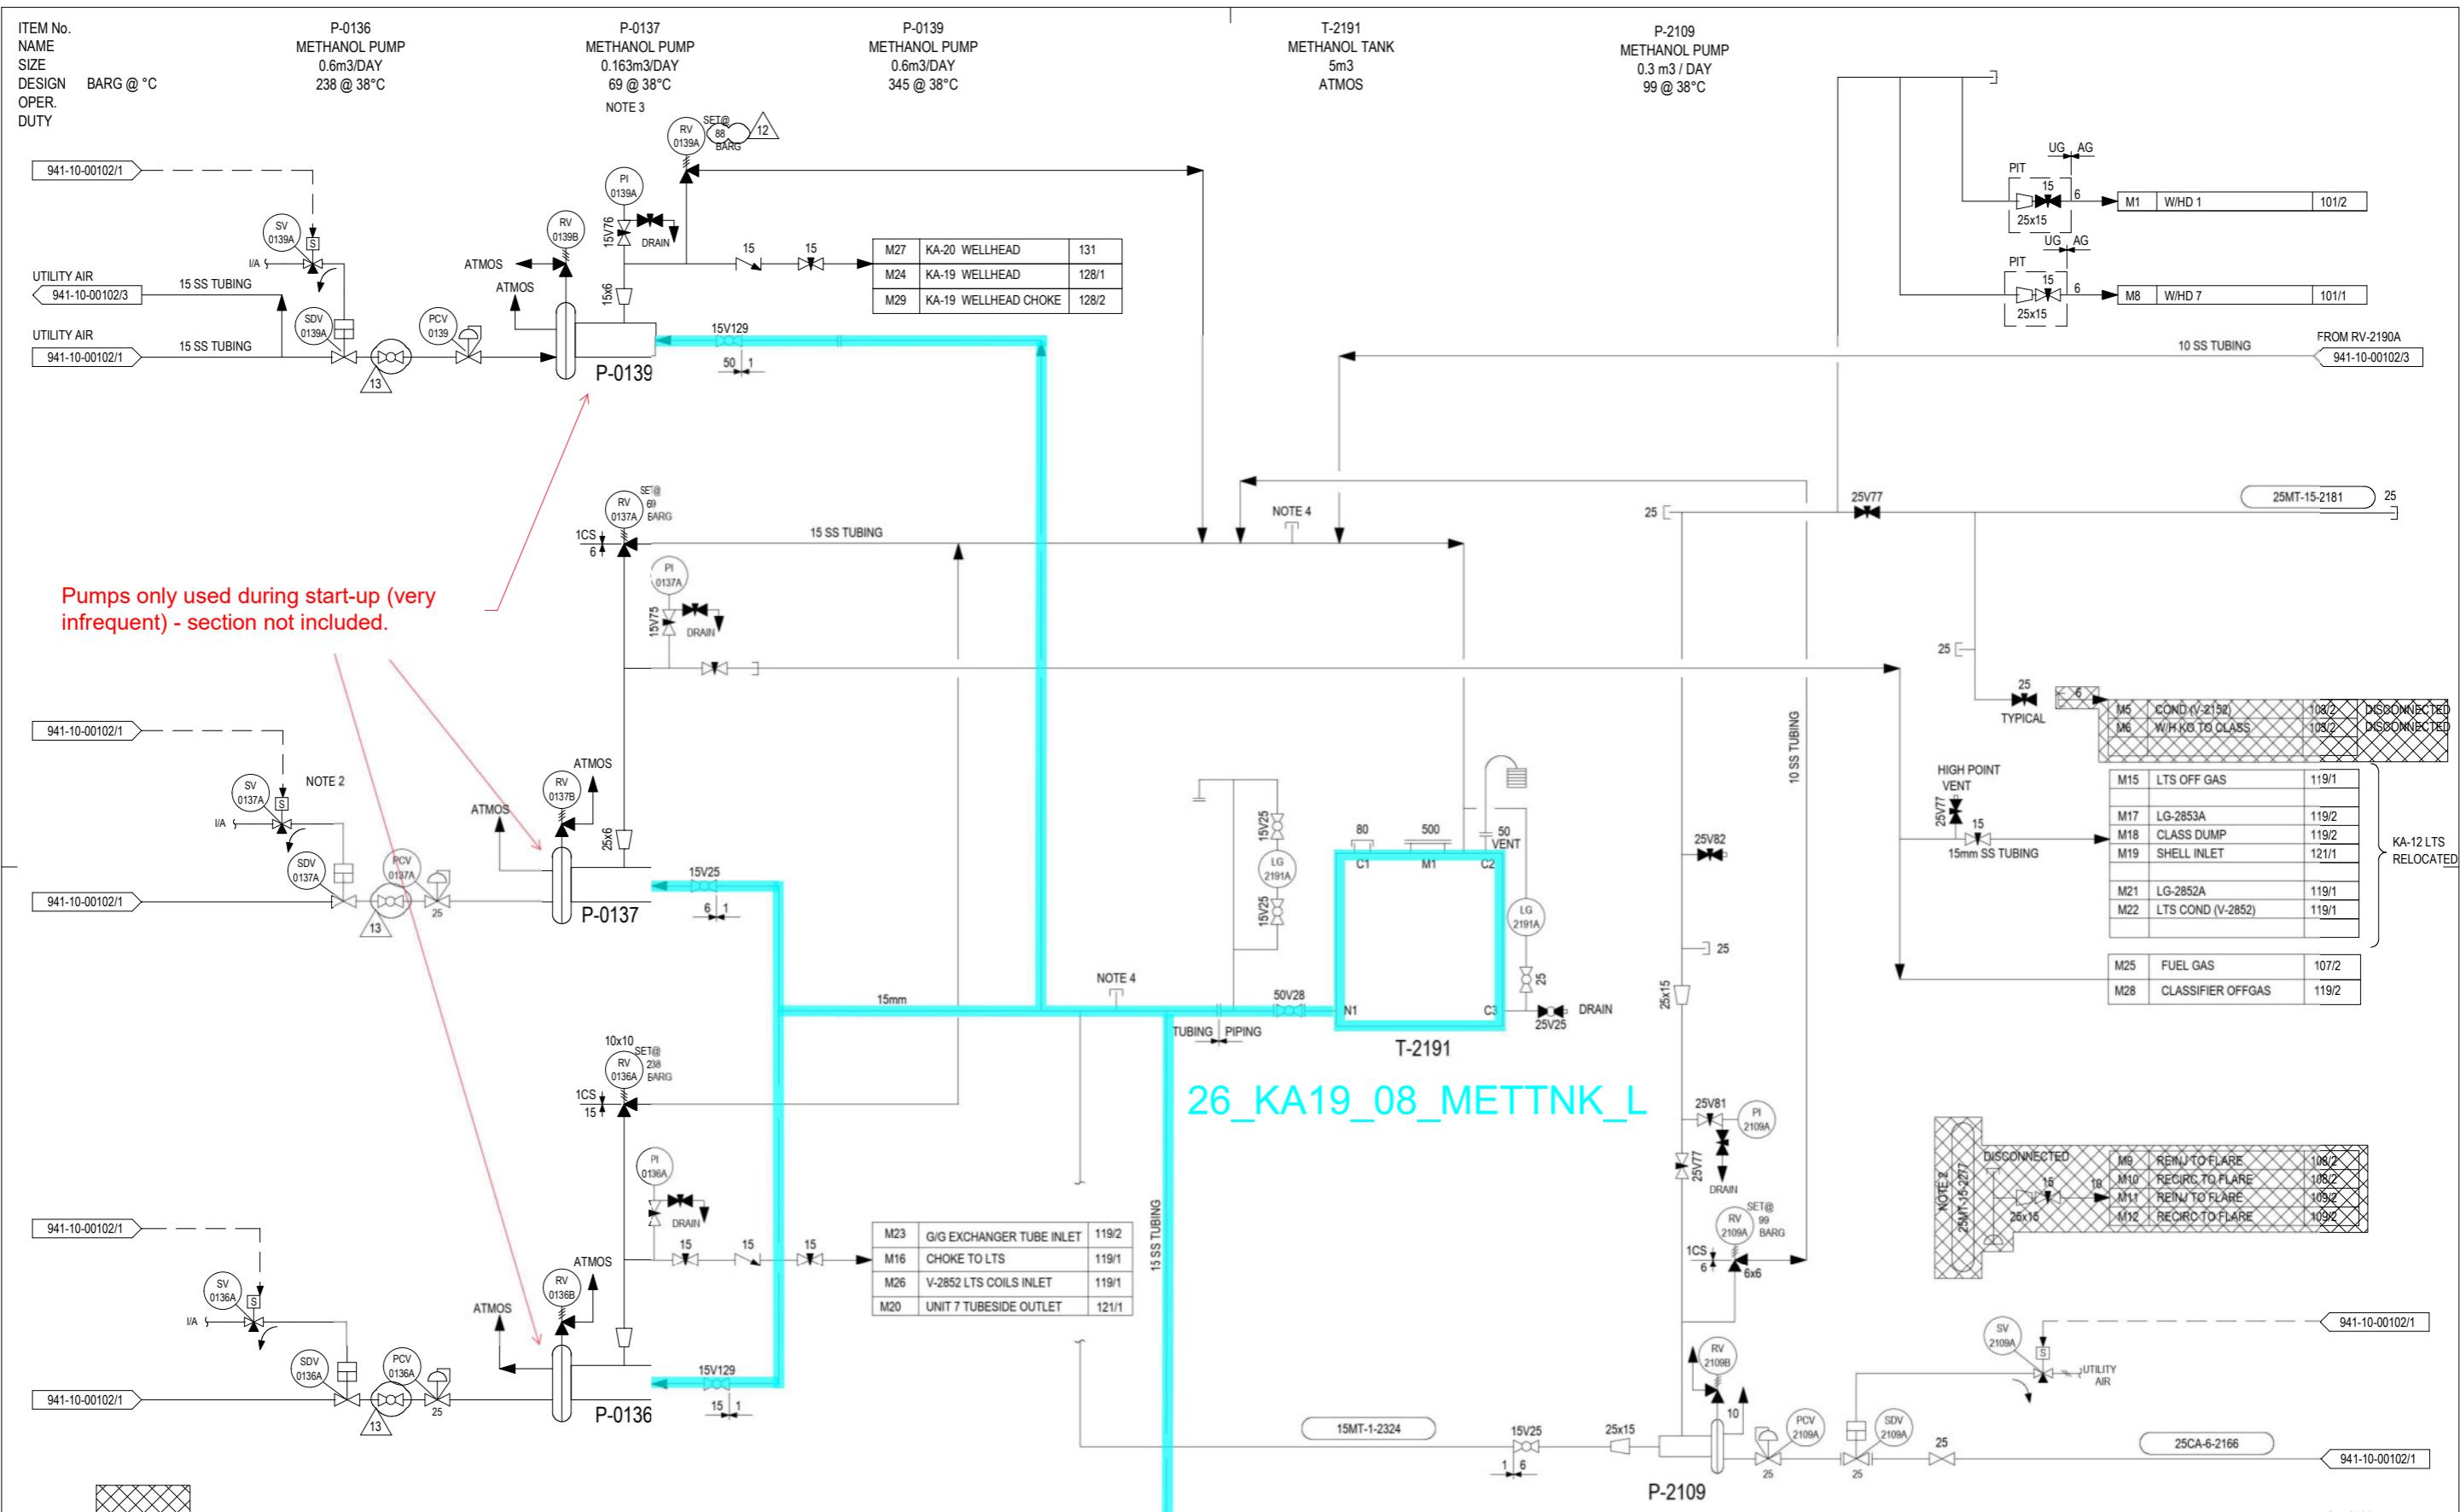

NOTES:


1. ALL TUBING IS IMPERIAL STANDARD.
2. FUEL GAS USD WILL REQUIRE TO BE RESET TO OPERATE METHANOL PUMP P-0137, EVEN IF INJECTING METHANOL TO ANOTHER LOCATION.
3. P-0137 WILL BE LINED OUT TO THE FUEL GAS SYSTEM WHEN THE SITE IS UNMANNED. THE PUMP WILL BE SET TO MINIMUM STROKE (APPROX 0.53 L/H).
4. FUTURE CONNECTION

This drawing is confidential and is the property of Todd Energy. It must not be disclosed to any third party or lent without written consent from Todd Energy.


KAPUNI WELLSITES PIPING & INSTRUMENT DIAGRAM METHANOL INHIBITOR KAPUNI WELLSITE 1 & 7												SHEET No		REVISION		
NO	DATE	BY	CHKD APPR.	CHKD APPR.	NO	DATE	BY	ECP	DESCRIPTION	CHKD APPR.	CHKD APPR.	NUMBER	TITLE	DESIGNED	K ALLUM	DATE
														DRAWN	G ROBERTSON	9/95
H1	03/17	JMP	ECP K179 APPROVED FOR DESIGN	ML	SG	07	07/08	MH	ECP	ECP K1245 AS BUILT TO SITE MARK UP ASB 8129KW	VB	PWM	.	AI	.	.
H2	10/16	JMP	ECP K145 APPROVED FOR HAZOP	SG	ML	CHECKED	M WEST	3/95
G1	03/12	JMM	ECP K145 APPROVED FOR DESIGN	GB	JA	A1	13	08/19	BB	ECP ECP XX1802 AS BUILT TO SITE MARK UP ASB T19007KK	JMP	AB	.	MW	.	.
F1	05/13	JG	ECP K134 APPROVED FOR CONSTRUCTION	JR	AB	ATH	12	08/18	BB	ECP ECP K1729 & KA-7 REMEDIATION AS BUILT TO ASB T18022KW & T18050KW	JMP	GD	.	KB	.	.
J1	05/18	JMP	KA-7 FACILITIES ISSUED FOR CONSTRUCTION	AH	KB	10	04/14	DG	ECP	ECP K1334 AS BUILT TO SITE MARK UP ASB 14036KW	JMP	AB	.	SJ	.	.
J2	05/18	JMP	KA-7 FACILITIES ISSUED FOR HAZOP	SB	KB	09	02/14	MH	ECP	ECP K1459 AS BUILT TO SITE MARK UP ASB 13285KW	JMP	AB	ATH	.	.	.
H2	09/17	JGM	K1279 GUSP APPROVED FOR CONSTRUCTION	ML	GB	SG	08	12/08	DW	ECP ECP K1152 AS BUILT TO SITE MARK UP ASB 8198KW	VB	PWM	.	AI	.	.
NO	DATE	BY	CONSTRUCTION ISSUE	CONSULTANT	TODD				REVISIONS	CONSULTANT	TODD		REFERENCE DRAWINGS	STICKFILE	.	.


Todd Energy


2 OF 3 | 13
DRAWING No 941-10-00102

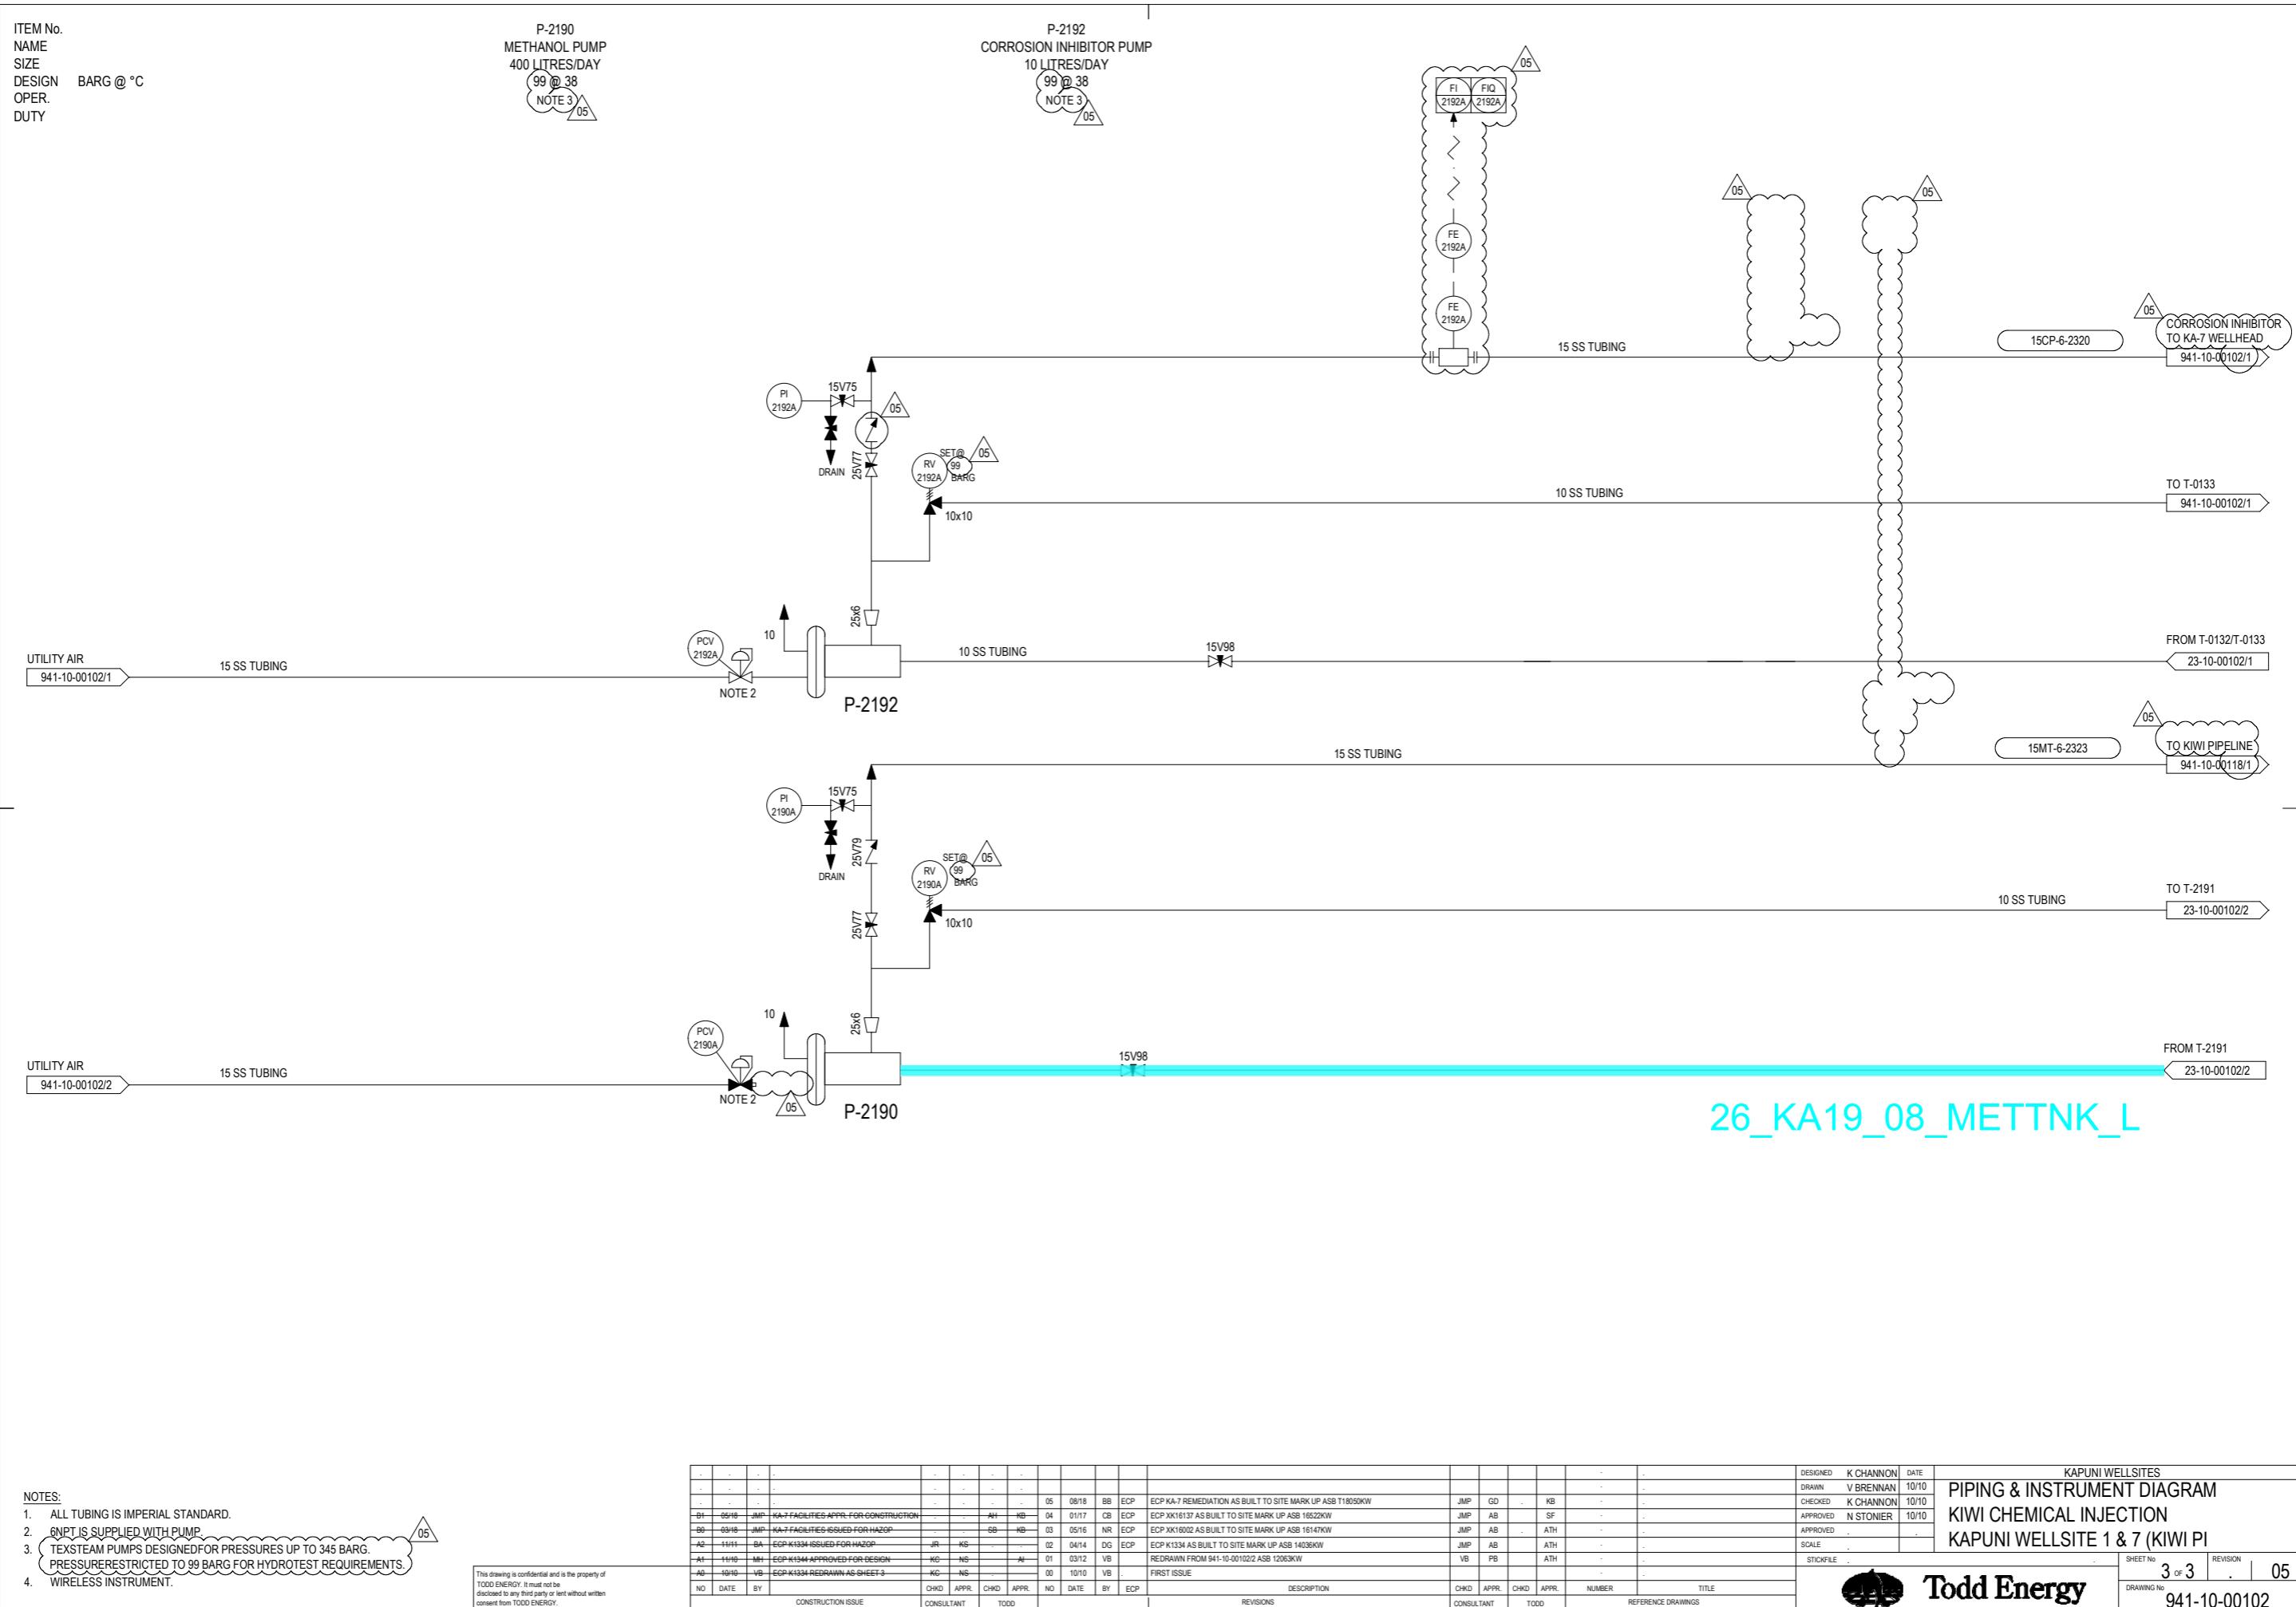

Appendix 2.
P&ID Sectionalisation for KA-4 and KA-14

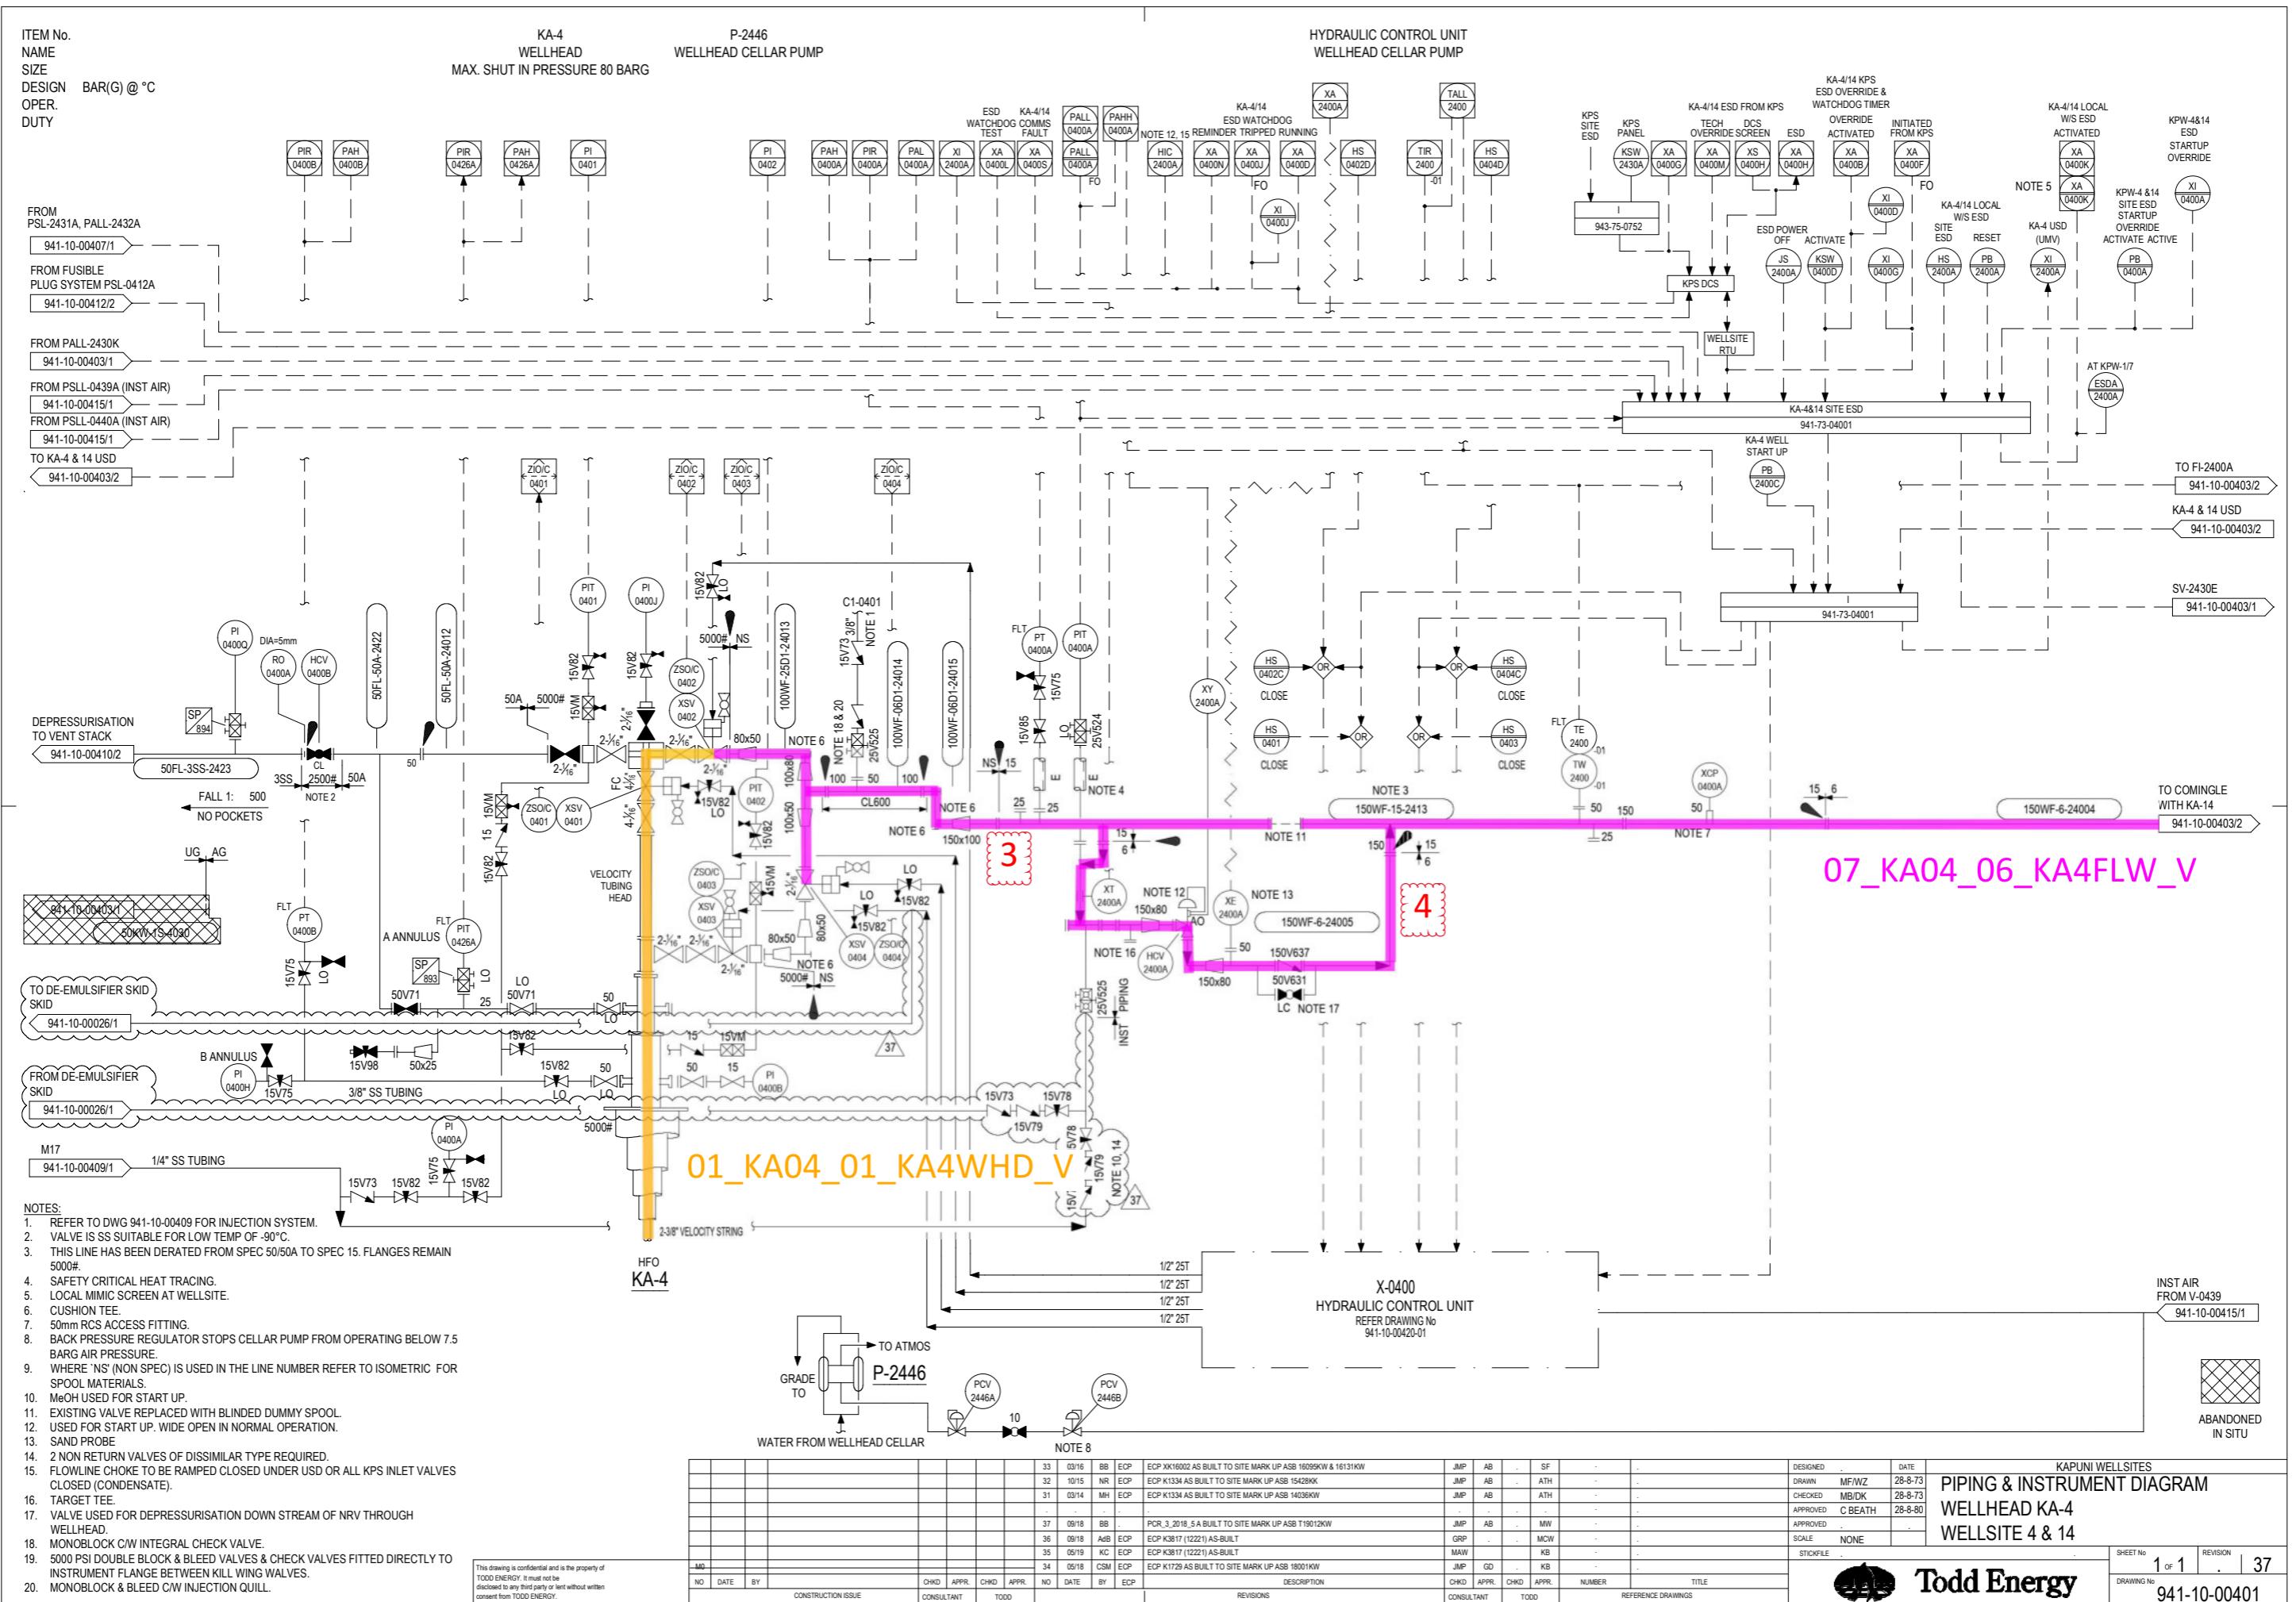

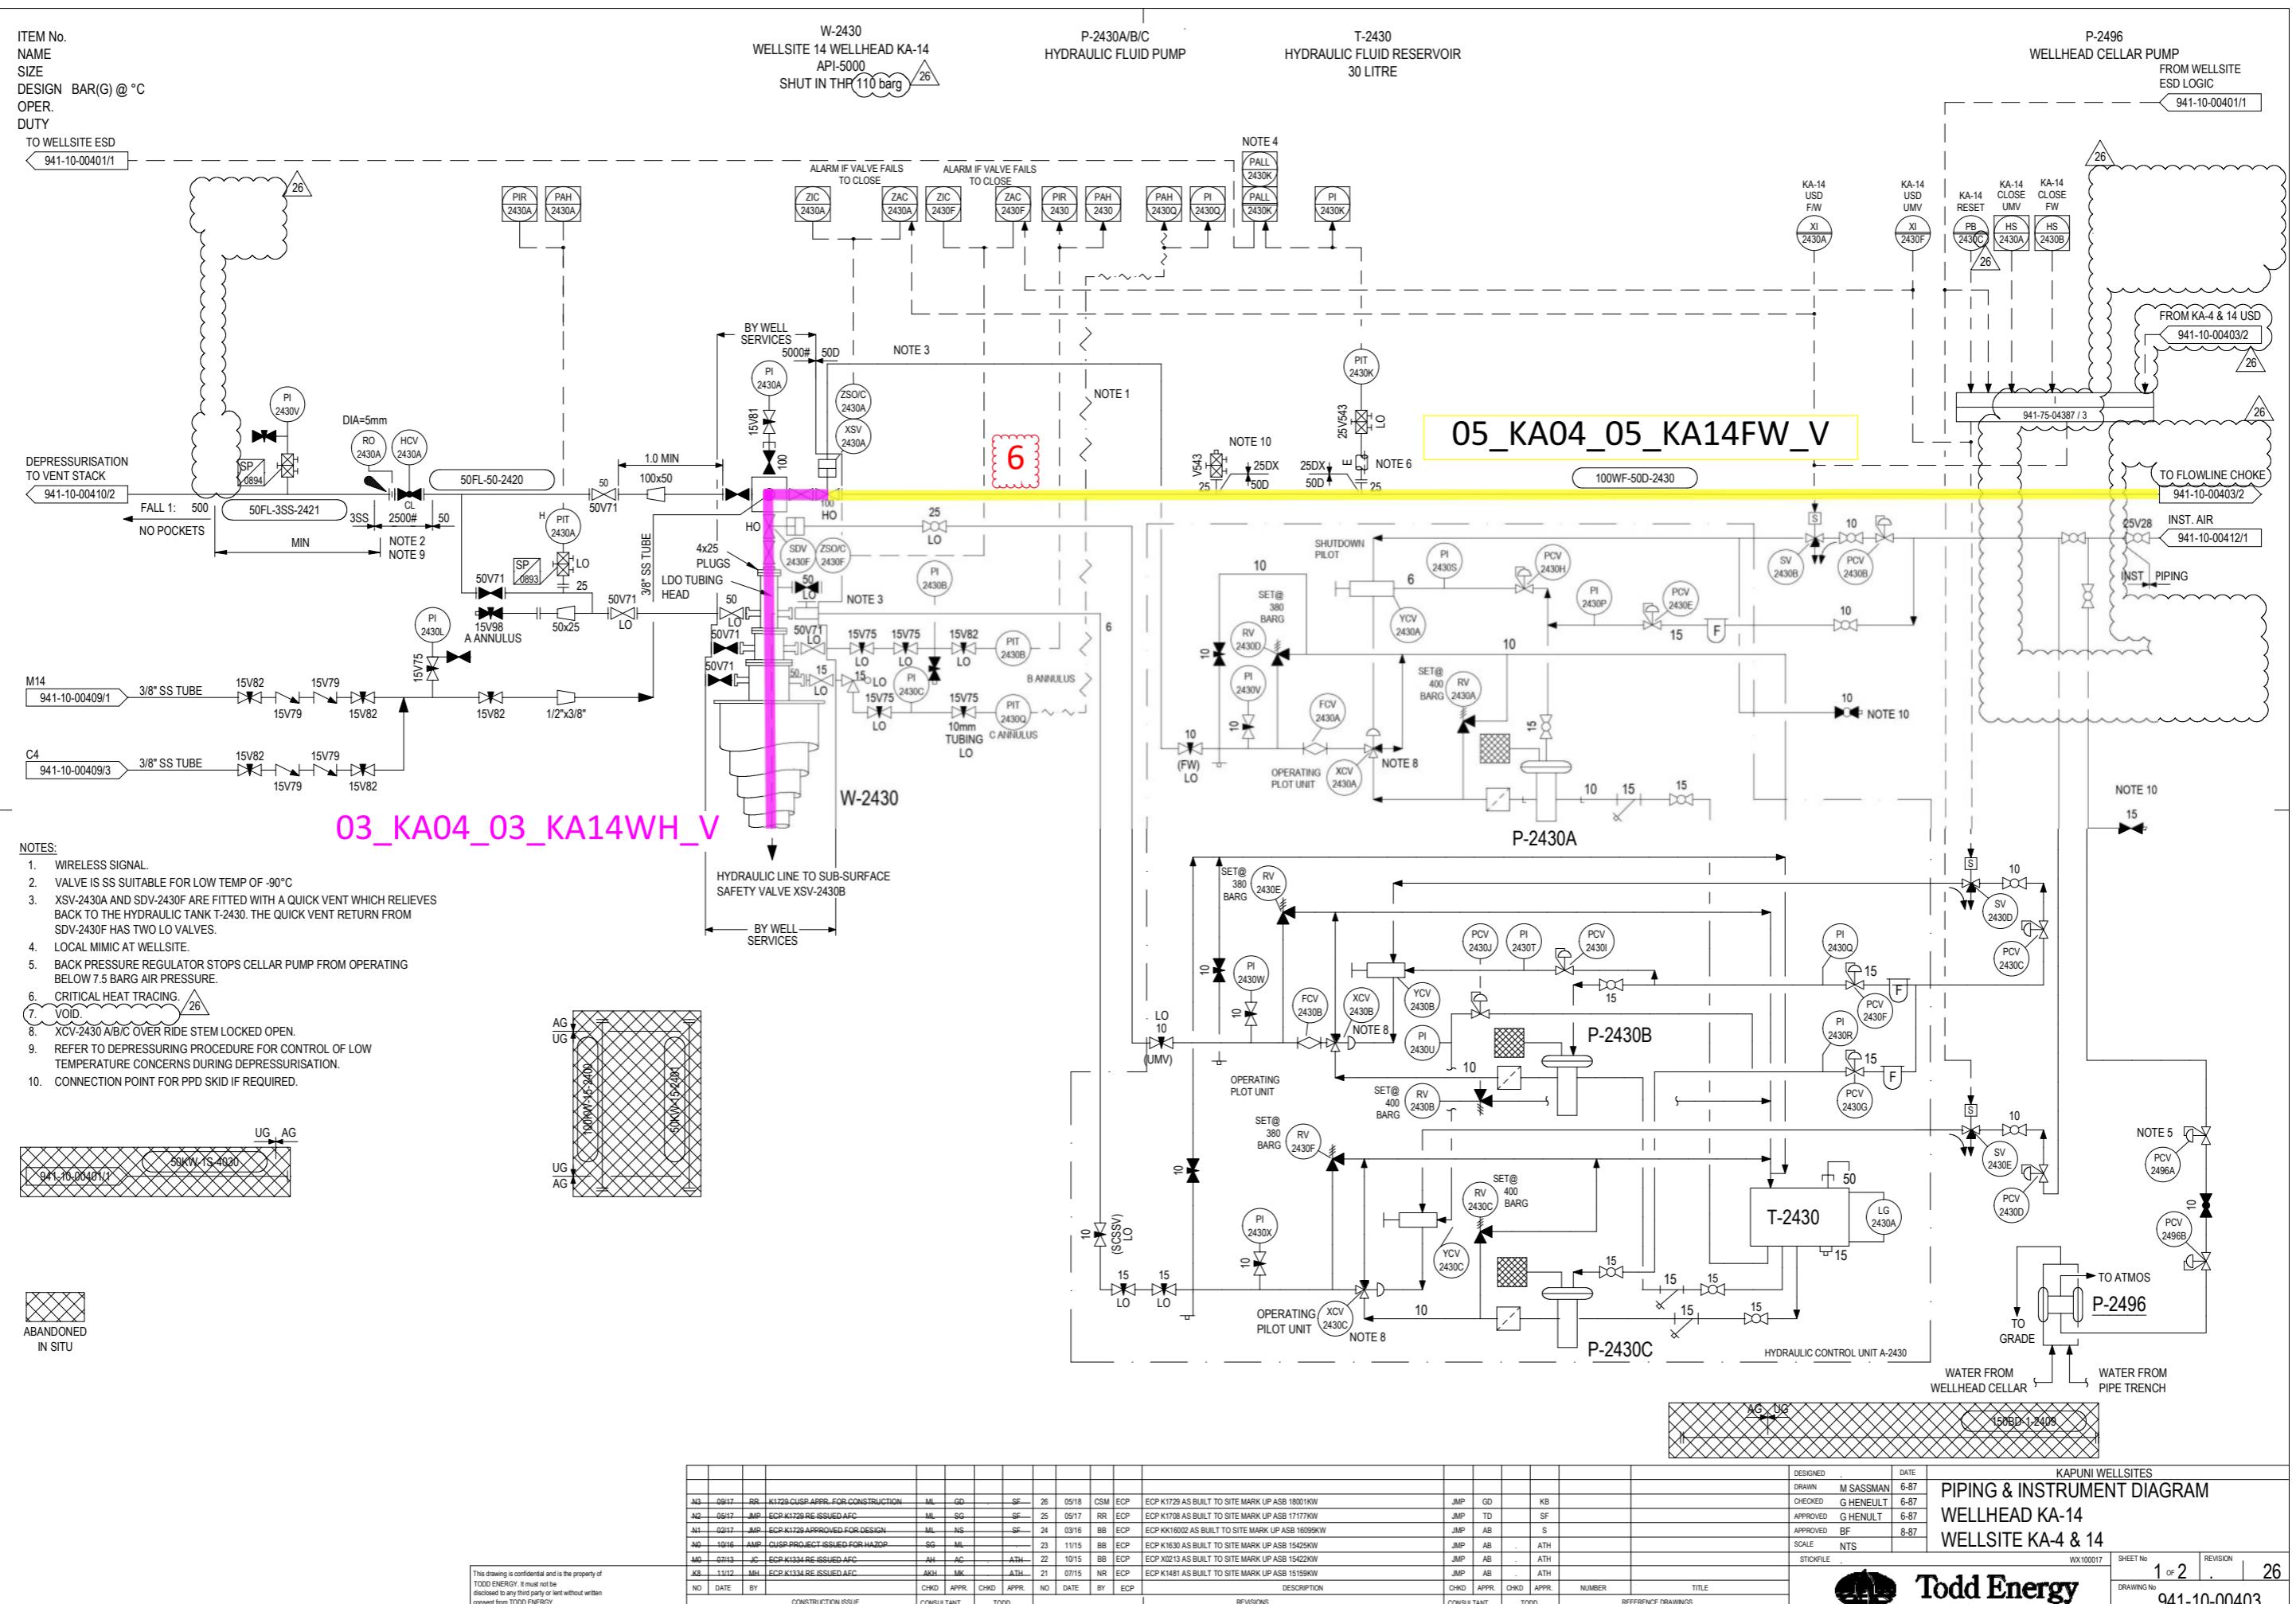

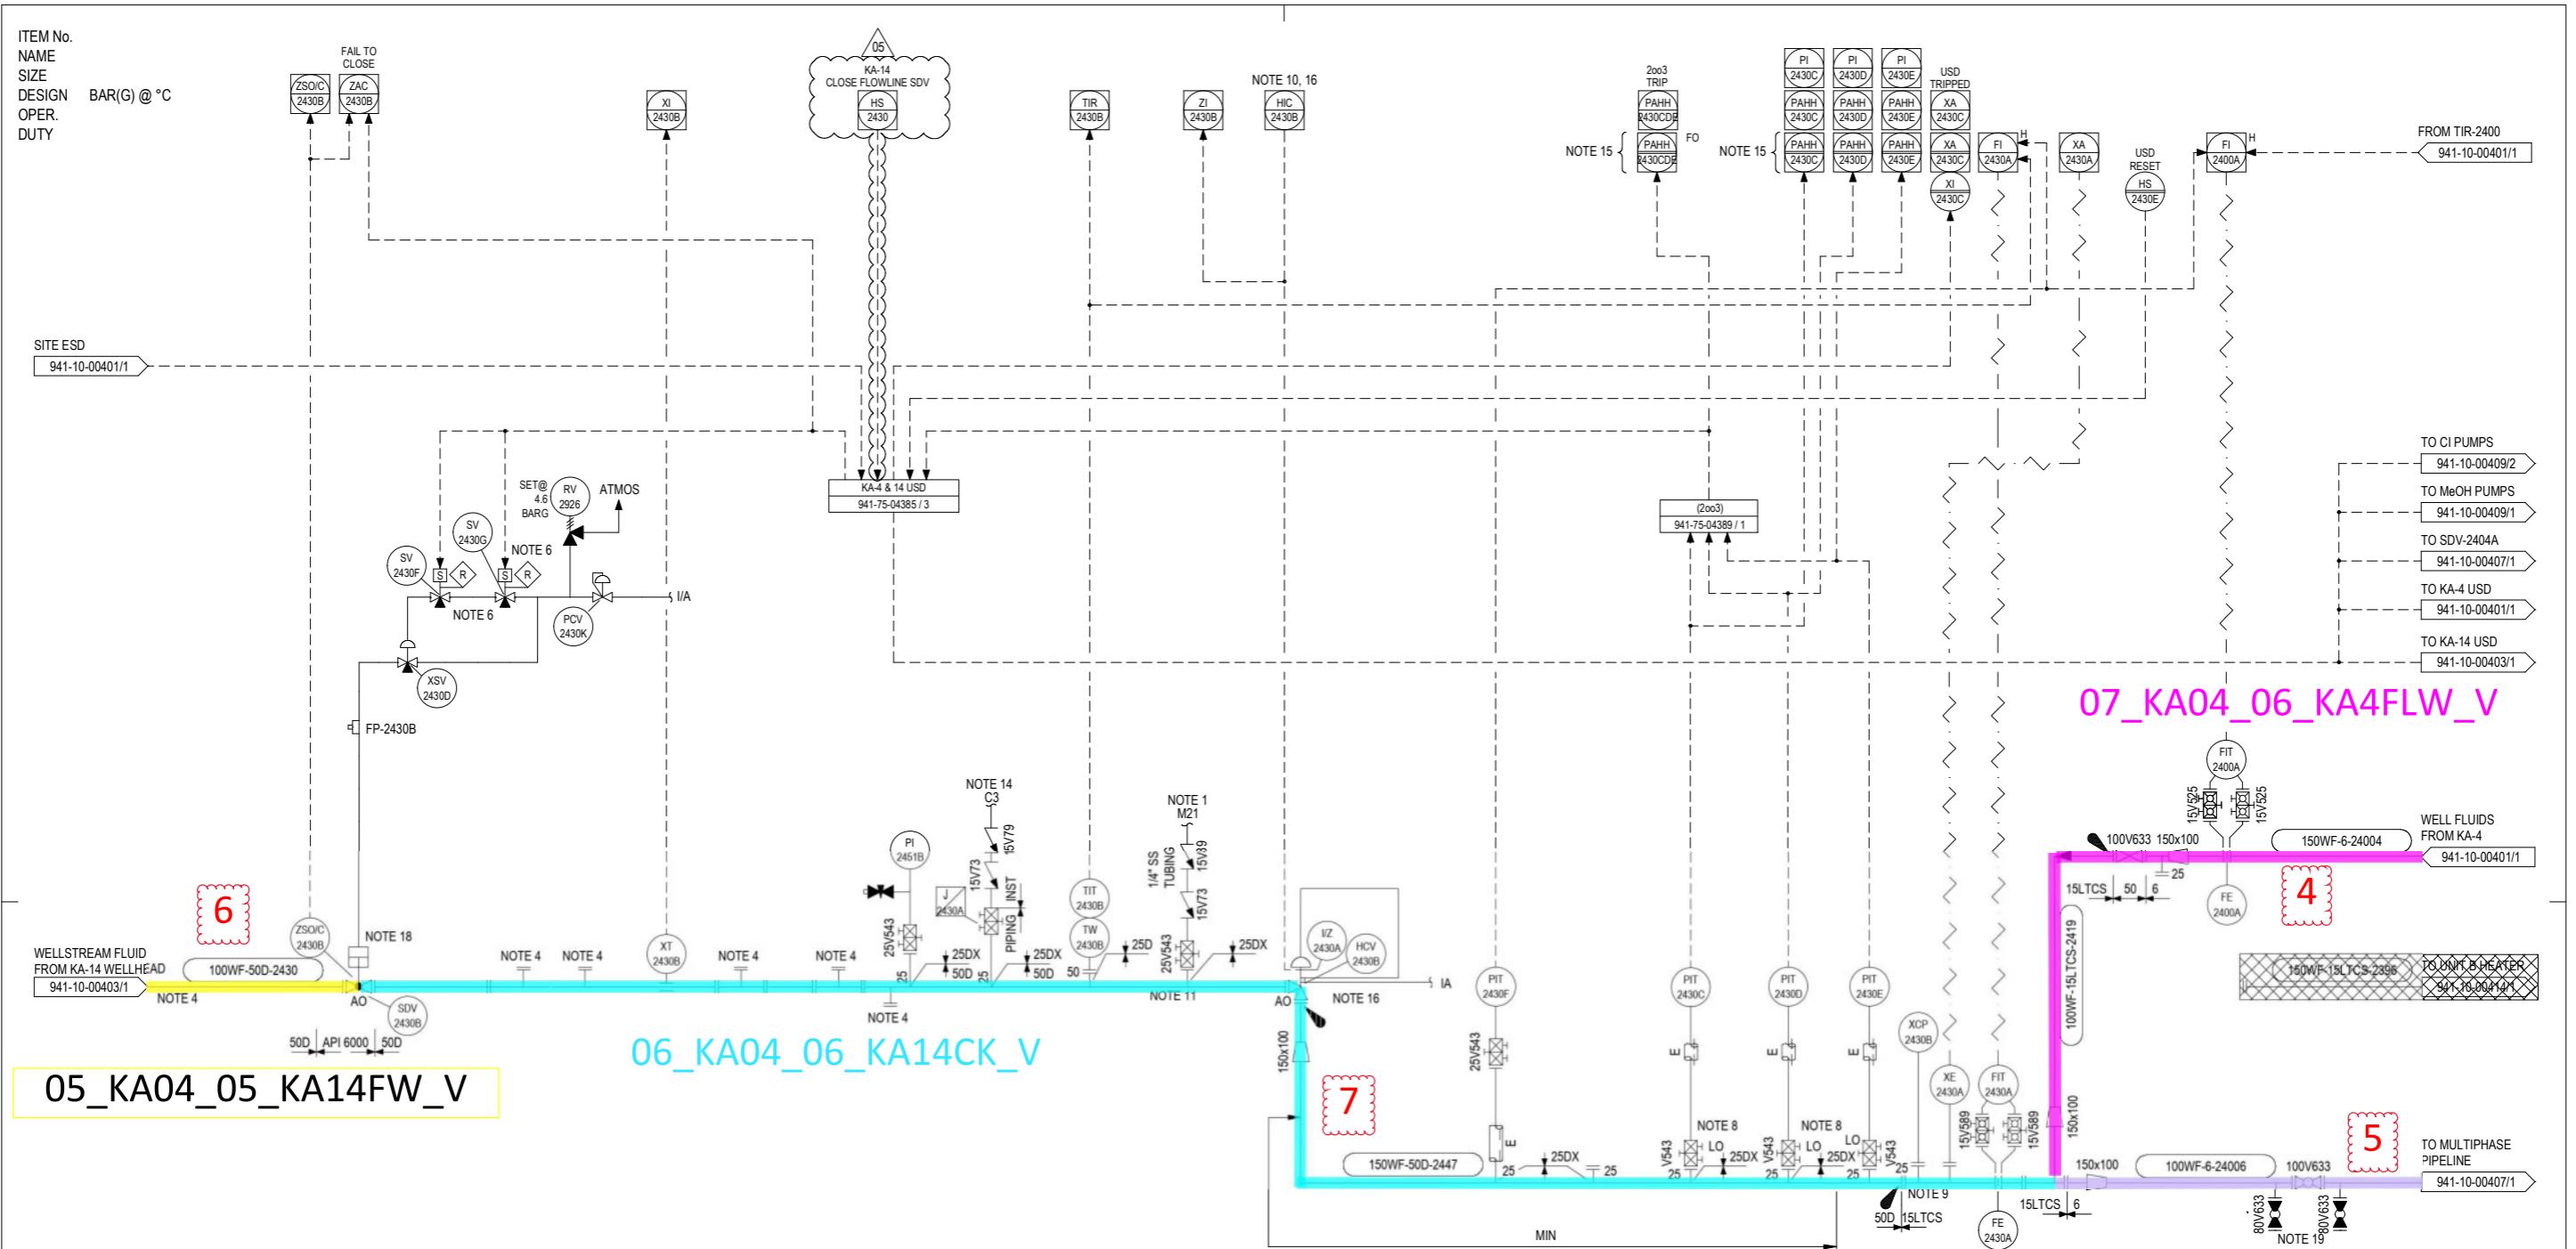


- NOTES.**
- METHANOL INJECTION LINES TO BE 1/4" SS BY INSTRUMENTS. SEE DWG 941-10-409/2 FOR METHANOL INJECTION SYSTEM.
 - CLAMP ON SAND FILTER MONITOR.
 - ALL TUBING IS IMPERIAL STANDARD.
 - TARGET TEE INCLUDED FOR POTENTIAL SAND PRODUCTION.
 - VOID.
 - ANTI-TAMPER MANUAL RESET SOLENOIDS, CANNOT BE RESET UNTIL PAHH SYSTEM IS RESET
 - VOID.
 - REMOVEABLE INSULATION ON MONOBLOCKS.
 - 50mm RCS ACCESS FITTING WITH CORROSION PROBE
 - ELASTOMERS IN ACCESS FITTING ONLY SUITABLE FOR -34°C.
 - VALVE OPENING TO BE CONTROLLED AND SET BY OPERATOR.
 - TWO PHASE AND/OR SLUG FLOW.
 - COTTON REEL SPOOL INSTALLED BETWEEN 100V93 VALVES
 - VOID.
 - C3 TO BE INSTALLED AT LEAST 2m FROM CHOKE VALVE.
 - LOCAL MIMIC SCREEN AT WELLSITE.
 - FLOWLINE CHOKE CONTROL SWITCHED TO MANUAL AND FULLY CLOSED (0%) UPON USD, OR ALL KPS INLET VALVES CLOSED.
 - VOID.
 - AXIAL FLOW SHUT OFF VALVE.
 - CONNECTIONS FOR PORTABLE WELL TESTING SEPARATOR.


This drawing is confidential and is the property of TODD ENERGY. It must not be disclosed to any third party or lent without written consent from TODD ENERGY.

KAPUNI WELLSITES												PIPING & INSTRUMENT DIAGRAM			
WELLHEAD KA-14												WELLSITE KA-4 & 14			
NO.	DATE	BY	CHKD	APPR.	CHKD	APPR.	NO.	DATE	BY	ECP	DESCRIPTION	CHKD	APPR.	CHKD	APPR.
NO.	DATE	BY	CHKD	APPR.	CHKD	APPR.	NO.	DATE	BY	ECP	DESCRIPTION	CHKD	APPR.	CHKD	APPR.
B1	08/14	NR	ECP	KA-14 REMEDIATION AFC			03	09/17	RR	ECP	ECP K1708 AS BUILT TO SITE MARK UP ASB 17177KW	JMP	SQ		MW
B0	07/14	JMP	KA-14 REMEDIATION FOR HAZOP	ML	AB		01	03/14	MH	ECP	ECP K1334 AS BUILT TO SITE MARK UP ASB 15314KW	JMP	AB		ATH
NO.	DATE	BY	CHKD	APPR.	CHKD	APPR.	NO.	DATE	BY	ECP	DESCRIPTION	CHKD	APPR.	CHKD	APPR.
											REVISIONS	CONSULTANT	TODD	NUMBER	TITLE
											REFERENCE DRAWINGS				

Todd Energy

2 of 2 | 05
DRAWING No. 941-10-00403

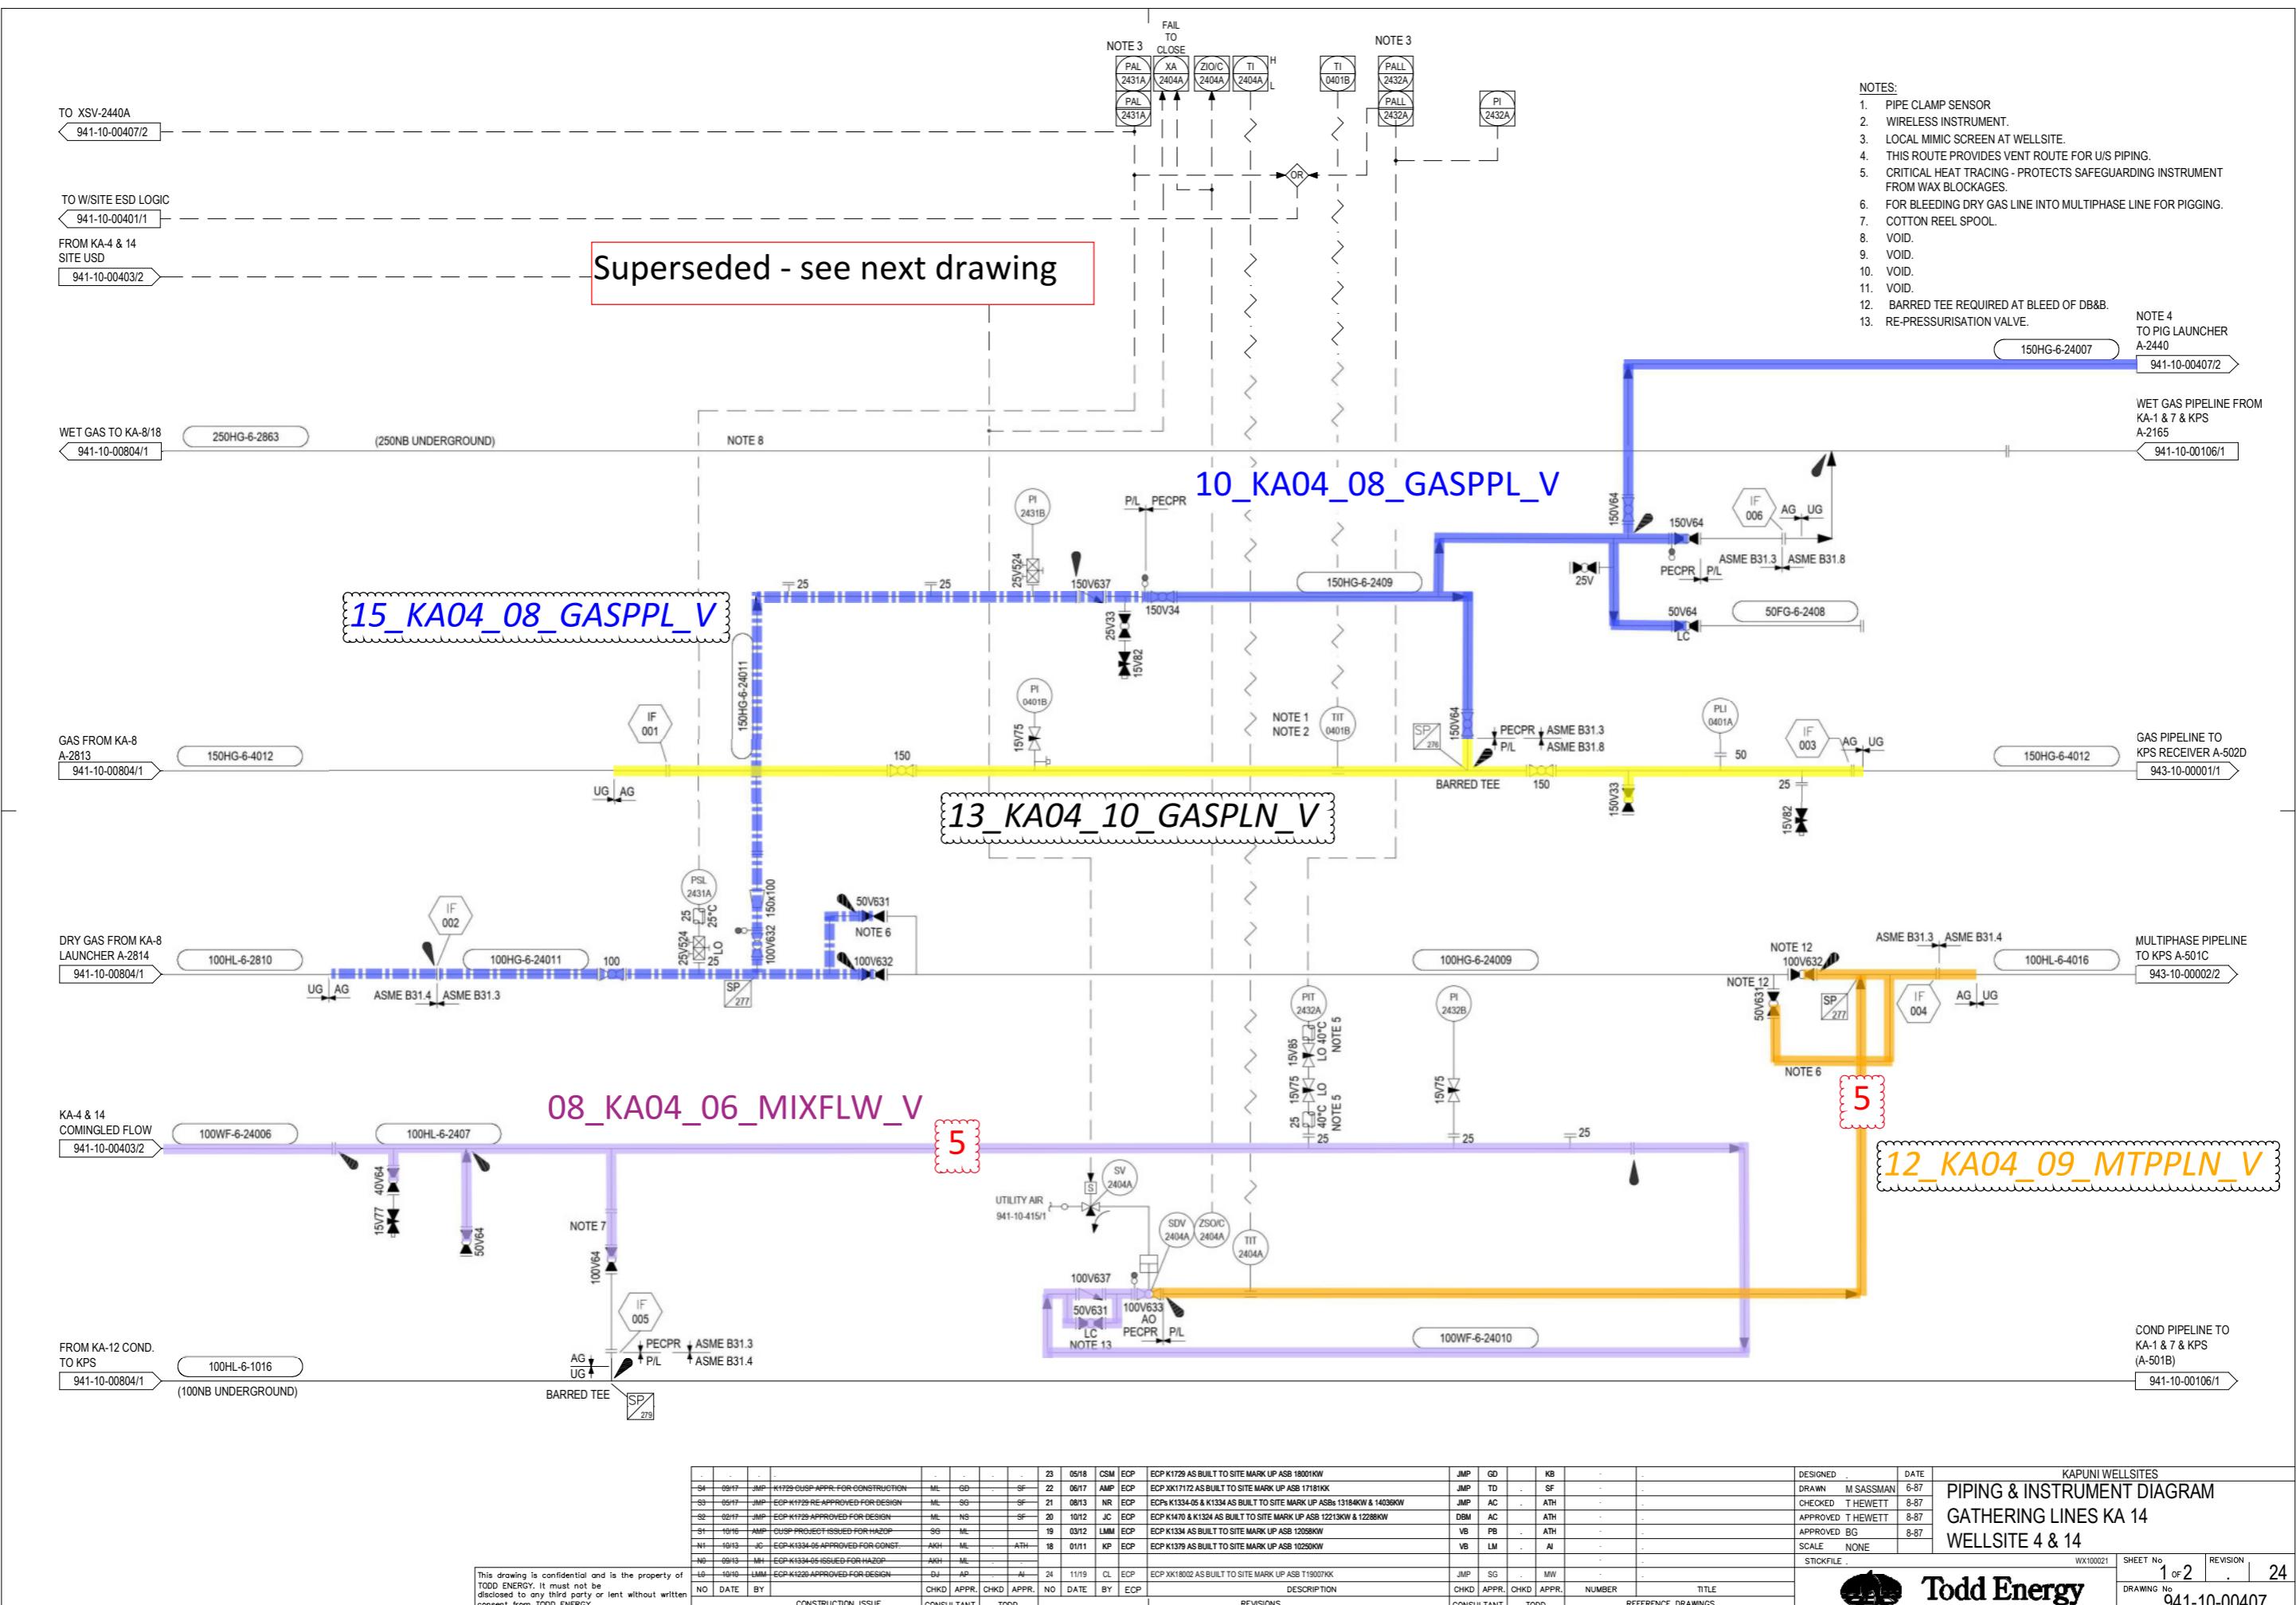

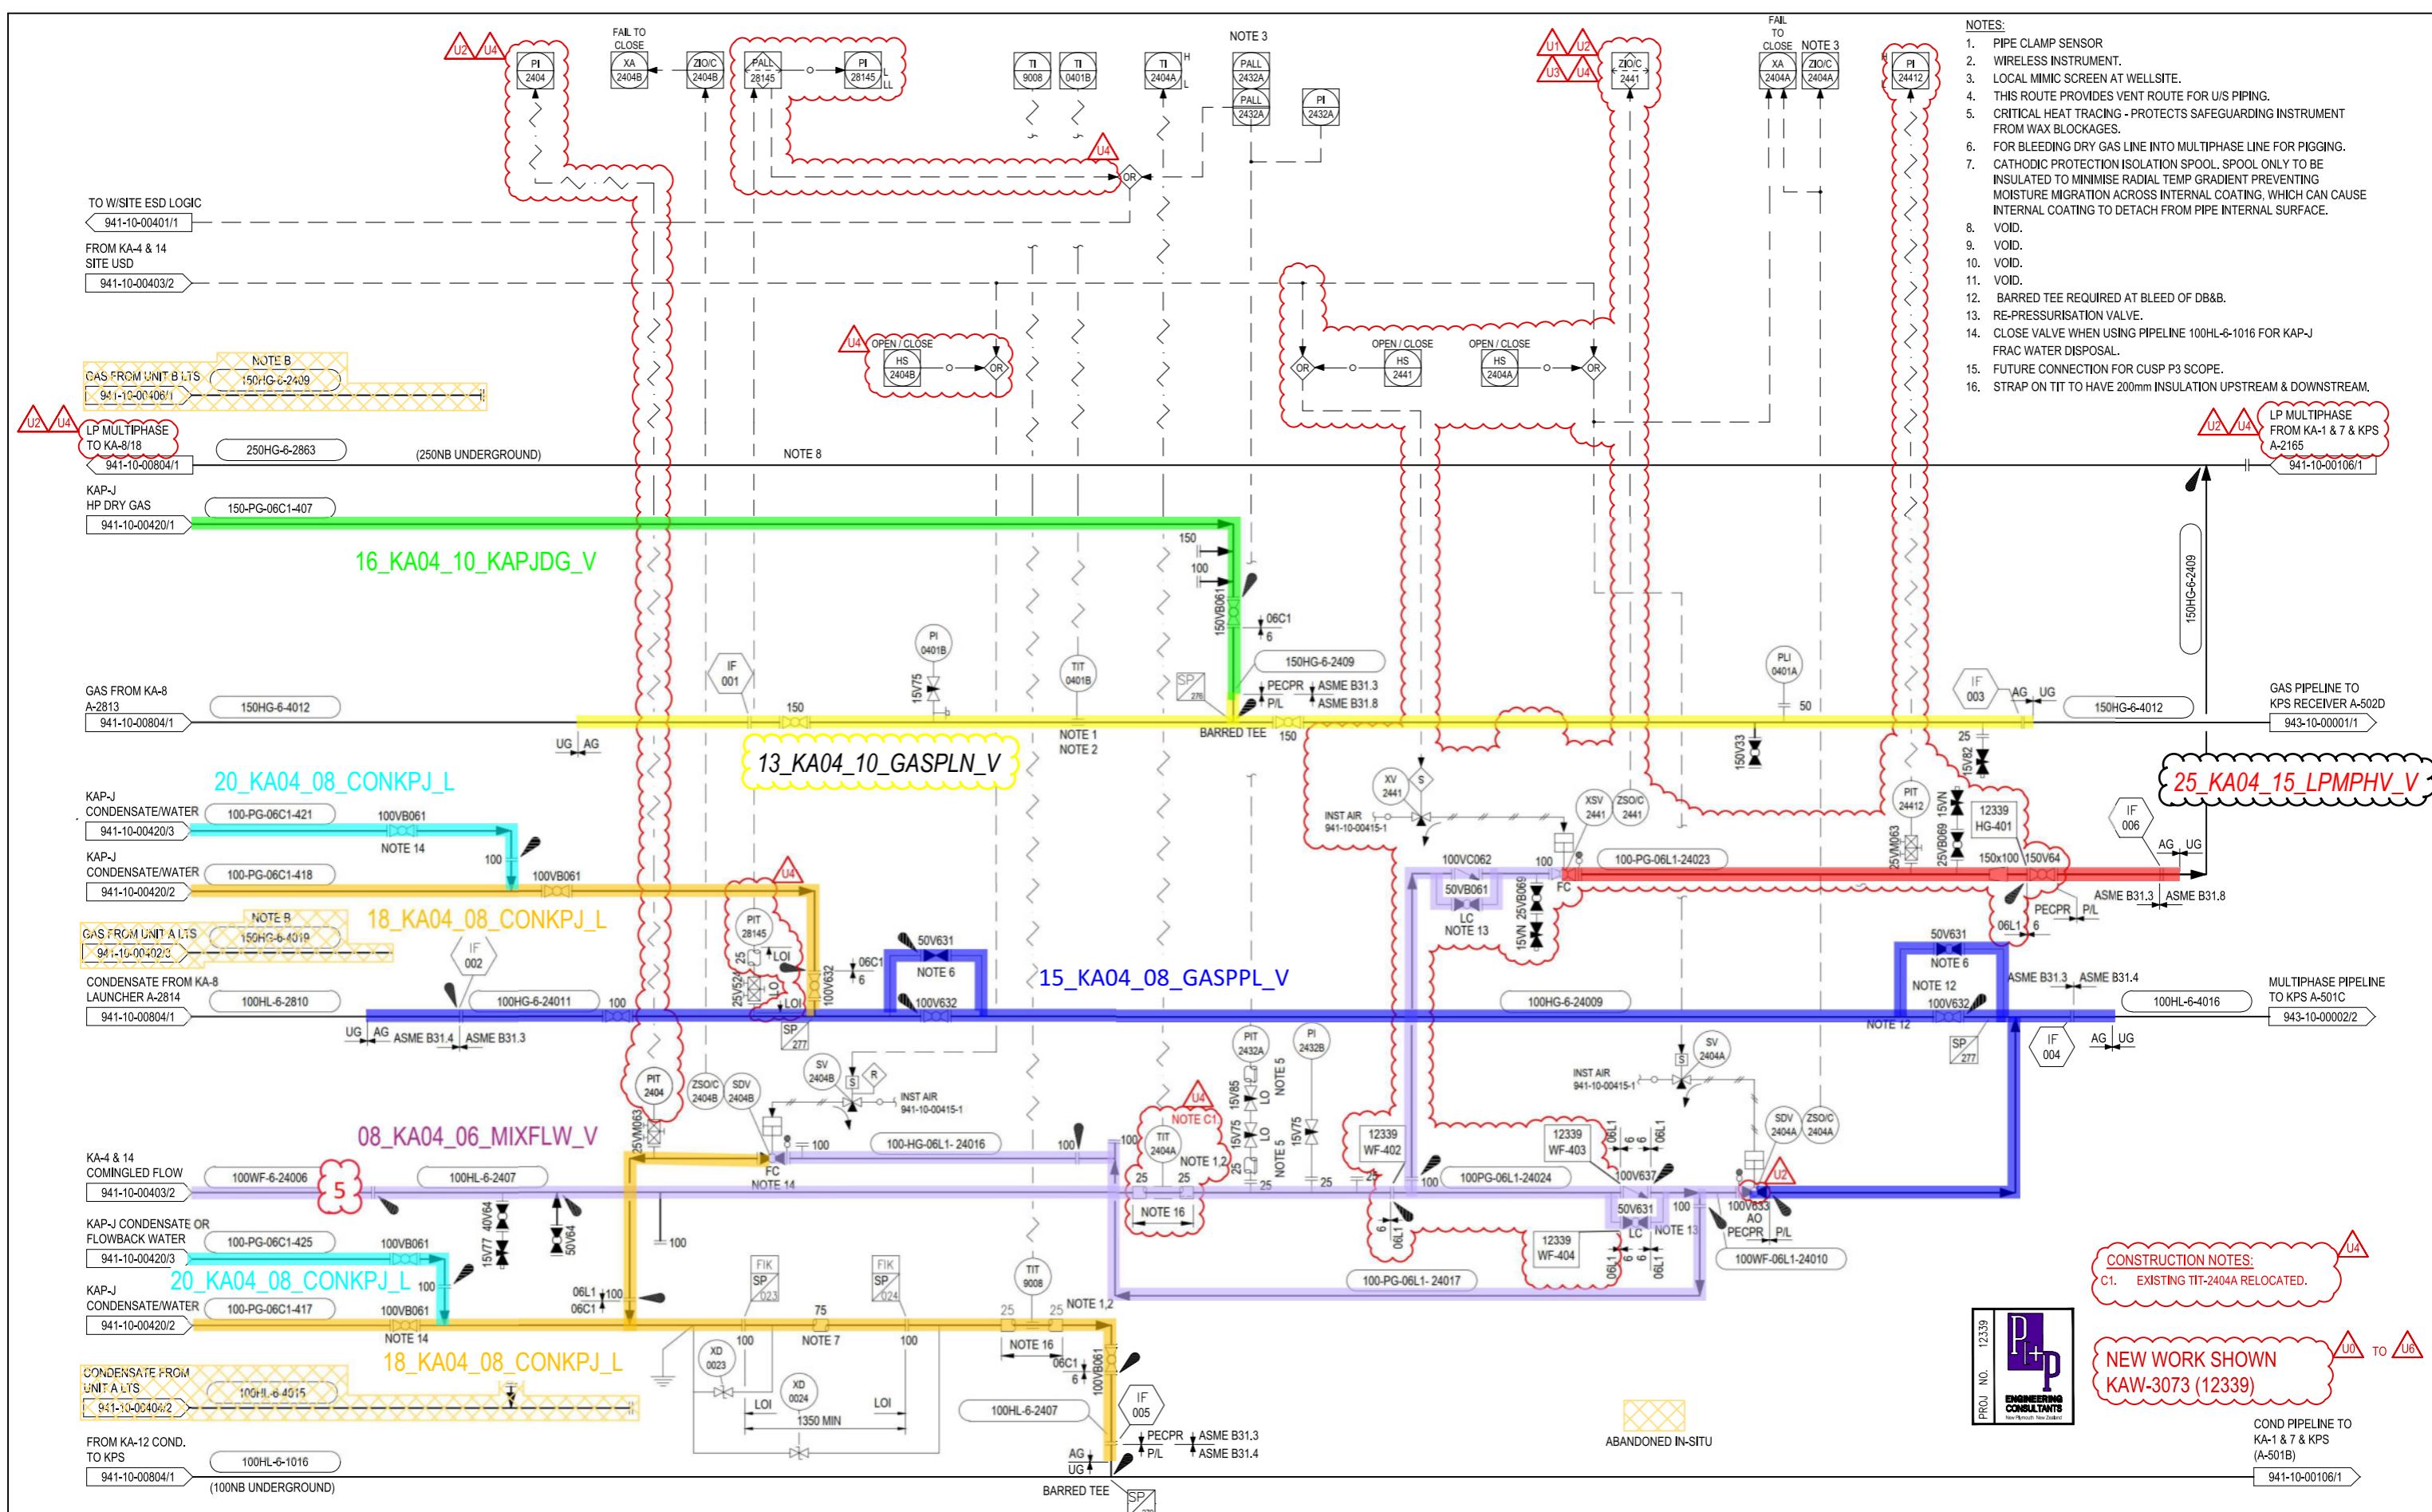


U6	ISSUED FOR CONSTRUCTION - KAW-3073 (12339)	MAW	GRP	NS	ZA	KB	04/22	25 AS BUILT FOR K1706 (11730)	MAW	GRP	JMT	. KB	12/21
U5	ISSUED FOR DETAIL DESIGN - KAW-3073 (12339)	GRP	MAW	NS	ZA	KB	02/22	24 ECP XK18002 AS BUILT TO SITE MARK UP ASB T19007KK	CL	JMP	SG	. MW	11/19
U4	ISSUED FOR DETAIL DESIGN PCR_3_2020_81	DB	GRP	NS	ZA	KB	09/20	23 ECP K1729 AS BUILT TO SITE MARK UP ASB 18001KK	CSM	JMP	GD	. KB	05/18
REV	CONSTRUCTION ISSUE	BY	CHK	ENG	APP	TODD	DATE	22 ECP XK17172 AS BUILT TO SITE MARK UP ASB 17181KK	AMP	JMP	TD	. SF	06/17

ITEM No.
NAME
SIZE
DESIGN
OPER.
DUTY

A-2440
SCRAPER LAUNCHER
08

Superseded - see next drawing

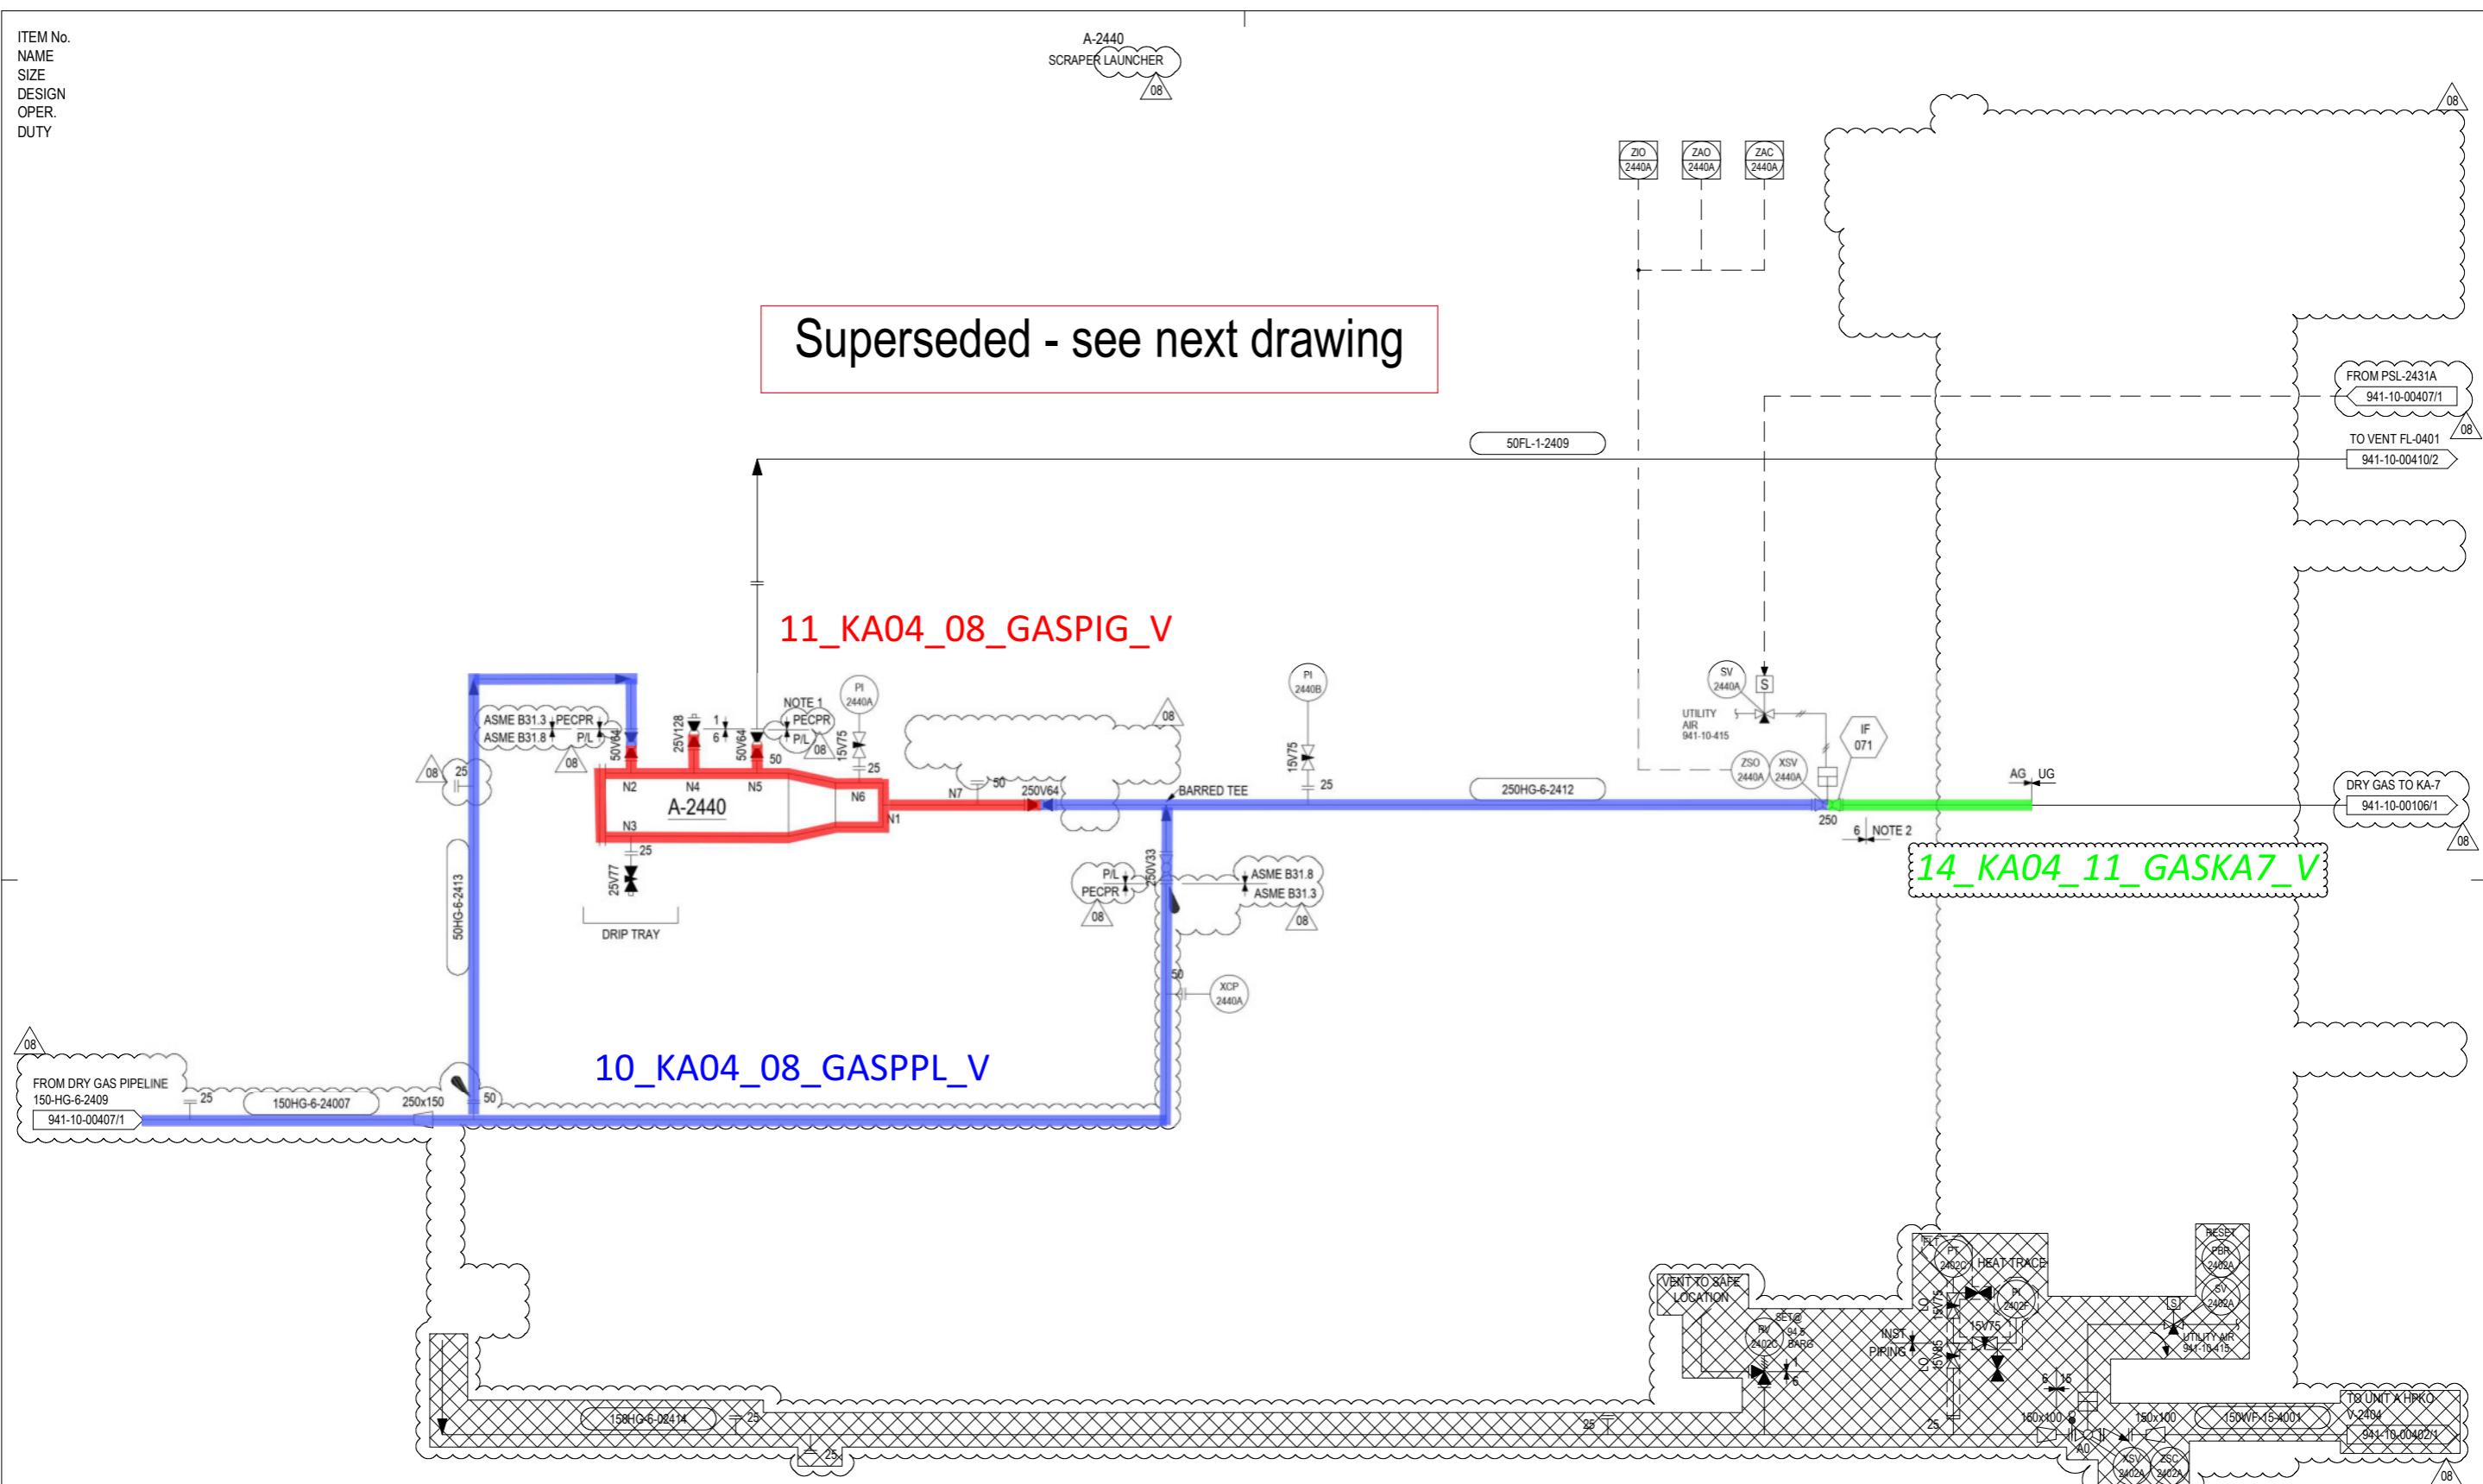

- NOTES**
- AVOID USING PIG TRAP VENT LINE FOR DEPRESSURISING KA-1/7 TO KA-4/14 FLOWLINE.
 - 250NB SCH 30 ERW API 5L X46 MDPE COATED CLASS 600 FLANGES 94.5 BARG @ 60°C TO NZS 5223 : PART 1 1986

This drawing is confidential and is the property of TODD ENERGY. It must not be disclosed to any third party or lent without written consent from TODD ENERGY.

KAPUNI WELLSITES																		
PIPING & INSTRUMENT DIAGRAM																		
GAS SCRAPER LAUNCHER A-2440																		
WELLSITE 4 & 14																		
C4	00/11	LMM	ECP K1334 UNIT A RE ISS APPR. FOR DESIGN	MK	K5	AI	07	04/12	LMM	ECP	ECP K1334 AS BUILT TO SITE MARK UP ASB 1205kW	VB	PB	ATH	-	-	DESIGNED	DATE
H4	09/17	RR	ECP K1729 GUSP APPR. FOR CONSTRUCTION	ML	GB	SF	05	12/08	DW	ECP	ECP K1379 AS BUILT TO SITE MARK UP ASB 10250kW	VB	LM	AI	-	-	DRAWN	M WEST 5/93
H3	09/17	IMP	ECP K1729 RE APPROVED FOR DESIGN	ML	SS	SF	04	05/06	DW	ECP	ECP K1152 AS BUILT TO SITE MARK UP ASB 8198kW	VB	PWN	AI	-	-	CHECKED	J CARLEY 5/93
H2	02/17	IMP	ECP K1729 APPROVED FOR DESIGN	ML	NS	SF	03	05/07	JMP	ECP	ECP K1041 AS BUILT TO SITE MARK UP ASB 6063kW	VB	PWN	AI	-	-	APPROVED	P NARASHMIN 5/93
H1	10/16	AMP	ECP PROJECT ISSUED FOR HAZOP	SG	ML	-	02	06/04	SK	K546	AS BUILT TO SITE MARK UPS	JHT	JA	KJE	-	-	APPROVED	S HARVEY 5/93
H0	08/16	AMP	ECP PROJECT ISSUED FOR HAZOP	ML	SS	-	-	-	-	-	-	-	-	-	-	SCALE	NTS	
G5	12/11	SG	ECP K1334 CWS-1000 APC	KS	AP	AI	08	05/18	CSM	ECP	ECP K1729 AS BUILT TO SITE MARK UP ASB 18001kW	JMP	GD	KB	-	-	STICKFILE	-
NO	DATE	BY	CHKD APPR.	CHKD APPR.	NO	DATE	BY	ECP	CONSTRUCTION ISSUE	CONSULTANT	TODD	DESCRIPTION	CHKD APPR.	CHKD APPR.	NUMBER	TITLE	WX100150	SHEET No
									REVISIONS	CONSULTANT	TODD					2 OF 2	REVISION	
																08		
																	DRAWING No	
																	941-10-00407	

Todd Energy

ITEM No.
NAME
SIZE
DESIGN
OPER.
DUTY

A-2440
SCRAPER LAUNCHER

