

APPENDIX E QRA KAPUNI GAS TREATMENT PLANT - WORLEY

TODD ENERGY LTD

Kapuni Gas Treatment Plant Quantitative Risk Assessment Report

610115-RPT-R0003
July 2022

Worley New Zealand Ltd
25 Gill Street, New Plymouth 4310
PO Box 705, New Plymouth 4340

Telephone +64-6-759 6300
Facsimile +64-6-759 6301
www.worley.com

Rev	Description	Originator	Reviewer	Worley Approver	Date	Client Approval	Date
A	Issued for Review/Comment	H Lee / L Ong	Y Lee	E Gloy	09/2020		
0	Approved for Use	H Lee / L Ong	E Gloy	N Stonier	12/2020		
1	Re-Approved for Use	Y Lee / L Ong	S Rankin	N Stonier	08/2021		
2	Re-Approved for Use	Y Lee	O Kilian	O Kilian	07/2022		

TABLE OF CONTENTS

1	ABBREVIATIONS.....	1
2	INTRODUCTION.....	3
2.1	Background	3
2.2	Objectives.....	3
2.3	Scope	3
2.4	Exclusions	3
2.5	QRA Study Cases	4
3	FACILITY AND PROCESS OVERVIEW	5
3.1	Facility Overview	5
3.2	Process Overview	9
3.3	Plant and/or Equipment Operational Status.....	11
4	STUDY METHODOLOGY AND ASSUMPTIONS	13
4.1	Assessment Tool.....	14
4.2	QRA Assumptions.....	14
4.3	Vapour Cloud Explosion and UK HSE Research Report RR1113 Findings.....	22
5	HAZARD IDENTIFICATION	24
5.1	Hazardous Materials	24
5.2	Isolatable Sections	24
5.3	Release Scenarios.....	25
6	FREQUENCY ANALYSIS	31
6.1	Release Frequency Assessment	31
6.2	Ignition and Explosion Probabilities.....	32
7	RISK ANALYSIS	33
7.1	Location Specific Individual Risk (LSIR).....	33
7.2	Major Risk Contributors	37
7.3	LPG Risk Analysis	38
8	SENSITIVITY CASES	41
8.1	Case 1. ESDV Success Probability of 98%	41
8.2	Case 2. Future Operating Case	44
9	POTENTIAL CUMULATIVE RISK FROM KPS AND KGTP	50
10	CONCLUSIONS.....	52
11	REFERENCES.....	54

APPENDICES

APPENDIX 1. SECTIONALISED P&IDS

APPENDIX 2. PARTS COUNT SHEETS

APPENDIX 3. ESTIMATED PIPING LENGTHS

APPENDIX 4. LEAK FREQUENCIES

APPENDIX 5. IGNITED EVENT AND TOXIC EVENT FREQUENCIES

EXECUTIVE SUMMARY

Introduction

Worley New Zealand Limited (Worley) has been commissioned by Todd Energy (Todd) to perform a Quantitative Risk Assessment (QRA) for the Kapuni Gas Treatment Plant (KGTP).

Objectives

The main objective of this study is to develop risk contours to assess land use compatibility in accordance with the NSW Hazardous Industry Planning Advisory Paper No. 4 (HIPAP 4) "Risk Criteria for Land Use Planning".

Methods

The study uses an internationally accepted QRA approach that involves identification of hazards, assessment of the frequency of potential events, assessment of the consequences of potential events, risk computation and comparison of risk results with Todd's risk acceptance criteria and NSW HIPAP 4 individual fatality risk criteria. The risk computation is carried out using DNV risk modelling software package Safeti version 8.22.

The assessment considers risks from KGTP for the following cases:

- Base Case – all facilities currently in operation;
- Sensitivity Case 1 – all facilities currently in operation with reduced ESDV success rate of 98% instead of 100%; and
- Sensitivity Case 2 – all facilities currently in operations including standby and mothballed facilities which might be brought back to operation in the future.

This QRA specifically evaluates onsite process/ flammable and toxic risks, but excludes risks from neighbouring facilities, non-flammable risks due to natural environmental hazards and occupational hazards.

Results

Risk contours for the Base Case are presented in Figure 1.

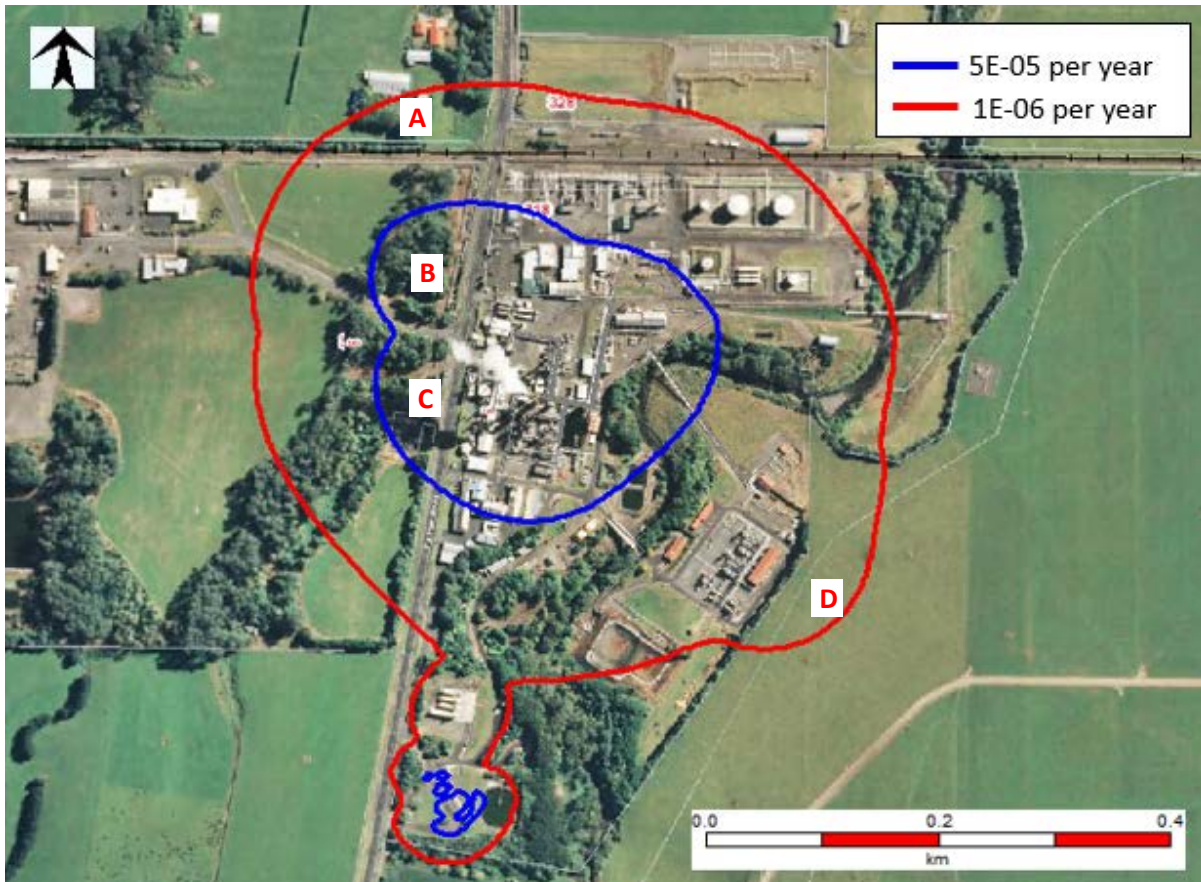


Figure 1: Base Case LSIR Contours at KGTP

The following conclusions have been made for the Base Case assessment:

- The 5E-05 per year contour extends into the KPS site to the north but remains within the Todd Energy site boundary;
- The 5E-05 per year contour extends across Palmer Road and into the bushes at the west boundary of the Ballance site;
- The 1E-06 per year contour extends onto the property of the neighbour to the northwest (approximately 180m NW of KGTP northern boundary) but does not extend as far as the dwelling and farm buildings;
- The main risk contributors to the shed area (location A) are ammonia toxic events from 71 mm leaks from the Liquid Receivers (KGT80_AMM_04_L_71mm) and Ammonia Condensers (KGT80_AMM_03_L_71mm) within the CO2 Recovery Unit (at approximately 15°C and 15 barg); and
- The main risk contributors to the Ballance site bushes (locations B and C) are ammonia toxic events from 22 mm leaks from the Liquid Receivers (KGT80_AMM_04_L_22mm) and Ammonia Condensers (KGT80_AMM_03_L_22mm) within the CO2 Recovery Unit (at approximately 15°C and 15 barg).
- The main risk contributors to the rural land area to the east of the plant (location D) are Product Gas jet fire events from 85 mm leaks from the Gas Storage Compressor (D4-0401) to Coalescer (KGT13_PGS_16_V_85mm), and the Gas Storage Compressor (KGT13_PGS_15_V_85mm) within the Product Gas Lines and Compressors unit (at approximately 15°C and 40 barg).

Risk contours for the Sensitivity Case 1 are presented in Figure 2.

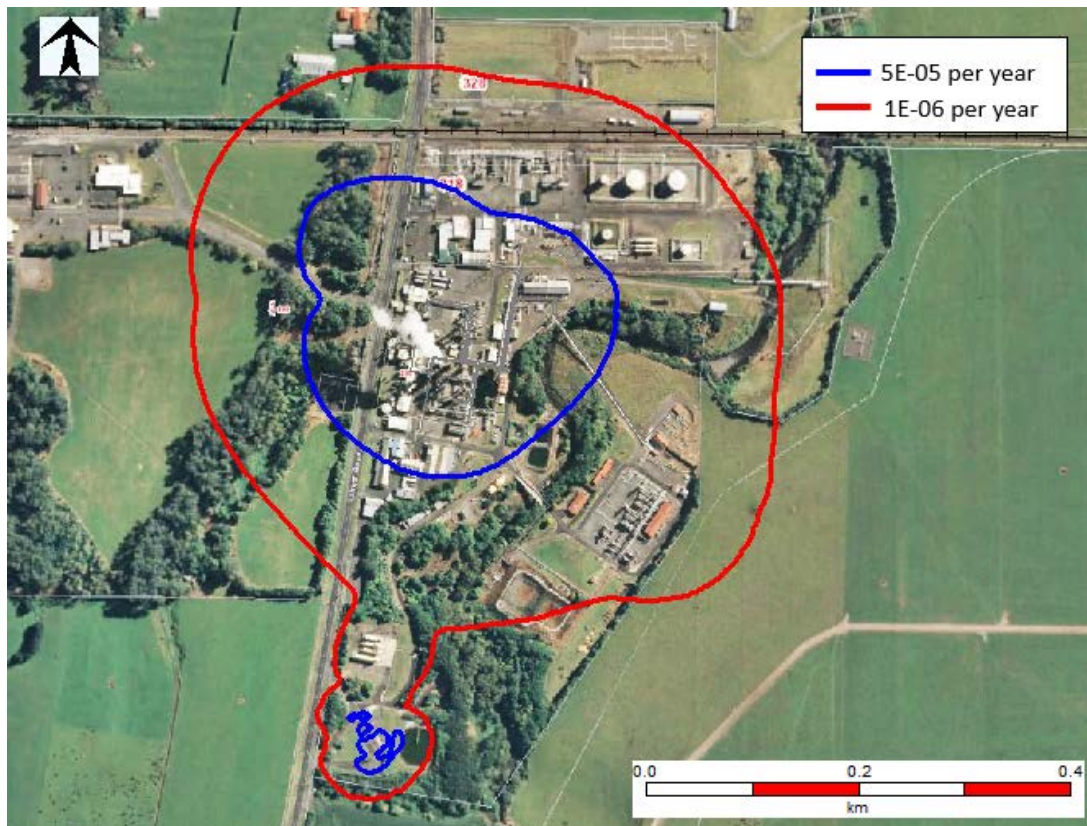


Figure 2: Sensitivity Case 1 LSIR Contours at KGTP

The 5E-05 per year and 1E-06 per year risk contours for Sensitivity Case 1 are similar to the Base Case risk contours. The assessment conclusions made against HIPAP 4 for Base Case are applicable to Sensitivity Case 1 as well. This is mainly due to:

- The ESDV failure probability change is only 2%, therefore the frequencies of hazardous events (fire explosion or toxic) associated with increased consequence distances (if any, from the additional inventory due to isolation failure cases) are not expected to be apparent in the risk contours; and
- In most modelling cases, especially gas releases, it is expected that the consequence effects would have reached the steady state condition before the inventory depletes. Hence the additional inventory may lead to a prolonged fire event, but not increase the magnitude of the consequence.

Risk contours for the Sensitivity Case 2 are presented in Figure 3.

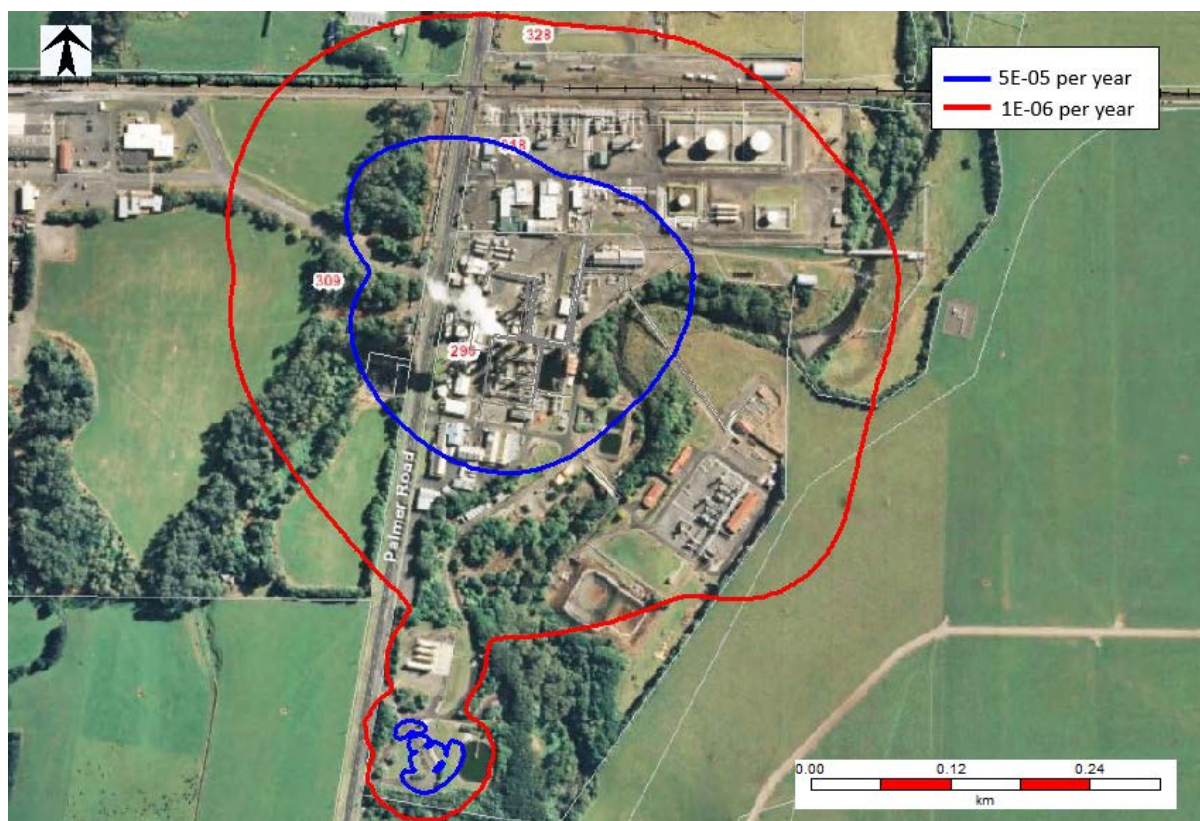


Figure 3: Sensitivity Case 2 LSIR Contours at KGTP

The risk contours of 5E-05 per year and 1E-06 per year for Sensitivity Case 2 are slightly larger, when compared to Base Case. This is particularly apparent at the LPG/NGL loading area at the southern edge of the KGTP site, which is due to the increased in loading frequencies for both the NGL and LPG loading scenarios. The increase in 5E-05 per year and 1E-06 per year contours do not change the assessment conclusions made against HIPAP 4 criteria. The assessment conclusions made against HIPAP 4 for Base Case are applicable to Sensitivity Case 2 as well.

Although there is additional equipment and inventories considered in Sensitivity Case 2, the increase in risk levels are not significant. This is most likely due to:

- The additional nodes/sections considered in Sensitivity Case 2 only formed a small part of the overall KGTP hazardous nodes/sections. There is approximately 18 % increase in total release frequency for Sensitivity Case 2 as compared to the Base Case, with 50% of the increase being from the “1-3 mm” leak category; and
- In most modelling cases, especially gas releases, it is expected that the consequence effects would have reached the steady state condition before the inventory depletes. Hence the additional inventory due to the higher throughput in Sensitivity Case 2 may lead to a prolonged fire event, but not increase the magnitude of the consequence.

1 ABBREVIATIONS

API	American Petroleum Institute
BLEVE	Boiling Liquid Expanding Vapour Explosion
CO ₂	Carbon Dioxide
DNV	Det Norske Veritas
DTL	Dangerous Toxic Load
ESDV	Emergency Shutdown Valve
FBR	Full Bore Rupture
FGL	First Gas Limited
GCPS	Global Congress on Process Safety
HCRD	Hydrocarbon Release Database
HIPAP4	NSW Hazardous Industry Planning Advisory Paper No. 4
HMB	Heat and Material Balance
IOGP	International Association of Oil and Gas Producers
IRPA	Individual Risk Per Annum
KGTP	Kapuni Gas Treatment Plant
KPS	Kapuni Production Station
LFL	Lower Flammable Limit
LPG	Liquefied Petroleum Gas
LSIR	Location Specific Individual Risk
MEM	Multi-Energy Method
NGL	Natural Gasoline
NH ₃	Ammonia
NIWA	National Institute of Water and Atmospheric Research Ltd
NZ	New Zealand
P&ID	Piping & Instrumentation Diagram
PFD	Probability of Failure on Demand
PHAST	Process Hazard Analysis Software Tool
SDV	Shutdown Valve
SLOT	Specified Level of Toxicity
SLOD	Significant Likelihood of Death
QRA	Quantitative Risk Assessment
RADD	Risk Assessment Database Directory
STDC	South Taranaki District Council
Todd	Todd Energy

KAPUNI GAS TREATMENT PLANT
QUANTITATIVE RISK ASSESSMENT REPORT

VCE	Vapour Cloud Explosion
Worley	Worley New Zealand Limited

2 INTRODUCTION

2.1 Background

A Quantitative Risk Assessment (QRA) was completed by Worley New Zealand Limited (Worley) for Kapuni Gas Treatment Plant (KGTP) in 2020 as requested by Todd Energy (Todd).

An Assumptions Register has been prepared and agreed with Todd [Ref. 1] prior to commencing the QRA to ensure all modelling inputs used represent the current processes and operating conditions of KGTP and assumptions made are reasonable.

This report presents the QRA methodology, modelling inputs, assumptions and risk results.

2.2 Objectives

The main objective of the study is to develop risk contours to assess land use compatibility in accordance with the NSW Hazardous Industry Planning Advisory Paper No. 4 (HIPAP 4) "Risk Criteria for Land Use Planning" [Ref. 8].

2.3 Scope

Facilities considered in the QRA include:

- CO₂ Removal Unit (Benfield);
- Dehydration and Dew Point Control Unit;
- Propane Refrigeration System;
- Liquefied Petroleum Gas (LPG) Production Unit;
- Storage tanks for LPG & Loadout Facility;
- Storage tank for Natural Gasoline (NGL) & Loadout Facility;
- Product Lines and Compressors;
- Cogeneration Area;
- Utilities;
- CO₂ Recovery Unit; and
- CO₂ Storage tanks & Loadout Facility.

2.4 Exclusions

The following facilities and scope of work are excluded from the QRA:

- Utilities such as instrument air and utility water as they do not contain any hydrocarbon inventory;
- The flare and blowdown;
- The impact from Ballance Agri-Nutrients and Kapuni Production Station (KPS) to KGTP. The cumulative risk considering both KGTP and KPS is discussed briefly in Section 9;
- Risk other than hydrocarbon/ process (e.g. transportation/ seismic/ volcanic risks);
- Societal Risk (F-N Curve); and
- Occupied building risk assessment.

2.5 QRA Study Cases

The QRA study includes base case and sensitivity cases assessment to study the impact of certain assumptions and/or plant operating capacity on the risk results. The QRA Base Case includes the assessment of current KGTP operation with a set of agreed modelling assumptions detailed in Section 4.2.

The two sensitivity cases considered in the KGTP QRA are:

- Sensitivity Case 1: 98% ESDV Success Probability; and
- Sensitivity Case 2: Future Operations.

The details of Base Case, Sensitive Case 1 and Sensitivity Case 2 are summarised in Table 2-1.

Table 2-1: KGTP QRA Base Case, Sensitivity Case 1, Sensitivity Case 2 Comparison

QRA Case	Details	Potential Impact
Base Case	<ul style="list-style-type: none"> • Current plant operation with 2 Benfield nominal throughput (12 Sm³/s), includes all Operating units summarised in Table 3-2 • Assumed ESDV system has 100% isolation success probability 	-
Sensitivity Case 1 (98% ESDV Success Probability)	<ul style="list-style-type: none"> • Current plant operation with 2 Benfield nominal throughput (12 Sm³/s), includes all Operating units summarised in Table 3-2 • Assumed ESDV system has 98% success probability 	<ul style="list-style-type: none"> • Increased release inventories during ESDV failure, i.e. 2% of the time. The volume for each isolatable section is added with the next biggest connecting isolation inventory
Sensitivity Case 2 (Future Operation)	<ul style="list-style-type: none"> • Maximum throughput operation (29 Sm³/s) for future operation after the Kapuni development project, includes all Operating, Mothballed and Standby units summarised in Table 3-2 • Assumed ESDV system has 100% isolation success probability (noting that the 100% and 98% scenarios give very similar results) 	<ul style="list-style-type: none"> • Additional equipment considered in the QRA model • Increased in inventory for each isolatable section due to increase in throughput • Increased in total leak frequency

3 FACILITY AND PROCESS OVERVIEW

3.1 Facility Overview

Kapuni is an onshore gas and condensate field located in South Taranaki, approximately 50 km south of New Plymouth and 14 km northwest of Hawera. Throughout the Kapuni gas field, there are feeder well-sites which deliver raw Kapuni gas to Kapuni Production Station (KPS) and KGTP. The well sites, KPS and KGTP are owned and operated by Todd. Todd recover hydrocarbon condensate from the raw gas at KPS. The remaining raw gas is delivered via pipeline from KPS to KGTP.

KGTP is located directly to the south of KPS, with a fence separating the two facilities. Ballance Agri-Nutrients plant is located to the west of the KGTP. The locations of these sites land area are shown in Figure 3-1:



Figure 3-1: Map Showing Locations of KPS, KGTP and Ballance Sites

Raw Kapuni gas has a very low heating value due to it containing about 40-46 mol% Carbon Dioxide (CO₂). Consequently, this gas needs to be treated at KGTP so that the natural gas meets the New Zealand (NZ) specification for reticulated natural gas and can, therefore, go into the NZ open access gas transmission network owned by First Gas Limited (FGL).

Overview site plans of KGTP are shown in Figure 3-2 to Figure 3-4, and Table 3-1 shows the description of each area.

Table 3-1: KGTP Area Description

Area	Description
1	CO ₂ Removal
2	Dehydration and Dewpoint Control
3	Refrigeration
4	LPG Production
5	Product Lines and Compressors (West)
6	Product Lines and Compressors (East)

KAPUNI GAS TREATMENT PLANT
QUANTITATIVE RISK ASSESSMENT REPORT

Area	Description
7	LPG Storage
8	LPG Loadout
9	Product Gas Storage Compressors (East)
10	Flare (East)
11	Flare (West)
12	Steam Boilers
13	CO ₂ Recovery
14	Alkali Storage
15	LTS Road Bridge
16	LTS Pipe Bridge
17	Methanol Storage

**KAPUNI GAS TREATMENT PLANT
QUANTITATIVE RISK ASSESSMENT REPORT**



Figure 3-2: Kapuni Gas Treatment Plant Plot Plan (Main Process Area)

KAPUNI GAS TREATMENT PLANT
QUANTITATIVE RISK ASSESSMENT REPORT

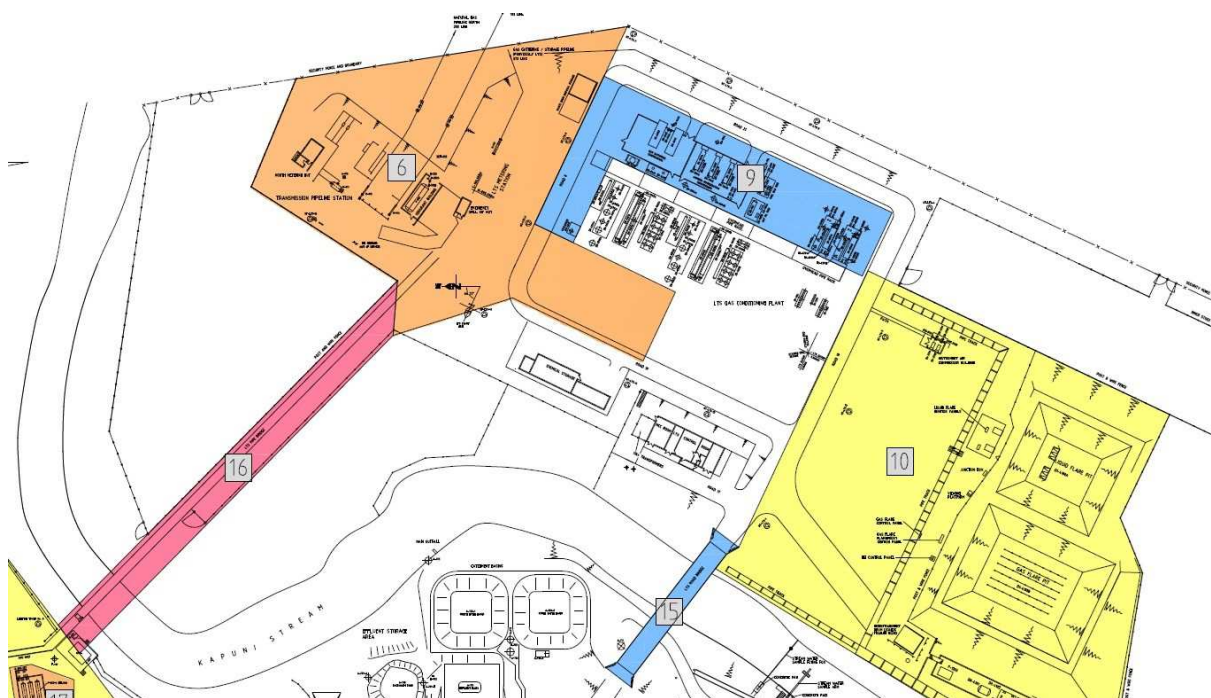


Figure 3-3: Kapuni Gas Treatment Plant Plot Plan (Product Gas Compression Unit and Flare Pits)

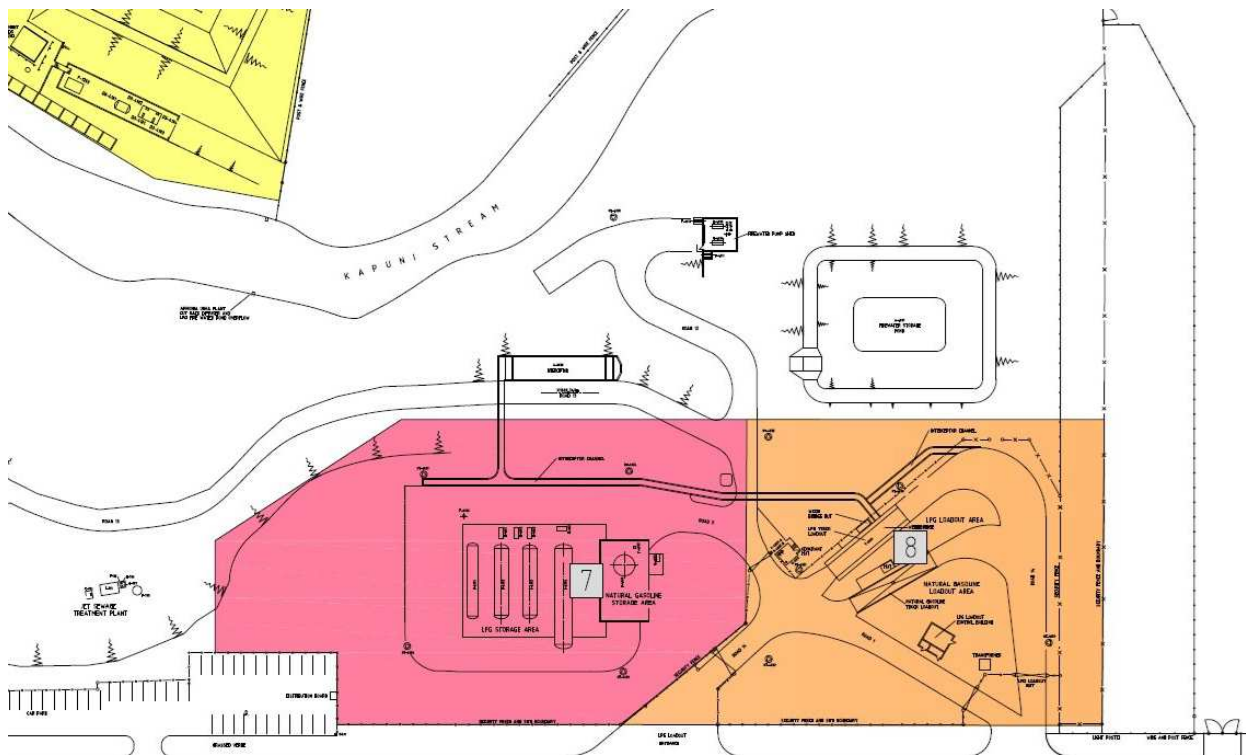


Figure 3-4: Kapuni Gas Treatment Plant Plot Plan (LPG Storage and Loadout Area)

3.2 Process Overview

The generalised gas treatment process in KGTP involves the following steps:

- a) Removal of the bulk of the CO₂ via a recirculating Benfield hot potassium carbonate process so that the gas meets the acceptable specifications for energy content.
- b) Removal of water by contact with methanol and then chilling using propane refrigerant to meet the water content and hydrocarbon dewpoint specifications.
- c) Removal of a large proportion of the heavier hydrocarbon components in the above chilling stage, followed by separation to produce Liquefied Petroleum Gas (LPG) and Natural Gasoline (NGL) for export/sale.
- d) Compression and metering of treated spec gas to transfer into the transmission network. Note that the Product Gas Compressor system is a First Gas asset but can be controlled from KGTP.
- e) CO₂ collected from Benfield Process is processed into liquid CO₂, using an ammonia refrigeration system and transferred to storage tanks for export/sale.

The KGTP process overview is shown in Figure 3-5.

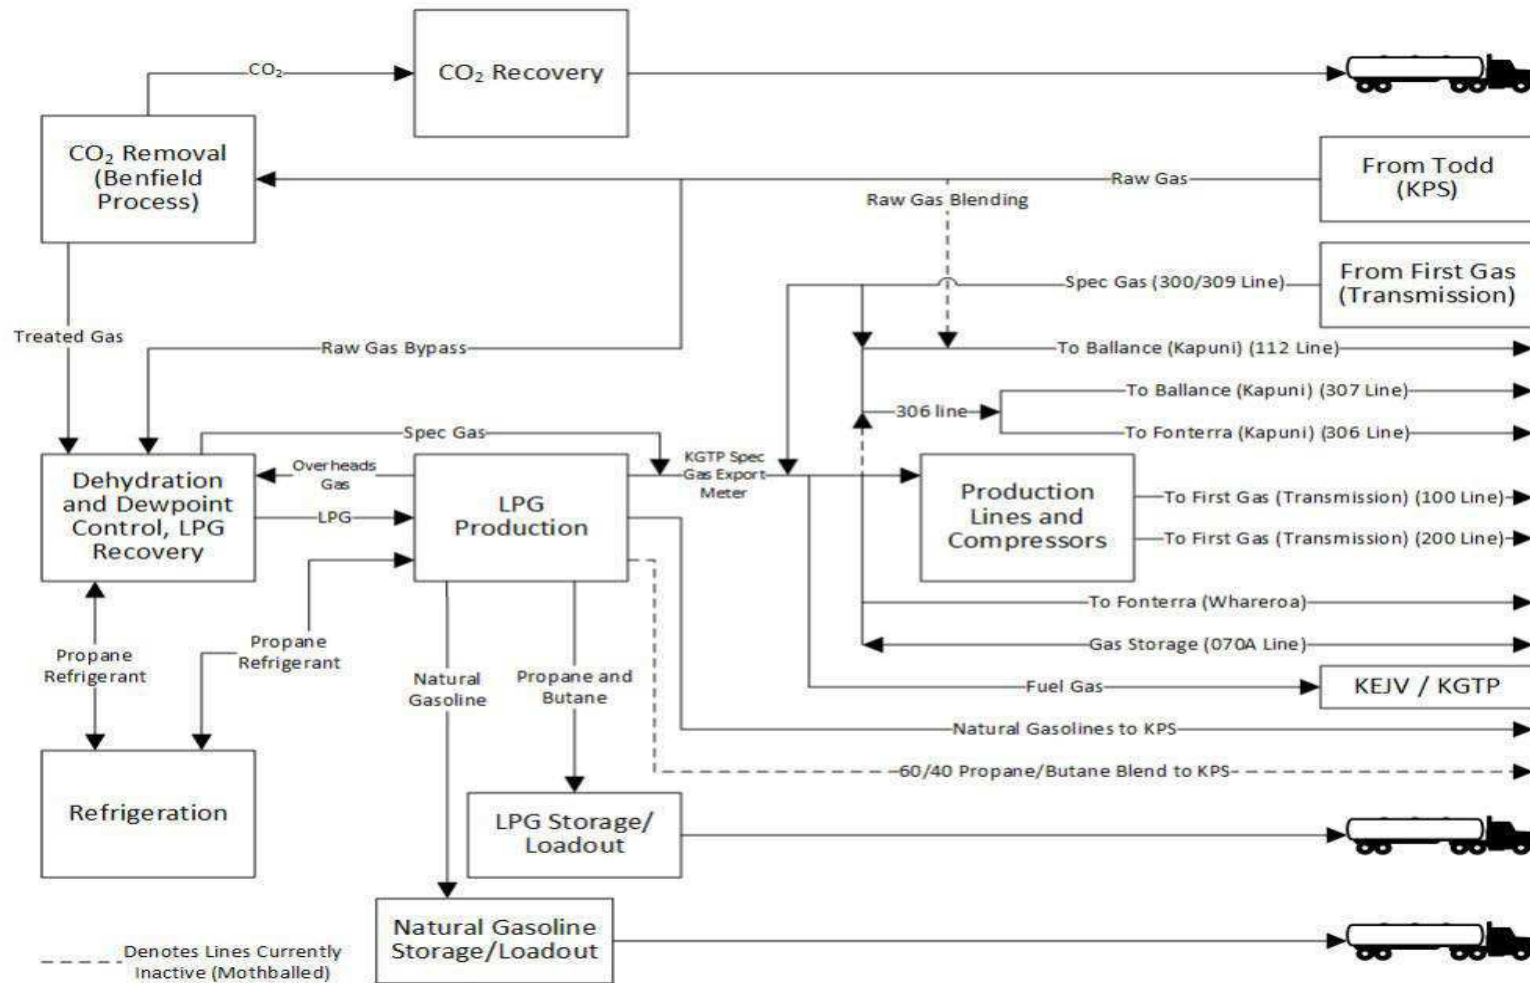


Figure 3-5: Kapuni Gas Treatment Plant Process Overview

3.3 Plant and/or Equipment Operational Status

Not all plant and equipment in the KGTP site are currently in operation. The four plant and equipment status categories defined by Todd are as follow:

- **Operating:** All plant and / or equipment that are currently in operation to achieve an outcome for the business.
- **Standby:** All plant and / or equipment that are ready to start when the operating plant and / or equipment unit stops.
- **Mothballed:** All plant and / or equipment that are unlikely to be used for achieving any business outcome in the near future. They are positively isolated from all upstream and downstream process systems. Blinds, spades or spacers are installed at all the points of disconnection from live process systems. All systems are electrically isolated and earthed. The plant and / or equipment is preserved to maintain it in a satisfactory condition.
- **Abandoned:** All plant and / or equipment that are unlikely to be used for achieving any business outcome in the foreseeable future. They are positively isolated and physically disconnected from all upstream and downstream process systems with a visible air gap present to prove positive isolation but maintain physical position on site. Blinds are installed at all the points of disconnection from live process systems. All systems are electrically isolated / disconnected as appropriate. Plant or equipment is not maintained or preserved.

The operational status of process plants / units in KGTP are summarised in Table 3-2.

Table 3-2 : KGTP Plants/Units Operational Status

Plant/Unit		Operational Status	Considered in QRA?
CO ₂ Removal Unit (Benfield)	Train 1, 2	Operating	Yes
	Train 3	Mothballed ^{Note1}	Yes (Sensitivity case 2) ^{Note 1}
Dehydration and Dew Point Control Unit	No. 2 Chilling System	Operating	Yes
	No. 1 Chilling System	Standby ^{Note2}	Yes (Sensitivity case 2) ^{Note 2}
Propane Refrigeration System		Operating	Yes
LPG Production Unit	Train 1	Standby ^{Note2}	Yes (Sensitivity case 2) ^{Note 2}
	Train 2	Operating	Yes
LPG Storage & Loadout Facility		Operating	Yes
<ul style="list-style-type: none"> • 60/40 Condensing Tank 		Mothballed ^{Note 6}	Yes (Sensitivity case 2) ^{Note 6}
Natural Gasoline Storage & Loadout Facility		Operating	Yes
Product Lines and Compressors		Operating	Yes
<ul style="list-style-type: none"> • Stab Gas Compressor • CNG Compressor • No.4 Product Gas Compressor 		Abandoned ^{Note 3}	No
Gas Gathering Facility		Operating	Yes
Cogeneration Area		Operating	Yes
CO ₂ Recovery Unit		Operating	Yes
Utilities		Operating	Yes

Plant/Unit	Operational Status	Considered in QRA?
<ul style="list-style-type: none"> Boilers (B-901-1/2/3) De-aerator (E-901-1) 	Mothballed ^{Note 4}	Yes (Sensitivity case 2) ^{Note 4}
<ul style="list-style-type: none"> Demin Plants 1&2 	Abandoned ^{Note 3}	No
LTS Conditioning Unit	Abandoned ^{Note 5}	No ^{Note5}

Notes:

1. Benfield train 3 is mothballed and considered in QRA as Sensitivity case 2.
2. One out of two trains of the Dehydration and Dew Point Control Unit and the LPG Production Unit are currently on standby and considered in QRA as Sensitivity case 2.
3. Equipment is abandoned and will never be recommissioned, therefore not considered in QRA.
4. Boilers and de-aerator are mothballed, and the fuel gas lines are blinded off. One boiler is not in the condition that could be easily restarted but two can be brought back online fairly easy. Therefore, only two boilers are considered in QRA as Sensitivity case 2.
5. The LTS gas conditioning unit is in an abandoned condition which would require significant remedial work prior to recommissioning, therefore not considered in the study. However, a few live product gas lines and Gas Storage Compressors (D4-0401/0402) in this area, are considered in QRA.
6. 60/40 LPG line is mothballed and is considered in QRA as Sensitivity Case 2.

The QRA study considers current KGTP operation as Base Case. Risk levels considering equipment to be use for future production are considered in the Sensitivity Case 2 assessment.

4 STUDY METHODOLOGY AND ASSUMPTIONS

The methodology followed for completing the QRA is aligned with good industry practice and the Todd Energy Fire and Explosion Analysis and Quantitative Risk Assessment Methodology Guideline [Ref. 2]. The generic process, specified in the Worley’s Onshore QRA Method Statement [Ref. 3], is illustrated in Figure 4-1 with the minor modification in that this study does not include the provision of risk mitigation measure recommendations.

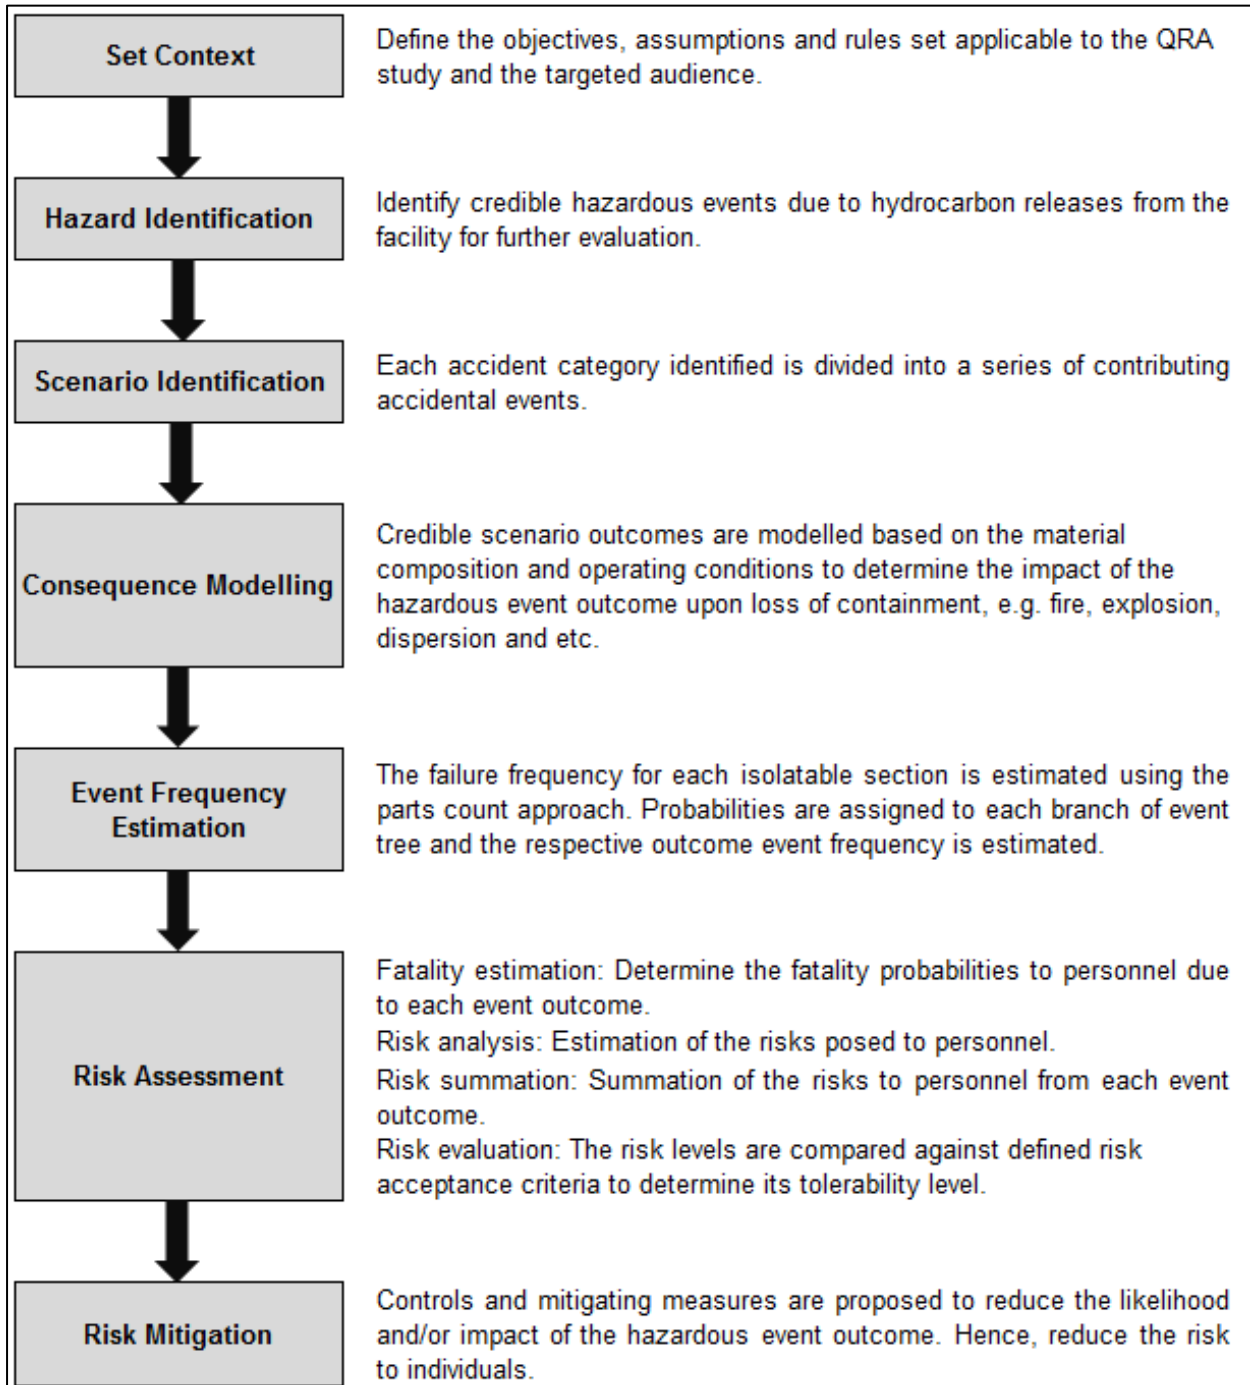


Figure 4-1: QRA Methodology

4.1 Assessment Tool

DNV Safeti Software version 8.22 [Ref. 6] is used to build the QRA model. Safeti is an integrated consequence and risk modelling package developed by DNV Software aimed at the onshore petrochemical and chemical process industry for assessing process plant risks via comprehensive QRA. It is designed to perform all the analytical, data processing and results presentation elements of a QRA within a structured framework.

4.2 QRA Assumptions

An Assumptions Register [Ref. 1] was generated which outlines the basis of all assumptions and the input bases inherent in the QRA study. Key assumptions are shown in the following subsections for reference.

4.2.1 Atmospheric Conditions

Meteorological conditions impact the outcomes of release modelling, including downwind flammable and toxic vapour cloud dispersion distance (influenced by atmospheric stability and wind speed), rate of pool vaporisation (ambient temperature), and atmospheric attenuation of radiant heat (temperature and relative humidity).

The following conditions are used as basis in the QRA modelling.

Wind Speed and Direction

Wind speed and direction data are taken from NIWA's Cliflo database [Ref. 19] for the Hawera Automatic Weather Station to represent the atmospheric conditions at KGTP. Data for 5-year period from January 2008 to December 2012 are taken, with wind speed and direction measurements taken every hour. The wind rose is shown in Figure 4-2.

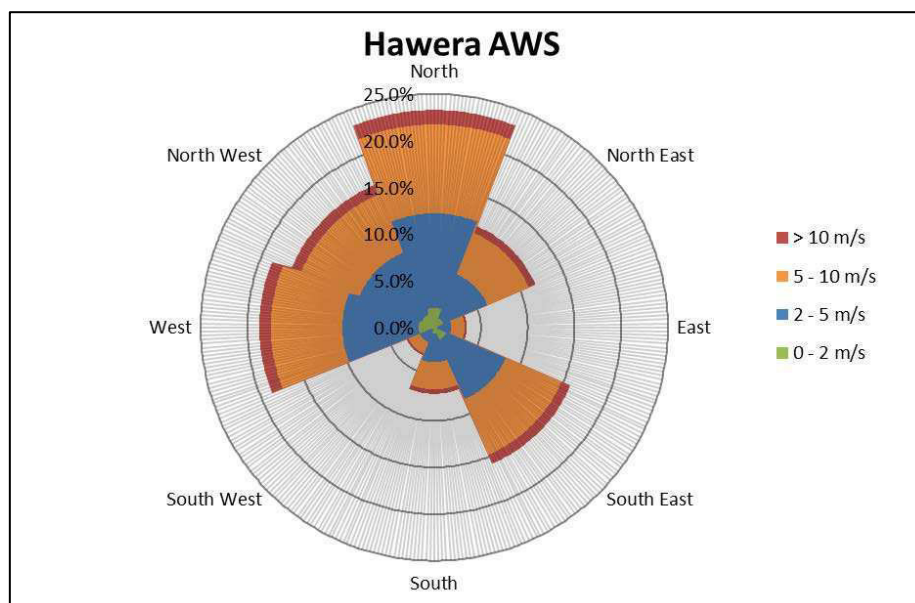


Figure 4-2: Hawera AWS Windrose

The following combinations of wind speed and atmospheric stability is used in the QRA model to represent the typical wind speed conditions around the plant area:

- 2/F – wind speed of 2 m/s with Pasquill Stability class F – stable, night with moderate clouds and light/moderate wind
- 5/D – wind speed of 5 m/s with Pasquill Stability class D – neutral, little sun and high wind or overcast/windy night

- 10/D – wind speed of 10 m/s with Pasquill Stability class D – neutral, little sun and high wind or overcast/windy night

For the modelling, wind speed reference height (the height at which the wind impacts a release) is set at 1 m (i.e. so as to match the release height). The Power Law wind profile is applied, where the wind speed varies with height according to power-law profile.

By consideration of the Pasquill Stability class relationship with day and night and wind speeds, the wind data for use in the QRA model is calculated as shown in Table 4-1.

Table 4-1: Hawera AWS Wind Data

Wind Speed / Pasquill Stability	North	North East	East	South East	South	South West	West	North West	Total
0 - 2 m/s / F	2.1%	1.1%	0.3%	1.4%	0.6%	0.3%	1.7%	1.5%	9.0%
2 - 5 m/s / D	10.1%	5.1%	1.5%	6.9%	3.1%	1.4%	8.2%	7.2%	43.5%
5 - 10 m/s / D	11.1%	5.6%	1.7%	7.5%	3.4%	1.5%	8.9%	7.9%	47.5%
Total	23.3%	11.8%	3.5%	15.9%	7.1%	3.2%	18.7%	16.5%	100.0%

Ambient Temperature and Relative Humidity

The following ambient temperature and relative humidity are used in the QRA:

- Ambient temperature: 14°C
- Relative humidity: 83%

Solar Radiation

The allowance for solar radiation has been excluded from the calculations.

Topography

Safeti cannot take into account the effects of the local undulating topography for the gas dispersion. The surface roughness of 0.1 m is applied to represent an area of “low crops, occasional large obstacles”.

4.2.2 General Leak Frequency

The leak frequencies for process equipment in general are taken from the International Association of Oil and Gas Producers (IOGP) Risk Assessment Data Directory (RADD) Process Release Frequency [Ref. 12]. Where IOGP data does not cover such as storage vessels, TNO Purple book failure data [Ref. 10] was used. The details are provided in the Assumptions Register [Ref. 1].

4.2.3 Release Hole Sizes

For every component failure, there is a range of credible hole sizes ranging from pinhole leak to full bore rupture. In general, the representative hole sizes used in the QRA is as shown in Table 4-2.

Selected representative holes sizes were chosen using the geometric mean of the smallest and largest hole size in each group. For example, the representative hole size for the range 10 – 50 mm is calculated as $(10 \times 50)^{0.5} = 22$ mm. The use of geometric mean is also aligned with the recommendation in the latest OGP Process Release Frequency [Ref. 12].

Table 4-2: Hole Size Distribution

OGP Hole Size Group (mm)	Representative Hole Size (mm)
1 - 3	2
3 - 10	6
10 - 50	22
50 - 150	85
> 150	Range geometric mean

22 mm is used as the maximum hole size for small bore fittings. The maximum hole size for a flange is also limited to 22 mm as a release from a flange is normally limited to a segment of a gasket between bolts [Ref. 2].

It is noted for equipment referencing TNO Purple Book [Ref. 10] failure data, actual hole sizes following the failure data is used as there are no sufficient leak size distribution data in Purple Book to calculate the geometric mean.

4.2.4 Leak Frequency Modification Factor

Several leak frequency modification factors are applied to the release frequency database as per the Assumption Register [Ref. 1] and Todd Energy's Methodology Guideline [Ref. 2].

Table 4-3: Leak Frequency Modification Factor

Type of Release		Reduction in frequencies
Piping Release Frequency	Process Piping	-
	Inter-unit Piping	90%
Rupture Release Frequency	Full bore rupture	52%

For KGTP, process (on skid) piping are considered for pipework which connect equipment within the unit boundary while inter-unit piping is considered for piping which connects different units within the KGTP site.

4.2.5 Isolation Success Probability

The Emergency Shutdown (ESD) systems are intended to shut down and isolate the process inventories to reduce damage or risk of escalation. When activated, emergency shutdown valves (ESDVs) divide the process system into a number of isolatable sections, with each potential leak source associated with a particular isolatable inventory.

In this KGTP QRA, 100% ESDV success probability is assumed for the Base Case inventory consideration.

4.2.6 Ignition Probabilities

For KGTP QRA, the Energy Institute (EI) ignition probability model referenced in OGP Ignition Probabilities [Ref. 14] is used for the estimation of overall ignition probability of loss of containment scenarios.

For this QRA, the following ignition scenarios are used [Ref. 14]:

- Scenario 8 – Large Plant Gas LPG (Gas of LPG release from large onshore plant) – Releases of flammable gases, vapour or liquids significantly above their normal (NAP) boiling point from large onshore outdoor plants (plant area above 1200 m², site area above 35,000 m²).

- Scenario 9 – Large Plant Liquid (Liquid release from large onshore plant) – Releases of flammable liquids that do not have any significant flash fraction (10% or less) if released from large onshore outdoor plants (plant area above 1200 m², site area above 35,000 m²) and which are not banded or otherwise contained.
- Scenario 13 – Tank Liquid 100 m x 100 m Bund (Liquid release from onshore tank farm where spill is limited by small or medium sized bund) – Releases of flammable liquids that do not have any significant flash fraction (10% or less) if released from onshore outdoor storage area ‘tank farm’ (e.g. spill in a large tank bund containing four or fewer tanks, or any other bund less than 25,000 m² area).

The graphs of ignition probabilities as a function of mass release rate are shown in Figure 4-3.

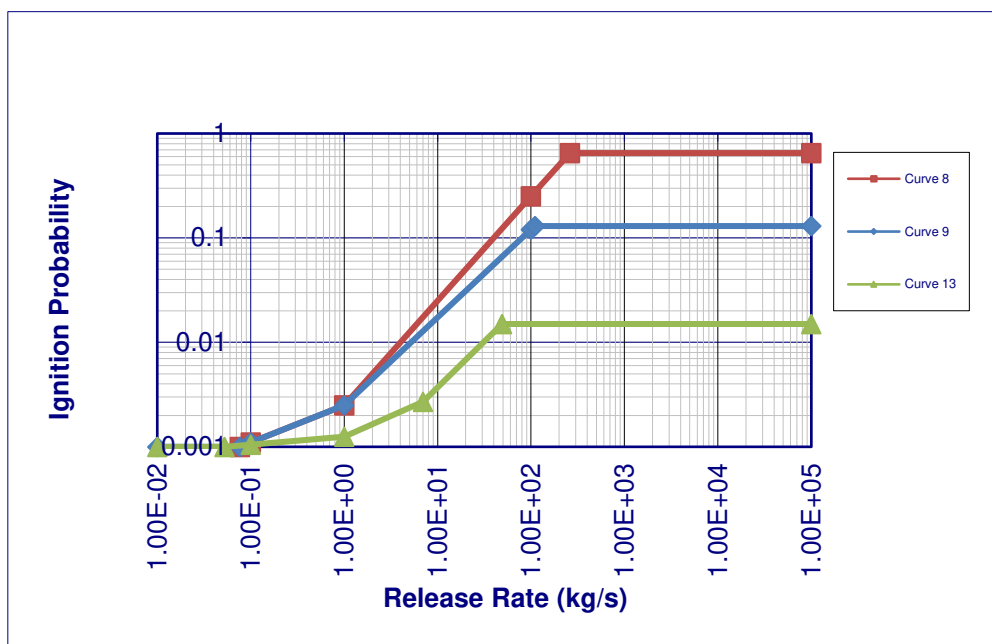


Figure 4-3 Ignition Probability

Early and Delayed Ignition Probabilities

The graph presented in Figure 4-3 represents the total ignition probability. An overall distribution for early to delayed ignition ratio of 30:70 to 50:50 split is considered reasonable. The timing of ignition is used as a means to predict the nature of the ignited event. Early ignition is taken to indicate a jet fire or pool fire depending on the material released. Delayed ignition is taken to indicate that the ignition would initially result in a flash fire or explosion.

For this study, a 30:70 split for early to delayed ignition probability is used. Given the maturity of the hazardous area and ignition control measures in place on KGTP site, it can be assumed that 70% of releases will not find an ignition source in the immediate area of the release and therefore will have a delayed ignition.

Explosion Probabilities

For this QRA, the generic explosion probabilities shown in Table 4-4 is used [Ref. 15].

Table 4-4: Explosion Probabilities

Release Rate Category	Release Rate (kg/s)	Explosion Probability given ignition
Minor	<1 (0.5 nominal)	0.04
Major	1-50	0.12
Massive	>50 (100 nominal)	0.3

4.2.7 Congested Areas

Flammable vapour cloud accumulation at congested area(s) is a prerequisite to initiate a Vapour Cloud Explosion (VCE).

KGTP is generally open with good ventilation expected throughout the year. However, some areas around the process plants can be quite congested due to the size and arrangement of process equipment/ vessels/ piping. These areas are identified as congested areas and shown in Figure 4-4.

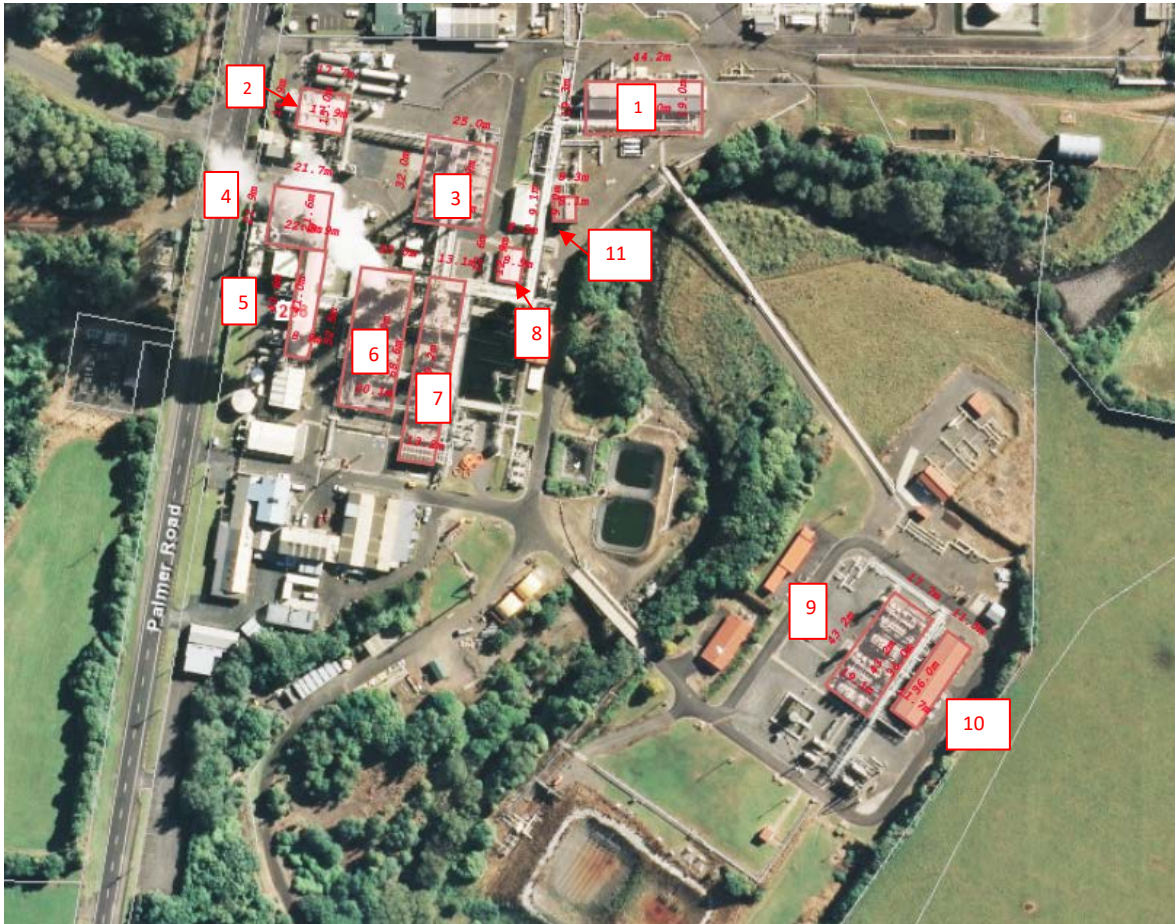


Figure 4-4: KGTP Congested Area

The estimated volume of each congested area is given in Table 4-5.

The VCE impacts are estimated using “Multi Energy Model” in Phast/Safeti, where the explosion overpressure is modelled based on blast strength of each congested area. The blast strength class assumed for each congested area is summarised in Table 4-5. Details and basis of the “Multi Energy Model” congested area parameters are provided in Assumptions Register [Ref. 1].

Table 4-5: Volume and Blast Strength Index of the Congested Areas

No.	Description	Volume (m ³)	Blast Strength Class
Congested Area 1	Gas Compression Area Compressor Shed	5,852	5
Congested Area 2	CO ₂ Recovery Area Compressor Shed	1,350	5
Congested Area 3	LPG Production Process Area	2,400	5
Congested Area 4	Cogeneration Process Area	2,904	5

No.	Description	Volume (m ³)	Blast Strength Class
Congested Area 5	Boiler House	3,321	5
Congested Area 6	Gas Treatment Process Area 1	3,180	5
Congested Area 7	Gas Treatment Process Area 2	2,691	5
Congested Area 8	OVHD Compressor Shed	585	5
Congested Area 9	LTS Conditioning Process Area	2,451	3
Congested Area 10	LTS Gas Conditioning Compressor House	2,592	5
Congested Area 11	Stab Gas Compressor Shed	432	5

It is noted that VCE is performed with a “black box” calculations in the Safeti model. Safeti estimates explosion risk based on percentage fill of the identified congested areas, taking into account of the flammable gas cloud dispersion from all release scenarios within KGTP. The software however does not report the eventual percentage filled in each identified congested area used for the explosion fatality risk modelling.

4.2.8 Fatality Criteria

Heat Radiation

The method of calculating the probability of fatality for an individual, given known exposure duration and thermal heat radiation levels, is undertaken by using a Probit function. The Probit function is a general formula which takes the same form, but with various constants used. The Probit used for lethality calculations is taken from the TNO Green Book [Ref. 11]. The Probit function is defined as follows:

$$\text{Probit} = -36.38 + 2.56 \ln (t \times q^{4/3})$$

Where:

t = exposure duration in seconds

q = thermal radiation level in W/m²

Safeti calculates the Probit values during the analysis.

An exposure duration of 20 seconds is used as a base case, although it is noted that personnel are likely to find some form of shielding protection within this time frame.

Flash Fire

If personnel are within the 100% lower flammable limit (LFL) of the gas plume, 100% fatality is assumed. LFL is the lower end of the concentration range over which the flammable mixture of a gas/ vapour in air can be ignited at a given temperature/ pressure.

A flash fire occurs when a dispersed cloud of flammable gas or vapour and air mixture is ignited within its flammable regions, causing a wall of flame to spread throughout the flammable region and back to the release point. The flame propagates through the cloud in a manner such that negligible or no damaging overpressure is generated. This flash is almost instantaneous as the flame propagates at high speed through the cloud and back to the source.

An assumption of 100% fatality rate within the footprint of the cloud is conservative and does not allow for potential risk reducing considerations such as;

- uneven mixing of gas and air in the cloud resulting in uneven propagation of the flame;
- topography;
- sparsely populated rural land use adjoining the site;

- availability of shelter;
- opportunity for escape; and
- clothing worn by persons exposed to the flash fire.

Thermal radiation outside of the flash fire falls off rapidly and is not sustained due to the instantaneous nature of the event. The potential for fatality outside the flash fire footprint is not considered credible.

Explosion Overpressure

The “Multi-Energy Explosion” model is used to model the congested area Vapour Cloud Explosion (VCE). The assessment criteria for explosion overpressure effects are based on the explosion effects taken from the HIPAP4 [Ref. 8] as given in Table 4-6.

Table 4-6: Effects of Explosion Overpressure

Explosion Overpressure (kPa)	Effects
3.5	No fatality and very low probability of injury
7	Probability of injury is 10%. No fatality
21	20% chance of fatality to a person in a building
35	50% chance of fatality for a person in a building and 15% chance of fatality for a person in the open
70	Threshold of lung damage 100% chance of fatality for a person in a building or in the open

Note: The two overpressure levels in bold are considered in the QRA as the fatality probabilities for personnel in the open.

BLEVE

Boiling Liquid Expanding Vapour Explosion (BLEVE) is an escalation scenario that occurs as a result of prolonged flame impingement on above ground pressurised vessels containing materials such as liquefied petroleum gas (LPG) or lighter end hydrocarbon. BLEVE would result in an explosion overpressure together with a fireball and missile generation over some distance. As the fireball tends to drift upward and to avoid double counting, only the explosion overpressure effects are considered in the QRA. The fatality criteria for BLEVE explosion are referenced from Table 4-6 above.

For KGTP study, BLEVE is considered credible if a pressurised vessel contains at least 4 m³ of volatile hydrocarbon (liquid butane or lighter). The BLEVE scenarios considered in the KGTP QRA study are shown in Table 4-7. These vessels are above ground vessels and no credit is taken for the available firefighting provisions (e.g. deluge).

Table 4-7: Vessels Considered for BLEVE in KGTP

Equipment Tag no.	Description	V/H Note 2	Material ^{Note1}	Equip. Volume (m ³)	Liquid Inventory (m ³)
D-420-2	De-Ethaniser	V	K402	33.5	16.75
D-420-1	Stabiliser	V	K402	10.3	5.15
D-430-2	De-Propaniser	V	K404	20.9	10.45
D-430-1	De-Propaniser	V	K404	14.3	7.15
F-4003	Propane Storage Vessel	H	Propane	113	51.32 ^{Note 3}
F-4004	Propane Storage Vessel	H	Propane	230	106.59 ^{Note 3}

Equipment Tag no.	Description	V/H Note 2	Material ^{Note1}	Equip. Volume (m ³)	Liquid Inventory (m ³)
F-4001	Butane Storage Vessel	H	Butane	66	51.29 ^{Note 4}
F-4002	Butane Storage Vessel	H	Butane	113	44.45 ^{Note 4}
F-315	Propane Refrigerant Surge Drum	H	Propane	9.2	4.6
D-315-2	Propane Refrigerant Economiser	H	Propane	17.6	5.3

Notes:

1. Material composition is provided in Assumptions Register [Ref. 1].
2. V - denotes vertical vessel, H - denotes horizontal vessel.
3. Mass inventory values (26 tonnes, 54 tonnes) were converted to volume respectively using Propane density of 506.6 kg/m³ at 2 barg, 15°C [Ref. 6].
4. Mass inventory values (30 tonnes, 26 tonnes) were converted to volume respectively using Butane density is 585.0 kg/m³ at 2 barg, 15°C [Ref. 6].

Toxic Effects

Fatality probabilities when exposed to toxic gas as a function of concentration and exposure duration can be calculated by using a probit function in the form given below:

$$\text{Probit} = a + b \ln(C^n \cdot t)$$

where:

t = exposure durations in minutes

C= concentration in ppm

a, b and n = material specific probit constants

The toxic materials handled onsite include:

- Ammonia;
- Methanol;
- Ethyl Mercaptan (odorant);
- t-Butyl Mercaptan (odorant); and
- Carbon Dioxide.

UK HSE [Ref. 20] gives the following toxic load values for toxic materials as shown in Table 4-8.

Table 4-8 : UK HSE Dangerous Toxic Load (DTL) for Specified Level of Toxicity (SLOT) and Significant Likelihood of Death (SLOD) Values

Material	n	SLOT DTL (ppm ⁿ ·min)	SLOD DTL (ppm ⁿ ·min)
Ammonia	2	3.78 x 10 ⁸	1.03 x 10 ⁹
Methanol	1	8.02 x 10 ⁵	2.67 x 10 ⁶
Ethyl mercaptan	1	1.66 x 10 ⁵	6.62 x 10 ⁵
t-Butyl mercaptan	1	9.9 x 10 ⁵	3.96 x 10 ⁶
Carbon Dioxide	8	1.5 x 10 ⁴⁰	1.5 x 10 ⁴¹

By solving the simultaneous equation, the other constants a and b can be calculated. The probit constants for toxic materials onsite are shown in Table 4-9.

Table 4-9 : Probit Constants

Material	a	b	n
Ammonia	-43.24	2.32	2
Methanol	-23.67	1.94	1
Ethyl mercaptan	-17.58	1.68	1
t-Butyl mercaptan	-20.53	1.68	1
Carbon Dioxide	-90.94	1.01	8

4.3 Vapour Cloud Explosion and UK HSE Research Report RR1113 Findings

The UK Buncefield Oil Depot explosion and fire in December 2005 is of particular interest for sites with vapour cloud explosion (VCEs) potential. UK HSE Research Report RR1113 (Review of Vapour Cloud Explosion Incidents) [Ref.22] describes post-Buncefield work undertaken by the UK HSE (along with US safety regulators) to consolidate previous research and analysis on vapour cloud development and explosions into a single review of historical incidents.

The review focusses on source terms, cloud development and explosion mechanics for both permanent fuel gases C2-C4 (e.g. LPG) and volatile liquids C4-C6 (e.g. gasoline). The report notes that, once a stable current of cold heavy vapour forms, the subsequent development of LPG and gasoline clouds are similar [Ref.22]. Those operating sites handling LPG should therefore be interested in records of vapour cloud development and VCEs at gasoline sites and vice versa.

There is one gasoline tank (F-4033) at the KGTP site. However, the tank has a volume of 65 m³ and filling rate of approximately 2 m³/hr, which is much lower than the 100 m³/hr “in-scope tank” criteria for Buncefield type overflow scenarios consideration [Ref. 24]. The Buncefield type overflow scenario assessment is therefore not addressed in this report.

The KGTP site handles and stores LPG, and it is acknowledged that the LPG spray releases could potentially form large vapour clouds under nil/ very low wind conditions (< 1.3m/s).

RR1113 notes that under nil / very low wind speed conditions (<1.3 m/s) vapour dispersion will be gravity-driven, and the vapour cloud will continue to grow for as long as the release continues (spreading out in all directions and/or following any downward slopes around the release source).

These large vapour clouds are almost certain to ignite, and the probability of a severe explosion event (open area VCE) is high, especially for gasoline. However, for LPG incidents, it is suggested that the clouds formed can be very rich or even over the upper flammability limit (UFL) and as such the risk of an open area VCE is most likely less than 50%. RR1113 concluded that additional experimental and modelling work is required determine what kind of LPG spray releases in nil/very low wind conditions could results in clouds within the flammable range.

The report also concludes that although the transition to a severe explosion seems to involve some degree of congestion or confinement as an initiator, the overpressure effects are not limited to areas of congestion or confinement. The report suggests that overpressures in this scenario could be in excess of 2000 mbar, with 100% fatalities throughout the extent of the large flammable cloud at time of ignition.

However, at this point in time, the explosion propagation mechanism through open/uncongested areas is subjected to considerable academic debate, and there are no commonly available methods to reproduce these specific conditions and subsequent high levels of overpressure with current industry standard explosion models (e.g. Multi Energy Method). Furthermore, the UK HSE Vapour Cloud Assessment (VCA) method provided in RR908 / FABIG 12 [Ref.26, 27] addresses gasoline overflow, but does not address LPG releases. As such, the LPG vapour cloud formation under nil/ very low wind conditions have not been quantified in this QRA.

The findings of RR1113 are highlighted in this assessment to reinforce the maintenance of plant integrity as critical risk reduction measures and suggest that the value of mitigation measures such as vapour detection should be reviewed. Site emergency response planning should take into consideration the LPG vertical spray release scenarios under nil / very low wind conditions.

5 HAZARD IDENTIFICATION

5.1 Hazardous Materials

The material compositions used in the QRA modelling are based on information and confirmation provided by Todd [Ref. 4, 5, 16].

Any stream that will generate different consequences is represented by different sections. For node sections with similar operating conditions or fluid composition that will generate similar consequence results, the stream which results in worst case result is selected as representative to rationalise the number of scenarios performed. This is also to avoid the method of averaging out the inputs of different feed gas streams as it may create a stream with 'brand new' operating conditions, material compositions and flowrates which does not represent the actual release conditions.

The effect of CO in hydrocarbon mixtures on fire hazards is considered to avoid over/under conservatism in the QRA. Research [Ref. 18] has found that CO₂/methane mixture were ignitable up to a CO₂ concentration of 60%. Following the research findings, hydrocarbon mixtures with CO₂ concentration of up to 60 vol% are assumed to remain flammable and modelled in the QRA to account for the fire and explosion hazards. CO₂ toxic effects on personnel fatalities are considered in the QRA study as discussed in Section 4.2.7. It is noted that the CO₂ toxic fatality effects are only considered for scenarios with equipment containing pure CO₂.

As far as is reasonable, the compositions in each stream are simplified (i.e. isomers are summed together). The important characteristic of molecular weight is kept close to the actual value to ensure the release rate is representative.

In addition to the material composition provided in process condition summary [Ref. 4], the following materials and the associated compositions are used in the QRA as well:

- Product gas (89 mol% Methane and 11 mol% Ethane);
- LPG (60 mol% Propane and 40 mol% Butane); and
- Natural Gasoline (50 mol% Pentane and 50 mol% Hexane).

Detailed stream compositions used for each isolatable sections/node were provided in Assumptions Register [Ref. 1].

Diesel and lube oil have high flash points and considered as combustible liquids, thus not further modelled in the QRA study. The flash point of a liquid is the lowest temperature at which a liquid will form a vapour in the air near its surface. For substances with high flash point, presence of major heat sources such as pre-existing fire [Ref. 7] are required to heat the substances above its flash point before it can be ignited in air.

5.2 Isolatable Sections

An ESD system can limit the outflow once a loss of containment occurs. When activated, ESDVs divide the process system into a number of isolatable sections, with each potential leak source associated with a particular isolatable inventory. These sections were split further where necessary and the entire contained inventory was considered as available for release.

Node sections highlighted in the Piping & Instrumentation Diagrams (P&IDs) are presented in Appendix 1. Details of the node sections for Base Case and Sensitivity Case 2 are presented in Table 5-1. Inventory calculation for Sensitivity Case 1 are detailed in Section 8.1.1.

5.3 Release Scenarios

Release rates were calculated based on the release hole sizes and fluid pressure/ tank head pressure. The height of release from all scenarios is assumed to be at 1 m above ground, although some equipment may be located at the elevation higher than the ground level. It is assumed that 70% of the releases are horizontal and 30% of the releases are vertical.

The release scenarios and the respective operating conditions used in the QRA study are presented in Table 5-1.

Table 5-1: Release Scenarios and Operating Conditions

Node	Description / Boundaries	Stream No. (Note 1)	T (° C)	P (barg)	Max Pipe / Hose Diameter (mm) (Note 2)	Pipe / Hose Length (m) (Note 3)	Volume of Isolatable Section (m³)
Raw Gas and Maui Gas Lines							
KGT01_RGS_01_V	Raw Gas header from KPS/KGTP Site Boundary via Inlet Separator (M-507) and Clanton Separator (M-105) to Absorber Towers (D-101-1/2) inlet valves (PV101-1/2), Cogen Plant Header (XSV-603), LTS Plant Gas Header and bypass to Separator (D-201-4) top line	K101	15	40	500	259	233.0
KGT01_RCS_01_L	Raw Condensate from Cyclone Bank (M-507) bottom to LPG Surge Vapouriser (F-201) inlet (liquid inventory taken up to XSV-516)	K919	15	40	100	218	4.1
KGT01_MAU_01_V	Maui Gas from 300 line & 309 line (XSV-594) adjoining with Product Gas Compressors Inlet header and sending Maui Gas export to AUP/ Ballance & Lactose Plant -306 line (up to XSV-9622)	K502	15	45	500	111	233.0
KGT01_MAU_02_V	Maui Gas export via Dry Gas In-line Filter (M-512) to A/U Plant- 112 line (up to HV-300)	K502	15	45	100	63	233.0
CO₂ Removal							
KGT02_TGS_01_V	Treated gas from top of CO ₂ Absorber Tower (D-101-1) via Gas Cooler (E-105-1) and Gas Separator (M-101-1) to FV-102-1 (Benfield Train 1)	K102	42	40	300	15	36.2
KGT03_TGS_04_V	Treated gas from top of CO ₂ Absorber Tower (D-101-2) via Gas Cooler (E-105-2) and Gas Separator (M-101-2) to FV-102-2 (Benfield Train 2)	K102	42	40	250	15	36.0
Dehydration and Dewpoint Control							
KGT01_TGS_07_V	Treated gas from CO ₂ Removal Unit via Decanted Water Stripper (D-201-3) and Wash Water Stripper (D-201-4) to Chilling System	K203	42	40	300	48	233.0
KGT01_TGS_10_V	Treated gas from Strippers via Gas/Gas Heat Exchangers (E-313-1/2) and Gas Chiller (E-313-3) to Low Temperature Separator (M-313) inlet	K203	42	40	300	48	233.0
KGT01_TGS_12_V	Treated gas from Strippers via Gas/Liquid Heat Exchanger (E-303-4) adjoining with Gas Chiller (E-313-3) inlet line	K203	42	40	200	49	233.0
KGT01_PGS_02_V	Product gas from Low Temperature Separator (M-313) and Two-Phase Separator (M-314) via Gas/Gas Heat Exchangers (E-313-1/2) to Product Gas header (PV-337)	K205	12	40	200	15	233.0
KGT04_PGS_07_V	Product gas from top of High Temperature Separator (M-307) to Product Gas header (PV-380)	K205	12	40	80	15	2.4
KGT01_MPG_01_L	Mixed LPG from bottom of Low Temperature Separator (M-313) and Two-Phase Separator (M-314) to FV-357 on outlet line	K204	12	40	80	15	56.3
KGT04_MPG_03_L	Mixed LPG from FV-357 on outlet line of Two-Phase Separator (M-313) via Gas Liquid Heat Exchanger (E-303-4) to High Temperature Separator (M-307) inlet	K204	12	40	100	35	4.0
KGT04_MPG_04_L	Mixed LPG from bottom of High Temperature Separator (M-307) to HT Separator Condensate Pumps (G-301-1/2) suction. (G-301-2 is on stand-by)	K204	12	40	150	15	4.0
KGT04_MPG_05_L	Mixed LPG from HT Separator Condensate Pump (G-301-1) Discharge to Wash Water Coalescer (M-302) inlet	K204	12	40	100	15	4.0
KGT04_MPG_06_L	Mixed LPG from Wash Water Coalescer (M-302) to LPG Production Unit (XSV-332)	K204	12	40	100	15	4.0
Product Gas Lines and Compressors							
KGT01_PGS_01_V	Product Gas header from Dehydration and Dew Point Unit to Product Gas Compressors Inlet header, domestic supply and sending Product Gas export to KPS and Whareroa (up to KPS/KGTP Site Boundary)	K501	15	40	400	229	233.0
KGT01_PGS_13_V	Product Gas from Product Gas header to blanket Hydrocarbon Separator (M-111) top section	K501	15	40	100	15	233.0
KGT01_PGS_14_V	Product Gas from Product Gas Header (FV-0106) via LTS pipe bridge to XSV-0109 near Gas Storage Compressors in LTS unit	K505	15	40	200	274	233.0
KGT13_PGS_15_V	Product Gas from XSV-0109 to Gas Storage Compressors (D4-0401/0402) Inlet (D4-0402 is on standby.)	K901	15	40	500	56	23.5
KGT13_PGS_16_V	Product Gas from Gas Storage Compressor (D4-0401) Discharge via Gas Storage Compressor Cooler (D2-0402) to Coalescer (D11-0417) inlet	K901	15	40	150	51	23.5
KGT13_PGS_17_V	Product Gas export from Coalescer (D11-0417) to Gas Storage/ 070 Pipeline (XSV-0112)	K901	15	40	500	51	23.5
KGT01_MGS_01_V	Mixed Gas from Process Gas header and Maui Gas line to suction of Product Gas Compressor (C-903-2/3/5) (C-903-3 is on standby.)	K501	15	40	400	91	233.0
KGT01_MGS_03_V	Mixed Gas from Product Gas Compressor (C-903-2) Discharge	K506	40	70	200	15	233.0
KGT01_MGS_07_V	Mixed Gas from Product Gas Compressor (C-903-5) Discharge	K506	40	70	200	15	233.0
KGT11_MGS_05_V	Mixed Gas discharge header to the flange to the flange with Transmission export line	K506	40	70	350	91	41.3
KGT11_MGS_08_V	Mixed Gas domestic supply to Stores/ Workshop/ Admin. Building	K506	40	70	50	251	41.3
KGT11_MGS_09_V	Mixed Gas export from Product Gas Compressor Discharge header via Oil Coalescer (M-919) to 100/200 Pipelines in Transmission metering area and side uses as purge gas for Odorant Injection Tank (F-553) and instrument gas for XSV-0107	K506	40	70	350	278	41.3

Node	Description / Boundaries	Stream No. (Note 1)	T (° C)	P (barg)	Max Pipe / Hose Diameter (mm) (Note 2)	Pipe / Hose Length (m) (Note 3)	Volume of Isolatable Section (m³)
Pigging							
KGT01_PIG_01_V	Pig Receiver - 300 and 309 Pipeline (M-918)	K502	15	45	500	-	233.0
KGT13_PIG_02_V	LTS Pig Launcher (M-917)	K901	15	40	500	-	23.5
KGT11_PIG_03_V	Kapuni North Pig Launcher - 200 Pipeline (M-915)	K506	40	70	200	-	41.3
KGT11_PIG_04_V	Kapuni South Pig Launcher - 100 Pipeline (M-916)	K506	40	70	200	-	41.3
Utilities and Cogen Unit							
KGT01_MPG_21_V	Mixed LPG from top of LPG Surge Vaporiser (F-201) via Rich Fuel Gas Separator (M-201-2) to HRSG burners (B-604-A-1/2/3, B-604-B1/2/3) in Cogen. Unit	K919	88	3.9	100	78	233.0
KGT01_MPG_22_L	Mixed LPG at bottom of LPG Surge Vaporiser (F-201)	K919(L)	88	3.9	50	15	56.3
KGT01_MPG_23_L	Mixed LPG from bottom of Hydrocarbon Separator (M-111) to LPG Surge Vaporiser (F-201) inlet	K919	15	40	50	50	56.3
KGT01_FGA_01_V	Product Gas from Product Gas header via Fuel Gas Heater (E-602) and Fuel Gas KO Pot (M-601) to Fuel Gas Superheater (E-603)	K503	15	40	150	38	233.0
KGT01_FGA_02_V	Fuel Gas from Fuel Gas Superheater (E-603) via Fuel Gas Filters (M-628-A/B) to HRSG A/B Burners (B-604-A-1/2/3, B-604-B1/2/3) (M-628-B is on standby.)	K503	15	40	150	138	233.0
KGT01_PGS_19_V	Product gas from Product Gas header to Ammonia/ CO ₂ Compressor Engines (CE-821/822) in CO ₂ Recovery Unit	K501	15	40	50	154	233.0
KGT01_PGS_21_V	Product gas from Product Gas header to Gas Flare System Burners (D1-4100B)	K501	15	40	100	274	233.0
LPG Production Facility - Stabiliser, De-Ethaniser							
KGT01_MPG_07_L	Mixed LPG from Dehydration unit (XSV-332) via De-Ethaniser Feed Preheater (E-420-3) to De-Ethaniser (D-420-2) inlet (LPG Production Train 2)	K401	12	30	100	194	56.3
KGT01_DET_01_V	De-Ethaniser (D-420-2) Top Vapour via De-Ethaniser OVHD Condenser (E-420-2) and De-Ethaniser Reflux Drum (F-420-2) to XSV-411-2 on inlet line to OVHD Compressor Suction Scrubber (M-422) (LPG Production Train 2)	K408	20	30	100	15	233.0
KGT01_PGS_04_V	Product gas from De-Ethaniser(D-420-2) via top of Suction Scrubber (M-422) to OVHD Compressor (C-421-1/2) inlet (LPG Production Train 2) (C-421-2 is on standby.)	K408	20	30	80	110	233.0
KGT01_PGS_05_V	Product gas from De-Ethaniser OVHD Compressor (C-421-1) discharge via De-Ethaniser OVHD Compressor Cooler (E-421-1) to Product gas header and to adjoining Treated Gas line from Strippers (LPG Production Train 2)	K408	20	30	200	143	233.0
KGT01_DEX_01_L	Reflux from De-Ethaniser Reflux Drum (F-420-2) via De-Ethaniser Reflux Pumps (G-420-1/2) to De-Ethaniser (D-420-2) top side (LPG Production Train 2) (G-420-2 is on standby.)	K402	100	30	80	15	56.3
KGT01_DEB_01_L	De-Ethaniser (D-420-2) Bottom Liquid to/from De-Ethaniser Reboiler (E-422-2) and to De-Propaniser Feed Surge Drum (F-420-3) inlet (LPG Production Train 2)	K402	100	30	150	15	56.3
KGT01_MPG_09_L	Mixed LPG from Bottom of De-Propaniser Feed Surge Drum (F-420-3) to De-Propaniser (D-430-1/2) inlet	K402	100	30	150	22	56.3
KGT01_MPG_10_V	Mixed LPG from Top of De-Propaniser Feed Surge Drum (F-420-3) to De-Propaniser (D-430-2) inlet	K402	100	30	100	15	233.0
LPG Production Facility - De-Propaniser							
KGT01_DPT_11_V	De-Propaniser (D-430-2) Top Vapour via De-Propaniser Condenser (E-430-2) to De-Propaniser Reflux Drum (F-430-2) (LPG Production Train 2)	K403	20	14	150	15	233.0
KGT01_DPX_11_L	Reflux from De-Propaniser Reflux Drum (F-430-2) via De-Propaniser Reflux Pumps (G-430-3/4) to De-Propaniser (D-430-2) (LPG Production Train 2) (G-430-4 is on stand-by.)	K403	20	14	100	15	56.3
KGT01_PC3_02_L	Product propane from De-Propaniser Reflux Pump (G-430-3) via Propane Product Cooler (E-4001-2) to XSV-417-2 on the export line to Storage (LPG Production Train 2)	K403	20	14	50	15	56.3
KGT01_DPB_11_L	De-Propaniser (D-430-2) Bottom Liquid to/from De-Propaniser Reboiler (E-432-2) and to De-Butaniser (D-440-1/2) (LPG Production Train 2)	K404	105	14	150	56	56.3
LPG Production Facility - De-C4							
KGT01_DBT_11_V	De-Butaniser (D-440-2) Top Vapour via De-Butaniser Condenser (E-440-2) to De-Butaniser Reflux Drum (F-440-2) and to Surge Vaporiser (F-201) (LPG Production Train 2)	K405	20	7	150	168	233.0
KGT01_DBX_11_L	Reflux from De-Propaniser Reflux Drum (F-440-2) via De-Butaniser Reflux Pumps (G-440-3/4) to De-Butaniser (D-440-2) (LPG Production Train 2) (G-440-4 is on standby.)	K405	20	7	80	15	56.3
KGT01_NGL_01_L	Natural Gasoline from bottom of De-Butaniser (D-440-2) and De-Butaniser Reboilers (E-442-1/2) to De-Ethaniser FEED Pre-Heater (E-420-3) inlet (LPG Production Train 2) (E-442-1 is on standby.)	K406	115	7	150	42	56.3
KGT01_NGL_02_L	Natural Gasoline from De-Ethaniser Feed Pre-Heater (E-420-3) via Gasoline Cooler (E-460) to the export lines KPS and Storage (XSV-416 and XSV-481-1)	K407	20	7	150	23	56.3

Node	Description / Boundaries	Stream No. (Note 1)	T (° C)	P (barg)	Max Pipe / Hose Diameter (mm) (Note 2)	Pipe / Hose Length (m) (Note 3)	Volume of Isolatable Section (m ³)
LPG Production Facility - Product Export and Loadout							
KGT32_NGL_05_L	Natural Gasoline from XSV-416 in LPG Production Unit to KPS (up to KPS/KGTP Site Boundary)	K507	20	7	50	210	0.4
KGT33_NGL_06_L	Natural Gasoline from LPG Production Unit (XSV-481-1) to XSV-4073 on the inlet to NGL Storage Tank (F-4033)	K703	15	7	100	578	4.7
KGT34_NGL_07_L	Natural Gasoline Storage Tank (F-4033)	K706	15	ATM	-	-	65.0
KGT35_NGL_09_L	Natural Gasoline export from Natural Gasoline Storage Tank (F-4033) via Natural Gasoline Load Out Pump (G-4033) to XSV-4068 on the NGL export line	K803	15	2.95	100	15	0.1
KGT36_NGL_10_L	Natural Gasoline from XSV-4068 to NGL Tanker Loading Hose (T-4003) inlet	K803	15	2.95	100	15	0.1
KGT36_NGL_11_L	Natural Gasoline Loadout Hose (T-4003)	K803	15	2.95	100	-	0.1
KGT36_NGL_12_L Note 4	Natural Gasoline Road Tanker	K803	15	2.95	100	-	20 tonnes
KGT37_PC3_05_L	Product Propane export from LPG Production Unit (XSV 417-2) to SDV-4004 on the inlet lines to Propane Storage Vessels (F-4003, F-4004)	K701	15	14	80	-	2.5
KGT39_PC3_07_V	Vapour Section of Propane Storage Vessel (F-4003)	K704	15	7	-	-	61.7
KGT39_PC3_08_L	Liquid Section of Propane Storage Vessel (F-4003)	K704	15	7	-	-	51.3
KGT40_PC3_09_V	Vapour Section of Propane Storage Vessel (F-4004)	K704	15	7	-	-	123.4
KGT40_PC3_10_L	Liquid Section of Propane Storage Vessel (F-4004)	K704	15	7	-	-	106.6
KGT41_PC4_04_L	Product Butane export from LPG Production Unit (XSV-419-2) to SDV-4005 on the inlet lines to Butane Storage Vessels (F-4001, F-4002)	K702	15	7	80	562	2.6
KGT43_PC4_06_V	Vapour Section of Butane Storage Vessel (F-4001)	K705	15	2	-	-	14.7
KGT43_PC4_07_L	Liquid Section of Butane Storage Vessel (F-4001)	K705	15	2	-	-	51.3
KGT44_PC4_08_V	Vapour Section of Butane Storage Vessel (F-4002)	K705	15	2	-	-	68.6
KGT44_PC4_09_L	Liquid Section of Butane Storage Vessel (F-4002)	K705	15	2	-	-	44.5
KGT45_PC3_12_L	Product Propane export from Propane Storage Vessels (F-4003, F-4004) via Propane Loadout Pumps (G-4002/4024) to SDV-4017 on the LPG export line (G-4002 is on standby.)	K801	15	10	200	15	0.5
KGT46_PC4_11_L	Product Butane export from Butane Storage Vessels (F-4001, F-4002) via Butane Loadout Pump (G-4001) to SDV-4016 on the LPG export line	K802	15	5	200	15	0.5
KGT47_LPG_01_L	Product LPG export from SDV-4016/4017 to LPG Loadout Arm (T-4002)	K806	15	7.5	100	15	0.1
KGT47_LPG_02_L	LPG Loadout Arm (T-4002)	K806	15	7.5	80	-	0.1
KGT47_LPG_03_L Note 4	LPG Road Tanker	K806	15	7.5	80	-	20 tonnes
KGT47_LPG_05_L	LPG Loadout Smart Hose to Isotainers	K806	15	7.5	50	-	0.1
KGT47_LPG_06_L Note 4	New LPG Road Tanker (Isotainer)	K806	15	7.5	50	-	12 tonnes
Propane Refrigeration System							
KGT70_REF_01_V	Vapour section of Propane Refrigerant Surge Drum (F-315)	K302	-34	1	100	15	36.4
KGT70_REF_02_L	Propane refrigerant from bottom of Propane Refrigerant Surge Drum (F-315) to Propane Refrigerant Economiser (D-315-2) inlet	K301	15	4	100	15	25.2
KGT70_REF_03_V	Propane refrigerant from Propane Refrigerant Economiser (D-315-2) to Compressors (C-330-1/ C-330-2) inter-stage suction	K301	15	4	150	22	36.4
KGT70_REF_04_L	Propane refrigerant from bottom of Propane Refrigerant Economiser (D-315-2) to each user (E-313-3, E-420-2) (E-303-3 is on standby.)	K301	15	4	200	174	25.2
KGT70_REF_05_L	Propane refrigerant in Gas Chiller (E-313-3)	K302	-34	1	150	15	25.2
KGT70_REF_07_L	Propane refrigerant in De-Ethaniser Reflux Drum (E-420-2)	K302	-34	1	150	15	25.2
KGT70_REF_11_V	Propane refrigerant from each user via Propane Compressor Suction Scrubber (M-333) to Compressors (C-330-1/ 2) suction	K302	-34	1	300	154	36.4
KGT70_REF_14_V	Propane refrigerant from Compressors (C-330-1/2) discharge via Oil Separator (M-330-1/2) to Propane Refrigerant Condensers (E-317-1A/B, E-317-2) inlet	K301	15	4	250	65	36.4
KGT70_REF_15_L	Propane refrigerant from Propane Refrigerant Condensers (E-317-1A/B, E-317-2) to Propane Refrigerant Surge Drum (F-315) inlet	K301	15	4	200	28	25.2
Mercaptans and Methanol							
KGT50 EMC_01_L	Ethyl Mercaptan from Transportable Odorant Drums (F-4007-A/ B) via Odorant Injection Pump (G-4011) to LPG Loadout Arm (T-4002) inlet (F-4007-B is on standby.)	K804	15	10	15	15	0.2
KGT50 EMC_02_L	Ethyl Mercaptan Transportable Odorant Drums (F-4007-A/ B)	K805	15	1	-	-	0.2
KGT51_BMC_05_L	t-Butyl Mercaptan Portable Odorant Tank (F-521) to domestic gas supply header	K603	15	8	-	-	0.1
KGT52_BMC_01_L	t-Butyl Mercaptan Odorant Injection Tank (F-553)	K603	15	1	-	-	19.0

Node	Description / Boundaries	Stream No. (Note 1)	T (° C)	P (barg)	Max Pipe / Hose Diameter (mm) (Note 2)	Pipe / Hose Length (m) (Note 3)	Volume of Isolatable Section (m³)
KGT52_BMC_02_L	t-Butyl Mercaptan from Odorant from Odorant Injection Tank (F-553) via Odorant Injection Pumps (G-552-A/B) to Transmission export lines (100/200 lines) (G-552-B is on standby.)	K602	15	80	15	15	19.0
KGT52_BMC_03_L	t-Butyl Mercaptan Filling Hose	K603	15	1	50	-	19.0
KGT53_BMC_04_L Note 4	t-Butyl Mercaptan Road Tanker	K603	15	1	50	-	16 tonnes
KGT55_MOH_01_L	Methanol Storage Tanks (F-502-1/2/4/6)	K918	15	ATM Liquid head (2.7m)	-	-	8.7
KGT55_MOH_02_L	Methanol from Methanol Storage Tanks (F-502-1/2/4/6) via Metering Pumps (G-309-1/2, G-319-1/2) to users (G-309-2, G-319-2 are on standby.)	K917	15	50	25	343	8.7
KGT55_MOH_03_L	Methanol Filling Hose	K918	15	0	40	-	8.7
KGT56_MOH_04_L Note 4	Methanol Road Tanker	K918	15	0	40	-	4 tonnes
CO₂ Recovery - Ammonia							
KGT80_AMM_01_V	Ammonia gas from Ammonia Compressor (C-888) discharge to Ammonia Condenser (E-895) through Oil Separator (M-892) (Train A)	K908	15	15	150	15	3.3
KGT80_AMM_11_V	Ammonia gas from Ammonia Compressor (C-821) discharge to Ammonia Receiver (F-823) through Oil Separator (M-825) and Ammonia Condenser (E-825) (Train B)	K908	15	15	150	15	3.3
KGT80_AMM_02_V	Ammonia gas section of Liquid Receivers (F-803/F-823)	K908	15	15	32	15	3.3
KGT80_AMM_03_L	Ammonia liquid from Ammonia Condensers (E-895/825) to Liquid Receiver (F-803/F-823)	K908	15	15	100	15	4.9
KGT80_AMM_04_L	Ammonia liquid from Liquid Receivers via Liquid Sub-Coolers (E-826/896) and CO ₂ Condenser (E-804) to Oil Receiver (M-828)	K908	15	15	100	21	4.9
KGT80_AMM_07_L	Ammonia liquid from SV-825 and SV-896C via Oil Receiver (M-828) (coil) to CO ₂ Chiller (E-803)	K908	15	15	25	38	4.9
KGT80_AMM_08_V	Ammonia gas return from CO ₂ Condenser (E-804) and Oil Receiver (M-828) to Ammonia Compressors (C-888/821) suction	K909	-30	0	250	15	3.3
KGT80_AMM_09_V	Ammonia gas return from CO ₂ Chiller (E-803) and liquid ammonia vaporising via Liquid Sub-Coolers (E-826/896) to Ammonia Compressors (C-888/821) suction	K909	-30	0	80	48	3.3
CO₂ Recovery - CO₂							
KGT90_CO2_01_V	CO ₂ gas from CO ₂ Compressor (C-802) Discharge via Pulsation Vessel (F-806), Intercooler (E-807) and Interstage Separator (M-830) to After Cooler (E-802) inlet (Train A)	K910	-26.6	15	100	15	45.6
KGT90_CO2_02_V	CO ₂ gas from CO ₂ Compressor (C-822) Discharge via Pulsation Vessel (F-826), Intercooler (E-827) and Interstage Separator (M-829) to After Cooler (E-802) (Train B)	K910	-26.6	15	100	15	45.6
KGT90_CO2_03_V	CO ₂ gas from CO ₂ After Cooler (E-802) via Aftercooler Separator (M-881) and via CO ₂ Chiller (E-803) to Chiller Separator (M-882)	K910	-26.6	15	100	31	45.6
KGT90_CO2_07_V	CO ₂ gas from Chiller Separator (M-882) outlet via CO ₂ Purifiers (M-807-1/2), CO ₂ Driers (B-801-1/2) and CO ₂ Particulate Filters (M-879-1/2) to CO ₂ Condenser (E-804) inlet adjoin with CO ₂ gas lines from Storage Tanks (F-801-1/2/3) (M-807-2, B-801-2 and M-879-2 are on standby.)	K910	-26.6	15	80	89	45.6
KGT90_CO2_08_L	CO ₂ liquid from CO ₂ Condenser (E-804) via CO ₂ Liquid Receiver (F-802) and CO ₂ Condenser Pump (G-883) to Liquid CO ₂ Storage Tanks (F-801-1/2/3) inlet	K910	-26.6	15	100	71	223.0
KGT90_CO2_16_V	CO ₂ gas from Aftercooler Separator (M-881) and Raw Gas Boosters (C-885/823) discharge via Catalyst Carbon Vessels (D-821/ D-801) to CO ₂ Compressors (C-802/822) suction	K907	15	1	300	180	45.6
KGT90_CO2_18_V	CO ₂ gas from Storage Tanks (F-801-1/2/3) to users (Compressor shelters, LPG Storage tanks and LPG Loading facility)	K920	15	0.094	50	796	45.6
KGT90_CO2_19_V	CO ₂ gas for Regeneration Cycle via Regeneration Heaters (B-802/ B-803), CO ₂ Purifier (M-807-2), CO ₂ Drier (B-801-1)	K922	15	0.1	80	15	45.6
KGT90_CO2_09_L	Liquid CO ₂ Storage Tank (F-801-1)	K910	-26.6	15	-	-	223.0
KGT90_CO2_10_L	Liquid CO ₂ Storage Tank (F-801-2)	K910	-26.6	15	-	-	223.0
KGT90_CO2_11_L	Liquid CO ₂ Storage Tank (F-801-3)	K910	-26.6	15	-	-	223.0
KGT90_CO2_12_L	Air Liquide CO ₂ Storage Tank (F-811)	K910	-26.6	15	-	-	223.0
KGT90_CO2_24_L	Liquid CO ₂ from Storage Tanks (F-801-1/2/3) via CO ₂ loadout pumps (G-821, G-801-1/2) to BOC CO ₂ Road Tanker Loadout Connections	K906	-26.6	15	100	71	223.0
KGT90_CO2_25_L	Liquid CO ₂ from Air Liquid CO ₂ Storage Tank (F-811) via G-812 to Air Liquid Road Tanker Loadout Connection	K906	-26.6	15	50	15	223.0
KGT90_CO2_26_V	CO ₂ gas to Storage Tanks (F-801-1/2/3) from BOC CO ₂ Road Tanker Revert Connections	K906	-26.6	15	50	23	45.6
KGT90_CO2_27_V	CO ₂ gas to from Air Liquid CO ₂ Storage Tank (F-811) from Air Liquid Road Tanker Revert Connection	K906	-26.6	15	25	15	45.6

Node	Description / Boundaries	Stream No. (Note 1)	T (° C)	P (barg)	Max Pipe / Hose Diameter (mm) (Note 2)	Pipe / Hose Length (m) (Note 3)	Volume of Isolatable Section (m ³)
KGT90_CO2_28_L	Vector CO ₂ Loadout connection	K906	-26.6	15	50	-	223.0
KGT90_CO2_29_V	BOC CO ₂ Road Tanker Revert connections	K906	-26.6	15	25	-	45.6
KGT90_CO2_30_L	BOC CO ₂ Road Tanker Loadout Connection	K906	-26.6	15	80	-	223.0
KGT90_CO2_31_V	Air Liquide Road Tanker Revert connection	K906	-26.6	15	25	-	45.6
KGT90_CO2_32_L	Air Liquide Road Tanker Loading connection	K906	-26.6	15	50	-	223.0
KGT90_CO2_33_L Note 4	Vector CO ₂ Road Tanker	K906	-26.6	15	50	-	18 tonnes
KGT90_CO2_34_L Note 4	BOC CO ₂ Road Tanker	K906	-26.6	15	80	-	18 tonnes
KGT90_CO2_35_L Note 4	Air Liquide Road Tanker	K906	-26.6	15	50	-	18 tonnes

Notes:

1. Stream compositions are provided in Assumptions Register [Ref. 1].
2. The maximum pipe/hose diameters of each node are determined using the P&IDs.
3. The piping lengths are measured from the KGTP layout drawings using scale [Ref. 17]. A safety factor 1.25 has been applied to all lengths measured from the map to account for bends and elevations which could not be determined from the 2D map. See Appendix 3 for the main estimated piping lengths.
4. Road tankers BLEVE have been excluded in the assessment since several control measures are provided for road tankers in KGTP site as listed below. This is in line with the following TNO Purple Book [Ref. 10] recommendation where it stated "In general, the external impact LOCs for road tanker accidents do not have to be considered in an establishment if measures have been taken to reduce road accidents, like speed limits." The KGTP site specific measures are:
 - Only one LPG/ NGL loadout occurs at a time. Other vehicles are precluded from entering the area via the site access system.
 - Site speed limit
 - Deluge cage over LPG loadout area

6 FREQUENCY ANALYSIS

6.1 Release Frequency Assessment

Following the nodes sectionalisation, parts (equipment) count on each release scenario is conducted based on Piping & Instrumentation Diagrams (P&IDs) to estimate the release frequency. The summary of estimated release frequencies for each KGTP unit for the Base Case are presented in Table 6-1. The detail breakdown of release frequencies for each node sections are provided in Appendix 4.

Table 6-1: Release Frequencies Summary for KGTP Units

Node Section	Base Case Release Frequencies (per year) ^{Note 1}						
	1 - 3 mm	3 - 10 mm	10 - 50 mm	50 - 150 mm	> 150 mm	Total	% Contrib.
Raw Gas and Maui Gas Lines	1.50E-02	6.58E-03	3.50E-03	6.07E-04	1.03E-04	2.58E-02	2.9%
CO ₂ Removal	6.12E-03	2.82E-03	1.56E-03	3.83E-04	3.57E-05	1.09E-02	1.2%
Dehydration and Dewpoint Control	2.56E-02	1.10E-02	5.66E-03	1.06E-03	2.54E-04	4.36E-02	4.9%
Product Gas Lines and Compressors	6.28E-02	2.75E-02	1.39E-02	2.96E-03	4.61E-04	1.08E-01	12.0%
Pigging	3.58E-06	1.85E-06	1.03E-06	2.55E-07	1.16E-07	6.83E-06	<0.01%
Utilities and Cogen Unit	4.82E-02	1.97E-02	8.94E-03	1.86E-03	7.00E-05	7.88E-02	8.8%
LPG Production Facility - Stabiliser, De-C2	2.89E-02	1.23E-02	5.99E-03	1.67E-03	3.58E-05	4.89E-02	5.5%
LPG Production Facility - De-C3	1.47E-02	5.92E-03	2.82E-03	6.34E-04	1.90E-05	2.41E-02	2.7%
LPG Production Facility - De-C4	2.09E-02	8.35E-03	3.88E-03	8.22E-04	1.62E-05	3.40E-02	3.8%
LPG Production Facility - Product Export and Loadout	2.33E-02	6.71E-02	3.40E-03	6.87E-04	5.94E-03	1.00E-01	11.2%
Propane Refrigeration System	3.78E-02	1.63E-02	7.60E-03	1.60E-03	3.15E-04	6.36E-02	7.1%
Mercaptans and Methanol	1.95E-02	1.65E-02	3.85E-03	2.05E-03	8.51E-04	4.28E-02	4.8%
CO ₂ Recovery - Ammonia	7.07E-02	2.81E-02	1.14E-02	2.90E-03	2.50E-04	1.13E-01	12.6%
CO ₂ Recovery - CO ₂	7.98E-02	9.66E-02	1.54E-02	4.18E-03	6.80E-03	2.03E-01	22.6%
Total	4.53E-01	3.19E-01	8.79E-02	2.14E-02	1.51E-02	8.97E-01	100.0%
% Contribution	50.5%	35.6%	9.8%	2.4%	1.7%	100.0%	-

Notes:

1. Release frequencies estimated have considered the operating factor of equipment.

The total release frequencies for the Base Case scenarios within KGTP are approximately 0.9 per annum, or equivalent one leak every 1.1 years. Approximately 51% of the leak frequencies are contributed from the “1 – 3 mm” hole sizes range.

6.2 Ignition and Explosion Probabilities

The split between immediate ignition, delayed ignition and explosion probabilities for the node sections are presented in Appendix 5.

7 RISK ANALYSIS

This section presents QRA risk results, presented in the form of Location Specific Individual Risk (LSIR) contours. Major risk contributors at selected points on the KGTP are discussed as well.

7.1 Location Specific Individual Risk (LSIR)

7.1.1 Criteria

LSIR is defined as the risk of fatality at a point in space to a hypothetical individual at a location for 365 days per year, 24 hours a day, unprotected and unable to escape.

As there are no standard risk criteria which have been developed for the New Zealand context, the individual risk has been assessed against the suggested risk criteria in the NSW HIPAP No. 4 “Risk Criteria for Land Use Planning” [Ref. 8], as shown in Table 7-1.

Table 7-1: Individual Fatality Risk Criteria

Land Use	Risk Criteria Adopted (per annum)	Interpretation for QRA
Hospitals, schools, childcare facilities, old age housing	0.5E-06 (or 5E-07) (1 in 2 million)	5E-07 risk contour should not extend to these areas
Residential, hotels, motels, tourist resorts	1E-06 (1 in 1 million)	1E-06 risk contour should not extend to these areas
Commercial developments including retail centres, offices and entertainment centres	5E-06 (1 in 200,000)	5E-06 risk contour should not extend to these areas
Sporting complexes and active open space	10E-06 (or 1E-05) (1 in 100,000)	1E-05 risk contour should not extend to these areas
Industrial	50E-06 (or 5E-05) (1 in 20,000)	5E-05 risk contour should, as a target, be contained within the boundaries of the industrial site where applicable

KGTP is situated in an area classified as “Rural Industrial” under the Operative South Taranaki District Plan [Ref. 23]. The KPS plant is located immediately adjacent to the north while the Ballance plant is located north-west of the KGTP site, as presented in Figure 3-1. It should be noted that the KGTP, KPS and Ballance sites have been classified as a single ‘Rural Industrial Zone’ on the STDC Operative District Plan.

There are no sporting complexes, hospitals or commercial developments in the area surrounding KGTP. The closest identified offsite parties are a dwelling and a farm shed (approximately 220 metres and 180 metres, respectively from the northwest boundary of KGTP), in addition to the KPS and Ballance plants. Therefore, only the “Industrial” (i.e. the 5E-05/ year risk) and “Residential” (the 1E-06 /year risk) are considered in the QRA study.

7.1.2 Base Case Risk Contours

Figure 7-1 presents the Base Case overall LSIR contours at KGTP. The LSIR for fire and explosion events as well as toxic events are presented in Figure 7-2 and Figure 7-3, respectively.

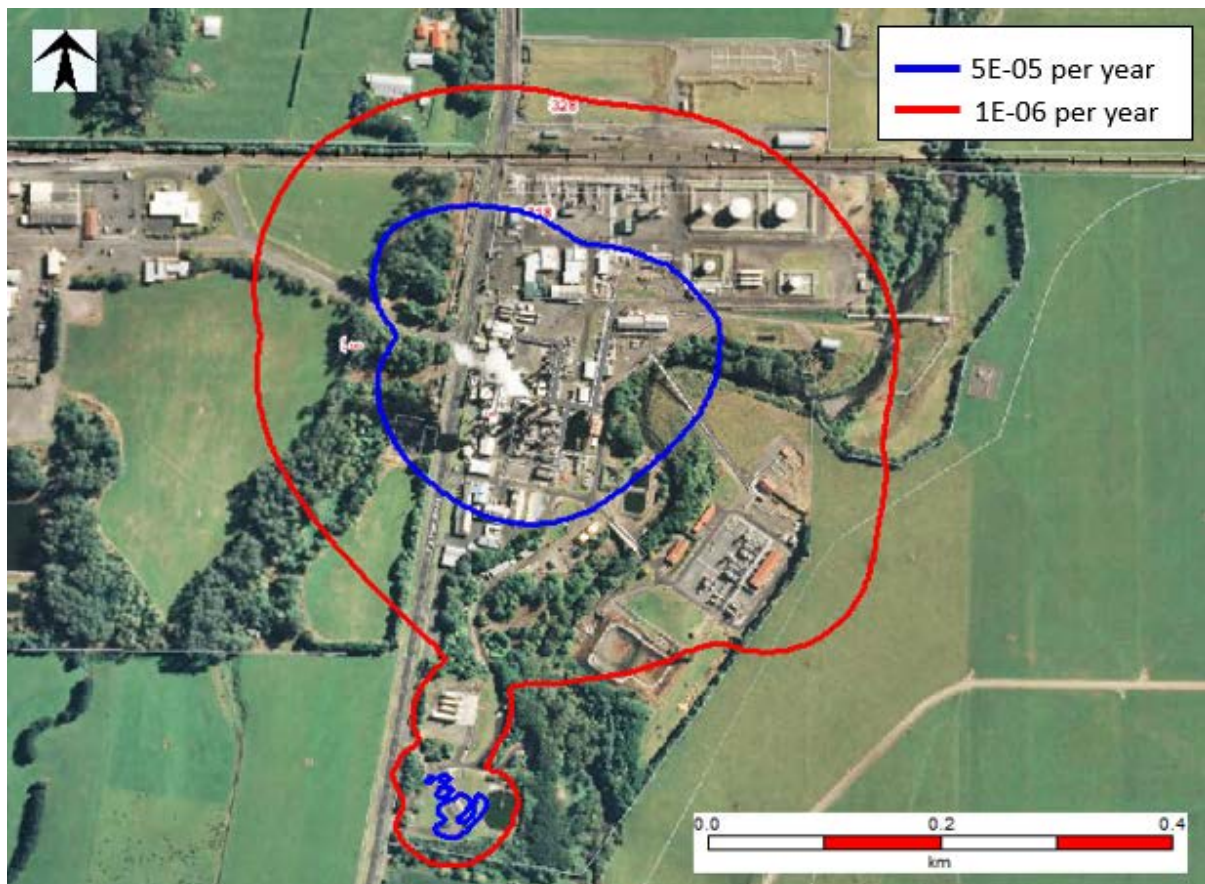


Figure 7-1: Base Case LSIR Contours at KGTP – All Events

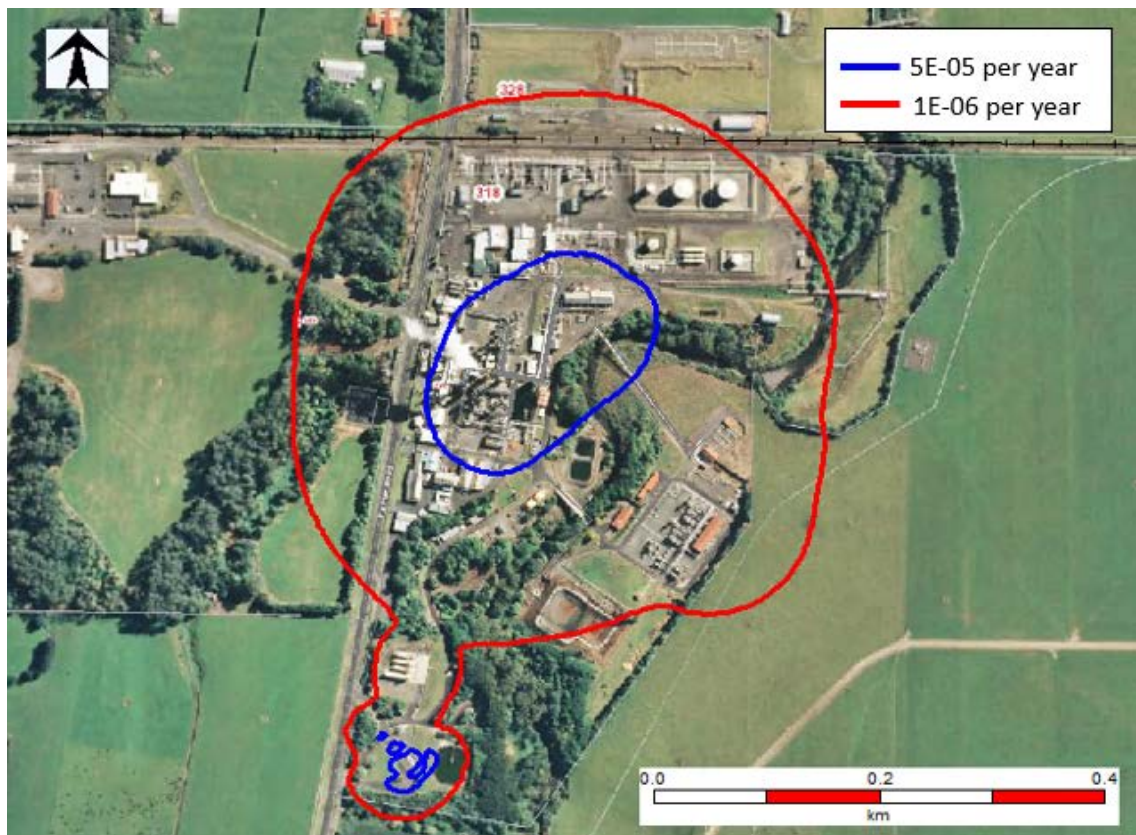


Figure 7-2: Base Case LSIR Contours at KGTP – Fire and Explosion Events

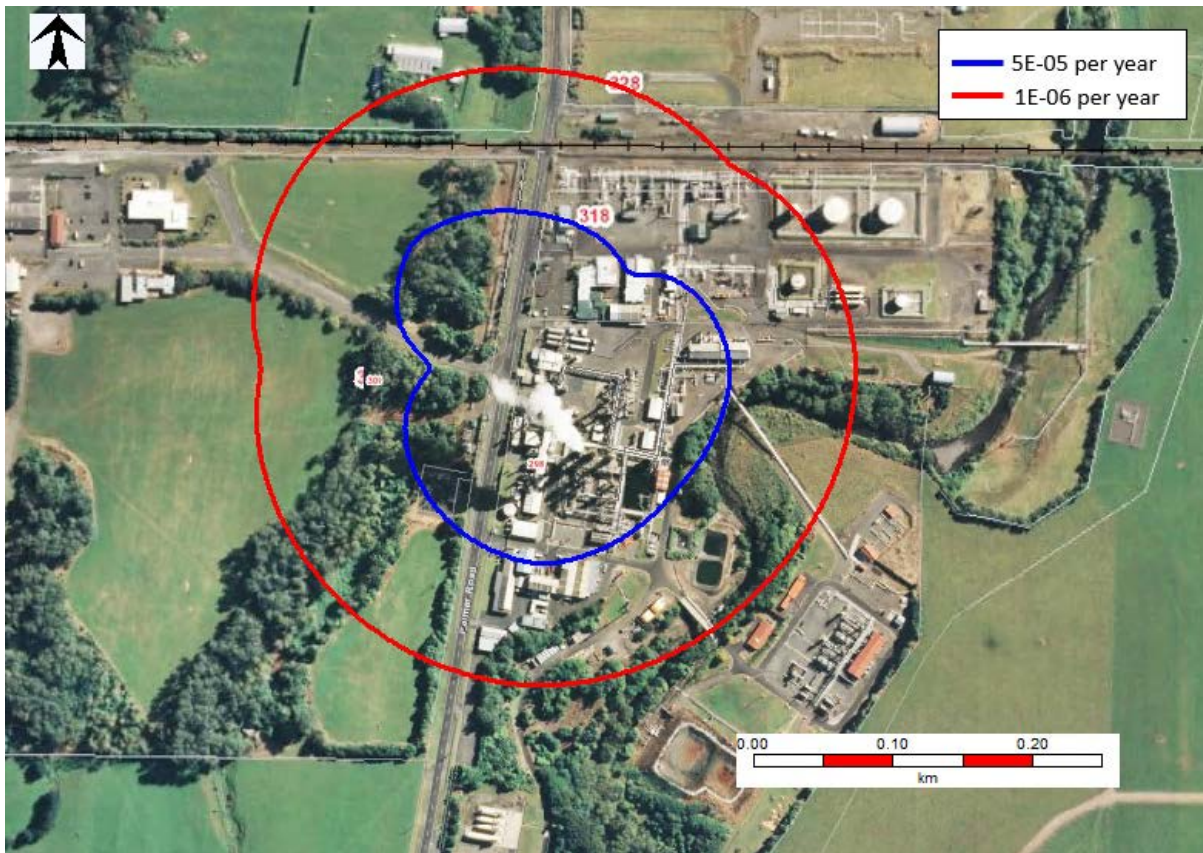


Figure 7-3: Base Case LSIR Contours at KGTP – Toxic Events

Overall risk levels are plotted between 5E-05 and 1E-06 per year, to allow for comparison against the NSW HIPAP 4 [Ref. 8] risk criteria documented in Table 7-2.

Table 7-2: Comparison with Fatality Risk Criteria (Base Case Overall LSIR)

Overall LSIR	Risk Contour	Risk Criteria	Result Observation
5E-05 / year	Blue	<i>Industrial</i> 5E-05 / year risk contour should, as a target, be contained within the boundaries of the industrial site where applicable.	<ol style="list-style-type: none"> 5E-05 per year contour extends into the KPS site to the north but remains within the Todd Energy site boundary. The 5E-05 per year contour extends across Palmer Road and into the bushes at the west boundary of the Ballance site. The 5E-05 per year contour offsite impact is mainly attributed to toxic events.
1E-06 / year	Red	<i>Residential</i> 1E-06 / year risk contour should not extend to residential, hotels, motels, tourist resorts	The 1E-06 per year contour extends onto the property of the closest neighbour north west of KGTP site but does not extend as far as the dwelling and farm buildings.

The major risk contributors are identified and analysed in Section 7.2.

7.2 Major Risk Contributors

The major risk contributors are extracted from the risk model at selected risk points (indicated as the red dots) of interest, as shown in Figure 7-4.



Figure 7-4: Major Risk Contributors Points

7.2.1 Base Case Risk Contributor Analysis

The major risk contributing scenarios towards the risk points of interests for base case are presented in Table 7-3.

Table 7-3: Major Risk Contributors to Selected Locations for Base Case Assessment

Risk Points	Release Source	Description	LSIR (per year)	Percentage of Risk Contribution (%)
A - Shed Area	KGT80_AMM_04_L_71mm	Ammonia liquid from Liquid Receivers via Liquid Sub-Coolers (E-826/896) and CO ₂ Condenser (E-804) to Oil Receiver (M-828)	5.21E-07	43.1%
	KGT80_AMM_03_L_71mm	Ammonia liquid from Ammonia Condensers (E-895/825) to Liquid Receiver (F-803/F-823)	4.21E-07	34.8%
B - Ballance Site 1	KGT80_AMM_04_L_22mm	Ammonia liquid from Liquid Receivers via Liquid Sub-Coolers (E-826/896) and CO ₂ Condenser (E-804) to Oil Receiver (M-828)	2.97E-05	34.5%
	KGT80_AMM_03_L_22mm	Ammonia liquid from Ammonia Condensers (E-895/825) to Liquid Receiver (F-803/F-823)	2.22E-05	25.8%

Risk Points	Release Source	Description	LSIR (per year)	Percentage of Risk Contribution (%)
C -Ballance Site 2	KGT80_AMM_04_L_22mm	Ammonia liquid from Liquid Receivers via Liquid Sub-Coolers (E-826/896) and CO ₂ Condenser (E-804) to Oil Receiver (M-828)	3.75E-05	35.5%
	KGT80_AMM_03_L_22mm	Ammonia liquid from Ammonia Condensers (E-895/825) to Liquid Receiver (F-803/F-823)	2.47E-05	23.3%
D - KGTP Site East	KGT13_PGS_16_V_85mm	Product Gas from Gas Storage Compressor (D4-0401) Discharge via Gas Storage Compressor Cooler (D2-0402) to Coalescer (D11-0417) Inlet	6.65E-07	33.5%
	KGT13_PGS_15_V_85mm	Product Gas to Gas Storage Compressors (D4-0401/0402) Inlet	3.87E-07	19.5%
E – LPG Area	KGT01_TGS_10_V_212mm	Treated gas from Strippers via Gas/Gas Heat Exchangers (E-313-1/2) and Gas Chiller (E-313-3) to Low Temperature Separator (M-313) inlet	2.64E-07	23.5%
	KGT01_PGS_01_V_245mm	Product Gas header from Dehydration and Dew Point Unit to Product Gas Compressors Inlet header, domestic supply and sending Product Gas export to KPS and Whareroa (up to KPS/KGTP Site Boundary)	1.23E-07	11.0%

Based on the major risk contributors above, it can be shown that the shed area and Ballance site risk ranking points are mainly impacted by the ammonia release scenarios, in line with the LSIR toxic risk contours shown in Figure 7-3. The KGTP site east risk point is mainly impacted by the Gas Storage Compressor inlet and discharge line.

7.3 LPG Risk Analysis

The LPG storage and loadout facilities contribution to the overall plant risk for the base case are assessed in this section [Ref. 28]. The 1E-06 per year LSIR contour generated from only the LPG storage and loadout area is shown in Figure 7-5.



Figure 7-5: 1E-06 per year Risk Contour Contributed by the LPG Storage & Loadout Area Scenarios only

The major risk contributors to the LPG area (point E) have been identified at Section 7.2 above. The LPG storage and loadout equipment does not feature in the lists as they do not contribute significantly to the overall risk. This is largely due to the low failure frequencies from the LPG equipment and the relatively small inventories compared to the main process area. Each LPG vessel only contributes to about 1% of the risk at point E.

The main vessels, pipework and equipment from the LPG storage and loadout area that contribute to this risk contour are summarized in Table 7-4.

Table 7-4: LPG Storage and Loadout Area Associated Scenarios

Description / Boundaries	Volume of Isolatable Section (m ³)
Natural Gasoline Storage Tank (F-4033)	65.0
Natural Gasoline Loadout Facilities (including Load Out Pump (G-4033), Loadout Hose (T-4003))	0.1
Natural Gasoline Road Tanker	20 tonnes
Vapour Section of Propane Storage Vessel (F-4003)	61.7
Liquid Section of Propane Storage Vessel (F-4003)	51.3
Vapour Section of Propane Storage Vessel (F-4004)	123.4
Liquid Section of Propane Storage Vessel (F-4004)	106.6
Vapour Section of Butane Storage Vessel (F-4001)	14.7
Liquid Section of Butane Storage Vessel (F-4001)	51.3
Vapour Section of Butane Storage Vessel (F-4002)	68.6
Liquid Section of Butane Storage Vessel (F-4002)	44.5
Propane and Butane Loadout Pumps (G-4002/4024, G-4001)	0.5

Description / Boundaries	Volume of Isolatable Section (m ³)
LPG Loadout Arm (T-4002)	0.1
LPG Road Tanker	20 tonnes
LPG Loadout (Smart Hose to Isotainers)	0.1
New LPG Road Tanker (Isotainer)	12 tonnes
Ethyl Mercaptan Odorant Injection Pump (G-4011)	0.2
Ethyl Mercaptan Transportable Odorant Drums (F-4007-A/ B)	0.2

The loadout frequencies assumed for the loadout equipment at the LPG area are summarised in Table 7-5.

Table 7-5: Loadout Frequencies

Description		Loading/Unloading	Load out Frequency (loadings/year)	Filling Time (hours/loading)
NGL	Tankers	Hose	715 (20 T/Load)	2 hours
LPG	Tankers	Arm	1452 (20 T/Load)	2 hours
	Isotainers	Hose	13 (12 T/Load)	1.2 hours
Ethyl Mercaptan	Transportable Odorant Drums (F-4007-A/B) contain Ethyl Mercaptan for odorising the LPG. 2 x 200L drums are swapped out approximately 12 times per year.			

8 SENSITIVITY CASES

The two sensitivities cases considered in the KGTP QRA study, as detailed in Section 2.5 are:

- Sensitivity Case 1: 98% ESDV Success Probability; and
- Sensitivity Case 2: Future Operation.

This section presents results of the QRA sensitivity cases.

8.1 Case 1. ESDV Success Probability of 98%

The ESD systems are intended shutdown and isolate the process inventories to reduce damage or risk of escalation. In the event an ESDV failed to close, the expected outcome is additional flow or inventory from the process system adding to the release.

In the QRA Base Case assessment, the probability of successful detection and isolation is assumed to be 100%. However, it is acknowledged that there is potential for detection and isolation to fail. The Probability of Failure on Demand (PFD) of the ESDV can be referenced from industry sources as follow:

- 0.001 – 0.01 per demand depending on the types of the ESD system (TNO Purple Book [Ref. 10]); and
- In the order of magnitude of 10^{-2} per demand (CMPT Quantitative Risk Assessment for offshore installation [Ref. 21]).

For the purpose of the Sensitive Case 1 assessment, ESDV success probability is assumed to be 98%, and the corresponding ESDV failure probability is 2%.

8.1.1 Isolatable Inventories for ESDV Failure Consideration

In Sensitivity Case 1, the inventory from the next connecting isolatable section (or the largest inventory if connecting with multiple isolatable sections) are added to the inventory from each isolatable section for the ESDV failure. The connecting isolatable sections have been identified from the P&IDs and are given in Table 8-1.

Table 8-1: Identification of the Connecting Isolatable Sections and Inventories

Isolatable Section	Description	Volume of Isolatable Section (m ³)		Connecting Isolatable Section	Volume of Connecting Isolatable Section Note 1 (m ³)		Total Volume (m ³)	
		Vapour	Liquid		Vapour	Liquid	Vapour	Liquid
KGT01	Raw gas and Maui gas lines, Dehydration and dewpoint unit, LPG production unit, Product gas lines, Utilities	233.0	56.3	KGT11 – Vapour; KGT04 - Liquid	41.3	4.0	274.2	60.3
KGT02	CO ₂ removal (Train 1)	36.2	-	KGT01	233.0	-	269.2	-
KGT03	CO ₂ removal (Train 2)	36.0	-	KGT01	233.0	-	269.0	-
KGT04	Mixed LPG - High Temperature Separator (M-307) and Wash Water Coalescer (M-302)	2.4	4.0	KGT01	233.0	56.3	235.4	60.3
KGT11	Mixed gas export from Product Gas Compressors (C-903-2/3/5) discharge	41.3	-	KGT01	233.0	-	274.2	-

KAPUNI GAS TREATMENT PLANT
QUANTITATIVE RISK ASSESSMENT REPORT

Isolatable Section	Description	Volume of Isolatable Section (m ³)		Connecting Isolatable Section	Volume of Connecting Isolatable Section Note 1 (m ³)		Total Volume (m ³)	
		Vapour	Liquid		Vapour	Liquid	Vapour	Liquid
	header to 100/200 Pipelines							
KGT13	Product gas export from Gas Storage Compressors (D4-0401/0402) to Gas Storage/070 Pipeline	23.5	-	KGT01	233.0	-	256.5	-
KGT32	NGL export from LPG production unit to KGTP/KPS boundary	-	0.4	KGT01	-	56.3	-	56.8
KGT33	NGL export from LPG production unit to Storage	-	4.7	KGT34	-	65.0	-	69.7
KGT34	NGL Storage Tank (F-4033)	-	65.0	KGT33	-	4.7	-	69.7
KGT35	NGL Loadout Pump (G-4033)	-	0.1	KGT34	-	65.0	-	65.1
KGT36	NGL Loadout System	-	0.1	KGT35	-	0.1	-	0.2
KGT37	Propane export from LPG production unit to Storage	-	2.5	KGT01	-	56.3	-	58.9
KGT39	Propane Storage Vessel (F-4003)	61.7	51.3	KGT37	-	2.5	61.7	53.9
KGT40	Propane Storage Vessel (F-4004)	123.4	106.6	KGT37	-	2.5	123.4	109.1
KGT41	Butane export from LPG production unit to Storage	-	2.6	KGT01	-	56.3	-	58.9
KGT43	Butane Storage Vessel (F-4001)	14.7	51.3	KGT41	-	2.6	14.7	53.8
KGT44	Butane Storage Vessel (F-4002)	68.6	44.5	KGT41	-	2.6	68.6	47.0
KGT45	Product Propane Loadout System	-	0.5	KGT40	-	106.6	-	107.1
KGT46	Product Butane Loadout System	-	0.5	KGT43	-	51.3	-	51.8
KGT47	Product LPG Loadout System	-	0.1	KGT45	-	0.5	-	0.6
KGT50	Odorant (Ethyl mercaptan) Injection System for LPG loadout	-	0.2	-	-	-	-	0.2
KGT51	Odorant (t-Butyl mercaptan) Injection System for Domestic	-	0.1	-	-	-	-	0.1

Isolatable Section	Description	Volume of Isolatable Section (m ³)		Connecting Isolatable Section	Volume of Connecting Isolatable Section Note 1 (m ³)		Total Volume (m ³)	
		Vapour	Liquid		Vapour	Liquid	Vapour	Liquid
KGT52	Odorant (t-Butyl mercaptan) Injection System for Gas Export Line	-	19.0	-	-	-	-	19.0
KGT55	Methanol Injection System	-	6.5	-	-	-	-	6.5
KGT70	Propane Refrigeration System	36.4	25.2	-	-	-	36.4	25.2
KGT80	CO2 Removal Unit – Ammonia System	3.3	4.9	-	-	-	3.3	4.9
KGT90	CO2 Removal Unit – Ammonia System	45.6	223.0	-	-	-	45.6	223.0

Notes:

1. For modelling purposes, only the inventory within the same phase are added, e.g. KGT02 contains vapour phase only, and is connected to KGT01 which contains both vapour and liquid phase, only the vapour inventory from KGT01 is added to KGT02.

8.1.2 Sensitivity Case 1 Release Frequencies

There are no changes in estimated release frequencies for the node sections in Sensitivity Case 1. Release frequencies assessment presented in Section 6.1 is applicable to Sensitivity Case 1.

8.1.3 Sensitivity Case 1 Risk Contours

Figure 8-1 presents the LSIR contour for KGTP Sensitivity Case 1.

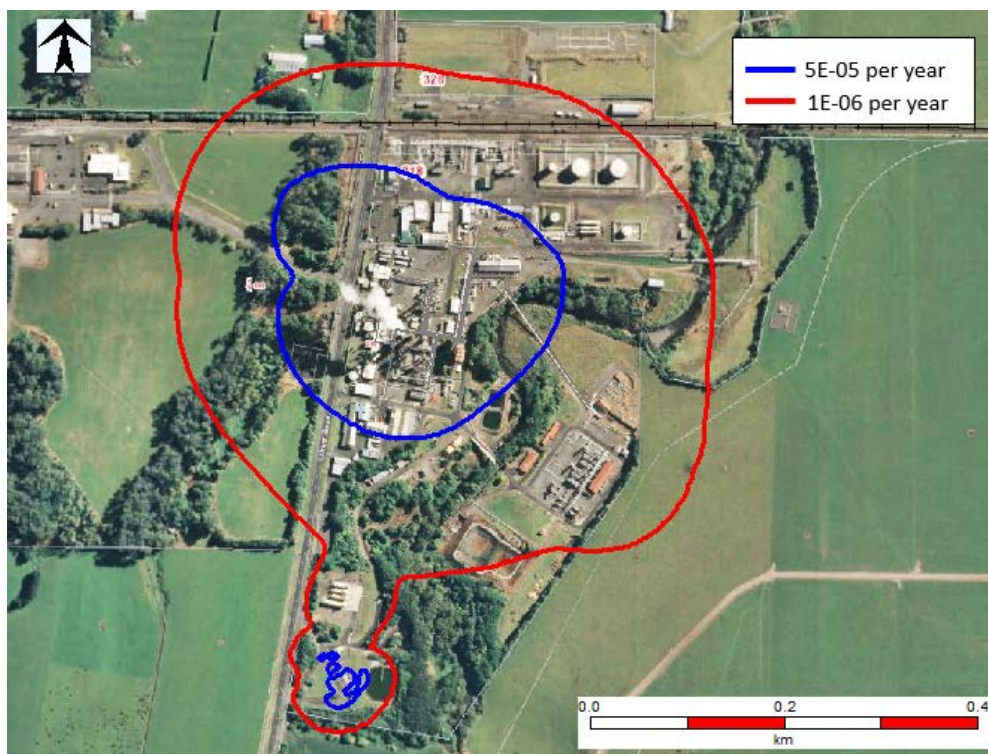


Figure 8-1: Sensitivity Case 1 LSIR Contours at KGTP

The 5E-05 per year and 1E-06 per year risk contours for Sensitivity Case 1 are shown to be similar to the Base Case risk contours (Figure 7-1). It can be concluded that the outcome of assessment against HIPAP 4 for Sensitivity Case 1 is same as that captured in the Base Case. Conclusions made in Table 7-2 are applicable for Sensitivity Case 1 as well.

The insignificant differences in risk contours for Sensitivity Case 1 when compared to Base Case is most likely due to:

- In most modelling cases, especially gas releases, it is expected that the consequence effects would have reached the steady state condition before the inventory depletes. Hence the additional inventory may lead to a prolonged fire event, but not increase the magnitude of the consequence; and
- The ESDV failure probability change is only 2%, therefore the frequencies of hazardous events (fire explosion or toxic) associated with increased consequences (if any) are not expected to be apparent in the risk contours.

8.2 Case 2. Future Operating Case

KGTP future operation at maximum throughput operation (29 Sm³/s) is considered in the QRA as Sensitivity Case 2.

8.2.1 Sensitivity Case 2 Release Scenarios

The additional release scenarios considered for the Sensitivity Case 2 assessment and the corresponding operating conditions are presented in Table 8-2. The volume of some isolatable sections for existing (Base Case) scenarios are increased due to maximum throughput consideration in Sensitivity Case 2.

Table 8-2: Release Scenarios and Operating Conditions (Sensitivity 2)

Node	Description / Boundaries	Stream No.	T (degC)	P (barg)	Max Pipe / Hose Diameter (mm)	Pipe / Hose Length (m)	Volume of Isolatable Section (m ³)
CO₂ Removal							
KGT05_RGS_07_V	Raw gas from Raw Gas header from HV-105-3 via Gas/Gas Heat Exchanger (E-101-3/2) to CO ₂ absorber tower (D-101-3) inlet (Benfield Train 3)	K101	15	40	300	15	33.0
KGT05_TGS_16_V	Treated gas from top of CO ₂ absorber tower (D-101-3) via Gas/Gas Heat Exchanger (E-101-3/2) and Gas Separator (M-101-3) adjoining with the inlet line to Strippers (D-201-3/4) in Dehydration and Dewpoint Control Unit (Benfield Train 3)	K102	42	40	300	15	33.0
Dehydration and Dewpoint Control							
KGT01_TGS_11_V	Treated gas from Strippers via Gas/Gas Heat Exchangers (E-303-1/2) and Gas Chiller (E-303-3) to 3 Phase Low Temperature Separator (M-306) inlet (No.1 Chilling System)	K203	42	40	200	43	271.6
KGT01_PGS_03_V	Product gas from top of 3 Phase Low Temperature Separator (M-306) via Gas/Gas Heat Exchanger (E-303-1/2) to PV-338 adjoining with Product Gas header (No.1 Chilling System)	K205	12	40	150	15	271.6
KGT01_MPG_02_L	Mixed LPG from bottom of 3 Phase Low Temperature Separator (M-306) to FV-381 on the line adjoining with inlet of Gas/Liquid Heat Exchanger (E-303-4) (No.1 Chilling System)	K204	12	40	100	15	56.3
Utilities and Cogen Unit							
KGT01_PGS_22_V	Product gas to Boilers (B-901-1/2)	K501	15	40	150	50	271.6
LPG Production Facility - Stabiliser, De-Ethanoliser							
KGT01_MPG_13_L	Mixed LPG from XSV-332 on outlet line of Wash Water Coalescer (M-302) in Dehydration unit to Stabiliser (D-420-1) inlet (LPG Production Train 1)	K401	12	30	150	144	56.3
KGT01_STT_01_V	Stabiliser (D-420-1) Top Vapour via Stabiliser OVHD Scrubber (M-420) to XSV-420 on inlet line to Suction Scrubber (M-421) (LPG Production Train 1)	K408	20	30	80	15	271.6
KGT01_PGS_10_V	Product gas from top of Stabiliser OVHD Scrubber (M-421) to Stabiliser OVHD Compressor (C-420-1/2) suction (LPG Production Train 1) (C-420-1 is on standby)	K408	20	30	100	90	271.6
KGT01_PGS_11_V	Product gas from Stabiliser OVHD Compressor (C-420-2) discharge via Stabiliser OVHD Compressor Cooler (E-420-5) to Product gas header (LPG Production Train 1)	K408	20	30	100	15	271.6
KGT01_STB_01_L	Stabiliser (D-420-1) Bottom Liquid to/from Stabiliser Reboiler (E-422-1) and to De-Propaniser Feed Surge Drum (F-420-3) inlet (LPG Production Train 1)	K402	100	30	150	15	56.3
LPG Production Facility - De-Propaniser							
KGT01_DPT_01_V	De-Propaniser (D-430-1) Top Vapour via De-Propaniser Condenser (E-430-1) to De-Propaniser Reflux Drum (F-430-1) (LPG Production Train 1)	K403	20	14	150	15	271.6
KGT01_DPX_01_L	Reflux from De-Propaniser Reflux Drum (F-430-1) via De-Propaniser Reflux Pumps (G-430-1/2) to De-Propaniser (D-430-1) (LPG Production Train 1) (G-430-2 is on stand-by.)	K403	20	14	100	15	56.3
KGT01_PC3_01_L	Product propane from De-Propaniser Reflux Pump (G-430-1) via Propane Product Cooler (E-4001-1) adjoining with export line to storages (LPG Production Train 1)	K403	20	14	50	22	56.3
KGT01_DPB_01_L	De-Propaniser (D-430-1) Bottom Liquid to/from De-Propaniser Reboiler (E-432-1) and to De-Butaniser (D-440-1/2) (LPG Production Train 1)	K404	105	14	150	44	56.3
LPG Production Facility - De-C4							
KGT01_DBT_01_V	De-Butaniser (D-440-1) Top Vapour via De-Butaniser Condenser (E-440-1) to De-Butaniser Reflux Drum (F-440-1) (LPG Production Train 1)	K405	20	7	100	15	271.6
KGT01_DBX_01_L	Reflux from De-Butaniser Reflux Drum (F-440-1) via De-Butaniser Reflux Pumps (G-440-1/2) to De-Butaniser (D-440-1) (LPG Production Train 1) (G-440-2 is on standby)	K405	20	7	80	15	56.3
KGT01_DBB_01_L	De-Butaniser (D-440-1) Bottom Liquid to /from De-Butaniser Reboiler (E-442-1) (LPG Production Train 1)	K406	115	7	150	15	56.3
KGT01_PC4_12_L	Product Butane from HV-450-1/2 on Debutaniser Reflux Pumps Discharge via Butane Cooler (E-450) adjoining with Product Propane at 60/40 Condensing Tank (M-430) inlet	K405	20	7	80	41	56.3
KGT01_PC3_13_L	Product Propane from Propane Product Coolers (E-4001-1/2) adjoining with Product Butane at 60/40 Condensing Tank (M-430) inlet	K403	20	14	50	15	56.3
KGT01_LPG_04_L	LPG product 60/40 via 60/40 Condensing Tank (M-430) to XSV-434 on KPS export line	K808	20	10.5	50	232	56.3
Propane Refrigeration System							
KGT70_REF_06_L	Propane refrigerant Gas Chiller (E-303-3)	K302	-34	1	150	64	25.2
CO₂ Recovery - CO₂							
KGT90_CO2_23_V	CO ₂ gas from CO ₂ Primary Separator (M-801-3)	K907	15	1	300	15	48.5

The modified isolatable section unit volume used in the Sensitivity Case 2 modelling are summarised in Table 8-3.

Table 8-3: Modified Volume of Isolatable Sections

Isolatable Section	Description	Volume of Isolatable Section (m ³) Base Case		Volume of Isolatable Section (m ³) Sensitivity Case 2	
		Vapour	Liquid	Vapour	Liquid
KGT01	Raw gas and Maui gas lines, Dehydration and dewpoint unit, LPG production unit, Product gas lines, Utilities	233.0	56.3	271.6	84.8
KGT05	CO ₂ removal (Train 3)	0 ^{Note 1}	0 ^{Note 1}	33.0	0
KGT70	Propane Refrigeration System	36.4	25.2	36.4	28.4
KGT90	CO ₂ Removal Unit – Ammonia System	45.6	223.0	48.5	223.0

Note 1: Only considered for Sensitivity Case 2 (for future operation).

8.2.2 Sensitivity Case 2 Leak Frequencies

The estimated release frequencies summary of each KGTP unit considered in Sensitivity Case 2 are presented in Table 8-4. The detail breakdown of release frequencies for each node sections are provided in Appendix 4.

Table 8-4: Release Frequencies Summary for KGTP Units (Sensitivity 2)

Node Section	Sensitivity 2 Release Frequencies (per year) ^{Note 1}						
	1 - 3 mm (2 mm)	3 - 10 mm (6 mm)	10 - 50 mm (22 mm)	50 - 150 mm (85 mm)	> 150 mm (Rupture)	Total	% Contribution
Raw Gas and Maui Gas Lines	1.50E-02	6.58E-03	3.50E-03	6.07E-04	1.03E-04	2.58E-02	2.4%
CO ₂ Removal	1.28E-02	5.82E-03	3.20E-03	6.10E-04	1.17E-04	2.25E-02	2.1%
Dehydration and Dewpoint Control	3.30E-02	1.45E-02	7.54E-03	1.71E-03	2.69E-04	5.70E-02	5.4%
Product Gas Lines and Compressors	6.28E-02	2.75E-02	1.39E-02	2.96E-03	4.61E-04	1.08E-01	10.2%
Pigging	3.58E-06	1.85E-06	1.03E-06	2.55E-07	1.16E-07	6.83E-06	<0.1%
Utilities and Cogen Unit	5.30E-02	2.18E-02	9.99E-03	2.03E-03	9.45E-05	8.70E-02	8.2%
LPG Production Facility - Stabiliser, De-C2	4.99E-02	2.16E-02	1.06E-02	2.81E-03	5.84E-05	8.49E-02	8.0%
LPG Production Facility - De-C3	3.13E-02	1.26E-02	6.06E-03	1.23E-03	3.30E-05	5.13E-02	4.8%
LPG Production Facility - De-C4	3.96E-02	1.59E-02	7.52E-03	1.63E-03	2.86E-05	6.47E-02	6.1%
LPG Production Facility - Product Export and Loadout	2.33E-02	9.14E-02	3.40E-03	6.87E-04	8.37E-03	1.27E-01	12.0%

Node Section	Sensitivity 2 Release Frequencies (per year) ^{Note 1}						
	1 - 3 mm (2 mm)	3 - 10 mm (6 mm)	10 - 50 mm (22 mm)	50 - 150 mm (85 mm)	> 150 mm (Rupture)	Total	% Contributi on
Propane Refrigeration System	3.99E-02	1.73E-02	8.06E-03	1.73E-03	3.22E-04	6.73E-02	6.3%
Mercaptans and Methanol	1.95E-02	2.01E-02	3.85E-03	2.05E-03	1.21E-03	4.68E-02	4.4%
CO ₂ Recovery - Ammonia	7.07E-02	2.81E-02	1.14E-02	2.90E-03	2.50E-04	1.13E-01	10.7%
CO ₂ Recovery - CO ₂	8.06E-02	9.70E-02	1.56E-02	4.22E-03	6.81E-03	2.04E-01	19.3%
Total	5.31E-01	3.80E-01	1.05E-01	2.52E-02	1.81E-02	1.06E+00	100.0%
% Contribution	50.2%	35.9%	9.9%	2.4%	1.7%	100.0%	-

Notes:

1. Release frequencies estimated has considered the operating factor of equipment.

The Sensitivity Case 2 scenarios have higher total release frequencies of 1.1 per annum, equivalent to one leak every 0.9 year. There is approximately 6% increase in total release frequencies for Sensitivity Case 2. This can be attributed to Sensitivity Case 2 considered additional equipment in operation. Similarly, to the Base Case, 50% of the leak frequencies are contributed from the “1 – 3 mm” hole sizes range.

8.2.3 Sensitivity Case 2 Risk Contours

Figure 8-2 presents the LSIR contour for Sensitivity Case 2.

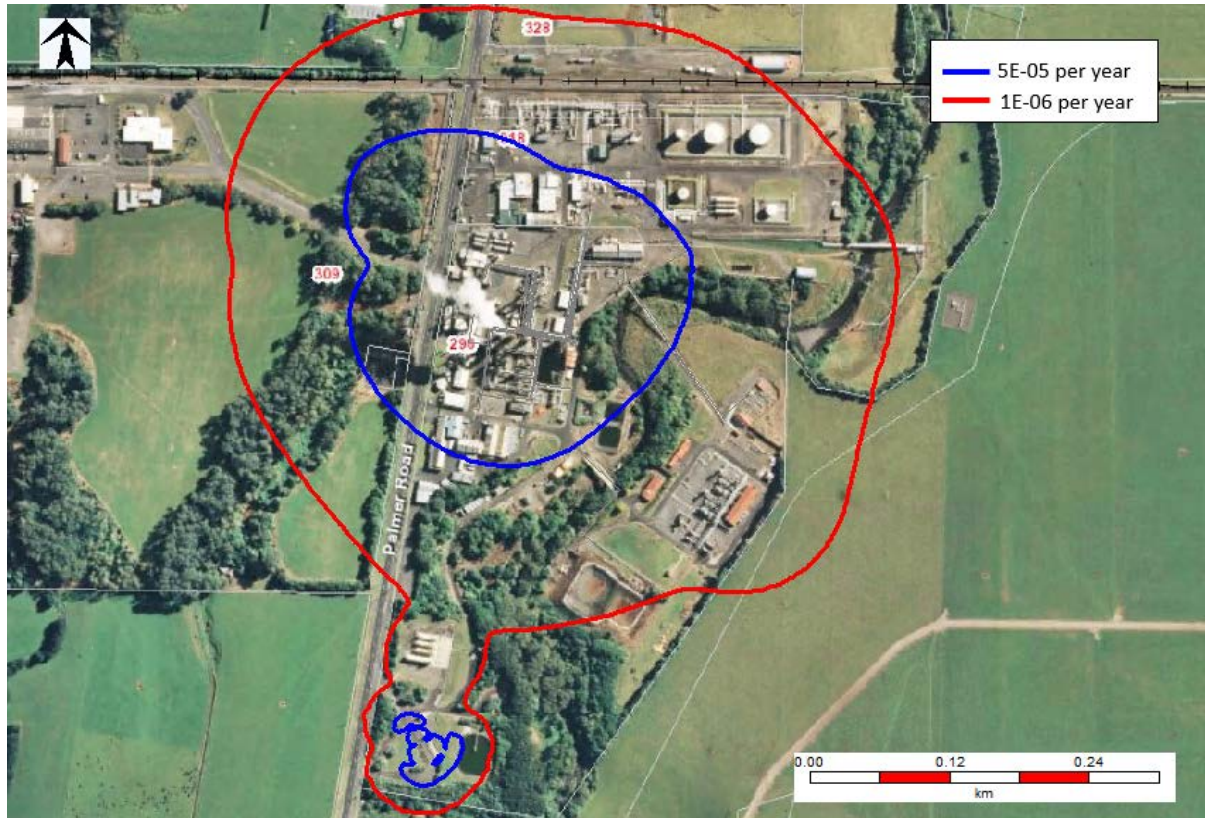


Figure 8-2: Sensitivity Case 2 LSIR Contours at KGTP

When compared to the Base Case, it can be seen that the Sensitivity Case 2 risk contours of 5E-05 per year and 1E-06 per year are slightly larger. This is particularly apparent at the LPG/NGL loading area, which is due to an increased in loading frequencies for both the NGL and LPG scenarios. The slight increase in 5E-05 per year and 1E-06 per year contours however does not change the assessment conclusions made against HIPAP 4 criteria. Conclusions made in Table 7-2 are applicable to Sensitivity Case 2 as well. Although there are additional equipment and inventories considered in Sensitivity Case 2, the increase in risk levels are not significant. This is most likely due to:

- The additional nodes/sections considered in Sensitivity Case 2 only formed a small part of the overall KGTP hazardous nodes/sections. There is approximately 18% increase in total release frequency for Sensitivity Case 2 as compared to the Base Case, with 50% of the increase is from the “1-3 mm” leak category; and
- In most modelling cases, especially gas releases, it is expected that the consequence effects would have reached the steady state condition before the inventory depletes. Hence the additional inventory may lead to a prolonged fire event, but not increase the magnitude of the consequence.

8.2.4 Sensitivity Case 2 Risk Contributor Analysis

The major risk contributing scenarios towards the risk points of interests for Sensitivity Case 2 (which has the worst case risk results) are presented in Table 8-5.

Table 8-5: Major Risk Contributors to Selected Locations for Sensitivity Case 2 Assessment

Risk Points	Release Source	Description	LSIR (per year)	Percentage of Risk Contribution
A - Shed	KGT80_AMM_04_L_71mm	Ammonia liquid from Liquid Receivers via Liquid Sub-Coolers (E-826/896) and CO ₂ Condenser (E-804) to Oil Receiver (M-828)	5.22E-07	41.6%
	KGT80_AMM_03_L_71mm	Ammonia liquid from Ammonia Condensers (E-895/825) to Liquid Receiver (F-803/F-823)	4.22E-07	33.6%
B - Ballance Site 1	KGT80_AMM_04_L_22mm	Ammonia liquid from Liquid Receivers via Liquid Sub-Coolers (E-826/896) and CO ₂ Condenser (E-804) to Oil Receiver (M-828)	2.97E-05	34.1%
	KGT80_AMM_03_L_22mm	Ammonia liquid from Ammonia Condensers (E-895/825) to Liquid Receiver (F-803/F-823)	2.22E-05	25.5%
C - Ballance Site 2	KGT80_AMM_04_L_22mm	Ammonia liquid from Liquid Receivers via Liquid Sub-Coolers (E-826/896) and CO ₂ Condenser (E-804) to Oil Receiver (M-828)	3.75E-05	34.7%
	KGT80_AMM_03_L_22mm	Ammonia liquid from Ammonia Condensers (E-895/825) to Liquid Receiver (F-803/F-823)	2.47E-05	22.8%
D - KGTP Site East	KGT13_PGS_16_V_85mm	Product Gas from Gas Storage Compressor (D4-0401) Discharge via Gas Storage Compressor Cooler (D2-0402) to Coalescer (D11-0417) inlet	6.65E-07	32.9%
	KGT13_PGS_15_V_85mm	Product Gas to Gas Storage Compressors (D4-0401/0402) Inlet (D4-0402 is on standby)	3.87E-07	19.1%
E- LPG Area	KGT01_TGS_10_V_212mm	Treated gas from Strippers via Gas/Gas Heat Exchangers (E-313-1/2) and Gas Chiller (E-313-3) to Low Temperature Separator (M-313) inlet	2.84E-07	20.4%
	KGT01_PGS_01_V_245mm	Product Gas header from Dehydration and Dew Point Unit to Product Gas Compressors Inlet header, domestic supply and sending Product Gas export to KPS and Whareroa (up to KPS/KGTP Site Boundary)	1.32E-07	9.5%

The major risk contributors for Sensitivity Case 2 are consistent with the major risk contributors for Base Case, with just slight differences on the fraction of risk contribution.

9 POTENTIAL CUMULATIVE RISK FROM KPS AND KGTP

The KPS plant, which is located to the north of the KGTP plant, is also under Todd's ownership / control. Risk from KPS was assessed and presented in the KPS QRA report [Ref. 29]. That report was commissioned for the South Taranaki District Plan Environment Court process.

Consistent assumptions and methodologies have been adopted for both QRAs, which followed the Todd Energy QRA Methodology Guideline [Ref. 2]. The KPS base case LSIR contour is shown in Figure 9-1.

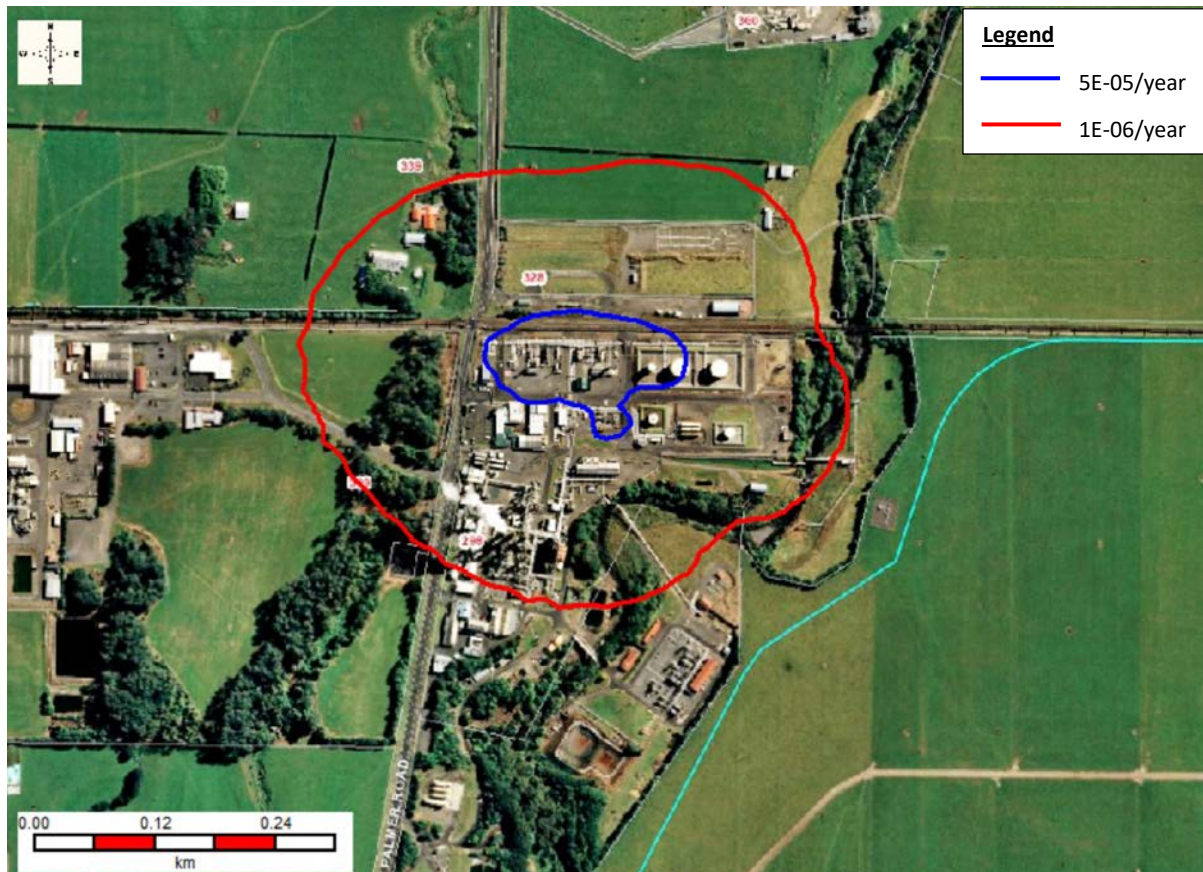


Figure 9-1: KPS LSIR Contour

The KPS QRA was completed using DNV Safeti software version 6.7 (formerly known as Phast Risk). Newer versions of the software have since been released, and one of the improvements made allows more accurate modelling of vapour dispersion distances, especially for large releases. The older version (e.g. Phast Risk 6.7) generally produced more conservative dispersion distances.

The plant has also been modified since the KPS QRA was finalised and accepted by the South Taranaki District Council in July 2020. The stabilizer replacement project, including additional isolation valves to reduce the inventory for some isolatable sections. This was considered in the KPS QRA (as sensitivity case 3) and has led to further risk reduction.

The KPS model was then upgraded to Safeti version 8.22 and combined with the KGTP Safeti model to generate the integrated QRA model. Releases from both plants and the interaction between them (e.g. a flammable vapour cloud from one plant entering the congested area at another plant) were taken into consideration when run as a single model to produce the cumulative risk.

The cumulative risk contours considering risks from both KPS and KGTP are presented in Figure 9-2.

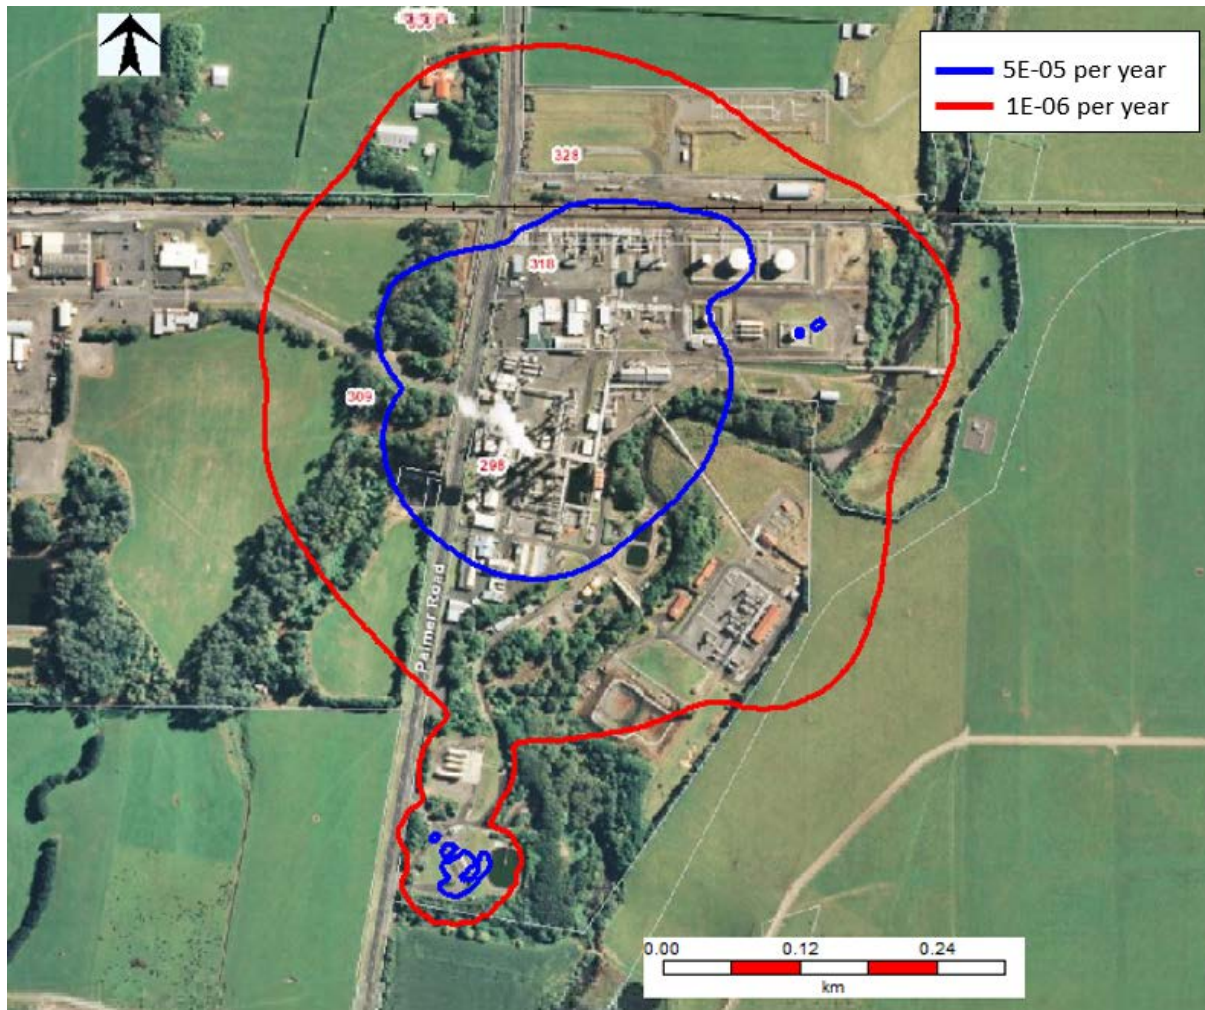


Figure 9-2: KPS and KGTP Integrated LSIR Contours

The risk contour for the cumulative risk does not extend further offsite in any direction, than the individual plant contours. This shows that there are no noticeable potential synergistic or cumulative offsite risks from Todd owned and operated plant. The risk assessment against the HIPAP4 criteria is as presented in Table 9-1.

Table 9-1: Risk Assessment Against HIPAP4 Criteria for the Cumulative Risk

Overall LSIR	Risk Contour	Risk Criteria	Observations
5E-05 / year	Blue	<i>Industrial</i> 5E-05 / year risk contour should, as a target, be contained within the boundaries of the industrial site where applicable.	<ol style="list-style-type: none"> The 5E-05 per year risk contour remains mostly within the Todd Energy site boundary, with the exception at the west boundary. The 5E-05 per year contour extends across Palmer Road and into the bushes at the west boundary of the Ballance site.
1E-06 / year	Red	<i>Residential</i> 1E-06 / year risk contour should not extend to residential, hotels, motels, tourist resorts	<ol style="list-style-type: none"> The 1E-06 per year risk contour extends onto the dwelling and farm building in the immediate vicinity of KPS to the northwest.

10 CONCLUSIONS

A quantitative risk assessment (QRA) was carried out to assess the risk levels at Kapuni Gas Treatment Plant (KGTP) due to fire, explosion and toxic hazards.

The assessment considers risks from KGTP for the following cases:

- Base Case – all facilities currently in operation;
- Sensitivity Case 1 – all facilities currently in operation with reduced ESDV success rate of 98% instead of 100%; and
- Sensitivity Case 2 – all facilities currently in operations including standby and mothballed facilities which might be brought back to operation in the future.

The overall risk levels are compared to the NSW HIPAP 4 [Ref. 8] risk criteria. The main findings of the QRA for all 3 cases are summarised in Table 10-1.

Table 10-1: QRA Main Findings

Case	Main Findings
Base Case	<ol style="list-style-type: none"> 1. The 5E-05 per year contour extends into the KPS site to the north but remains within the Todd Energy site boundary. 2. The 5E-05 per year contour extends across Palmer Road and into the bushes at the west boundary of the Ballance site. 3. The 1E-06 per year contour extends onto the property of the neighbour to the northwest (approximately 180m NW of KGTP northern boundary) but does not extend as far as the dwelling and farm buildings. 4. The main risk contributors to the shed area are ammonia toxic events from the 71 mm leaks from the Liquid Receivers (KGT80_AMM_04_L_71mm) and Ammonia Condensers (KGT80_AMM_03_L_71mm) within the CO2 Recovery Unit at approximately 15°C and 15 barg. 5. The main risk contributors to the Ballance site bushes are ammonia toxic events from the 22 mm leaks from the Liquid Receivers (KGT80_AMM_04_L_22mm) and Ammonia Condensers (KGT80_AMM_03_L_22mm) within the CO2 Recovery Unit at approximately 15°C and 15 barg. 6. The main risk contributors to the rural land area to the east of the plant are Product Gas jet fire events from the 85 mm leaks from the Product Gas from the Gas Storage Compressor (D4-0401) to Coalescer (KGT13_PGS_16_V_85mm), and Product Gas feeding to the Gas Storage Compressor (KGT13_PGS_15_V_85mm) within the Product Gas Lines and Compressors unit (at approximately 15°C and 40 barg).

Case	Main Findings
Sensitivity Case 1 – ESDV Success Probability of 98%	<ol style="list-style-type: none"> 1. There are no significant changes to the risk contours with modification of the ESDV success probability. The assessment made against the HIPAP 4 criteria remains the same as per the base case. 2. The similar risk contours finding is due to: <ul style="list-style-type: none"> - The ESDV failure probability change is only 2%, therefore the frequencies of hazardous events (fire explosion or toxic) associated with increased consequences (if any) are not expected to be apparent in the risk contours; and - In most modelling cases, especially gas releases, it is expected that the consequence effects would have reached the steady state condition before the inventory depletes. Hence the additional inventory may lead to a prolonged fire event, but not increase the magnitude of the consequence.
Sensitivity Case 2 – Future Operations	<ol style="list-style-type: none"> 1. The risk contours for Sensitivity Case 2 risk contours is slightly larger when compared to the Base Case risk contours, however the contour increase is relatively small. The assessment made against the HIPAP 4 criteria remains the same as per the base case. 2. The slight increase in risk contours is due to: <ul style="list-style-type: none"> - The additional nodes/sections considered in Sensitivity Case 2 only formed a small part of the overall KGTP hazardous nodes/sections. There is approximately 18% increase in total release frequency for Sensitivity Case 2 as compared to the Base Case, with 50% of the increase is from the “1-3 mm” leak category; and - In most modelling cases, especially gas releases, it is expected that the consequence effects would have reached the steady state condition before the inventory depletes. Hence the additional inventory may lead to a prolonged fire event, but not increase the magnitude of the consequence.

11 REFERENCES

1. Kapuni Gas Treatment Plant – Assumptions Register for FEA and QRA, 610115-RPT-R0001-R0, Worley, July 2020.
2. Todd Energy Fire and Explosion Analysis and Quantitative Risk Assessment Methodology Guideline, NZ-1005-TECD721654, Rev. 0.
3. Onshore QRA Method Statement, PCD-473, Rev. A, Worley, May 2015.
4. KGTP Process Conditions Summary provided by Todd Energy (Kelly Wilson) via email: New Process Conditions for KGTP QRA, 7 May 2020
5. Email communication between Worley (Hailey Lee) and Todd Energy (Kelly Wilson) on 25 May 2020; Email Subject: KGTP QRA Discussion Note (25 May 2020).
6. DNV Safeti 8.22 software
7. Oil and Gas UK, Fire and Explosion Guidance, Issue 1 May 2007
8. New South Wales Hazardous Industry Planning Advisory Paper No. 4, Risk Criteria for Land Use Safety Planning, January 2011
9. Taranaki Regional Council,
<https://maps.trc.govt.nz/LocalMapView/?map=5113f49337a84cf098db177c728b1361>
10. TNO Purple Book, Guidelines for Quantitative Risk Assessment, December 2005
11. TNO Green Book, Methods for the Determination of Possible Damage, 1992
12. OGP 434-1, Process Release Frequencies, September 2019
13. OGP-434-3, Storage Incident Frequencies, March 2010
14. OGP-434-6, Ignition Probabilities, September 2019
15. IP research report, Ignition probability review, model development and look-up correlations, January 2006.
16. Email communication between Worley (Elsimarie Gloy) and Todd Energy (Roisin Johnson) on 17 June 2020; Email Subject: RE: [External] RE: Notes from meeting
17. KGTP Site Layouts, 1000000-0200-0005-01, Sheet 01, Rev. 38, January 2020.
18. Flammability of Hydrocarbon/CO₂ Mixtures: Part 1. Ignition and Explosion Characteristics, Pursell et al., January 2011.
19. New Zealand National Climate Database (<http://cliflo.niwa.co.nz/>)
20. UK HSE Toxicity Levels of Chemicals (<https://www.hse.gov.uk/chemicals/haztox.htm>)
21. CMPT Quantitative Risk Assessment for offshore installation, DNV Technical.
22. Review of Vapour Cloud Explosion Incidents, UK Health and Safety Executive Research Report, RR1113, 2017.
23. Operative District Plan, South Taranaki District Council, December 2004.
24. Safety and Environmental Standards for Fuel Storage Sites, Process Safety Leadership Group Final Report, UK Health and Safety Executive, 2009
25. Do Not Believe the Hype: Using Case Studies and Experimental Evidence to Show Why the HSE is Wrong about Excluding Deflagration-to-Detonation Transitions. June 2019 Published on behalf of the AIChE. Process Safety Progress (Vol.38, No.2). Scott Davis, John Pagliaro, Drew Botwinick, Thomas DeBold, Kees van Wingerden, Dan Allason, and D. Michael Johnson

26. FABIG Technical Note 12 Vapour cloud development in over-filling incidents. April 2013. Fire and Blast Information Group (FABIG).
27. Vapour Cloud Formation, Experiments and modelling, UK Health and Safety Executive Research Report (RR908), 2012.
28. Letter dated 16 November 2020 to Nik Pyselman, Subject: LPG Storage & Loadout Risk Contribution (610115-LTO-C0001).
29. Kapuni Production Station – Quantitative Risk Assessment Report, 620052-RPT-R0002-R4, June 2020.

Appendix 1.
Sectionalised P&IDs

EQUIPMENT No.


DESCRIPTION
CAPACITY
MAWP @ TEMP

D-101-1
CO2 ABSORBER TOWER
64m³
55.2 Barg @ 127°C OR 49.4 @ 146°C

E-105-1
GAS COOLER
1.1m³
TUBE: 60.33 Barg @ 138°C
SHELL: 17.0 Barg @ 93°C

M-101-1
GAS SEPARATOR
4.1m³
52 Barg @ 0°C to 138°C

- NOTES:
1. THE LV OPERATING SPEED IN OPEN DIRECTION IS TO BE LIMITED.
 2. HAND SWITCH INITIATES RAMP OF SET POINT FOR CARBONATE PUMP START UP.
 3. VALVE TRIM SEALED SIDE MUST POINT UPSTREAM.
 4. FLUSHING POINT USING FLUSHING RING ASSEMBLY SPI-275.
 5. VALVE & OUTLET LOCATED AT TOP PLATFORM.
 6. FLUSHING RING FITTED
 7. 300# OUT OF SPEC FLANGES IN 1H1/1C1 LINE SEGMENT REQUIRED DUE TO BACK PRESSURE EXERTED BY RO-106-1A/1B
 8. HIGH PRESSURE CONDENSATE FLUSHING PROVIDED FOR START-UP & FAULT CONDITIONS.
 9. SPEED SETPOINT TO SELECTED CARBONATE PUMP CONTROLS.
 10. HS-127-1 AND FIC-127-1 ARE PART OF COORDINATED PLANT INLET FLOW CONTROL ACROSS ALL THREE TRAINS.
 11. OPEN END ELEVATION OF HPV TO BE ABOVE PSE-144-1.

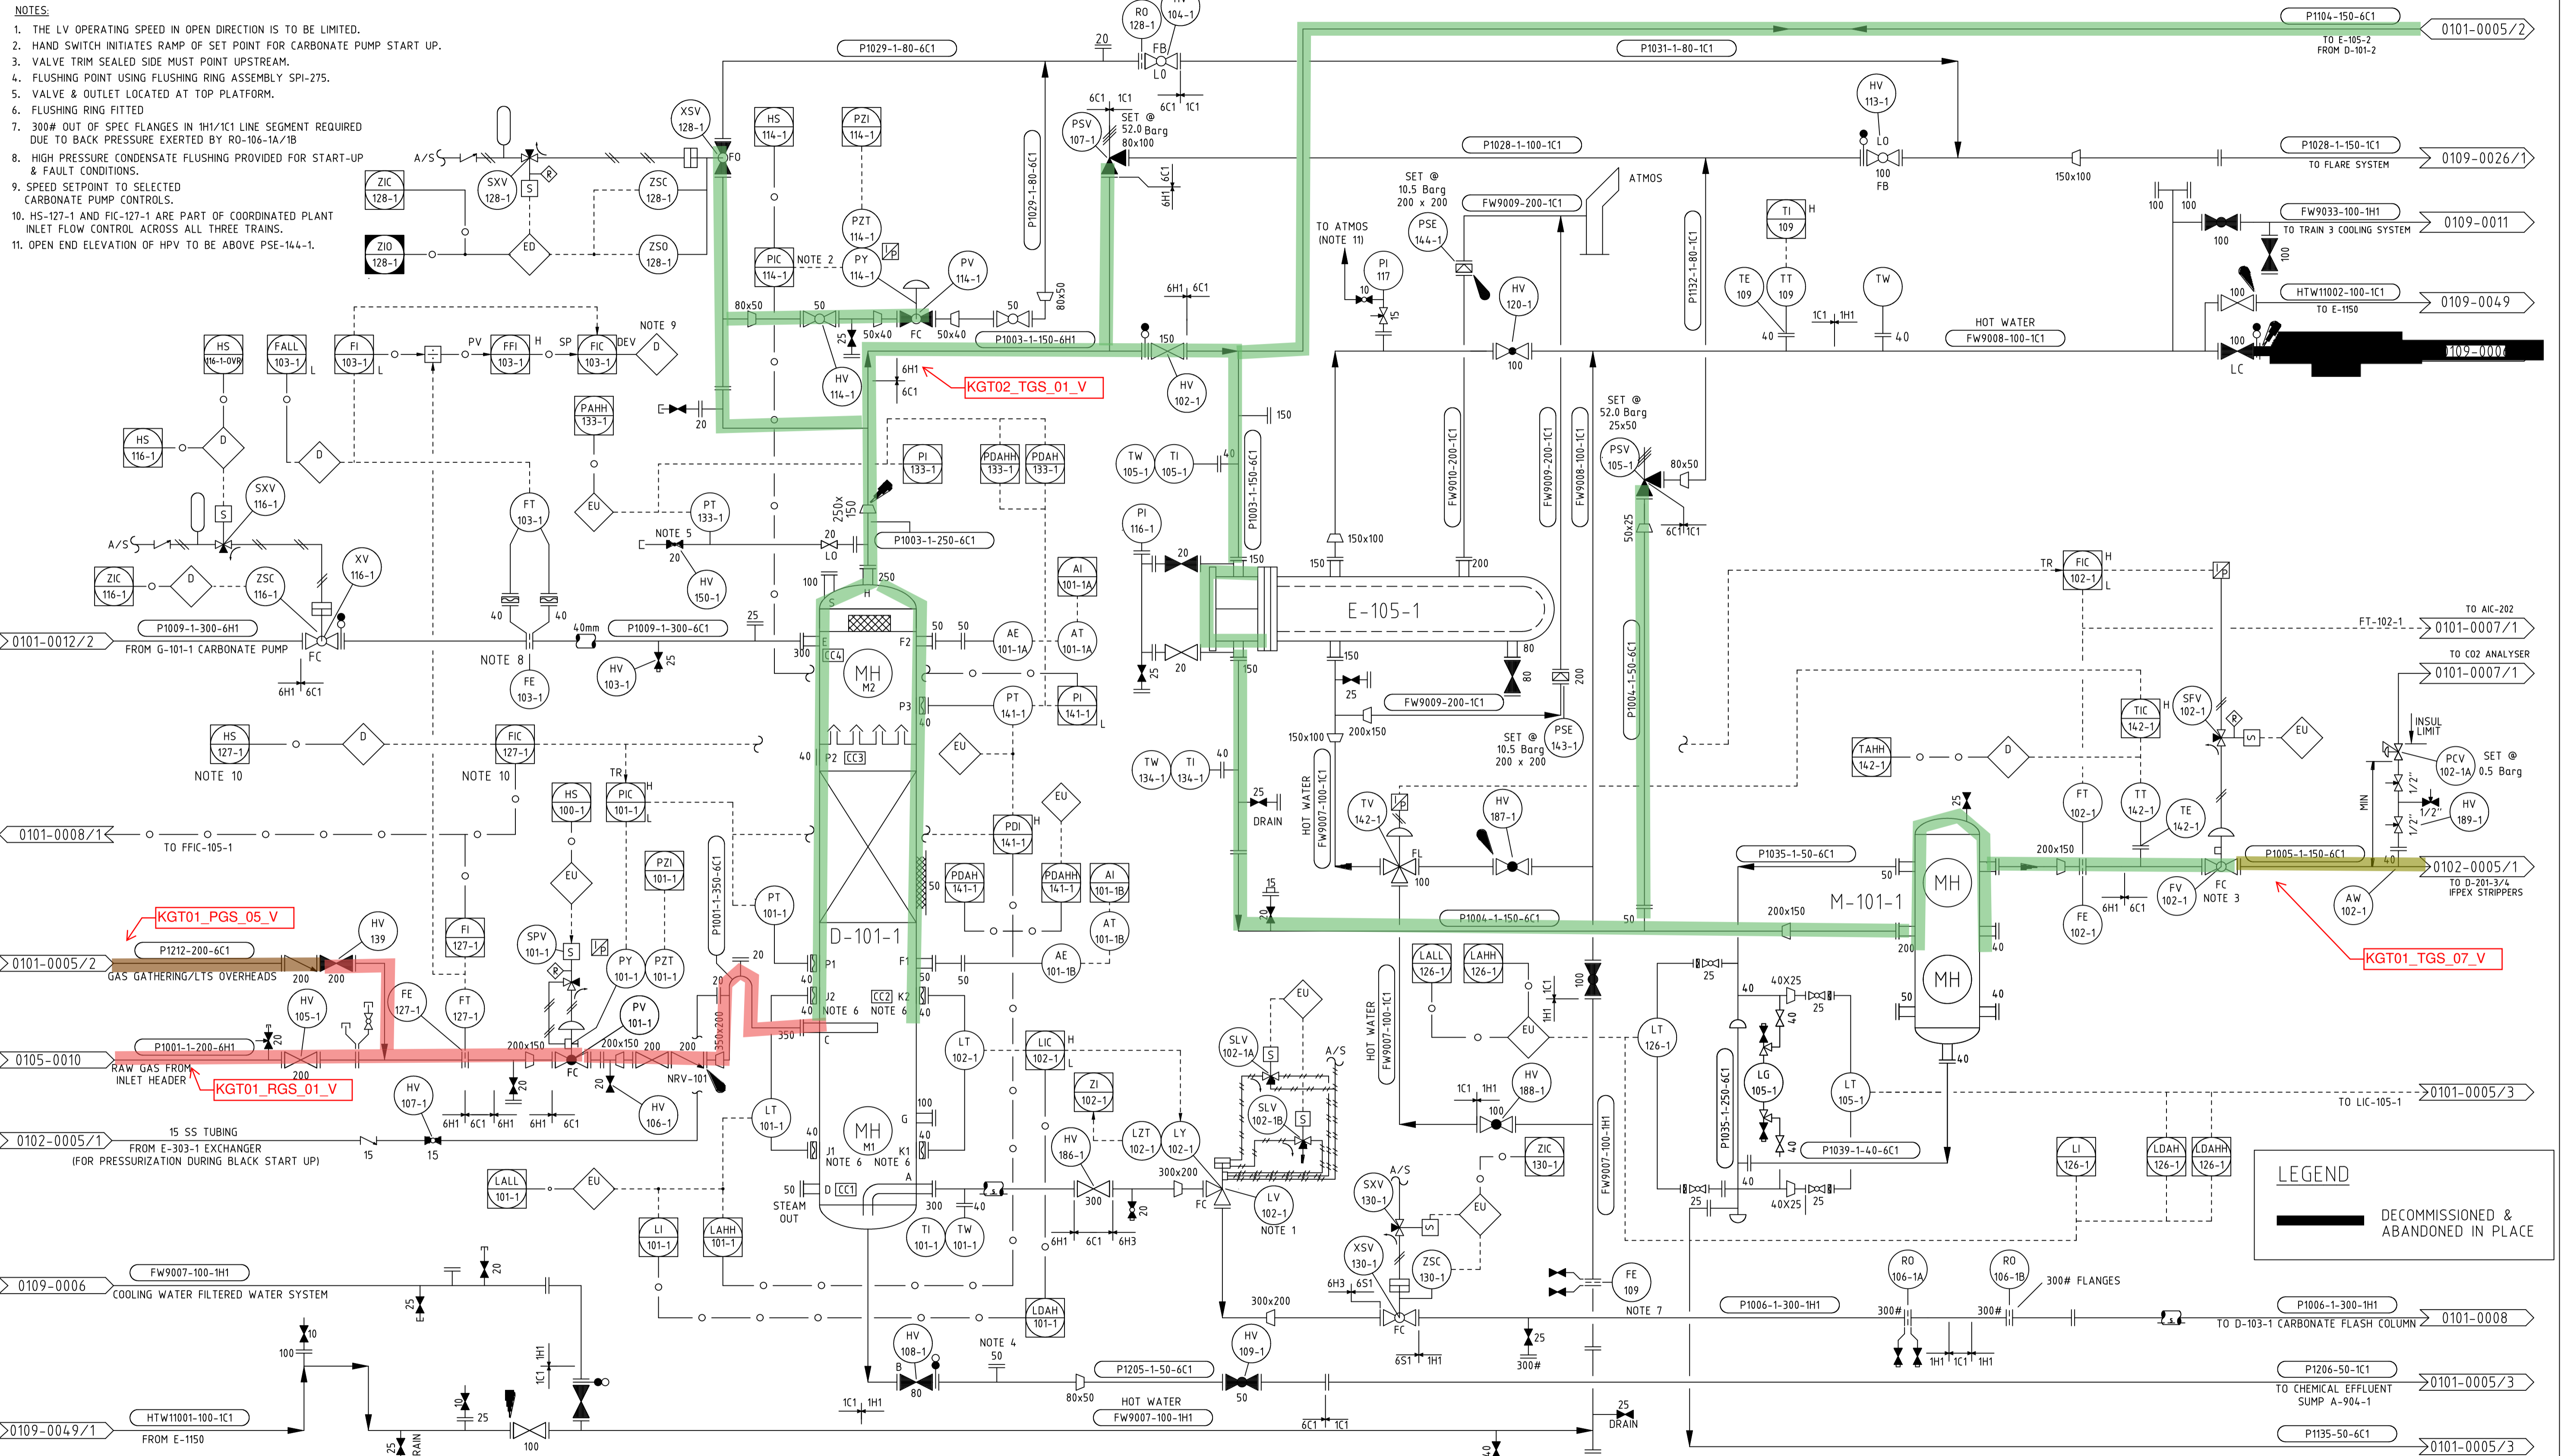

REV	AMENDMENT	BY	CHK	ENG	APP	DATE	REV	AMENDMENT	BY	CHK	ENG	APP	DATE
42	AS BUILT P84-875 VALVE HV-186-1 REPLACEMENT	RL	SR	AM	SES	08/2013	32	AS BUILT WS1256761 GAS VALVE PROXIMITY SWITCH	ES	RL/CB	LH	SES	05/08
41	SITE AS BUILT PDI-141-1	RL	AAB	AM	SES	07/2013							
40	AS BUILT P84-1041 FLARE GAS MEASUREMENT	ES/RL	TC	AM	SES	09/12							
39	AS BUILT P84-1067 GAS COOLER HIGH TEMP TRIP	ES/RL	AAB	SRH	SES	10/11	49	AS BUILT P84-1274 DEMIN 2 DECOMMISSIONED	RL	JC	AM	TC	10/2019
38	PARTIAL AS BUILT FOR PROJECT 520421	CJ	NB	JS	LH	03/11	48	AS BUILT P84-2105 HIGH POINT VENT ON GAS COOLER	RL	JC	AM	TC	03/2019
37	PARTIAL AS BUILT P84-1042 FLASH COL PSV REPLACEMENT	CJ	NB	JS	LH	01/11	47	AS BUILT FOR P84-1405 INLET PRESS/FLOW CONTROL	JC/RL	AAB	AM	TC	08/2018
36	AS BUILT AIT-102-1 MOVED TO DRG 0101-0007/1	ES/RL	TC	LH	SES	10/10	46	AS BUILT SCR-640 HS-116-1-OVR	JC/RL	AAB	AM	SES	09/2016
35	AS BUILT WS2007362 BENFIELD CO2 SLIP IN DCS	ES	RL	LH	SES	05/10	45	AS BUILT P84-848 WOBBER CONTROL	ES/RL	AAB	AM	SES	08/2014
34	AS BUILT WS1404939 BENFIELD RELIEF VALVE UPGRADE	VB	KS	PWM	LH	09/09	44	AS-BUILT P84-832 GAS SEPARATOR LEVEL TRANSMITTER	JB	JC	AM	SES	05/2014
33	AS BUILT WS1333085 M-101-182 SYSTEM RE-RATE	VB	KS	KS	LH	09/09	43	HAND VALVE NUMBERS ADDED FOR ISOLATIONS	RL	JC	AM	SES	10/2013

VECTOR KAPUNI LIMITED
PRIVATE BAG 2020
NEW PLYMOUTH 4342
PHONE 0800 734 567

COPYRIGHT The copyright in this document is vested in Vector Kapuni Limited
The contents of this document shall not be reproduced, either in whole or part, by any
means whatsoever without the prior written consent of Vector Kapuni Limited.

DRN	P.RAWLES	03/03/1987	ENG	R.VanLUF	02/07/1987
CHK	R.VanLUF	02/07/1987	APP		

SCALE:	JOB NO.	SERIES	DRG. NO	SHT 01	REVISION
NTS	1000000	0101	0005	OF 03 SHTS	49


EQUIPMENT No.

DESCRIPTION
CAPACITY
MAMP @ TEMP

D-101-2
CO2 ABSORBER TOWER
64m3
4.9 Barg @ 127°C

E-105-2
GAS COOLER
1.2m3
TUBE: 60.3 Barg @ 138°C
SHELL: 17 Barg @ 93°C

M-101-2
GAS SEPARATOR, T2
4.1m3
52 Barg @ 0°C TO 138°C

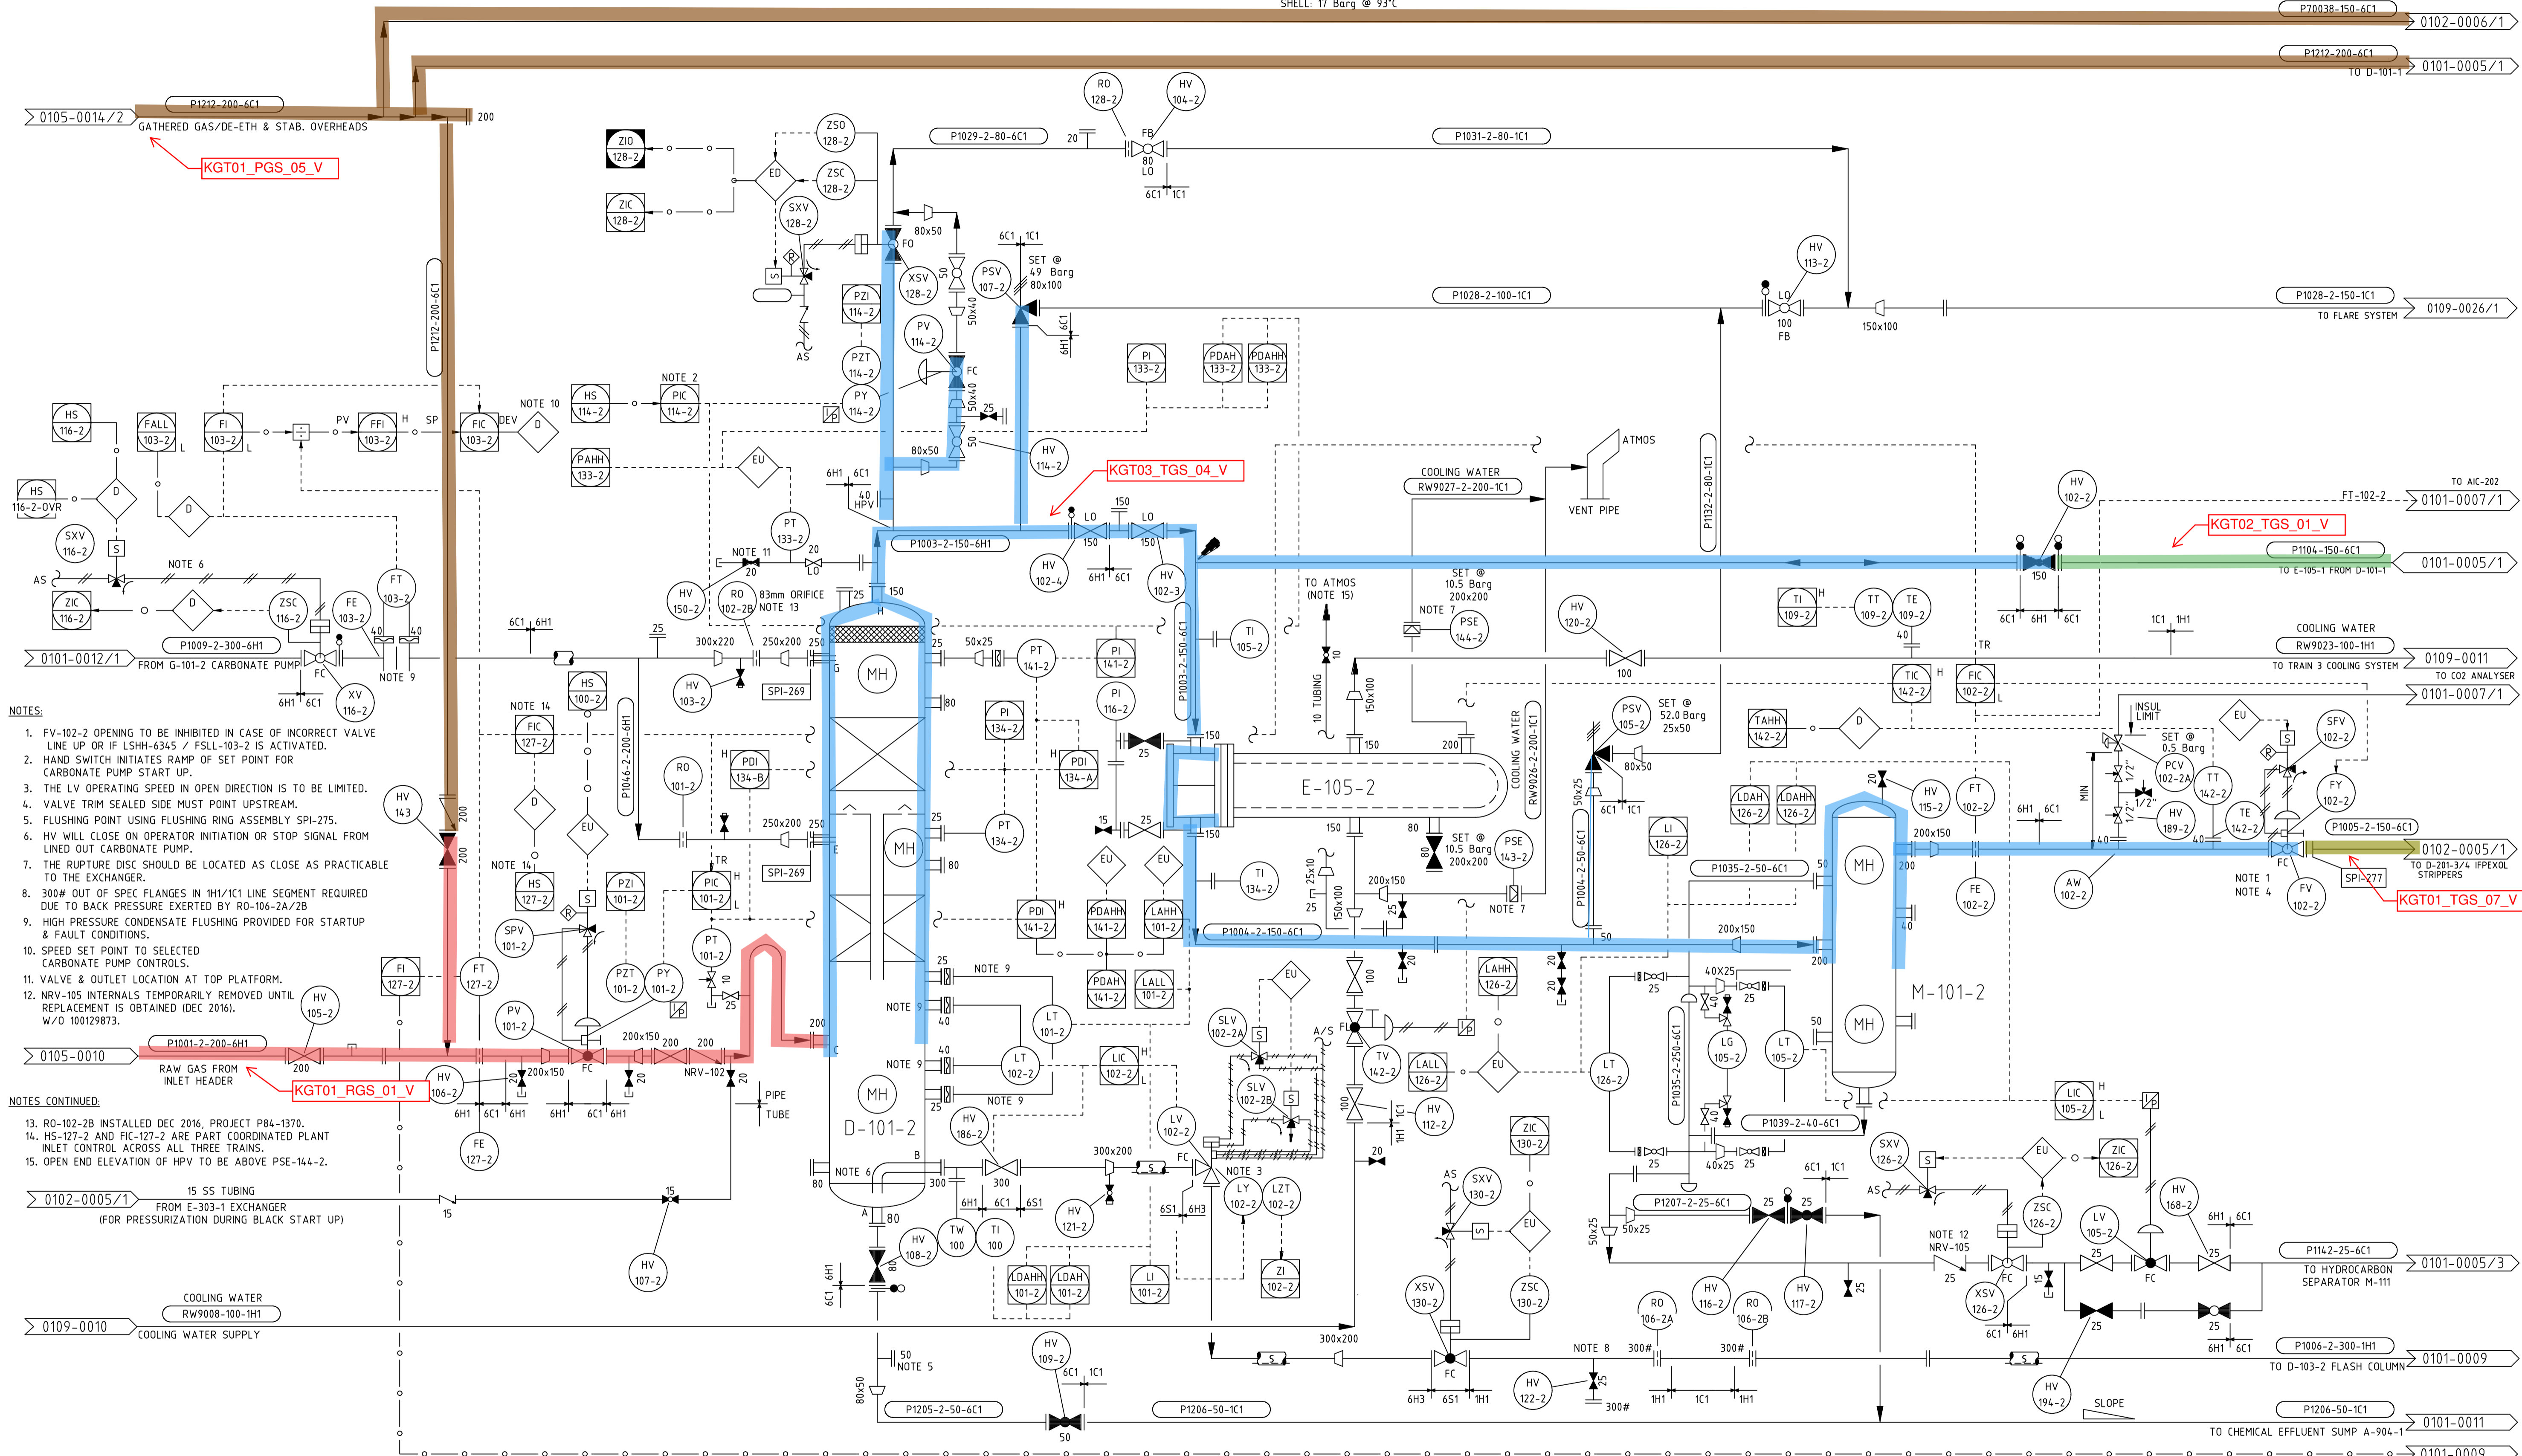

- NOTES:
- FV-102-2 OPENING TO BE INHIBITED IN CASE OF INCORRECT VALVE LINE UP OR IF LSHH-6345 / FSL-103-2 IS ACTIVATED.
 - HAND SWITCH INITIATES RAMP OF SET POINT FOR CARBONATE PUMP START UP.
 - THE LV OPERATING SPEED IN OPEN DIRECTION IS TO BE LIMITED.
 - VALVE TRIM SEALED SIDE MUST POINT UPSTREAM.
 - FLUSHING POINT USING FLUSHING RING ASSEMBLY SPI-275.
 - HV WILL CLOSE ON OPERATOR INITIATION OR STOP SIGNAL FROM LINED OUT CARBONATE PUMP.
 - THE RUPTURE DISC SHOULD BE LOCATED AS CLOSE AS PRACTICABLE TO THE EXCHANGER.
 - 300# OUT OF SPEC FLANGES IN 1H1/1C1 LINE SEGMENT REQUIRED DUE TO BACK PRESSURE EXERTED BY RO-106-2A/2B
 - HIGH PRESSURE CONDENSATE FLUSHING PROVIDED FOR STARTUP & FAULT CONDITIONS.
 - SPEED SET POINT TO SELECTED CARBONATE PUMP CONTROLS.
 - VALVE & OUTLET LOCATION AT TOP PLATFORM.
 - NRV-105 INTERNALS TEMPORARILY REMOVED UNTIL REPLACEMENT IS OBTAINED (DEC 2016). W/O 100129873.
- NOTES CONTINUED:
- RO-102-2B INSTALLED DEC 2016, PROJECT P84-1370.
 - HS-127-2 AND FIC-127-2 ARE PART COORDINATED PLANT INLET CONTROL ACROSS ALL THREE TRAINS.
 - OPEN END ELEVATION OF HPV TO BE ABOVE PSE-144-2.

REV	AMENDMENT	BY	CHK	ENG	APP	DATE	REV	AMENDMENT	BY	CHK	ENG	APP	DATE
41	AS BUILT P84-3007 ESD LEVEL TRANS DEVIATION ALARMS	ES	TC	LH	SES	03/10	51	AS-BUILT P84-832 GAS SEPARATOR LEVEL TRANSMITTER	JB	JC	AM	SES	05/2014
							50	HAND VALVE NUMBER HV-189-2 ADDED FOR ISOLATIONS	RL	CR	AM	SES	12/2013
							49	AS BUILT P84-875 VALVE HV-186-2 REPLACEMENT	RL	SR	AM	SES	08/2013
58	AS BUILT P84-1496 P114-2, REMOVAL OF THREADED FITTINGS	RL	JCC	AM	TC	07/2019	48	AS BUILT SPI-269 ADDED TO NOZZLES G & E ON D-101-2 (WERE 200NB)	RL/ES	CR	AM	SES	04/2013
57	AS BUILT P84-2015 PT-134-2 & P84-2105 HPV ON GAS COOLER	JC/RL	AC/JC	AM	TC	03/2019	47	AS BUILT HV-107-2 RELOCATED TO NEW LOCATION	ES/RL	TC	AM	SES	12/2012
56	AS BUILT P84-1405 INLET PRESSURE/FLOW CONTROL	JC/RL	AAB	AM	TC	08/2018	46	AS BUILT P84-1041 FLARE GAS MEASUREMENT	ES/RL	TC	AM	SES	09/2012
55	AS BUILT P84-1277 REPLACE FV-102-2 & P84-1370 RO-102-2B	RL	JCC	AM	TC	12/2016	45	HAND VALVE NUMBERS ADDED FOR ISOLATIONS	RL/ES	CR	AM	SES	07/2012
54	AS BUILT COMMENTS INCORPORATED INCLUDING NOTE 12	RL	JCC	AM	TC	12/2016	44	AS BUILT - P84-1067 GAS COOLER HIGH TEMP TRIP	ES/RL	AAB	SRH	SES	10/11
53	REVISED FOR LOCKED VALVE STATUS AND VALVE NUMBERS	RL	JC/AM	AM	SES	08/2015	43	AS BUILT - P84-2052 CO2 SLIP ANALYSER - TRAIN 2	ES/RL	TJ	JS	SES	07/11
52	AS BUILT P84-848 WOBBE CONTROL	ES/RL	AAB	AM	SES	08/2014	42	PARTIAL AS BUILT FOR 520421	NK	CJ	JL	SES	01/11

VECTOR KAPUNI LIMITED
PRIVATE BAG 2020
NEW PLYMOUTH 4342
PHONE 0800 734 567

ssj^o

COPYRIGHT The copyright in this document is vested in Vector Kapuni Limited. The contents of this document shall not be reproduced, either in whole or part, by any means whatsoever without the prior written consent of Vector Kapuni Limited.

AUTOCAD ORIGINAL SHEET SIZE A1


DRN	P.RAWLES	02/07/1987	ENG	R.VanLUF	02/07/1987
CHK	R.VanLUF	02/07/1987	APP		

SCALE:	JOB NO.	SERIES	DRG. NO	SHT	REVISION
NTS	1000000	0101	0005	02 OF 03 SHTS	58

EQUIPMENT No.

DESCRIPTION
CAPACITY
MAWP @ TEMP

M-111
HYDROCARBON SEPARATOR
DIA = 1.2m, TT = 4.6m
15 Barg @ 150°C

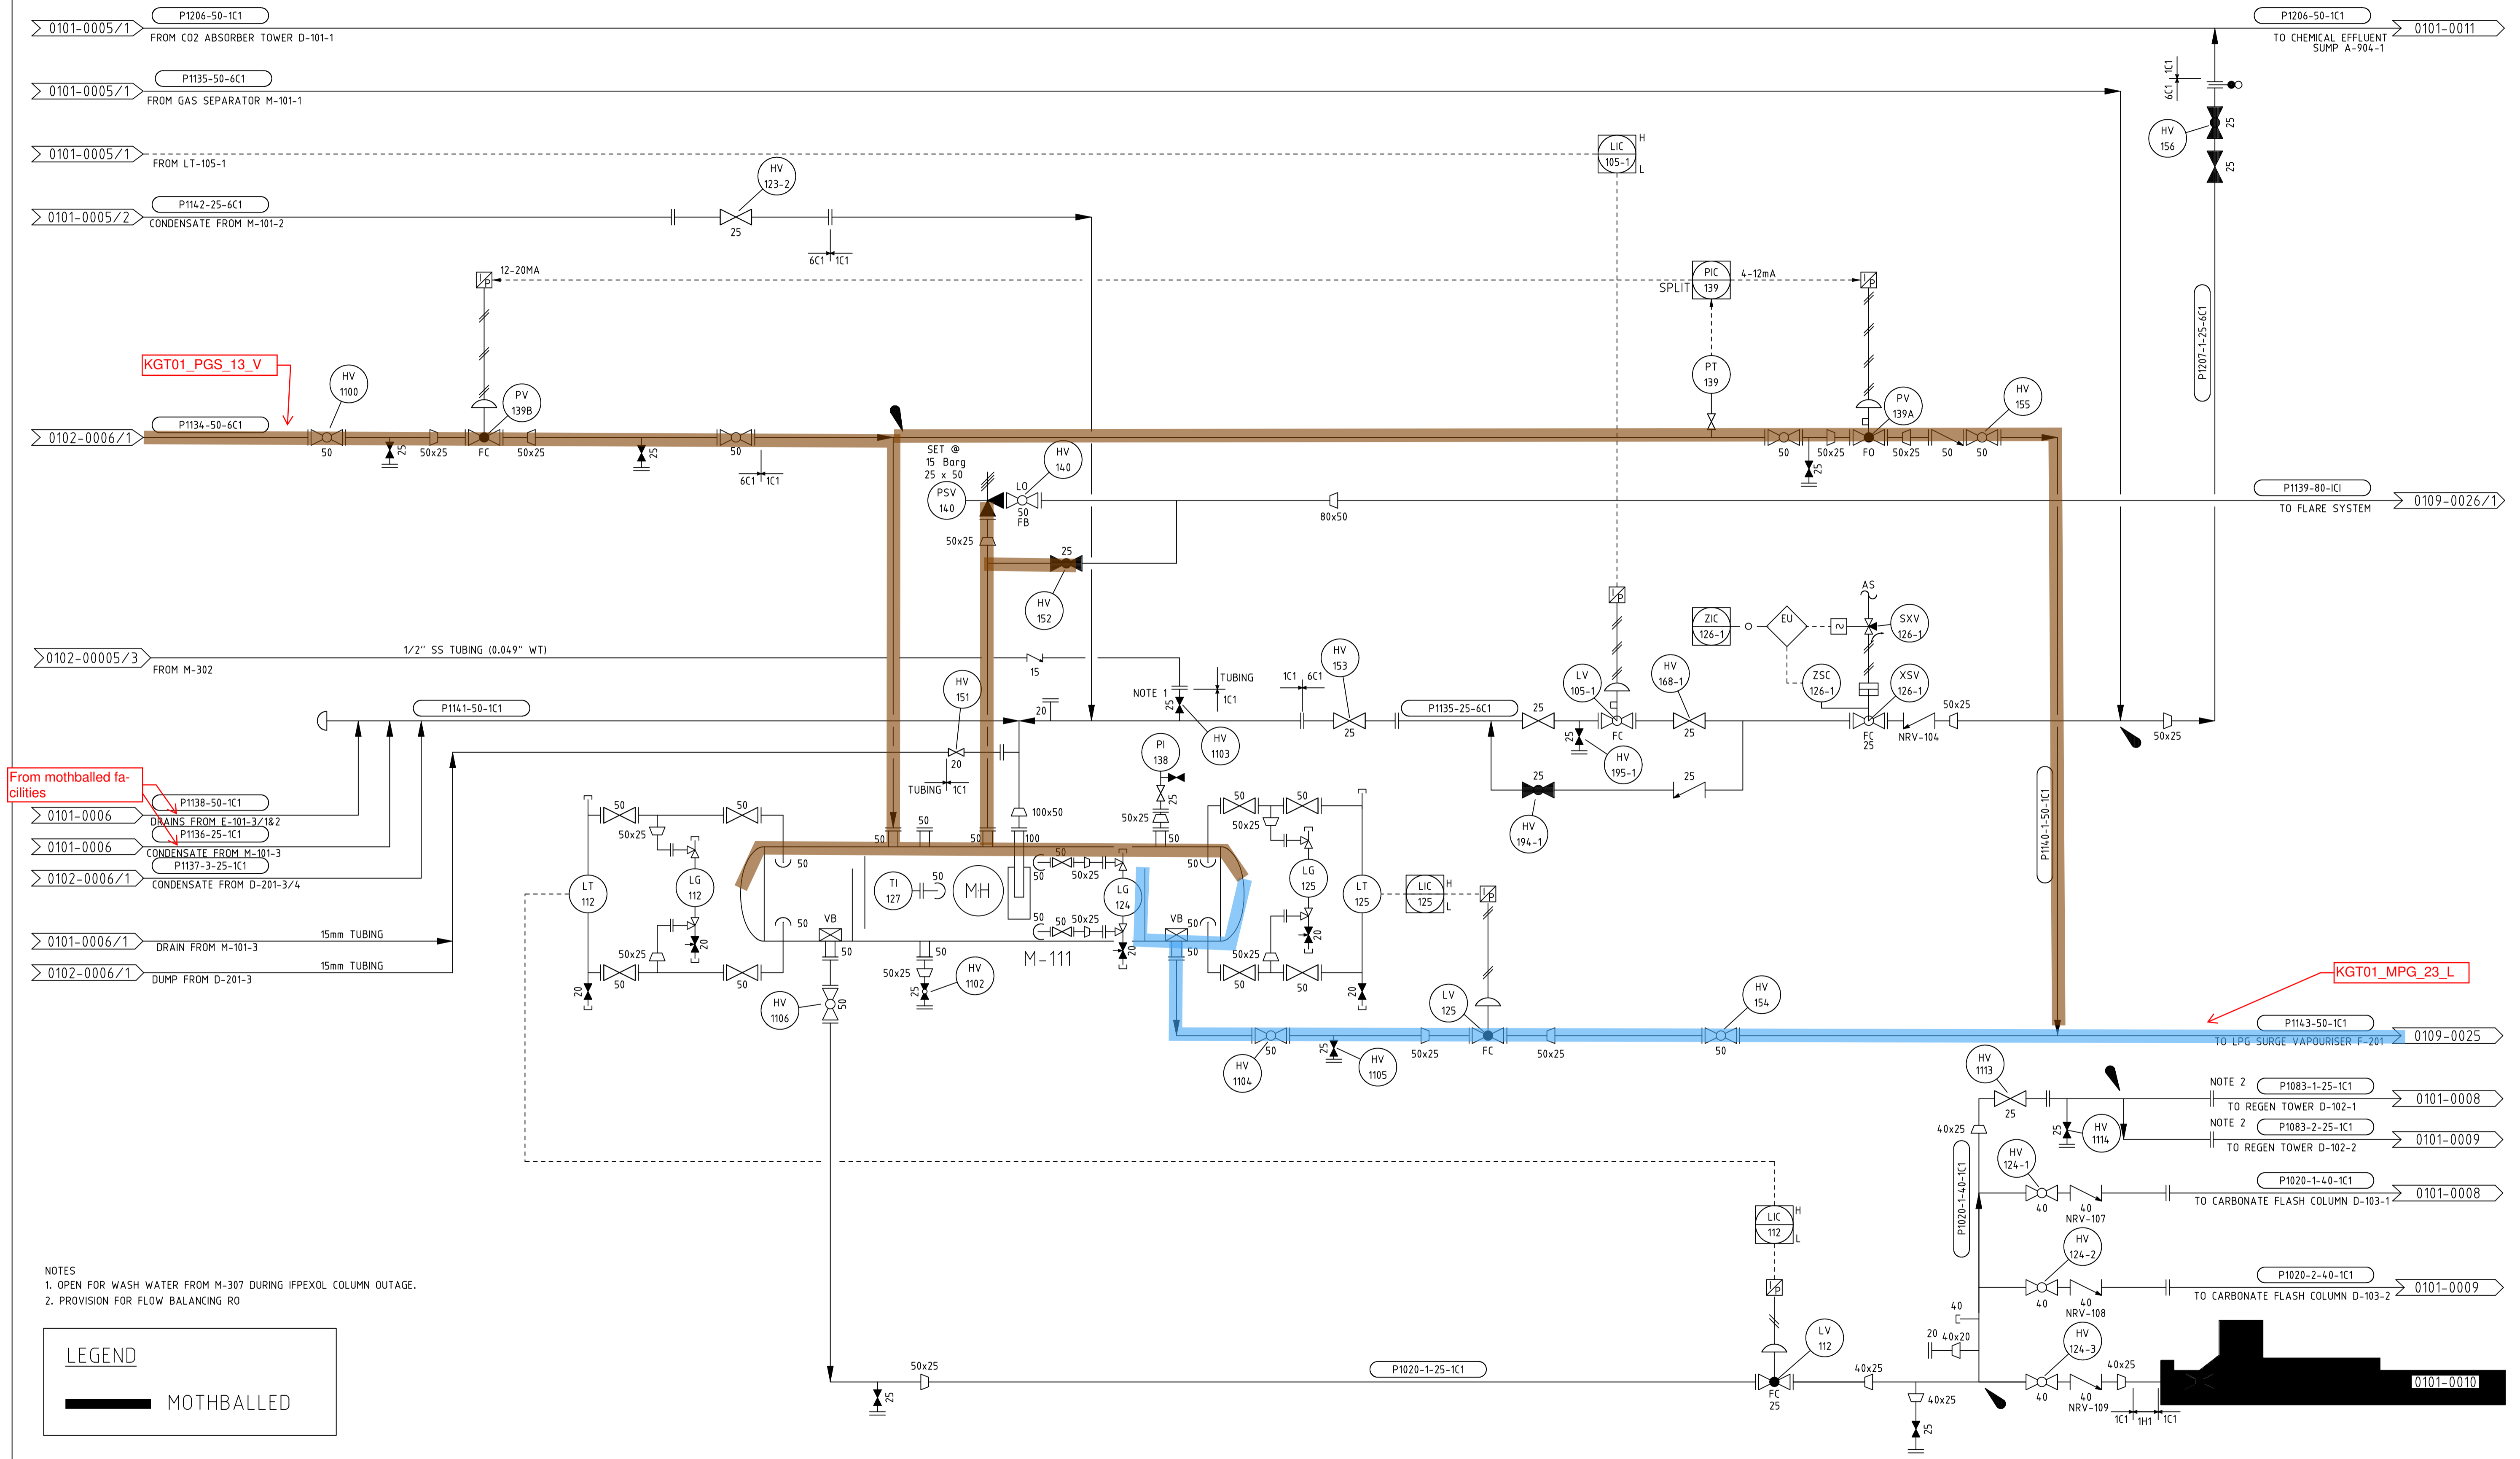

LEGEND
MOTHBALLED

REV	AMENDMENT	BY	CHK	ENG	APP	DATE	REV	AMENDMENT	BY	CHK	ENG	APP	DATE
9	HAND VALVE NUMBERS ADDED FOR ISOLATIONS					04/2013							
8	HAND VALVE NUMBERS ADDED FOR ISOLATIONS					06/2012							
7	AS BUILT P84-2001 M-111 Tr3 RELOCATION WS2007432	RL	WB	SRH	SES	11/2011							
6	AS BUILT WS1148373 LPG SPEC DURING IFP COLUMN OUTAGE	VB	NS	PWM	LH	04/09							
5	CLOSED SPECTACLE BLIND ADDED - LINE P1207-1-25-6C1	ES	RL	LH	SS	11/07							
4	LEVEL GAUGE BRIDLES FOR LG-124, 112 & 125 AS BUILT	RL	ES	LH	DS	11/2007							
13	AS BUILT P84-1429 ELIMINATE INEFFICIENCY IN WASH WATER	JS	CJ	AM	SES	01/2018							
12	NRV No's ADDED & HV No's ADDED FOR ISOLATIONS	RL	JCC	AM	SES	08/2015							
11	VENTS & DRAINS ADDED TO M-111 LEVEL BRIDLES	RL	JA	AM	SES	11/2014							
10	HAND VALVE NUMBER HV-190-3 ADDED FOR ISOLATION	RL	CR	AM	SES	11/2013							
A	M-111 MOVED FROM SHT 1 - SYSTEM NUMBERS ADDED	VB	TMA	MH	SES	04/03							

VECTOR KAPUNI LIMITED
PRIVATE BAG 2020
NEW PLYMOUTH 4342
PHONE 0800 734 567

sjio

COPYRIGHT The copyright in this document is vested in Vector Kapuni Limited
The contents of this document shall not be reproduced, either in whole or part, by any
means whatsoever without the prior written consent of Vector Kapuni Limited.

AUTOCAD ORIGINAL SHEET SIZE A1

DRN	P.RAWLES	02/03/1987	ENG	R.Van LIJF	02/07/1987
CHK	R.Vab LIJF	02/07/1987	APP		02/07/1987

SCALE:	JOB NO.	SERIES	DRG. NO	SHT	REVISION
N/A	1000000	0101	0005	03 OF 03 SHTS	14

EQUIPMENT No.

DESCRIPTION
CAPACITY
MAWP @ TEMP

E-101-3/2


GAS/GAS HEAT EXCHANGER
2.4m³
TUBE 55.16 Barg @ 127/0°C
SHELL 55.16 Barg @ 127/0°C

D-101-3

CO2 ABSORBER TOWER
51.5m³
53.43 Barg @ 127/0°C (NOTE 8)

M-101-3

GAS SEPARATOR
0.45m³
55.16 Barg @ 121/-29°C
15mm SS TUBING

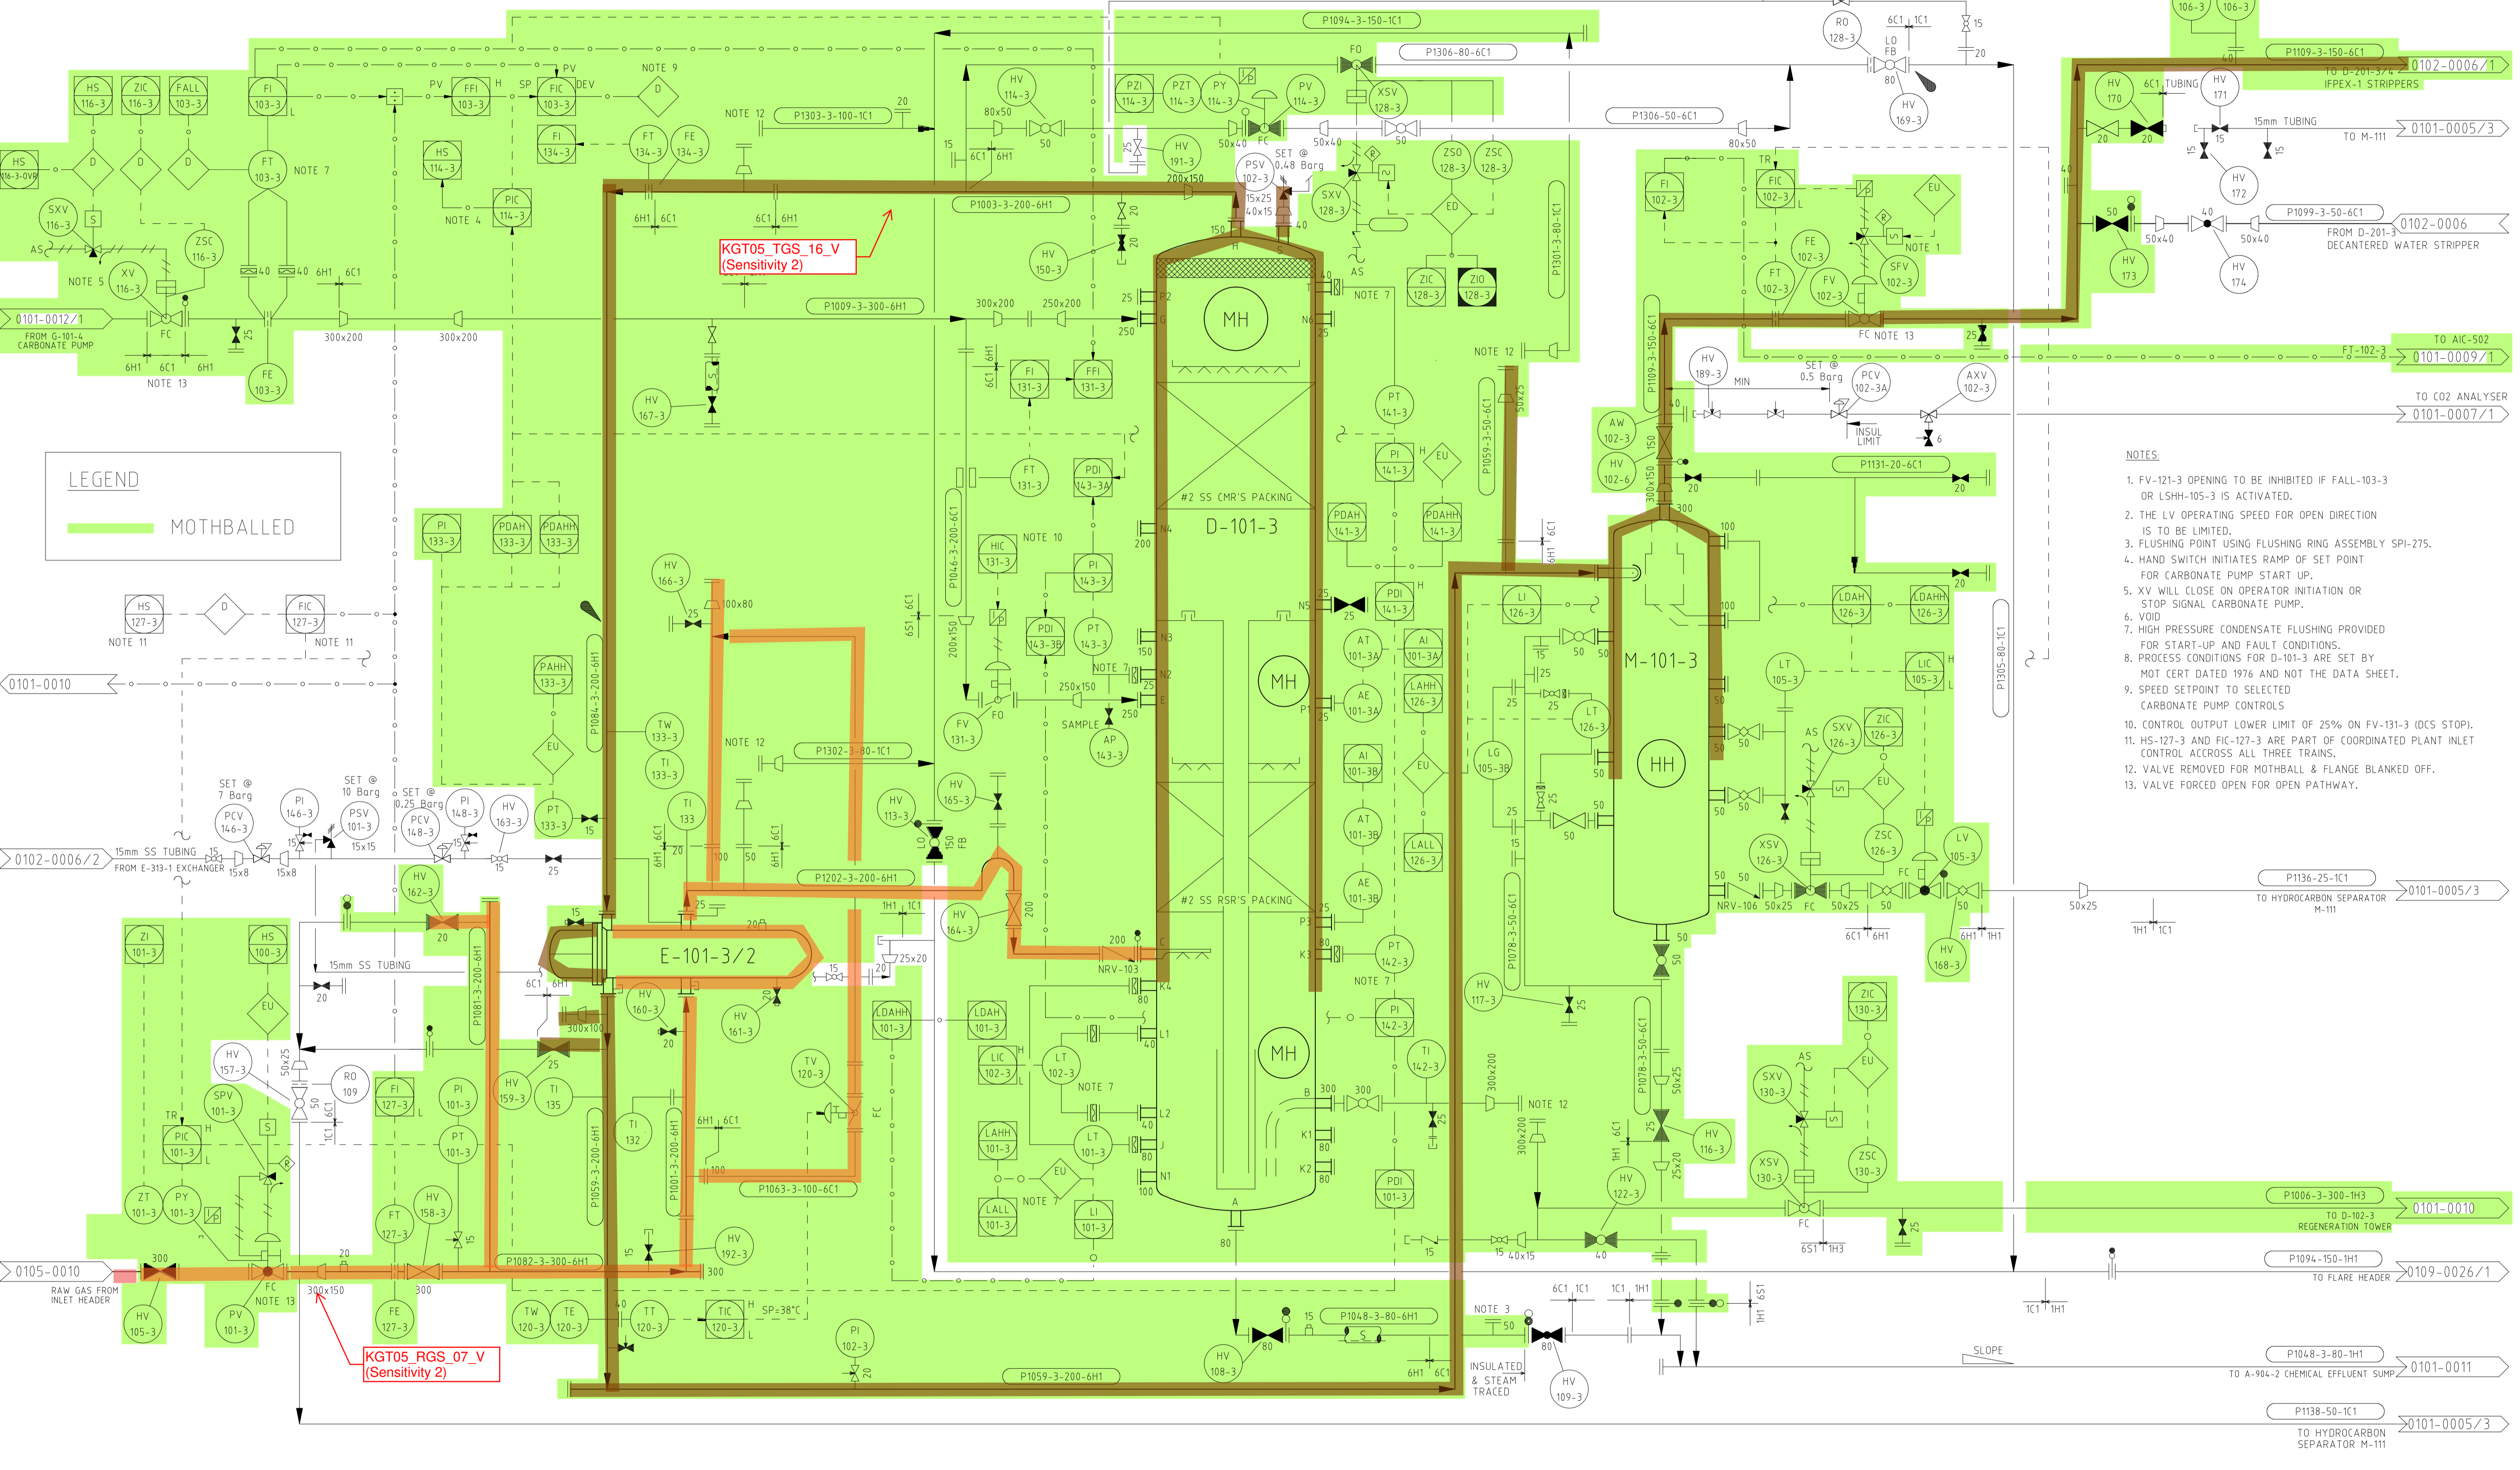

- NOTES:
1. FV-121-3 OPENING TO BE INHIBITED IF FALL-103-3 OR LSHH-105-3 IS ACTIVATED.
 2. THE LV OPERATING SPEED FOR OPEN DIRECTION IS TO BE LIMITED.
 3. FLUSHING POINT USING FLUSHING RING ASSEMBLY SPI-275.
 4. HAND SWITCH INITIATES RAMP OF SET POINT FOR CARBONATE PUMP START UP.
 5. XV WILL CLOSE ON OPERATOR INITIATION OR STOP SIGNAL CARBONATE PUMP.
 6. VOID
 7. HIGH PRESSURE CONDENSATE FLUSHING PROVIDED FOR START-UP AND FAULT CONDITIONS.
 8. PROCESS CONDITIONS FOR D-101-3 ARE SET BY MDT CERT DATED 1976 AND NOT THE DATA SHEET.
 9. SPEED SETPOINT TO SELECTED CARBONATE PUMP CONTROLS
 10. CONTROL OUTPUT LOWER LIMIT OF 25% ON FV-131-3 (DCS STOP).
 11. HS-127-3 AND FIC-127-3 ARE PART OF COORDINATED PLANT INLET CONTROL ACROSS ALL THREE TRAINS.
 12. VALVE REMOVED FOR MOTHBALL & FLANGE BLANKED OFF.
 13. VALVE FORCED OPEN FOR OPEN PATHWAY.

REV	AMENDMENT	BY	CHK	ENG	APP	DATE	REV	AMENDMENT	BY	CHK	ENG	APP	DATE
42	AS BUILT P84-832 GAS SEPARATOR LEVEL TRANSMITTER REPLACE	LN	CJ	AM	SES	01/2014							
41	HAND VALVE NUMBERS ADDED FOR ISOLATIONS	RL/ES	CR	AM	SES	04/2013	51	AS BUILT P84-1367 MOTHBALL BENFIELD TRAIN 3	JB	CJ	AM	TC	09/2019
40	AS BUILT P84-1041 FLARE GAS MEASUREMENT	ES/RL	TC	AM	SES	09/12	50	AS BUILT. NOTE 3 ADDED FOR FLUSHING POINT ASSEMBLY	RL	JCC	AM	TC	07/2019
39	AS BUILT P84-1067 GAS COOLER HIGH TEMP TRIP	ES/RL	AAB	SRH	SES	10/11	49	AS BUILT P84-1405 INLET PRESSURE/FLOW CONTROL	JC/RL	AAB	AM	TC	08/2018
38	AS BUILT 25 NB VALVE ADDED TO NOZZLE NS OF D-101-3	RL	CR	LH	SES	03/2011	48	AS BUILT FOR SCR-640 HS-116-3-OVR	JC/RL	AAB	AM	SES	09/2016
37	AS BUILT INTERNALS & NOZZLE NUMBERS FOR D-101-3	ES/RL	CR	LH	SES	12/2010	47	AS BUILT P84-1289 ADDED AXV-102-3 LIQUID SHUT OFF VALVE	JCC	RL/CB	AM	SES	04/2016
36	AS BUILT AIT-101-3 MOVED TO DRG 0101-0007/1	ES/RL	TC	LH	SES	10/10	46	AS BUILT P84-1044 REPLACE LV-105-3 & ADD NRV No's	RL	JCC	AM	SES	08/2015
35	AS BUILT WS2007362 BENFIELD CO2 SLIP IN DCS	ES	TC	LH	SES	05/10	45	AS BUILT - P84-944 REPLACE TRAIN 3 THINNED PIPE WORK	JC	LN	AM	SES	02/15
34	AS BUILT CW9002 REMOVED WITH E-101-3/2 DEMOLITION	TL	RL	LH	SES	11/2009	44	AS BUILT - P84-848 WOBBE CONTROL ON PROCESSED/EXPORT GAS	ES/RL	AAB	AM	SES	04/14
33	AS BUILT WS1404939 BENFIELD RELIEF VALVE UPGRADE	VB	KS	PWM	LH	09/09	43	3 ADDITIONAL HAND VALVE NUMBERS ADDED FOR ISOLATIONS	RL	CR	AM	SES	03/2014

VECTOR KAPUNI LIMITED
PRIVATE BAG 2020
NEW PLYMOUTH 4342
PHONE 0800 734 567

COPYRIGHT The copyright in this document is vested in Vector Kapuni Limited. The contents of this document shall not be reproduced, either in whole or part, by any means whatsoever without the prior written consent of Vector Kapuni Limited.


AUTOCAD ORIGINAL SHEET SIZE A1

REFERENCE DRAWINGS

DRN	P.RAWLES	01/03/1987	ENG	R.VanLUF	02/07/1987
CHK	R.VanLUF	01/03/1987	APP	R.VanLUF	02/07/1987

CO2 REMOVAL
PIPING & INSTRUMENT DIAGRAM
CO2 ABSORBER TRAIN 3

SCALE:	JOB NO.	SERIES	DRG. NO	SHT	REVISION
NONE	1000000	0101	0006	01 OF 01 SHTS	51

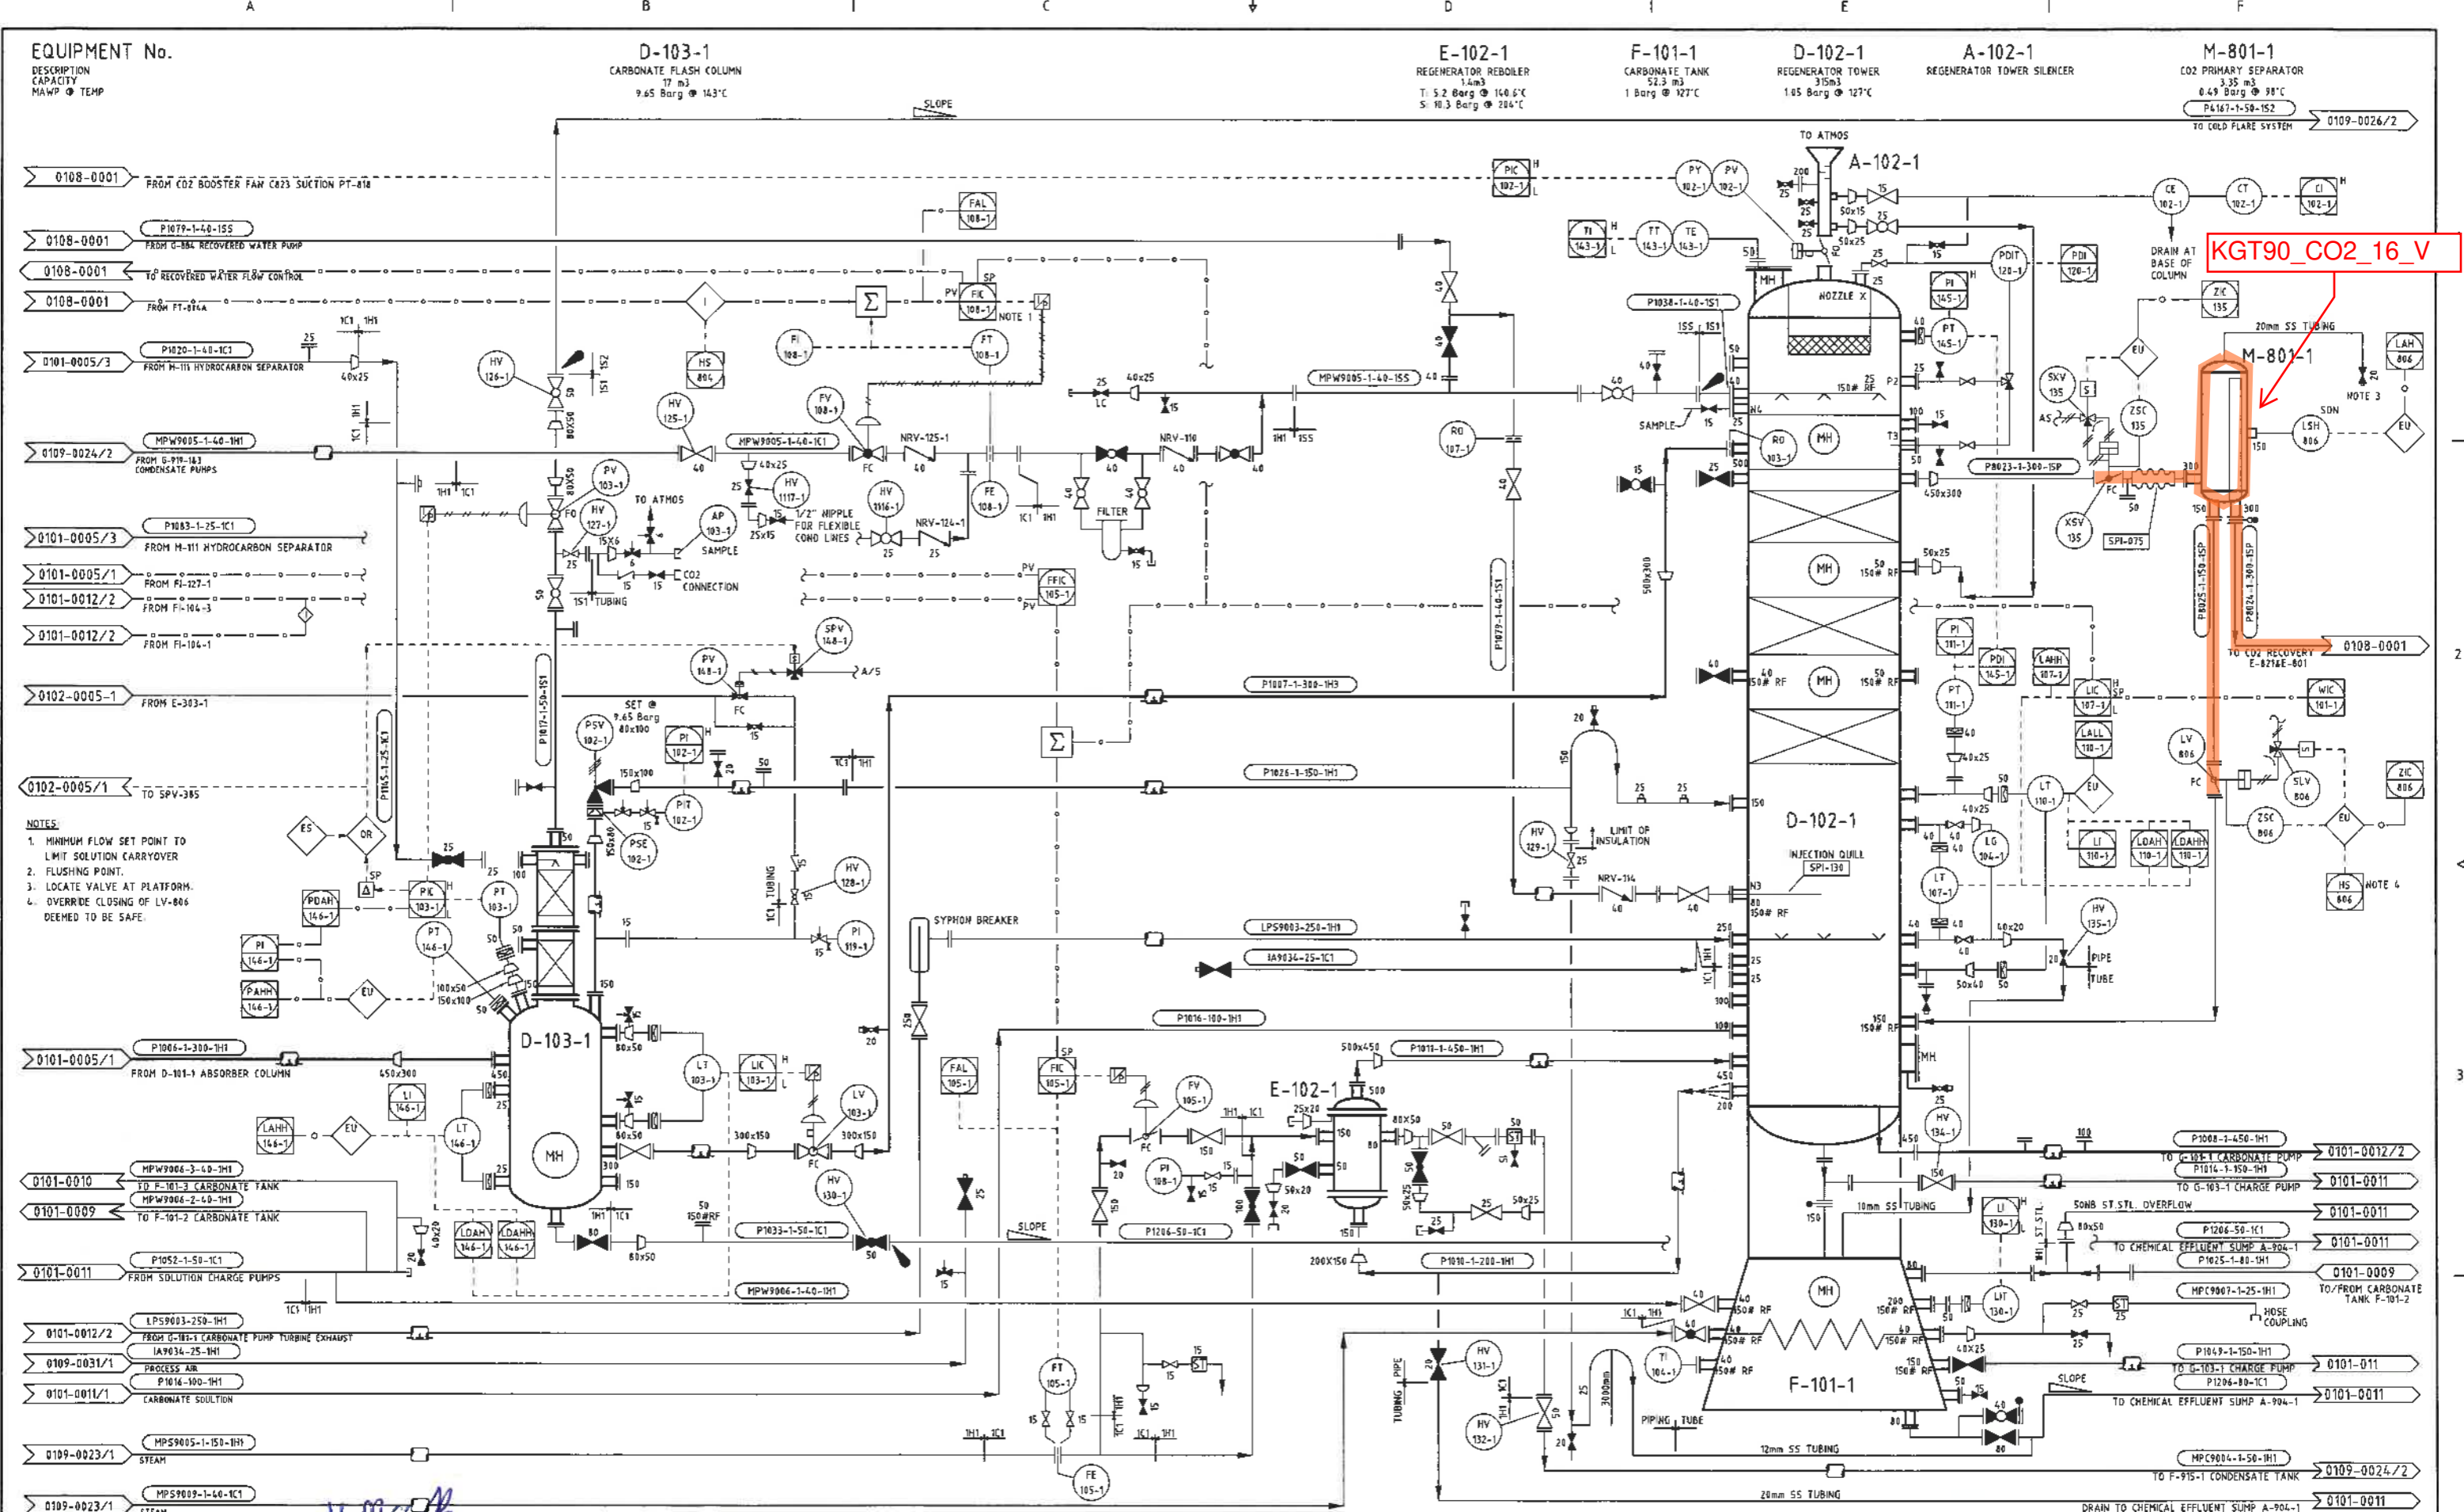

REV	AMENDMENT	BY	CHK	ENG	APP	DATE	REV	AMENDMENT	BY	CHK	ENG	APP	DATE
42	AS BUILT P&ID LINE P&ID-1-25-IC1 DISCONNECTED FROM D-103-1	RL	JCC	AM	TC	06/2020	32	AS BUILT P&ID-161 CARBONATE SOLUTION INVENTORY CONTROL	ES/RL	AAB	AM	SES	08/12
41	AS BUILT P&ID-1524 PRESSURISE TR 1 & 2 FLASH COLS WITH CO2	RL	JCC	AM	TC	10/2019	31	AS BUILT DELAY ADDED TO LOW FLOW ALARM	ES/RL	AC	SRN	SES	10/11
40	AS BUILT BYPASS VALVE ON LINE MP(9004) NOW SHOWN OPEN	RL	JCC	AM	TC	07/2019	30	PARTIAL AS BUILT P&ID-1042 PSV FLASH COL REPLACEMENT	CJ	NB	J5	LH	01/2011
39	AS BUILT P&ID-1629 ELIMINATE INEFFICIENCY IN WASH WATER	J5	CJ	AM	SES	01/2018	29	AS BUILT W52007362 BENFIELD CO2 SLIP IN DCS	ES	TC	LH	SES	05/10
38	AS BUILT SCR-350 LV-806 & AS BUILT E-102-1 NOZZLES / PIPING	RL	JCC	AM	SES	08/2017	28	AS BUILT P&ID-2852	ES	TC	LH	SES	10/2019
37	AS BUILT SCR-589 FAL-105-1	JCC	RL/AM	AM	SES	07/2016	27	AS BUILT W51343179 REGEN BOILER EFFICIENCY &	RL	TC	LH	SES	05/2009
36	AS BUILT P&ID-1209 RETROFIT FLASH COLUMN PCV	GH	CJ	AM	SES	03/2016	26	W51498381 CHEM HOSE COUP. & W51448350 SAMPLE POINT	RL	SR	LH	SES	01/2008
35	HV NH3 ADDED FOR ISOLATIONS & M-801-1 PROCESS COND. REVISED	RL	AC	AM	SES	10/2013	25	AS BUILT W51343081. TRAIN 1 CO2 XSV INSPECTION PORT	RL	CP	LH	DS	11/2007
34	AS BUILT - LAHH-107 ADDED	ES/RL	AAB	AM	SES	02/13	25	DRAIN FROM LINE P1026-1-150-1H1 WAS SHOWN CLOSED	RL	CP	LH	DS	11/2007
33	AS-BUILT P&ID-139	LN	CJ	AM	SES	11/2012	24	AS BUILT W51266302 POLISHING TANK REMOVAL	RL	CP	LH	P/R	10/2007

VECTOR KAPUNI LIMITED
PRIVATE BAG 2020
NEW PLYMOUTH 4342
PHONE 0800 734 567

COPYRIGHT The copyright in this document is vested in Vector Kapuni Limited. The contents of this document shall not be reproduced, either in whole or part, by any means whatsoever without the prior written consent of Vector Kapuni Limited.

AUTOCAD ORIGINAL SHEET SIZE A1

DATE	DATE	SCALE:	JOB NO.	SERIES	DRG. NO	SHT 01	REVISION
DRN P.RAWLES	ENG	NTS	1000000	0101	0008	OF 01	42
CHK A.vanGAMEREN	APP J.F.STUART					SHTS	

DATE	DATE	SCALE:	JOB NO.	SERIES	DRG. NO	SHT 01	REVISION
DRN P.RAWLES	ENG	NTS	1000000	0101	0008	OF 01	42
CHK A.vanGAMEREN	APP J.F.STUART					SHTS	

EQUIPMENT No.

DESCRIPTION
CAPACITY
MAMP @ TEMP


D-103-2
CARBONATE FLASH COLUMN
17 m³
9.65 Barg @ 143°C

E-102-2
REGENERATOR REBOILER
1.6m²
510.3 Barg @ 204°C T.5.2 Berg @ 140.6°C

D-102-2
REGENERATOR TOWER
315m³
1 Barg @ 127°C

F-101-2
CARBONATE TANK
52.3 m³
1 Barg @ 127°C

M-801-2
CO₂ PRIMARY SEPARATOR
1.0m³
3.4 Barg @ 98°C

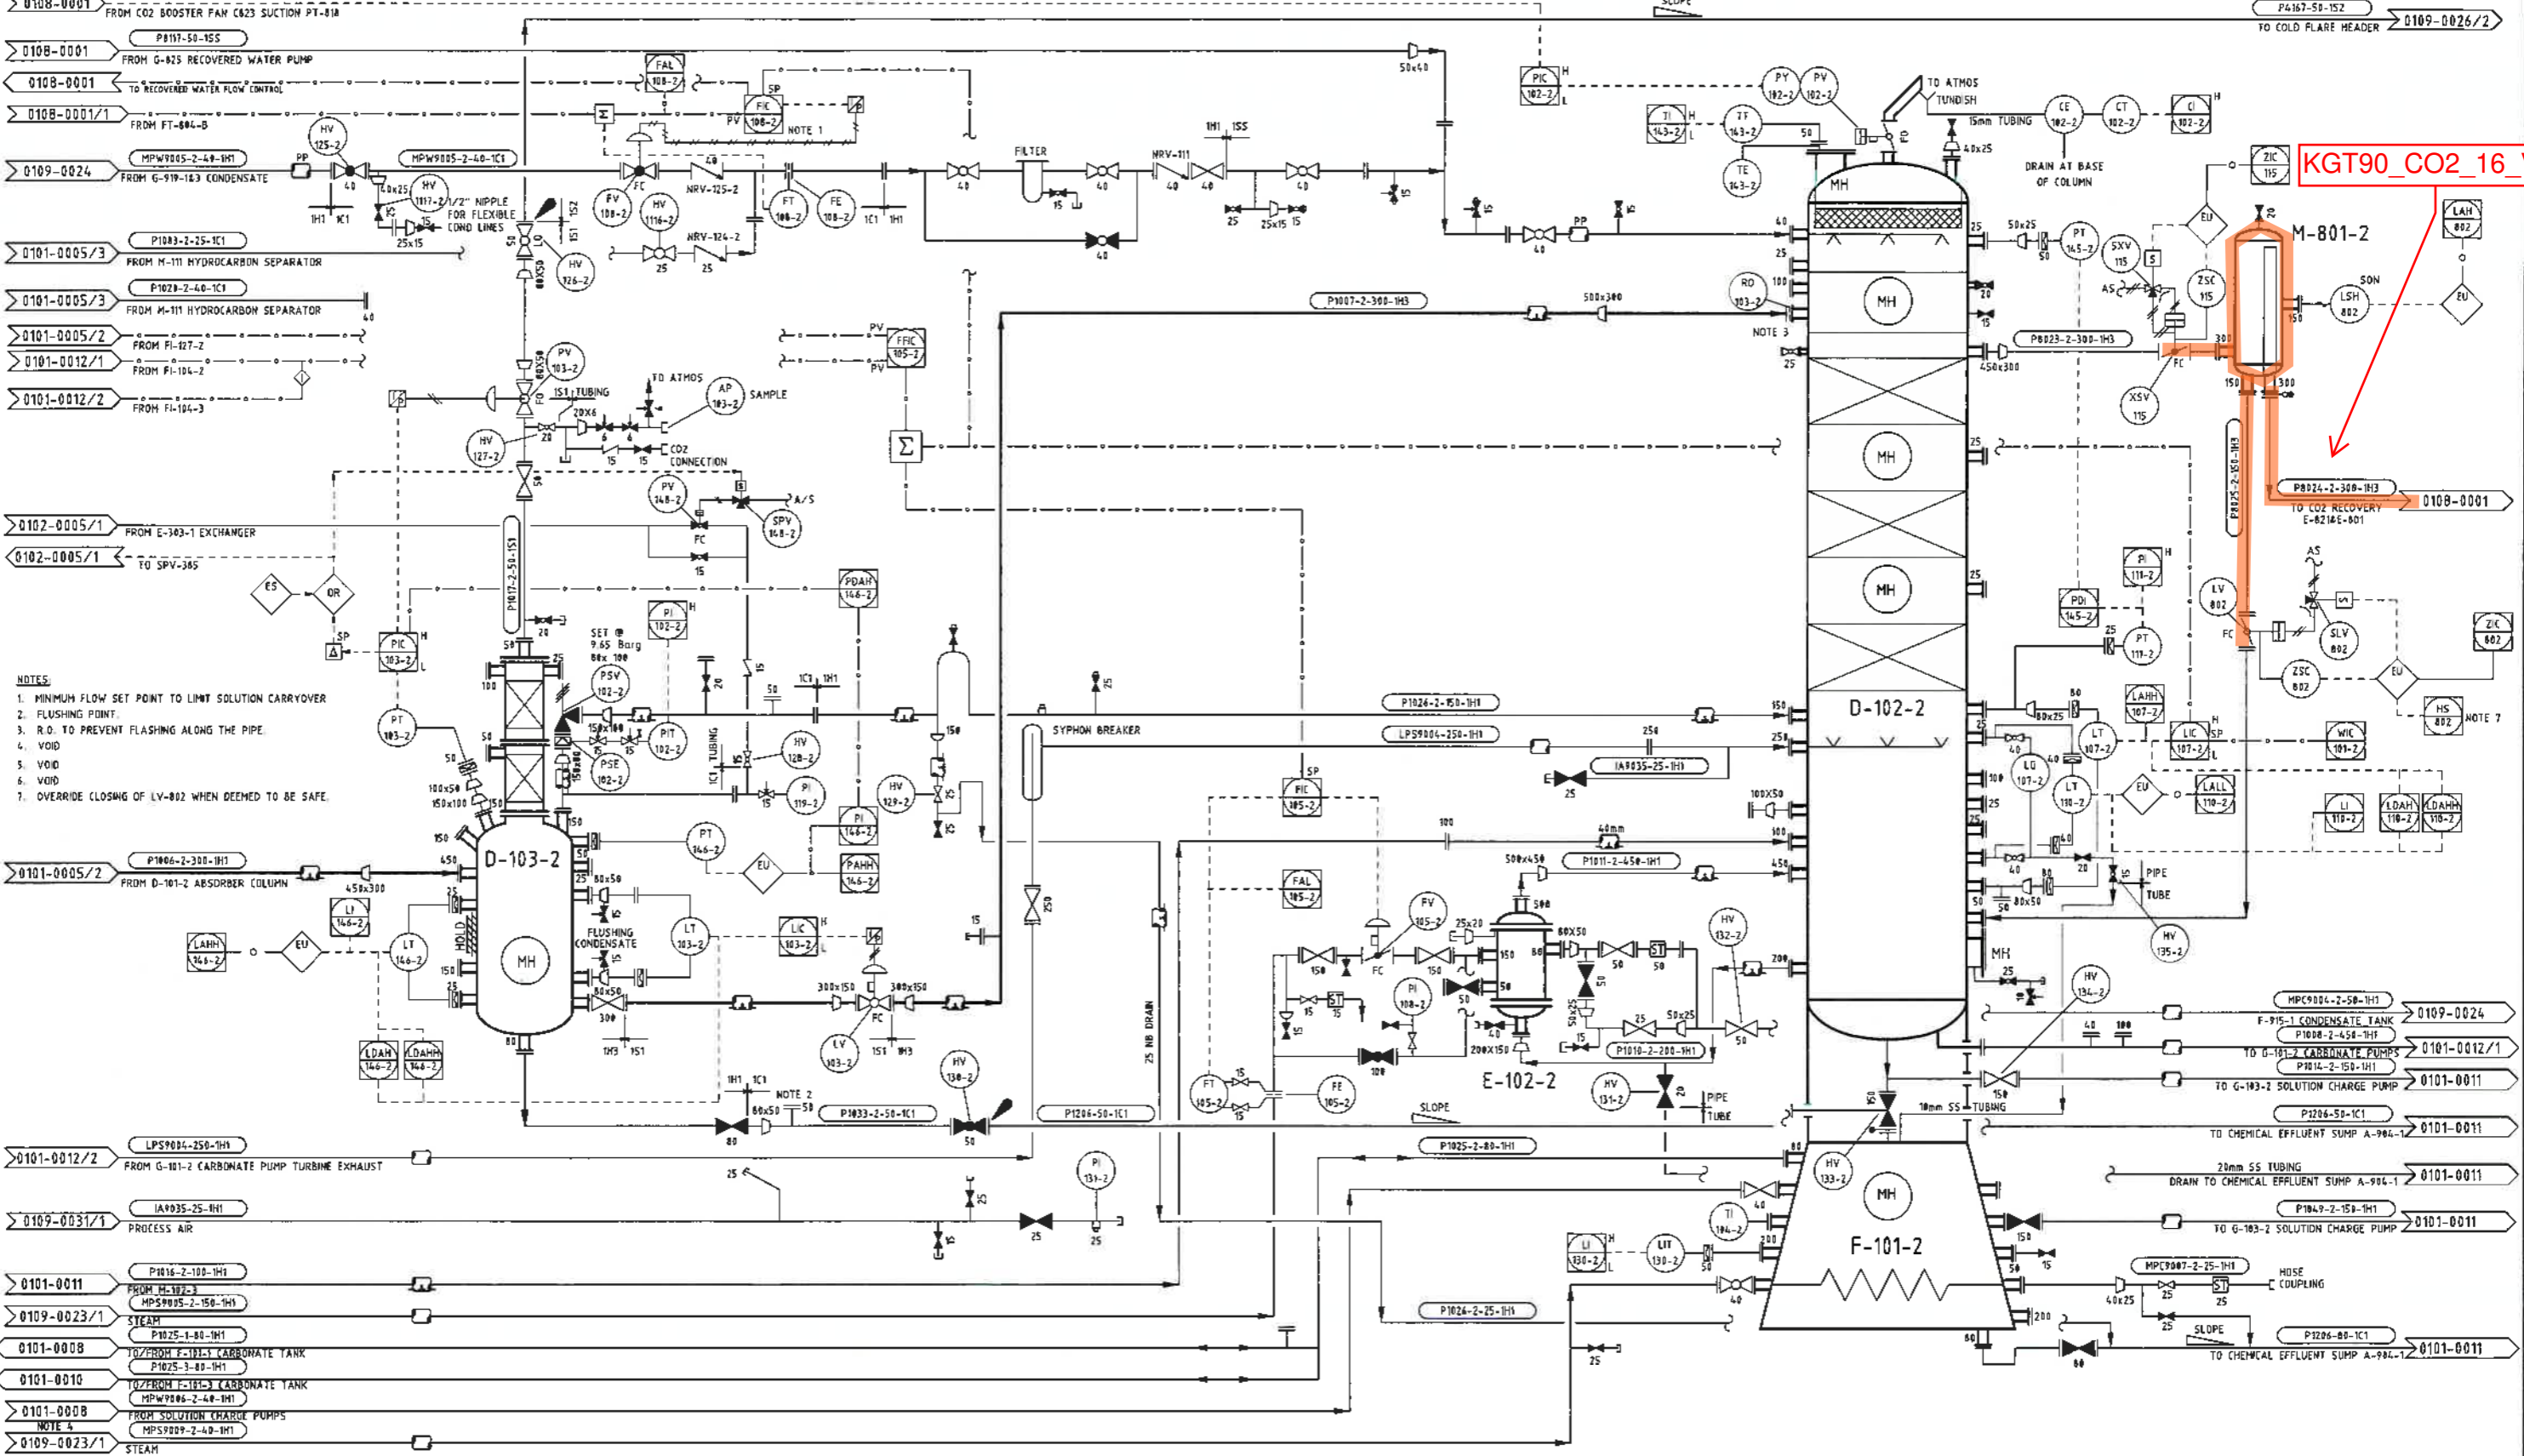

- NOTES:
- MINIMUM FLOW SET POINT TO LIMIT SOLUTION CARRYOVER
 - FLUSHING POINT
 - R.O. TO PREVENT FLASHING ALONG THE PIPE
 - VOID
 - VOID
 - VOID
 - VERRIDE CLOSING OF LV-802 WHEN DEEMED TO BE SAFE.

REV	AMENDMENT	BY	CHK	ENG	APP	DATE	REV	AMENDMENT	BY	CHK	ENG	APP	DATE
34	PI-15 REMOVED, M-801-2 PROCESS COND. REVISED & NRV No. ADDED	RL	JC	ER	AM	05/2015	34	PI-15 REMOVED, M-801-2 PROCESS COND. REVISED & NRV No. ADDED	RL	JC	ER	AM	05/2015
33	AS BUILT LAHM-107-2 ADDED	ES	AAB	AM	SES	02/13	33	AS BUILT LAHM-107-2 ADDED	ES	AAB	AM	SES	02/13
32	AS BUILT P84-130 DISCHARGE RECOVERED WATER	LN	CJ	AM	SES	12/2012	32	AS BUILT P84-130 DISCHARGE RECOVERED WATER	LN	CJ	AM	SES	12/2012
31	AS BUILT P84-141 CARBONATE SOLUTION INVENTORY CONTROL	ES/RL	AAB	AM	SES	08/12	31	AS BUILT P84-141 CARBONATE SOLUTION INVENTORY CONTROL	ES/RL	AAB	AM	SES	08/12
30	HAND VALVE NUMBERS ADDED FOR ISOLATIONS	RL/ES	ER	AM	SES	04/2012	30	HAND VALVE NUMBERS ADDED FOR ISOLATIONS	RL/ES	ER	AM	SES	04/2012
29	AS BUILT DELAY ADDED TO LOW FLOW ALARM	ES/RL	AC	SRM	SES	10/11	29	AS BUILT DELAY ADDED TO LOW FLOW ALARM	ES/RL	AC	SRM	SES	10/11
28	AS BUILT P84-820 LCV-103-2 REPLACED	MW	ES	JS	SES	08/11	28	AS BUILT P84-820 LCV-103-2 REPLACED	MW	ES	JS	SES	08/11
27	PARTIAL AS BUILT FOR P84-1042 PSV FLASH COL REPLACEMENT	NK	CJ	JS	LH	01/11	27	PARTIAL AS BUILT FOR P84-1042 PSV FLASH COL REPLACEMENT	NK	CJ	JS	LH	01/11
26	AS BUILT P84-3007 ESD LEVEL TRANS DEVIATION ALARMS	ES	TC	LH	SES	03/10	26	AS BUILT P84-3007 ESD LEVEL TRANS DEVIATION ALARMS	ES	TC	LH	SES	03/10
25	AS BUILT P84-2852 BENEFIELD REBOILER STEAM CHANGES	ES	TC	LH	SES	10/09	25	AS BUILT P84-2852 BENEFIELD REBOILER STEAM CHANGES	ES	TC	LH	SES	10/09

VECTOR KAPUNI LIMITED
PRIVATE BAG 2020
NEW PLYMOUTH 4342
PHONE 0800 734 567

Vector

COPYRIGHT The copyright in this document is vested in Vector Kapuni Limited. The contents of this document shall not be reproduced, either in whole or part, by any means whatsoever without the prior written consent of Vector Kapuni Limited.

AUTOCAD ORIGINAL SHEET SIZE A1

REFERENCE DRAWINGS
CAUSE & EFFECTS - 0780-0082/01, 2, 3, 7 & 8.

DRN	P.RAWLES	ENG	DATE	DATE
CHK	A.vanGAMEREN	APP	J.F.STUART	10/02/1988

CO₂ REMOVAL
PIPING & INSTRUMENT DIAGRAM
CARBONATE REGENERATION TRAIN 2

SCALE: NTS

JOB NO.	SHT 01	REVISION
1000000	01	41

1000000-0101-0009-01.DWG

EQUIPMENT No.

DESCRIPTION
CAPACITY
MAMP @ TEMP

P8116-50-155
0108-0001 FROM G-425 RECOVERED WATER PUMP

0108-0001 TO RECOVERED WATER FLOW CONTROL

0108-0001/01 FROM FT-804-C

MPW9005-3-40-1H1
0109-0024/2 CONDENSATE FROM G-919-1A3

P1020-3-25-1C1
0101-0005/3 FROM M-111 HYDROCARBON SEPARATOR

P1006-3-300-1H3
0101-0006 RICH D-101-3 CARBONATE FROM ABSORBER

0101-0006/1 FROM FI-127-3

0101-0012/1 FROM FI-104-4

0101-0012/1 FROM FI-104-2

LEGEND
MOTHBALLED

- NOTE:
1. MINIMUM FLOW SET POINT TO LIMIT SOLUTION CARRYOVER
 2. PV-102-3 ACTUATOR AND INTERNALS REMOVED.
 3. TRIPS C-823 (P&ID 0108-0001) WHEN SELECTED.
 4. XSV-117 REMAINS CLOSED WHEN HS-802-3 NOT SELECTED FOR TRAIN 3 CO2 PRODUCTION.
 5. OVERRIDE CLOSING OF LV-801 WHEN DEEMED TO BE SAFE.
 6. WEATHER CAP INSTALLED FOR MOTHBALL.

LPS9010-300-1H1
0101-0012/1 FROM G-103-4 CARBONATE PUMP TURBINE EXHAUST

P1016-3-100-1H1
0101-0011 CARBONATE FROM M102-344 SOLUTION FILTERS

MPW9005-3-150-1H1
0109-0023/1 STEAM

P1025-3-80-1H1
0101-0009 TO/FROM CARBONATE TANKS F-101-2

MPW9006-3-40-1H1
0101-0008 FROM SOLUTION CHARGE PUMPS

MPW9009-3-40-1H1
0109-0023/1 STEAM


24	AS BUILT W51343179 REGEN BOILER EFFICIENCY &												34	AS BUILT SCR-589 FAL-105-3	JCC	RL/AM	AM	SES	07/2016
	W51498381 CHEMICAL HOSE COUPLING ADDED	RL	TC	LH	SES	06/2009							33	AS BUILT P84-1542 PV-102-3 ACT. AND INTERNALS REMOVED	JCC	RL/TC	AM	SES	05/2015
23	AS BUILT W51042819-BENFIELD SYSTEM HAZARD REPORT	ES	CP	LH	PJR	03/07							32	HAND VALVE No's ADDED FOR ISOLATIONS & MAWP FOR M-801-3	RL/ES	TC	AM	SES	06/2013
22	AS BUILT W51236269 CTRL RECOVERED WATER TO REGENS	ES	TC	LH	PJR	01/07							31	AS BUILT P84-130	LN	CJ	AM	SES	11/2012
21	AS BUILT FOR W5933791 FILTER DRAIN	RL	ES	LH	PJR	06/2006							30	AS BUILT P84-141 CARBONATE SOLUTION INVENTORY CONTROL	ES/RL	AAB	AM	SES	08/12
20	AS BUILT POST PEP TRAIN 1, REDLINE MARKUPS INCORP.	RH	RL	LH	PJR	10/2004							29	AS BUILT P84-2001 M-111 Tr 3 RELOCATION W52007432	RL	WB	SRH	SES	11/2011
													28	AS BUILT DELAY ADDED TO LOW FLOW ALARM	ES/RL	AC	SRH	SES	10/11
36	AS BUILT P84-1367 MOTHBALL BENFIELD TRAIN 3	JB	JCC	AM	TC	09/2019							27	AS BUILT ISOLATION VALVES ADDED TO FT-105-3	RL	ES	LH	SES	07/10
35	AS BUILT SCR-350 LV-801 GATED FROM FO TO FC AND	RL	JCC	AM	TC	07/2019							26	AS BUILT W52007362 BENFIELD CO2 SLIP IN DCS	ES	RL	LH	SES	05/10
	FV-105-3 BYPASS WAS 150NB CHANGED TO 40NB												25	AS BUILT P84-2052 BENFIELD REBOILER STEAM CHANGES	ES	TC	LH	SES	10/09
REV	AMENDMENT	BY	CHK	ENG	APP	DATE	REV	AMENDMENT	BY	CHK	ENG	APP	DATE	AUTOCAD					

E-102-3
REGENERATOR REBOILER
1.9m3
SHELL:10.3 Barg @ 204°C TUBE: 5.2 Barg @ 140.4°C

F-101-3
CARBONATE TANK
CAPACITY XXm3
MAWP XXBarg @ XXX°C

D-102-3
REGENERATOR TOWER
Xm3
1 Barg @ 127°C

M-801-3
CO2 PRIMARY SEPARATOR
1.8m3
3.4 Barg @ 98°C

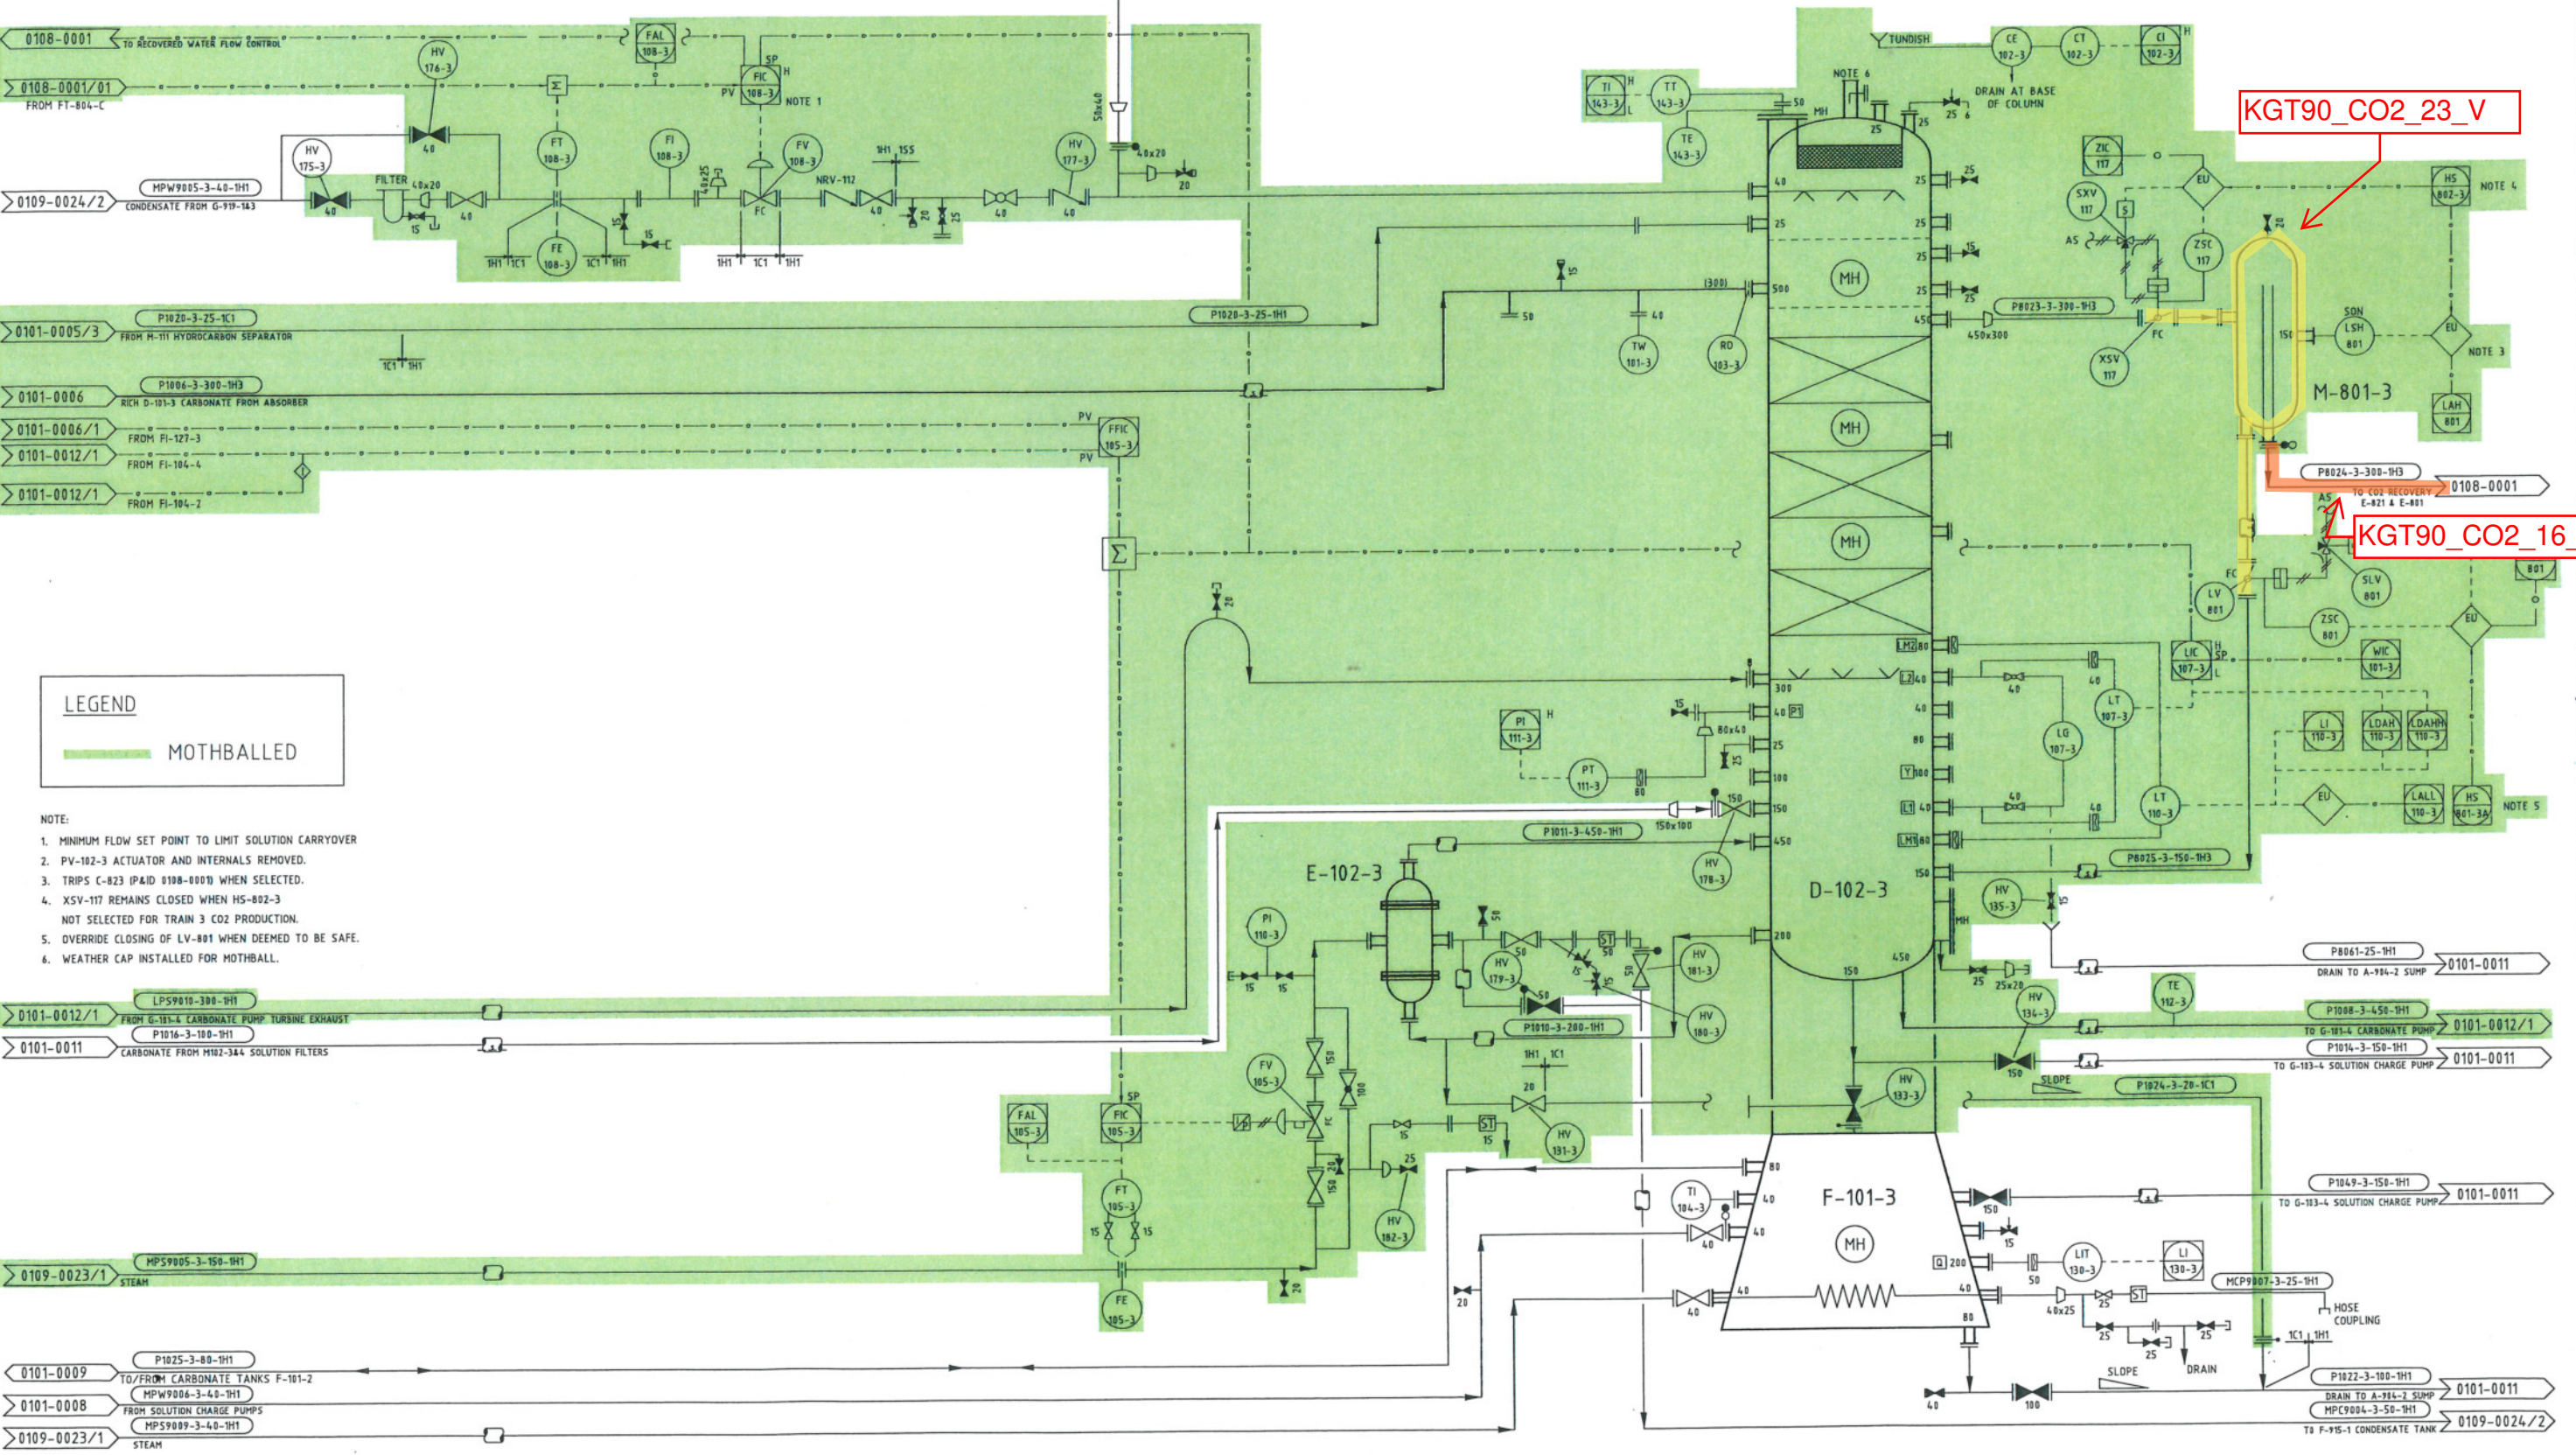

KGT90_CO2_23_V

KGT90_CO2_16_V

REFERENCE DRAWINGS		DATE	DATE
CAUSE & EFFECTS - 0780-0082/01, 02, 07, 08		ENG	J.F.STUART
DRN	P.RAWLES	APP	10/02/1988
CHK	A.R.G.		

CO2 REMOVAL PIPING & INSTRUMENT DIAGRAM CARBONATE REGENERATION TRAIN 3		SCALE:	JOB NO.	SERIES	DRG. NO	SHT 01	REVISION
		NONE	1000000	0101	0010	OF 01 SHTS	36


VECTOR KAPUNI LIMITED
PRIVATE BAG 2020
NEW PLYMOUTH 4342
PHONE 0800 734 567

COPYRIGHT The copyright in this document is vested in Vector Kapuni Limited. The contents of this document shall not be reproduced, either in whole or part, by any means whatsoever without the prior written consent of Vector Kapuni Limited.

EQUIPMENT No.
DESCRIPTION
CAPACITY
MAWP @ TEMP

E-303-1
GAS/GAS HEAT EXCHANGER
2.1m³
TUBE: 82.74 Barg @ -48/38°C
SHELL: 82.74 Barg @ -48/38°C

E-303-2
GAS/GAS HEAT EXCHANGER
2.1m³
TUBES: 82.74 Barg @ -48/38°C
SHELL: 82.74 Barg @ -48/38°C

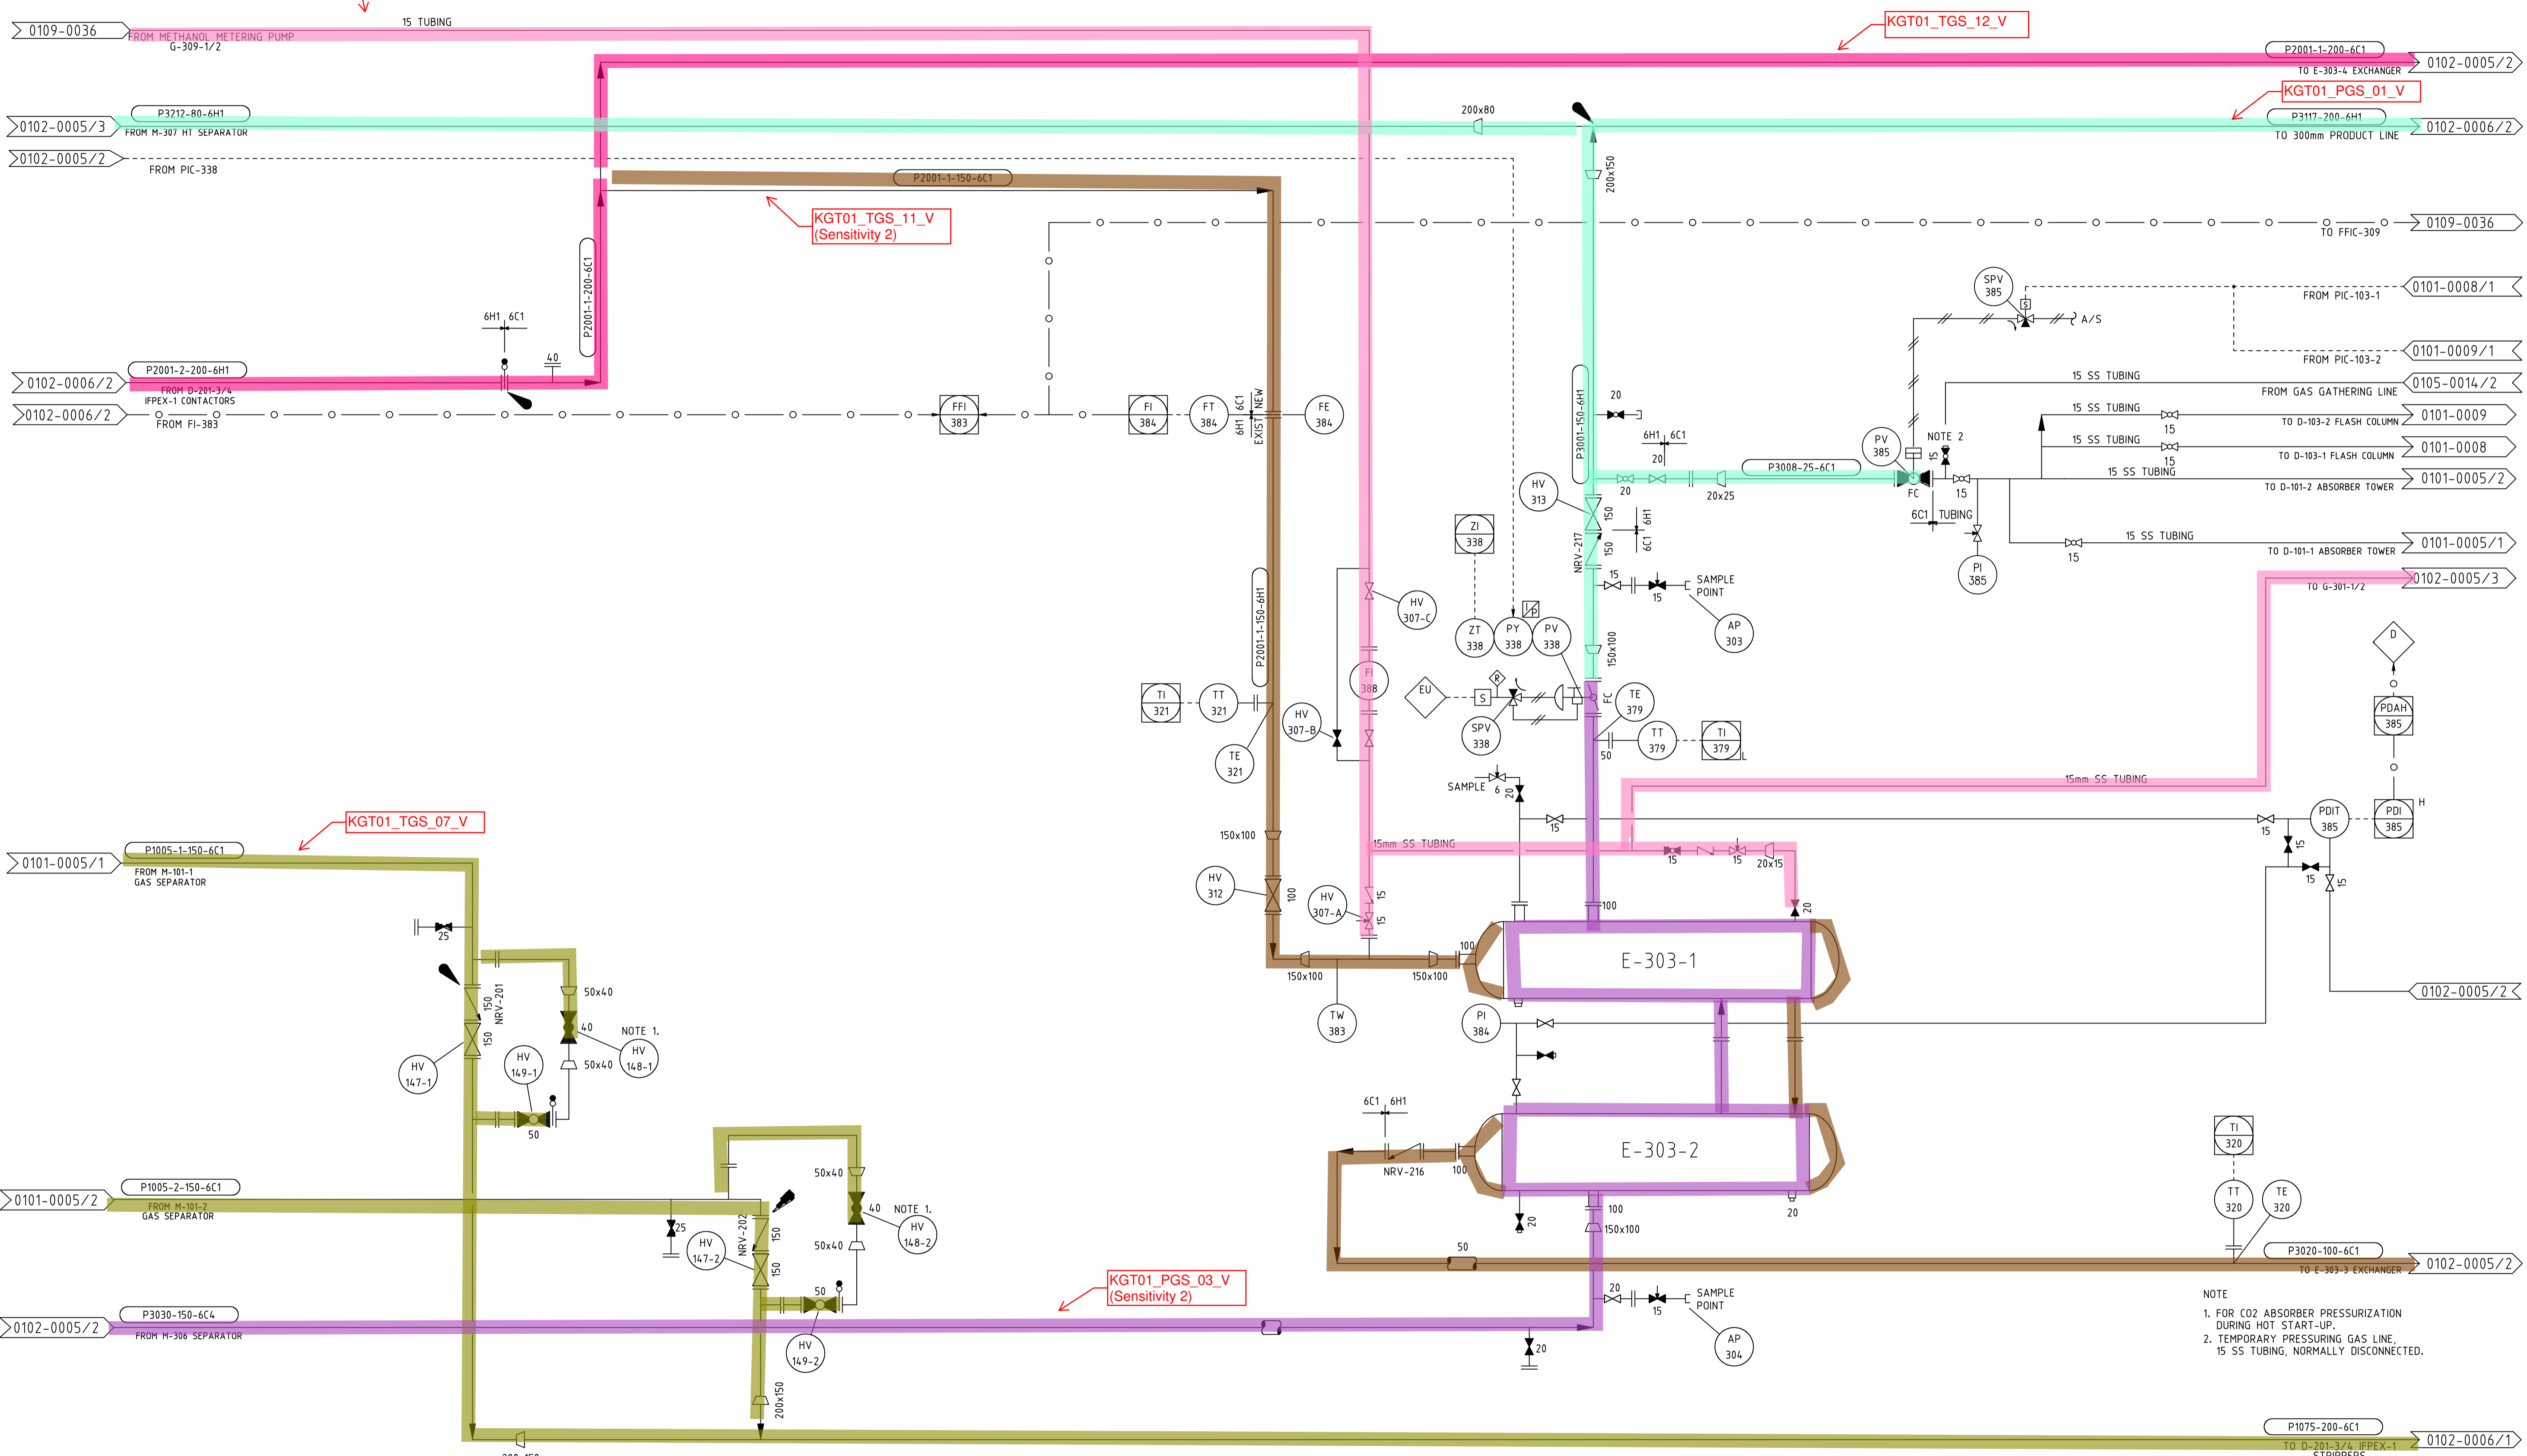

NOTE
1. FOR CO2 ABSORBER PRESSURIZATION DURING HOT START-UP.
2. TEMPORARY PRESSURING GAS LINE, 15 SS TUBING, NORMALLY DISCONNECTED.

REV	AMENDMENT	BY	CHK	ENG	APP	DATE	REV	AMENDMENT	BY	CHK	ENG	APP	DATE
22	PV-338 INSTRUMENT BALOON ADDED	RL	ES	LH	SES	07/2008							
21	STRAINER, ISOLATION VALVES & BYPASS ADDED TO FI-388	RL	ES	LH	DS	11/2007	31	P&ID SPLITTING CONTINUATION FROM 0105-0014-02	JCC	RL	AM	SES	06/2016
20	AS BUILT WS146704 CRIT. CONTROL VALVE FEEDBACK	VB	MP	PR	LH	03/07	30	NRV AND HAND VALVE NUMBERS ADDED FOR ISOLATIONS	RL	JCC	AM	SES	11/2015
19	AS BUILT FOR WS956053	VB	MP	PR	LH	07/06	29	AS BUILT P84-1091 ENHANCED LPG RECOVERY	JT	JC	AM	SES	08/2014
18	AS BUILT PTL COM'TS FOR TUBING TO ABSORBER TOWERS	RL	JM	LH	PJR	06/2005	28	HAND VALVE NUMBERS ADDED FOR ISOLATIONS	RL	AC	AM	SES	10/2013
17	LINE NUMBERS/SPEC BREAKS REVISED	RH	RL	LH	PJR	12/04	27	HAND VALVE NUMBERS ADDED FOR ISOLATIONS	RL/ES	CR	AM	SES	06/2012
16	AS BUILT PEP REDLINES & SAMPLE PT's AP-303.4 INCORP.	RH	RL	LH	PJR	12/2004	26	PARTIAL AS BUILT FOR P84-2992 MEGH INJECTION	AA	GH	WB	JS	10/11
15	AS BUILT FOR PEP PROJECT	RL	RH	CP/LH	PJR	02/2004	25	AS BUILT PGC HAZOP COMMENTS WS1324841	RL/ES	TC	JS	SES	08/2011
14	PROCESS ISOLATION POINTS ADDED ON INDIVIDUAL LAYERS	CMW	RL	CM	AIM	10/02	24	AS BUILT P84-1070 PRESS. GAS FM GAS GATHERING LINE	RL/MW	LR	JS	SES	07/2011
13	DESIGN DATA RATIONALISED FOR E-303-1 & E-303-2	CMW	RL	AvG	AIM	08/02	23	STRAINER REMOVED FROM FI-388	ES	RL/JY	LH	SES	09/08

VECTOR KAPUNI LIMITED
PRIVATE BAG 2020
NEW PLYMOUTH 4342
PHONE 0800 734 567

ssj^o

COPYRIGHT The copyright in this document is vested in Vector Kapuni Limited
The contents of this document shall not be reproduced, either in whole or part, by any means whatsoever without the prior written consent of Vector Kapuni Limited.

AUTOCAD ORIGINAL SHEET SIZE A1

DRN	P.RAWLES	DATE	01/03/87	ENG	R.VanLIJF	DATE	02/07/87
CHK	R.VanLIJF			APP	R.VanLIJF		02/07/87

SCALE:	JOB NO.	SERIES	DRG NO.	SHT 01 OF 03 SHTS	REVISION
NTS	1000000	0102	0005		31

CAD NO: BC000501

EQUIPMENT No.

DESCRIPTION
CAPACITY
MAWP @ TEMP


M-306
3 PHASE LOW TEMPERATURE SEPARATOR
1524 I.D. X 4850 T (9.78m3)
55 Barg @ -44°C

G-308-1
DECANTED WATER PUMP (100 TON)
FLOW 0.2 m3/Hr
MAWP 82 Barg @ 66°C

G-308-2
DECANTED WATER PUMP (100 TON)
FLOW 0.2 m3/Hr
MAWP 82 Barg @ 66°C

E-303-3
GAS CHILLER
2.1m3
TUBE 75.8 Barg @ 66°C/-44°C
SHELL 17.25 Barg @ 66°C/-44°C

E-303-4
GAS/LIQUID HEAT EXCHANGER
SHELL 0.53m3 TUBE 0.31m3
TUBE 58.6 Barg @ -44°C to 66°C
SHELL 50.0 Barg @ -42°C to 66°C

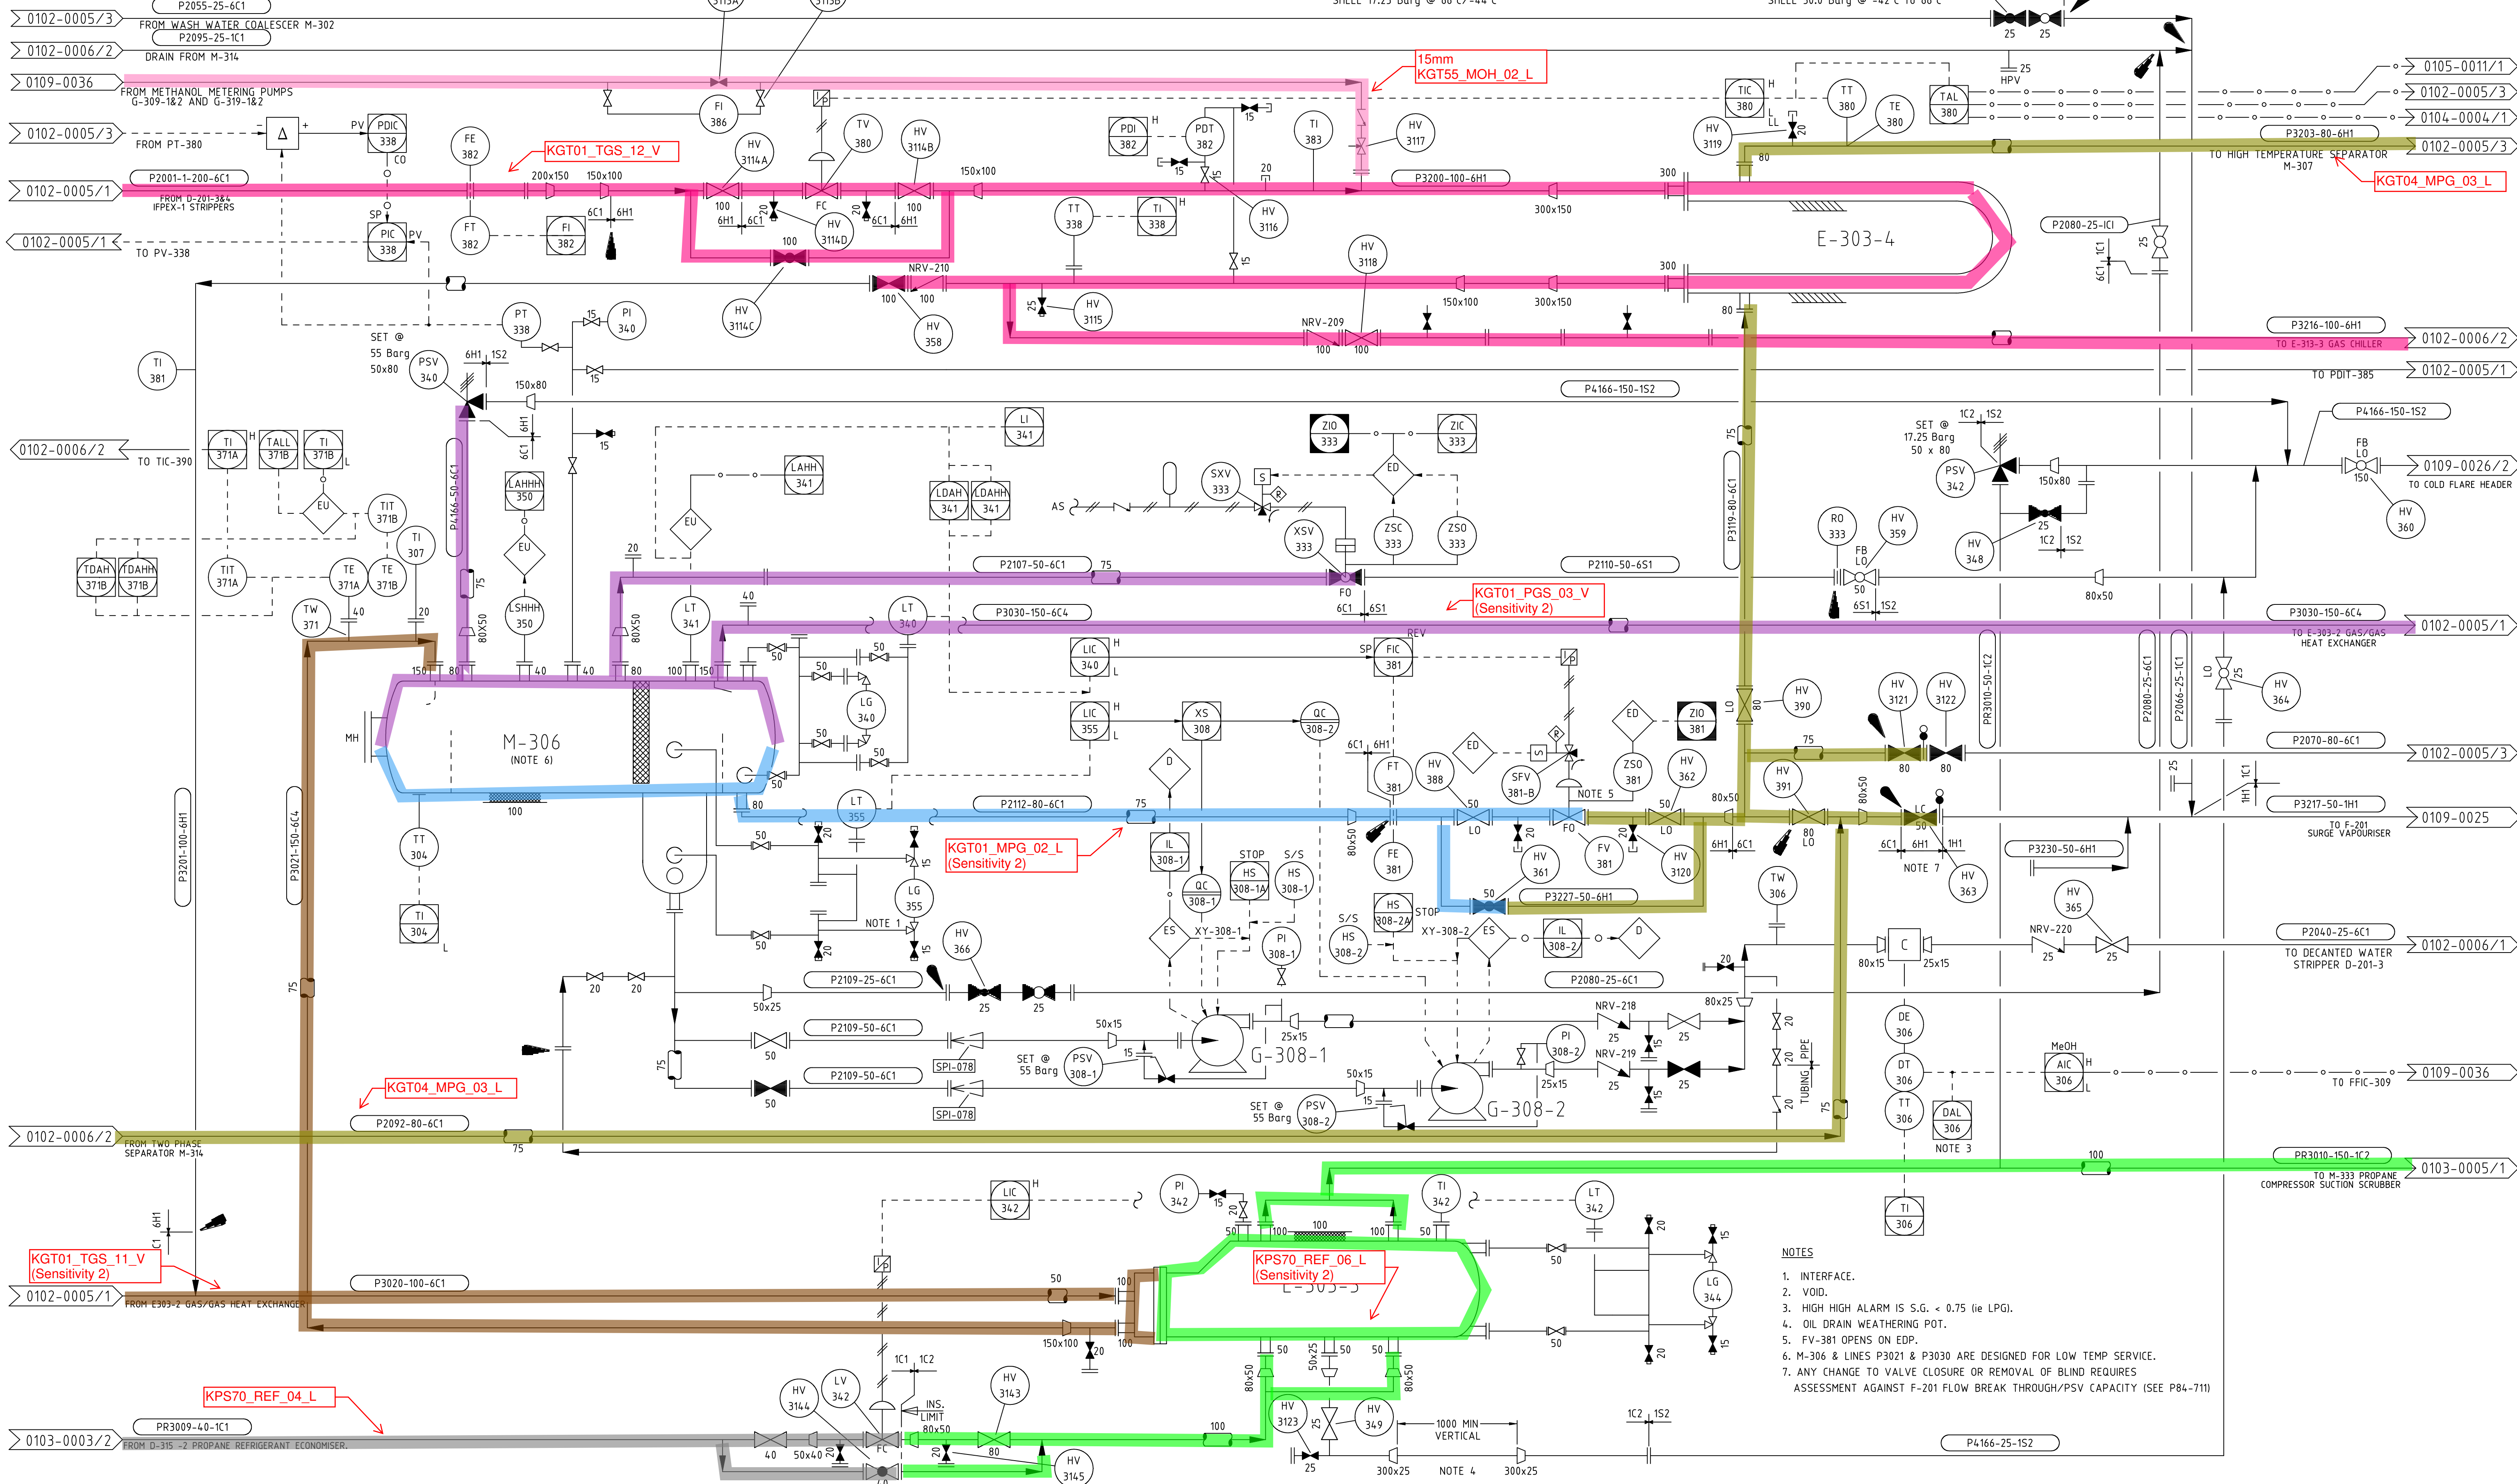

- NOTES
- INTERFACE.
 - VOID.
 - HIGH HIGH ALARM IS S.G. < 0.75 lie LPGI.
 - OIL DRAIN WEATHERING POT.
 - FV-381 OPENS ON EDP.
 - M-306 & LINES P3021 & P3030 ARE DESIGNED FOR LOW TEMP SERVICE.
 - ANY CHANGE TO VALVE CLOSURE OR REMOVAL OF BLIND REQUIRES ASSESSMENT AGAINST F-201 FLOW BREAK THROUGH/PSV CAPACITY (SEE P84-711)

REV	AMENDMENT	BY	CHK	ENG	APP	DATE	REV	AMENDMENT	BY	CHK	ENG	APP	DATE
39	AS BUILT - P84-1332 HIGH LEVEL PRO. 100T & 200T CHILLERS	RL	JCC	AM	TC	07/2019	30	AS BUILT P84-711 SURGE VAPORISER RELIEF	DH	SH	AM	SES	05/2013
38	AS BUILT - P84-1332 HIGH LEVEL PRO. 100T & 200T CHILLERS	WPG	SHA	AM	SES	08/2017	29	AS BUILT P84-3299 RERATE. PSV-308-1 & 2 WERE 82 BARG	RL/ES	PR	AM	SES	05/2013
37	AS BUILT MODS P84-1242 IMPROVEMENTS TO PROPANE REFRIG	RL	JCC	AM	SES	04/2017	27	AS BUILT P84-3166 - PROCESS VARIABILITY STUDY	ES/RL	TC	JS	SES	05/11
36	AS BUILT P84-1242 IMPROVEMENTS TO PROPANE REFRIG	RL	JCC	AM	SES	01/2017	26	AS BUILT TW-371 AND VENT SIZES CORRECTED	RL/ES	TC	LH	SES	09/10
35	AS BUILT MODS & HV NUMBERS ADDED FOR ISOLATIONS	RL	JCC	AM	SES	12/2015	25	AS BUILT P84-3007 ESD LEVEL TRANS DEVIATION ALARMS	ES	TC	LH	SES	03/10
34	HAND VALVE NUMBERS ADDED ON LOCKED VALVES	RL	JC	AM	SES	02/2015	24	AS BUILT W5980053 METHANOL METERS	ES	CB	LH	SES	06/09
33	AS-BUILT P84-1193 ENHANCED LPG RECOVERY	JB	TH	AM	SES	10/2014	23	AS BUILT LINE LIST COMMENTS ADDED	ES	RL	LH	SES	02/09
32	HAND VALVE NUMBERS ADDED FOR ISOLATIONS	RL	JC	AM	SES	08/2014	22	AS BUILT W51131635 LT SEP UNDER TEMP PROTECTION	VB	WF	PWM	LH	09/08
31	AS BUILT P84-3257 200T INLET BACK PRESSURE CONTROL	LN	JC	AM	SES	05/2014	21	AS BUILT W51131635 LT SEP UNDER TEMP PROTECTION	VB	LH	MP	PJR	07/07
								TT-306 ON M-306 NOW TAGGED TT-304	JLM	ES	AAB	PJR	10/05

VECTOR KAPUNI LIMITED
PRIVATE BAG 2020
NEW PLYMOUTH 4342
PHONE 0800 734 567

REFERENCE DRAWINGS
0780-0082/06 EDP CAUSE AND EFFECTS

DRN P.RAWLES 01/03/1987 ENG R.VanLIJF 02/07/1987
CHK R.VanLIJF APP R.VanLIJF 02/07/1987

SCALE: NTS


JOB NO. 1000000

SHEET 02 OF 03

REVISION 39

1000000-0102-0005-02.dwg

DRN	DATE	ENG	APP	DATE	SCALE	JOB NO.	SHEET	REVISION
P.RAWLES	01/03/1987	ENG	R.VanLIJF	02/07/1987	NTS	1000000	02 OF 03	39
R.VanLIJF	02/07/1987	APP	R.VanLIJF	02/07/1987				

 

EQUIPMENT No. M-305
 DESCRIPTION COALESCER PRE-FILTER
 CAPACITY 0.01m³
 MAWP 50 Bar @ 120°C

M-307
 HIGH TEMPERATURE SEPARATOR
 1219 ID x 3650 T/T (4.74m3)
 55 Bar @ 66/-29°C (NOTE 9)

G-301-1
 HT SEPARATOR CONDENSATE PUMP
 FLOW 28.4m³/hr
 MAWP 58.6 Bar @ 66°C

G-301-2
 HT SEPARATOR CONDENSATE PUMP
 FLOW 28.4m³/hr
 MAWP 58.6 Bar @ 66°C

M-302
 WASH WATER COALESCER
 CAPACITY 0.01m³
 MAWP 58.6 Bar @ 66°C

- NOTES:
- INTERFACE.
 - AUTOMATIC RECIRCULATION VALVE.
 - LAHH-381 TRIPS SPV-380
 - LALL-381 TRIPS G-301-1&2
 - CLOSED FOR WASH WATER TO M-111 DURING IPEXOL COLUMN OUTAGE.
 - OPEN FOR WASH WATER TO M-307/M-111 DURING IPEXOL COLUMN OUTAGE.
 - POAHH-341 TRIPS FIC-380 TO MANUAL AND FULLY CLOSED.
 - VALVE THROTTLED TO SLOW RATE OF OPENING OF LV-380-2 TO APPROX. 2 SECONDS AND HANDLE REMOVED.
 - M-307 AND ASSOCIATED PIPEWORK HAS BEEN CHECKED AND CONFIRMED SUITABLE TO OPERATE DOWN TO -35°C.

REV	AMENDMENT	BY	CHK	ENG	APP	DATE	REV	AMENDMENT	BY	CHK	ENG	APP	DATE
40	CONTINUATION FROM P&ID SPLITTING 0104-0004	JCC	RL	AM	SES	06/2016	30	AS BUILT P84-159 REMOVE ZSC-334 INHIBIT FROM ESD SYS	RM	CJ	SES	AM	10/2013
39	HAND VALVE NUMBER HV-314 ADDED FOR ISOLATIONS	RL	JCC	AM	SES	04/2016	29	AS BUILT P84-2992 MECH INJECTION WORK RE-INSTATED	RL/ES	AAB	AM	SES	11/2012
38	HAND VALVE NUMBER ADDED FOR ISOLATIONS	RL	JCC	AM	SES	12/2015	28	AS BUILT P84-1131 HTS VAPOUR 3 TRAIN OP.	ES/RL	AAB	AM	SES	10/12
37	REVISED FOR FOR ISOLATIONS & LO REMOVED FROM HV-373-2	RL	JCC	AM	SES	10/2015	27	PARTIAL AS BUILT FOR P84-2992 MECH INJECTION	AA	GH	WB	JS	10/11
36	LEVEL BRIDLE LT-381, LT-380, LT-346, HV NUMBERS ADDED	JCC	RL/CB	AM	SES	04/2015	26	AS BUILT M-305 DV & PGC HAZOP COMMENTS	RL/ES	JHS	JS	SES	08/11
35	HAND VALVE NUMBERS, NRV NUMBERS, CSO AND NOTE 8 ADDED	RL	JCC/AM	AM	SES	04/2015	25	AS BUILT P84-3166 - PROCESS VARIABILITY STUDY	ES/RL	TC	JS	SES	05/11
34	AS BUILT P84-1166 HT SEP CONTROL MODS & P&ID SPLITTING	RL	JCC/AB	AM	SES	02/2015							
33	AS BUILT, DRAIN VALVE DETAILED ON LT-346 OF M-302	RL	JCC	AM	SES	09/2014							
32	HAND VALVE No's ADDED FOR ISOLATIONS & PDAH-341 ADDED	RL	JCC	AM	SES	08/2014							
31	AS BUILT P84-3257 200T INLET BACK PRESSURE CONTROL	LN	JC	AM	SES	05/2014	41	AS BUILT FAL-346 & NOTE 9 ADDED, M-305 DATA REVISED	RL	JCC	AM	TC	07/2019

VECTOR KAPUNI LIMITED
 PRIVATE BAG 2020
 NEW PLYMOUTH 4342
 PHONE 0800 734 567

Copyright © The copyright in this document is vested in Vector Kapuni Limited. The contents of this document shall not be reproduced, either in whole or part, by any means whatsoever without the prior written consent of Vector Kapuni Limited.

AUTOCAD ORIGINAL SHEET SIZE A1

REFERENCE DRAWINGS
 CAUSE & EFFECTS - 0780-0082/04 & 0780-0082/05

DRN	J.WELLS	17/08/1996	ENG	K.EDEN	01/12/1987
CHK	M.LU	01/02/1987	APP		

DEHYDRATION AND DEWPOINT CONTROL
 PIPING & INSTRUMENT DIAGRAM
 HT SEPARATOR & WASH WATER COALESCER

SCALE:	JOB NO.	SERIES	DRG. NO	SHT	REVISION
NONE	1000000	0102	0005	03 OF 03 SHTS	41

EQUIPMENT No.

DESCRIPTION
CAPACITY
MAWP @ TEMP

D-201-3
DECANTED WATER STRIPPER
6.6m³
55.16 Barg @ 121/0°C

D-201-4
WASH WATER STRIPPER
8.1m³
55.16 Barg @ 121/0°C

- NOTES:
1. TRAYS REMOVED AND REPLACED BY RANDOM PACKING.
 2. TRAYS REMOVED AND REPLACED BY STRUCTURED PACKING
 3. BOTTOM OF 25NB HYDROCARBON DRAIN IS 13% ABOVE BOTTOM LEVEL RANGE OF LT-201-4.
 4. FOR FUTURE CORIOLIS
 5. LT-201-4 RADAR TRANSMITTER HAS BENT ROD ANTENNA SPAN = 265MM. CAUTION IS REQUIRED WHEN REMOVING FROM VESSEL.

0102-0005/3 FROM M-302 WASH WATER COALESCER
P2044-25-6C1
0102-0005/2 FROM G-308-1/2 DECANTED WATER PUMP (100 TON)
P2040-25-6C1
0102-0006/2 FROM G-318-1/2 DECANTED WATER PUMP (200 TON)
P2094-25-6C1

LEGEND
MOTHBALLED

0101-0006 FROM GAS SEPARATOR M-101-3
P1109-3-150-6C1
0102-0005/1 FROM GAS SEPARATORS M-101-182
P1075-200-6C1
0105-0010 P2108-80-6C1
0101-0005/2 GATHERED GAS DEPTH & STAB OVERHEADS
P70038-150-6C1
0102-0005/3 FROM FT-345
P2100-150-6C1

REV	AMENDMENT	BY	CHK	ENG	APP	DATE	REV	AMENDMENT	BY	CHK	ENG	APP	DATE
42	AS-BUILT P84-1377 AP-201-3A ADDED & AP-201-3 RELOCATED	RL	NM	AM	SES	05/2016	32	FROM ARROW CORRECTED FOR GATH GAS & WS1384042	RL	SR	LH	SES	02/09
41	AS-BUILT - P84-1233 TRAYS REMOVED, ADDED AXV-102-3	JCC	RL/CB	AM	SES	04/2016	31	SAMPLE POINT AP-201-4B ADDED WS1368350	ES	RL	LH	SES	12/08
40	NRV No's ADDED & HV No's ADDED FOR ISOLATIONS ETC.	RL	JCC	AM	SES	09/2015	30	AS BUILT WS1043310 IMPROVE IFFXOL CONTROL	ES	MD	LH	SES	04/08
39	AS BUILT P84-944 REPLACE TRAIN 3 THINNED PIPEWORK	JC	LN	AM	SES	02/15	29	LINE No SPECS FOR P1086, P1087, P1088 REVISED TO 600#	RL	RH	LH	DS	11/2007
38	AS BUILT FOR P84-176 UPGRADE IFFEX	KM	CJ	AM	SES	11/13							
37	HAND VALVE NUMBER ADDED FOR ISOLATIONS & SPI-264	RL	CR	AM	SES	06/2013							
36	PGC/IFFEXOL HAZOP MARK UPS WS 1324841	MW	LR	JS	SES	08/11							
35	AS BUILT P84-3007 ESD LEVEL TRANS DEVIATION ALARMS	ES	TC	LH	SES	03/10	45	AS BUILT P84-1367 MOTHBALL BENFIELD TRAIN 3	JB	CJ	AM	TC	09/2019
34	AS BUILT D-201-3 & 4. NOZ. CONFIG. & TYPE. WS2007270	RL	WB	LH	SES	10/09	44	AS BUILT P84-1356 ADDED AP-201-3B, AP-201-4C	JCC	RL/AC	AM	SES	03/2017
33	AS BUILT AP-201-3 RE-POSITIONED	ES	RL	LH	SES	10/09	43	P&ID SPLITTING CONTINUATION FROM 0105-0014-02	JCC	RL	AM	SES	06/2016

VECTOR KAPUNI LIMITED
PRIVATE BAG 2020
NEW PLYMOUTH 4342
PHONE 0800 734 567

Copyright © The copyright in this document is vested in Vector Kapuni Limited. The contents of this document shall not be reproduced, either in whole or part, by any means whatsoever without the prior written consent of Vector Kapuni Limited.

AUTOCAD ORIGINAL SHEET SIZE A1


REFERENCE DRAWINGS

CAUSE AND EFFECT - 0780-0082/04

DRN	P.RAWLES	DATE	ENG	R.VanLUF	DATE
CHK	R.VanLUF	02/04/1987	APP	R.VanLUF	03/07/1987

DEHYDRATION AND DEWPOINT CONTROL
PIPING & INSTRUMENT DIAGRAM
IFFEX-1 STRIPPERS

SCALE:	JOB NO.	SERIES	DRG. NO	SHT 01	REVISION
NTS	1000000	0102	0006	OF 02 SHTS	45

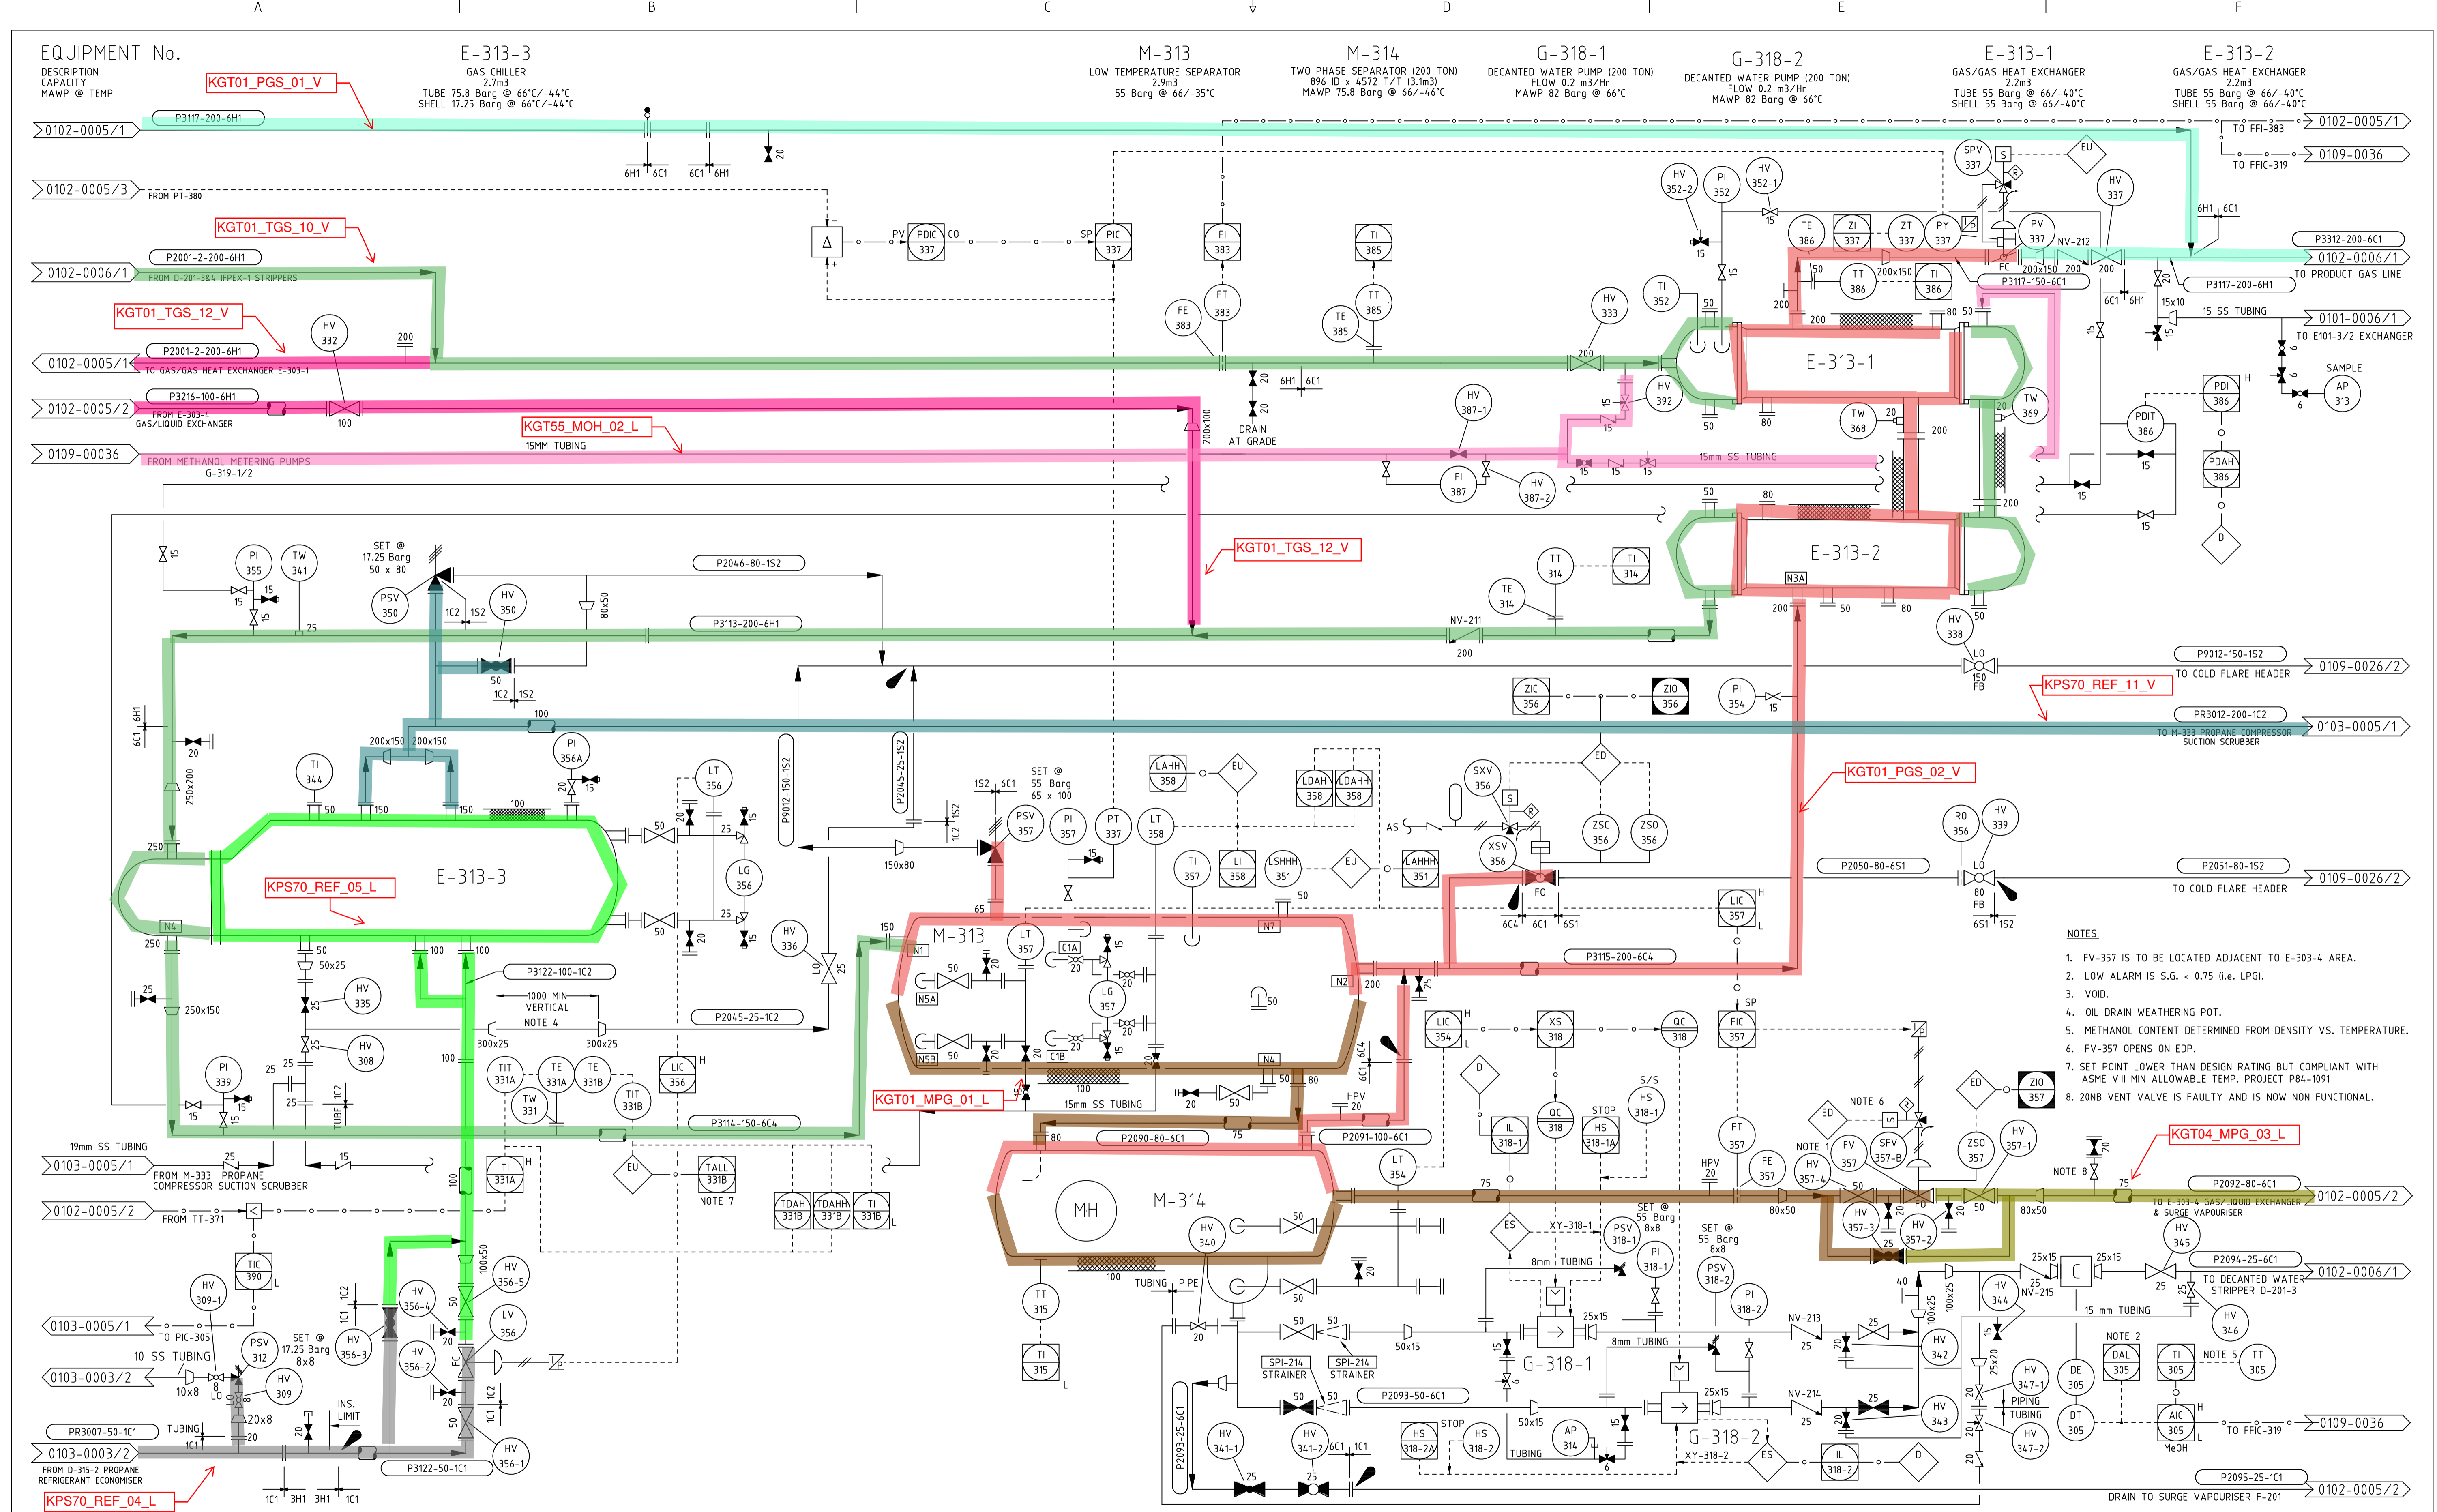

- NOTES:**
1. FV-357 IS TO BE LOCATED ADJACENT TO E-303-4 AREA.
 2. LOW ALARM IS S.G. < 0.75 (I.E. LPG).
 3. VOID.
 4. OIL DRAIN WEATHERING POT.
 5. METHANOL CONTENT DETERMINED FROM DENSITY VS. TEMPERATURE.
 6. FV-357 OPENS ON EDP.
 7. SET POINT LOWER THAN DESIGN RATING BUT COMPLIANT WITH ASME VIII MIN ALLOWABLE TEMP. PROJECT P84-1091
 8. 20NB VENT VALVE IS FAULTY AND IS NOW NON FUNCTIONAL.

REV	AMENDMENT	BY	CHK	ENG	APP	DATE	REV	AMENDMENT	BY	CHK	ENG	APP	DATE
40	AS BUILT TW-318 & TE-318 REMOVED FROM P2094-25-6C1	RL	JCC	AM	TC	05/2017	30	PARTIAL AS BUILT FOR P84-2992 MECH INJECTION	AA	GH	WB	JS	10/11
39	AS BUILT P84-1342 IMPROVE PROPANE SUCT. SCRUBBER DRAIN	RL	JCC	AM	TC	11/2016	29	AS BUILT PGC HAZOP COMMENTS WS1324&41	RL/ES	TC	JS	SES	08/11
38	HV No's ADDED FOR ISOLATIONS & LT-356, LT-354 MODS	RL	JCC	AM	SES	08/2015	28	AS BUILT P84-3166 - PROCESS VARIABILITY STUDY	ES/RL	TC	JS	SES	05/11
37	AS-BUILT P84-1168 REPLACE M-313 LEVEL BRIDLE	CJ	SH	AM	SES	01/2015							
36	AS-BUILT P84-1168 ON SITE	JB	JC	AM	SES	09/2014							
35	AS-BUILT P84-1091 ENHANCED LPG RECOVERY	JB	JC	AM	SES	08/2014							
34	AS-BUILT P84-929 PROPANE THERMAL RELIEFS	JB	SH	AM	SES	06/2014	44	AS BUILT P84-1517 REMOVE LG-354 FROM M-314	RL	JCC	AM	TC	07/2019
33	HAND VALVE NUMBERS ADDED FOR ISOLATIONS	RL	CR	AM	SES	04/2014	43	AS BUILT P84-1509, PI-350 REMOVED & HV-309-1 No. ADDED	RL	JCC	AM	TC	06/2019
32	AS BUILT P84-3299 RERATE, PSV-318-1 & 2 WERE 82 BARG	RL/ES	PR	AM	SES	05/2013	42	AS BUILT P84-1332 HIGH LVL PROTECTION	JCC	AAB	AM	SES	08/2018
31	SPEC CHANGE AT PSV-357 CORRECTED FROM 1C1 TO 6C1	RL	CR	AM	SES	10/2012	41	AS BUILT P84-1332 HIGH LVL PROTECTION & P84-1305	JCC	MM	AM	SES	07/2017

VECTOR KAPUNI LIMITED
 PRIVATE BAG 2020
 NEW PLYMOUTH 4342
 PHONE 0800 734 567

ssj^o

COPYRIGHT The copyright in this document is vested in Vector Kapuni Limited. The contents of this document shall not be reproduced, either in whole or part, by any means whatsoever without the prior written consent of Vector Kapuni Limited.

AUTOCAD ORIGINAL SHEET SIZE A1

REFERENCE DRAWINGS

0780-0082/06 EDP CAUSE AND EFFECTS

DRN	P.RAWLES	07/04/1987	ENG	R.VanLUF	02/07/1987
CHK	R.VanLUF	03/07/1987	APP	R.VanLUF	02/07/1987


DEHYDRATION AND DEWPOINT CONTROL
 PIPING & INSTRUMENT DIAGRAM
 GAS CHILLER & SEPARATOR TRAIN 3 (200 TON)

SCALE: NTS

JOB NO.	SERIES	DRG. NO	SHT	REVISION
1000000	0102	0006	02 OF 02 SHTS	44


EQUIPMENT No.
DESCRIPTION
CAPACITY
MAWP @ TEMP

F-315
PROPANE REFRIGERANT SURGE DRUM
9.2 m³
18.27 Barg @ 93/-29°C

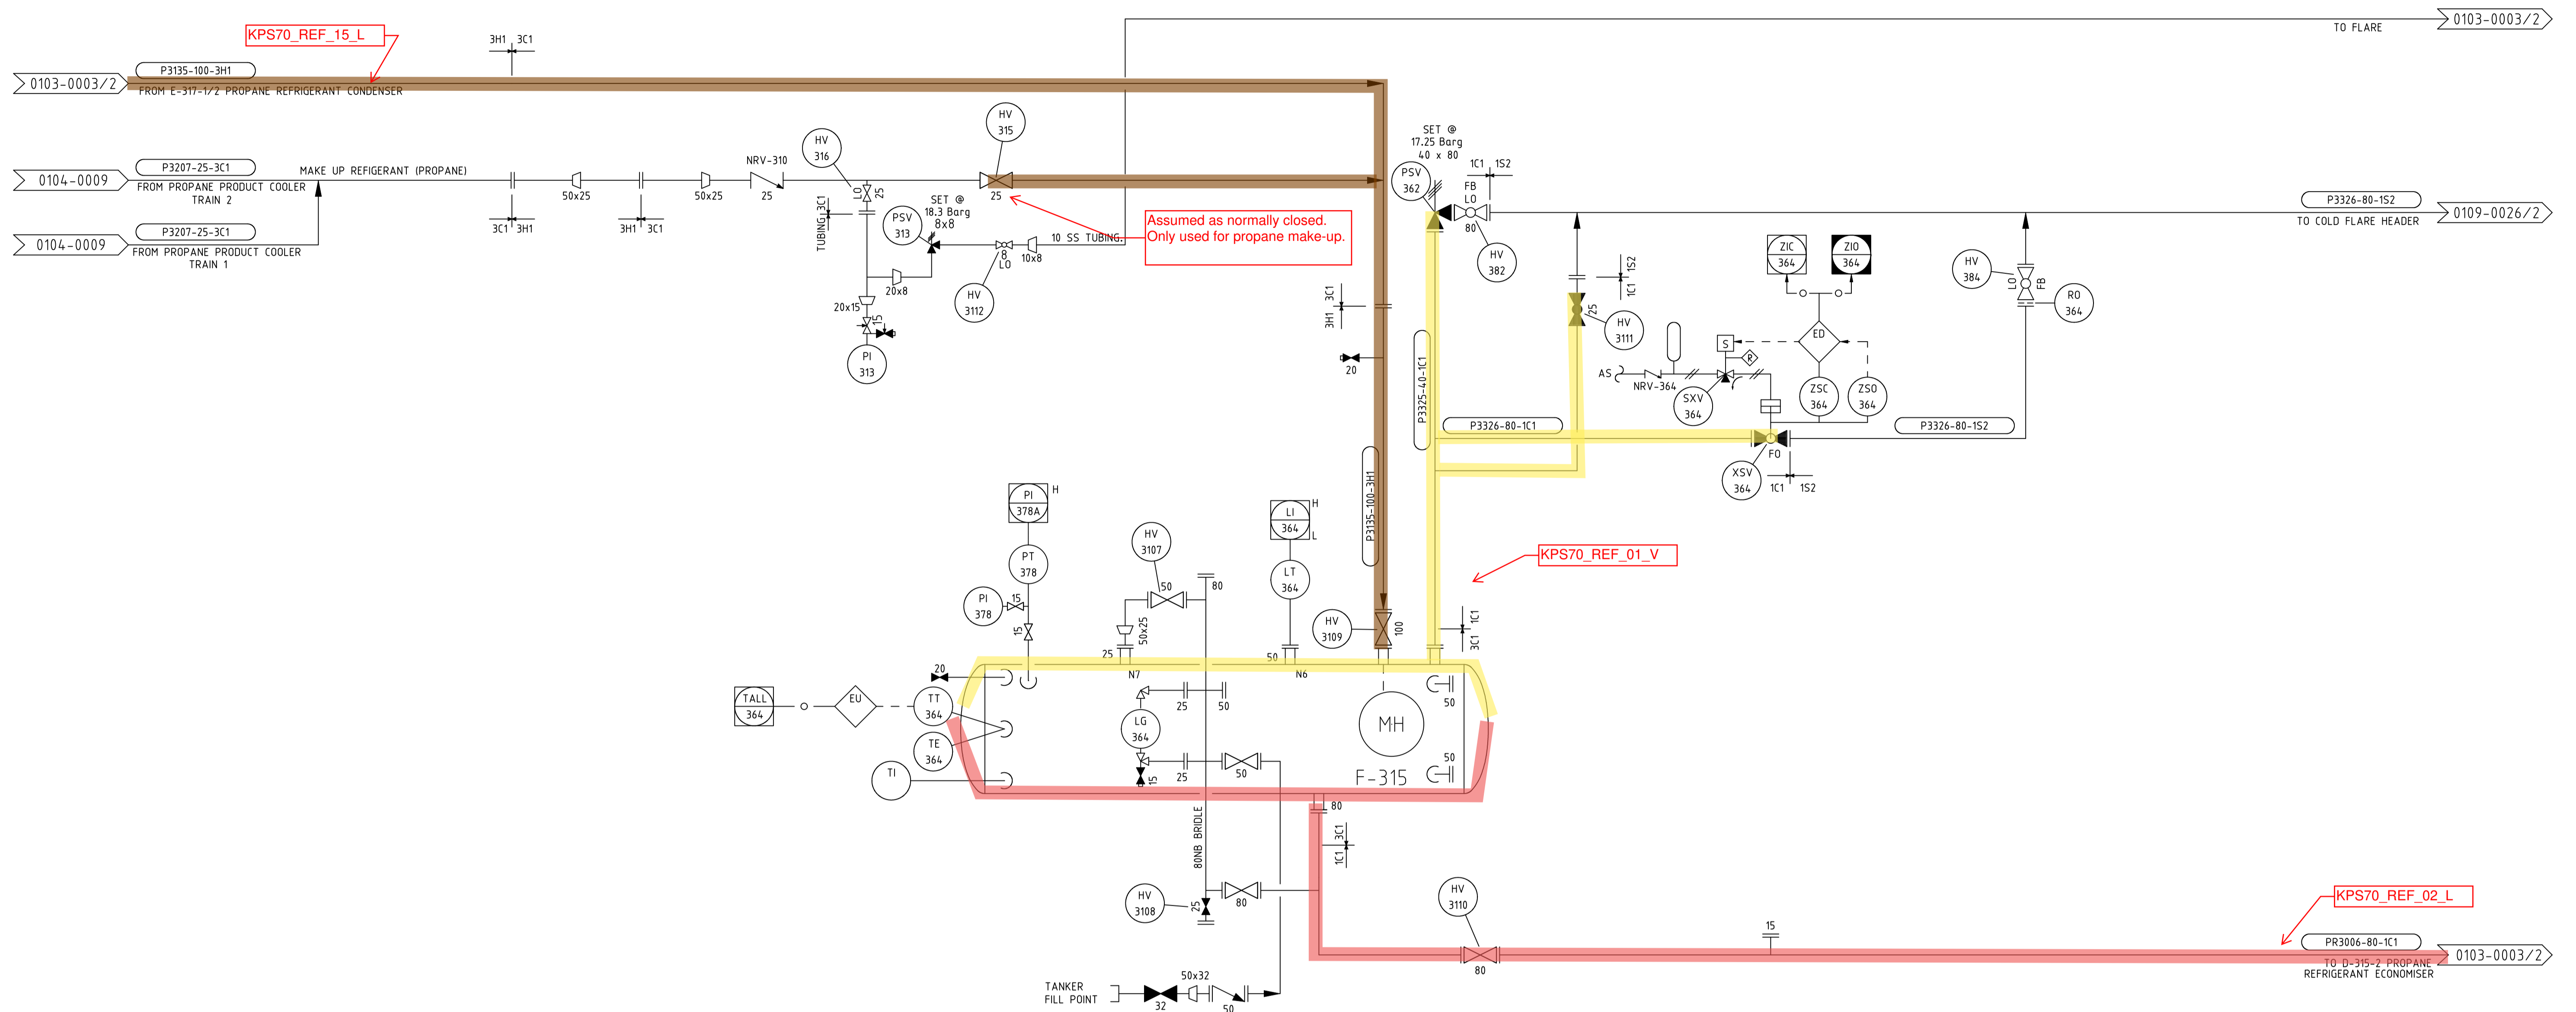

REV	AMENDMENT	BY	CHK	ENG	APP	DATE	REV	AMENDMENT	BY	CHK	ENG	APP	DATE
13	HAND VALVE NUMBERS ADDED FOR ISOLATIONS	RL	CR	AM	SES	10/2013							
12	AS BUILT WS1059590 F-315 LEVEL TRANSMITTER UPGRADE	RL	MD	LH	PJR	07/2007							
11	PROCESS ISOLATION POINTS ADDED ON INDIVIDUAL LAYERS	CMW	RL	CM	AIM	10/02							
10	DESIGN DATA RATIONALISED FOR F-315	CMW	RL	AvG	AIM	08/02							
9	REVISED FOR NEW PRINT DRAWING CONTENT NOT CHANGED	VB	RL	EJH	RS	10/99							
18	AS BUILT P84-1525 FILL CONN FOR PROPANE REFRIG SYSTEM	RL	JC	AM	TC	02/2020	8	AS BUILT & SITE CHECKED FOR REFURBISHMENT PROJECT	V.B.	G.R.	K.E.	G.M.	02/98
17	HAND VALVE NUMBERS ADDED FOR ISOLATIONS	RL	JCC	AM	SES	12/2015	7	AS BUILT COMMENTS INCORPORATED	V.B.	B.T.	A.V.G.	C.J.	5/95
16	AS BUILT FOR P84 SPLITTING - CONT. DRG. No's REVISED	RL	JCC	AM	SES	01/2015	6	REVISED FOR CONTINUITY CHECK	P.T.D.	O.G.M.	A.V.G.	C.J.	10/94
15	AS-BUILT P84-856 INTERLOCK LOW TEMP PROTECTION	LN	JC	AM	SES	10/2014	5	AS BUILT & UPDATED TO VERSION 11.52	W.D.	J.C.	G.M.	J.R.	3/94
14	AS-BUILT P84-929 PROPANE THERMAL RELIEFS	JB	SH	AM	SES	06/2014	4	REDRAWN ON ACD AS 2 SHEETS	J.C.	M.W.	D.K.M.	J.R.	7/93

VECTOR KAPUNI LIMITED
PRIVATE BAG 2020
NEW PLYMOUTH 4342
PHONE 0800 734 567

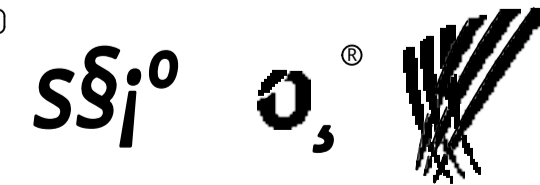


COPYRIGHT The copyright in this document is vested in Vector Kapuni Limited
The contents of this document shall not be reproduced, either in whole or part, by any
means whatsoever without the prior written consent of Vector Kapuni Limited.

REFERENCE DRAWINGS		DATE	DATE
DRN	G.BUTLER	01/03/1974	ENG
CHK	J.GARNIE	01/03/1974	APP
	E.DRUMMOND	05/05/1974	ENG
	P.DOKTER	05/05/1974	APP

REFRIGERATION SYSTEM
PIPING & INSTRUMENT DIAGRAM
PROPANE REFRIGERATION SURGE DRUM

SCALE:	JOB NO.	SERIES	DRG. NO	SHT 01 OF 02 SHTS	REVISION
NTS	1000000	0103	0003		18

1000000-0103-0003-01.DWG

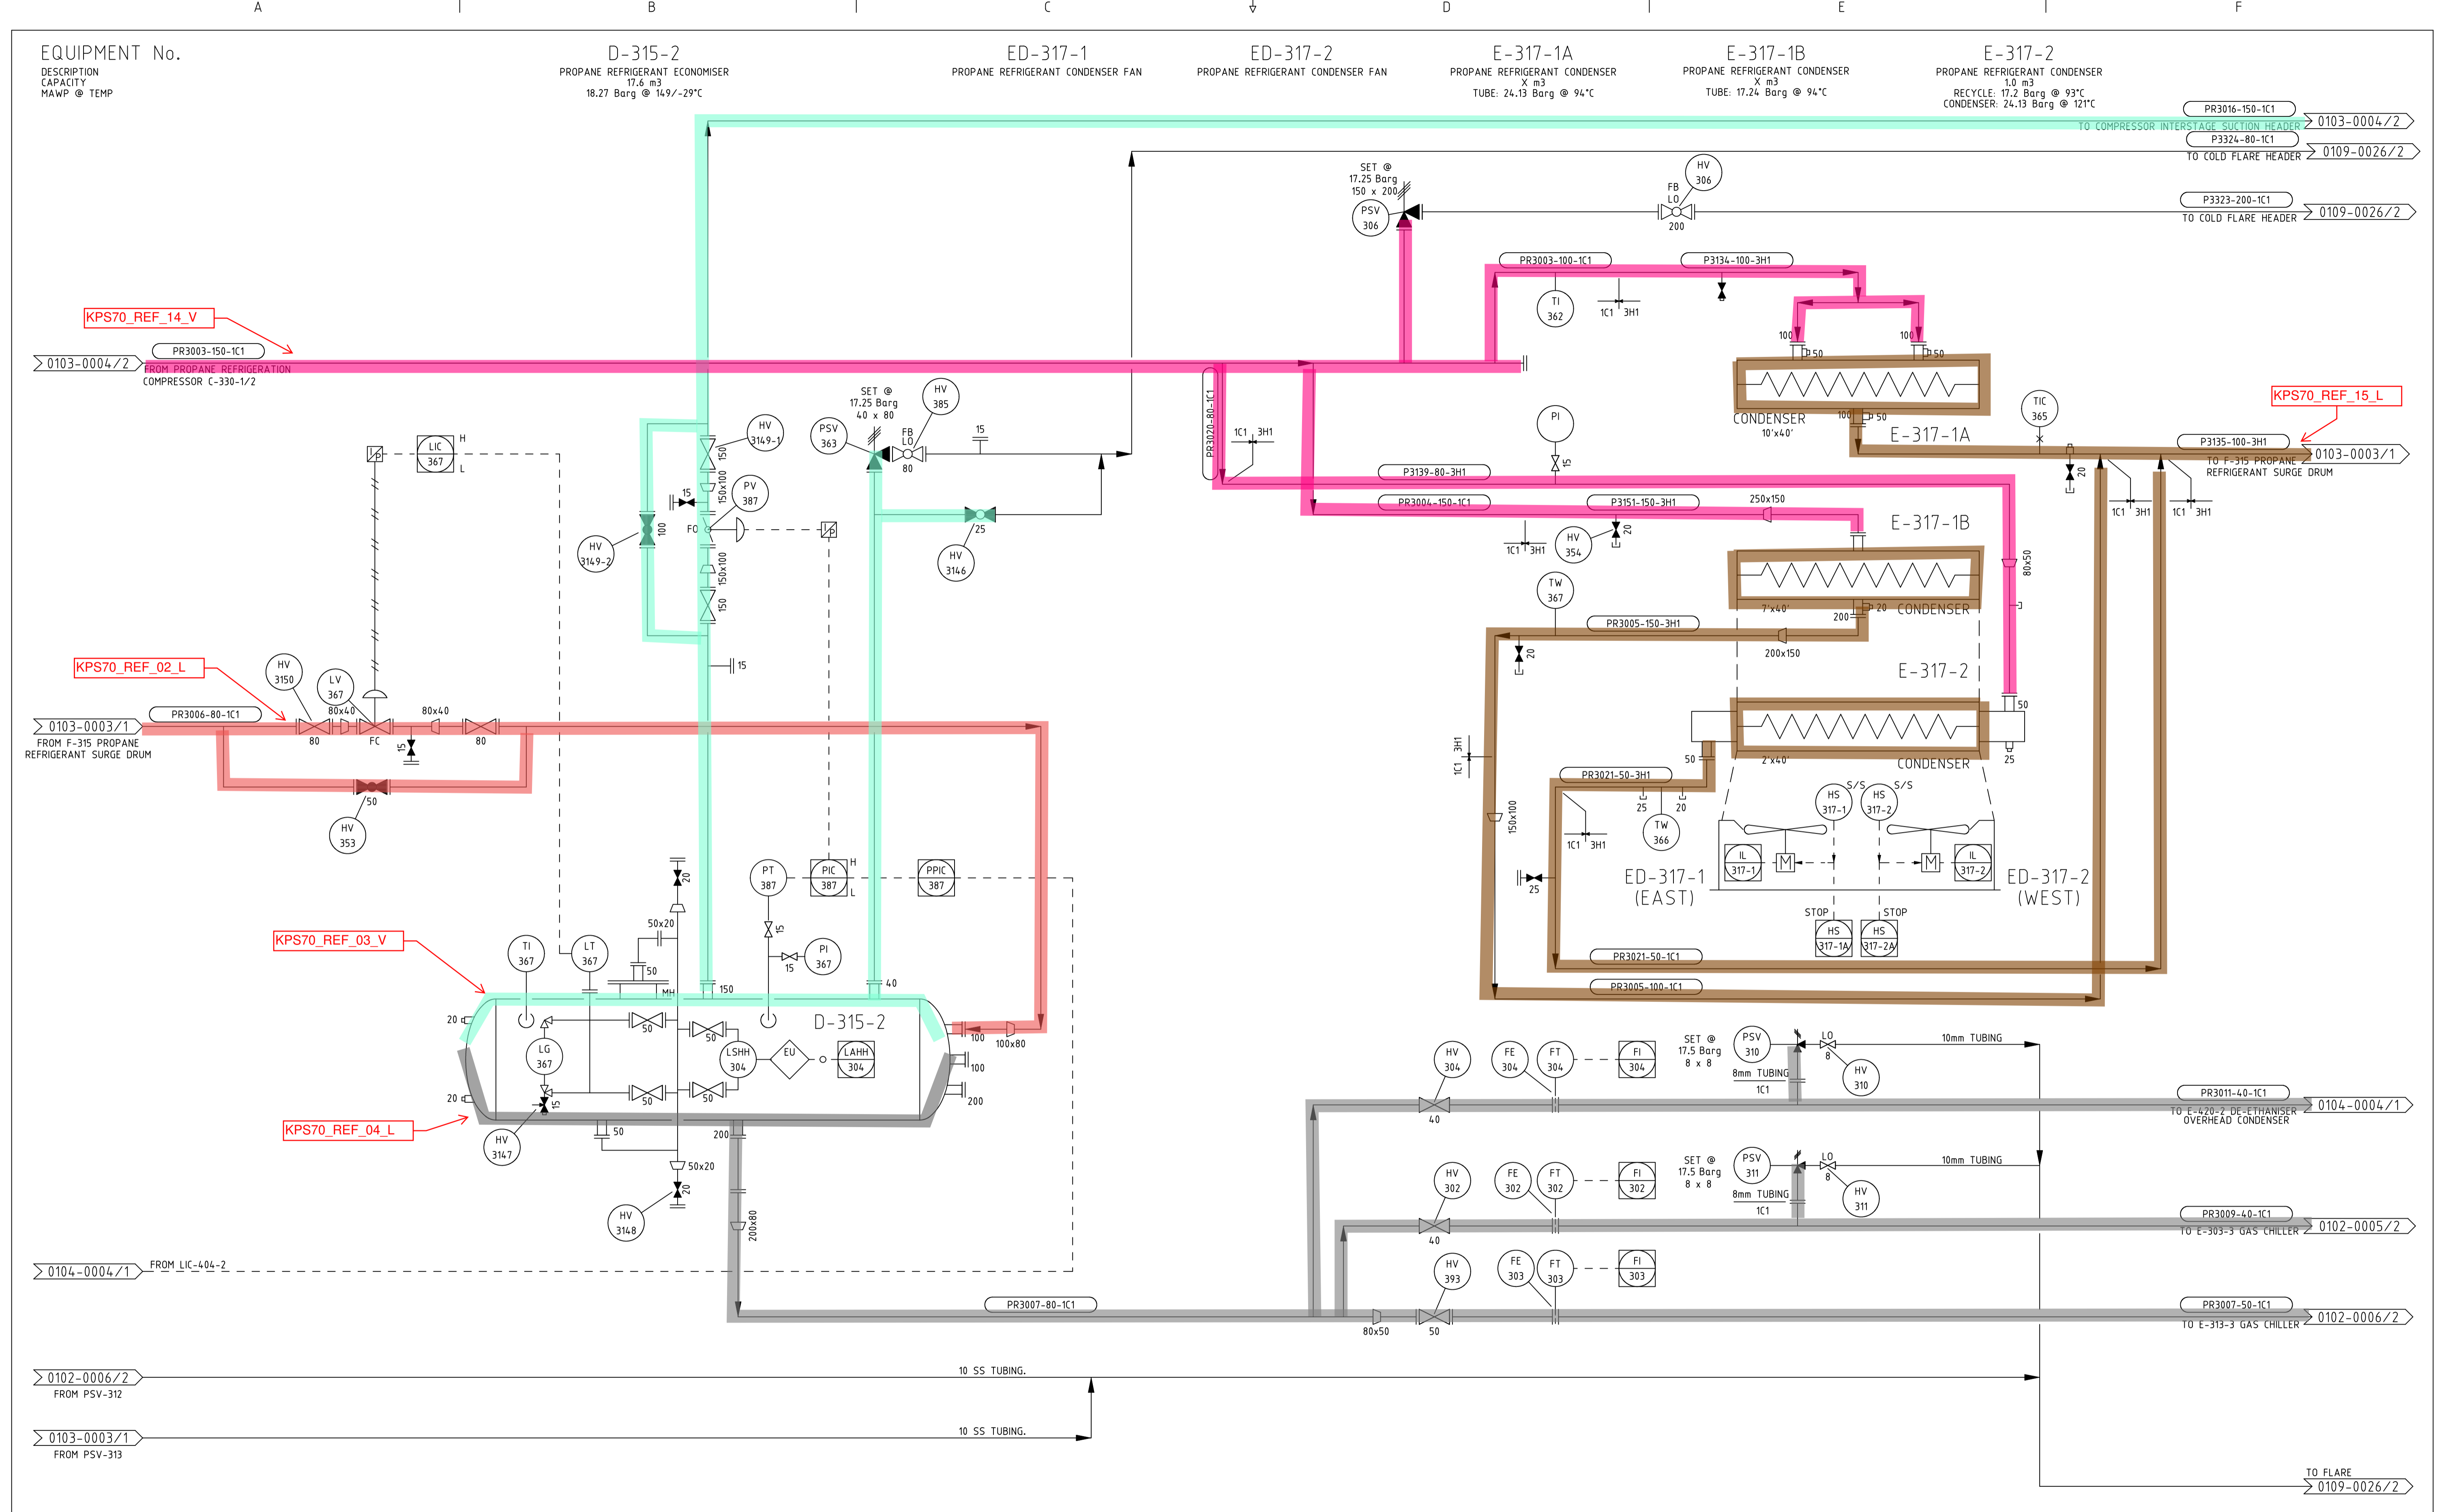

REV	AMENDMENT	BY	CHK	ENG	APP	DATE	REV	AMENDMENT	BY	CHK	ENG	APP	DATE
19	HAND VALVE NUMBERS ADDED FOR ISOLATIONS	RL	JCC	AM	SES	01/2017	9	PROCESS ISOLATION POINTS ADDED ON INDIVIDUAL LAYERS	CMW	RL	CM	AIM	10/02
18	HAND VALVE NUMBERS ADDED FOR ISOLATIONS	RL	JCC	AM	SES	12/2015	8	DESIGN DATA RATIONALISED D-315, E-317'S & ED'S 1&2 ADDED	CMW	RL	AvG	AIM	08/02
17	AS BUILT P84-1220 RE LT-367 & HV NUMBERS ADDED	RL	JCC	AM	SES	08/2015	7	EQUIPMENT TAGS ON CONDENSERS MODIFIED	VB	RL	E.JH	RJW	02/01
16	AS BUILT FOR P84-1220 RE LT-367 & HV NUMBERS ADDED	RL	JCC	AM	SES	08/2015	7	REVISED FOR NEW PRINT DRAWING CONTENT NOT CHANGED	VB	RL	E.JH	RS	10/99
15	AS BUILT FOR P84-1220 RE LT-367 & HV NUMBERS ADDED	JCC	RL	AM	SES	01/2015	6	AS BUILT & SITE CHECKED FOR REFURBISHMENT PROJECT	V.B.	G.R.	K.E.	G.M.	02/98
14	AS BUILT P84-929 PROPANE THERMAL RELIEFS	JB	JC	AM	SES	06/2014	5	AS BUILT COMMENTS ADDED	J.B.H.	R.L.	AvG	A.M.B.	05/12/96
13	HAND VALVE NUMBERS ADDED FOR ISOLATIONS	RL	CR	AM	SES	10/2013	4	AS BUILT COMMENTS INCORPORATED	V.B.	B.T.	AvG	C.J.	5/95
12	CAPACITY OF D-315-2 CHANGED, LINE P3151-150-3H1 ADDED	ES	RL	LH	SES	10/09	3	REVISED FOR CONTINUITY CHECK	P.T.D.	O.G.M.	A.V.G.	C.J.	10/94
11	AS BUILT TV-365, TV-366 AND TV367 DELETED	RL	GS	LH	PJR	02/2007	2	AS BUILT & UPDATED TO VERSION 11.52	W.T.	J.B.E.	G.M.	J.R.	3/94
10	AS BUILT FOR PEP PROJECT	RL	JBH	CP/LH	PJR	02/2004	1	REDRAWN ON CAD AS 2 SHEETS	J.C.	M.W.	D.K.M.	J.R.	7/93

VECTOR KAPUNI LIMITED
 PRIVATE BAG 2020
 NEW PLYMOUTH 4342
 PHONE 0800 734 567

ssj^o

COPYRIGHT The copyright in this document is vested in Vector Kapuni Limited. The contents of this document shall not be reproduced, either in whole or part, by any means whatsoever without the prior written consent of Vector Kapuni Limited.

AUTOCAD ORIGINAL SHEET SIZE A1


DRN	G.BUTLER	03/03/1974	ENG	E.DRUMMOND	05/05/1974
CHK	J.GARNE	03/03/1974	APP	P.DOKTER	05/05/1974

SCALE:	JOB NO.	SERIES	DRG. NO	SHT 02	REVISION
NTS	1000000	0103	0003	02	19

EQUIPMENT No.

DESCRIPTION
CAPACITY
MAWP @ TEMP

EQUIPMENT No.	DESCRIPTION	CAPACITY	MAWP @ TEMP
E-330-1	OIL COOLER	HEAT LOAD 128kW CAPACITY 0.044m ³	TUBE: 12 Barg @ 100/-20°C SHELL: 30 Barg @ 100/-20°C
M-331-1	OIL FILTER	CAPACITY 0.0134m ³	MAWP 42 Barg @ 0°C TO 120°C
M-332-1	OIL FILTER	CAPACITY 0.0134m ³	MAWP 42 Barg @ 0°C TO 120°C
C-330-1	COMPRESSOR	-34°C 1.21/14.5 Barg CAPACITY 619 kWR SHAFTPOWER 441 kW	-27.7°C 1.52/14.5 Barg CAPACITY 778 kWR SHAFTPOWER 462 kW
M-330-1	OIL SEPARATOR	CAPACITY 1.54m ³	MAWP 20.68 Barg @ 100-44°C
E-331-1	OIL HEATER	HEAT LOAD 0.6kW	

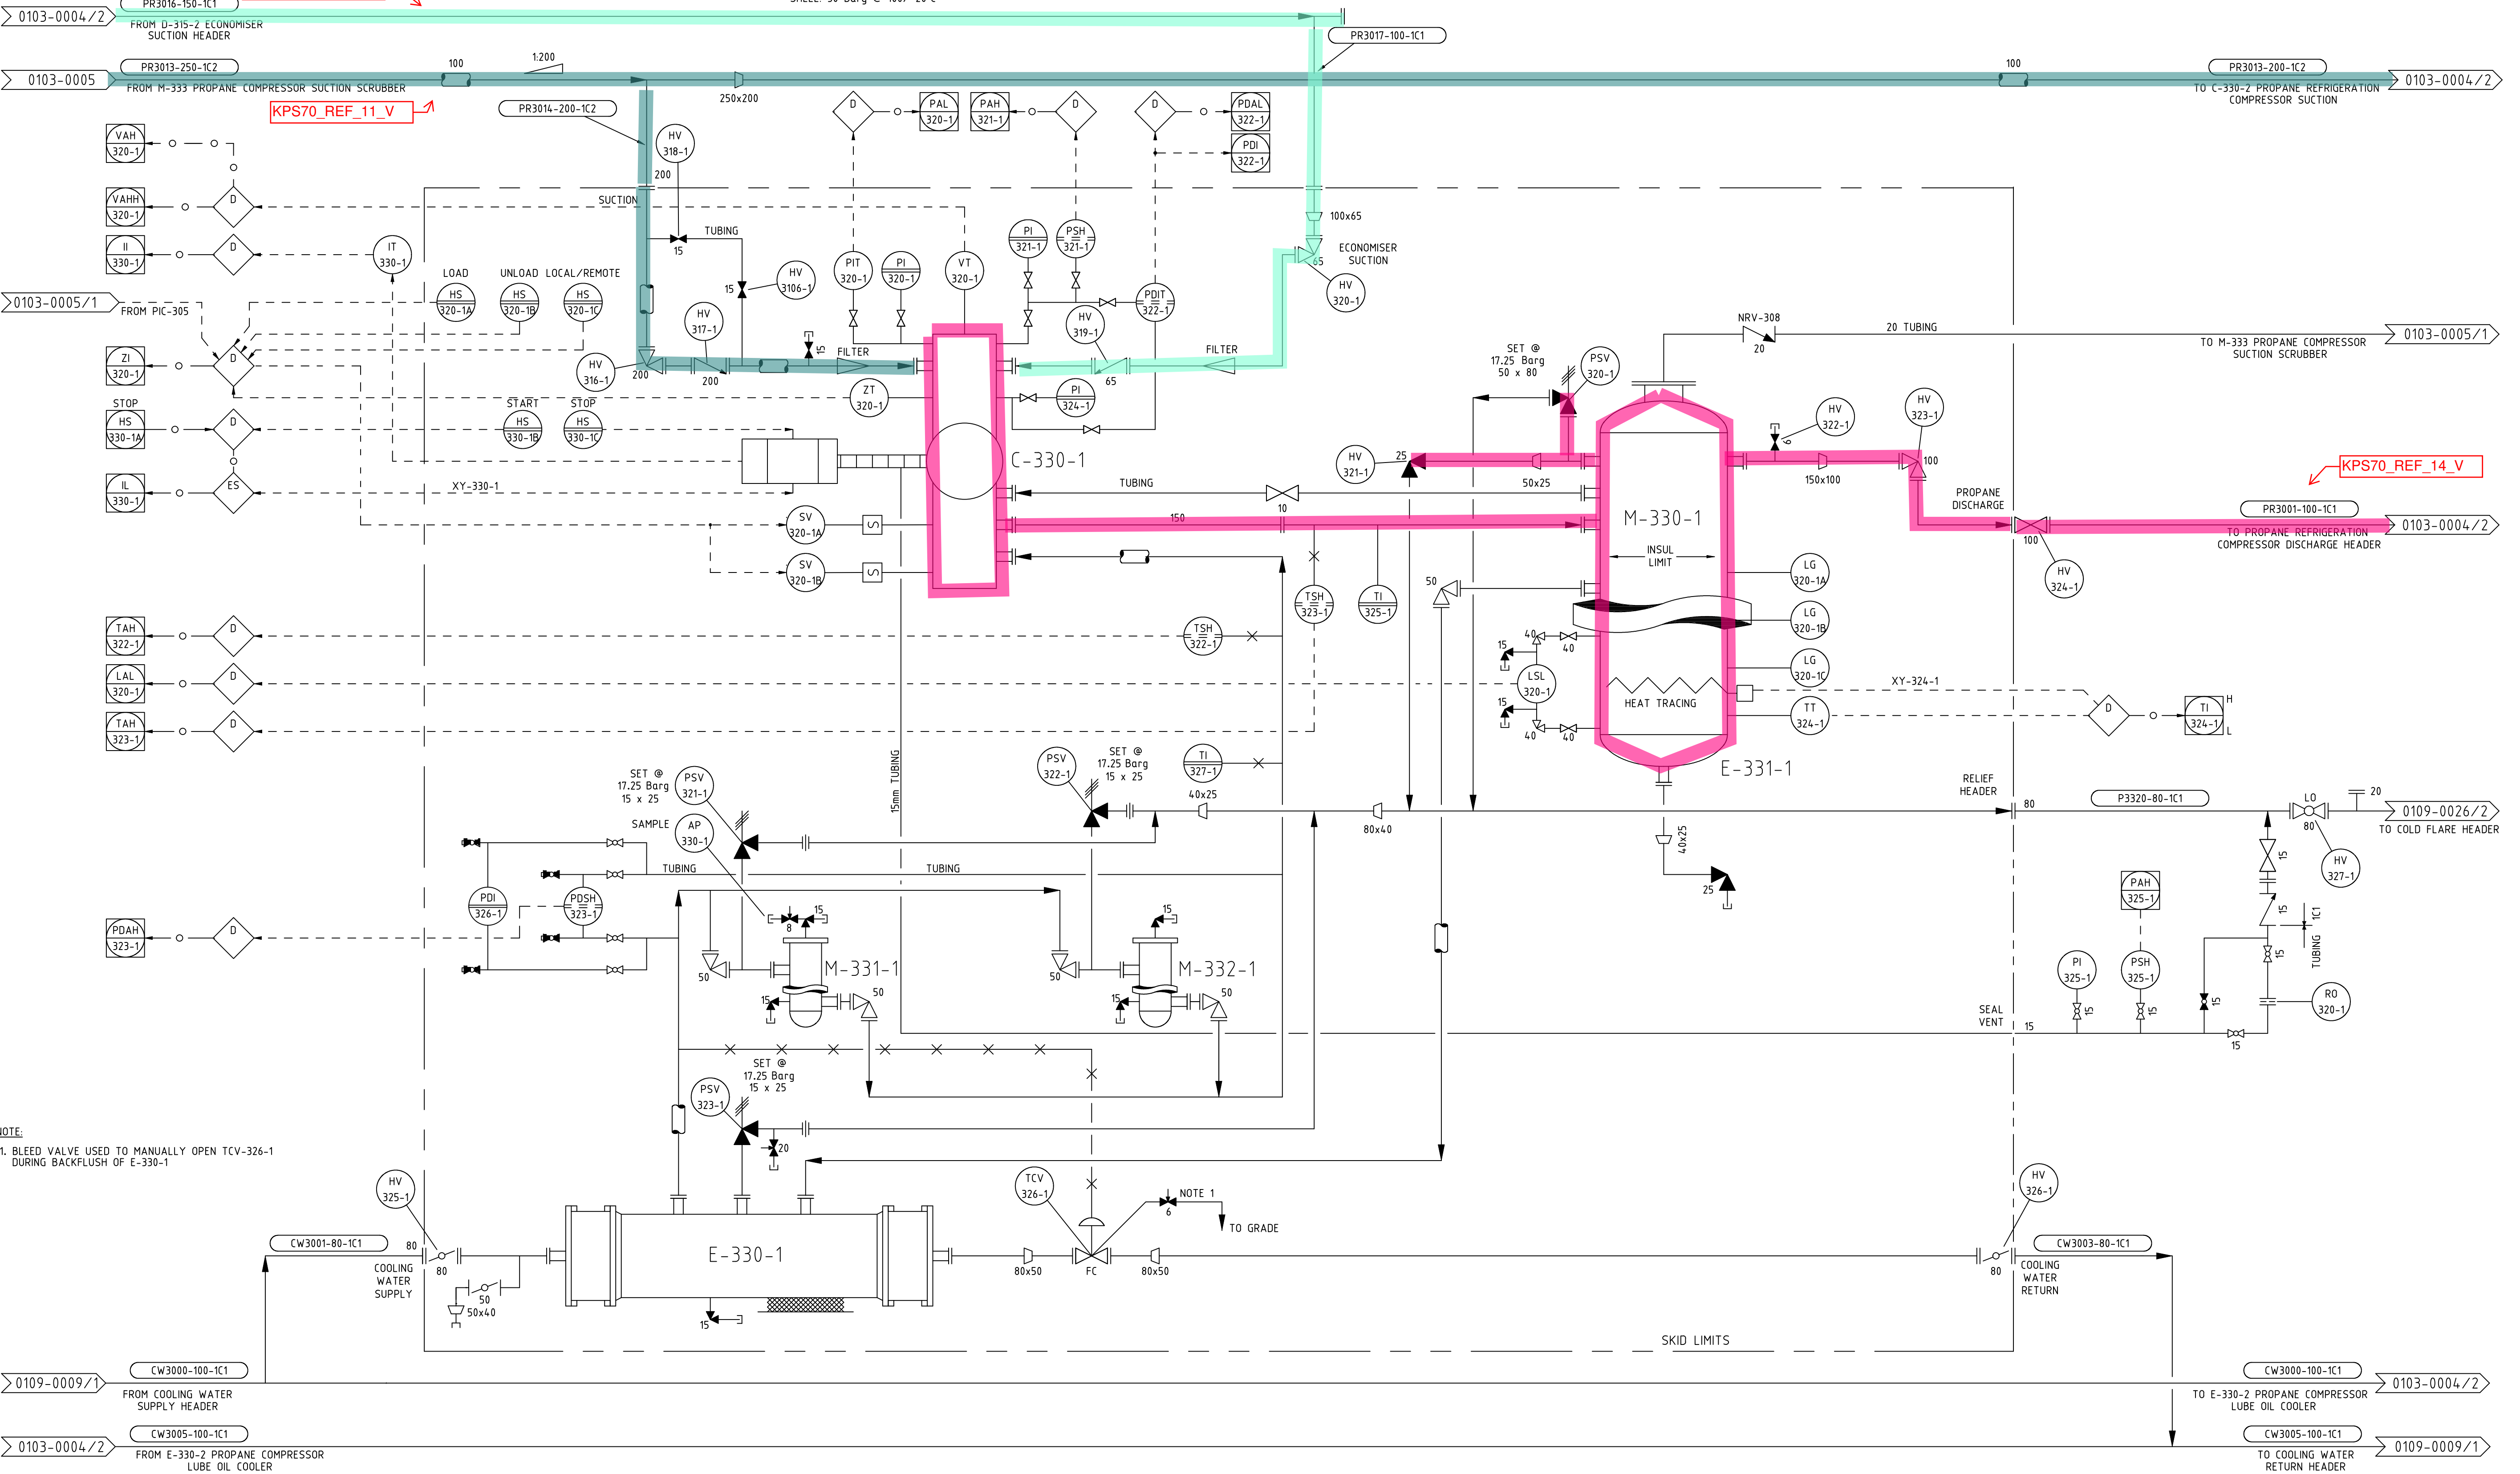

NOTE:
1. BLEED VALVE USED TO MANUALLY OPEN TCV-326-1 DURING BACKFLUSH OF E-330-1

REV	AMENDMENT	BY	CHK	ENG	APP	DATE	REV	AMENDMENT	BY	CHK	ENG	APP	DATE
17	20NB VENT ADDED TO LINE P3320-80-1C1	RL	JCC	AM	TC	07/2019	10	AS BUILT 15NB GATE VALVE ADDED TO TUBING BYPASS	RL	ES	LH	SES	08/2010
16	AS BUILT XT-001 REMOVED & VENT ADDED TO LINE P3320-80-1C1	RL	JCC	AM	TC	07/2019	9	AS BUILT WS2007279 PROPANE AVOIDABLE LOSSES	RL	MB	LH	SES	02/2010
15	AS BUILT P84-1242 PROPANE REFRIG. IMPROVEMENTS	PM	JT	AM	SES	10/15	8	AS BUILT WS1415208 LPG ENHANCEMENTS	AJW	TC	LH	SES	07/2008
14	NRV No's ADDED & HAND VALVE No's ADDED FOR ISOLATIONS	RL	JC	AM	SES	05/2015	7	AS BUILT WS1292113 OIL COOLER BACKFLUSH & WS1281537	ES	GS	LH	SES	02/08
13	AS BUILT P84-1091 ENHANCED LPG RECOVERY	JT	JC	AM	SES	08/2014	6	AS BUILT WS1266290 C-330-1/2 PRESS. SWITCH TO TRANS	KN	LH	KC	PJR	11/07
12	HAND VALVE NUMBER ADDED FOR ISOLATIONS	RL	CR	AM	SES	03/2014	5	AS BUILT WS1131635 LT SEP UNDER TEMP PROTECTION	VB	LH	MP	PJR	07/07
11	AS BUILT P84-1041 FLARE GAS MEASUREMENT	ES/RL	TC	AM	SES	09/12	4	DESIGN DATA RATIONALISED E-330-1 & M-330-1	CMW	RL	AvG	AIM	08/02
							3	HEAT TRACING NOTE ADDED. TSH/L 324-1 NOW TT-324-1	VB	RL	EJH	RJW	02/01
							2	REVISED FOR NEW PRINT. DRAWING CONTENT NOT CHANGED	VB	RL	EJH	RS	10/99
							1	AS BUILT & SITE CHECKED FOR REFURBISHMENT PROJECT	V.B.	G.R.	K.E.	G.M.	02/98

VECTOR KAPUNI LIMITED
PRIVATE BAG 2020
NEW PLYMOUTH 4342
PHONE 0800 734 567

REFERENCE DRAWINGS
C7182-01 - ABB P&ID
0780-0080-01 LPG CAUSE & EFFECT

SCALE: NTS
JOB NO. 1000000
SERIES 0103
DRG. NO 0004
SHT 01 OF 02 SHTS
REVISION 17

DATE: 25/03/1996
APP: G.MUIR
DATE: 25/03/1996

DATE: 25/03/1996
APP: K.E. EDEN
DATE: 25/03/1996

DRN: J.WELLS
CHK: T.LIM

ORIGINAL SHEET SIZE A1

COPYRIGHT The copyright in this document is vested in Vector Kapuni Limited. The contents of this document shall not be reproduced, either in whole or part, by any means whatsoever without the prior written consent of Vector Kapuni Limited.

EQUIPMENT No.

DESCRIPTION
CAPACITY
MAWP @ TEMP

E-330-2
OIL COOLER
HEAT LOAD 128kW CAPACITY 0.044m³
TUBE: 12 Barg @ 100/-20°C
SHELL: 30 Barg @ 100/-20°C


M-331-2
OIL FILTER
CAPACITY 0.0134m³
MAWP 42 Barg @ 0°C TO 120°C

M-332-2
OIL FILTER
CAPACITY 0.0134m³
MAWP 42 Barg @ 0°C TO 120°C

C-330-2
COMPRESSOR
-34°C 1.21/14.5 Barg CAPACITY 619 kW SHAFTPOWER 441 kWe
-27.7°C 1.52/14.5 Barg CAPACITY 778 kW SHAFTPOWER 462 kWe

M-330-2
OIL SEPARATOR
CAPACITY 1.54m³
MAWP 20.68 Barg @ 100/-44°C

E-331-2
OIL HEATER
HEAT LOAD 0.6kW

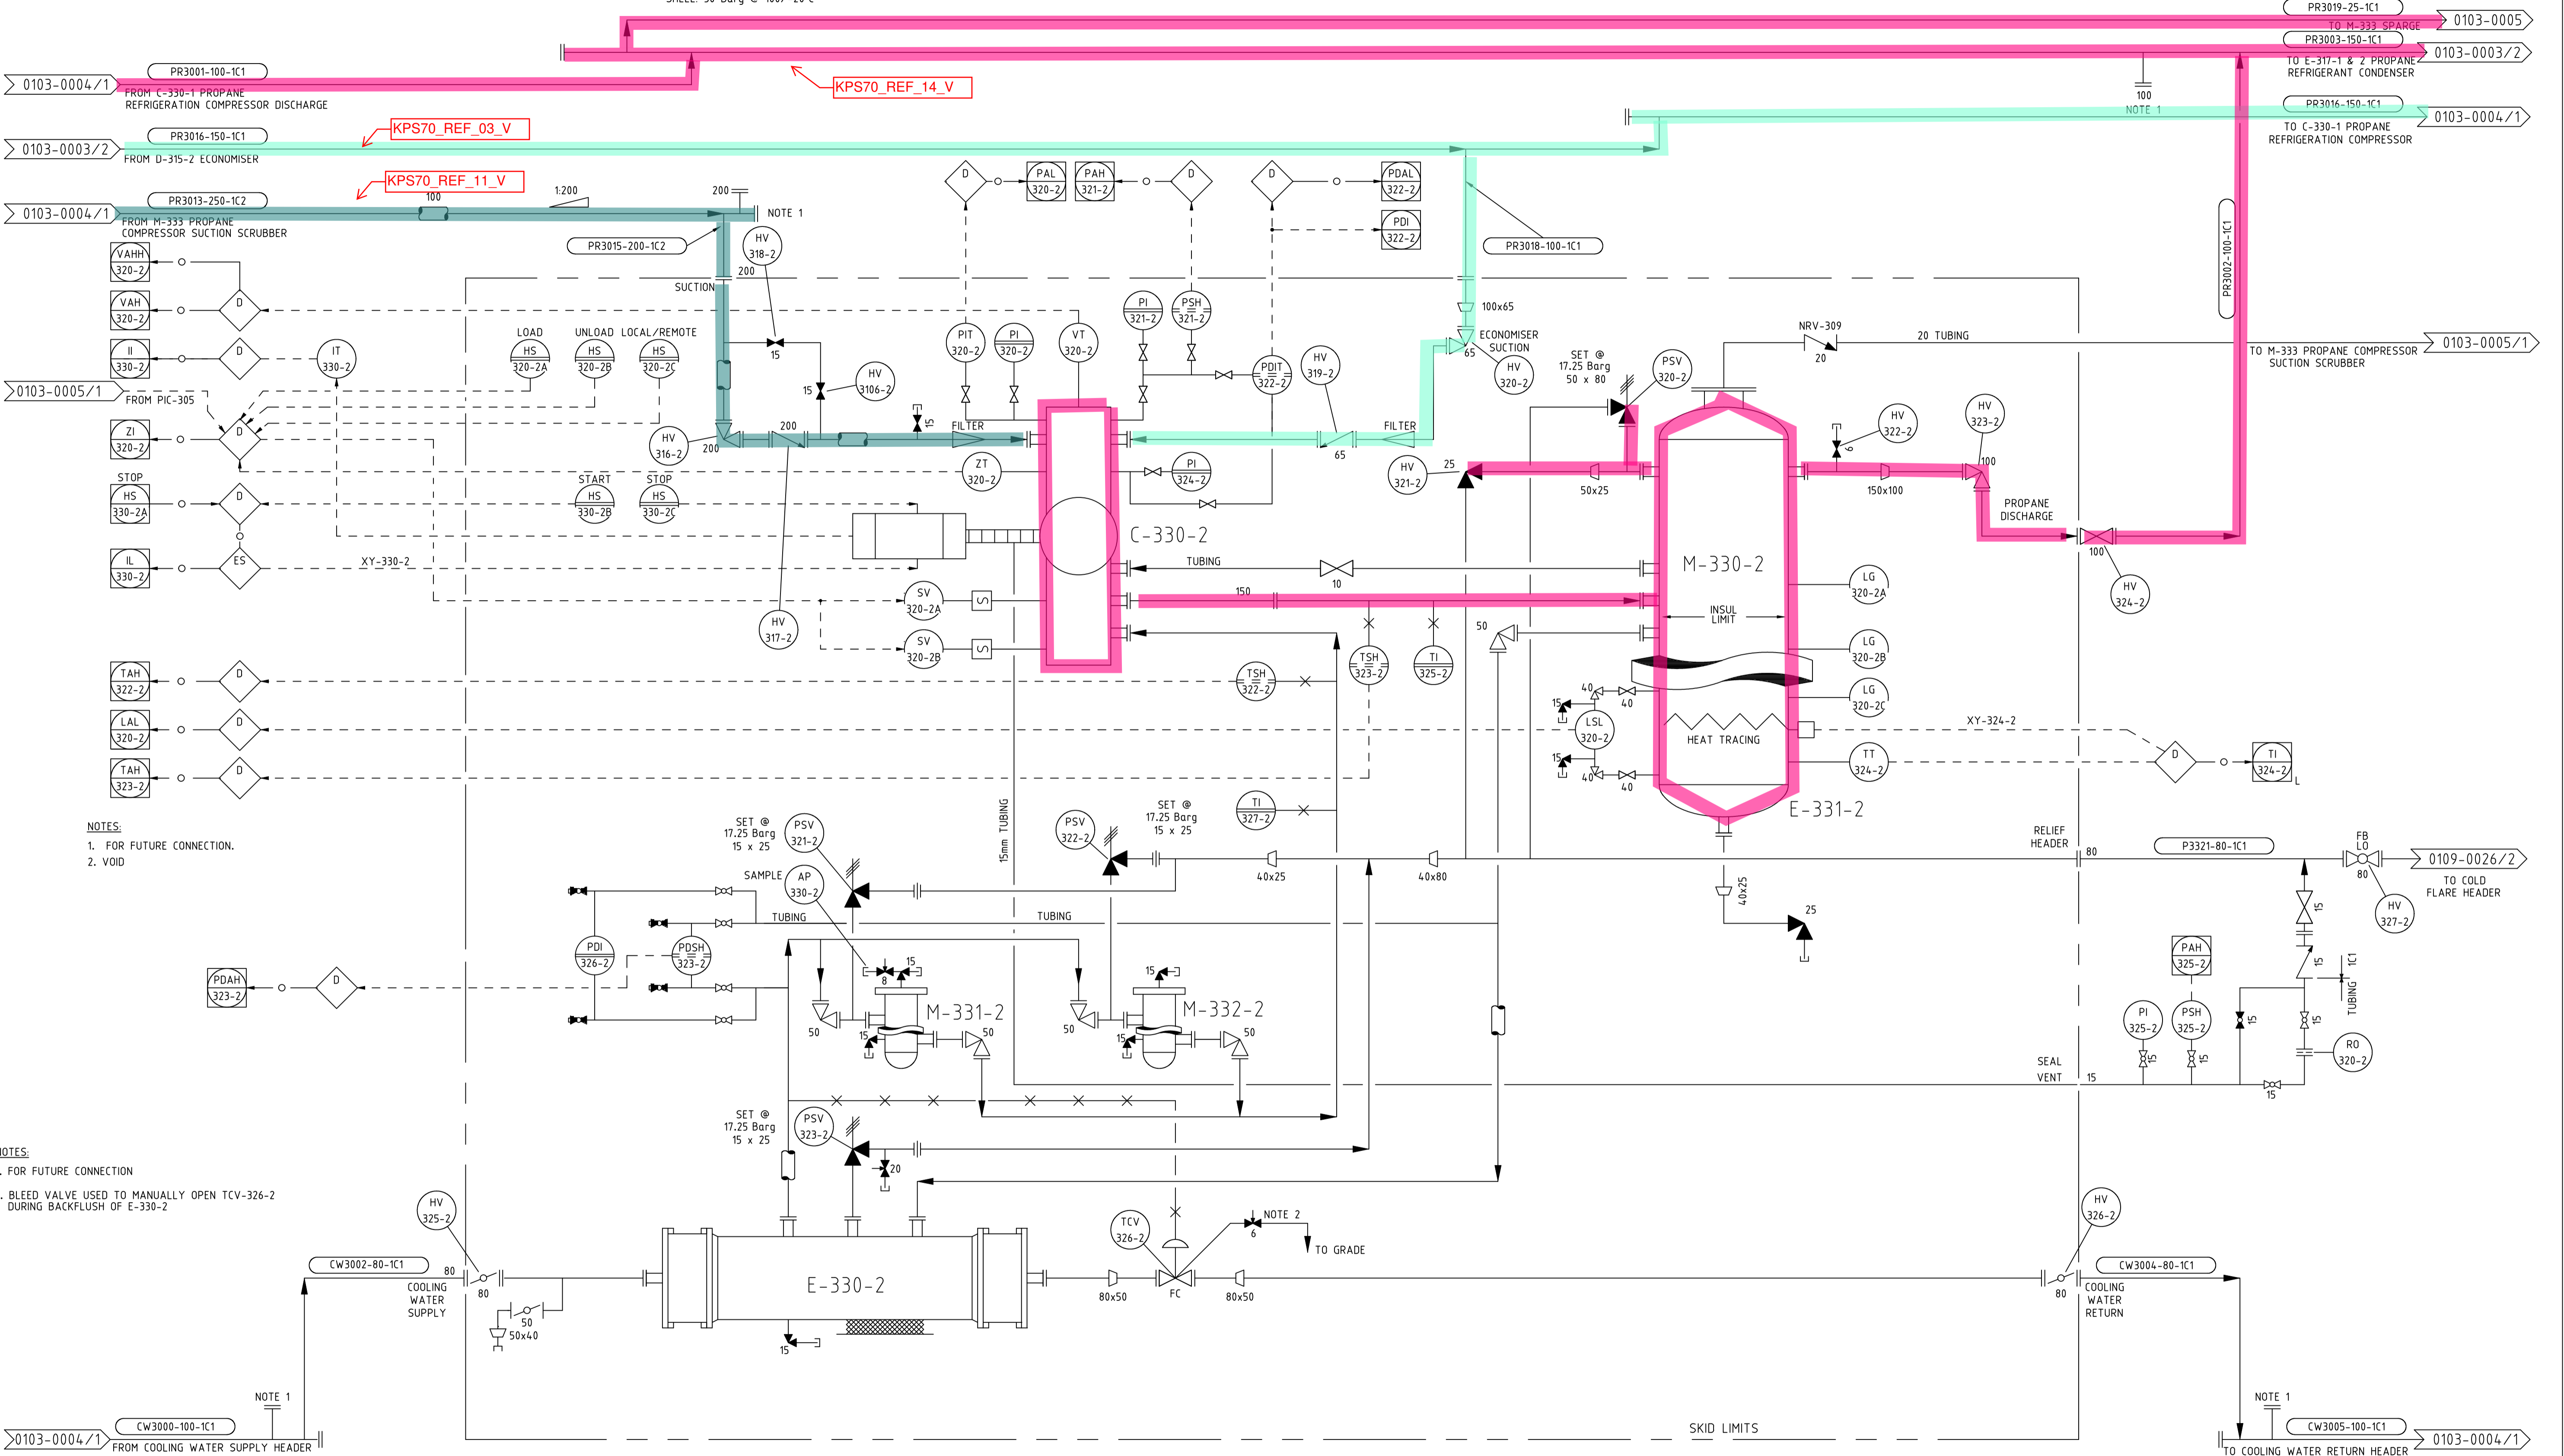

NOTES:
1. FOR FUTURE CONNECTION.
2. VOID

NOTES:
1. FOR FUTURE CONNECTION
2. BLEED VALVE USED TO MANUALLY OPEN TCV-326-2 DURING BACKFLUSH OF E-330-2

NOTE 1
FROM COOLING WATER SUPPLY HEADER

NOTE 1
TO COOLING WATER RETURN HEADER

REV	AMENDMENT	BY	CHK	ENG	APP	DATE	REV	AMENDMENT	BY	CHK	ENG	APP	DATE
10	AS BUILT 15NB GATE VALVE ADDED TO TUBING BYPASS	RL	ES	LH	SES	08/2010							
9	AS BUILT WS2007279 PROPANE AVOIDABLE LOSSES	RL	MB	LH	SES	02/2010							
8	AS BUILT WS1415208 LPG ENHANCEMENTS	AJW	TC	LH	SES	07/08							
7	AS BUILT WS1292113 OIL COOLER BACKFLUSH & WS1281537	ES	GS	LH	SES	02/08							
6	AS BUILT WS1266290 C-330-1/2 PRESS. SWITCH TO TRANS	KN	LH	KC	PJR	11/07							
5	AS BUILT WS1131635 LT SEP UNDER TEMP PROTECTION	VB	LH	MP	PJR	07/07							
14	AS BUILT P84-1242 PROPANE REFRIG. IMPROVEMENTS	PM	JT	AM	SES	10/15							
13	NRV No's & HAND VALVE No's ADDED FOR ISOLATIONS	RL	JC	AM	SES	05/2015							
12	HAND VALVE NUMBERS ADDED FOR ISOLATIONS	RL	CR	AM	SES	10/2013							
11	AS BUILT P84-1041 FLARE GAS MEASUREMENT	ES/RL	TC	AM	SES	09/12							

VECTOR KAPUNI LIMITED
PRIVATE BAG 2020
NEW PLYMOUTH 4342
PHONE 0800 734 567



COPYRIGHT The copyright in this document is vested in Vector Kapuni Limited
The contents of this document shall not be reproduced, either in whole or part, by any
means whatsoever without the prior written consent of Vector Kapuni Limited.

REFERENCE DRAWINGS
C7182-01 - ABB P&ID
0780-0080-01 LPG CAUSE & EFFECT


REFRIGERATION SYSTEM
PIPING & INSTRUMENT DIAGRAM
PROPANE COMPRESSOR NO. 2

DRN	J.WELLS	25/03/1996	ENG	K.EDEN	25/03/1996
CHK	T.LIM	25/03/1996	APP	G.MUIR	25/03/1996

SCALE:	JOB NO.	SERIES	DRG. NO	SHT	REVISION
NTS	1000000	0103	0004	02 OF 02 SHTS	15

EQUIPMENT No.
DESCRIPTION
CAPACITY
MAWP @ TEMP

M-333
PROPANE COMPRESSOR SUCTION SCRUBBER
1090 Ø x 2150
MAWP 17.25BarG @ +60°C TO -44°C

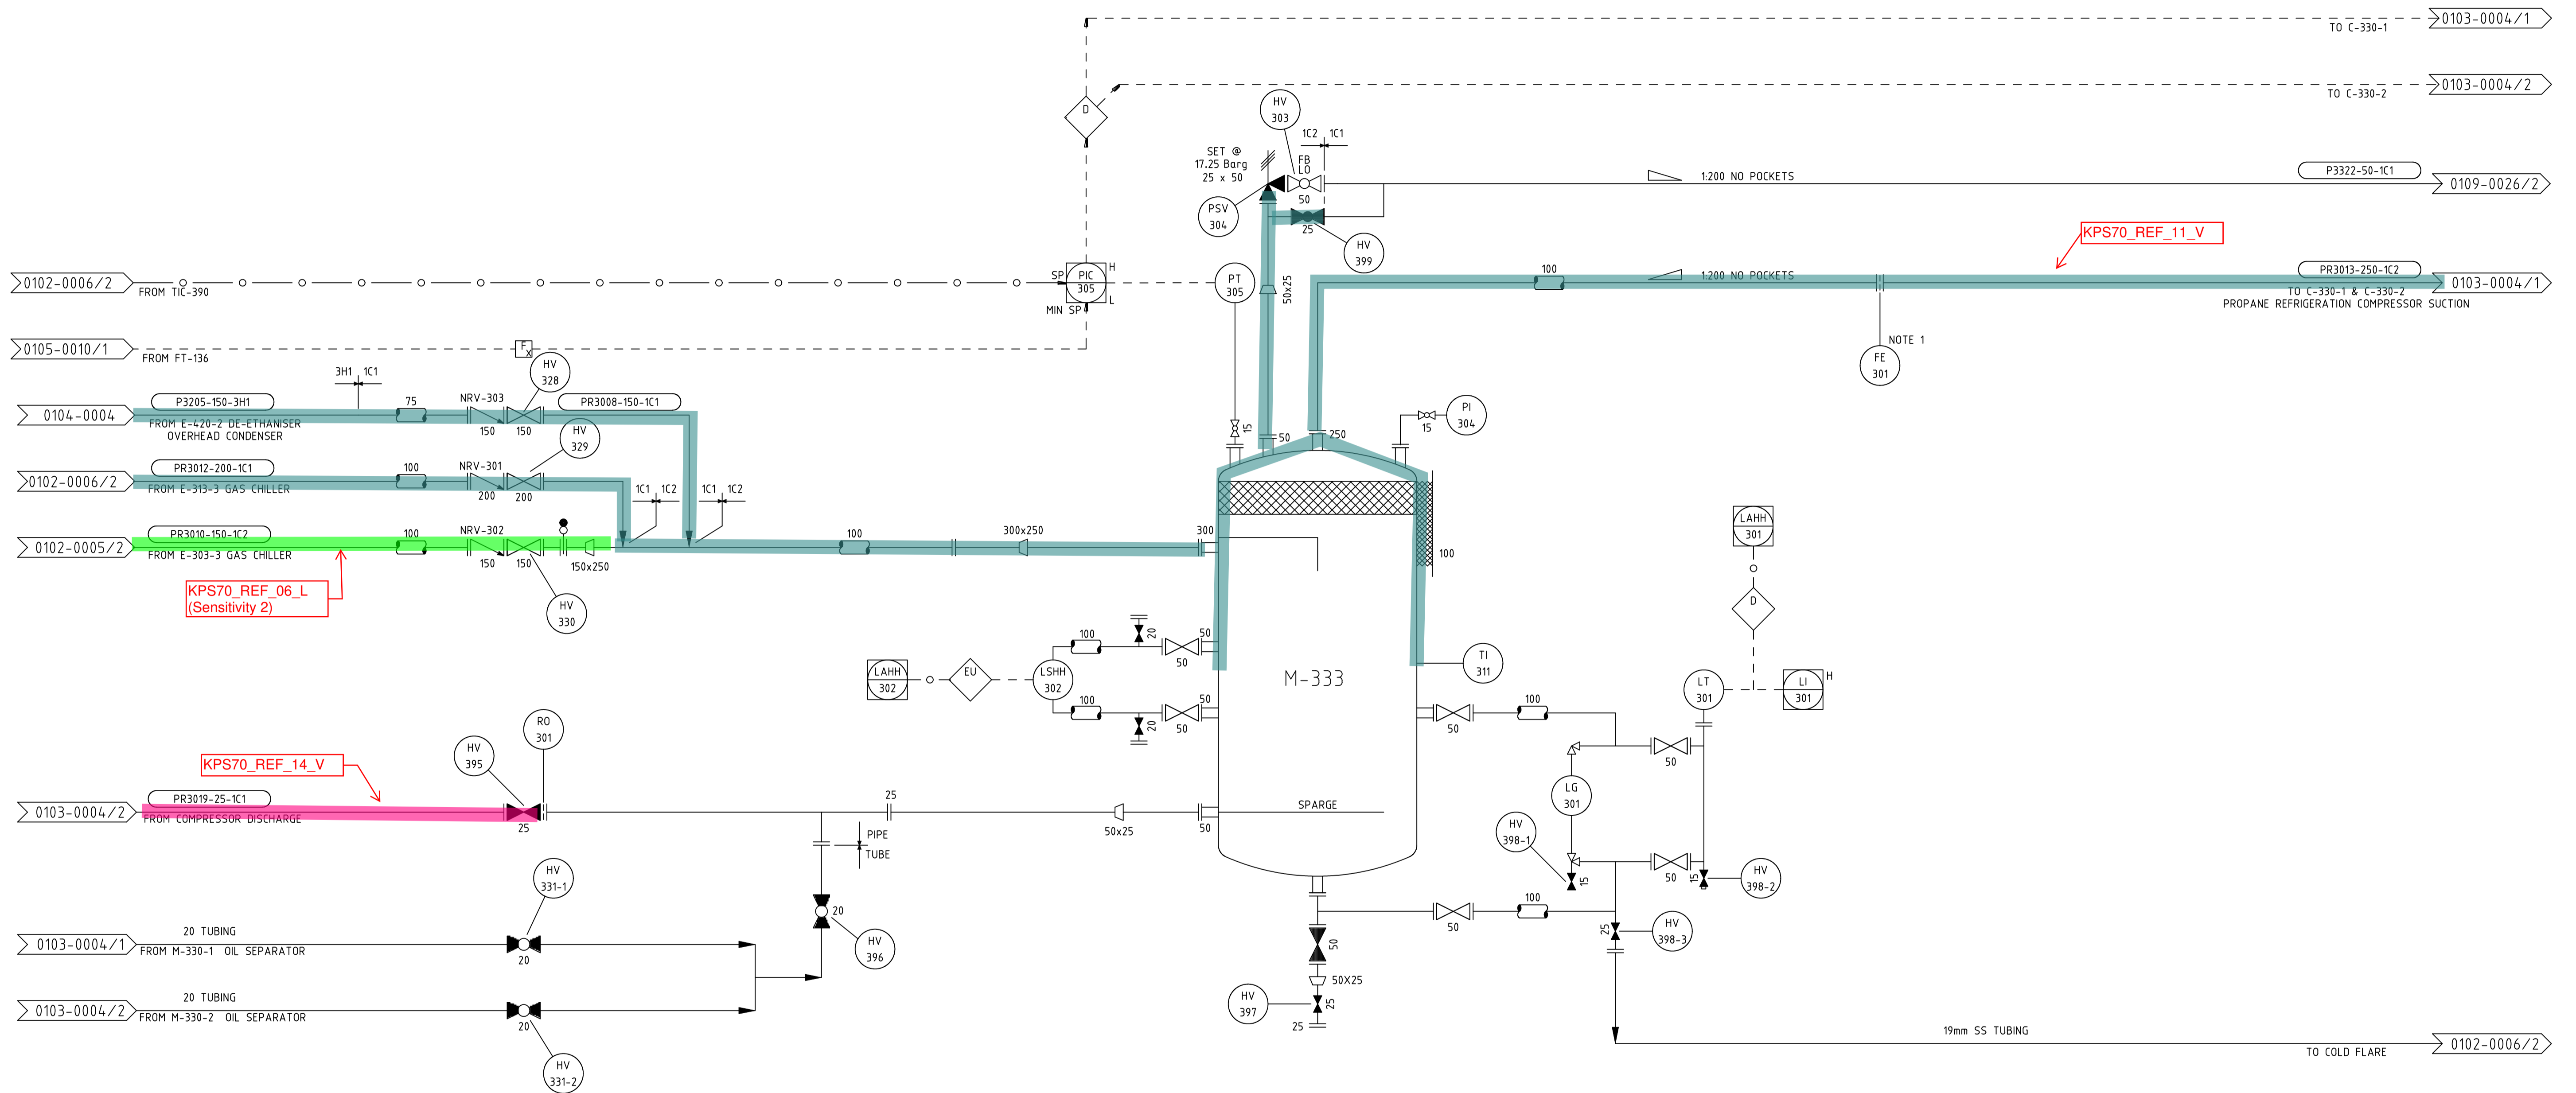

NOTES:
1. FLOW ELEMENT REPLACED WITH A FULL BORE ORIFICE.

REV	AMENDMENT	BY	CHK	ENG	APP	DATE	REV	AMENDMENT	BY	CHK	ENG	APP	DATE
10	LEVEL BRIDLE LT-301, NRV, HV NUMBERS ADDED	JCC	RL/CB	AM	SES	04/2015							
9	HAND VALVE NUMBERS ADDED FOR ISOLATIONS	RL	CR	AM	SES	10/2013							
8	M-333 LEVEL BRIDLE AND DRAIN AS BUILT	RL	MB	LH	SES	02/2011							
7	AS BUILT WS955915 PERMANENT DRAIN FROM M-333	RL	MB	LH	SES	03/2010							
6	AS BUILT WS2007279 PROPANE AVOIDABLE LOSSES	RL	MB	LH	SES	02/2010							
5	AS BUILT REDUCER CHANGED	ES	RL	LH	SES	10/09							
4	AS BUILT WS1131635 LT SEP UNDER TEMP PROTECTION	VB	LH	MP	PJR	07/07							
3	PROCESS ISOLATION POINTS ADDED ON INDIVIDUAL LAYERS	CMW	RL	CM	AIM	10/02							
12	AS BUILT M-333 LEVEL HIGH HIGH	JCC	RL/AQ	AM	SES	06/2016							
11	AS BUILT P84-1242 PROPANE REFRIG. IMPROVEMENTS	PH	JT	AM	SES	10/2015							
1	AS BUILT FOR REFURBISHMENT PROJECT	V.B.	G.R.	K.E.	G.M.	02/98							

VECTOR KAPUNI LIMITED
PRIVATE BAG 2020
NEW PLYMOUTH 4342
PHONE 0800 734 567

COPYRIGHT The copyright in this document is vested in Vector Kapuni Limited
The contents of this document shall not be reproduced, either in whole or part, by any
means whatsoever without the prior written consent of Vector Kapuni Limited.


REFERENCE DRAWINGS		DATE	DATE
DRN	J.WELLS	27/03/1996	26/03/1996
CHK	T.LIM	26/03/1996	26/03/1996

REFRIGERATION SYSTEM PIPING & INSTRUMENT DIAGRAM PROPANE COMPRESSOR SEPARATORS					
SCALE:	JOB NO.	SERIES	DRG. NO	SHT 01 OF SHTS	REVISION
NTS	1000000	0103	0005	01	13

EQUIPMENT No.

DESCRIPTION
CAPACITY
MAWP @ TEMP

F-420-3
DE-PROPANISERS FEED SURGE DRUM
1.5 m³
68.95 Barg @ XX°C

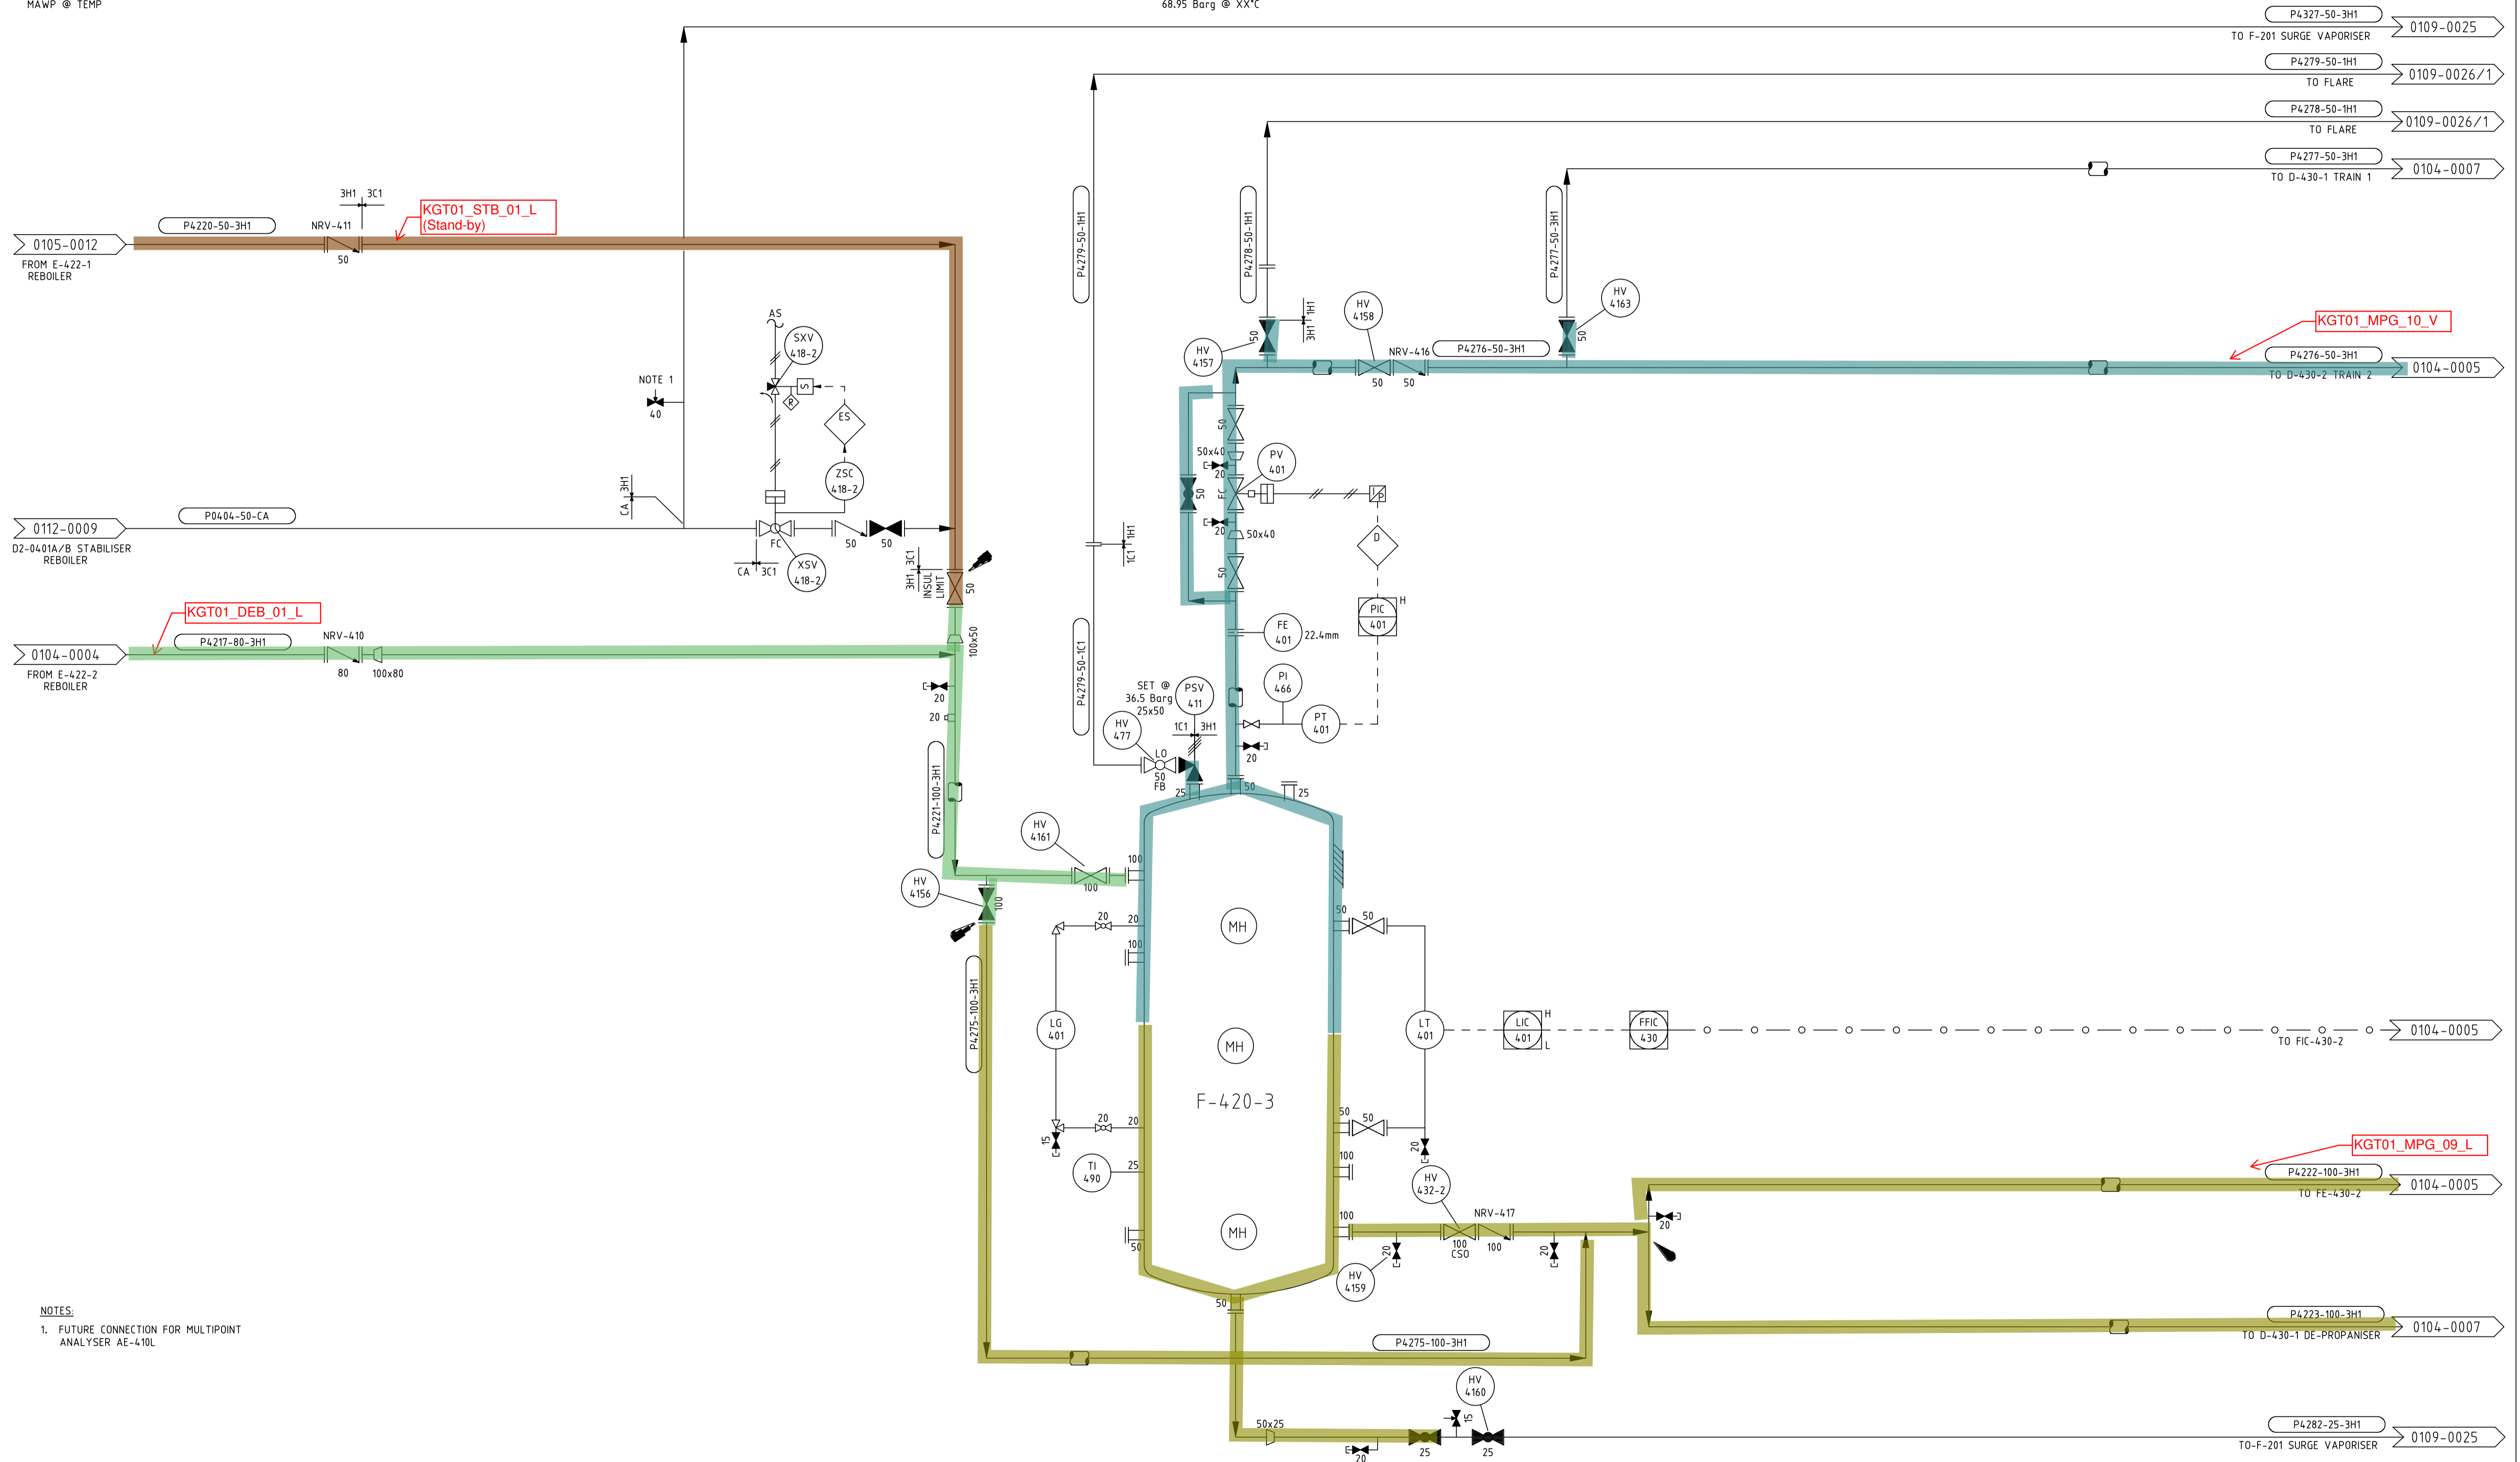

NOTES:
1. FUTURE CONNECTION FOR MULTIPPOINT ANALYSER AE-410L

REV	AMENDMENT	BY	CHK	ENG	APP	DATE	REV	AMENDMENT	BY	CHK	ENG	APP	DATE
6	AS BUILT P84-1438 LPG HAZOP COMMENTS	RL	JCC	AM	TC	11/2019							
5	AS BUILT CSO REMOVED FROM VALVE XSV-418-2	RL	JCC	AM	TC	07/2019							
4	AS BUILT P84-1142 DEPROPANISER TRIPS	JCC	RL/AB	AM	SES	07/2016							
3	HAND VALVE No's ADDED FOR ISOLATIONS	RL	JCC	AM	SES	10/2015							
2	HAND VALVE No's ADDED FOR ISOLATIONS. NRV No's ADDED	RL	JC	AM	SES	03/2015							
1	P&ID SPLIT PROJECT. CONTENTS MOVED FROM 0104-0005/01	RL	JC	AM	SES	12/2014							

VECTOR KAPUNI LIMITED
PRIVATE BAG 2020
NEW PLYMOUTH 4342
PHONE 0800 734 567



COPYRIGHT The copyright in this document is vested in Vector Kapuni Limited
The contents of this document shall not be reproduced, either in whole or part, by any
means whatsoever without the prior written consent of Vector Kapuni Limited.


REFERENCE DRAWINGS

0780-0082/06 EDP CAUSE AND EFFECTS
0780-0080 CAUSE AND EFFECTS

DRN	R	LOCHHEAD	DATE	ENG	A	MANN	DATE
CHK	J	CERDA	01/12/2014	APP	S	SMITH	01/12/2014

LPG PRODUCTION FACILITY
PIPING & INSTRUMENT DIAGRAM
DE-PROPANISER FEED SURGE DRUM

SCALE:	JOB NO.	SERIES	DRG. NO	SHT	REVISION
NONE	1000000	0104	0003	01 OF 01 SHTS	6

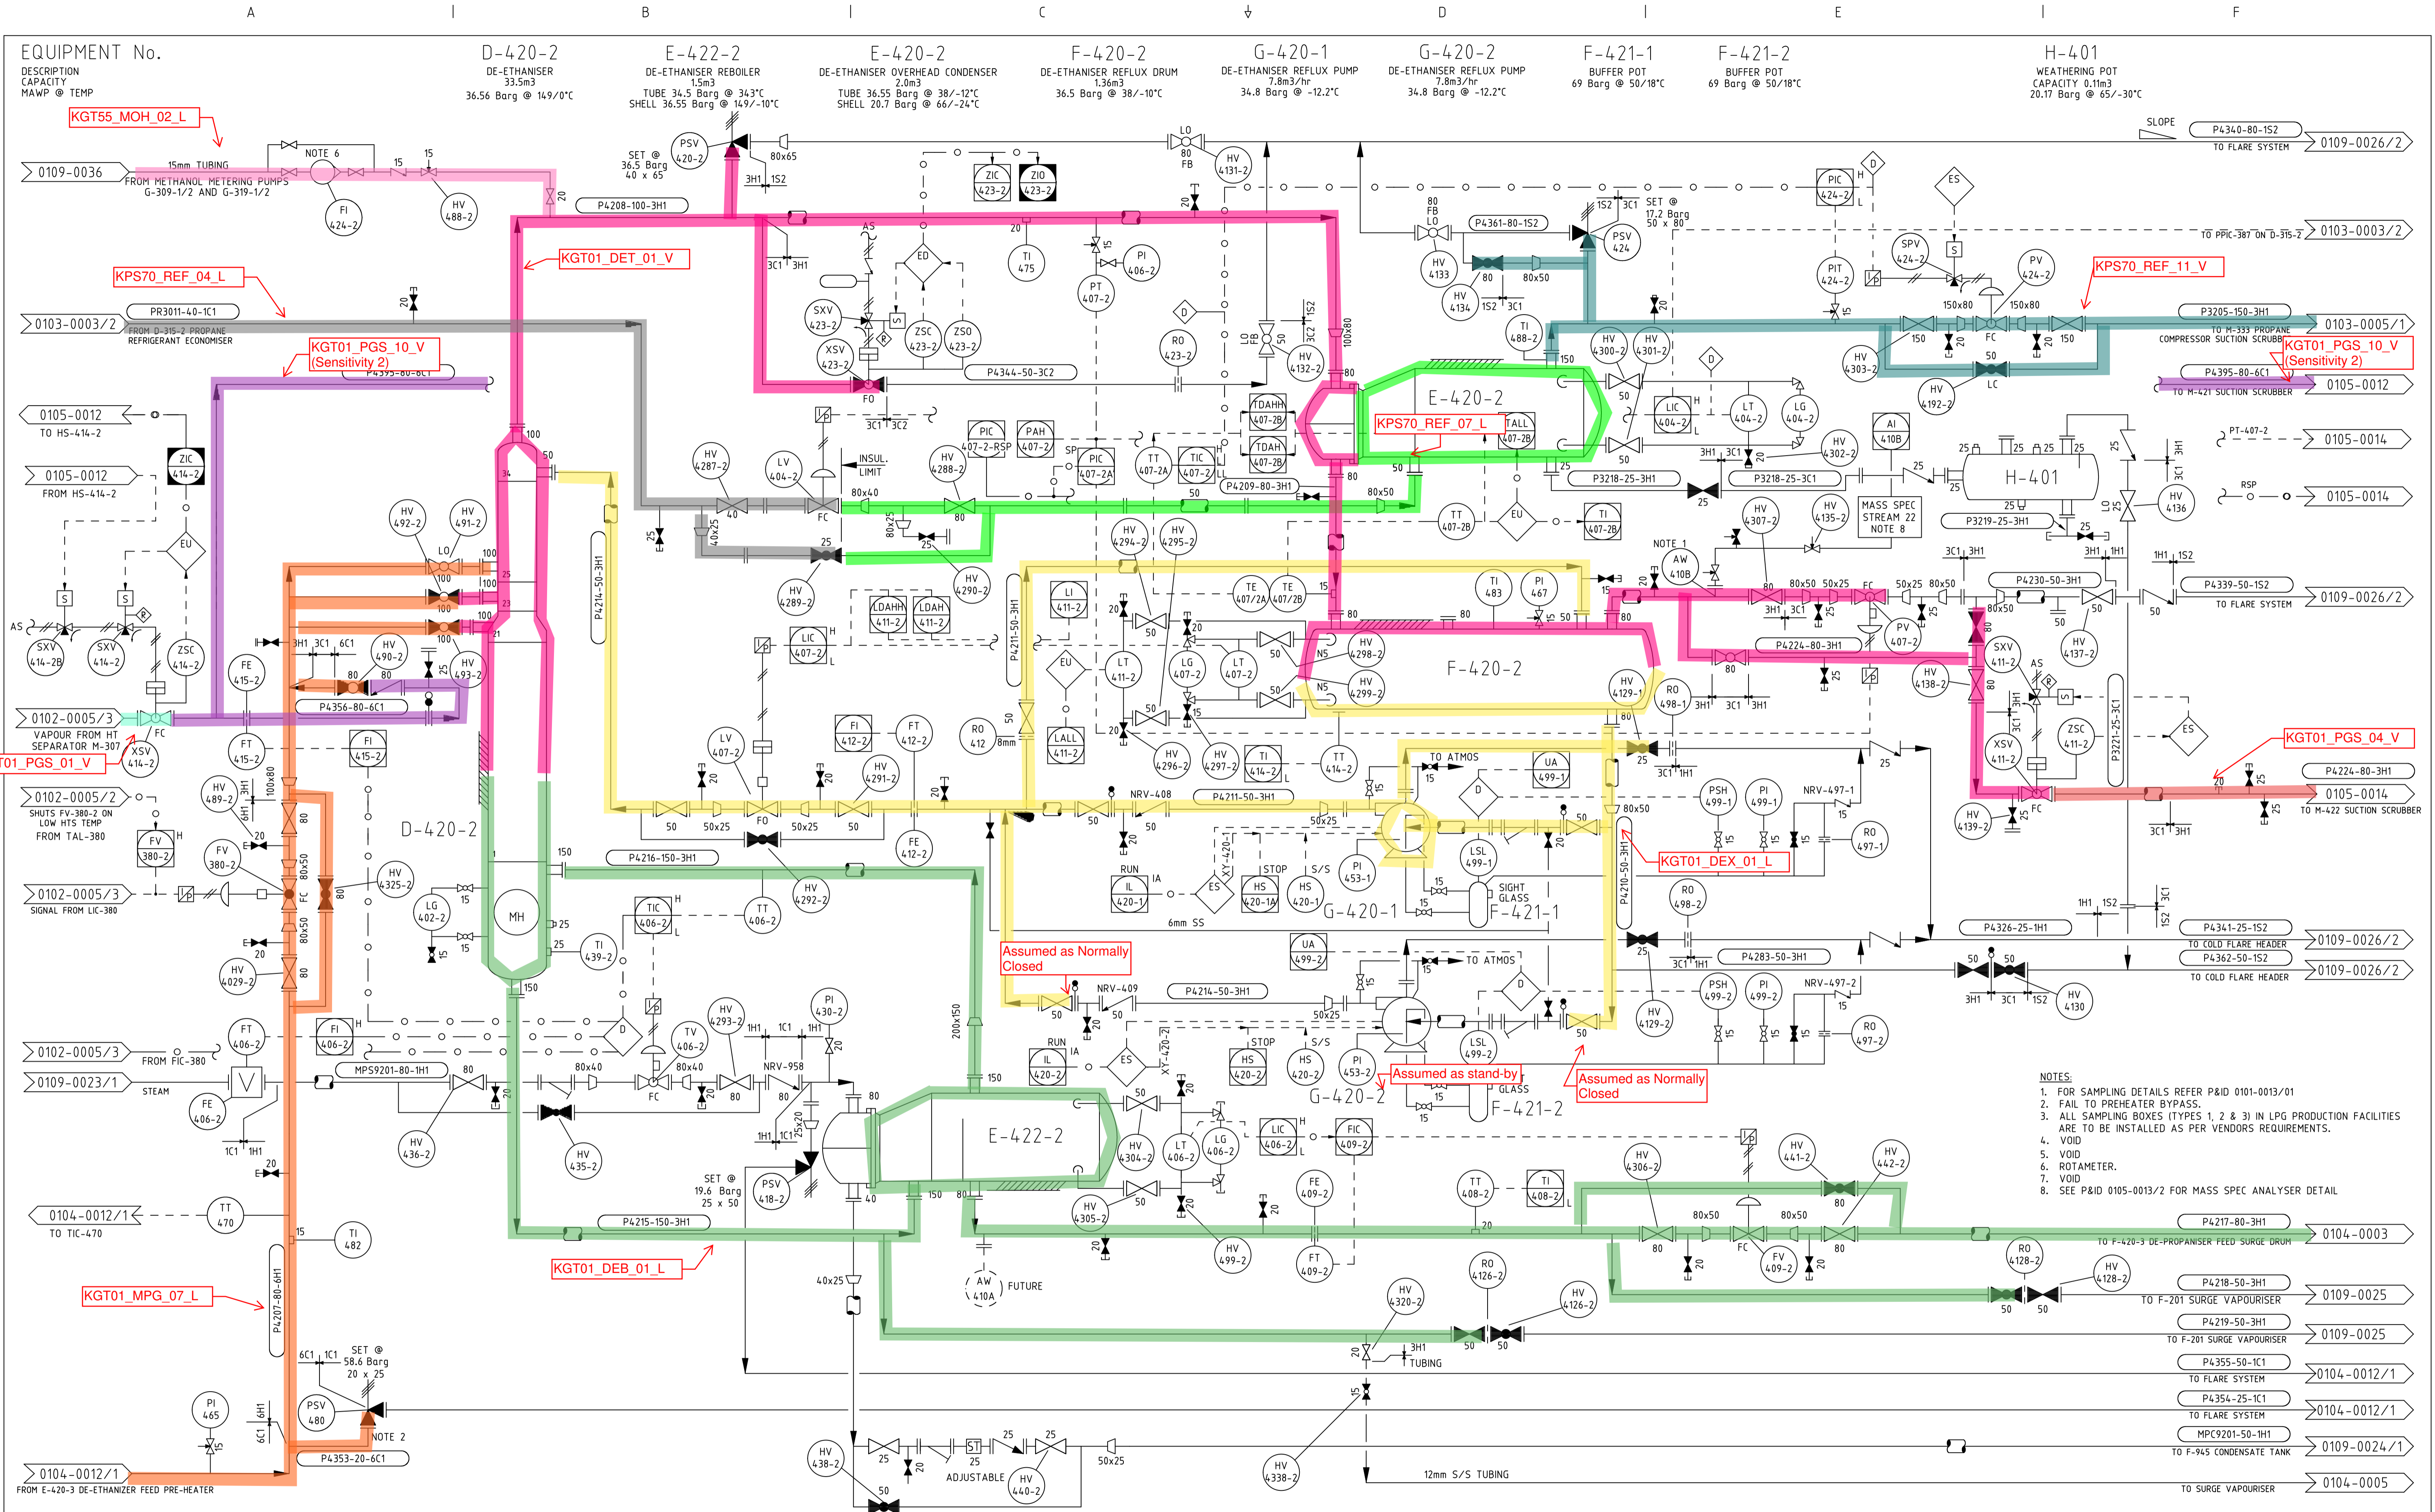

NO.	DESCRIPTION	REV	DATE	BY	CHK	ENG	APP	DATE	REV	DESCRIPTION	REV	DATE	BY	CHK	ENG	APP	DATE
53	AS BUILT P84-1399 DE-ETH. DE-PROP DEWATERING	RL	JCC	AM	MM	05/2018	44	HAND VALVE No's REVISED FOR "-2 ETC" WHERE APPLICABLE	RL	JCC	AM	09/2014					
52	AS BUILT RE P84-1399, LOCKED VALVES & XT-003 DELETED	RL	NM	AM	SES	05/2017	43	HAND VALVE No's ADDED FOR ISOLATIONS & AS BUILT MODS	RL	JCC	AM	09/2014					
51	HAND VALVE No's ADDED FOR ISOLATIONS	RL	JCC	AM	SES	01/2017	42	AS BUILT P84-3257 200T INLET BACK PRESSURE CONTROL	LN	JC	AM	05/2014					
50	P&ID SPLIT MOVED TO 0104-0012/1, HV & NRV NUMBERS ADDED	JCC	RL/NM	AM	SES	01/2016	41	AS BUILT P84-1131 HTS VAPOUR RECYCLE 3 TRAIN OP	ES/RL	AAB	AM	10/12					
49	AS BUILT P84-1089 NATURAL GASOLINE & COALESCER SAMPLE POINTS	CJ	JT	AM	SES	10/2015	40	AS BUILT P84-1041 FLARE GAS MEASUREMENT	ES/RL	TC	AM	09/12					
48	AS BUILT P84-1242 PROPANE REFRIG. IMPROVEMENTS	CJ	JT	AM	SES	10/2015	39	PARTIAL AS BUILT P84-1102 REPLACE LV 404-2	LN	GH	WB	02/2012					
47	AS BUILT P84-1143 DE-ETHANISER OH CONDENSER LOW TEMP, ETC.	WPG	SHA	AM	SES	08/2015											
46	AS BUILT P84-1219 F-201 OVERPRESSURE	LN	CJ	AM	SES	06/2015											
45	CONTIN. DRG. No's REVISED FOR P&ID SPLITTING PROJECT & AS BUILT FOR P&ID LOGIC	RL	JCC	AM	SES	12/2014											
	AMENDMENT	BY	CHK	ENG	APP	DATE	REV	AMENDMENT	BY	CHK	ENG	APP	DATE				

VECTOR KAPUNI LIMITED
 PRIVATE BAG 2020
 NEW PLYMOUTH 4342
 PHONE 0800 734 567

ssj^o

COPYRIGHT The copyright in this document is vested in Vector Kapuni Limited. The contents of this document shall not be reproduced, either in whole or part, by any means whatsoever without the prior written consent of Vector Kapuni Limited.

AUTOCAD ORIGINAL SHEET SIZE A1


REFERENCE DRAWINGS		DATE	DATE
DRN	P.RAWLES	01/04/1987	ENG
CHK	R.VanLUF	APP	R.VanLUF

LPG PRODUCTION FACILITY PIPING & INSTRUMENTATION DIAGRAM DE-ETHANISER					
SCALE:	JOB NO.	SERIES	DRG. NO	SHT 01 OF 01 SHTS	REVISION
NTS	1000000	0104	0004		54

EQUIPMENT No.

DESCRIPTION
CAPACITY
MAWP @ TEMP

D-430-2	E-430-2	E-430-2A	E-430-2B	E-432-2	G-430-3	G-430-4	F-430-2
DE-PROPANISER	DE-PROPANISER CONDENSER	DE-PROPANISER CONDENSER FAN	DE-PROPANISER CONDENSER FAN	DE-PROPANISER REBOILER	DE-PROPANISER REFLUX PUMP	DE-PROPANISER REFLUX PUMP	DE-PROPANISER REFLUX DRUM
20.9 m ³ 20 Barg @ 149/-29°C	0.57 m ³ 24.14 Barg @ 93/-4°C			1.5 m ³ TUBE: 34.5 Barg @ 343/XX°C SHELL: 24.13 Barg @ 149/-10°C	23 m ³ /hr 20 Barg @ 49°C	23 m ³ /hr 20 Barg @ 49°C	3.95 m ³ 24.13 Barg @ 79/-10°C

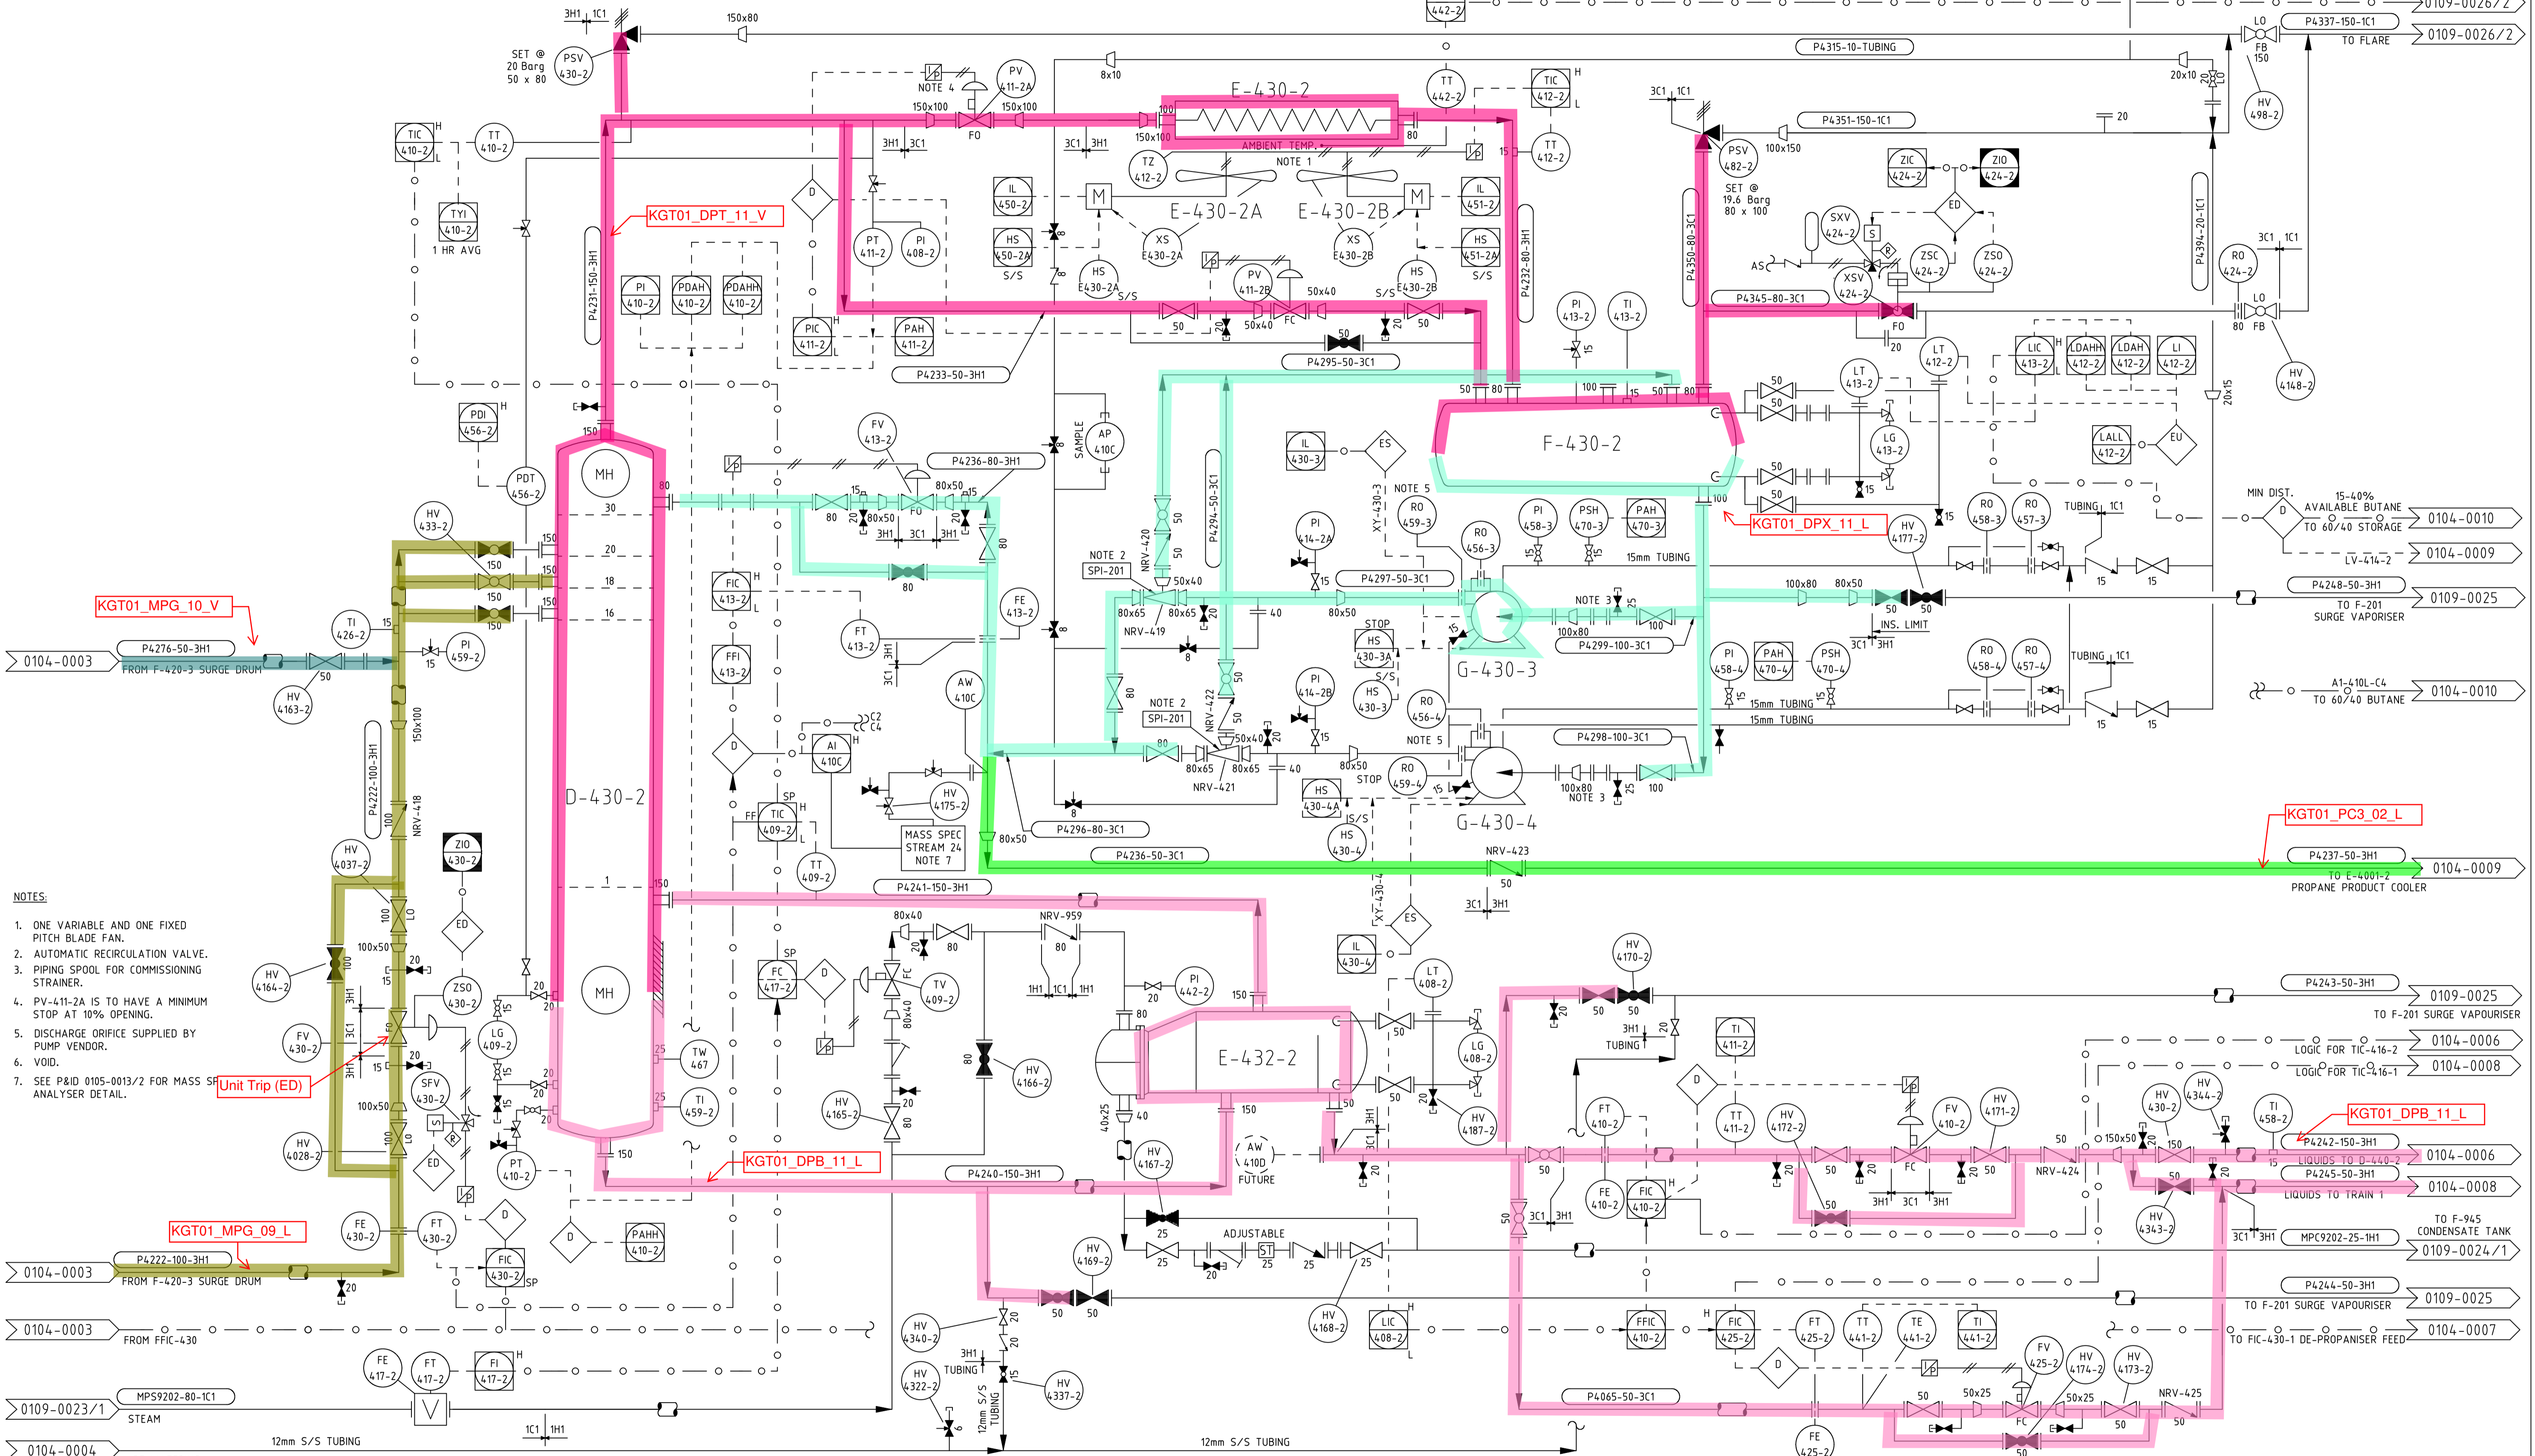

- NOTES:
- ONE VARIABLE AND ONE FIXED PITCH BLADE FAN.
 - AUTOMATIC RECIRCULATION VALVE.
 - PIPING SPOOL FOR COMMISSIONING STRAINER.
 - PV-411-2A IS TO HAVE A MINIMUM STOP AT 10% OPENING.
 - DISCHARGE ORIFICE SUPPLIED BY PUMP VENDOR.
 - VOID.
 - SEE P&ID 0105-0013/2 FOR MASS SP ANALYSER DETAIL.

REV	AMENDMENT	BY	CHK	ENG	APP	DATE	REV	AMENDMENT	BY	CHK	ENG	APP	DATE
29	AS BUILT P84-1101 TEMP INDIC FLAME LINE EXIT LPG	ES/RL	AAB	LH	SES	08/10/39	39	AS BUILT P84-1399 DE-ETH, DE-PROP DEWATERING	RL	JC/CC	AM	MM	05/2018
28	AS BUILT WITH COMMENTS FROM LINE LIST	RL	ES	LH	SES	08/10/38	38	AS BUILT P84-1399 HV-433-2 CONFIG & VENT ADDED P4351	RL	JCC	AM	SES	05/2017
27	AS BUILT PER INCIDENT No. 510811	ES	AAB	LH	SES	05/10/37	37	AS BUILT SCR-631 DE-BUTANISER TRIPS	JCC	RL/AB	AC	SES	07/2016
26	AS BUILT P84-3007 ESD LEVEL TRANS DEVIATION ALARMS	ES	AW	LH	SES	03/10/36	36	AS BUILT - P84-1148 ADDED PT-410-2	JCC	RL/AB	AM	SES	01/2016
							35	HAND VALVE NUMBERS ADDED FOR ISOLATIONS	RL	JC	AM	SES	11/2015
							34	AS BUILT P84-1089 NATURAL GASOLINE & COALESER SAMPLE POINTS	CJ	JT	AM	SES	10/2015
43	HAND VALVE No's ADDED FOR ISOLATIONS & GEN AS BUILDS	RL	JCC	AM	TC	01/2020	33	P84-844 LPG SAMPLE POINTS CONNECTED TO FLARE AS BUILT	CJ	JT	AM	SES	08/2015
42	AS BUILT P84-1438 LPG HAZOP COMMENTS ETC.	RL	JCC	AM	TC	11/2019	32	LT-413-2, LT-412-2, LT-408-2 BRIDLE, NRV, HV NUMBERS ADDED	JCC	RL/CB	AM	SES	04/2015
41	VALVES ADDED TO LEVEL BRIDLE ON D-430-2	RL	JCC	AM	TC	07/2019	31	P&ID SPLIT INTO 3 DRGS IE. 0104-0003/01, 0005/01 & 0009/01	RL	JC	AM	SES	12/2014
40	HV-4340-2 ADDED FOR ISOLATIONS	RL	JCC	AM	TC	08/2018	30	AS BUILT WS2029090 DE PROP STEAM LINE REPAIR. MPC9202	RL/ES	RM	LH	SES	11/2010

VECTOR KAPUNI LIMITED
PRIVATE BAG 2020
NEW PLYMOUTH 4342
PHONE 0800 734 567

REFERENCE DRAWINGS
0780-0082/06 EDP CAUSE AND EFFECTS
0780-0080/01, 02 & 03 CAUSE AND EFFECTS
0780-0149 CAUSE AND EFFECTS


SCALE: NONE
JOB NO. 1000000
SERIES 0104
DRG. NO 0005
SHT 01 OF 01 SHTS
REVISION 43

DATE: 01/05/1987
ENG: R.VanLUF
APP: R.VanLUF

DATE: 02/07/1987
APP: R.VanLUF

AUTOCAD ORIGINAL SHEET SIZE A1

DATE: 02/07/1987
APP: R.VanLUF

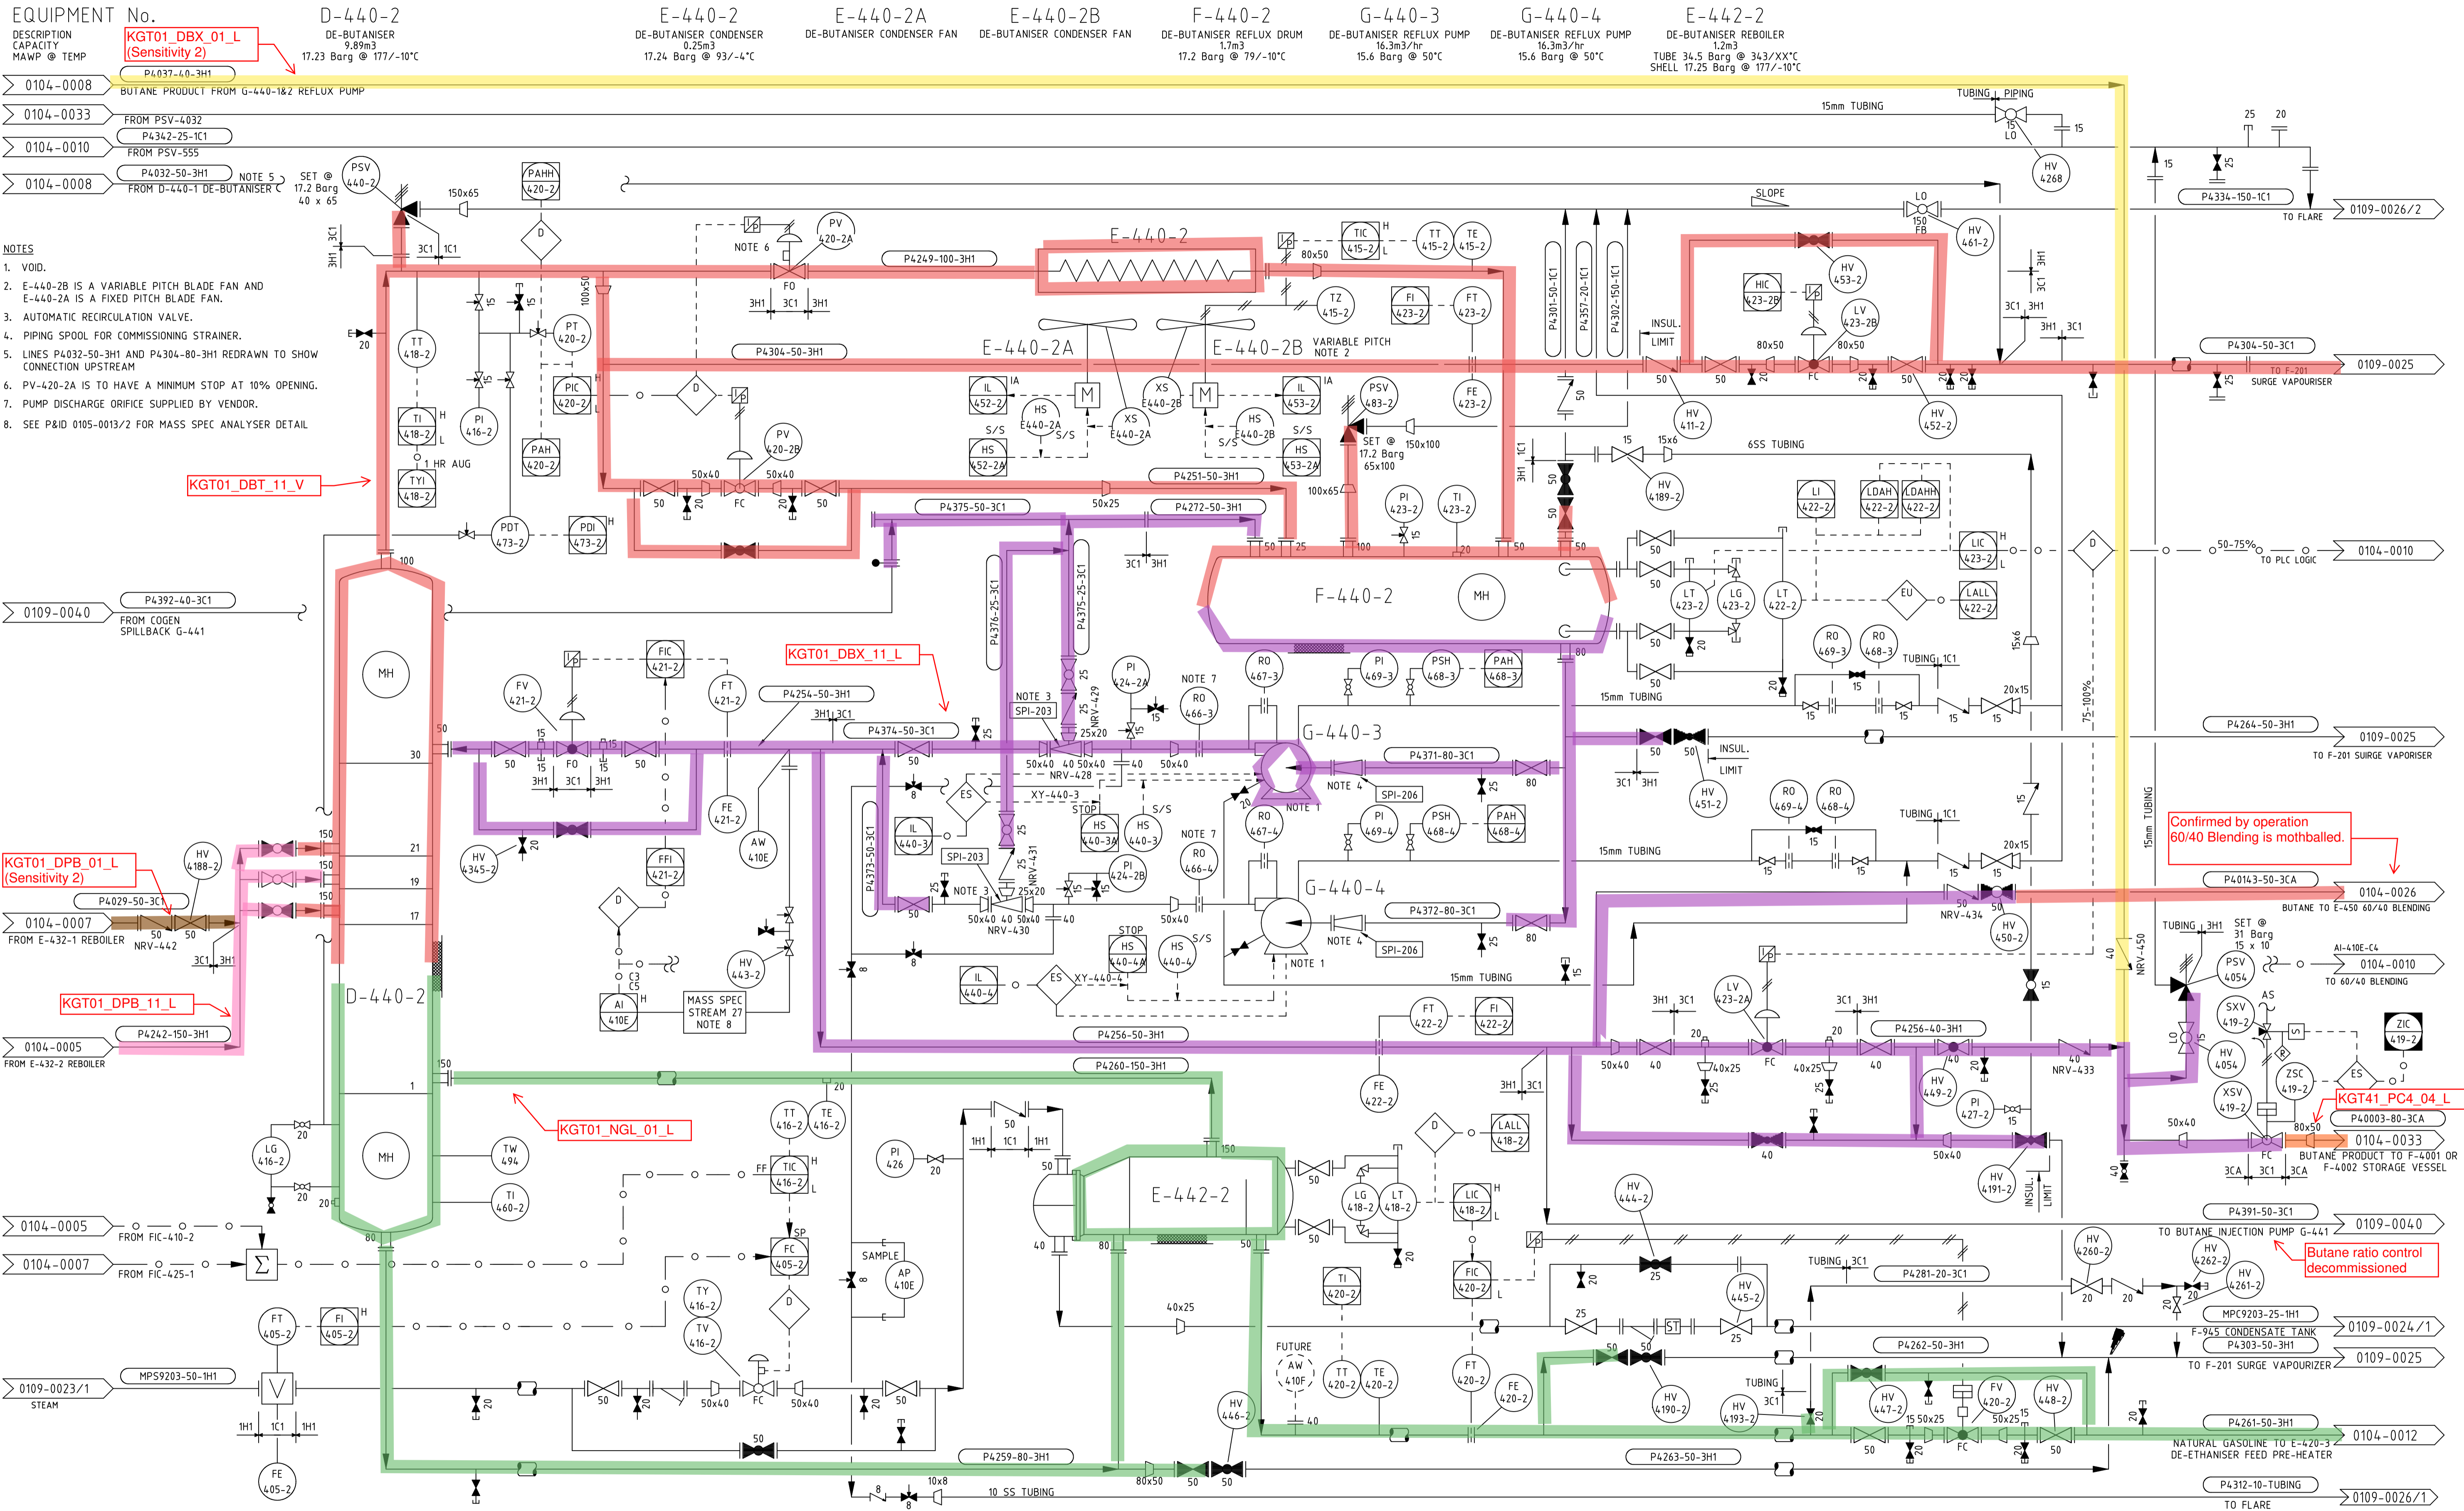

VECTOR KAPUNI LIMITED
 PRIVATE BAG 2020
 NEW PLYMOUTH 4342
 PHONE 0800 734 567

ssj^o

COPYRIGHT The copyright in this document is vested in Vector Kapuni Limited. The contents of this document shall not be reproduced, either in whole or part, by any means whatsoever without the prior written consent of Vector Kapuni Limited.

AUTOCAD ORIGINAL SHEET SIZE A1


DRN	P.RAWLES	01/05/1987	ENG	R.Van LIJF	DATE
CHK	R.Van LIJF		APP	R.Van LIJF	02/07/1987

SCALE:	JOB NO.	SERIES	DRG. NO	SHT 01	REVISION
NONE	1000000	0104	0006	OF 01	35

EQUIPMENT No.

DESCRIPTION
CAPACITY
MAWP @ TEMP

A I B C D E F

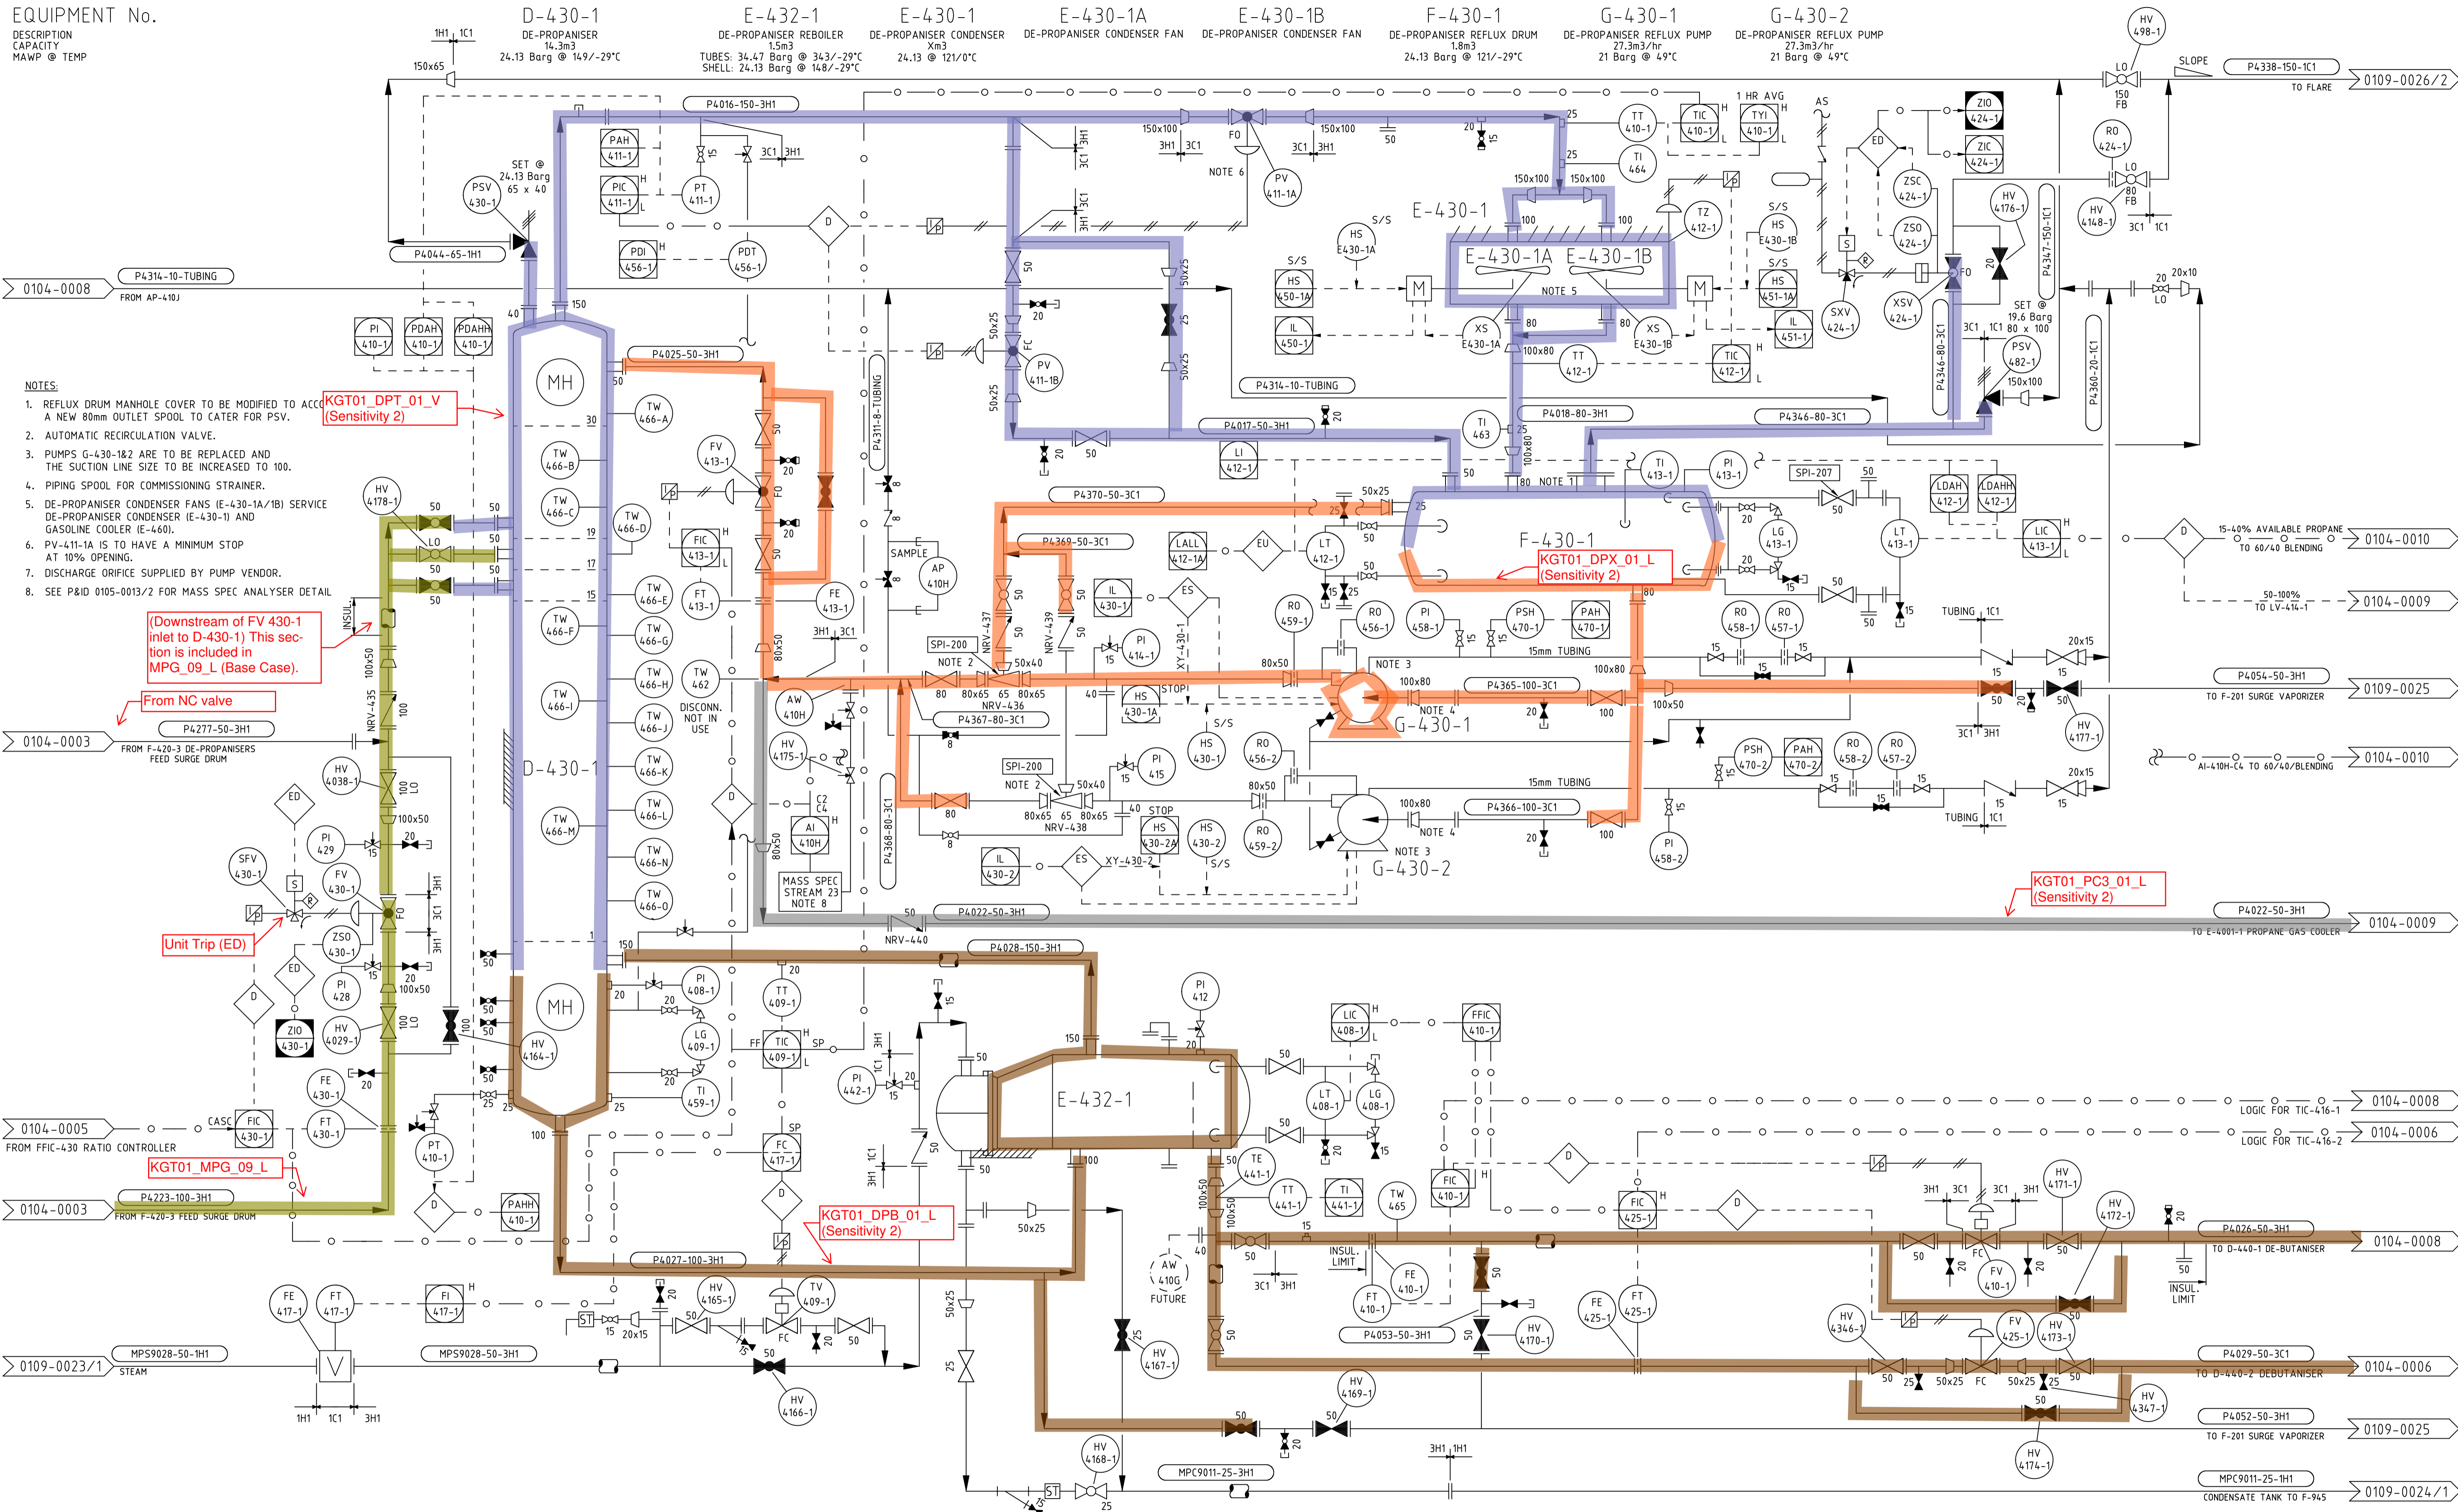

- NOTES:
- REFLUX DRUM MANHOLE COVER TO BE MODIFIED TO ACCOMMODATE A NEW 80mm OUTLET SPOOL TO CATER FOR PSV.
 - AUTOMATIC RECIRCULATION VALVE.
 - PUMPS G-430-1&2 ARE TO BE REPLACED AND THE SUCTION LINE SIZE TO BE INCREASED TO 100.
 - PIPING SPOOL FOR COMMISSIONING STRAINER.
 - DE-PROPANISER CONDENSER FANS (E-430-1A/1B) SERVICE DE-PROPANISER CONDENSER (E-430-1) AND GASOLINE COOLER (E-460).
 - PV-411-1A IS TO HAVE A MINIMUM STOP AT 10% OPENING.
 - DISCHARGE ORIFICE SUPPLIED BY PUMP VENDOR.
 - SEE P&ID 0105-0013/2 FOR MASS SPEC ANALYSER DETAIL

REV	AMENDMENT	BY	CHK	ENG	APP	DATE	REV	AMENDMENT	BY	CHK	ENG	APP	DATE
26	P84-844 LPG SAMPLE POINTS CONNECTED TO FLARE AS BUILT	CJ	JT	AM	SES	08/2015	16	PROCESS ISOLATION POINTS ADDED ON INDIVIDUAL LAYERS	CMW	RL	CW	AIM	10/02
25	P&ID SPLITTING, E-4001-1 MOVED TO DRG. No. 0104-0009/01	RL	JCC	AM	SES	12/2014	15	AS BUILT FOR W5133241 EDP COMM & DESIGN DATA ADDED	CMW	RL	AvG	AIM	08/02
24	AS BUILT PER INCIDENT 510811	ES	AAB	LH	SES	05/10	14	PSV-430-1 MODIFIED. FLANGES ADDED TO P3207	VB	RL	EJH	RJW	02/01
23	AS BUILT P84-3007 ESD LEVEL TRANS DEVIATION ALARMS	ES	TC	LH	SES	03/10	13	REDUCER ON P4044 CORRECTED	VB	RL	EJH	RS	10/99
22	AS BUILT W52006869 LPG COLUMN CONTROL STRATEGY	ES	AAB	LH	SES	02/09							
21	AS BUILT W51042819-BENFIELD SYSTEM HAZARD REPORT	ES	CP	LH	PJR	01/07							
20	PAH-411-1 ADDED AND CAUSE & EFFECTS DRG NUMBER	RL	CP	LH	PJR	11/2006	30	HAND VALVE No's ADDED FOR ISOLATIONS & GEN AS BUILDS	RL	JCC	AM	TC	01/2020
19	ISOLATION VALVE FROM SHELLSIDE E-4001-1 REMOVED	RL	ES	LH	PJR	05/2006	29	SCR-631 DE- BUT TRIPS & LINE MPS9028 SPEC CHANGE	RL	JCC	AM	SES	01/2017
18	TAGS REPLACED WITH HS-430-1A/1B	JM	WN	LH	PJR	01/06/05	28	AS BUILT - P84-1148 ADDED PT-410-1	JCC	RL/AB	AM	SES	01/2016
17	VIBRATION SWITCHES ADDED TO E-430-1. AS BUILT	JBH	RL	LH	PJR	11/06/03	27	HV AND NRV NUMBERS ADDED FOR ISOLATIONS	RL	JCC	AM	SES	10/2015

VECTOR KAPUNI LIMITED
PRIVATE BAG 2020
NEW PLYMOUTH 4342
PHONE 0800 734 567

ssj^o

COPYRIGHT The copyright in this document is vested in Vector Kapuni Limited. The contents of this document shall not be reproduced, either in whole or part, by any means whatsoever without the prior written consent of Vector Kapuni Limited.

AUTOCAD ORIGINAL SHEET SIZE A1

REFERENCE DRAWINGS

CAUSE & EFFECTS - 0780-0080/01, 02, 03
CAUSE & EFFECTS - 0780-0082/06
CAUSE & EFFECTS - 0780-0149

DRN	P.RAWLES	02/07/1987	ENG	R.VanLUF	DATE
CHK	R.VanLUF		APP	R.VanLUF	02/07/1987


LPG PRODUCTION FACILITY
PIPING & INSTRUMENT DIAGRAM
DE-PROPANISER TRAIN 1

SCALE:	JOB NO.	SERIES	DRG. NO	SHT 01	REVISION
NONE	1000000	0104	0007	01	30

EQUIPMENT No.

DESCRIPTION
CAPACITY
MAWP @ TEMP

A I B C D E F

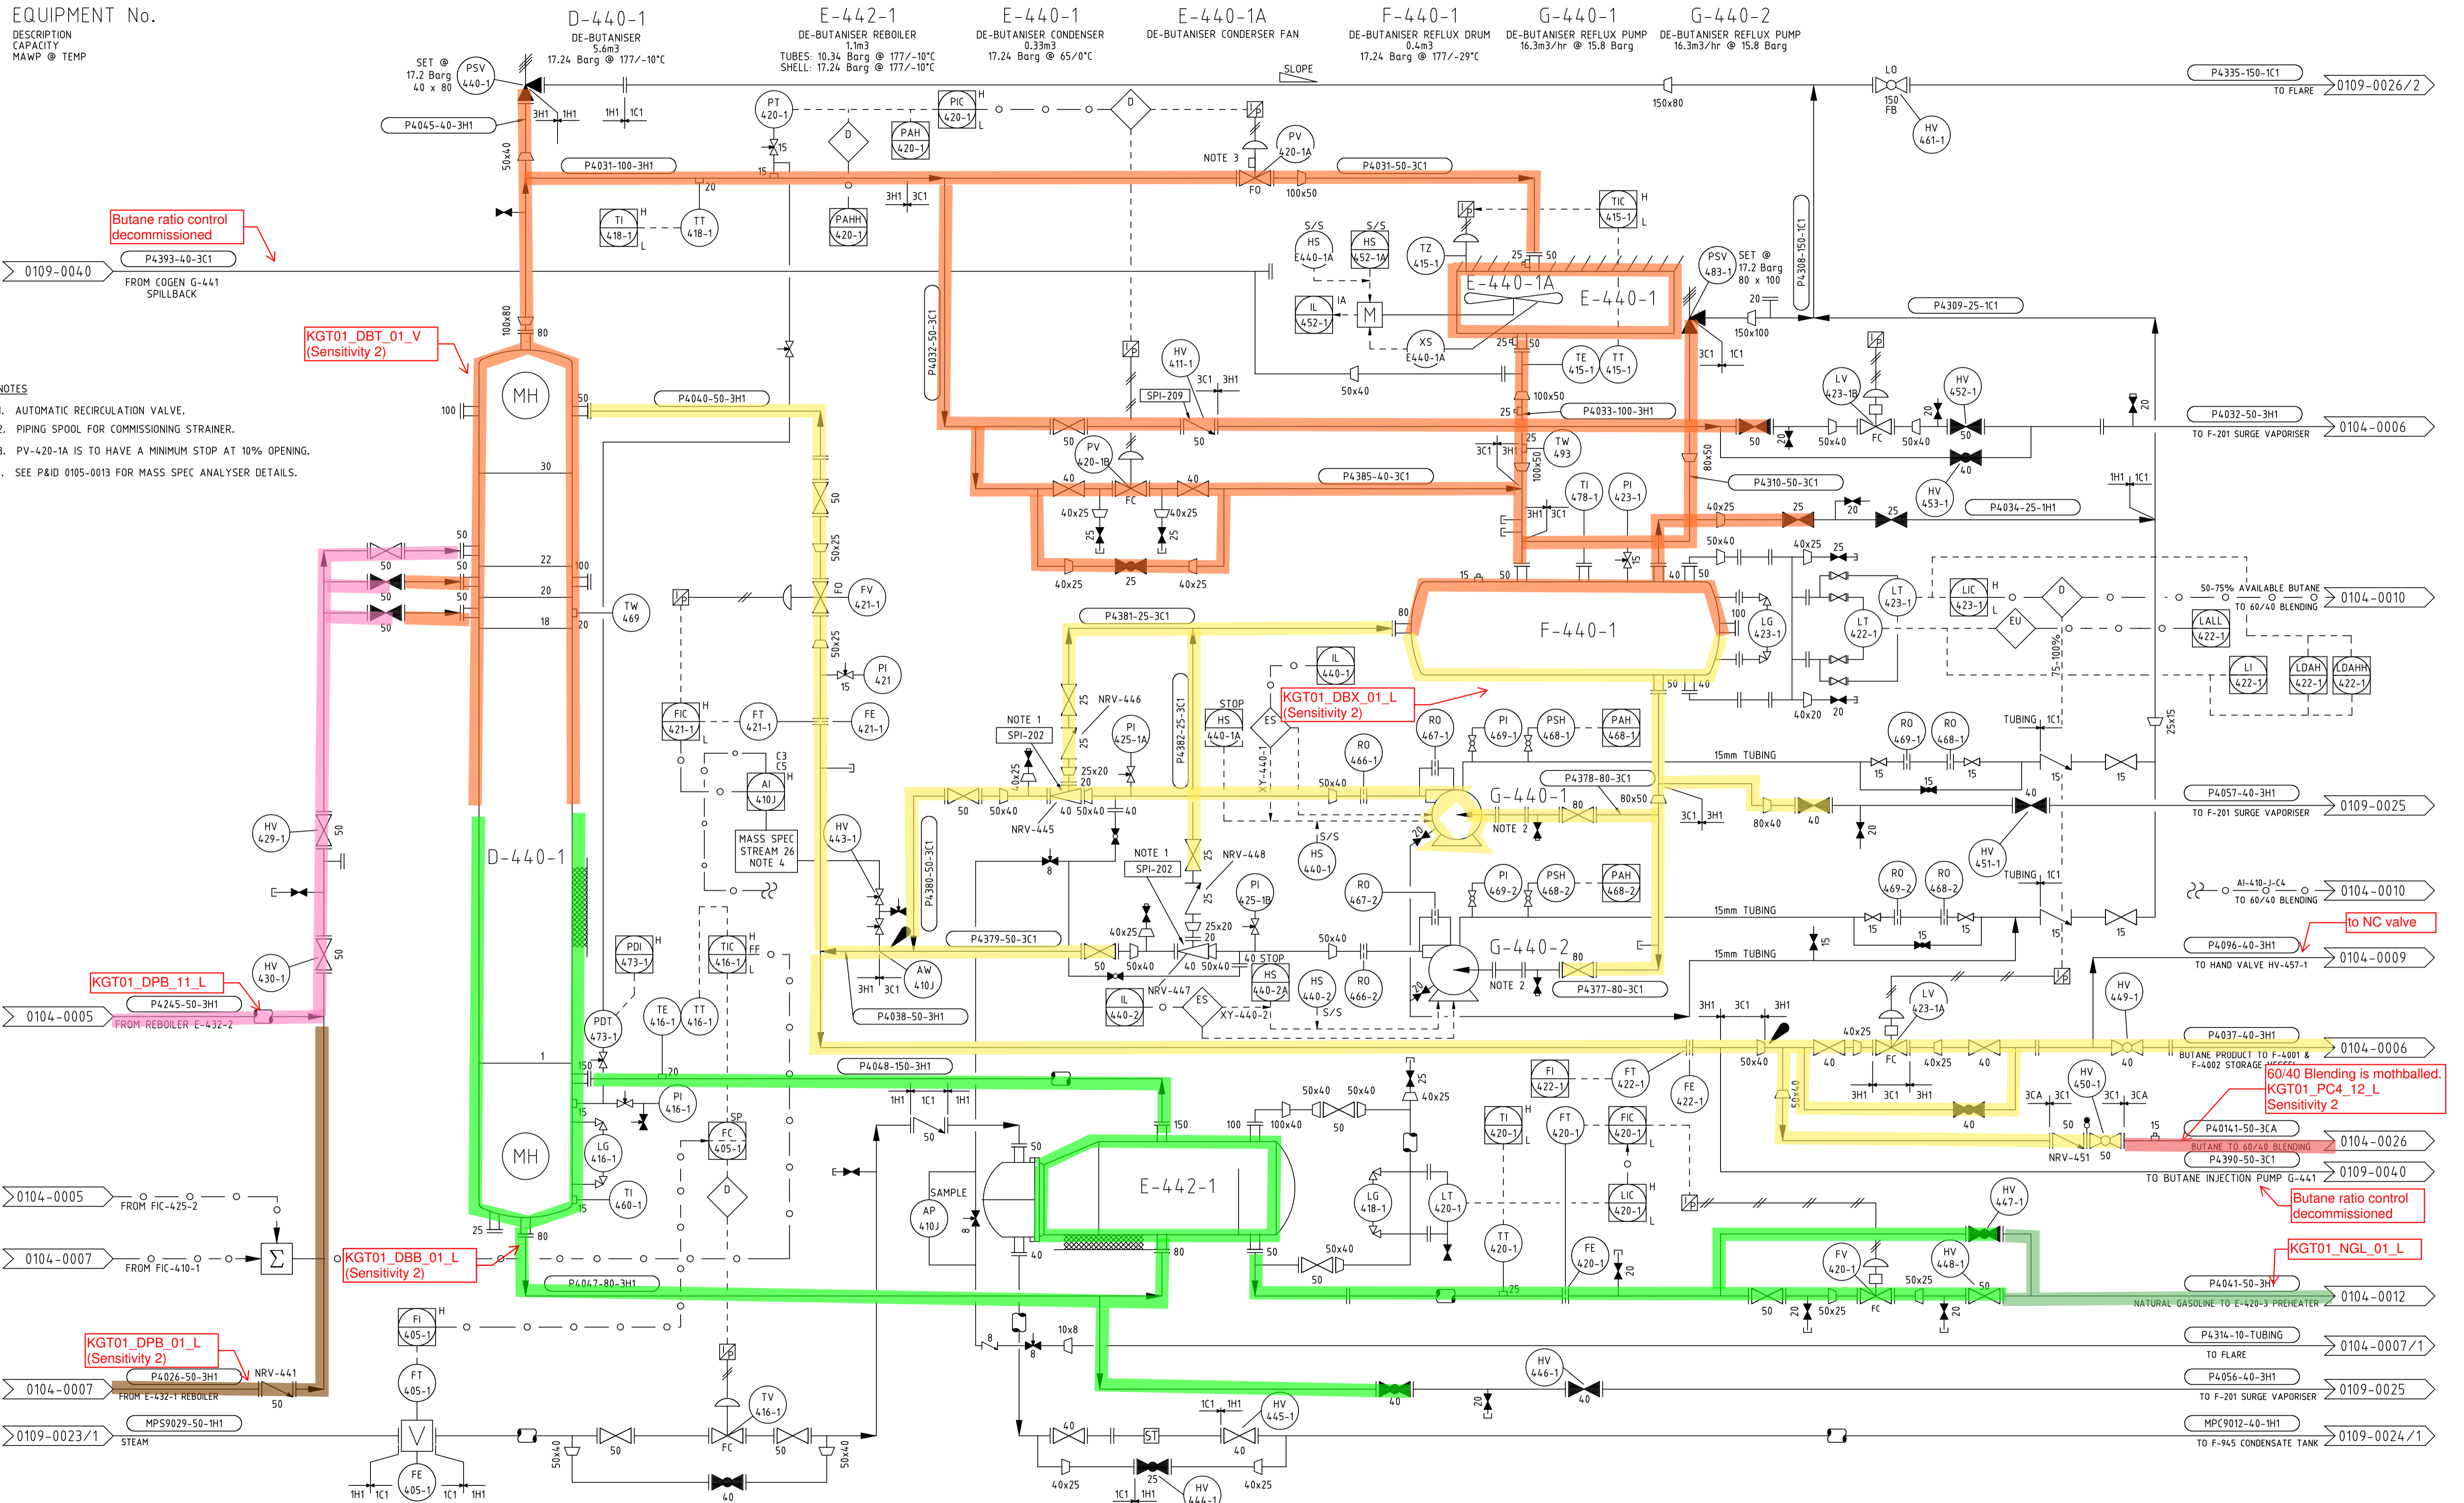

- NOTES
1. AUTOMATIC RECIRCULATION VALVE.
 2. PIPING SPOOL FOR COMMISSIONING STRAINER.
 3. PV-420-1A IS TO HAVE A MINIMUM STOP AT 10% OPENING.
 4. SEE P&ID 0105-0013 FOR MASS SPEC ANALYSER DETAILS.

REV	AMENDMENT	BY	CHK	ENG	APP	DATE	REV	AMENDMENT	BY	CHK	ENG	APP	DATE
20	HAND VALVE NUMBERS ADDED FOR ISOLATIONS	RL	CR	AM	SES	10/2013	10	PROCESS ISOLATION POINTS ADDED ON INDIVIDUAL LAYERS	CMW	RL	CM	AIM	10/02
19	AS BUILT MSCR 317 - LOW FLOW ALARM ADDED TO FIC-420-1	RL/ES	AL	AM	SES	02/2013							
18	AS BUILT PER INCIDENT No. 510811	ES	AAB	LH	SES	05/10							
17	AS BUILT P84-3007 ESD LEVEL TRANS DEVIATION ALARMS	ES	TC	LH	SES	03/10	26	AS BUILT HP VENT ADDED TO P4309 & LINE No. P4096 ADDED	RL	JCC	AM	TC	07/2019
16	AS BUILT VALVES TO F-440-1 & WS1476991 STEAM TRAP	RL	SR	LH	SES	05/2009	25	SCR-631 DE-BUTANIZER TRIPS	JCC	RL/AB	AM	SES	08/2016
15	AS BUILT WS2006869 LPG COLUMN CONTROL STRATEGY	ES	AAB	LH	SES	02/09	24	CONTINUATION FROM P&ID SPLITTING 0104-0004	JCC	RL	AM	SES	06/2016
14	AS BUILT WS 1042819-BENFIELD SYSTEM HAZARD REPORT	ES	CP	LH	PJR	01/07	23	AS BUILT P84-871 BUTANE INJECTION PUMP DEMO	JCC	RL/CB	AM	TC	11/2015
13	PAH-420-1 ADDED AND CAUSE & EFFECTS DRAWING No.	RL	CP	LH	PJR	11/2006	22	P84-844 LPG SAMPLE POINTS CONNECTED TO FLARE AS BUILT	CJ	JT	AM	SES	08/2015
12	TAGS REPLACED WITH HS-E440-1A	JM	WN	LH	PJR	01/06/15	21	P&ID SPLIT. DRG. No. WAS 0104-0007/02 & PART OF	RL	JCC	AM	SES	12/2014
11	VIBRATION SWITCH ADDED TO E-440-1A	BH	RL	LH	PJR	11/06/03		DRAWING RELOCATED TO 0104-0009					

VECTOR KAPUNI LIMITED
PRIVATE BAG 2020
NEW PLYMOUTH 4342
PHONE 0800 734 567

REFERENCE DRAWINGS
CAUSE & EFFECTS - 0780-0080/01, 02
CAUSE & EFFECTS - 0780-0082/06
CAUSE & EFFECTS - 0780-0149

LPG PRODUCTION FACILITY
PIPING & INSTRUMENT DIAGRAM
DE-BUTANISER TRAIN 1
DRAWING NUMBER WAS 0104-0007/02

COPYRIGHT The copyright in this document is vested in Vector Kapuni Limited
The contents of this document shall not be reproduced, either in whole or part, by any
means whatsoever without the prior written consent of Vector Kapuni Limited.

AUTOCAD ORIGINAL SHEET SIZE A1

DRN	P.RAWLES	03/07/1987	ENG	R.VanLUF	DATE
CHK	R.VanLUF		APP	R.VanLUF	

SCALE:	JOB NO.	SERIES	DRG. NO	SHT	REVISION
NONE	1000000	0104	0008	01	26

EQUIPMENT No.

DESCRIPTION
CAPACITY
MAMP @ TEMP

E-4001-1
PROPANE PRODUCT COOLER
0.3m³
TUBE: 18.67 Barg @ 65°C
SHELL: 28.0 Barg @ 90°C

E-4001-2
PROPANE PRODUCT COOLER
0.34m³
TUBE: 18.67 Barg @ 65°C
SHELL: 28.0 Barg @ 90°C

0104-0007 FROM LIC-413-1

0104-0007 FROM D-430-1 DE-PROPANISER

0109-0009 FROM COOLING WATER TOWERS T-901-1, 2 & 3

0104-0008 FROM DOWNSIDE OF LV-423-1A

0104-0005 FROM LIC-413-2

0104-0005 FROM D-430-2 DE-PROPANISER

0109-0009 FROM COOLING WATER TOWERS T-901-1, 2 & 3

P4348-50-1C1 TO FLARE SYSTEM 0109-0026/2

P40140-50-3CA PROPANE TO 60/40 BLENDING 0104-0026

KGT01_PC3_13_L
Sensitivity 2
60/40 blending is mothballed.

CW9215-25-1H1 TO COOLING T-901-1,2&3 WATER TOWERS 0109-0009

P3207-25-3C1 PROPANE REFRIGERANT SURGE DRUM F-315 0103-0003/1

P4062-40-3H1 TO FLARE 0109-0026/1

P4022-40-3H1 PRODUCT TO M-430 60/40 CONDENSATE TANK 0104-0010

P4064-50-3H1 TO F-201 SURGE VAPORISER 0109-0025

P4358-15-1C1 TO FLARE SYSTEM 0109-0026/2

P4001-80-3CA PROPANE PRODUCT TO F-4003 & F-4004 PROPANE STORAGE 0104-0033

P4352-50-1C1 TO FLARE SYSTEM 0109-0026/2

P4305-50-3H1 TO F-201 0109-0025

P4237-50-3H1 PRODUCT TO M-430 60/40 CONDENSATE TANK 0104-0010

P40142-50-3CA PROPANE TO 60/40 BLENDING 0104-0026

CW9213-50-1H1 TO COOLING T-901-1,2&3 WATER TOWERS 0109-0009

P3207-25-3C1 TO PROPANE REFRIGERANT SURGE DRUM F-315 0103-0003/1

KGT37_PC3_05_L

KGT01_PC3_13_L
Sensitivity 2
60/40 blending is mothballed.

KGT01_PC3_02_L



VECTOR KAPUNI LIMITED
PRIVATE BAG 2020
NEW PLYMOUTH 4342
PHONE 0800 734 567

REFERENCE DRAWINGS
0780-0082/06 EDP CAUSE AND EFFECTS
0780-0080 CAUSE AND EFFECTS
0780-0149 CAUSE AND EFFECTS

LPG PRODUCTION FACILITY
PIPING & INSTRUMENT DIAGRAM
PROPANE PRODUCT COOLERS TRAIN 1 AND 2

REV	AMENDMENT	BY	CHK	ENG	APP	DATE	REV	AMENDMENT	BY	CHK	ENG	APP	DATE
3	AS BUILT HV-459-1 WAS LC, LO ADDED TO HV-4186-1 AND 2	RL	JCC	AM	TC	07/2019							
2	NRV AND HV NUMBERS ADDED FOR ISOLATIONS	RL	JCC	AM	SES	10/2015							
1	P&ID SPLIT. CONTENTS MOVED FROM 0104-0005/01, 0007/01 & 02	RL	JC	AM	SES	12/2014							


DRN	R	LOCHHEAD	DATE	ENG	A	MANN	DATE
CHK	J	CERDA	01/12/2014	APP	S	SMITH	01/12/2014

SCALE:	JOB NO.	SERIES	DRG. NO	SHT	REVISION
NONE	1000000	0104	0009	01 OF 01 SHTS	3

EQUIPMENT No.

DESCRIPTION
CAPACITY
MAWP @ TEMP

M-430
60/40 CONDENSING TANK
0.1 m³
24.13 Barg @ X°C

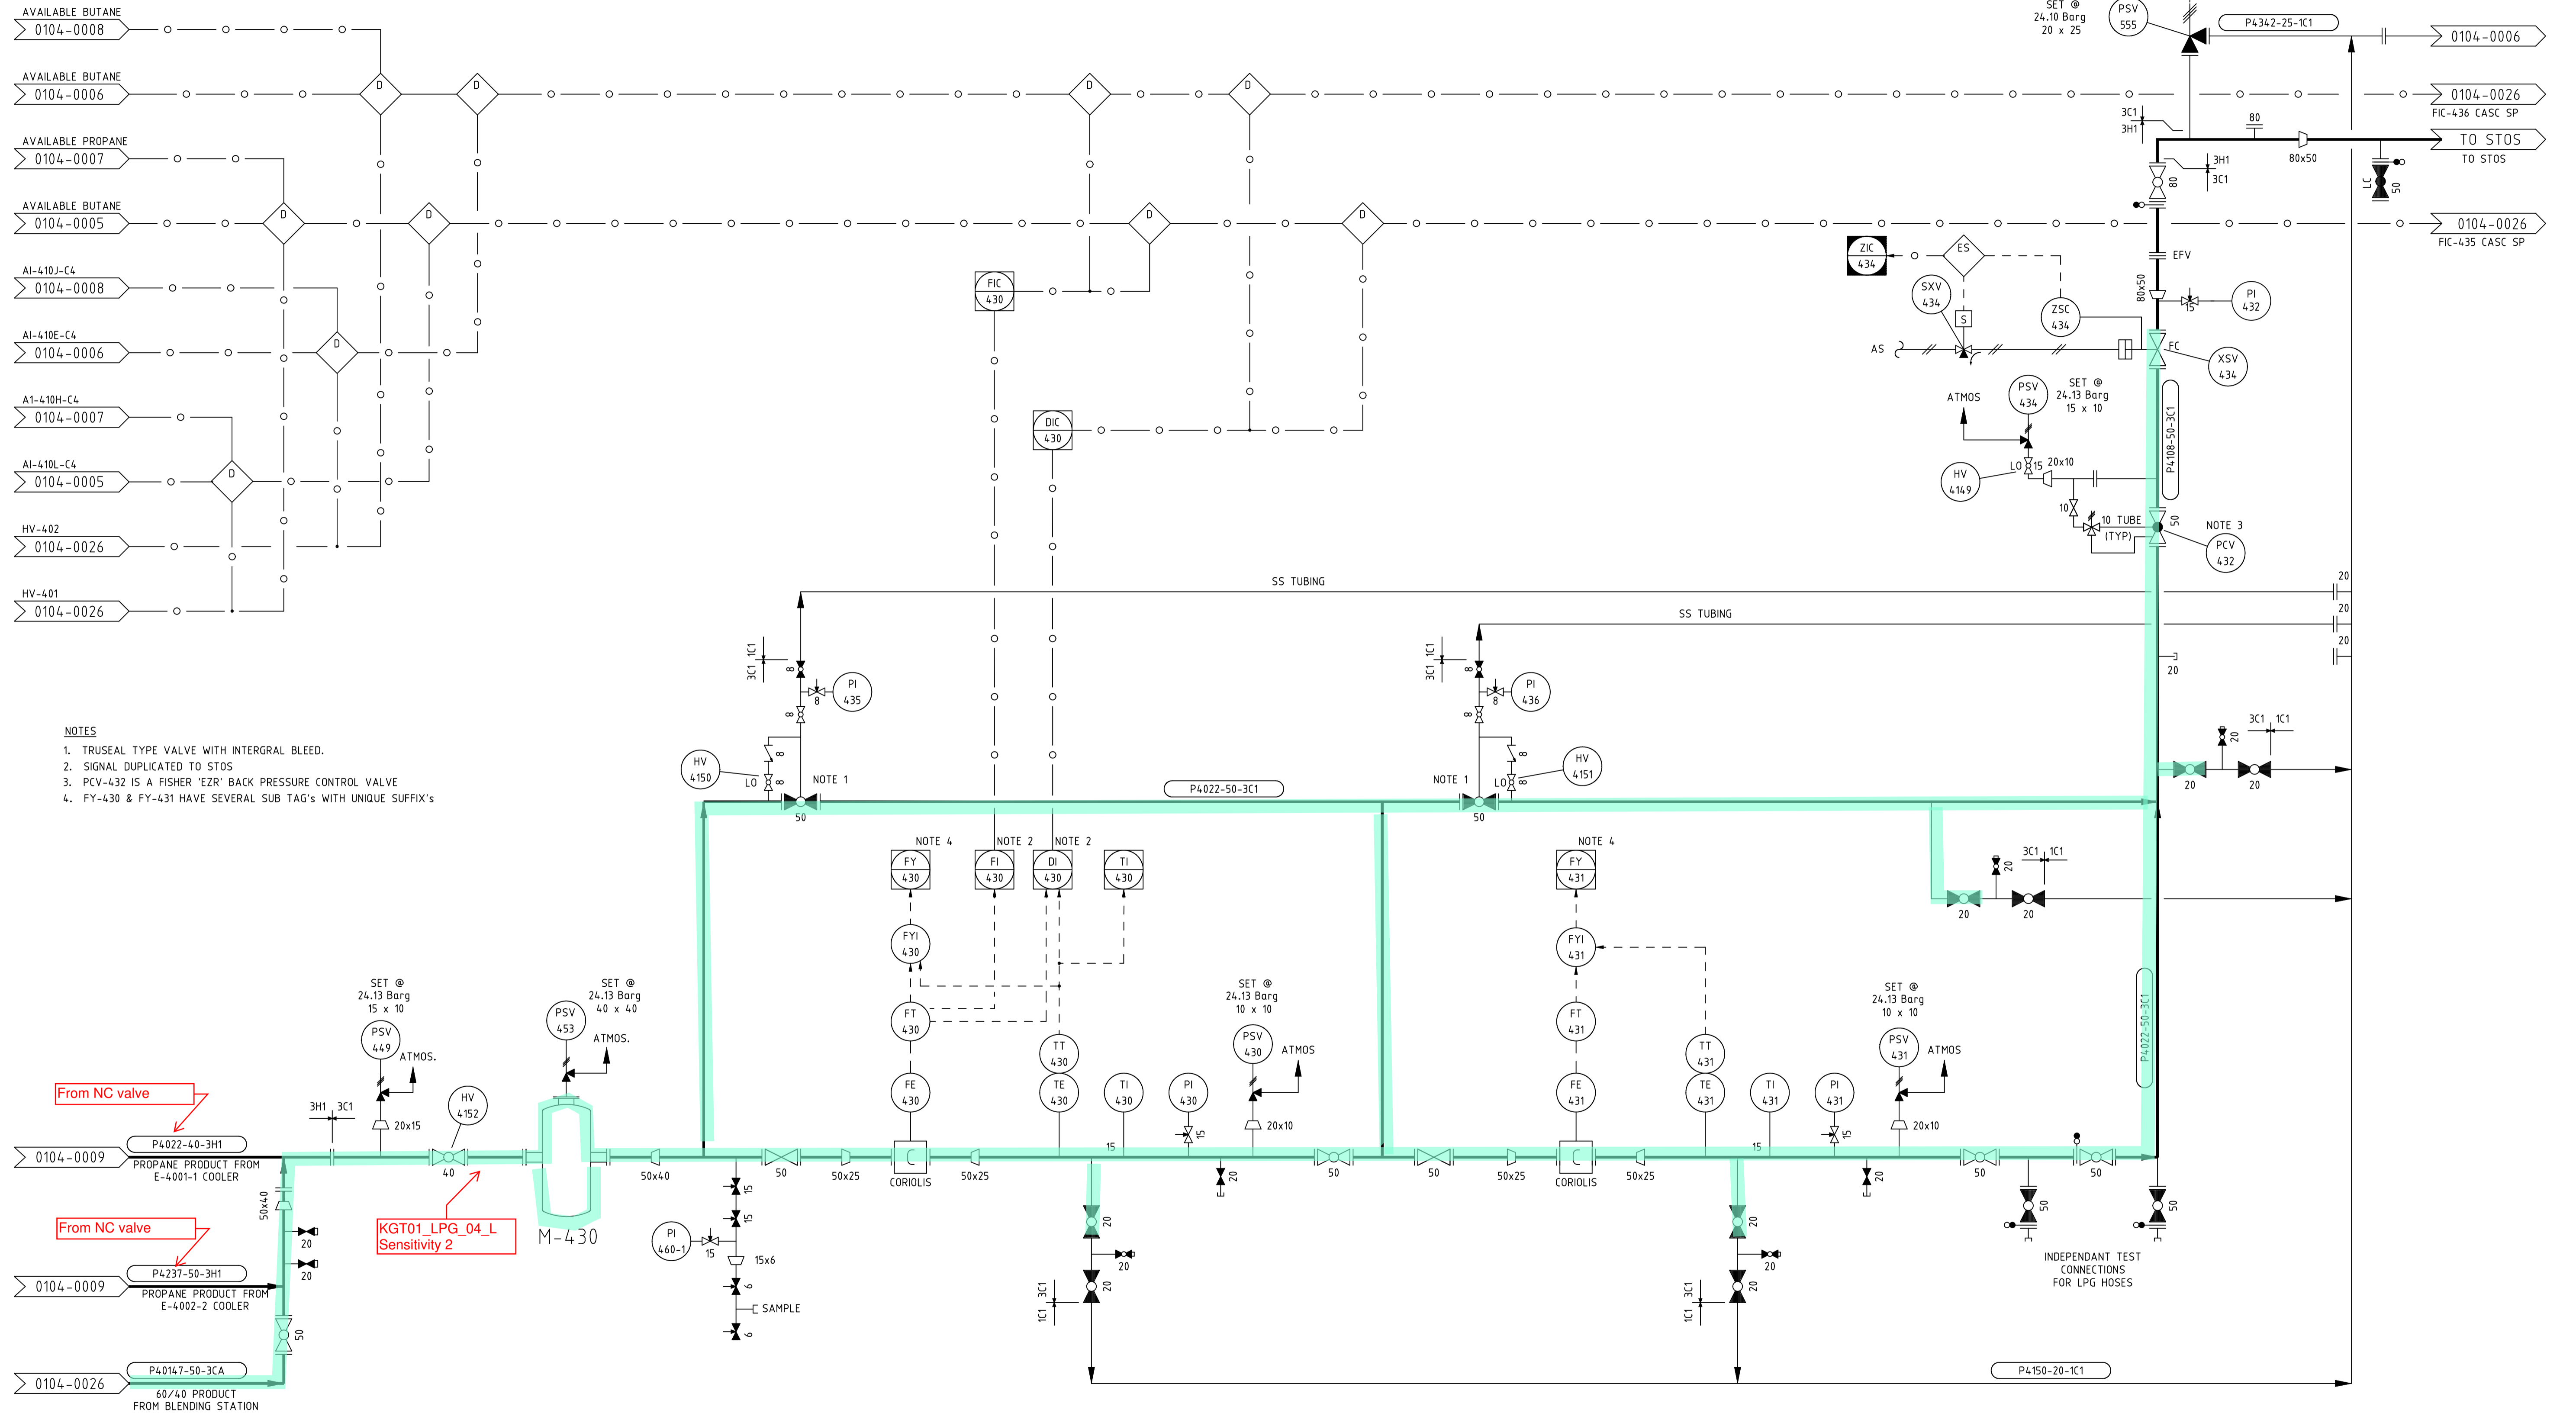

- NOTES
1. TRUSEAL TYPE VALVE WITH INTEGRAL BLEED.
 2. SIGNAL DUPLICATED TO STOS
 3. PCV-432 IS A FISHER 'EZR' BACK PRESSURE CONTROL VALVE
 4. FY-430 & FY-431 HAVE SEVERAL SUB TAG'S WITH UNIQUE SUFFIX'S

REV	AMENDMENT	BY	CHK	ENG	APP	DATE	REV	AMENDMENT	BY	CHK	ENG	APP	DATE
32	P&ID SPLITTING PROJECT. DRG No. WAS 0104-0008/01	RL	JCC	AM	SES	12/2014	22	DESIGN DATA RATIONALISED M-430	JBH	RL	AvG	AIM	08/02
31	P84-165 AS BUILT FLOW COMPUTER ADDITION	ARJ	RL	AM	SES	12/2013	21	AS BUILT-DECOMMISSION OF BULLETS PROJECT WS104846	VB	RL	EJH	RJW	02/01
30	AS BUILT REVERSE CHK VLV'S RE WITH TRU SEAL VLV'S	RL/ES	CR	LH	SES	10/2010	20	P4094 REROUTED TO F-431-2, P4323 TERMINATED	VB	RL	EJH	RJW	12/00
29	AS BUILT 50 VALVE D/STREAM OF FE-431 WAS CLOSED	RL/ES	CB	LH	SES	10/2010	19	AS BUILT F-431-1 REMOVED	VB	RL	EJH	RJW	10/00
28	AS BUILT FOR INCIDENT No. 510811	ES	AAB	LH	SES	04/10	18	P4216, P4095 REMOVED, BLINDS & PSV-433 ADDED	VB	RL	EJH	RS	10/99
27	8mm BLEED VALVES FOR TRUSEAL VALVES WERE CLOSED	RL	JYJ	LH	SES	02/2010	17	SAMPLE POINTS ADDED	VB	RL	EJH	RS	10/98
26	AS BUILT WS1216971 SPEC BLIND SHIFTED AT LPG METER	RL	MS	LH	PJR	01/2007							
25	TUBING ASSOCIATED WITH TRUSEAL VALVES AS BUILT	RL	ES	LH	PJR	11/2006							
24	AS BUILT	ES	WN	LH	PJR	10/06							
23	AS BUILT - WS177367 STOS BACK PRESSURE VALVE	PL	RL	LH	AIM	01/03	33	HV HAND VALVE NUMBERS ADDED TO LOCKED VALVES	RL	JCC	AM	TC	07/2019


VECTOR KAPUNI LIMITED
PRIVATE BAG 2020
NEW PLYMOUTH 4342
PHONE 0800 734 567

COPYRIGHT The copyright in this document is vested in Vector Kapuni Limited
The contents of this document shall not be reproduced, either in whole or part, by any
means whatsoever without the prior written consent of Vector Kapuni Limited.

AUTOCAD ORIGINAL SHEET SIZE A1

REFERENCE DRAWINGS		DATE		DATE	
CAUSE & EFFECTS - 0780-0149/01		02/07/1987	ENG	02/07/1987	R.VanLIJF
		02/07/1987	APP	02/07/1987	R.VanLIJF

LPG PRODUCTION FACILITY PIPING & INSTRUMENT DIAGRAM 60/40 STORAGE DRAWING NUMBER WAS 0104-0008/01					
SCALE:	JOB NO.	SERIES	DRG. NO	SHT 01	REVISION
NTS	1000000	0104	0010	01	33

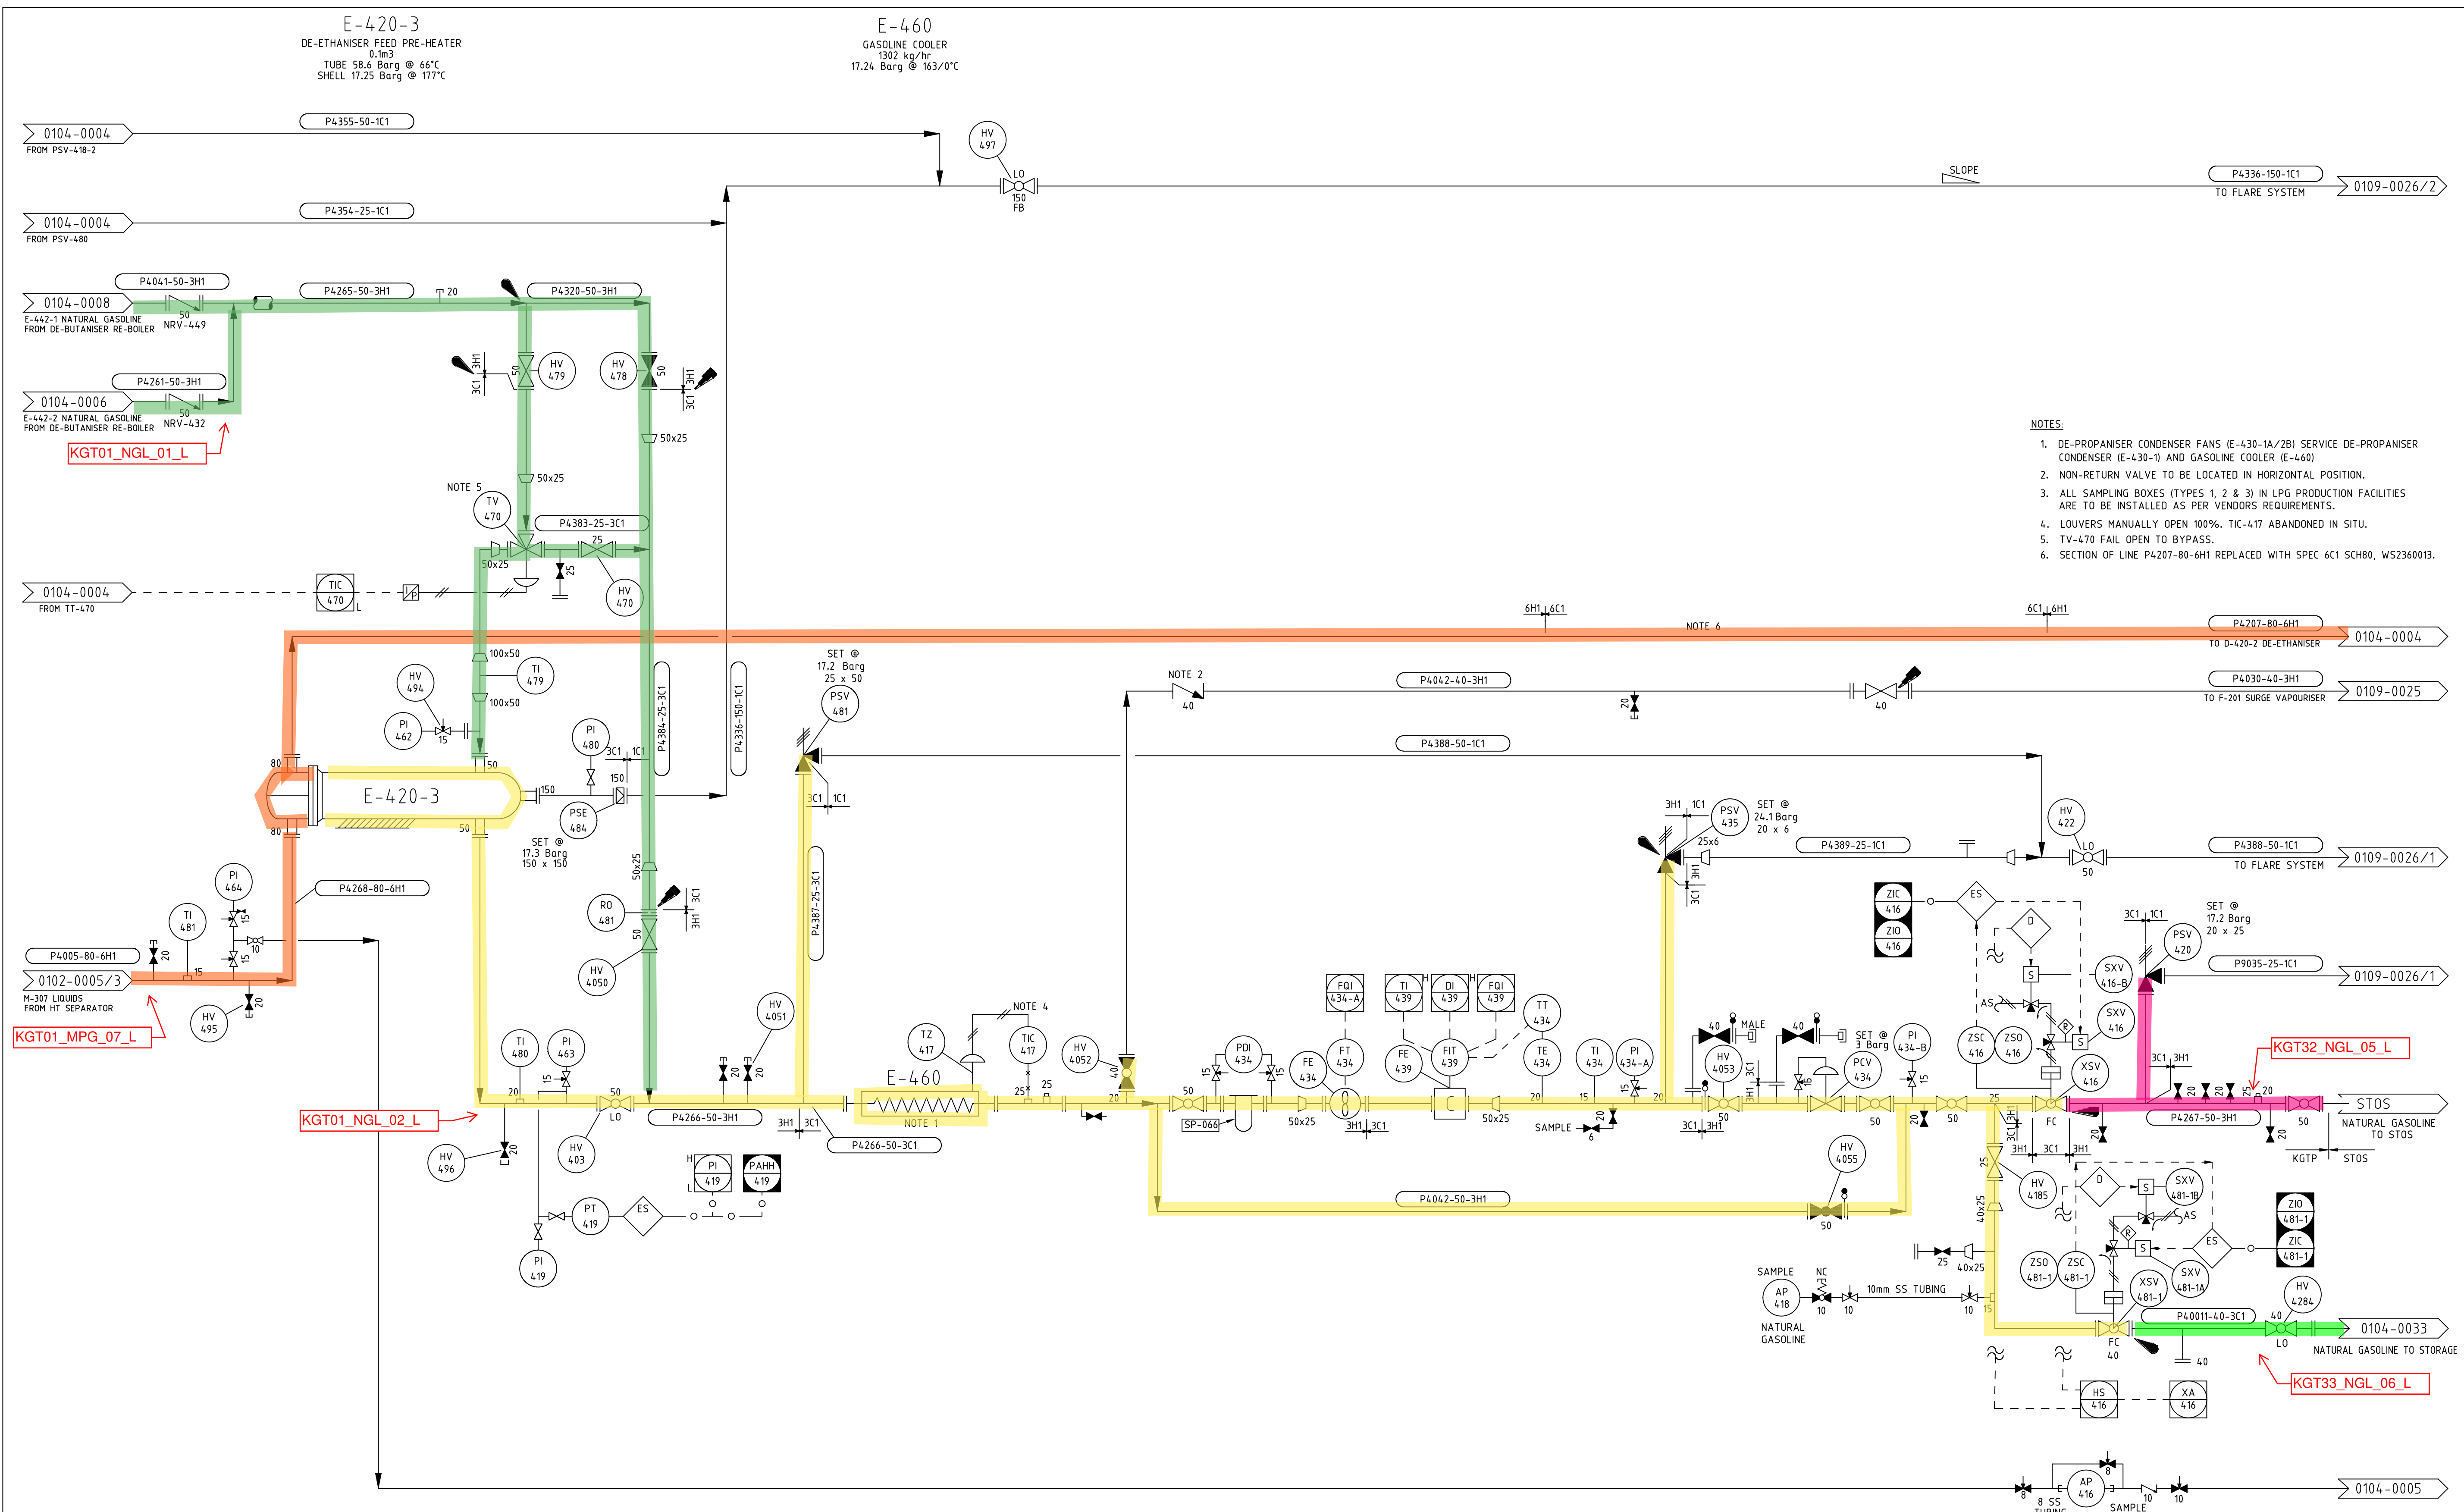

- NOTES:**
1. DE-PROPANISER CONDENSER FANS (E-430-1A/2B) SERVICE DE-PROPANISER CONDENSER (E-430-1) AND GASOLINE COOLER (E-460)
 2. NON-RETURN VALVE TO BE LOCATED IN HORIZONTAL POSITION.
 3. ALL SAMPLING BOXES (TYPES 1, 2 & 3) IN LPG PRODUCTION FACILITIES ARE TO BE INSTALLED AS PER VENDORS REQUIREMENTS.
 4. LOUVERS MANUALLY OPEN 100%. TIC-417 ABANDONED IN SITU.
 5. TV-470 FAIL OPEN TO BYPASS.
 6. SECTION OF LINE P4207-80-6H1 REPLACED WITH SPEC 6C1 SCH80, WS2360013.

REV	AMENDMENT	BY	CHK	ENG	APP	DATE	REV	AMENDMENT	BY	CHK	ENG	APP	DATE
5	AS BUILT P84-1438 LPG HAZOP COMMENTS, P84-1451 LO VALVE WS2360013 PIPE REPLACED FOR CUI & SCR995 NAT GAS LINE OUT	RL	JCC	AM	TC	11/2019							
4	AS BUILT P84-1310B NATURAL GASOLINE TEMP STORAGE.	RL	JC/JS	AM	SES	05/2018							
3	AS BUILT - P84-1310 PERMANENT NATURAL GASOLINE STORAGE	JT	DV	AM	SES	09/2017							
2	AS BUILT P84-1310 NATURAL GASOLINE TEMP STORAGE	RL	JC/JS	AM	TC	10/2016							
1	P&ID SPLIT CONTENTS FROM 0104-0004/1	JCC	RL/NM	AM	SES	01/2016							

VECTOR KAPUNI LIMITED
 PRIVATE BAG 2020
 NEW PLYMOUTH 4342
 PHONE 0800 734 567

COPYRIGHT The copyright in this document is vested in Vector Kapuni Limited. The contents of this document shall not be reproduced, either in whole or part, by any means whatsoever without the prior written consent of Vector Kapuni Limited.

AUTOCAD ORIGINAL SHEET SIZE A1

REFERENCE DRAWINGS

CAUSE & EFFECTS - 0780-0080/01, 02, 03
 0780-0149/01

DRN	P.RAWLES	DATE	ENG	R.VanLIJF	DATE
CHK	R.VanLIJF	01/04/1987	APP	R.VanLIJF	02/07/1987

LPG PRODUCTION FACILITY
 PIPING & INSTRUMENT DIAGRAM
 GASOLINE METERING
 P&ID SPLIT FROM 0104-0004-01

SCALE:	JOB NO.	SERIES	DRG. NO	SHT	REVISION
NTS	1000000	0104	0012	01 OF 01 SHTS	5

EQUIPMENT No.


DESCRIPTION
CAPACITY
MAWP @ TEMP

E-450

BUTANE COOLER
70kW
SHELL 14.0 Barg @ 85°C
TUBE 25.0Barg @ 100°C
SURFACE AREA 4.35m²
VOLUME SHELL 0.16m³, TUBE 0.03m³

F-450

FLARE K/O POT

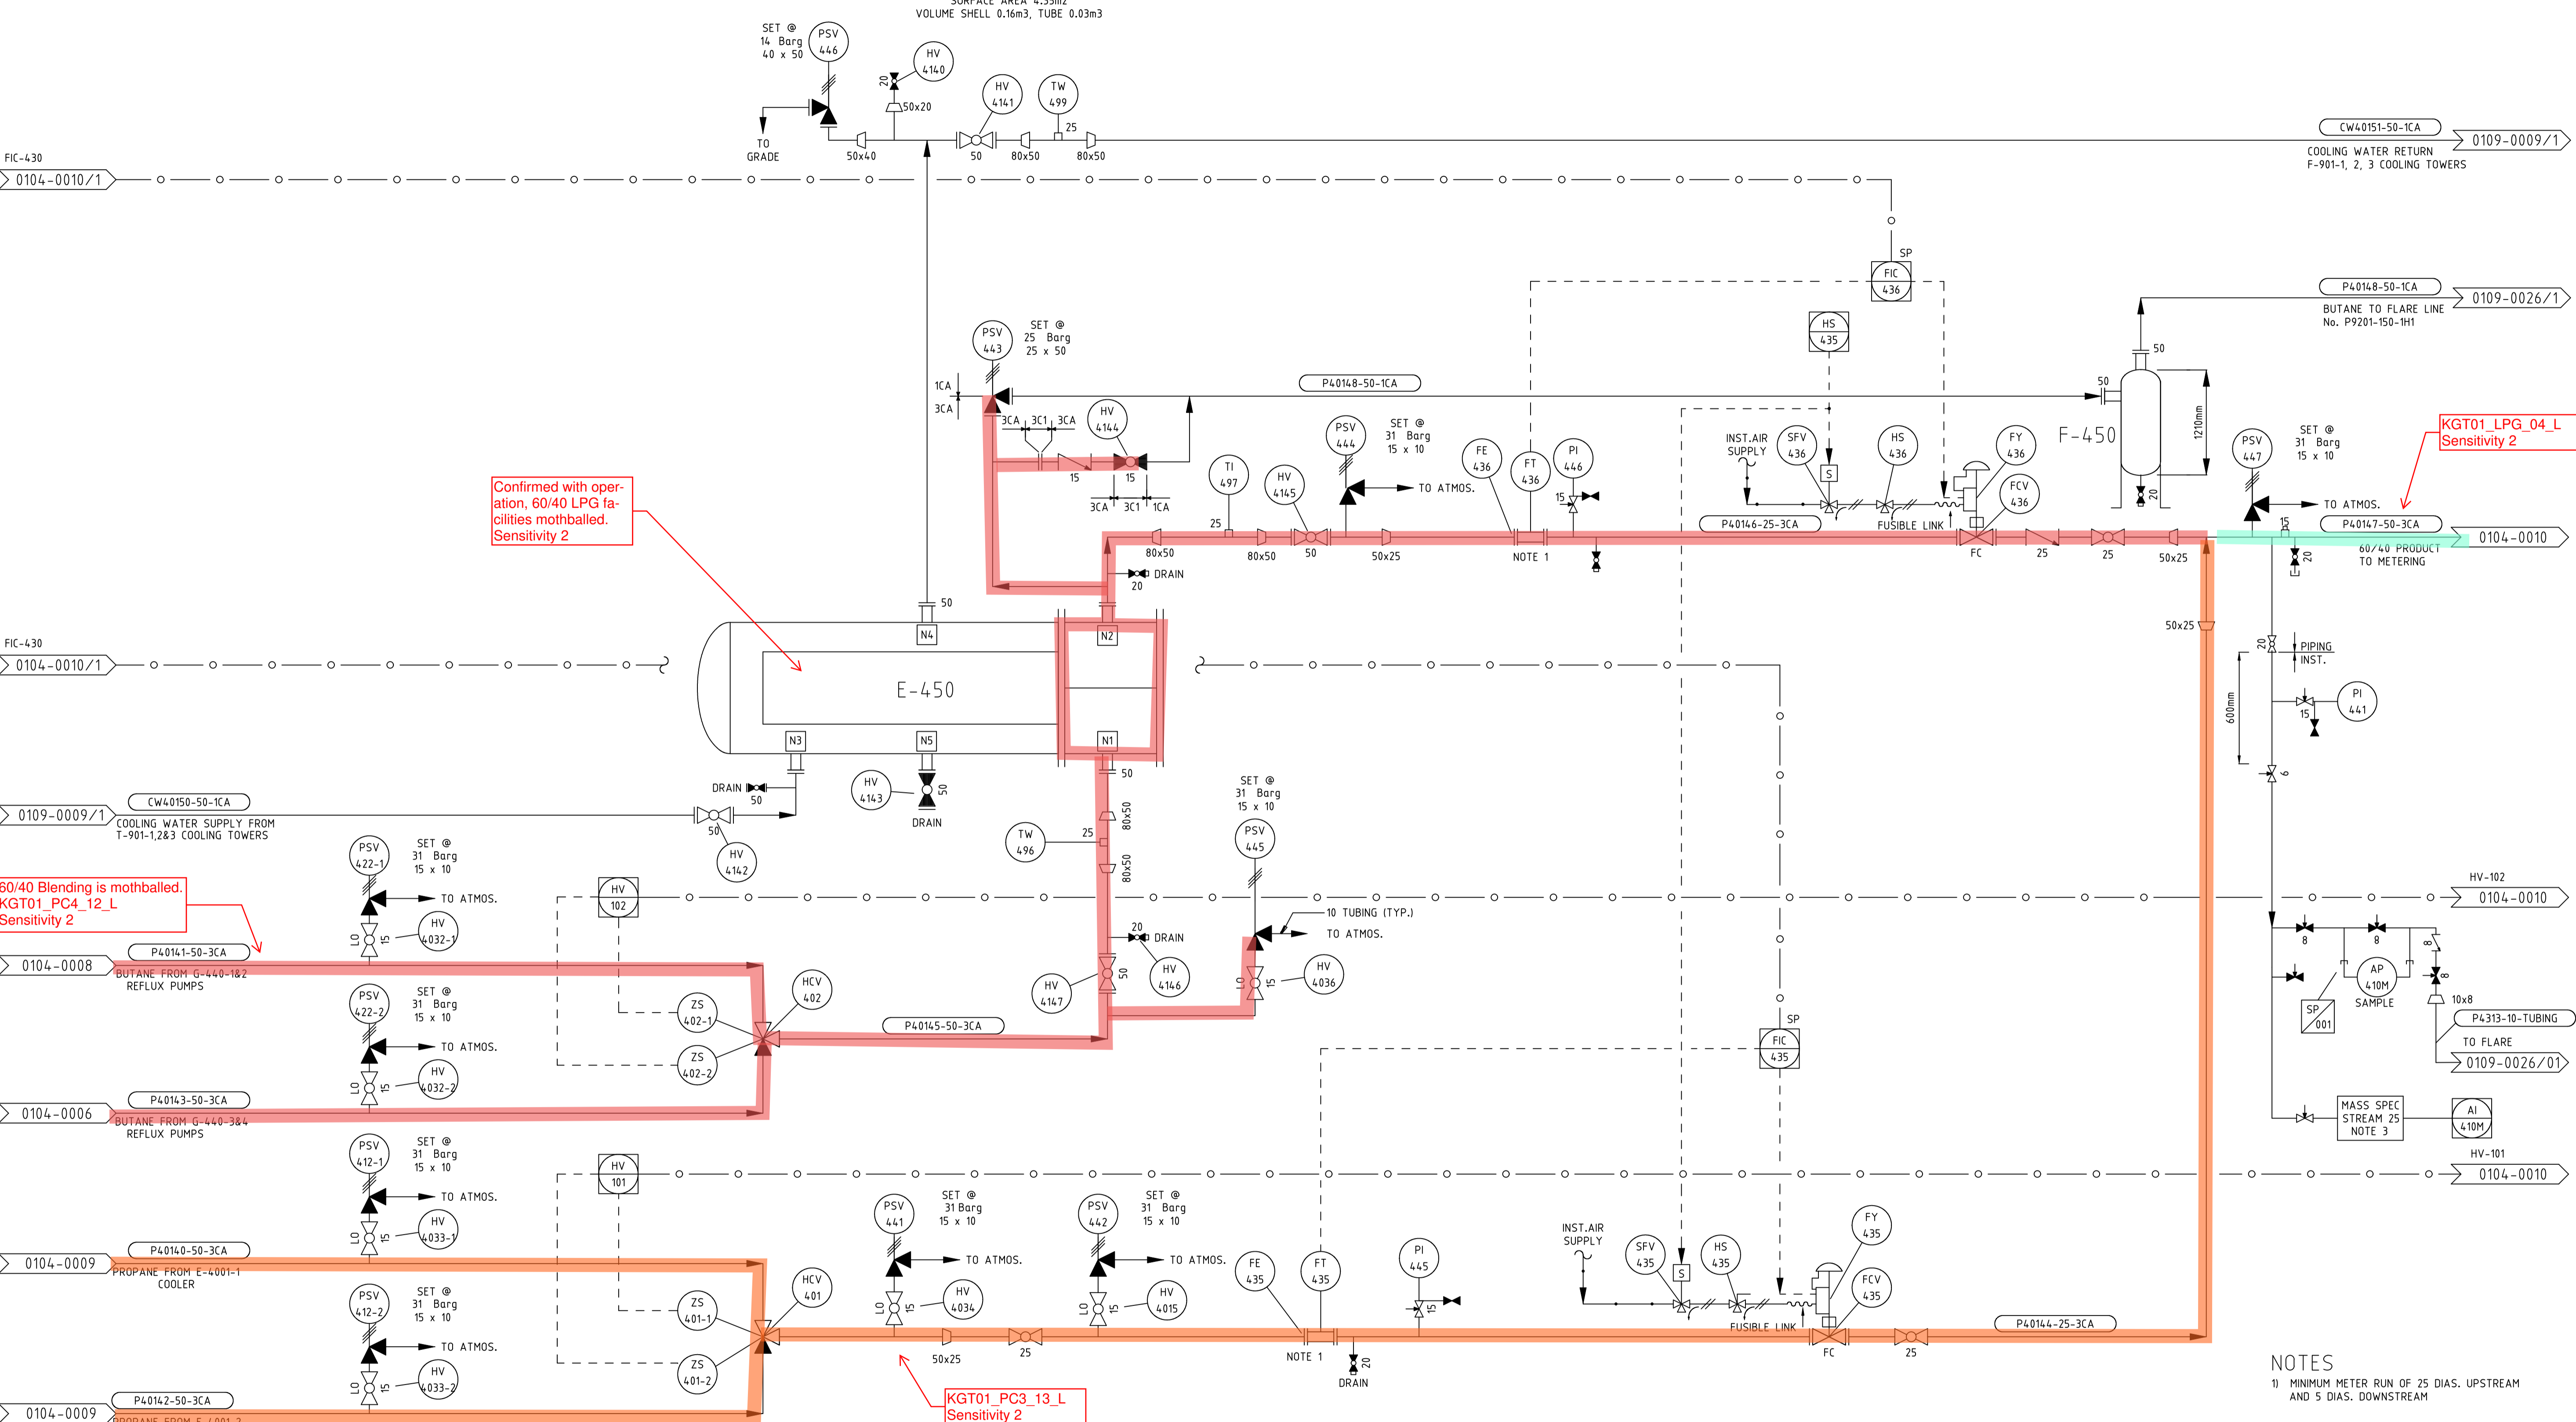

Confirmed with operation, 60/40 LPG facilities mothballed. Sensitivity 2

60/40 Blending is mothballed. KGT01_PC4_12_L Sensitivity 2

KGT01_PC3_13_L Sensitivity 2


- NOTES
- MINIMUM METER RUN OF 25 DIAS. UPSTREAM AND 5 DIAS. DOWNSTREAM
 - SEE P&ID 0105-0013/2 FOR MASS SPEC ANALYSER DETAIL.

REV	AMENDMENT	BY	CHK	ENG	APP	DATE	REV	AMENDMENT	BY	CHK	ENG	APP	DATE
8	AS BUILT TO WS1121373 PSV-443 BYPASS MODIFICATIONS	PJ	LH	MP	SR	01/07							
7	PROCESS ISOLATION POINTS ADDED ON INDIVIDUAL LAYERS	CMW	RL	CM	AIM	10/02							
6	E-450 SHELL & TUBE DESIGN DATA ADDED	JBH	RL	AvG	AIM	08/02							
5	CONTINUATION OF P40147 MODIFIED	VB	RL	EJH	RJW	02/01							
4	PROCESS CONDITIONS REVISED	RL	JBH	EJH	RS	10/98							
3	AS BUILT FOR REFURBISHMENT PROJECT	J.W.	G.R.	K.E.	G.M.	02/98							
2	AS BUILT PO-KGP-10-KCOM-002 PSV-446 WAS 19 BARG. P84-3023	V.B.	B.T.	A.V.G.	C.J.	5/95							
1	REVISED FOR CONTINUITY CHECK	P.T.D.	O.G.M.	A.V.G.	C.J.	10/94							
B	NGC REVISED COMMENTS ADDED.	V.B.	M.W.	G.M.	J.R.	7/94							
A	REDRAWN ON AUTOPLANT	J.B.C.	V.B.	G.M.	J.R.	4/94							

VECTOR KAPUNI LIMITED
PRIVATE BAG 2020
NEW PLYMOUTH 4342
PHONE 0800 734 567

COPYRIGHT The copyright in this document is vested in Vector Kapuni Limited. The contents of this document shall not be reproduced, either in whole or part, by any means whatsoever without the prior written consent of Vector Kapuni Limited.

REFERENCE DRAWINGS				LPG LOADING FACILITY PIPING & INSTRUMENT DIAGRAM 60/40 BLENDING						
DRN	N.B.	DATE	ENG	DATE	SCALE:	JOB NO.	SERIES	DRG. NO	SHT	REVISION
CHK		18/08/1992	APP		NONE	1000000	0104	0026	01 OF 01 SHTS	16

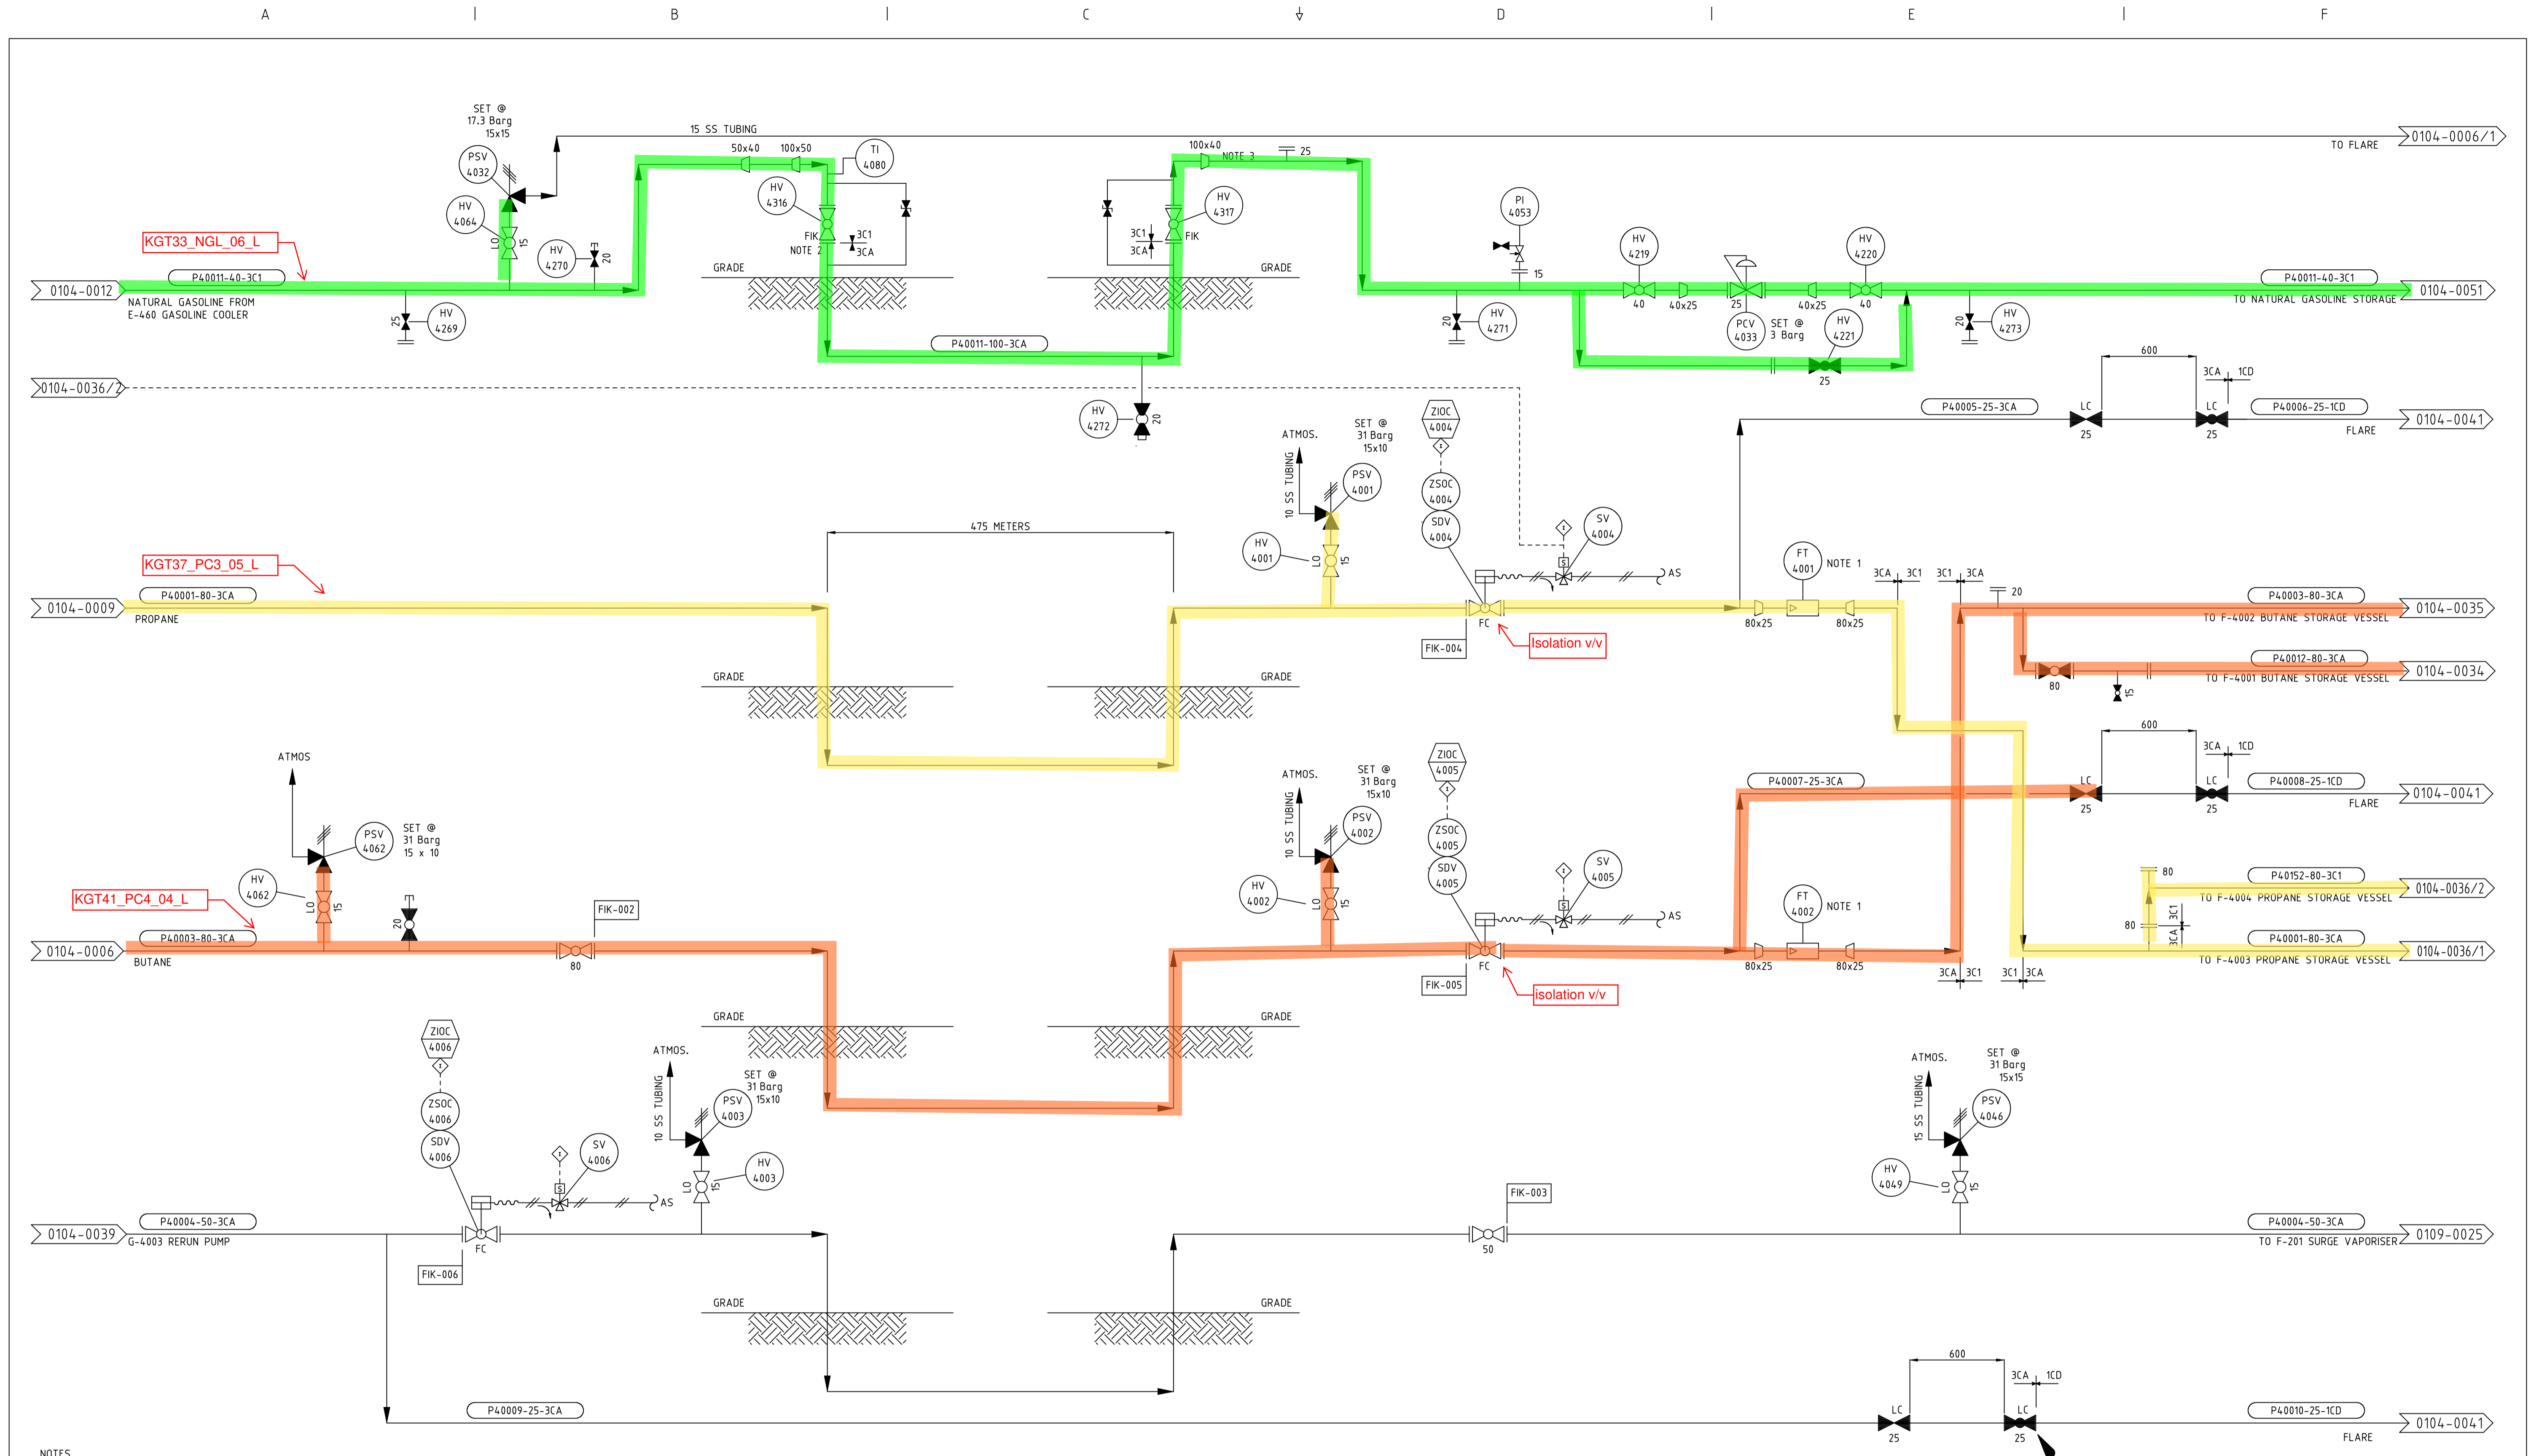

- NOTES**
1. THE FLOW TRANSMITTER ELEMENTS OF FT-4001 AND FT-4002 ARE DECOMMISSIONED, BUT WITH THE BODY LEFT IN SITU AS A SPOOL PIECE.
 2. P40011-100-3CA HAS BEEN DE-RATED TO 17.3 BARG DESIGN PRESSURE.
 3. P40011-100-3C1 FROM UNDERGROUND TO F-4033 LIMITED BY PRESSURE RATING OF PCV-4033.

REV	AMENDMENT	BY	CHK	ENG	APP	DATE	REV	AMENDMENT	BY	CHK	ENG	APP	DATE
10	AS BUILT - P84-1310 PERMANENT NATURAL GASOLINE STORAGE	JT	DV	AM	SES	09/2017							
9	REVISED FOR P&ID SPLITTING. CONT. DRG. No's REVISED	RL	JCC	AM	SES	01/2015							
8	NOTE 1 ADDED REGARDING FT-4001 & FT-4002	RL/ES	CB	AM	SES	04/2013							
7	AS BUILT P84-3025 LPG ESD LOGIC. PSV-4062 WAS 18.86 BARG.	RL/ES	RM	LH	SES	09/2010							
6	PSV-4062 ADDED & VALVE MOVED TO 0104-0005	ES	RL	LH	SES	12/08							
5	AS BUILT W51404955-LPG RELIEF VALVE ISOLATION	ES	TL	LH	SES	07/08							
4	AS BUILT FOR PEP PROJECT W5822071	RL	RH	LH	GE	05/2004							
3	AS BUILT PSV-4046 ADDED TO LINE P40004	JBH	RL	LH	RJW	28/05/01							
2	TITLE BLOCK REVISED. DRAWING CONTENT NOT CHANGED	VB	RL	EJH	RS	10/99							
1	REDRAWN ON AUTOPLANT. WAS 104-10	D.R.	J.C.	G.M.	C.J.	09/94							

VECTOR KAPUNI LIMITED
 PRIVATE BAG 2020
 NEW PLYMOUTH 4342
 PHONE 0800 734 567


COPYRIGHT The copyright in this document is vested in Vector Kapuni Limited
 The contents of this document shall not be reproduced, either in whole or part, by any
 means whatsoever without the prior written consent of Vector Kapuni Limited.

DRN	DATE	ENG	APP	DATE
J.TERRILL	01/11/1991	C.SIEDZUK		01/11/1991
RDK	01/11/1991	B.NICHOLLS		01/02/1992

SCALE:	JOB NO.	SERIES	DRG. NO	SHT 01	REVISION
N/A	1000000	0104	0033	01	11

EQUIPMENT No.
DESCRIPTION
CAPACITY
MAWP @ TEMP

F-4001
BUTANE STORAGE VESSEL (30 TONNES)
4m
15.51 Barg @ 45/-10°C

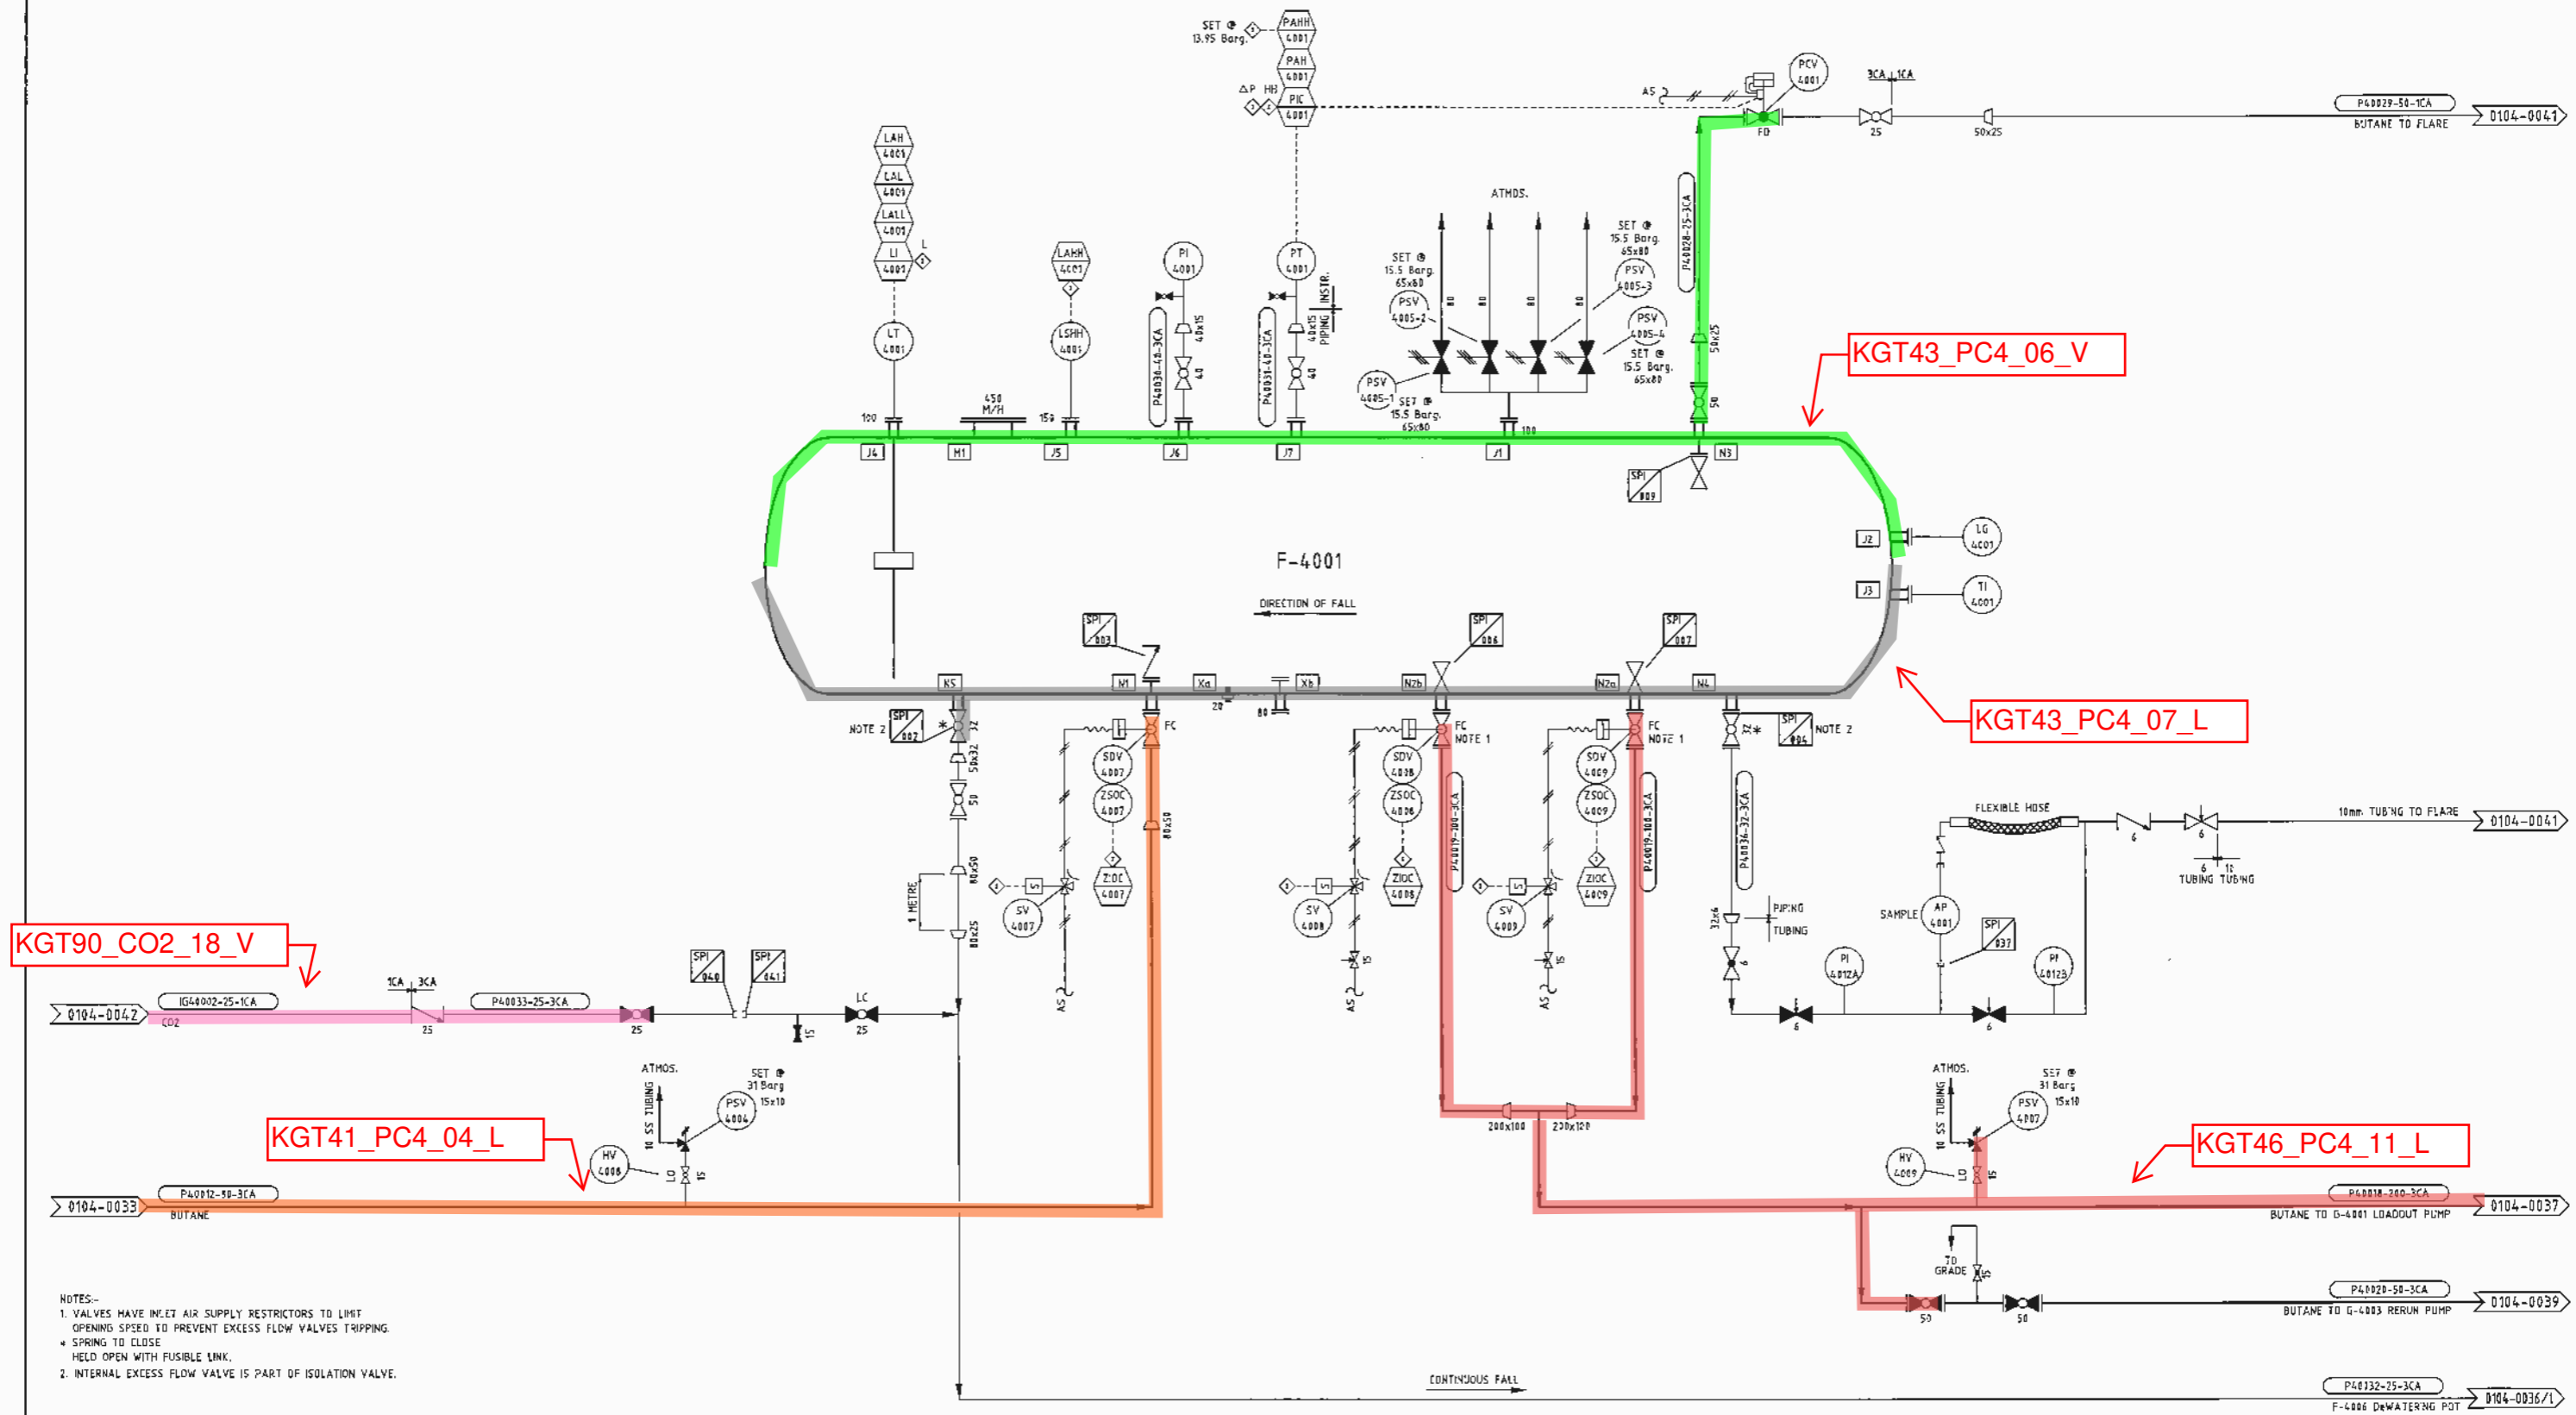

NOTES:-
1. VALVES HAVE INLET AIR SUPPLY RESTRICTORS TO LIMIT OPENING SPEED TO PREVENT EXCESS FLOW VALVES TRIPPING.
* SPRING TO CLOSE
HELD OPEN WITH FUSIBLE LINK.
2. INTERNAL EXCESS FLOW VALVE IS PART OF ISOLATION VALVE.

REV	AMENDMENT	BY	CHK	ENG	APP	DATE	REV	AMENDMENT	BY	CHK	ENG	APP	DATE
11	AS BUILT P64-1103 LPG BULLETS ACTUATION L/O VALVES	RL	ES	TC	JS	SES	06/2011						
10	AS BUILT WS1374282, SAP320481 LPG SAMPLE POINTS	RL	MS	LH	SES	06/2009							
9	AS BUILT WS1512171 PSV TAIL PIPE LENGTHS REDUCED	RL	JS	LH	SES	05/2009							
8	AS BUILT WS1604955-LPG RELIEF VALVE ISOLATION	ES	TL	LH	SES	07/08							
7	AS BUILT FOR PEP PROJECT WS822871	RL	RH	LH	GE	05/2004							
6	RELIEF VALVES ON F-4001 TAGGED, AS BUILT	JBH	RL	LH	AIM	15/04/03							
5	DESIGN DATA RATIONALISED FOR F-4001	CHW	RL	AVG	AIM	08/02							
4	SAMPLE POINT ADDED & VALVES ADDED TO SV-4008/4009	VB	RL	EJH	RS	10/78							
14	AS BUILT P64-1516 ADD EXCESS FLOW VALVES TO DRAINS	RL	JCC	NA	AM	06/2020							
15	HAND VALVE NUMBERS ADDED TO LOCKED VALVES	RL	JCC	AM	TC	07/2019							
12	BMPT 286-745 PSV TAIL PIPE REVISED	DL	CJ	AM	SES	12/2012							

VECTOR KAPUNI LIMITED
PRIVATE BAG 2020
NEW PLYMOUTH 4342
PHONE 0800 734 567

Vector

COPYRIGHT The copyright in this document is vested in Vector Kapuni Limited. The contents of this document shall not be reproduced, either in whole or part, by any means whatsoever without the prior written consent of Vector Kapuni Limited.

AUTOCAD ORIGINAL SHEET SIZE A1


DRN	J.TERRILL	01/11/199	ENG	C.SIEDZUK	01/11/1991
CHK	RDK	01/11/1991	APP	B.NICHOLLS	01/02/1992

SCALE:	JOB NO.	SERIES	DRG. NO	SHT 01 OF SHTS	REVISION
N/A	1000000	0104	0034	01	14

EQUIPMENT No.

DESCRIPTION
CAPACITY
MAWP @ TEMP

BUTANE STORAGE VESSEL 150 TONNES
113m³
17.24 Barg @ 50/0°C

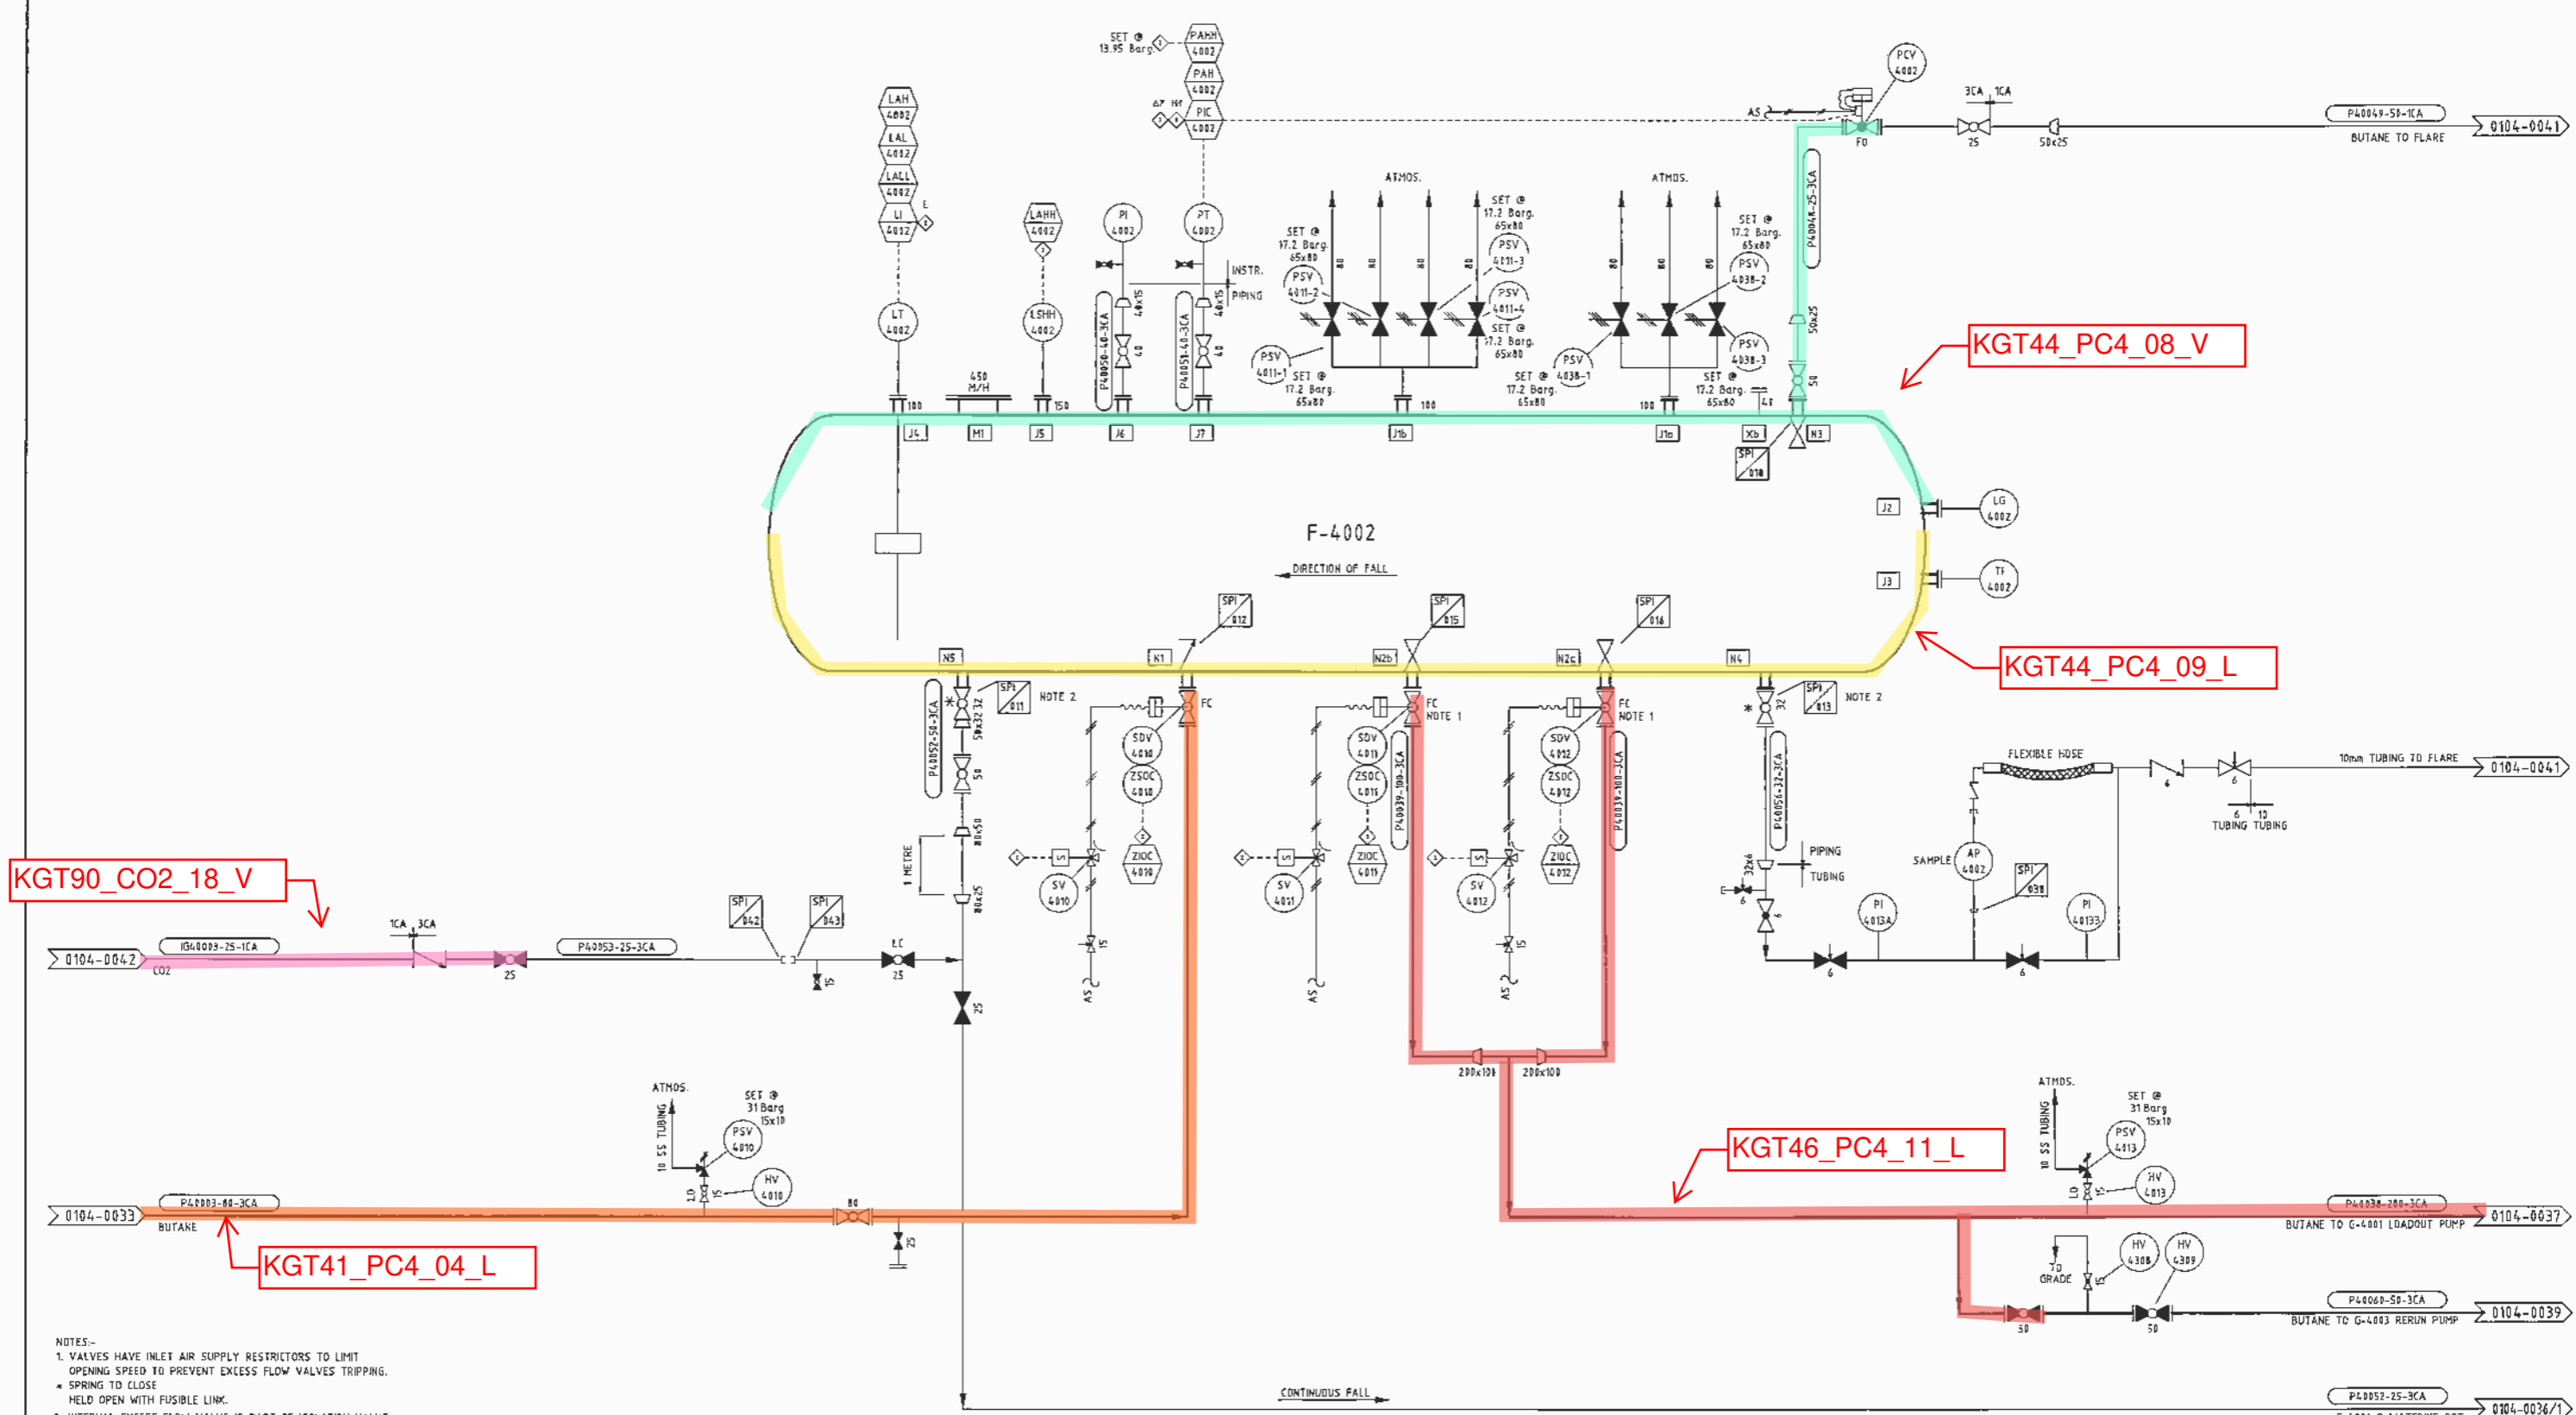

- NOTES:-
- VALVES HAVE INLET AIR SUPPLY RESTRICTORS TO LIMIT OPENING SPEED TO PREVENT EXCESS FLOW VALVES TRIPPING.
 - * SPRING TO CLOSE
 - * HELD OPEN WITH FUSIBLE LINK.
 - INTERNAL EXCESS FLOW VALVE IS PART OF ISOLATION VALVE.

REV	AMENDMENT	BY	CHK	ENG	APP	DATE	REV	AMENDMENT	BY	CHK	ENG	APP	DATE
11	AS BUILT P4-1103 LPG BULLETS ACTUATION L/O VALVES	RL	MS	LH	SES	06/2010							
10	AS BUILT WS3174282, SAP3028481 LPG SAMPLE POINTS	RL	MS	LH	SES	06/2009							
9	AS BUILT WS9512171 PSV TAIL PIPE LENGTHS REDUCED	RL	JS	LH	SES	05/2009							
8	AS BUILT WS94955-LPG RELIEF VALVE ISOLATION	ES	TL	LH	SES	07/08							
7	AS BUILT FOR PEP PROJECT WS822471	RL	RM	LH	GE	05/2004							
6	RELIEF VALVES DN F-4002 TAGGED, AS BUILT	JBH	RL	LH	AIM	15/04/13							
5	DESIGN DATA RATIONALIZED FOR F-4002-PSV-4038 SET PT	CMW	RL	AVG	AIM	08/12							
4	SAMPLE POINT ADDED & VALVES ADDED TO SV-4016/4012	VB	RL	EJH	RS	10/98							
3	AS BUILT COMMENTS INCORPORATED	V.B.	B.T.	A.V.G.	C.J.	5/95							
2	REDRAWN IN AUTOPLANT, WAS 104-12	D.R.	J.C.	G.M.	C.J.	10/94							

VECTOR KAPUNI LIMITED
PRIVATE BAG 2020
NEW PLYMOUTH 4342
PHONE 0800 734 567

COPYRIGHT The copyright in this document is vested in Vector Kapuni Limited. The contents of this document shall not be reproduced, either in whole or part, by any means whatsoever without the prior written consent of Vector Kapuni Limited.

AUTOCAD ORIGINAL SHEET SIZE A1

REFERENCE DRAWINGS

DRN	J.TERRILL	01/11/1991	ENG	C.SIEDZUIK	01/11/1991
CHK	RDK	01/11/1991	APP	B.NICHOLLS	01/02/1992

LPG LOADING FACILITY
PIPING & INSTRUMENT DIAGRAM
F-4002 STORAGE VESSEL


SCALE:	JOB NO.	SERIES	DRG. NO	SHT 01	REVISION
N/A	1000000	0104	0035	01	15

EQUIPMENT No.

DESCRIPTION
CAPACITY
MAWP @ TEMP

F-4003
PROPANE STORAGE VESSEL (50 TONNES)
13m³
15.51 Barg @ 45/0°C

F-4006
DeWATERING POT
0.34m³
17.24 Barg @ 54/-30°C

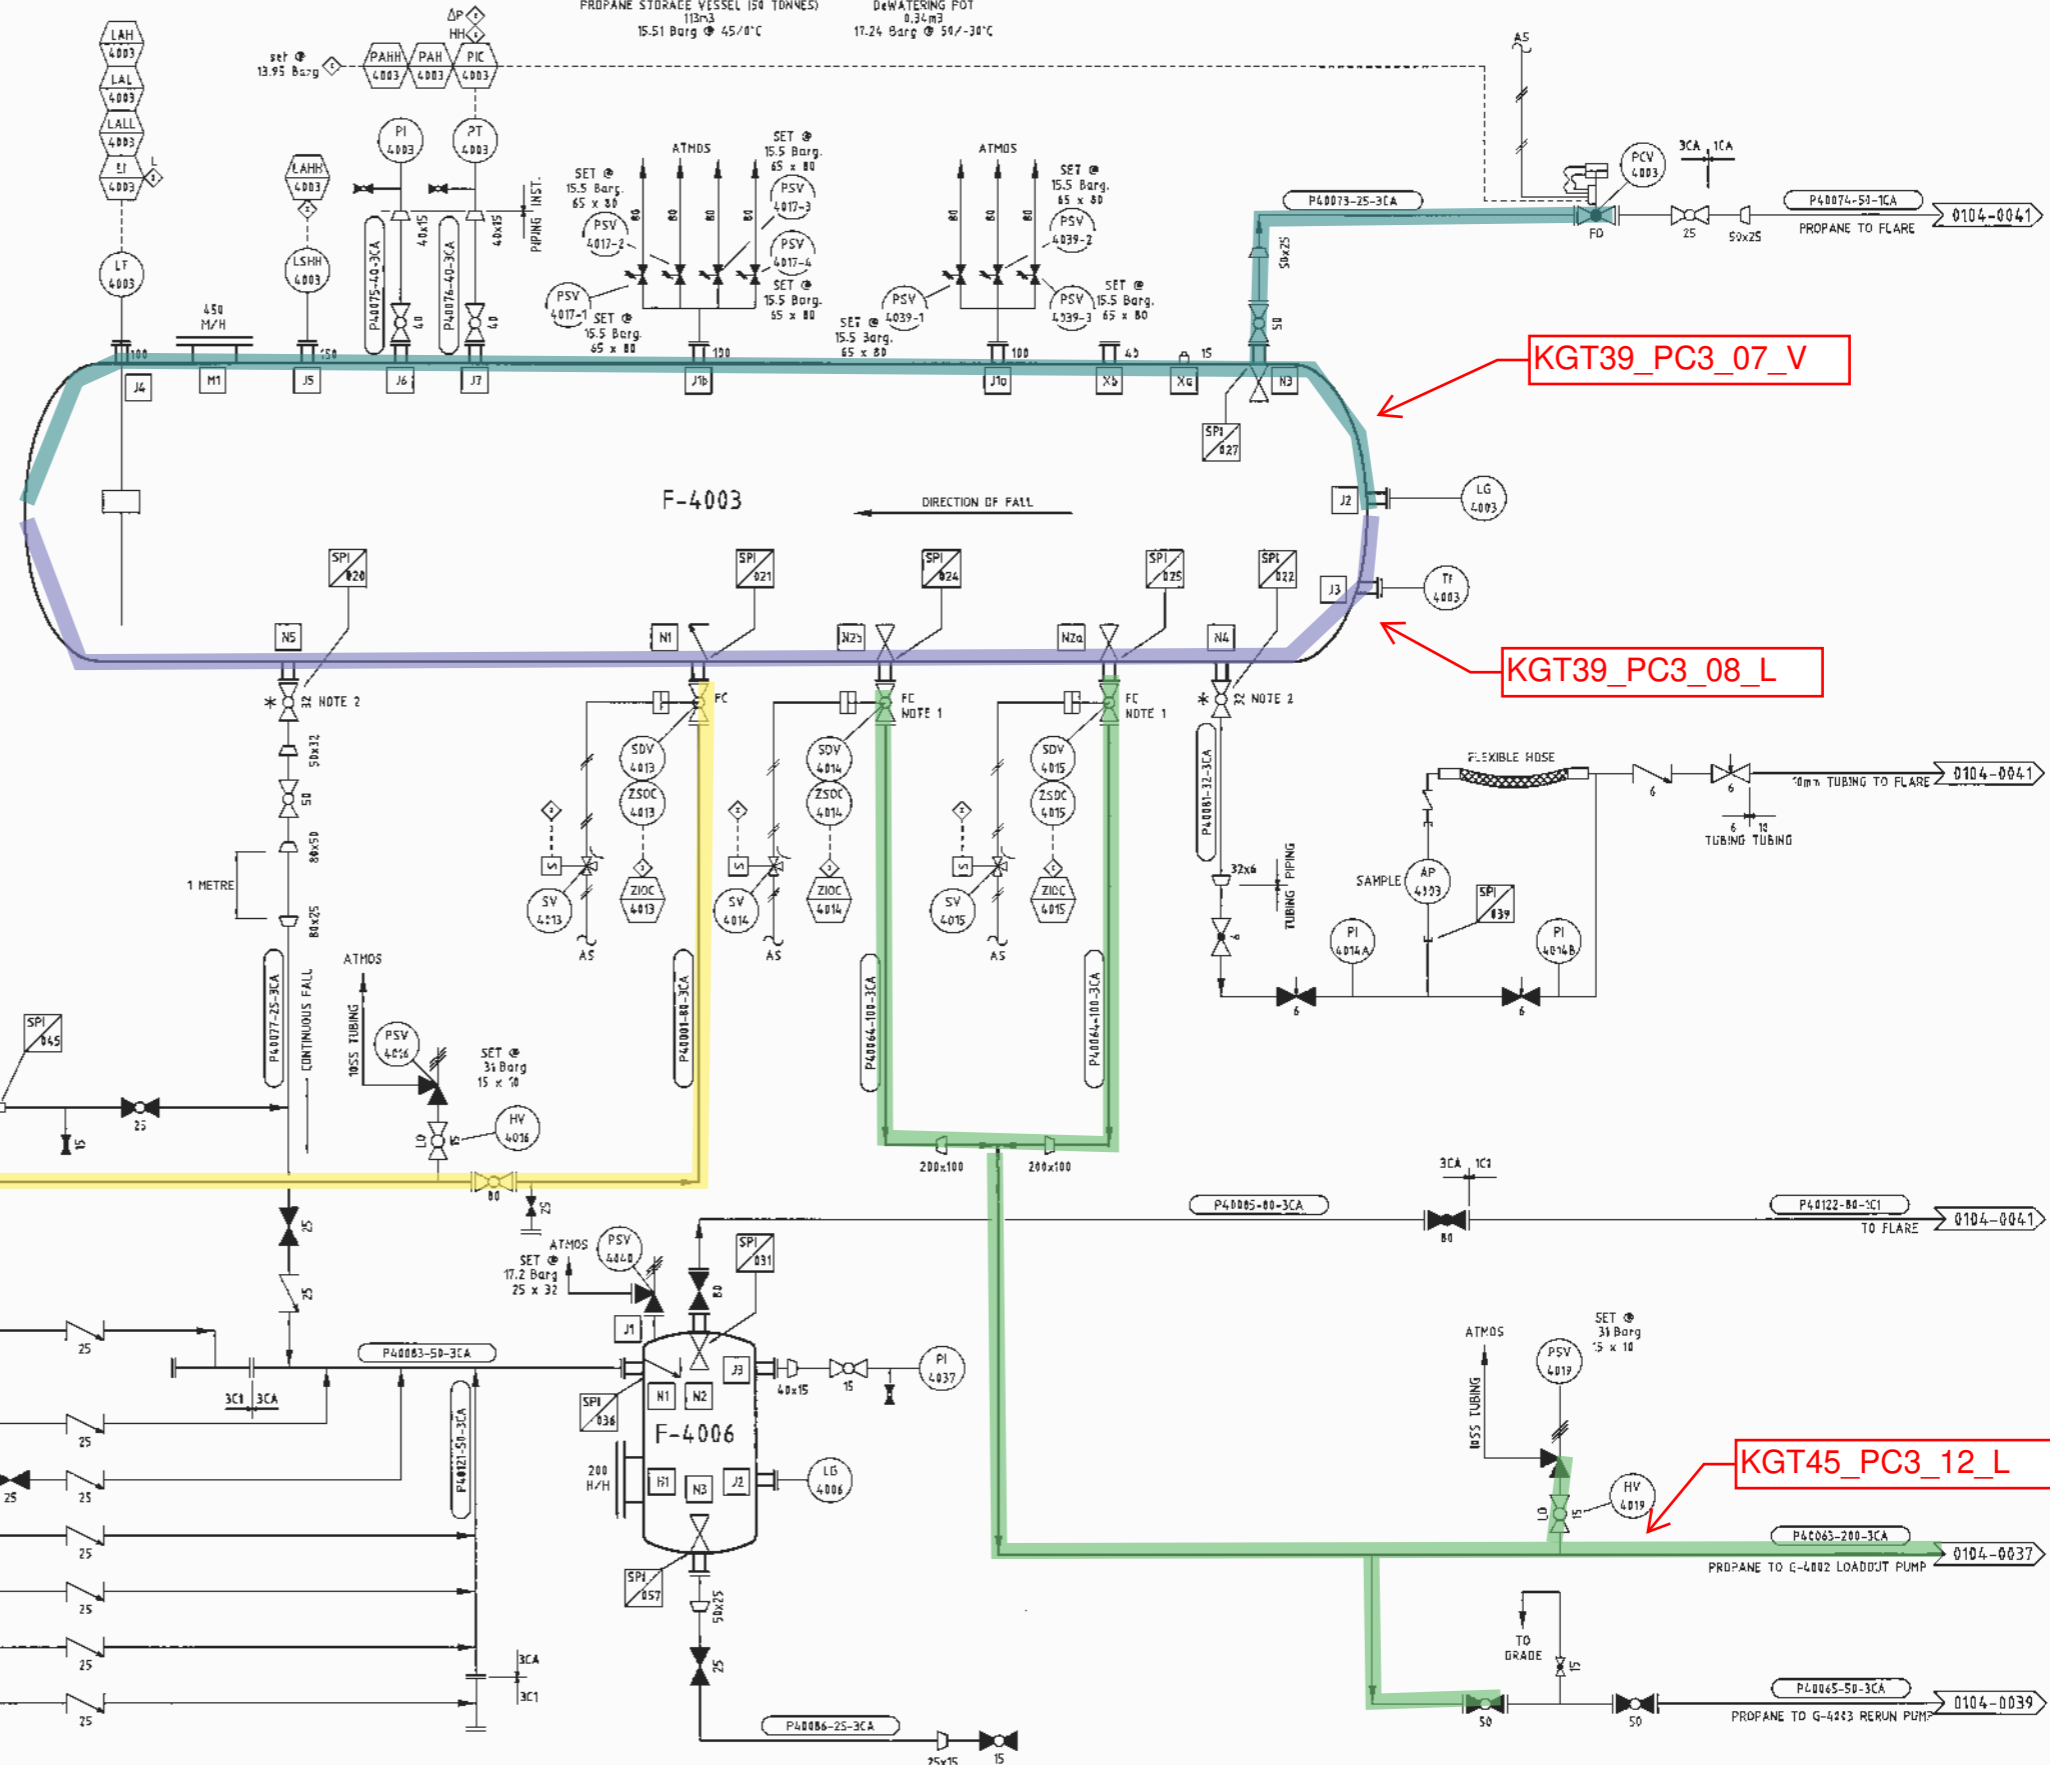

- NOTES:-
1. VALVES HAVE INLET AIR SUPPLY RESTRICTORS TO LIMIT OPENING SPEED TO PREVENT EXCESS FLOW VALVES TRIPPING.
* SPRING TO CLOSE
HELD OPEN WITH FUSIBLE LINK.
2. INTERNAL EXCESS FLOW VALVE IS PART OF ISOLATION VALVE.


KGT90_CO2_18_V

KGT39_PC3_07_V

KGT39_PC3_08_L

KGT37_PC3_05_L

KGT45_PC3_12_L

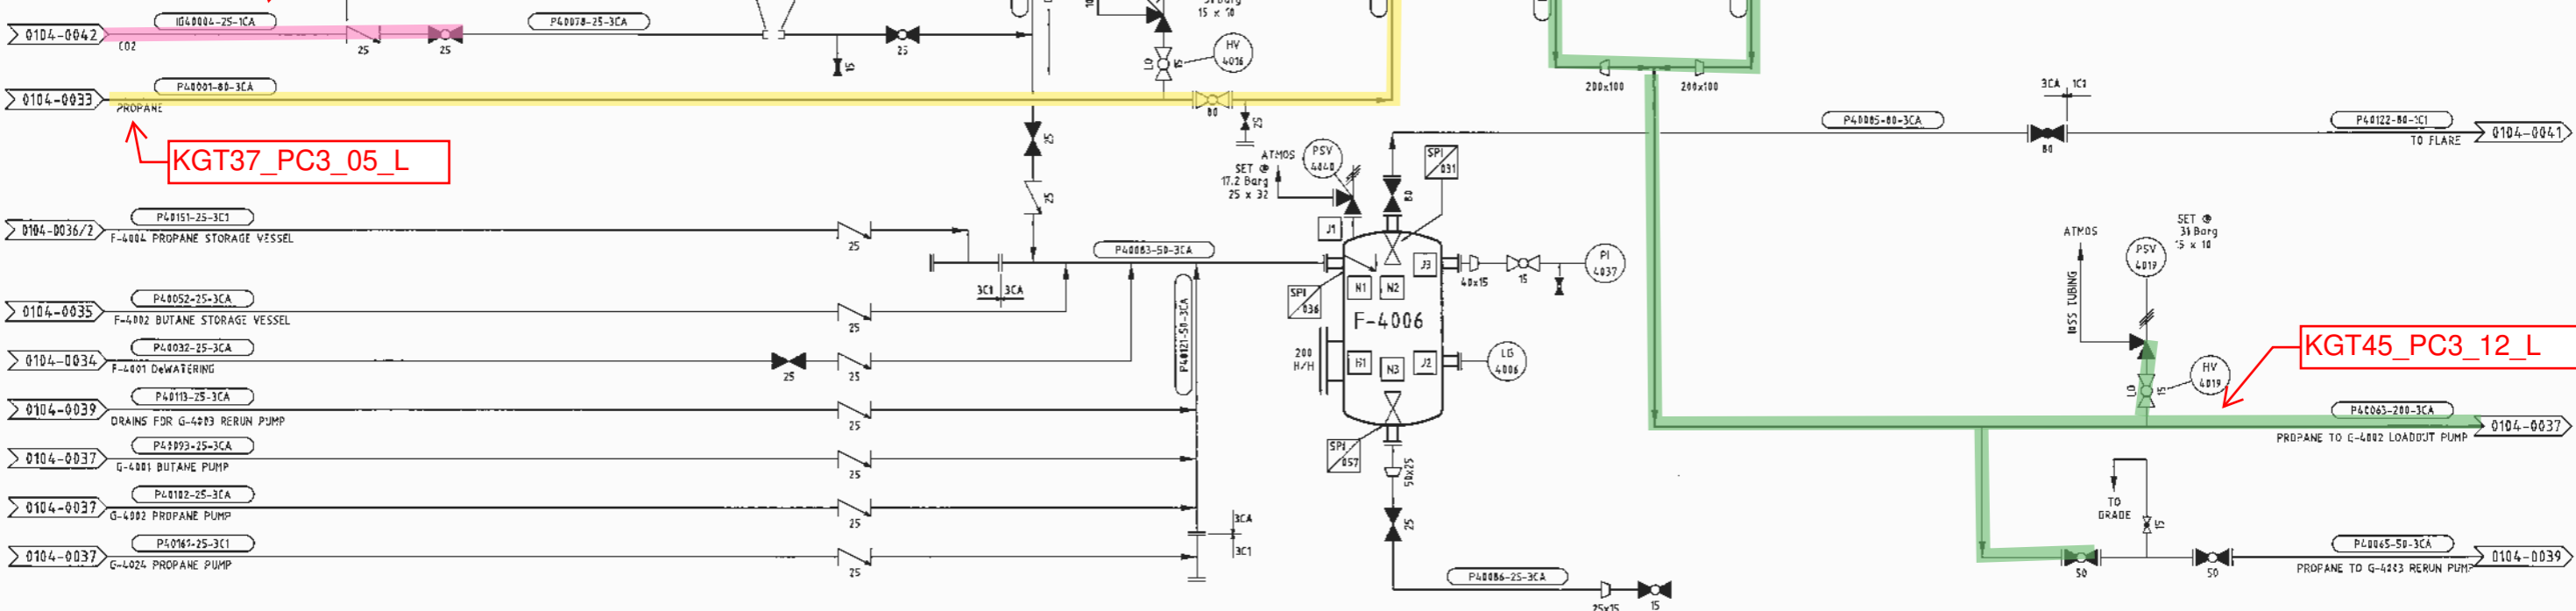

REV	AMENDMENT	BY	CHK	ENG	APP	DATE	REV	AMENDMENT	BY	CHK	ENG	APP	DATE
11	AS BUILT WS1970262_SAP3020411 LPG SAMPLE POINTS	RL	MS	LH	SES	06/2009							
10	AS BUILT WS1512171 PSV TAIL PIPE LENGTHS REDUCED	RL	JS	LH	SES	05/2009							
9	AS BUILT WS1404955 - PSV-4019 ISOLATION	RL	ES	LH	SES	11/2008							
8	AS BUILT WS1404955-LPG RELIEF VALVE ISOLATION	ES	TL	LH	SES	17/08							
7	AS BUILT FOR PEP PROJECT WS422971	RL	RH	LH	GE	05/2004							
6	RELIEF VALVES ON F-4003 TAGGED, AS BUILT	JBH	RL	LH	AIM	15/04/03							
5	F-4133, 4006 DESIGN DATA & PSV-4040 SP RATIONALISED	JBH	RL	AvG	AIM	08/02							
4	SAMPLE POINT ADDED, F-4104 CAPACITY MODIFICATION	VB	RL	EJH	RS	10/98							
3	AS BUILT COMMENTS INCORPORATED	V.B.	B.T.	A.V.G.	C.J.	5/95							
2	REDRAWN ON AUTOPLANT, WAS 0104-0019	V.B.	J.C.	G.M.	C.J.	09/94							

VECTOR KAPUNI LIMITED
PRIVATE BAG 2020
NEW PLYMOUTH 4342
PHONE 0800 734 567

Vector

COPYRIGHT The copyright in this document is vested in Vector Kapuni Limited. The contents of this document shall not be reproduced, either in whole or part, by any means whatsoever without the prior written consent of Vector Kapuni Limited.

AUTOCAD ORIGINAL SHEET SIZE A1

REFERENCE DRAWINGS

DRN	J.TERRILL	01/11/1991	ENG	C.SIEDZUIK	01/11/1991
CHK	R.D.K.	01/11/1991	APP	B.NICHOLLS	01/02/1992


LPG LOADING FACILITY
PIPING & INSTRUMENT DIAGRAM
F-4003 STORAGE VESSEL

SCALE:	JOB NO.	SERIES	DRG. NO	SHT 01	REVISION
N/A	1000000	0104	0036	OF 02	16

1000000-0104-0036-01.DWG

EQUIPMENT No.
DESCRIPTION
CAPACITY
MAWP @ TEMP

F-4004
PROPANE STORAGE VESSEL 1100 TONNES
230m³
15.5 Barg @ 40/-11°C

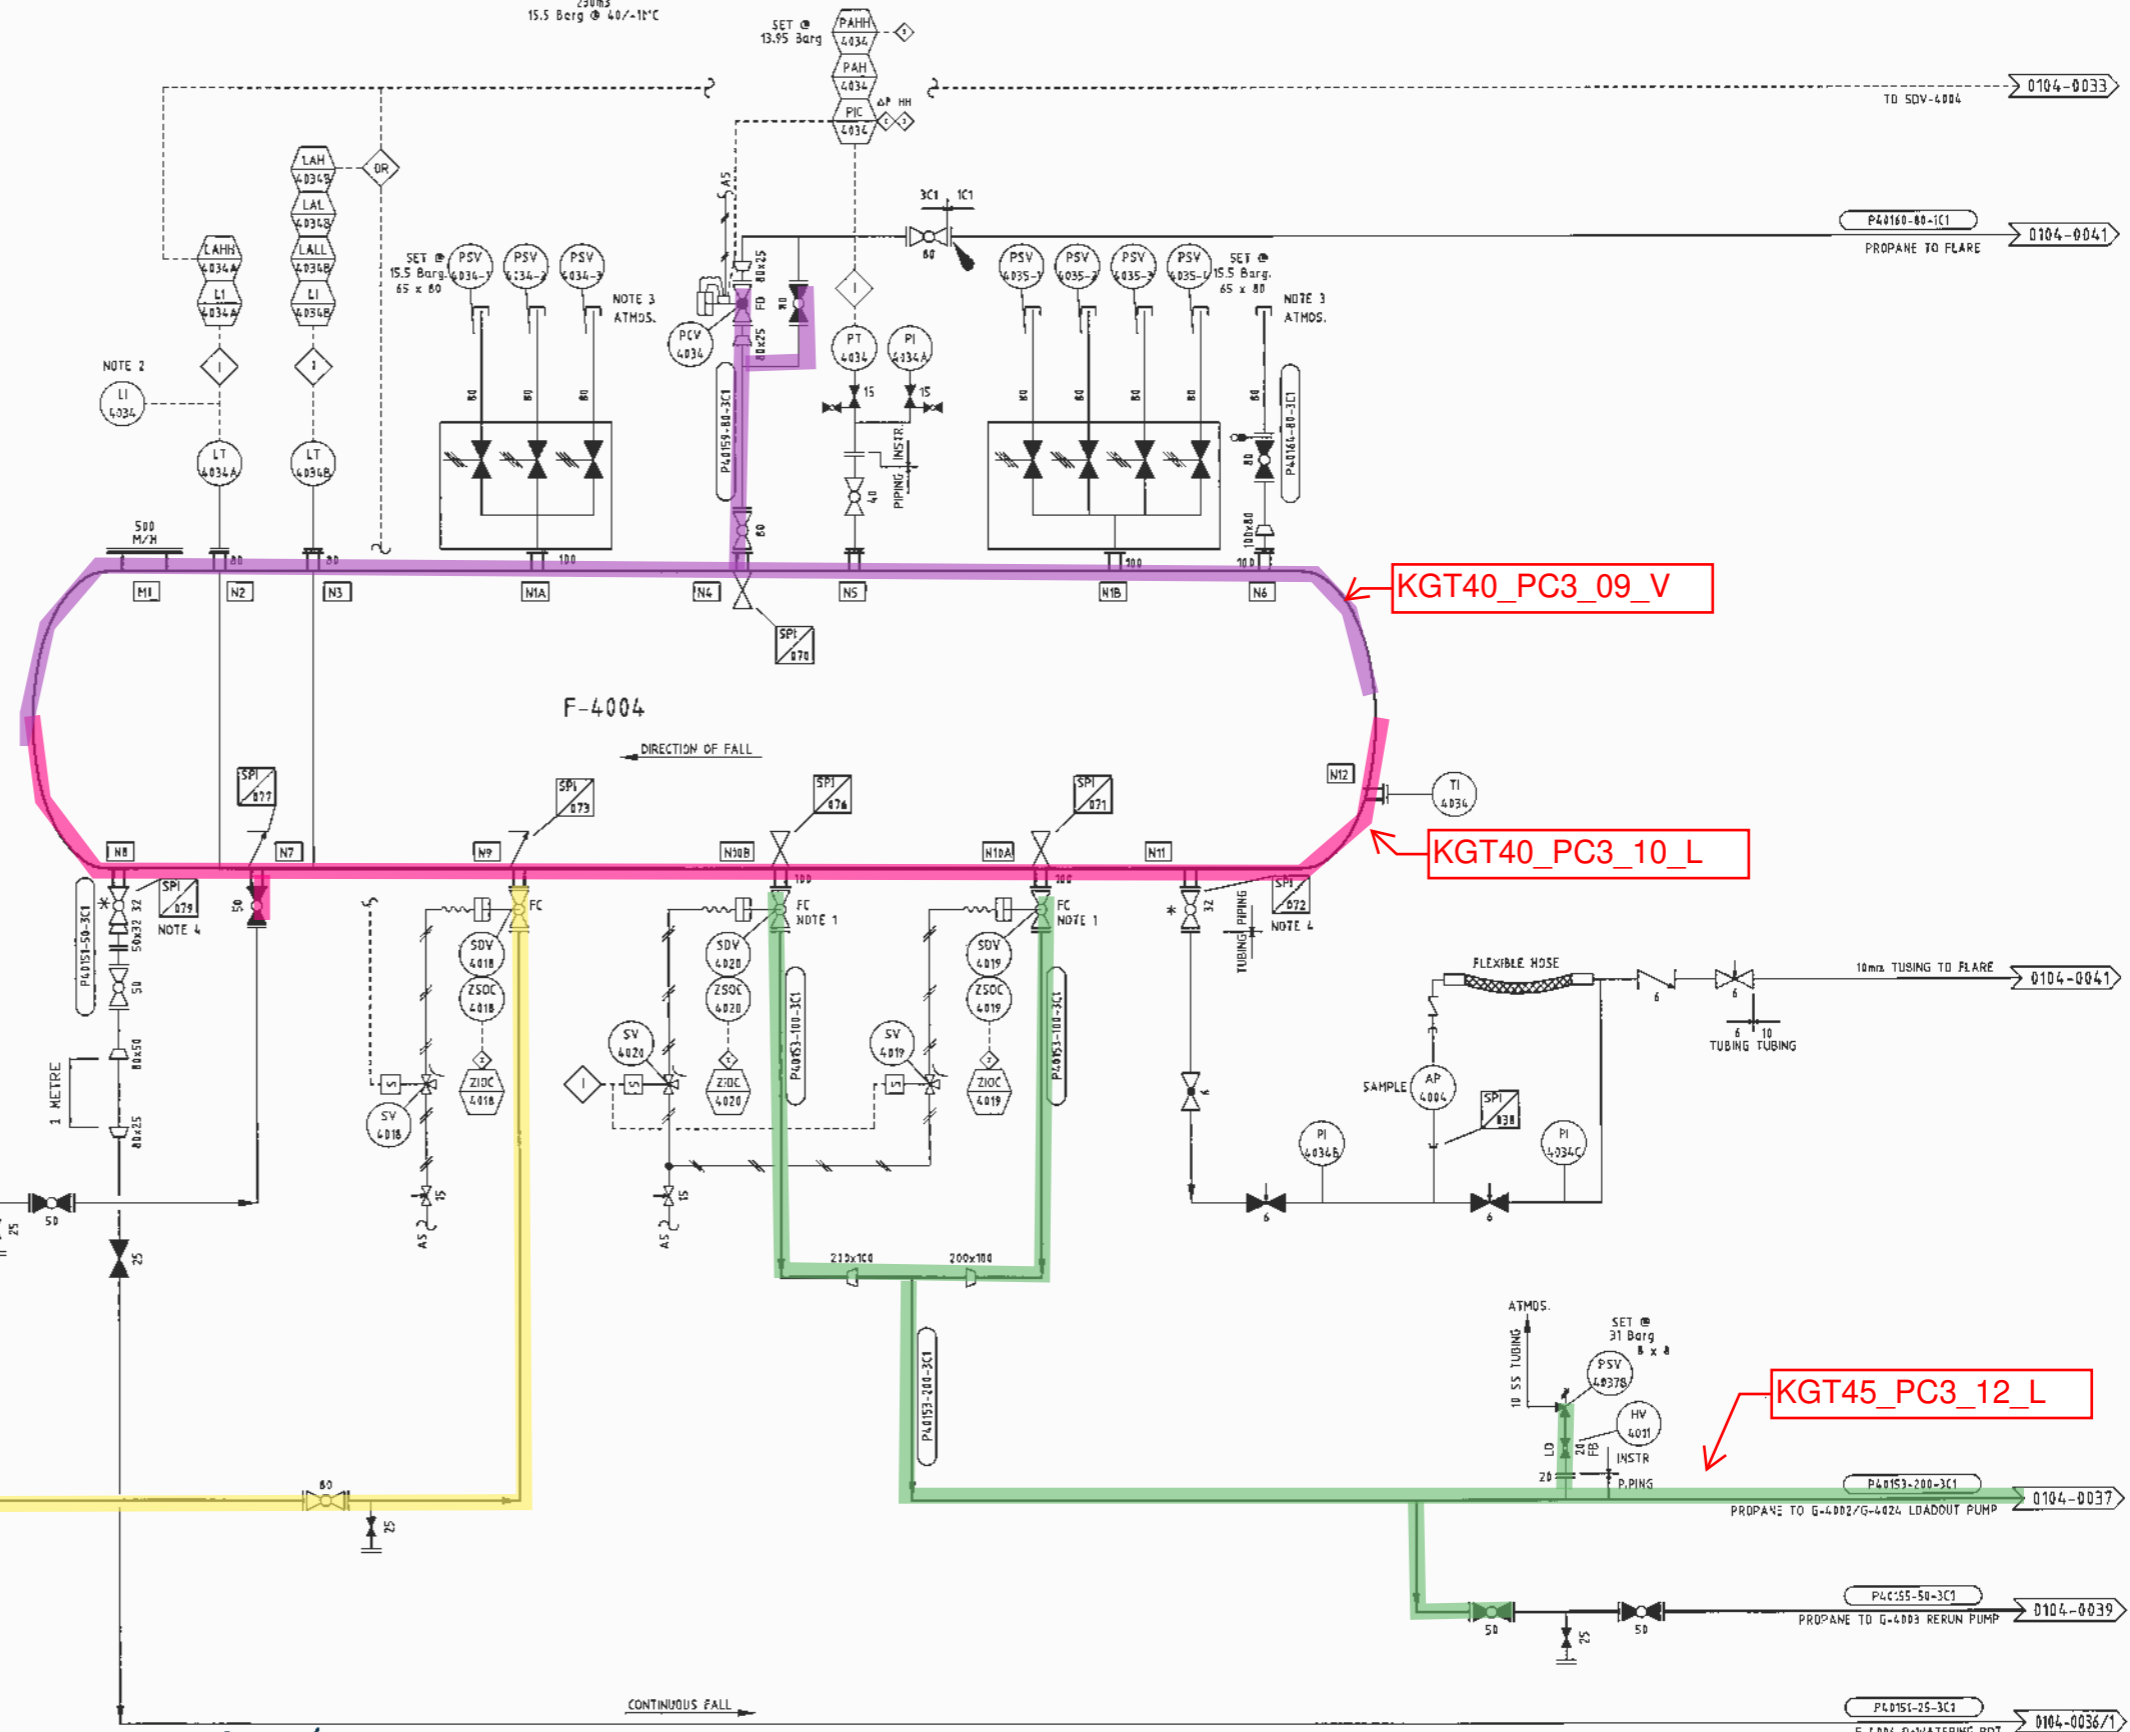

KGT90_CO2_18_V

KGT40_PC3_09_V

KGT40_PC3_10_L

KGT37_PC3_05_L

KGT45_PC3_12_L

- NOTES--
1. VALVES HAVE INLET AIR SUPPLY RESTRICTORS TO LIMIT OPENING SPEED TO PREVENT EXCESS FLOW VALVES TRIPPING.
 2. LEVEL INDICATOR TO BE CLEARLY VISIBLE AT GRADE.
 3. WEATHER PROTECTION FOR RELIEF VALVE DISCHARGE.
 4. INTERNAL EXCESS FLOW VALVE IS PART OF ISOLATION VALVE.

REV	AMENDMENT	BY	CHK	ENG	APP	DATE	REV	AMENDMENT	BY	CHK	ENG	APP	DATE
10	AS BUILT P84-1557, PSV-4037-A & P84-1575 NOTE 4	RL	JEC	CC/NA	AM	06/2020							
9	AS BUILT P84-1557 LOCKED OPEN VALVE ADDED TO PSV-4337B	RL	JEC	AM	TC	11/2019							
8	AS BUILT P84-1483 & SPI ADDED TO NOZZLE N4	RL	MW	AM	TC	03/2019							
7	AS BUILT P84-1253 PLC CHANGEOUT, SPEC BLIND, PSV	JCE	RL/CEB	AM	SES	01/2016							
6	BUILT P84-945 PSV TAIL PIPE REVISED	DL	CJ	AM	SES	12/2012							
5	AS BUILT P84-1043 LPG BULLETS ACTUATION L/O VALVES	RL/ES	TC	JS	SES	06/2011							
4	AS BUILT W51374282, SAP3220401 LPG SAMPLE POINTS	RL	MS	LH	SES	06/2009							
3	AS BUILT W51372171 PSV TAIL PIPE LENGTHS REDUCED	RL	JS	LH	SES	05/2009							
2	AS BUILT W51392131 F-4004 LVL INPUT RATIONALISATION	ES	AAB	LH	SES	08/08							
1	AS BUILT FOR PEP PROJECT W5022071	RL	RH	LH	GE	05/2006							

VECTOR KAPUNI LIMITED
PRIVATE BAG 2020
NEW PLYMOUTH 4342
PHONE 0800 734 567

Vector

COPYRIGHT The copyright in this document is vested in Vector Kapuni Limited
The contents of this document shall not be reproduced, either in whole or part, by any
means whatsoever without the prior written consent of Vector Kapuni Limited.

AUTOCAD ORIGINAL SHEET SIZE A1

REFERENCE DRAWINGS


DRN	T	ALLERTON	DATE	ENG	L HUNT	DATE
CHK	G	ROBERTSON	03/03/2003	APP	G EATON	03/03/2003

LPG LOADING FACILITY
PIPING & INSTRUMENT DIAGRAM
F-4004 STORAGE VESSEL

SCALE:	JOB NO.	SERIES	DRG. NO	SHT	OF	REVISION
NTS	1000000	0104	0036	02	02	10

1000000-0104-0036-02.DWG

EQUIPMENT No.
DESCRIPTION
CAPACITY
MAWP @ TEMP

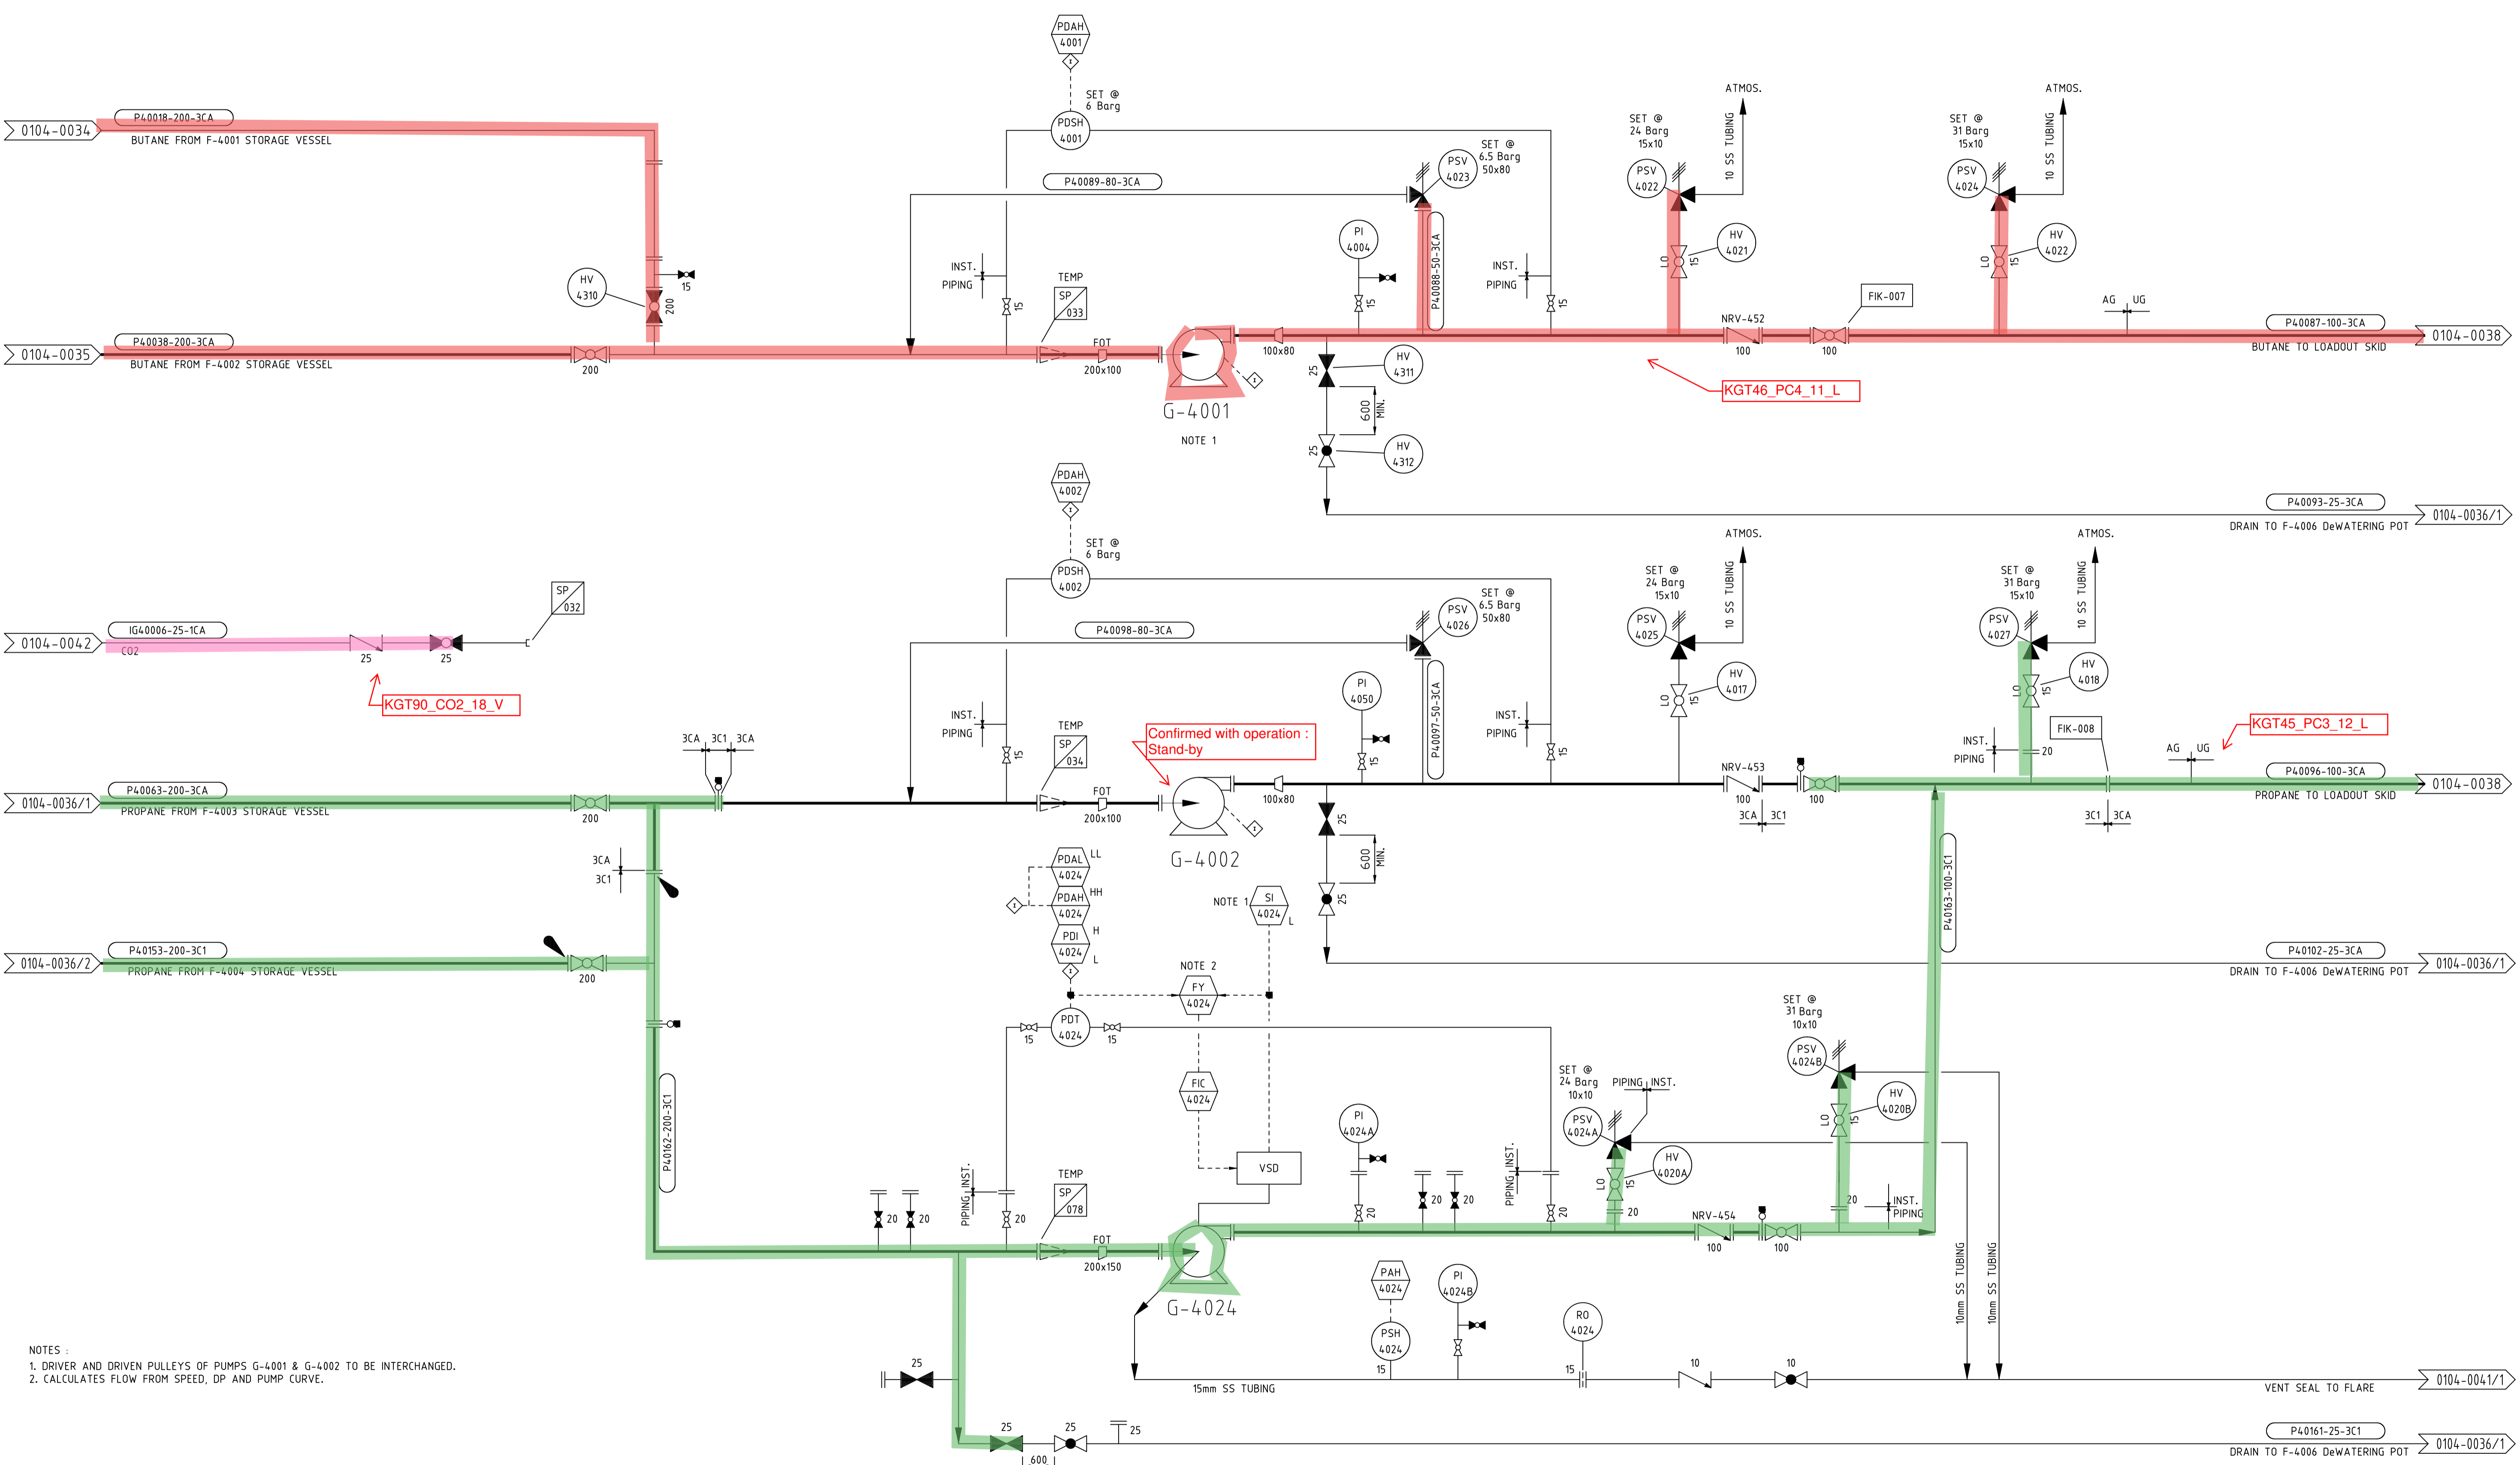

NOTES:
1. DRIVER AND DRIVEN PULLEYS OF PUMPS G-4001 & G-4002 TO BE INTERCHANGED.
2. CALCULATES FLOW FROM SPEED, DP AND PUMP CURVE.

REV	AMENDMENT	BY	CHK	ENG	APP	DATE	REV	AMENDMENT	BY	CHK	ENG	APP	DATE
7						01/2017							
6						07/08							
5						05/2004							
4						08/02							
3						10/99							
2						5/95							
1						10/94							

VECTOR KAPUNI LIMITED
PRIVATE BAG 2020
NEW PLYMOUTH 4342
PHONE 0800 734 567



COPYRIGHT The copyright in this document is vested in Vector Kapuni Limited
The contents of this document shall not be reproduced, either in whole or part, by any
means whatsoever without the prior written consent of Vector Kapuni Limited.

REFERENCE DRAWINGS
CAUSE & EFFECTS - 0780-0030/1 & 2

DRN	J. TERRILL	01/11/1991	ENG	C. SIEDZUIK	01/11/1991
CHK	RDK	01/11/1991	APP	B. NICHOLLS	01/02/1992


LPG LOADING FACILITY
PIPING & INSTRUMENT DIAGRAM
LOADOUT PUMPS
VSD OPTION

SCALE:	JOB NO.	SERIES	DRG. NO	SHT 01	REVISION
N/A	1000000	0104	0037	01 OF SHTS	7

EQUIPMENT No.

DESCRIPTION
CAPACITY
MAWP @ TEMP

T-4003 NATURAL GASOLINE LOADOUT ARM 50m³/hr
T-4002 LPG LOADOUT ARM 24Barg @ -48/120°C
T-4001 WEIGHBRIDGE

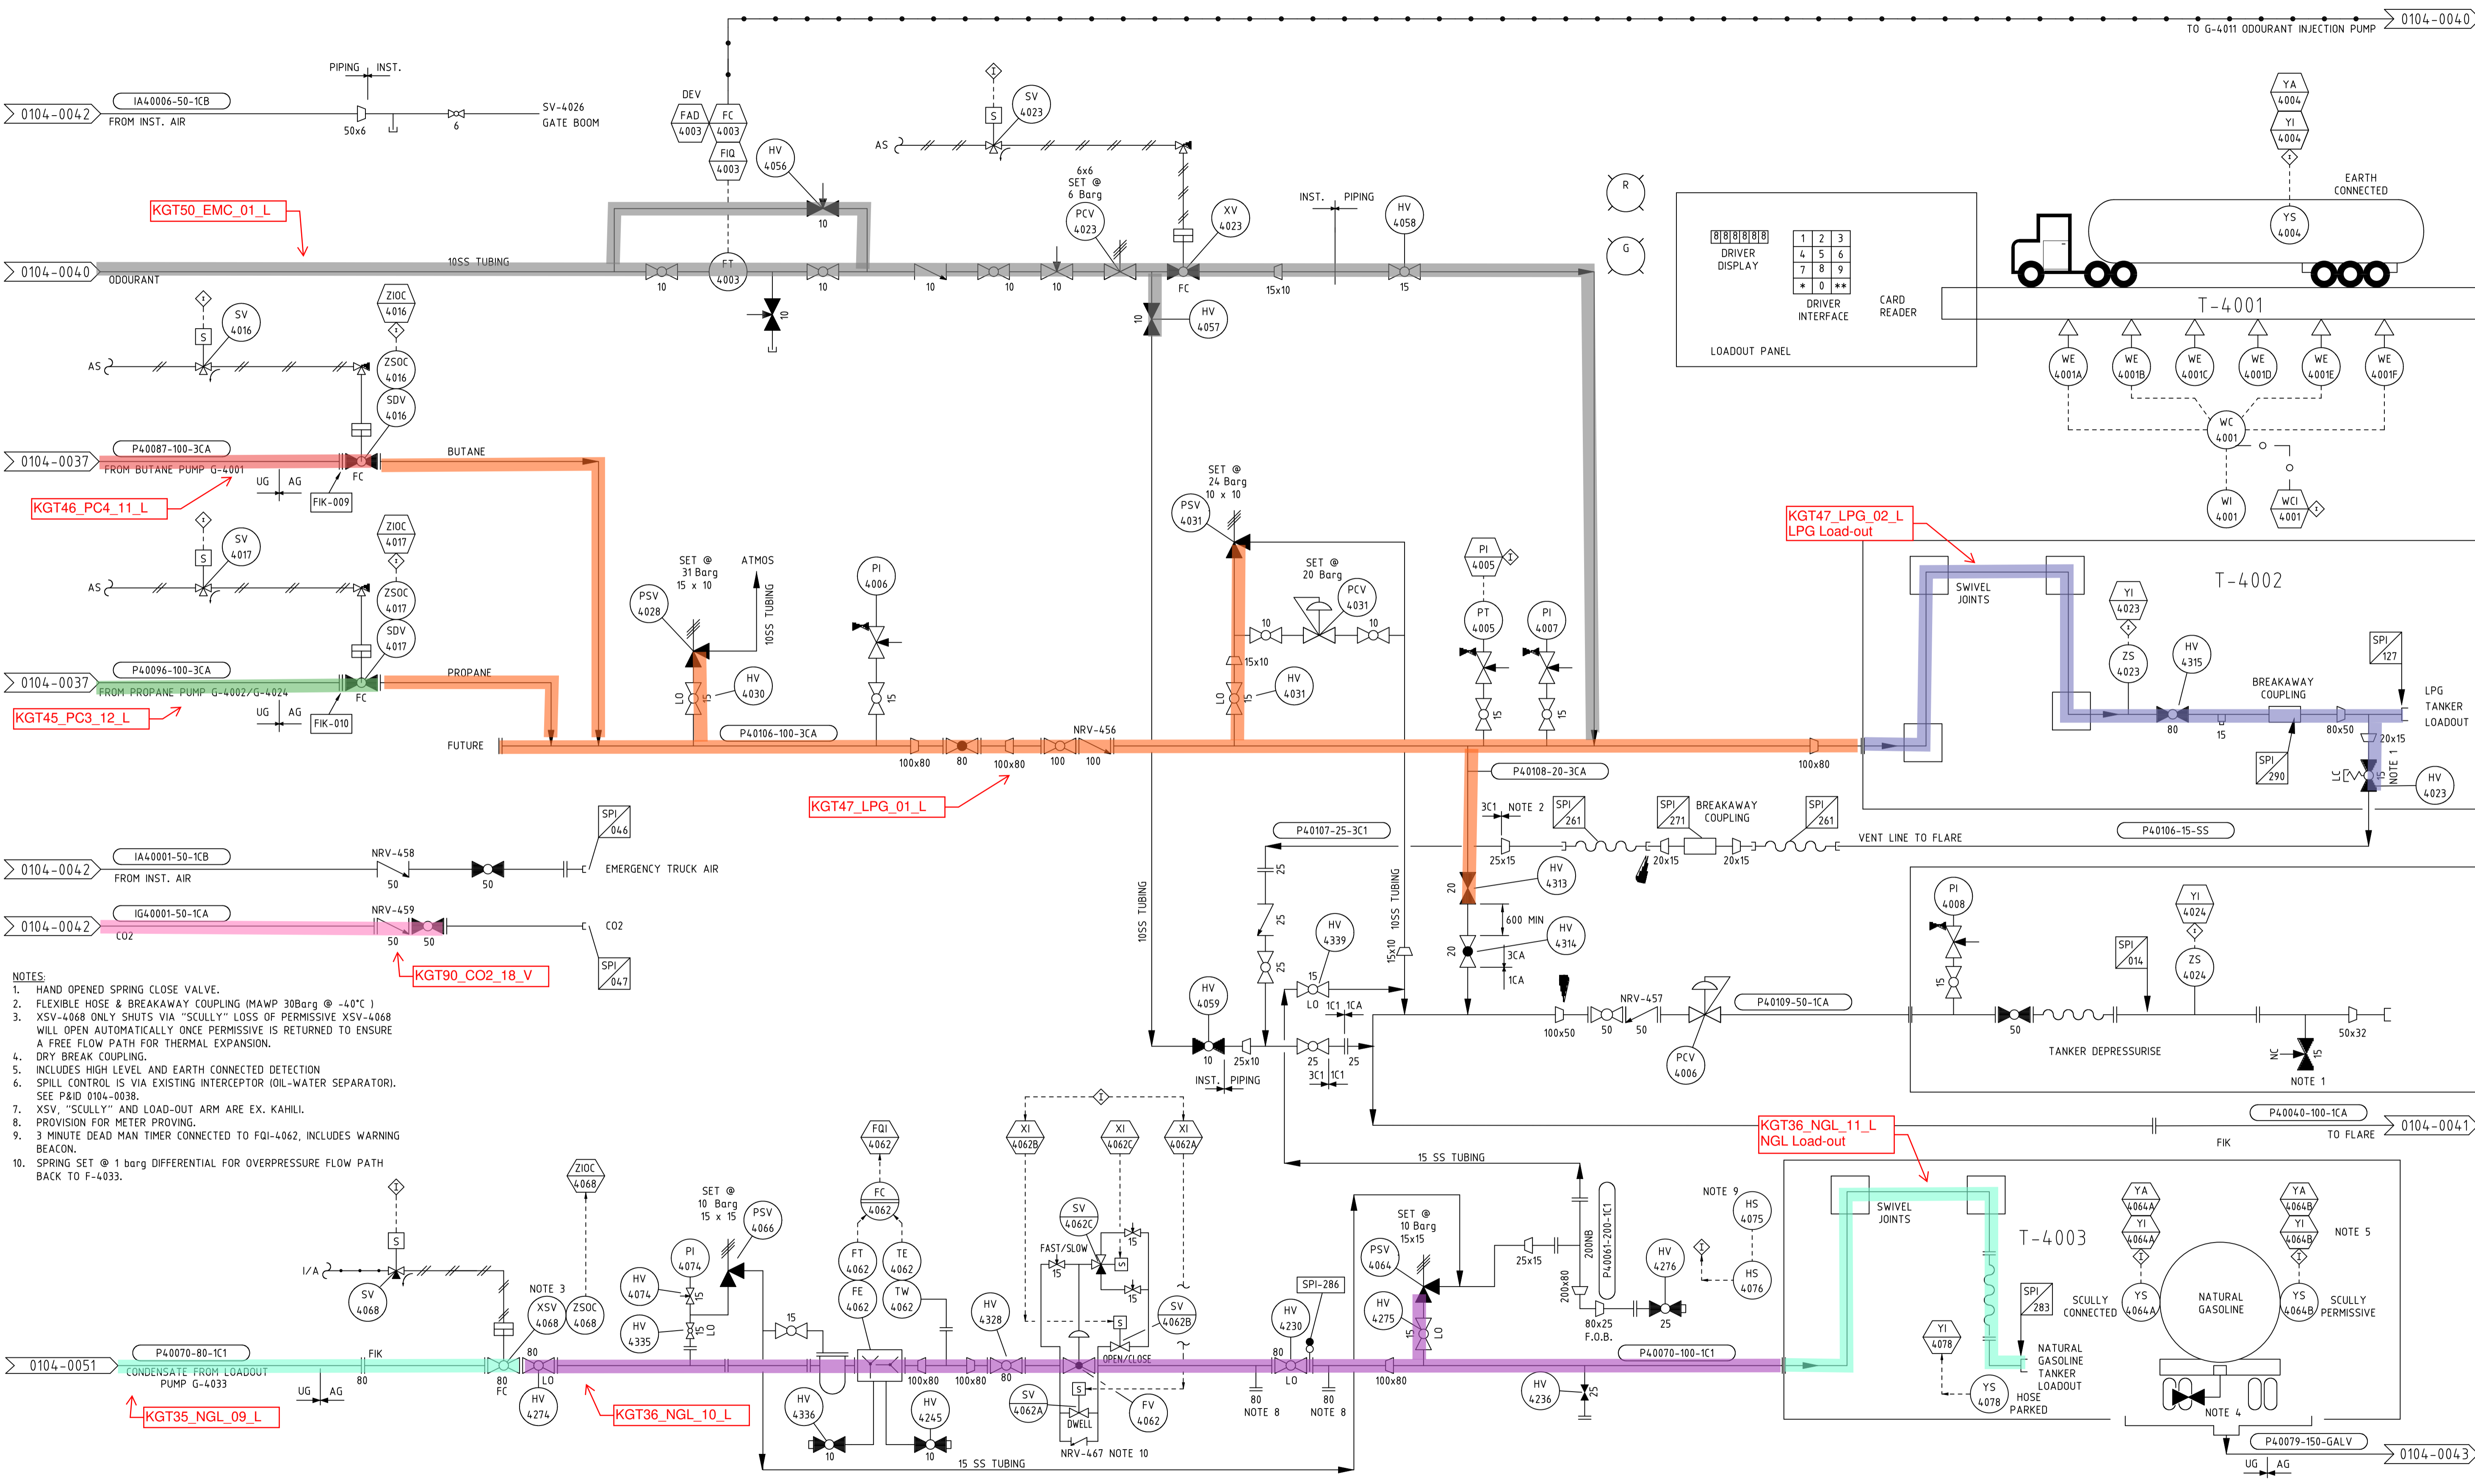

- NOTES:
- HAND OPENED SPRING CLOSE VALVE.
 - FLEXIBLE HOSE & BREAKAWAY COUPLING (MAWP 30Barg @ -40°C)
 - XSV-4068 ONLY SHUTS VIA "SCULLY" LOSS OF PERMISSIVE XSV-4068 WILL OPEN AUTOMATICALLY ONCE PERMISSIVE IS RETURNED TO ENSURE A FREE FLOW PATH FOR THERMAL EXPANSION.
 - DRY BREAK COUPLING.
 - INCLUDES HIGH LEVEL AND EARTH CONNECTED DETECTION
 - SPILL CONTROL IS VIA EXISTING INTERCEPTOR (OIL-WATER SEPARATOR). SEE P&ID 0104-0038.
 - XSV, "SCULLY" AND LOAD-OUT ARM ARE EX. KAHILL.
 - PROVISION FOR METER PROVING.
 - 3 MINUTE DEAD MAN TIMER CONNECTED TO FQI-4062, INCLUDES WARNING BEACON.
 - SPRING SET @ 1 barg DIFFERENTIAL FOR OVERPRESSURE FLOW PATH BACK TO F-4033.

REV	AMENDMENT	BY	CHK	ENG	APP	DATE	REV	AMENDMENT	BY	CHK	ENG	APP	DATE
22	AS BUILT SPI-290 AND LINE NUMBER P40106 ADDED	RL	JCC	AM	TC	07/2019	11	AS BUILT FOR PROJECT P84-3022	SA	CJ	WB	LH	08/2010
21	AS BUILT P84-1502 REDUCE NG LOADOUT LINE OPERATING PRESSURE	RL	DW	AM	TC	08/2018	10	PIPING AND VALVES AS BUILT ON LINE P40109-50-1CA	RL	WB	LH	SES	01/2010
20	AS BUILT - P84-1310 PERMANENT NATURAL GASOLINE STORAGE	JT	DV	AM	SES	09/2017	9	AIR LINE TO GATE BOOM AS BUILT	RL	WB	LH	SES	11/2009
19	HAND VALVE NUMBERS ADDED FOR ISOLATIONS	RL	JCC	AM	SES	01/2017	8	AS BUILT WS1404955-LPG RELIEF VALVE ISOLATION	ES	TL	LH	SES	07/08
18	AS BUILT TAG CHANGE PCV-4023 & CLARITY TO T-4002	JCC	RL	AM	SES	04/2016	7	AS BUILT FOR PEP PROJECT WS822071	RL	RH	LH	GE	05/2004
17	AS BUILT P84-1253 PLC CHANGEOUT, HV TAGS	JCC	RL/CB	AM	SES	01/2016	6	25mm FLANGE ADDED TO P40040-100-1CA, AS BUILT	JBH	RL	H/MB	PJR	11/09/03
16	HAND VALVE AND NON RETURN VALVE NUMBERS ADDED	RL	JCC	AM	SES	09/2015	5	HV-4003 TAG ADDED, PCV-4003 ADDED	VB	RL	EJH	RS	10/98
15	AS BUILT P84-231 REPLACE LPG LOADOUT ARM	JB	CJ	AM	SES	06/2015	4	NEEDLE VALVE ADDED UPSTREAM OF SDV 4023.	P.T.D.	R.L.	A.V.G.	J.B.G.	08/95
14	AS BUILT P84-231 PCV-4031 ADDED TO LOADOUT ARM	ES	CJ	AM	SES	12/13	3	AS BUILT COMMENTS INCORPORATED	V.B	B.T.	A.V.G.	C.J.	5/95
13	HV-4023 ADDED	JB	KH	JS	SES	05/11	2	REDRAWN ON AUTOPLANT, WAS 0104-0015	V.B.	J.C.	G.M.	C.J.	09/94

VECTOR KAPUNI LIMITED
PRIVATE BAG 2020
NEW PLYMOUTH 4342
PHONE 0800 734 567

REFERENCE DRAWINGS
CAUSE & EFFECTS - 0780-0030/1 & 2

LPG LOADING FACILITY
PIPING & INSTRUMENT DIAGRAM
TANKER FILLING


COPYRIGHT The copyright in this document is vested in Vector Kapuni Limited
The contents of this document shall not be reproduced, either in whole or part, by any
means whatsoever without the prior written consent of Vector Kapuni Limited.

DRN	J.TERRILL	02/11/1991	ENG	C.SIEDZUK	02/11/1991
CHK	R.D.K	02/11/1991	APP	B.NICHOLLS	02/02/1992

SCALE:	JOB NO.	SERIES	DRG. NO	SHT 01	REVISION
NTS	1000000	0104	0038	01	22

EQUIPMENT No.
DESCRIPTION
CAPACITY
MAWP @ TEMP

G-4003
OFF-SPEC RERUN PUMP
6m³/hr
8 Barg

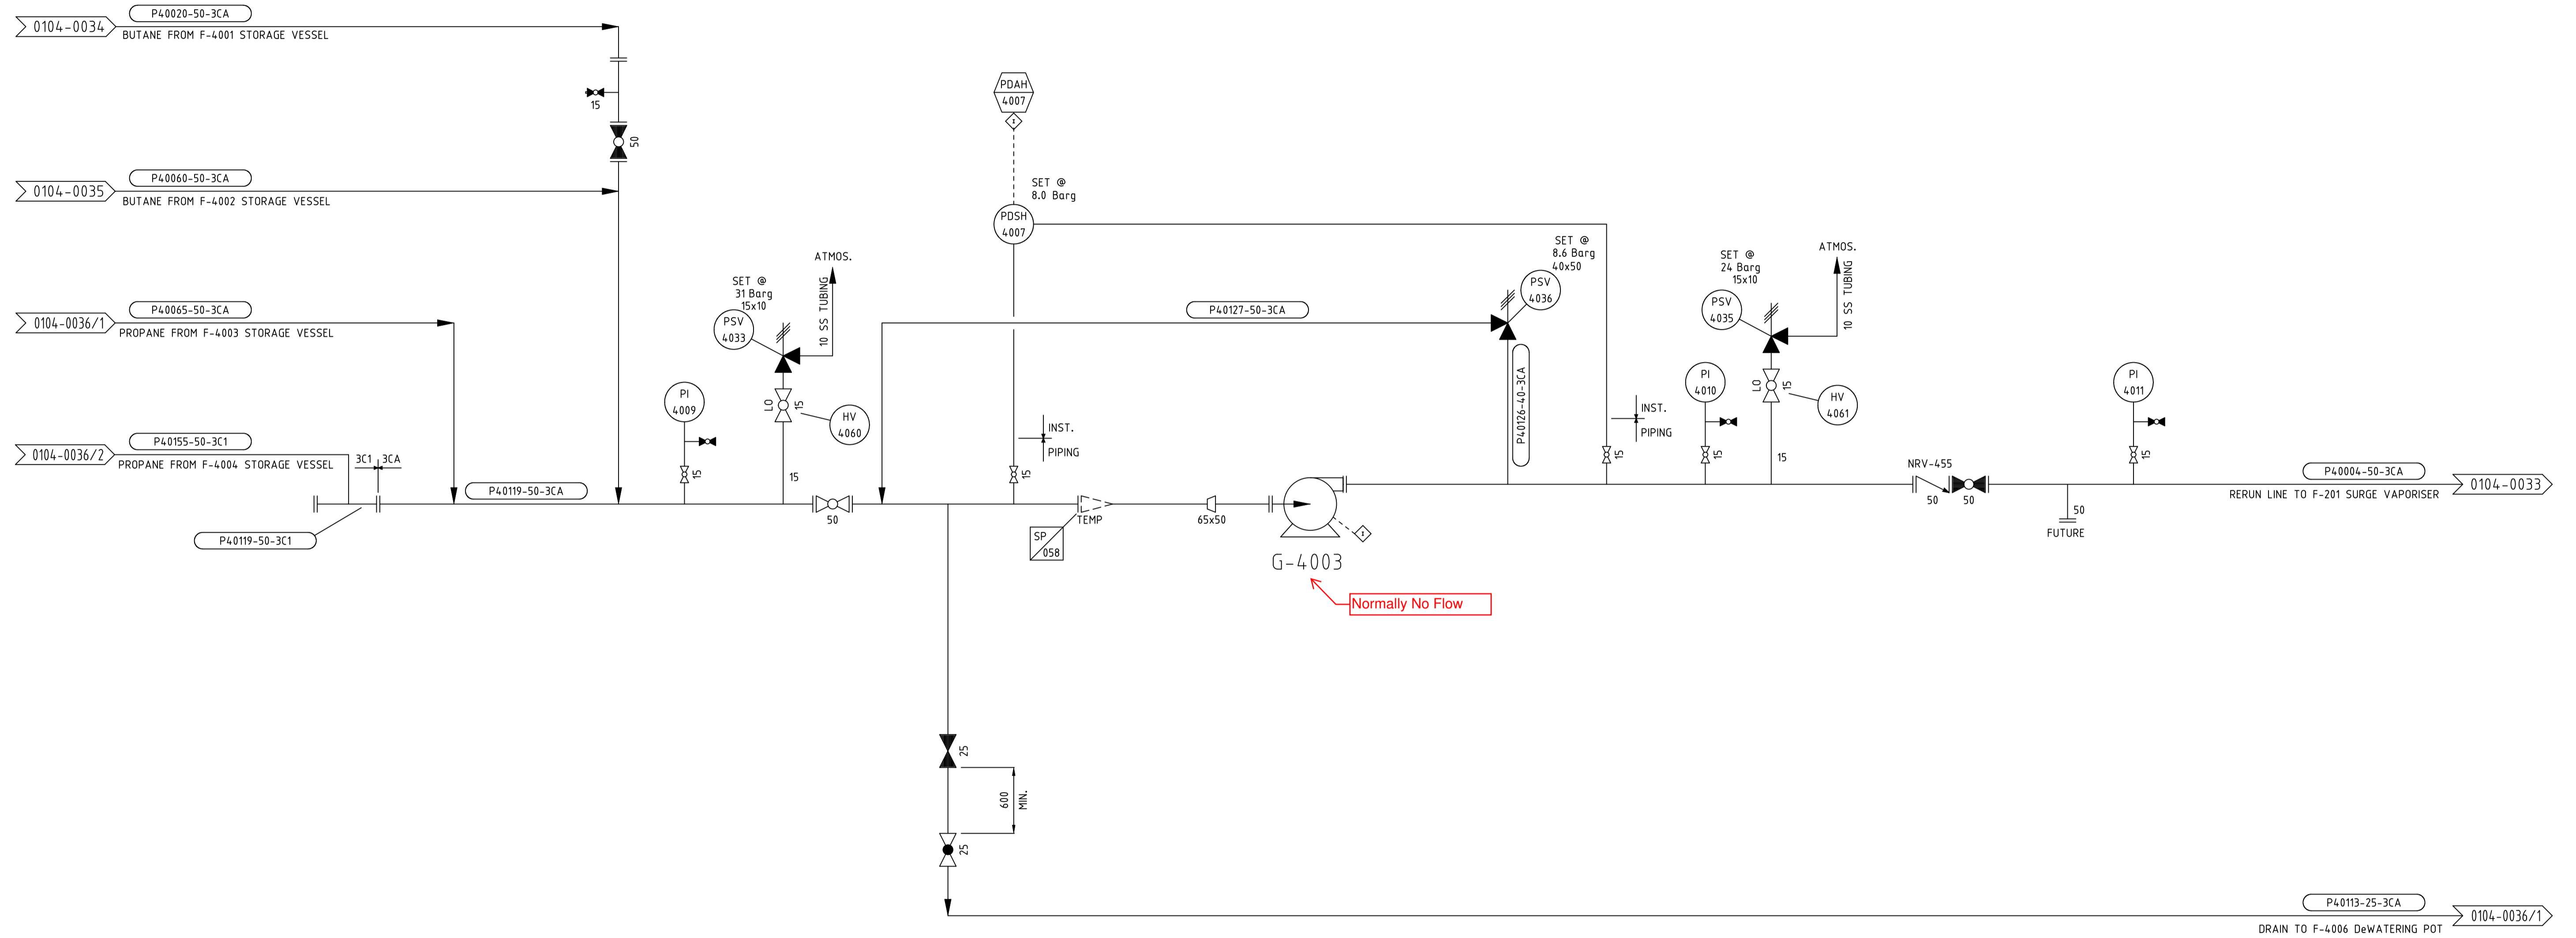

REV	AMENDMENT	BY	CHK	ENG	APP	DATE	REV	AMENDMENT	BY	CHK	ENG	APP	DATE
7	HV HAND VALVE NUMBERS ADDED TO LOCKED VALVES	RL	JCC	AM	IC	07/2019							
6	AS BUILT WS1404955-LPG RELIEF VALVE ISOLATION	ES	TL	LH	SES	07/08							
5	AS BUILT FOR PEP PROJECT WS822071	RL	RH	LH	GE	05/2004							
4	TITLE BLOCK REVISED, DRAWING CONTENT NOT CHANGED	VB	RL	EJH	RS	10/99							
3	REDRAWN ON AUTOPLANT, WAS 104-16	D.R.	J.C.	G.M.	C.J.	09/94							

VECTOR KAPUNI LIMITED
PRIVATE BAG 2020
NEW PLYMOUTH 4342
PHONE 0800 734 567

COPYRIGHT The copyright in this document is vested in Vector Kapuni Limited
The contents of this document shall not be reproduced, either in whole or part, by any
means whatsoever without the prior written consent of Vector Kapuni Limited.

REFERENCE DRAWINGS		DATE		DATE	
CAUSE & EFFECTS - 0780-0030/1 & 2		DRN	J.TERRILL	11/91	ENG
		CHK	RDK	11/91	APP
					B.NICHOLLS
					2/92

LPG LOADING FACILITY PIPING & INSTRUMENT DIAGRAM OFF-SPEC RERUN PUMP					
SCALE:	JOB NO.	SERIES	DRG. NO	SHT 01 OF 01 SHTS	REVISION
NTS	1000000	0104	0039		7
BE003901					

EQUIPMENT No.
DESCRIPTION
CAPACITY
MAWP @ TEMP


F-4007-A
TRANSPORTABLE ODOURANT DRUM
CAPACITY 200L
MAWP 10BarG @ AMBIENT

F-4007-B
TRANSPORTABLE ODOURANT DRUM
CAPACITY 200L
MAWP 10BarG @ AMBIENT

G-4011
ODOURANT INJECTION PUMP
1.9-66 L/hr
0-123 BarG
0.37kW

N2 BOTTLE

ODOURANT BUILDING

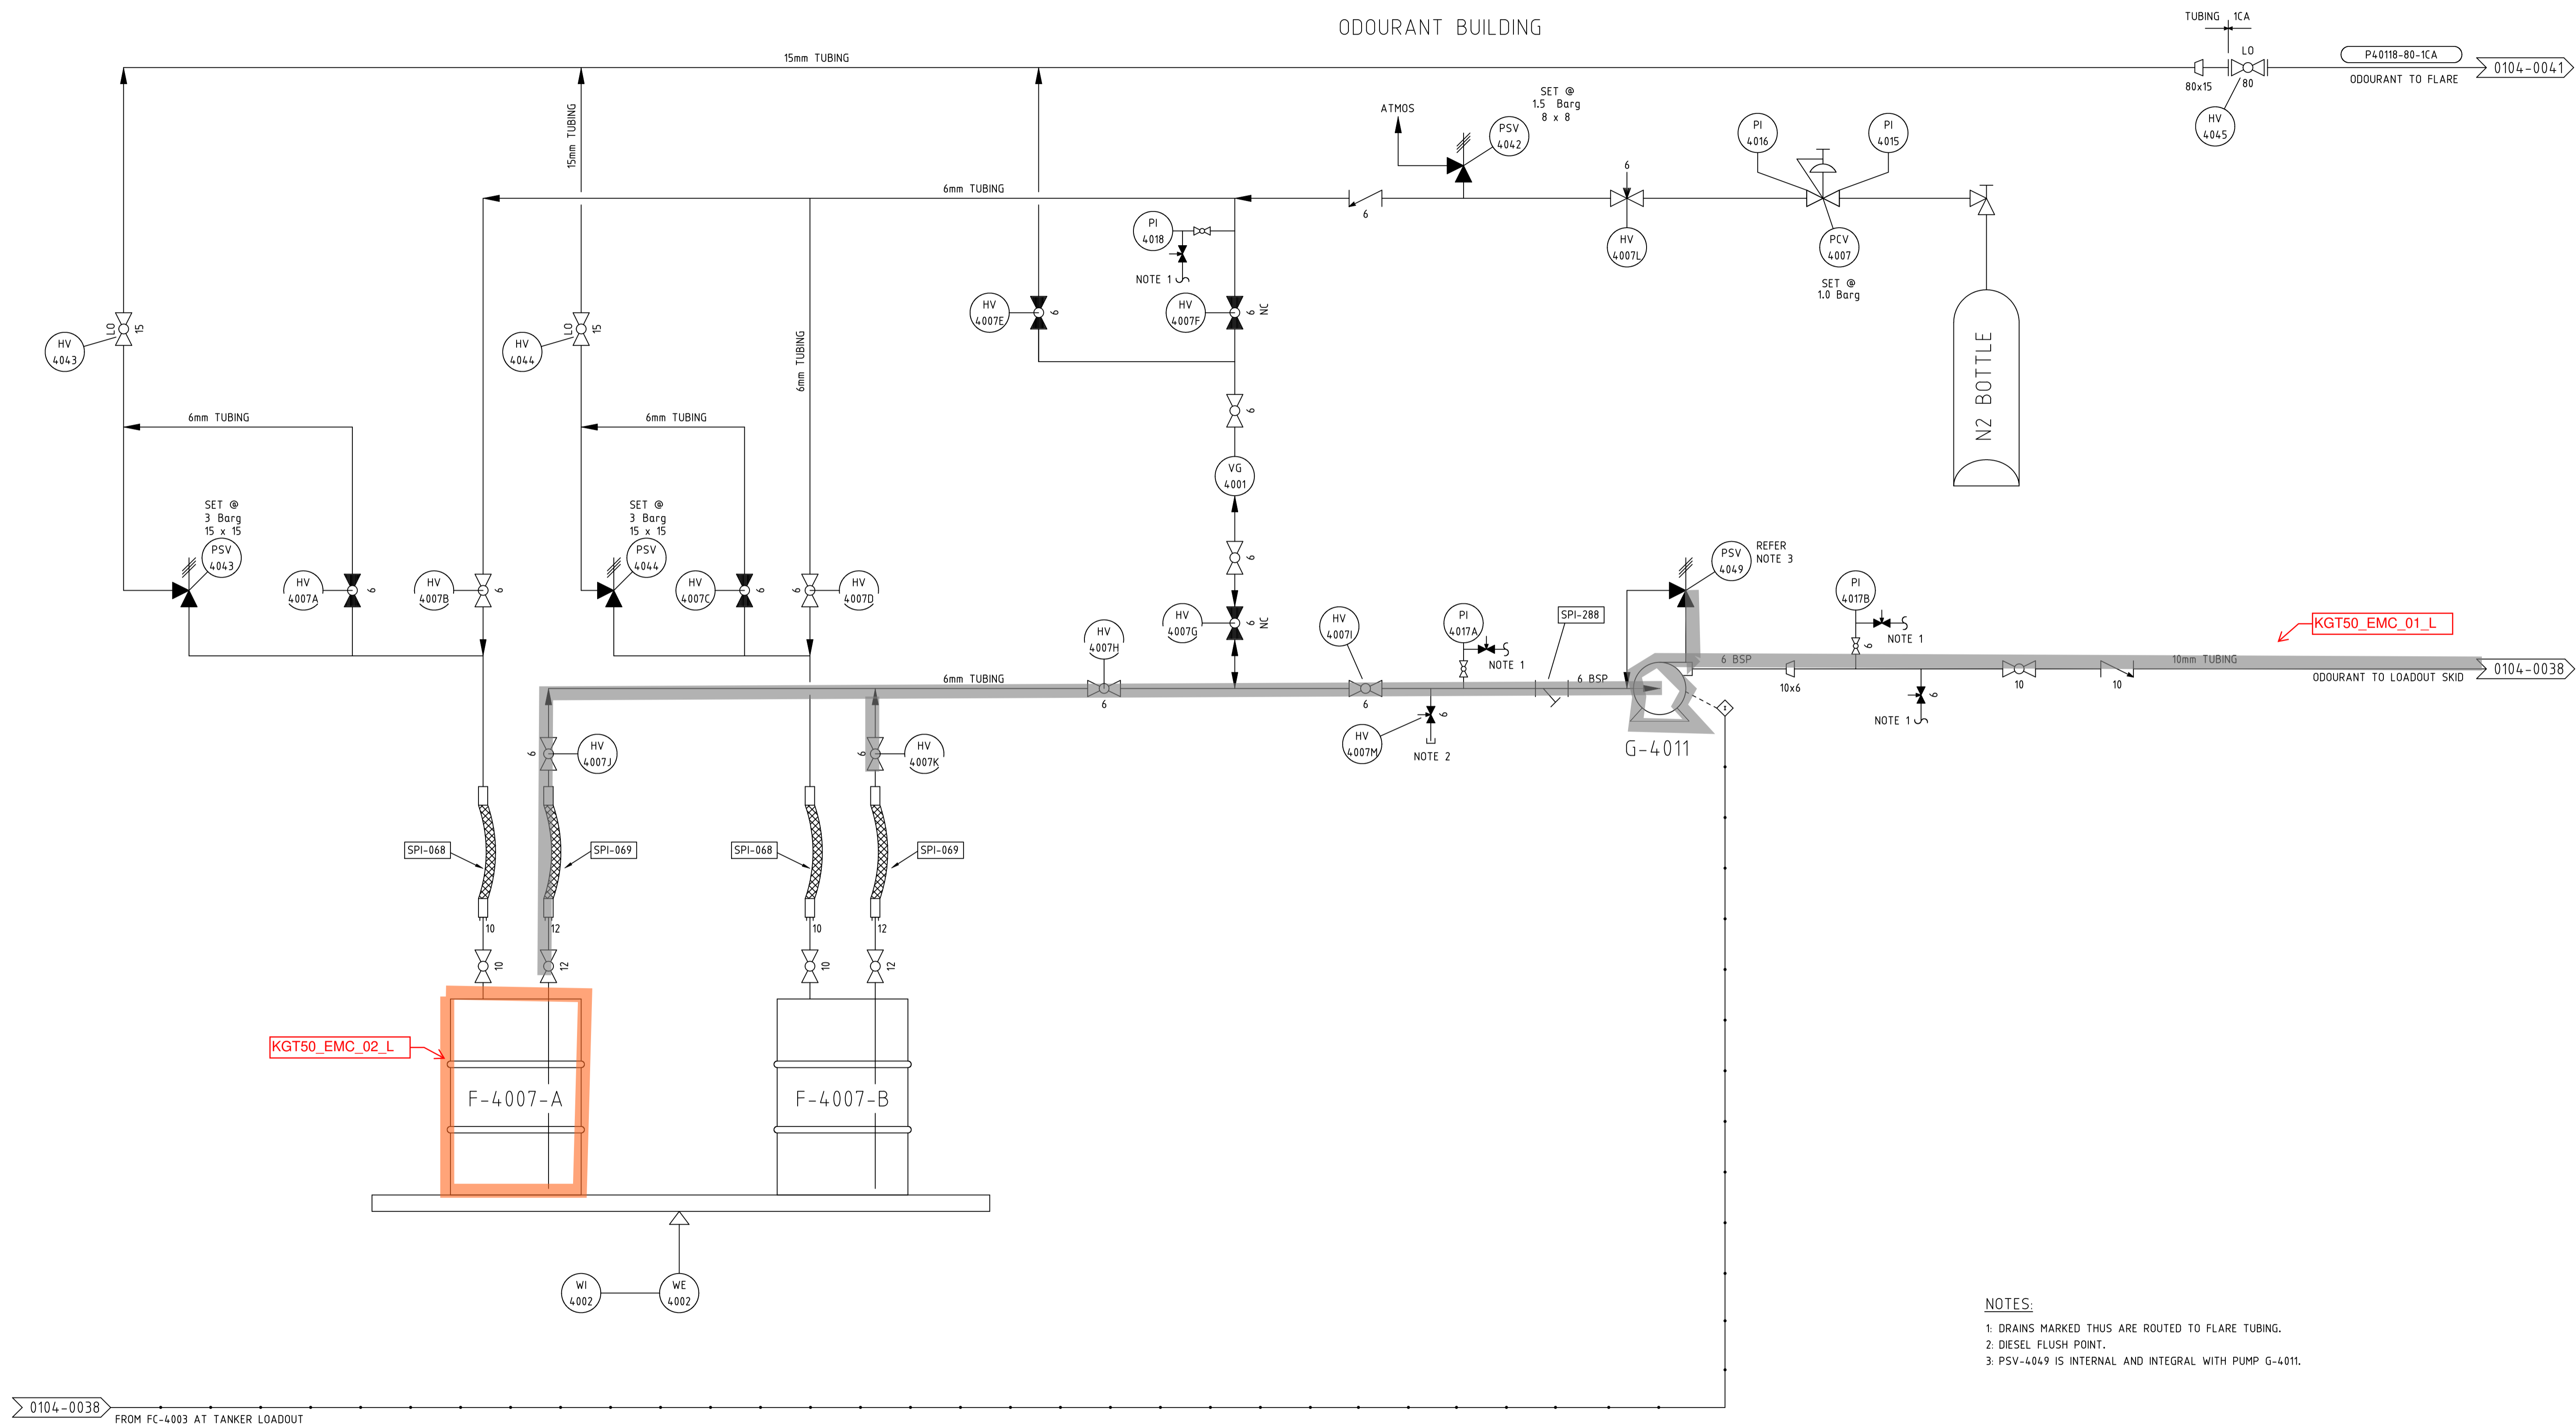


NOTES:

1. DRAINS MARKED THUS ARE ROUTED TO FLARE TUBING.
2. DIESEL FLUSH POINT.
3. PSV-4049 IS INTERNAL AND INTEGRAL WITH PUMP G-4011.

0104-0038 FROM FC-4003 AT TANKER LOADOUT


REV	AMENDMENT	BY	CHK	ENG	APP	DATE	REV	AMENDMENT	BY	CHK	ENG	APP	DATE
8	AS BUILT P84-1375 ADDITION SPI-288 & 3 HV No's ADDED	RL	JC	AM	MM	05/2018							
7	AS BUILT WS2060791 REPLACE ODOURANT INJECTION PUMP	RL	MK	AM	SES	11/2013							
6	NOTE 3 ADDED REGARDING STATUS OF PSV-4049	RL	MK	AM	SES	07/2013							
5	AS BUILT FOR WS145015 TRANSPOR. ODOURANT DRUMS	VB	RL	LH	RJW	05/01							
4	TITLE BLOCK REVISED. DRAWING CONTENT NOT CHANGED	VB	RL	EJH	RS	10/99							
3	AS BUILT COMMENTS INCORPORATED	V.B.	B.T.	A.V.G.	C.J.	05/95							
2	REDRAWN ON AUTOPLANT, WAS 0104-0017	V.B.	J.C.	G.M.	C.J.	09/94							

VECTOR KAPUNI LIMITED
PRIVATE BAG 2020
NEW PLYMOUTH 4342
PHONE 0800 734 567

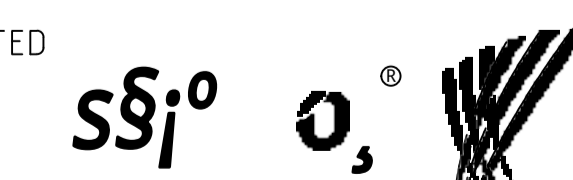

REFERENCE DRAWINGS			
DRN	DATE	ENG	APP
J.TERRILL	01/11/1991	ENG	C.SIEDZUIK
R.D.K.	01/11/1991	APP	B.NICHOLLS

LPG LOADING FACILITY PIPING & INSTRUMENT DIAGRAM ODOURANT STORAGE & PUMPS					
SCALE:	JOB NO.	SERIES	DRG. NO	SHT 01 OF 01 SHTS	REVISION
NTS	1000000	0104	0040	01	8

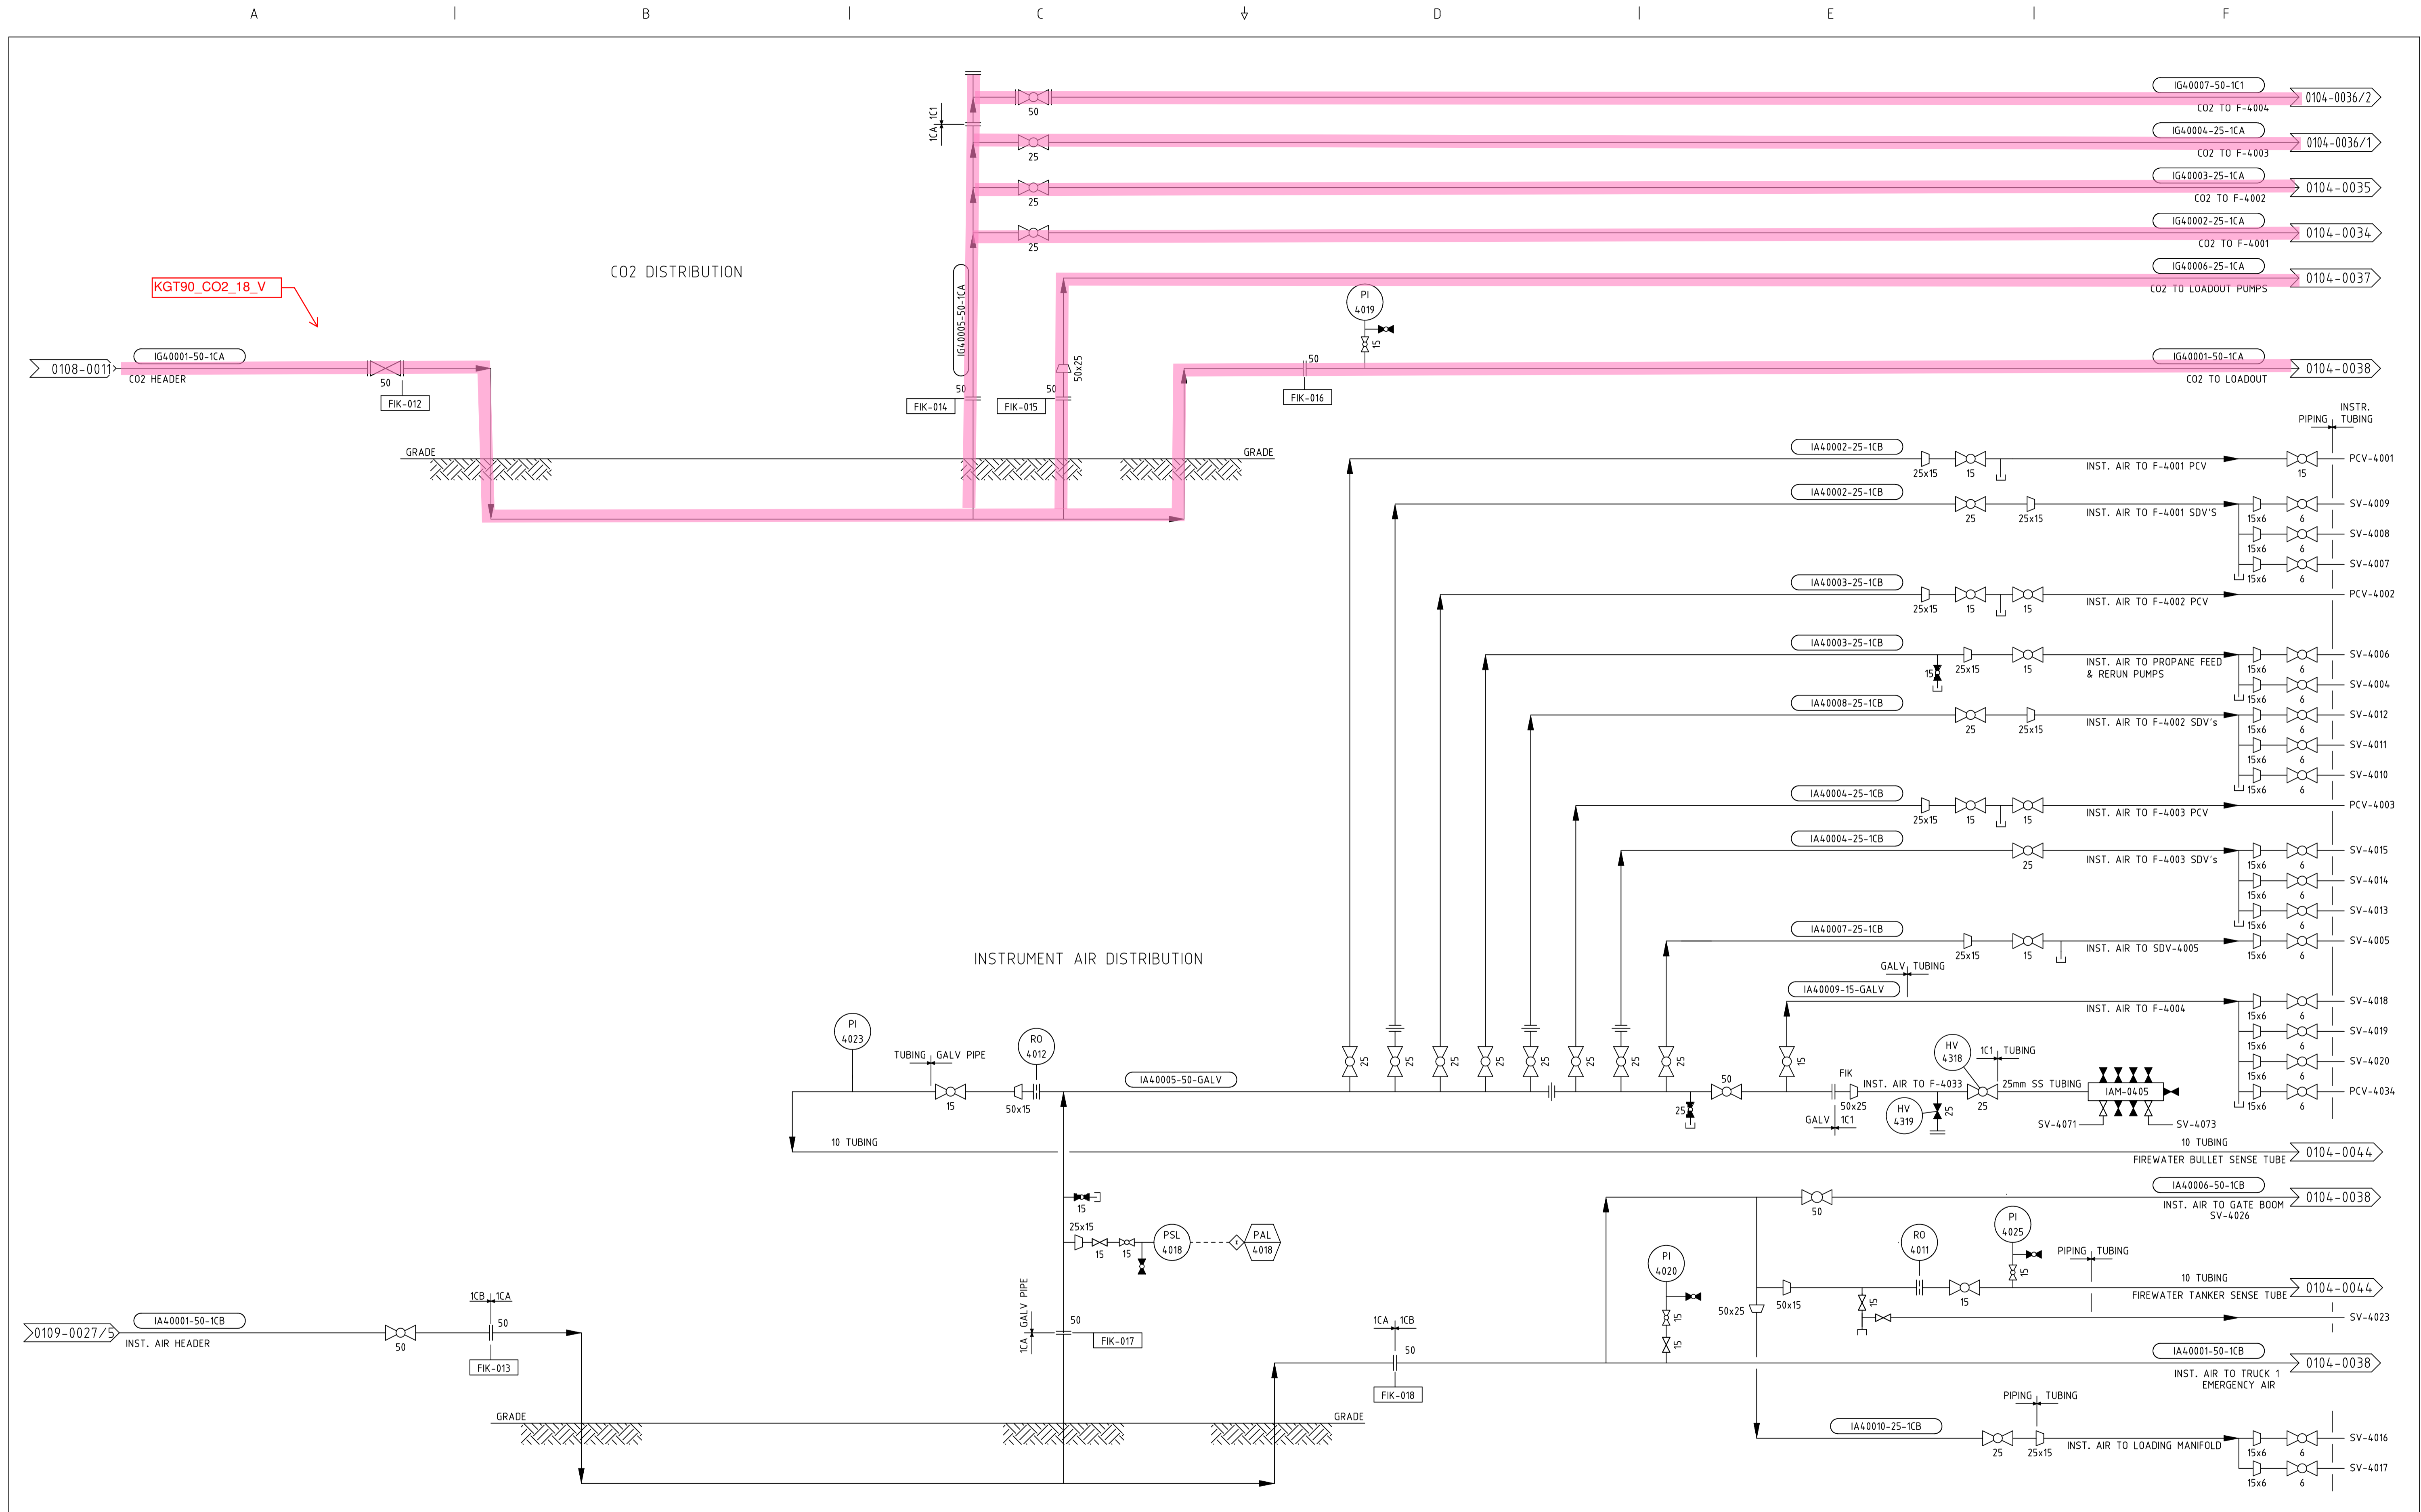

REV	AMENDMENT	BY	CHK	ENG	APP	DATE	REV	AMENDMENT	BY	CHK	ENG	APP	DATE
6	AS BUILT - PR4-1310 PERMANENT NATURAL GASOLINE STORAGE	JT	DV	AM	SES	09/2017							
5	AS BUILT PC-KGP-09-KOPS-002 ISOLATION VALVES ADDED	RL/ES	WB	LH	SES	10/2010							
4	AS BUILT FOR LPG LOADOUT AREA	RL	WB	LH	SES	10/2009							
3	AS BUILT FOR PEP PROJECT WSB22071	RL	RH	LH	GE	05/2004							
2	CONTINUATION 0108-0004 NOW 0108-0011	VB	RL	EJH	RS	10/98							
1	REDRAWN ON AUTOPLANT, WAS 104-19	D.R.	J.C.	G.M.	C.J.	09/94							

VECTOR KAPUNI LIMITED
 PRIVATE BAG 2020
 NEW PLYMOUTH 4342
 PHONE 0800 734 567

sjio

COPYRIGHT The copyright in this document is vested in Vector Kapuni Limited. The contents of this document shall not be reproduced, either in whole or part, by any means whatsoever without the prior written consent of Vector Kapuni Limited.

AUTOCAD ORIGINAL SHEET SIZE A1

REFERENCE DRAWINGS
 CAUSE & EFFECTS - 0780-0030/01 & 02

DRN	J. TERRILL	01/11/1991	ENG	C. SIEDZUK	01/11/1991
CHK	RDK	01/11/1991	APP	B. NICHOLLS	01/12/1992

LPG LOADING FACILITY
 PIPING & INSTRUMENT DIAGRAM
 UTILITIES PIPE LINES

SCALE:	JOB NO.	SERIES	DRG. NO	SHT 01	REVISION
NTS	1000000	0104	0042	01 OF 01 SHTS	6


1000000-0104-0042-01.DWG

EQUIPMENT No.
DESCRIPTION
CAPACITY
MAWP @ TEMP

F-4032
NATURAL GASOLINE STORAGE SEAL DRUM
250NB x 1.9m HIGH

F-4033
NATURAL GASOLINE STORAGE TANK (EX KAHILI)
4.5Øm x 6m HIGH
TOTAL VOLUME: 95.4m³
WORKING VOLUME: 73.4m³ (LAL to LAH) 80.5m³ (LALL to LAHH)
PRESSURE: 1741mm WG @ 80°C (DESIGN)
VACUUM: -65mm WG @ 80°C (DESIGN)

G-4033
NATURAL GASOLINE LOAD OUT PUMP
50m³/hr DP 2.9 Barg
19.6 Barg @ 45°C

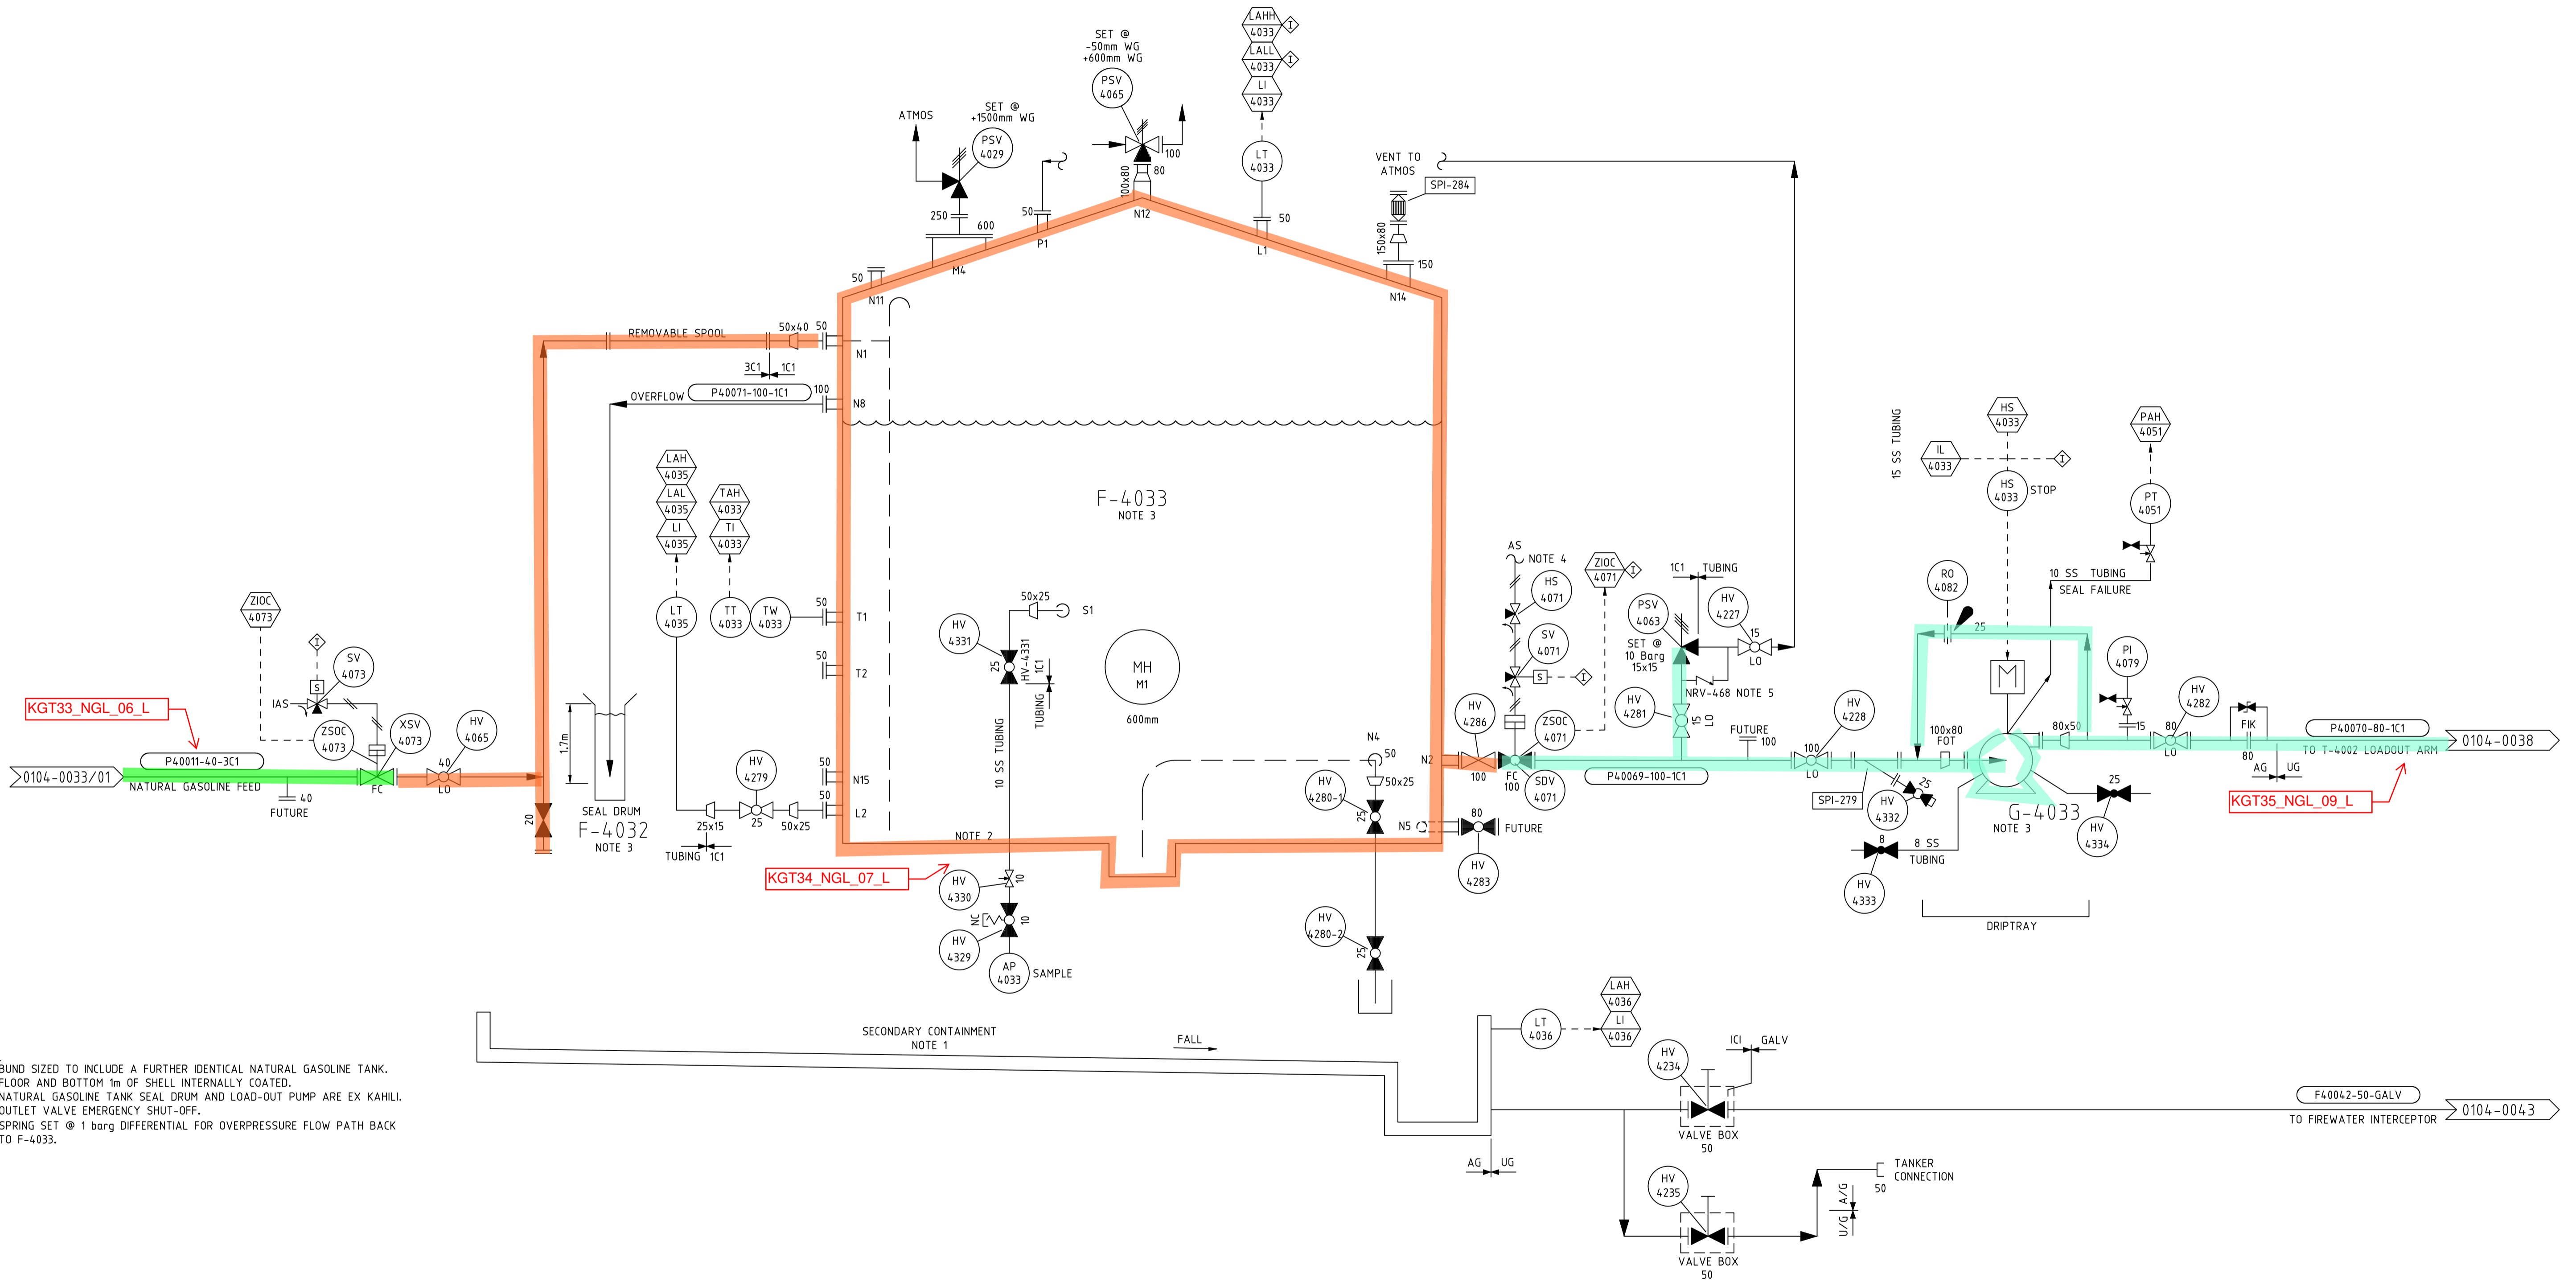

- NOTES:
- BUND SIZED TO INCLUDE A FURTHER IDENTICAL NATURAL GASOLINE TANK.
 - FLOOR AND BOTTOM 1m OF SHELL INTERNALLY COATED.
 - NATURAL GASOLINE TANK SEAL DRUM AND LOAD-OUT PUMP ARE EX KAHILI.
 - OUTLET VALVE EMERGENCY SHUT-OFF.
 - SPRING SET @ 1 barg DIFFERENTIAL FOR OVERPRESSURE FLOW PATH BACK TO F-4033.

REV	AMENDMENT	BY	CHK	ENG	APP	DATE	REV	AMENDMENT	BY	CHK	ENG	APP	DATE
3	AS BUILT HV-4234 & 4235 CHANGED TO FLANGED & GALV SHOWN	RL	JCC	AM	TC	07/2019							
2	AS BUILT P84-1502 REDUCE NG LOADOUT LINE OPERATING PRESSURE	RL	DW	AM	TC	08/2018							
1	AS BUILT - P84-1310 PERMANENT NATURAL GASOLINE STORAGE	JT	DV	AM	SES	09/2017							

VECTOR KAPUNI LIMITED
PRIVATE BAG 2020
NEW PLYMOUTH 4342
PHONE 0800 734 567

COPYRIGHT The copyright in this document is vested in Vector Kapuni Limited
The contents of this document shall not be reproduced, either in whole or part, by any
means whatsoever without the prior written consent of Vector Kapuni Limited.

REFERENCE DRAWINGS

DRN	DATE	ENG	APP	DATE
B KNOX	21/04/2016	ENG	S HARPER	21/04/2016
C JAMIESON	21/04/2016	APP	W WANG	21/04/2016


KAPUNI GAS TREATMENT PLANT
PIPING & INSTRUMENT DIAGRAM
NATURAL GASOLINE STORAGE TANK F-4033

SCALE:	JOB NO.	SERIES	DRG. NO	SHT 01	REVISION
NTS	1000000	0104	0051	01	3

EQUIPMENT No.

DESCRIPTION
CAPACITY
MAWP @ TEMP

M-502
FILTER / SEPARATOR
0.73m³
55.16 Barg @ 66/-29°C

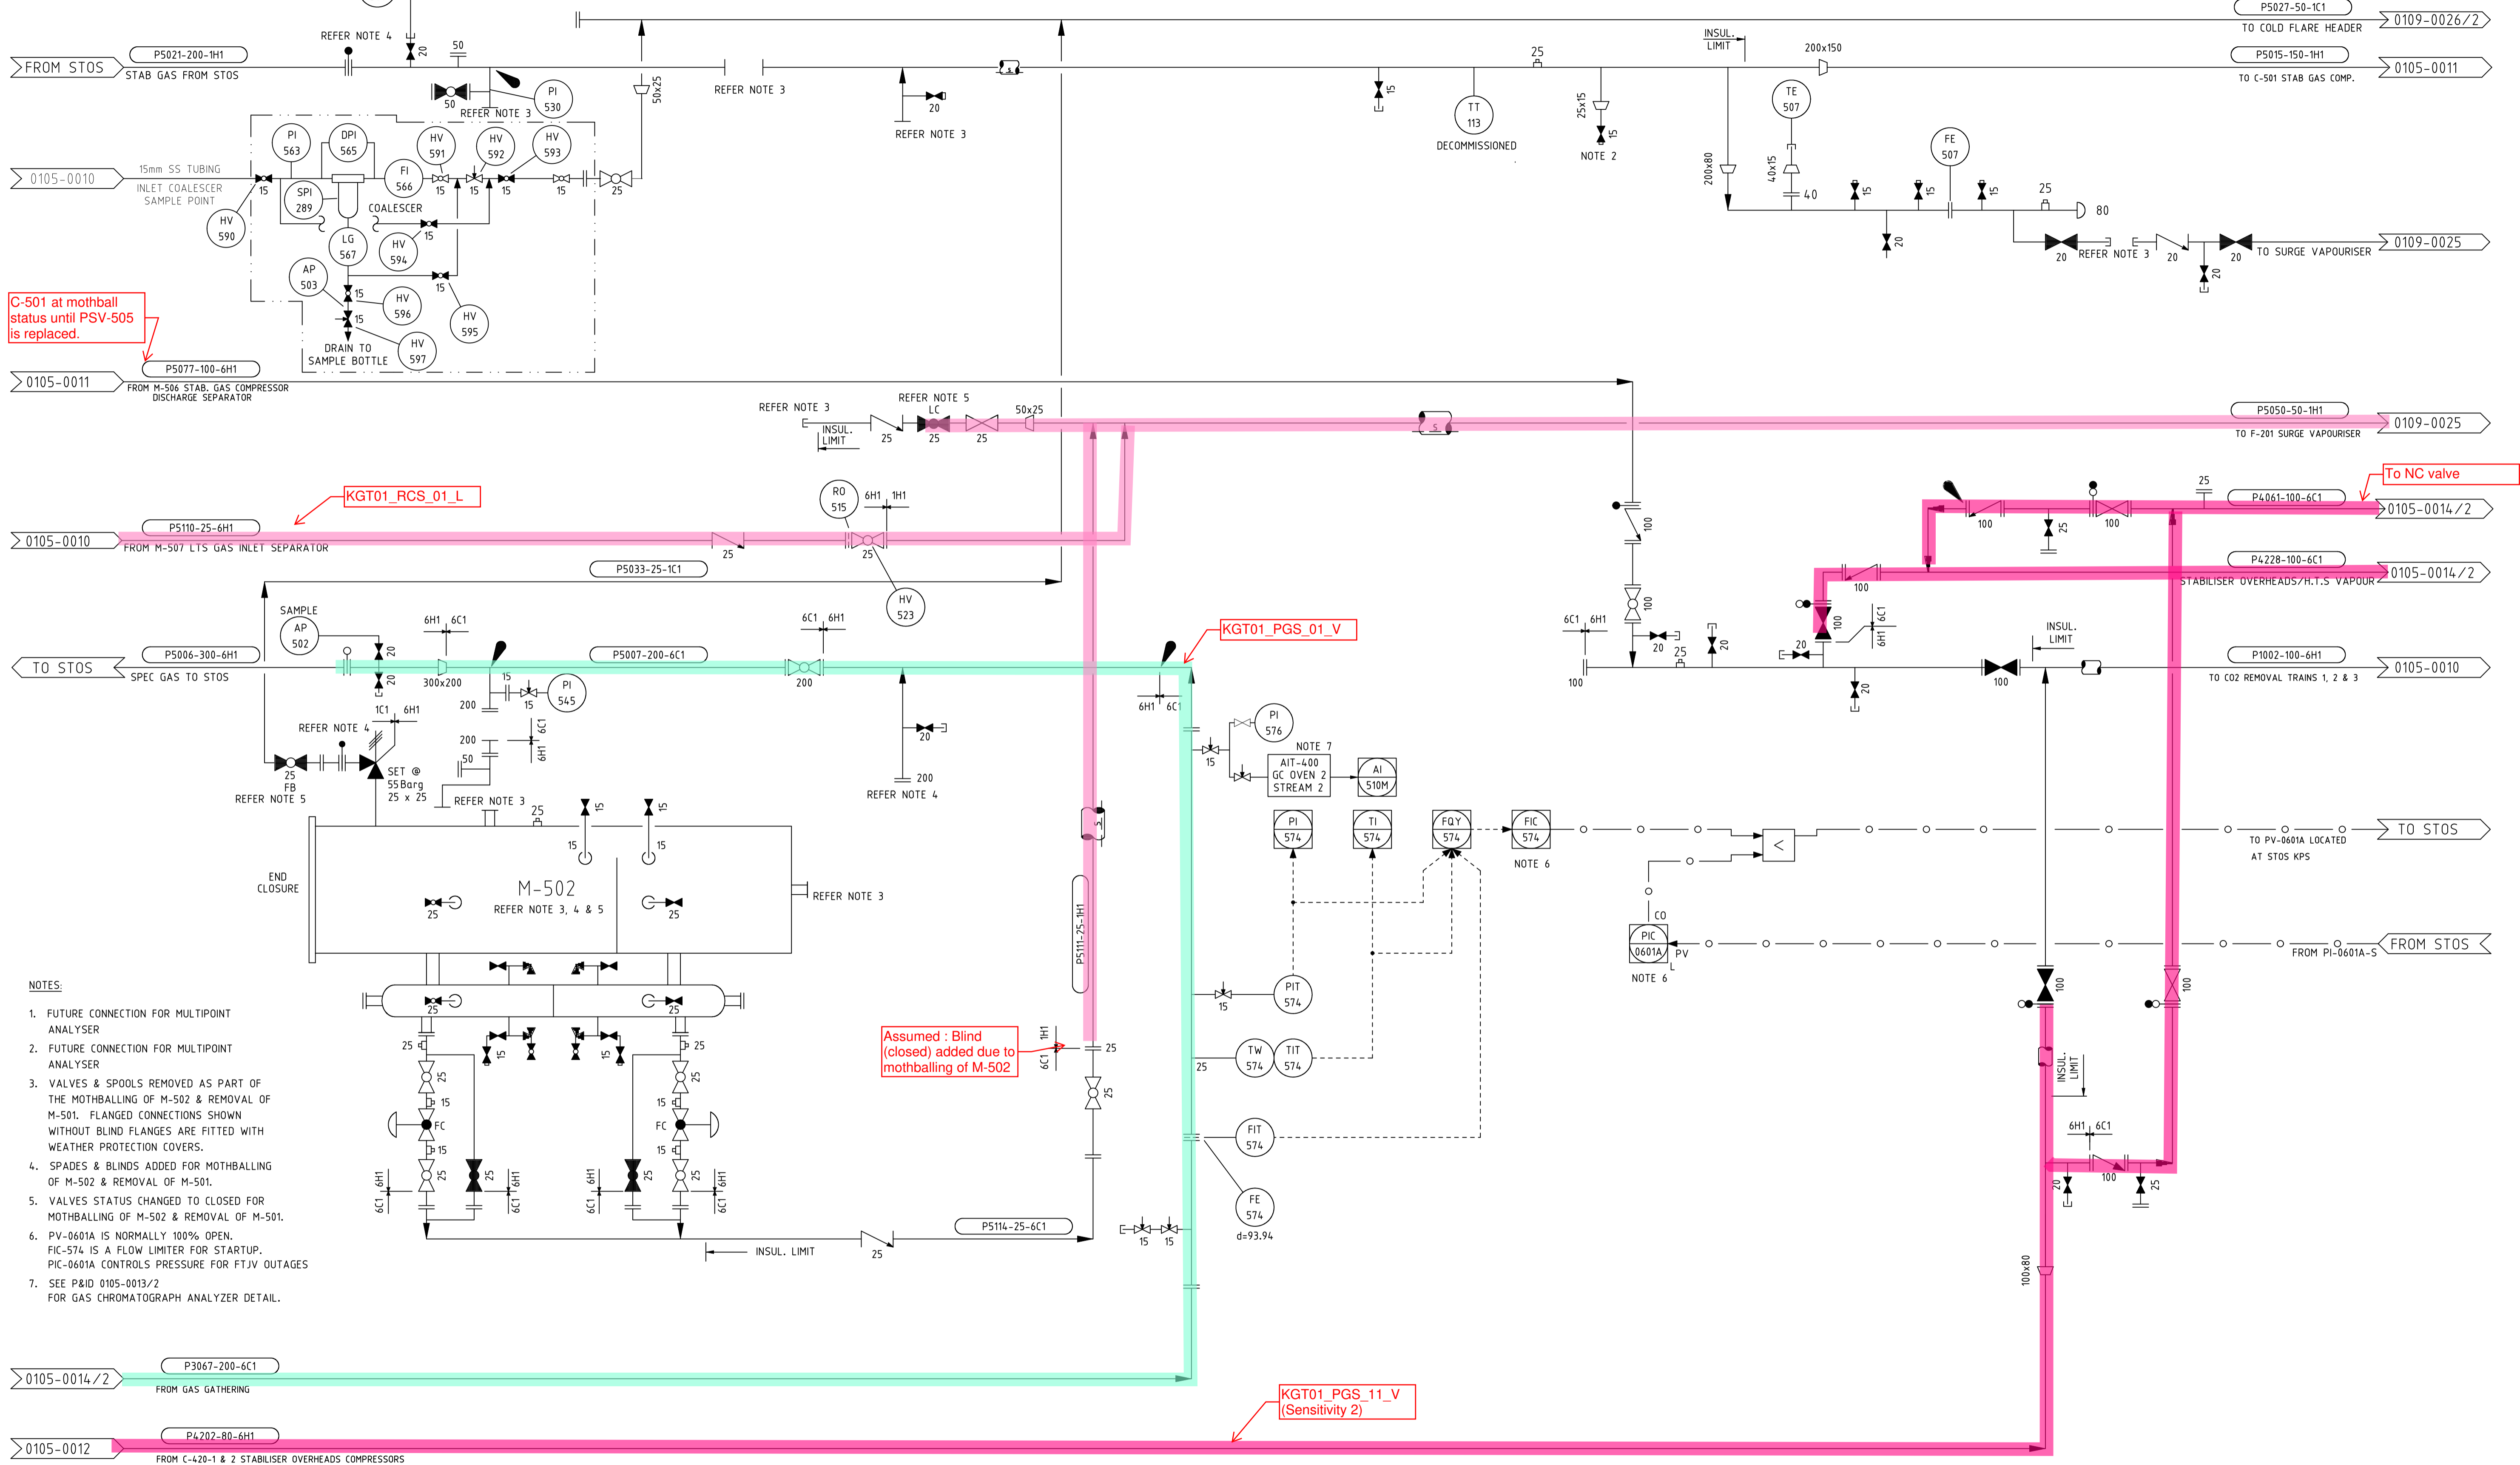

- NOTES:
1. FUTURE CONNECTION FOR MULTIPPOINT ANALYSER
 2. FUTURE CONNECTION FOR MULTIPPOINT ANALYSER
 3. VALVES & SPOOLS REMOVED AS PART OF THE MOTHBALLING OF M-502 & REMOVAL OF M-501. FLANGED CONNECTIONS SHOWN WITHOUT BLIND FLANGES ARE FITTED WITH WEATHER PROTECTION COVERS.
 4. SPADES & BLINDS ADDED FOR MOTHBALLING OF M-502 & REMOVAL OF M-501.
 5. VALVES STATUS CHANGED TO CLOSED FOR MOTHBALLING OF M-502 & REMOVAL OF M-501.
 6. PV-0601A IS NORMALLY 100% OPEN. FIC-574 IS A FLOW LIMITER FOR STARTUP. PIC-0601A CONTROLS PRESSURE FOR FTJV OUTAGES
 7. SEE P&ID 0105-0013/2 FOR GAS CHROMATOGRAPH ANALYZER DETAIL.

Assumed: Blind (closed) added due to mothballing of M-502


REV	AMENDMENT	BY	CHK	ENG	APP	DATE	REV	AMENDMENT	BY	CHK	ENG	APP	DATE
21	SPADE OPEN (SPACER) ADDED TO LINE P5006-300-6H1	TL	RL	LH	SES	01/2010							
20	AS BUILT-TODD - PO-K3P-09-KGTH-002	MAW	VWP	CRP	LH	08/2009							
19	AS BUILT WS992071 PREVENT OIL TO BALLANCE	RL	ES	LH	SES	04/2008							
18	AS BUILT WS1292009 M-502 DEMOLITION	EA	CB	AAB	PJR	09/07							
17	AS BUILT WS1042819-BENFIELD SYSTEM HAZARD REPORT	ES	CP	LH	PJR	04/07	27	AS BUILT - P84-1434 INLET COALESCER SP	WPG	PMO	AM	TC	08/2018
16	M-501 REMOVED FROM SITE	RL	ES	LH	PJR	05/2006	26	P&ID SPLITTING CONTINUATION FROM 0105-0014-02	JCC	RL	AM	SES	06/2016
15	AS BUILT FOR WS833005 RECYCLE STAB & DE-ETH O/H'S	VB	CWM	LH	CF	09/05	25	AS BUILT - P84-1140 AI-510M SAMPLE RELOCATION	JCC	RL/CB	AC	TC	05/2016
14	AS BUILT WS853855 BLEND TO BALLANCE & MOTHBALLLED	RL	AK	LH	PJR	07/2004	24	AS BUILT FOR ISOLATED EQUIPMENT BY ADDING SPADES ETC.	RL	NA	AM	SES	08/2015
13	PROCESS ISOLATION POINTS ADDED ON INDIVIDUAL LAYERS	CMW	RL	CM	AIM	10/02	23	P84-866 AS BUILT LOWER WHAREROA SUPPLY LINE PRESSURE	LN	AB	AM	SES	04/2014
12	M-501 & M-502 DESIGN DATA RATIONALISED	JBH	RL	AVG	AIM	08/02	22	HAND VALVE NUMBERS ADDED FOR ISOLATIONS	RL	CR	AM	SES	03/2014

VECTOR KAPUNI LIMITED
PRIVATE BAG 2020
NEW PLYMOUTH 4342
PHONE 0800 734 567

COPYRIGHT The copyright in this document is vested in Vector Kapuni Limited. The contents of this document shall not be reproduced, either in whole or part, by any means whatsoever without the prior written consent of Vector Kapuni Limited.

DRN	P.RAWLES	DATE	07/04/1994	ENG	DATE
CHK	J.STEWART	DATE	07/04/1994	APP	DATE

SCALE:	JOB NO.	SERIES	DRG. NO	SHT 01 OF 01 SHTS	REVISION
N/A	1000000	0105	0009		27

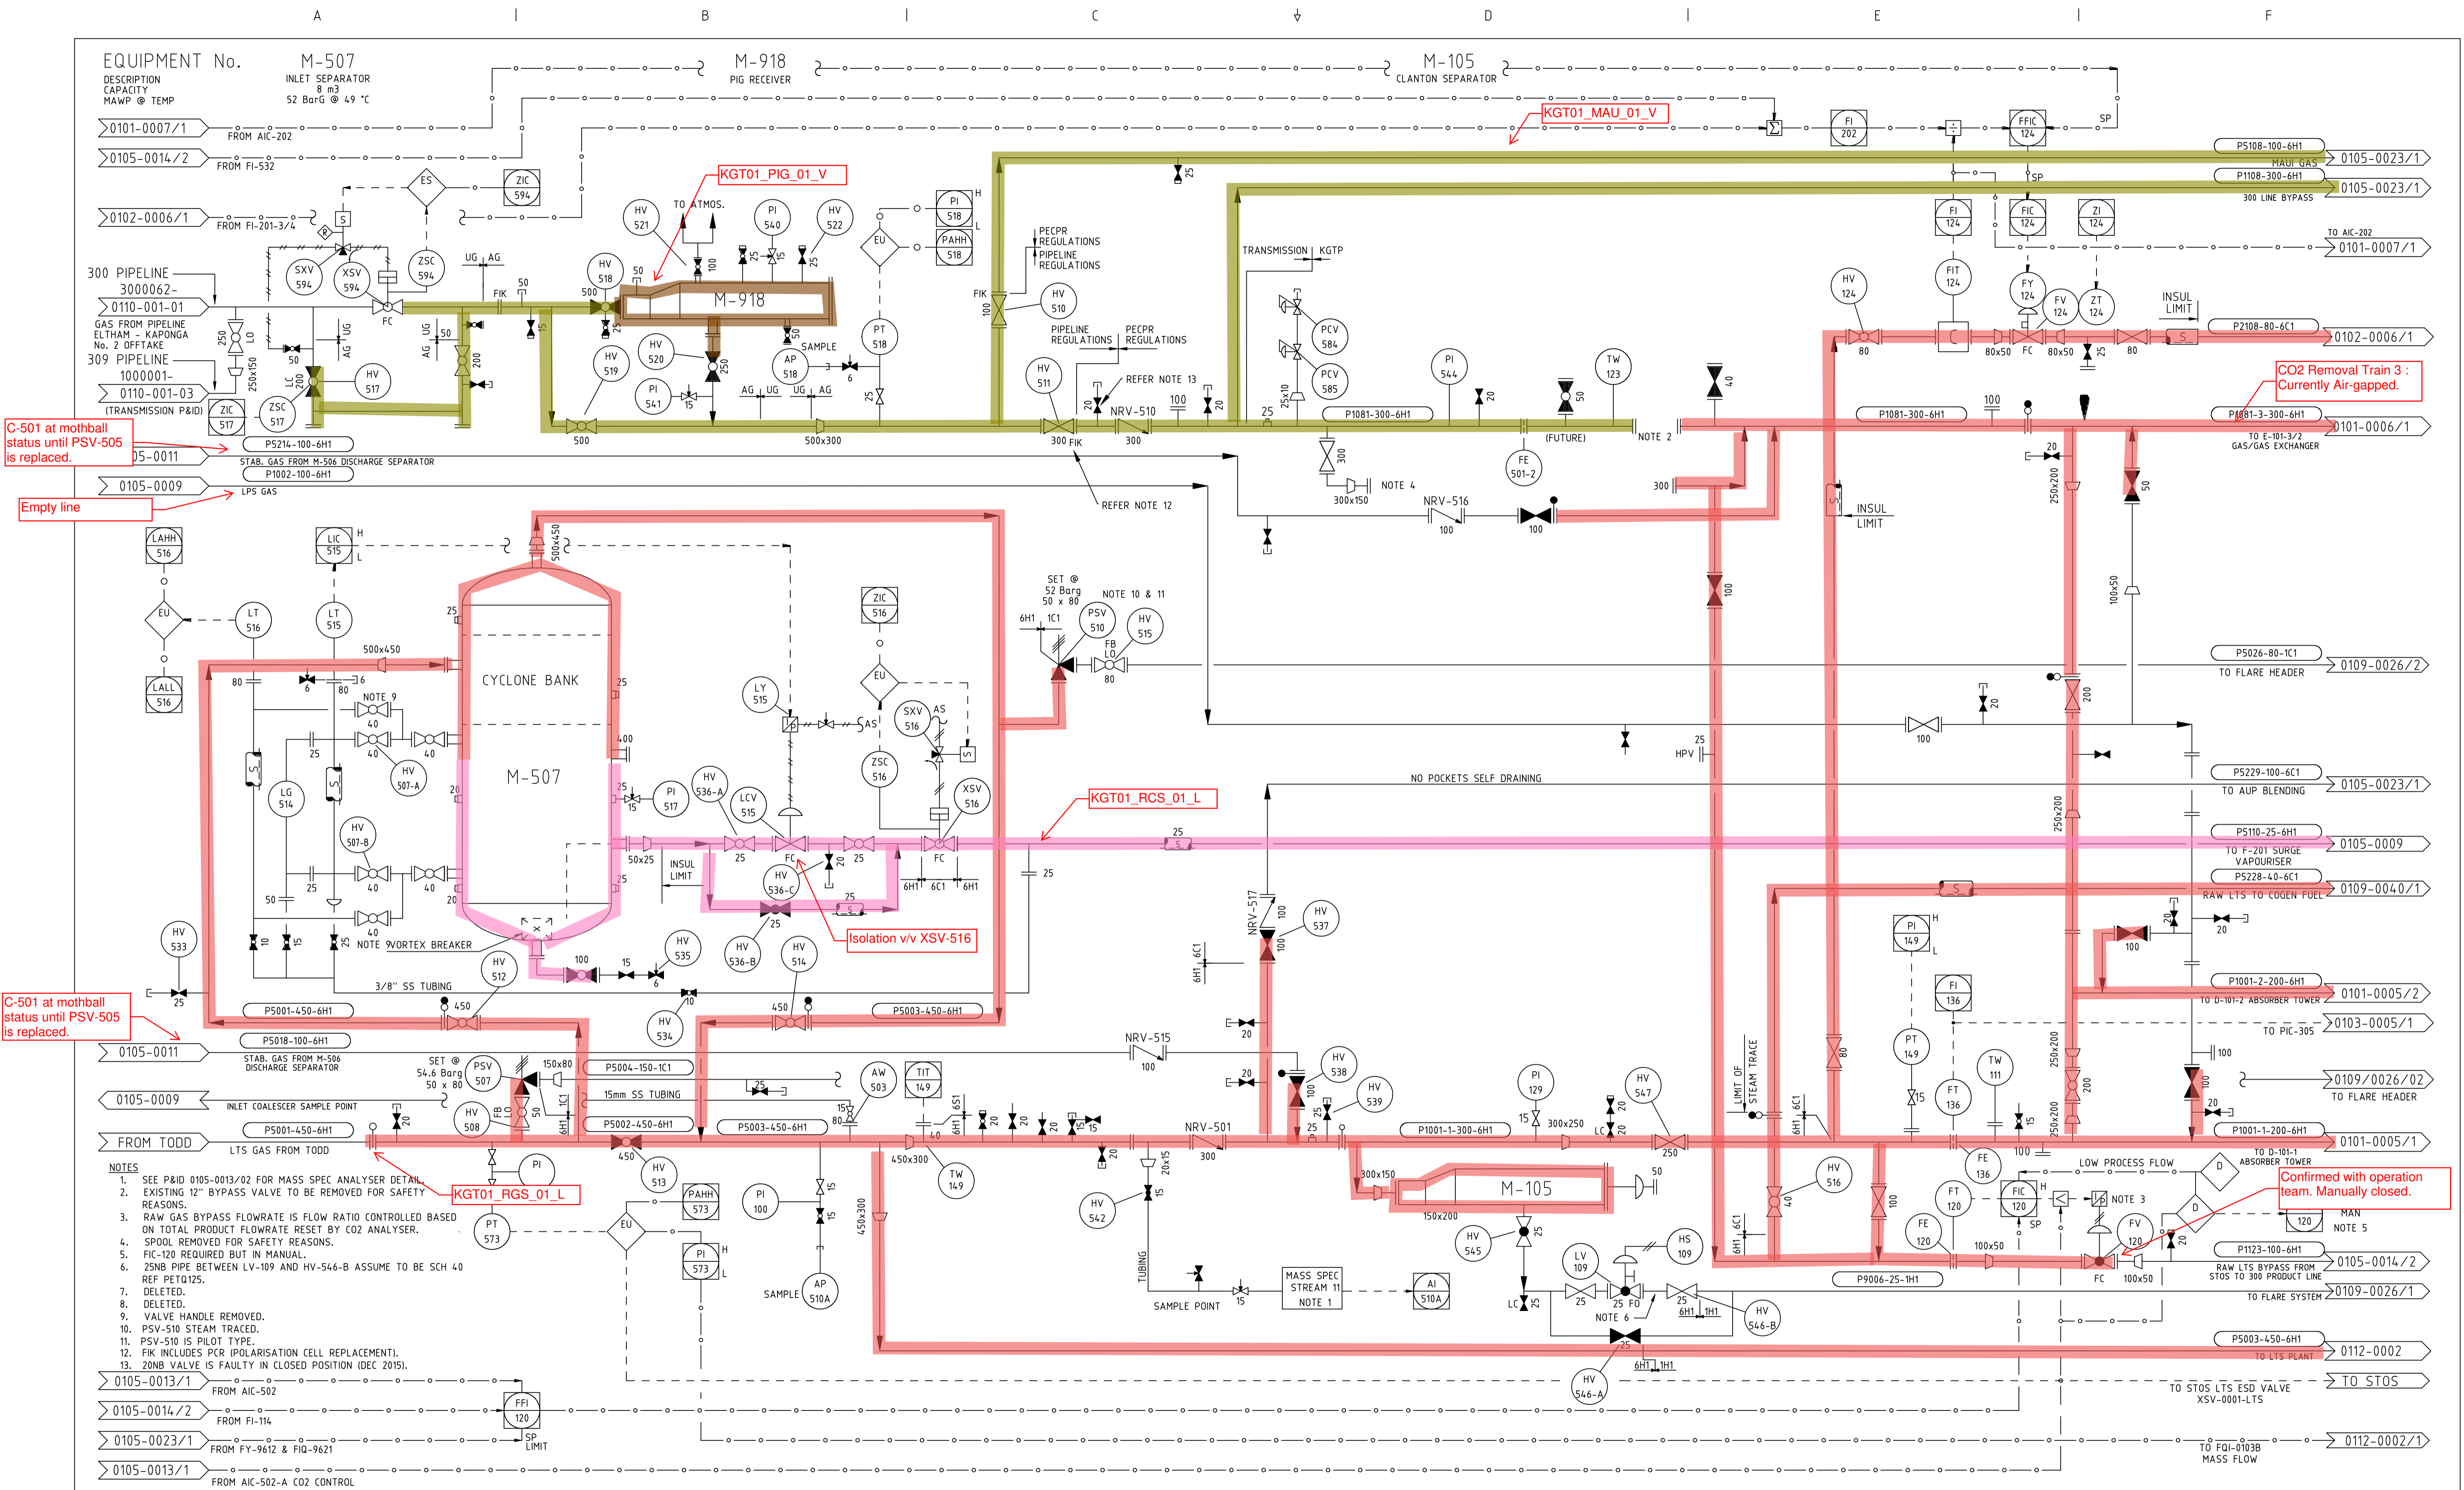

C-501 at mothball status until PSV-505 is replaced.

Empty line

C-501 at mothball status until PSV-505 is replaced.

KGTO1_RGS_01_L

KGTO1_PIG_01_V

KGTO1_MAU_01_V

KGTO1_RCS_01_L

Confirmed with operation team. Manually closed.

- NOTES
- SEE P&ID 0105-0013/02 FOR MASS SPEC ANALYSER DETAIL.
 - EXISTING 12" BYPASS VALVE TO BE REMOVED FOR SAFETY REASONS.
 - RAW GAS BYPASS FLOWRATE IS FLOW RATIO CONTROLLED BASED ON TOTAL PRODUCT FLOWRATE RESET BY CO2 ANALYSER.
 - SPOOL REMOVED FOR SAFETY REASONS.
 - FI-120 REQUIRED BUT IN MANUAL.
 - 25NB PIPE BETWEEN LV-109 AND HV-546-B ASSUME TO BE SCH 40 REF PET10125.
 - DELETED.
 - DELETED.
 - VALVE HANDLE REMOVED.
 - PSV-510 STEAM TRACED.
 - PSV-510 IS PILOT TYPE.
 - FIK INCLUDES PCR (POLARISATION CELL REPLACEMENT).
 - 20NB VALVE IS FAULTY IN CLOSED POSITION (DEC 2015).

REV	AMENDMENT	BY	CHK	ENG	APP	DATE	REV	AMENDMENT	BY	CHK	ENG	APP	DATE
43	CONTIN. DRG. No. REVISED FOR EXPORT COMPRESSOR RE-NUMBERING	RL/ES	MH	AM	SES	05/12/18	53	AS BUILT - P84-1434 INLET COALESCER SP	WPG	PMO	AM	TC	08/2018
42	AS BUILT P84-3402 LTS TEMPERATURE TRANSMITTER	ES/RL	TC	AM	SES	02/12/18	52	NOTE 6 ADDED RE PET10125 & DEMARC ADDED RE PECCR REGS	RL	JC/CR	AM	SES	05/2017
41	AS BUILT P84-1040 PHASE 1 INLET SAMPLE COALESCER	RL/ES	AB	LH	SES	03/11/18	51	DEMARC REVISED AT XSV-594 & DEMARC CHANGE POINT No's ADDED	RL	JCC	AM	SES	03/2017
40	PARTIAL AS BUILT FOR P84-701 LTS SEP. M-507 LEVEL CTR	CJ	NB	JS	LH	03/11/18	50	BLEED VALVE ADDED TO HV-518 - MOC 3604	NK	RH	DT	RS	10/2016
39	HAND VALVE NUMBERS ADDED FOR FLANGE INSUL. KITS	RL	ES	LH	SES	08/2009	49	TRANSMISSION / KGTP DEMARCATION ADDED RE INCIDENT ACTION	RL	JC	AM	SES	05/2016
							48	AS BUILT FOR XC-X0-15-XPLN-005 FIK ADDED TO HV-511 ETC.	RL	CR	AM	SES	12/2015
							47	AS BUILT FOR ISOLATED EQUIPMENT BY ADDING SPADES ETC.	RL	NA	AM	SES	08/2015
							46	AS BUILT FIK NOW SHOWN A/G. FT-501-2A REMOVED. NRV No's ADDED	RL	JC	AM	SES	05/2015
							45	AS BUILT - P84-848 WOBBER CONTROL ON PROCESSED/EXPORT GAS	ES/RL	AAB	AM	SES	04/2014
							44	HAND VALVE No's ADDED & CONT REVISED FOR 300 PIPELINE	RL	CR	AM	SES	02/2014

VECTOR KAPUNI LIMITED
PRIVATE BAG 2020
NEW PLYMOUTH 4342
PHONE 0800 734 567

sjio

COPYRIGHT The copyright in this document is vested in Vector Kapuni Limited. The contents of this document shall not be reproduced, either in whole or part, by any means whatsoever without the prior written consent of Vector Kapuni Limited.

AUTOCAD ORIGINAL SHEET SIZE A1

REFERENCE DRAWINGS

0780-0081 SHT 1 TO 3 CAUSE AND EFFECTS
0780-0082 SHT 5 & 6 CAUSE AND EFFECTS
0780-0083 SHT 1 CAUSE AND EFFECTS
0780-0149 SHT 1 CAUSE AND EFFECTS


DRN	P.RAWLES	08/04/1994	ENG	R.vanLUF	25/03/1987
CHK	J.STEWART	08/04/1994	APP	R.vanLUF	25/03/1987

PRODUCT LINES AND COMPRESSORS
PIPING & INSTRUMENT DIAGRAM
INLET LINES - LTS AND MAUI


SCALE:	JOB NO.	SERIES	DRG. NO	SHT	REVISION
NTS	1000000	0105	0010	01 OF 01 SHTS	56

EQUIPMENT No.
DESCRIPTION
CAPACITY
MAWP @ TEMP

A-911 OIL SUMP
C-501 STAB GAS COMPRESSOR
F-930 STAB COMP OIL TANK
E-501 INTERSTAGE COOLER
M-505 STAB GAS COMP INTERSTAGE SEPARATOR
E-502 STAB GAS COMP DISCHARGE COOLER
M-506 STAB GAS COMP DISCHARGE SEPARATOR

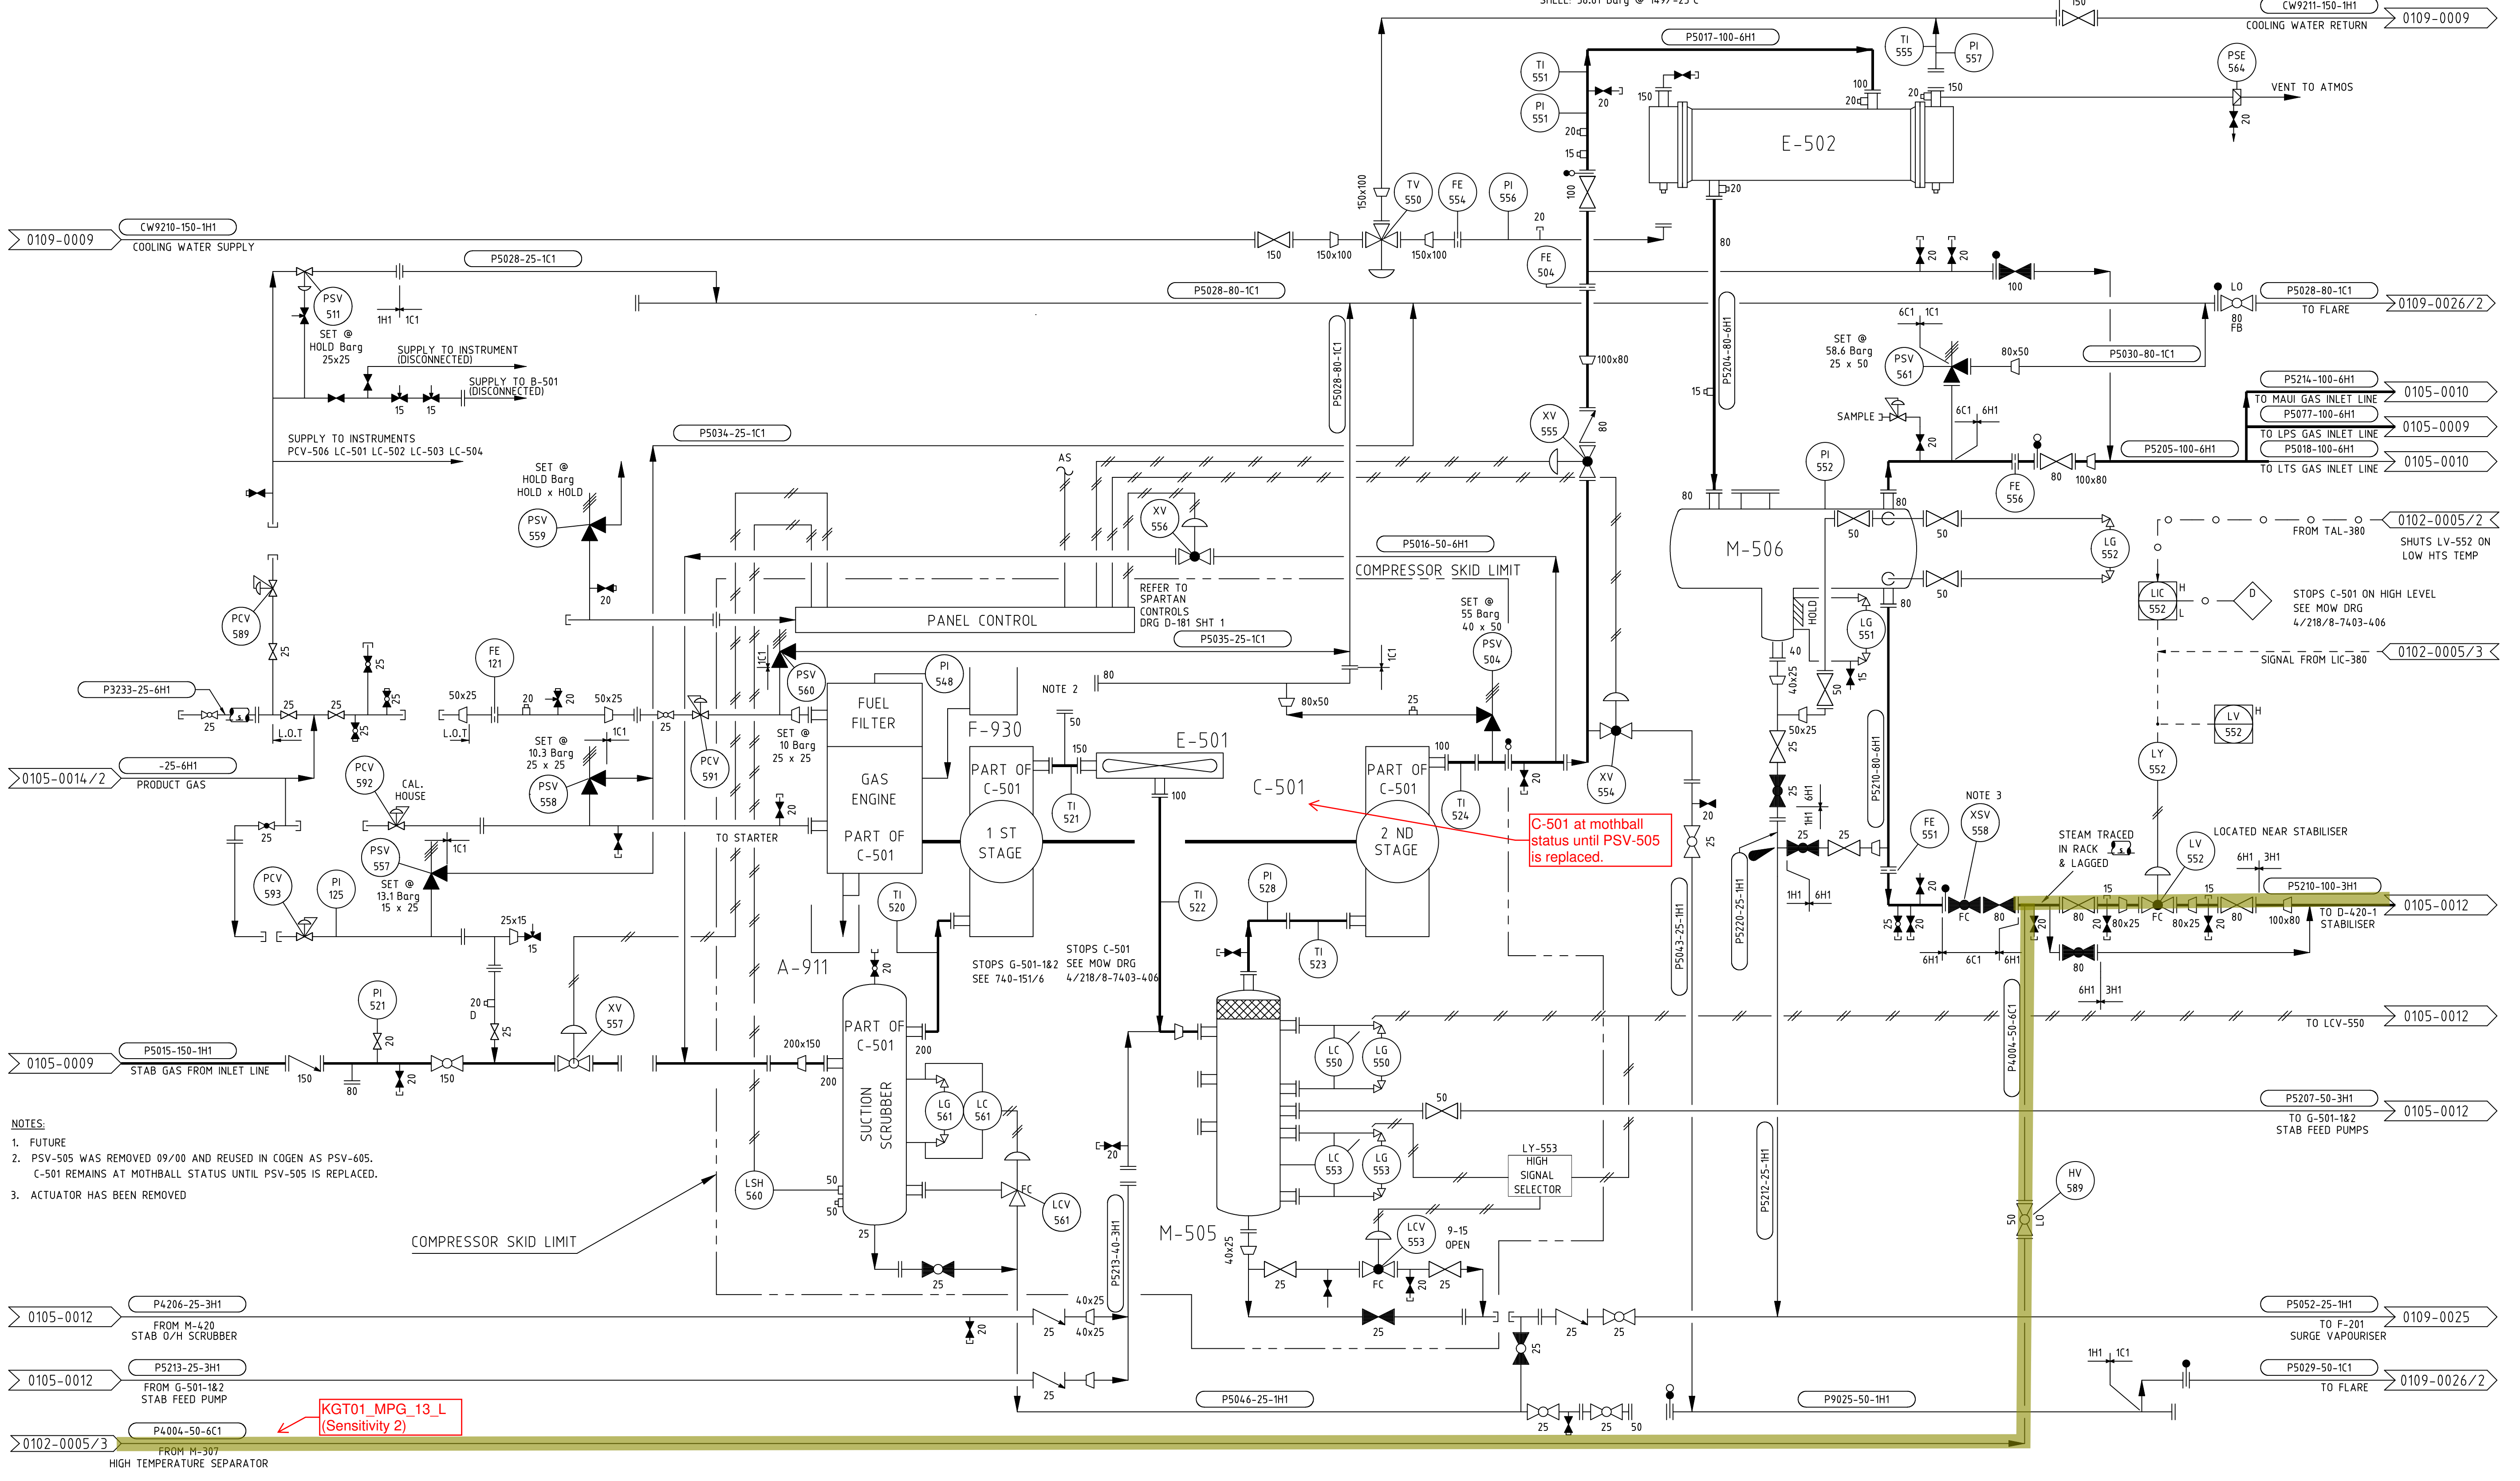

- NOTES:
1. FUTURE
 2. PSV-505 WAS REMOVED 09/00 AND REUSED IN COGEN AS PSV-605. C-501 REMAINS AT MOTHBALL STATUS UNTIL PSV-505 IS REPLACED.
 3. ACTUATOR HAS BEEN REMOVED

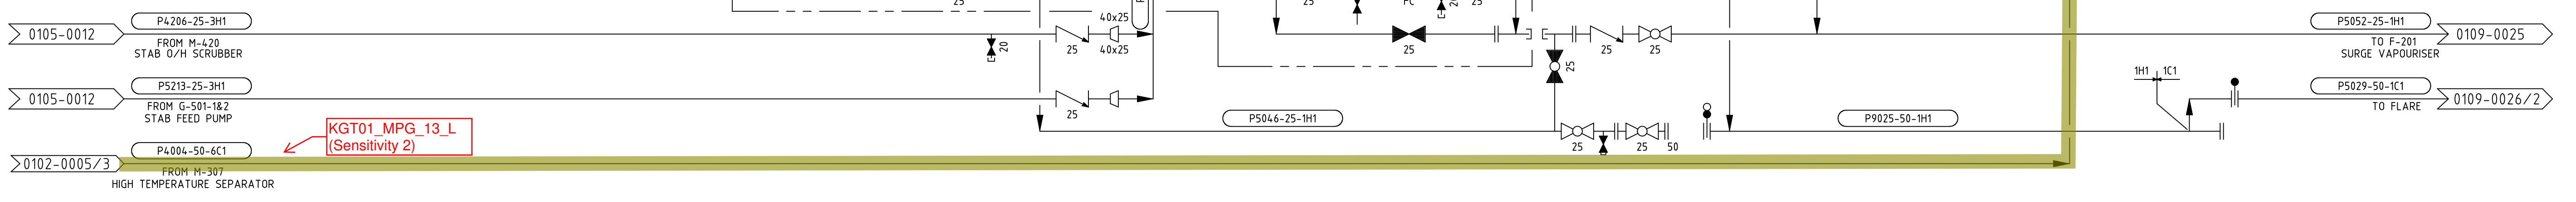

REV	BY	CHK	ENG	APP	DATE	REV	BY	CHK	ENG	APP	DATE
23					06/2006						
22					06/2005						
21					07/2004	31					
20					10/02	30					
19					08/02	29					
18					02/01	28					
17					10/00	27					
16					10/99	26					
15					02/98	25					
14					02/96	24					

VECTOR KAPUNI LIMITED
PRIVATE BAG 2020
NEW PLYMOUTH 4342
PHONE 0800 734 567

ssj^o

COPYRIGHT The copyright in this document is vested in Vector Kapuni Limited. The contents of this document shall not be reproduced, either in whole or part, by any means whatsoever without the prior written consent of Vector Kapuni Limited.


REFERENCE DRAWINGS

CAUSE & EFFECTS - 0780-0081/1
CAUSE & EFFECTS - 0780-0082/5

DRN	P.RAWLES	DATE	ENG	K.EDEN	DATE
CHK	R.vanLIJF	01/01/1987	APP	R.vanLIJF	24/03/1987

PRODUCT LINES AND COMPRESSORS
PIPING & INSTRUMENT DIAGRAM
INLET LINES - STAB GAS COMPRESSOR

SCALE:	JOB NO.	SERIES	DRG. NO	SHT	REVISION
NONE	1000000	0105	0011	01 OF 01 SHTS	31

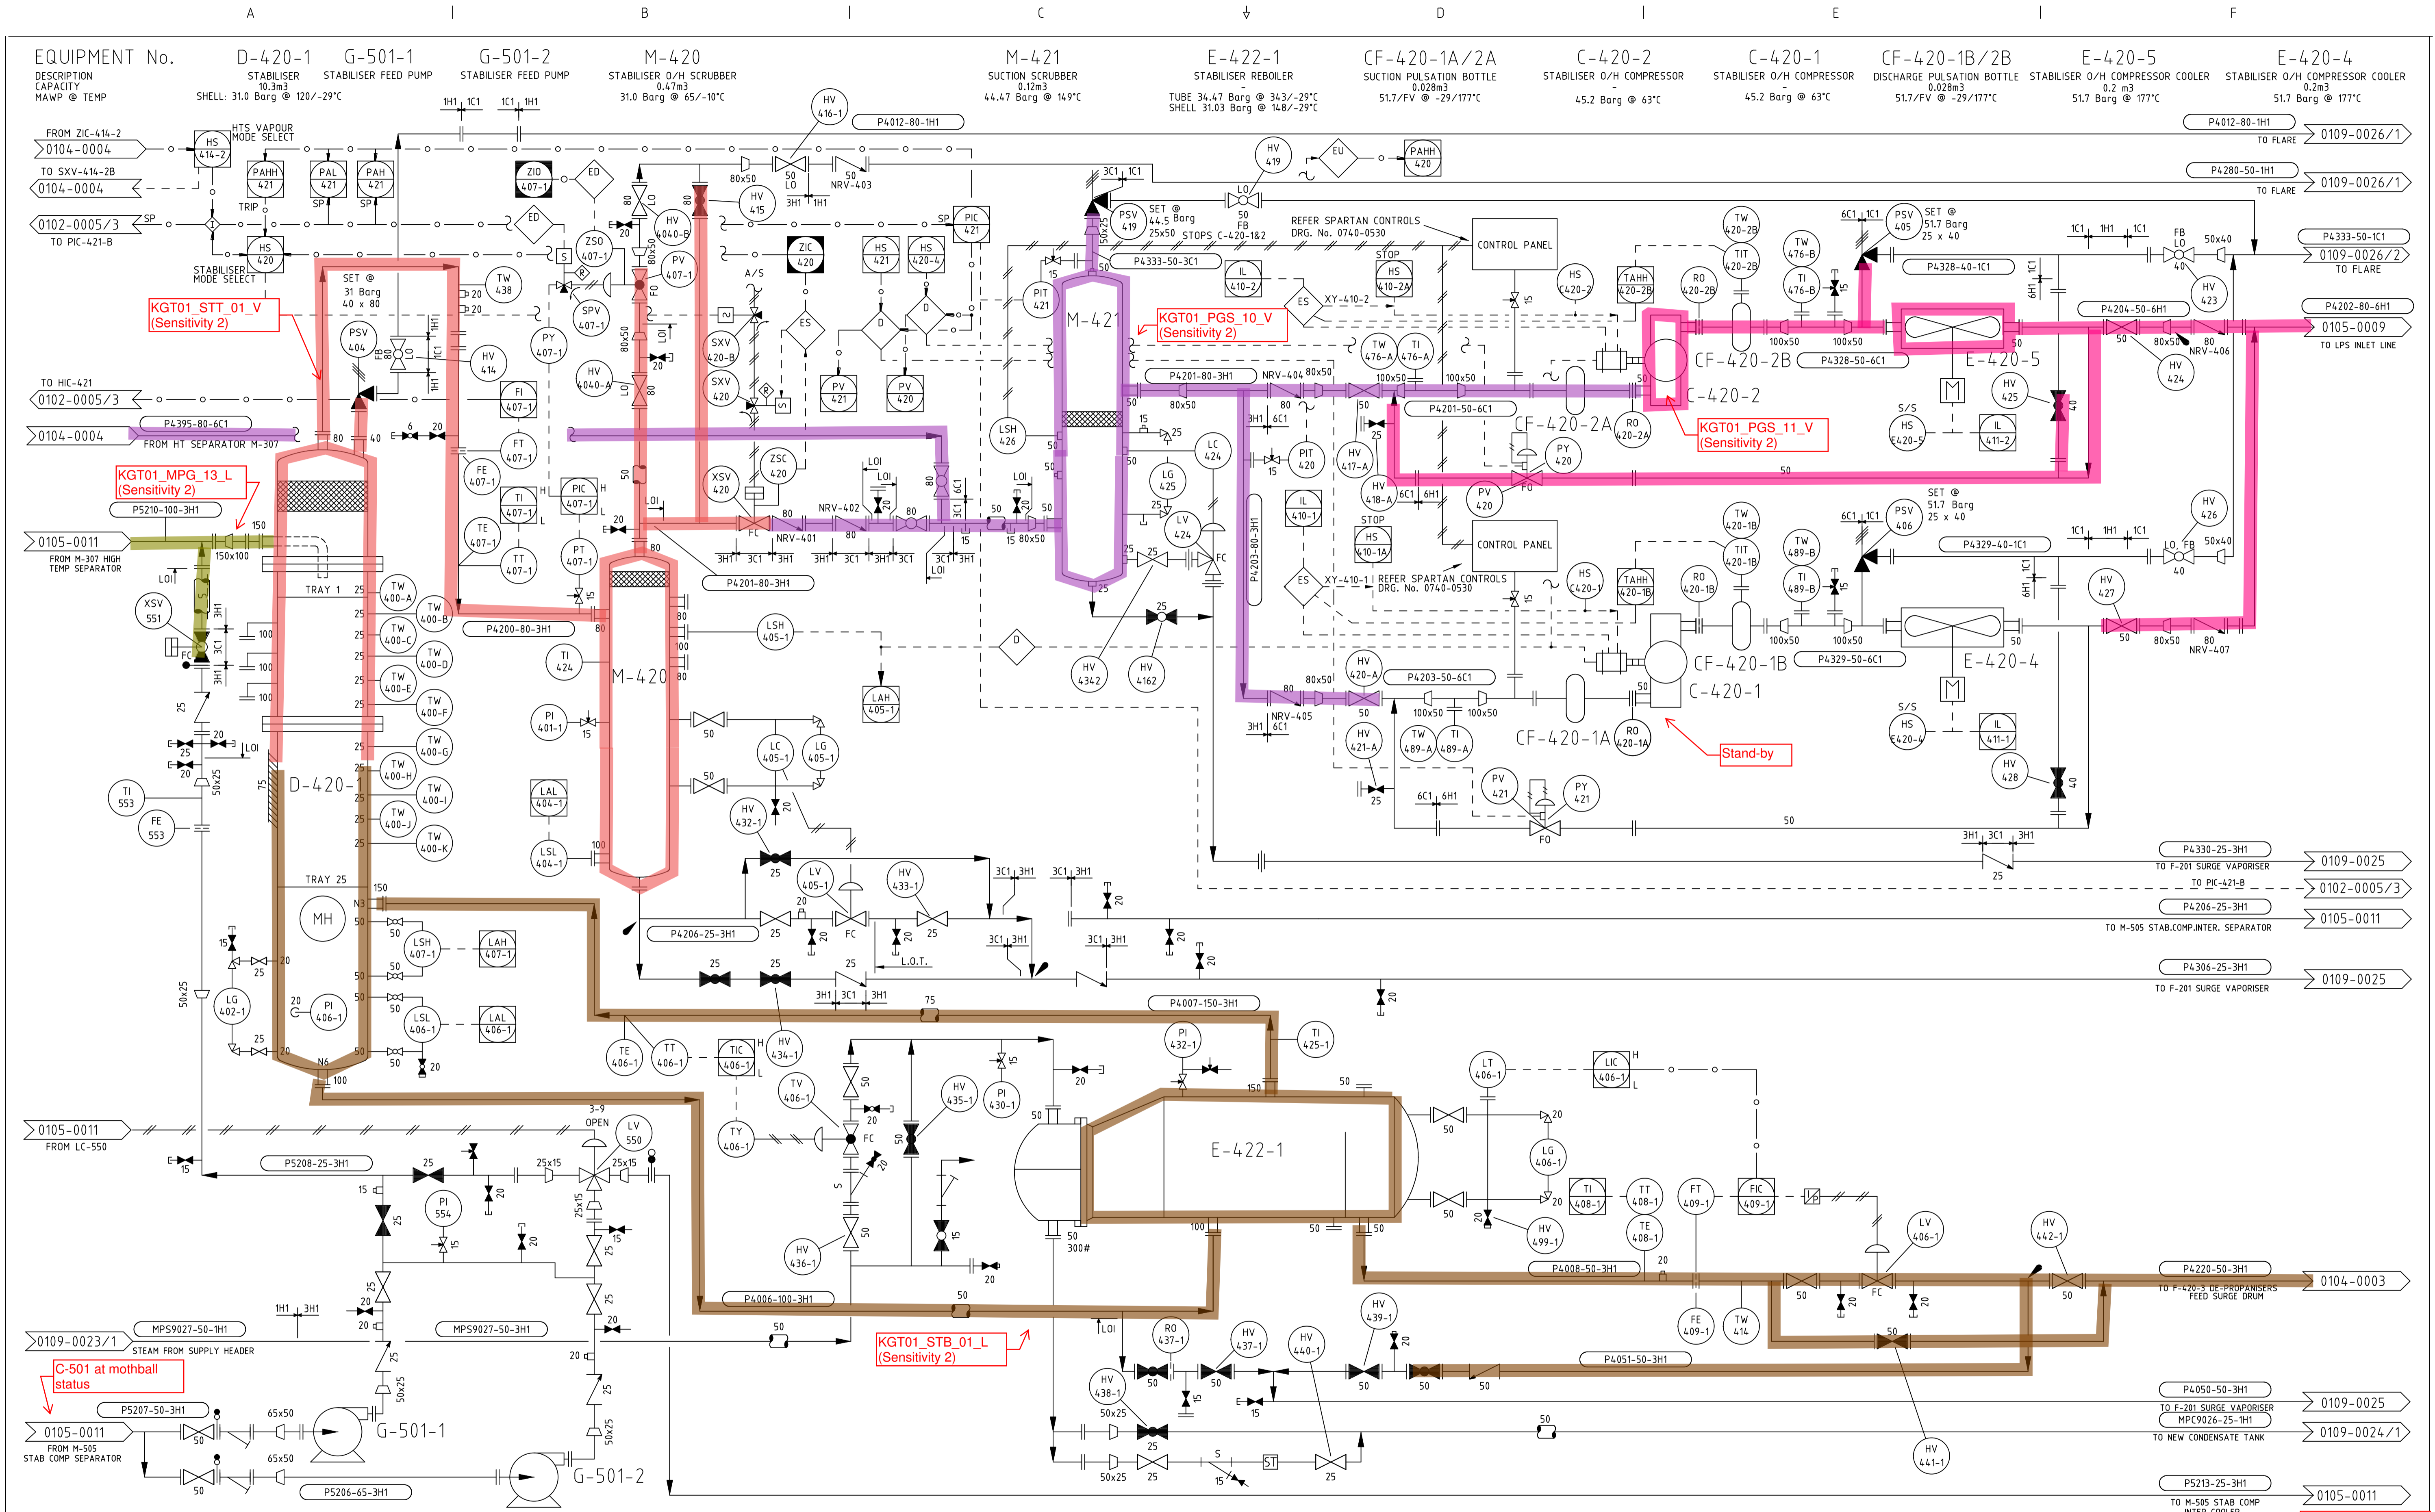

REV	AMENDMENT	BY	CHK	ENG	APP	DATE	REV	AMENDMENT	BY	CHK	ENG	APP	DATE
22	HAND VALVE NUMBERS ADDED FOR ISOLATIONS	RL	CR	AM	SES	07/2013	12	AS BUILT FOR WS133241 EDP COMM & DESIGN DATA ADDED	CMW	RL	AvG	AIM	08/02
21	AS BUILT P84-1131 HTS VAPOUR RECYCLE 3 TRAIN OP.	ES/RL	AAB	AM	SES	10/12	11	FLANGES ADDED TO VALVES ON P4051	VB	RL	EJH	RJW	02/01
20	AS BUILT P84-1041 FLARE GAS MEASUREMENT	ES/RL	TC	AM	SES	09/12							
19	AS BUILT P84-1541 AUTOMATIC LEVEL CONTROL	ES/RL	TC	SH	SES	10/11							
18	AS BUILT P84-1131 HTS VAPOUR RECYCLE 3 TRAIN OP.	CJ	GH	JS	LH	09/10	28	HAND VALVE NUMBERS ADDED FOR ISOLATIONS	RL	JCC	AM	TC	09/2018
17	AS BUILT WS1366493 HTS VAPOUR TO DEC2	VB	KS	PWM	LH	01/10	27	SPEC CHANGE ON LINE MPS9027, REMOVE XT-005 & LO ON XSV-420	RL	JCC	AM	SES	01/2017
16	AS BUILT WS2017750 STABILISER LEVELS	ES	TC	LH	SES	09/09	26	P84-844 LPG SAMPLE POINTS CONNECTED TO FLARE AS BUILT	CJ	JT	AM	SES	08/2015
15	AS BUILT WS 1449299	ES	CB	CJ	SES	05/09	25	AS BUILT LO VALVES, VALVE NUMBERING AND ISOLATED EQUIP.	RL	JC/NA	AM	SES	08/2015
14	FI-407-1 LOW ALARM DELETED	JM	MD	LH	PJR	06/2005	24	AS BUILT P84-1219 F-201 OVERPRESSURE	LN	CJ	AM	SES	06/2015
13	PROCESS ISOLATION POINTS ADDED ON INDIVIDUAL LAYERS	CMW	RL	CM	AIM	10/02	23	REVISED FPR P&ID SPLITTING, CONT. DRG. No's REVISED	RL	JCC	AM	SES	01/2015

VECTOR KAPUNI LIMITED
PRIVATE BAG 2020
NEW PLYMOUTH 4342
PHONE 0800 734 567

REFERENCE DRAWINGS
CAUSE & EFFECTS - 0780-0080/2
CAUSE & EFFECTS - 0780-0080/3

SCALE: NONE
JOB NO. 1000000
SERIES 0105
DRG. NO. 0012
SHT 01 OF 01 SHTS
REVISION 28

DATE: 01/02/1987
DATE: 24/03/1987

DATE: 01/02/1987
DATE: 24/03/1987

REV	AMENDMENT	BY	CHK	ENG	APP	DATE	REV	AMENDMENT	BY	CHK	ENG	APP	DATE
22	HAND VALVE NUMBERS ADDED FOR ISOLATIONS	RL	CR	AM	SES	07/2013	12	AS BUILT FOR WS133241 EDP COMM & DESIGN DATA ADDED	CMW	RL	AvG	AIM	08/02
21	AS BUILT P84-1131 HTS VAPOUR RECYCLE 3 TRAIN OP.	ES/RL	AAB	AM	SES	10/12	11	FLANGES ADDED TO VALVES ON P4051	VB	RL	EJH	RJW	02/01
20	AS BUILT P84-1041 FLARE GAS MEASUREMENT	ES/RL	TC	AM	SES	09/12							
19	AS BUILT P84-1541 AUTOMATIC LEVEL CONTROL	ES/RL	TC	SH	SES	10/11							
18	AS BUILT P84-1131 HTS VAPOUR RECYCLE 3 TRAIN OP.	CJ	GH	JS	LH	09/10	28	HAND VALVE NUMBERS ADDED FOR ISOLATIONS	RL	JCC	AM	TC	09/2018
17	AS BUILT WS1366493 HTS VAPOUR TO DEC2	VB	KS	PWM	LH	01/10	27	SPEC CHANGE ON LINE MPS9027, REMOVE XT-005 & LO ON XSV-420	RL	JCC	AM	SES	01/2017
16	AS BUILT WS2017750 STABILISER LEVELS	ES	TC	LH	SES	09/09	26	P84-844 LPG SAMPLE POINTS CONNECTED TO FLARE AS BUILT	CJ	JT	AM	SES	08/2015
15	AS BUILT WS 1449299	ES	CB	CJ	SES	05/09	25	AS BUILT LO VALVES, VALVE NUMBERING AND ISOLATED EQUIP.	RL	JC/NA	AM	SES	08/2015
14	FI-407-1 LOW ALARM DELETED	JM	MD	LH	PJR	06/2005	24	AS BUILT P84-1219 F-201 OVERPRESSURE	LN	CJ	AM	SES	06/2015
13	PROCESS ISOLATION POINTS ADDED ON INDIVIDUAL LAYERS	CMW	RL	CM	AIM	10/02	23	REVISED FPR P&ID SPLITTING, CONT. DRG. No's REVISED	RL	JCC	AM	SES	01/2015

Stabiliser system is stand-by condition. Only considered in Sensitivity case 2.

EQUIPMENT No.

DESCRIPTION
CAPACITY
MAWP @ TEMP

M-422
DE-ETHANISER O/H COMP SUCTION SCRUBBER
0.12m³
44.5 Barg @ 14.9°C

C-421-1
DE-ETHANISER O/H COMPRESSOR
Xm3
43.4 Barg @ X°C


C-421-2
DE-ETHANISER O/H COMPRESSOR
Xm3
43.4 Barg @ X°C

CF-421-1A/2A
SUCTION PULSATION BOTTLE
0.024m³
51.7 @ -29/14.9°C

CF-421-1B/2B
DISCHARGE PULSATION BOTTLE
0.024m³
75 @ -29/177°C

E-421-1
DE-ETHANISER O/H COMPRESSOR COOLER
0.014m³
51.7 Barg @ 177°C

E-421-2
DE-ETHANISER O/H COMPRESSOR COOLER
0.014m³
51.7 Barg @ 177°C

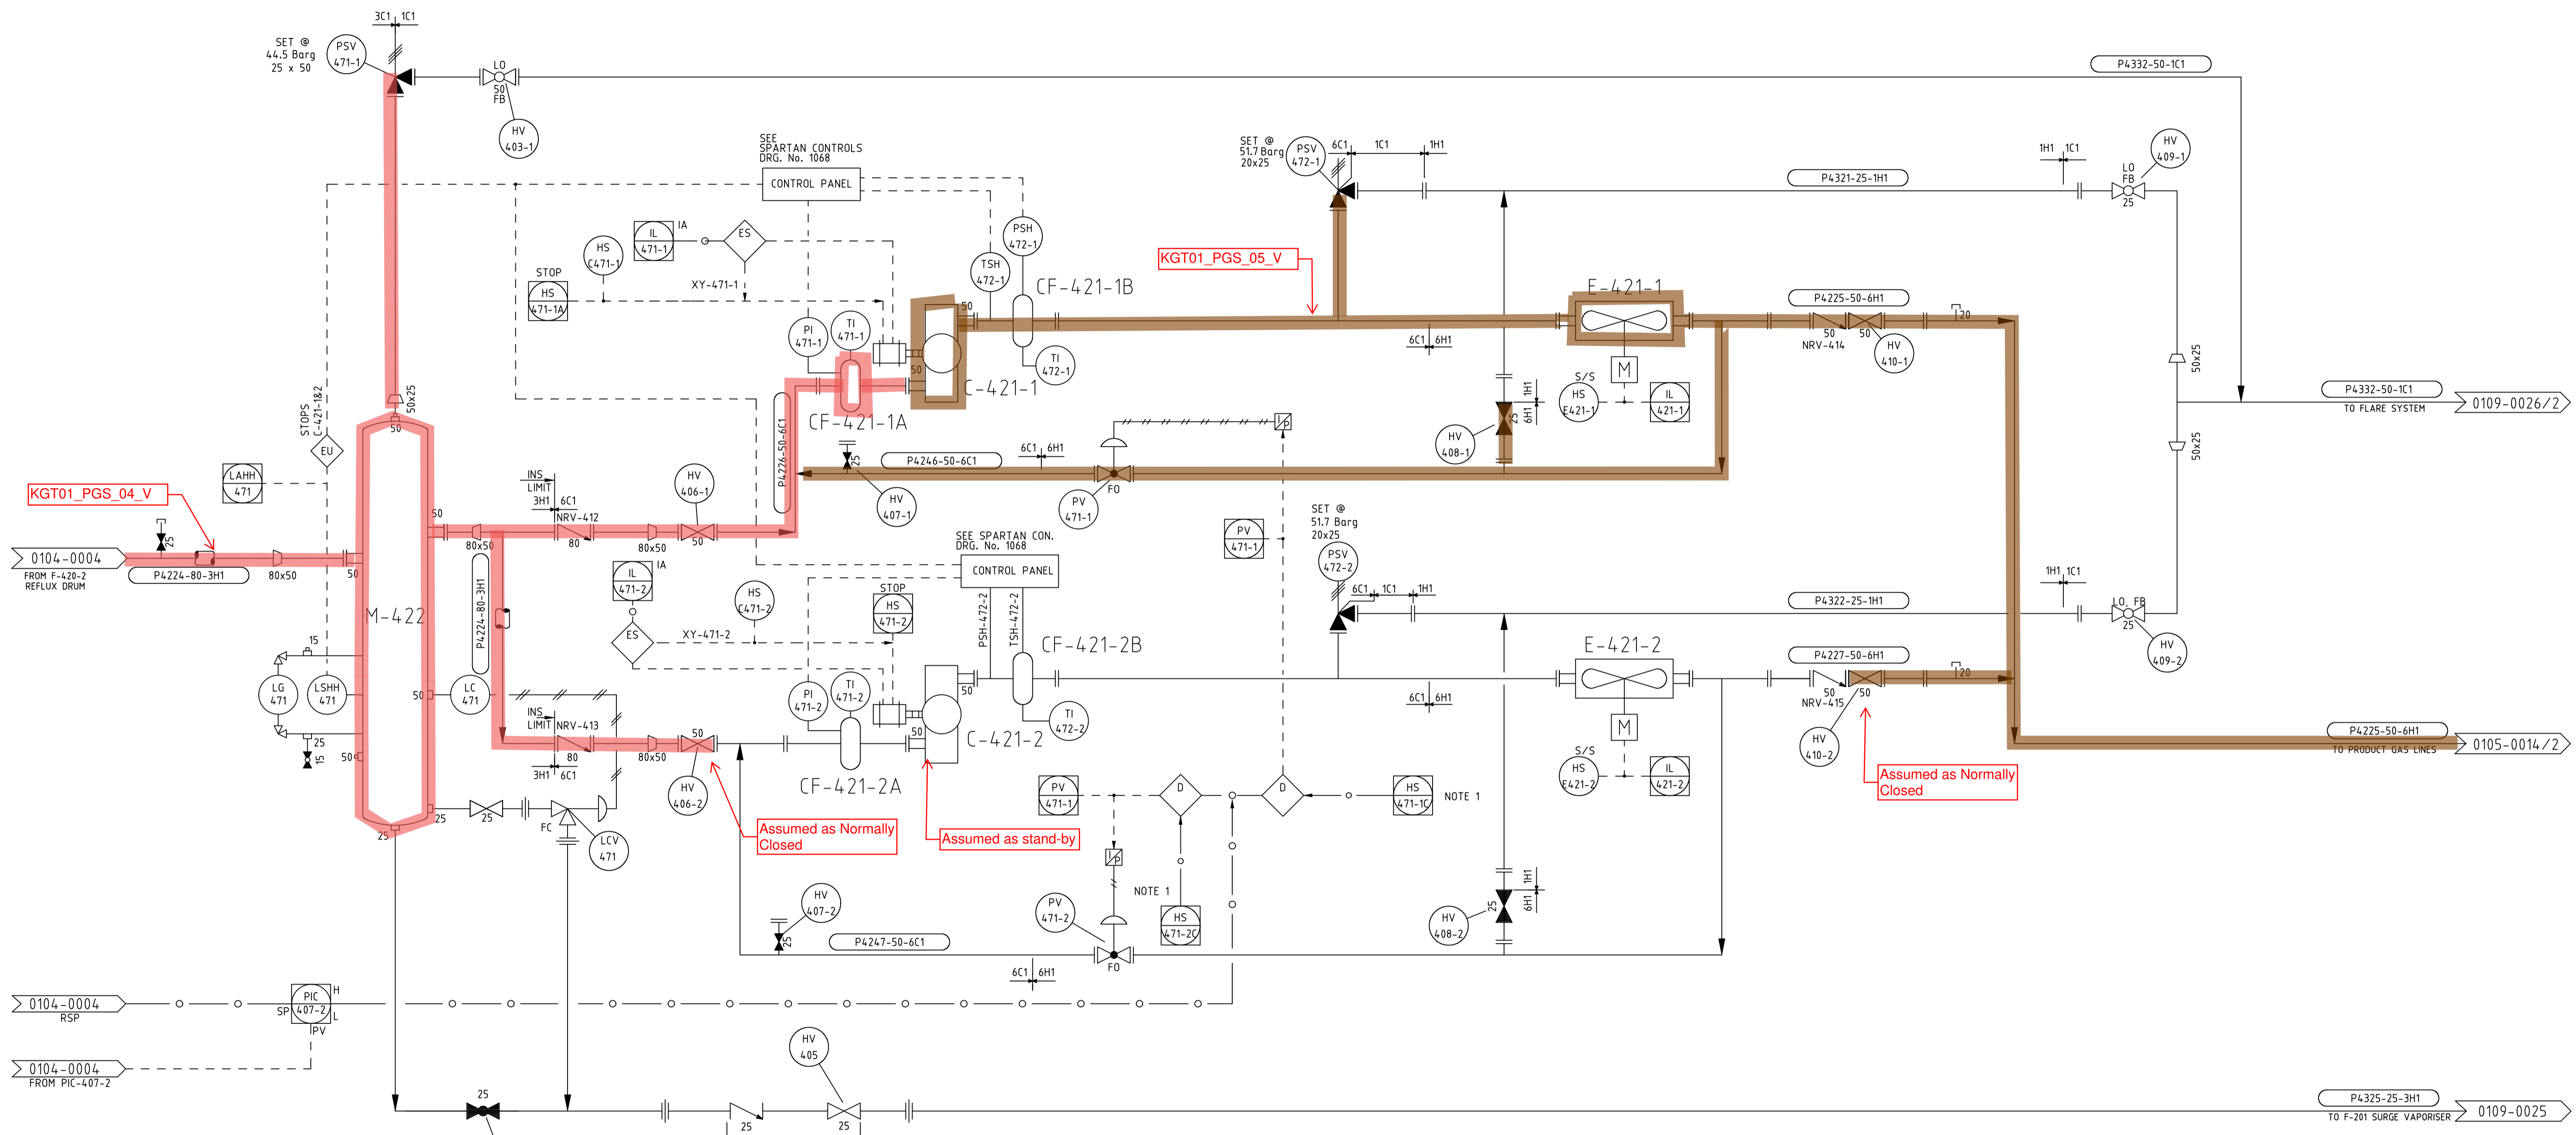

NOTE
1. HS-471-1C & -2C OPEN PV-471-1 & -2 RESPECTIVELY FOR FULL RECYCLE FLOW.

REV	AMENDMENT	BY	CHK	ENG	APP	DATE	REV	AMENDMENT	BY	CHK	ENG	APP	DATE
45	AS BUILT VENTS D/STREAM OF PSV-560 & 561 RUN TO COMMON HEADER	RL/ES	MB	LH	SES	09/2010	55	HAND VALVE NUMBERS ADDED FOR ISOLATIONS					
							54	AS BUILT P84-1041 FLARE GAS MEASUREMENT	ES/RL	TC	AM	SES	09/2012
							53	CONTIN. DRG. NO. REVISED FOR EXPORT COMPRESSOR RE-NUMBERING	ES/RL	MH	AM	SES	05/2012
62	AS BUILT P84-1438 LPG HAZOP COMMENTS & REMOVE XT-006	RL	JCC	AM	TC	11/2019	52	P84-814 AS BUILT PORT. ODORANT TANK. PSV-586 SET PRESS ADDED	RL	JG	AM	SES	04/2012
61	P&ID SPLITTING 015-0014-01	JCC	RL/NM	AM	SES	06/2016	51	P84-814 PARTIAL AS BUILT PORTABLE ODORANT TANK	LN	CJ	AM	SES	03/2012
60	AS BUILT P84-1140 SAMPLE REL. DEMARCATION ADDED	JCC	RL	AM	SES	05/2016	50	P84-3100 PARTIAL AS BUILT DE-ETH STAB OVHD COMP PSV	CJ	WB	AM	SES	02/2012
59	AS BUILT LO VALVES, HV-543-A WAS LO & HV-9601 WAS LC	RL	JC	AM	SES	02/2016	49	AS BUILT P84-1070 PRESSURISING GAS FROM GAS GATHERING LINE	RL/MW	LR	JS	SES	07/2011
58	AS BUILT LO VALVES, VALVE NUMBERING & ISOLATED EQUIP.	RL	JC/NA	AM	SES	08/2015	48	LOGIC ASSOCIATED WITH ZSC-9601 AS BUILT	RL/ES	TC	JS	SES	06/2011
57	HAND VALVE NUMBER HV-403-1 WAS HV-403	RL	JCC	AM	SES	09/2014	47	HOLD NOTE 1 CLARIFIED	RL/ES	TC	LH	SES	03/2011
56	AS BUILT P84-2004 PCV-548 REMOVAL & P84-848 WOBBE	RL	NA/AB	AM	SES	07/2014	46	AS BUILT P84-35. FT-114 FLOW CONDIT. PLATES. PC-KGP-11-KGTH-003.	RL/ES	TC	LH	SES	10/2010

VECTOR KAPUNI LIMITED
PRIVATE BAG 2020
NEW PLYMOUTH 4342
PHONE 0800 734 567

REFERENCE DRAWINGS
0780-0080/01, 02 & 03 CAUSE & EFFECTS
0780-0081/01, 02 & 03 CAUSE & EFFECTS
885-0007 LOGIC DIAGRAM


COPYRIGHT The copyright in this document is vested in Vector Kapuni Limited
The contents of this document shall not be reproduced, either in whole or part, by any
means whatsoever without the prior written consent of Vector Kapuni Limited.

AUTOCAD ORIGINAL SHEET SIZE A1

DRN	P.RAWLES	DATE	23/01/1988	ENG	DATE	DATE	DATE
CHK	R.THAMBYAH	23/01/1988	APP	J.STUART	10/02/1988	SCALE:	NONE
JOB NO.	1000000	SERIES	0105	DRG. NO	0014	SHT	01 OF 03 SHTS
REVISION	62						

EQUIPMENT No.

DESCRIPTION
CAPACITY
MAWP @ TEMP

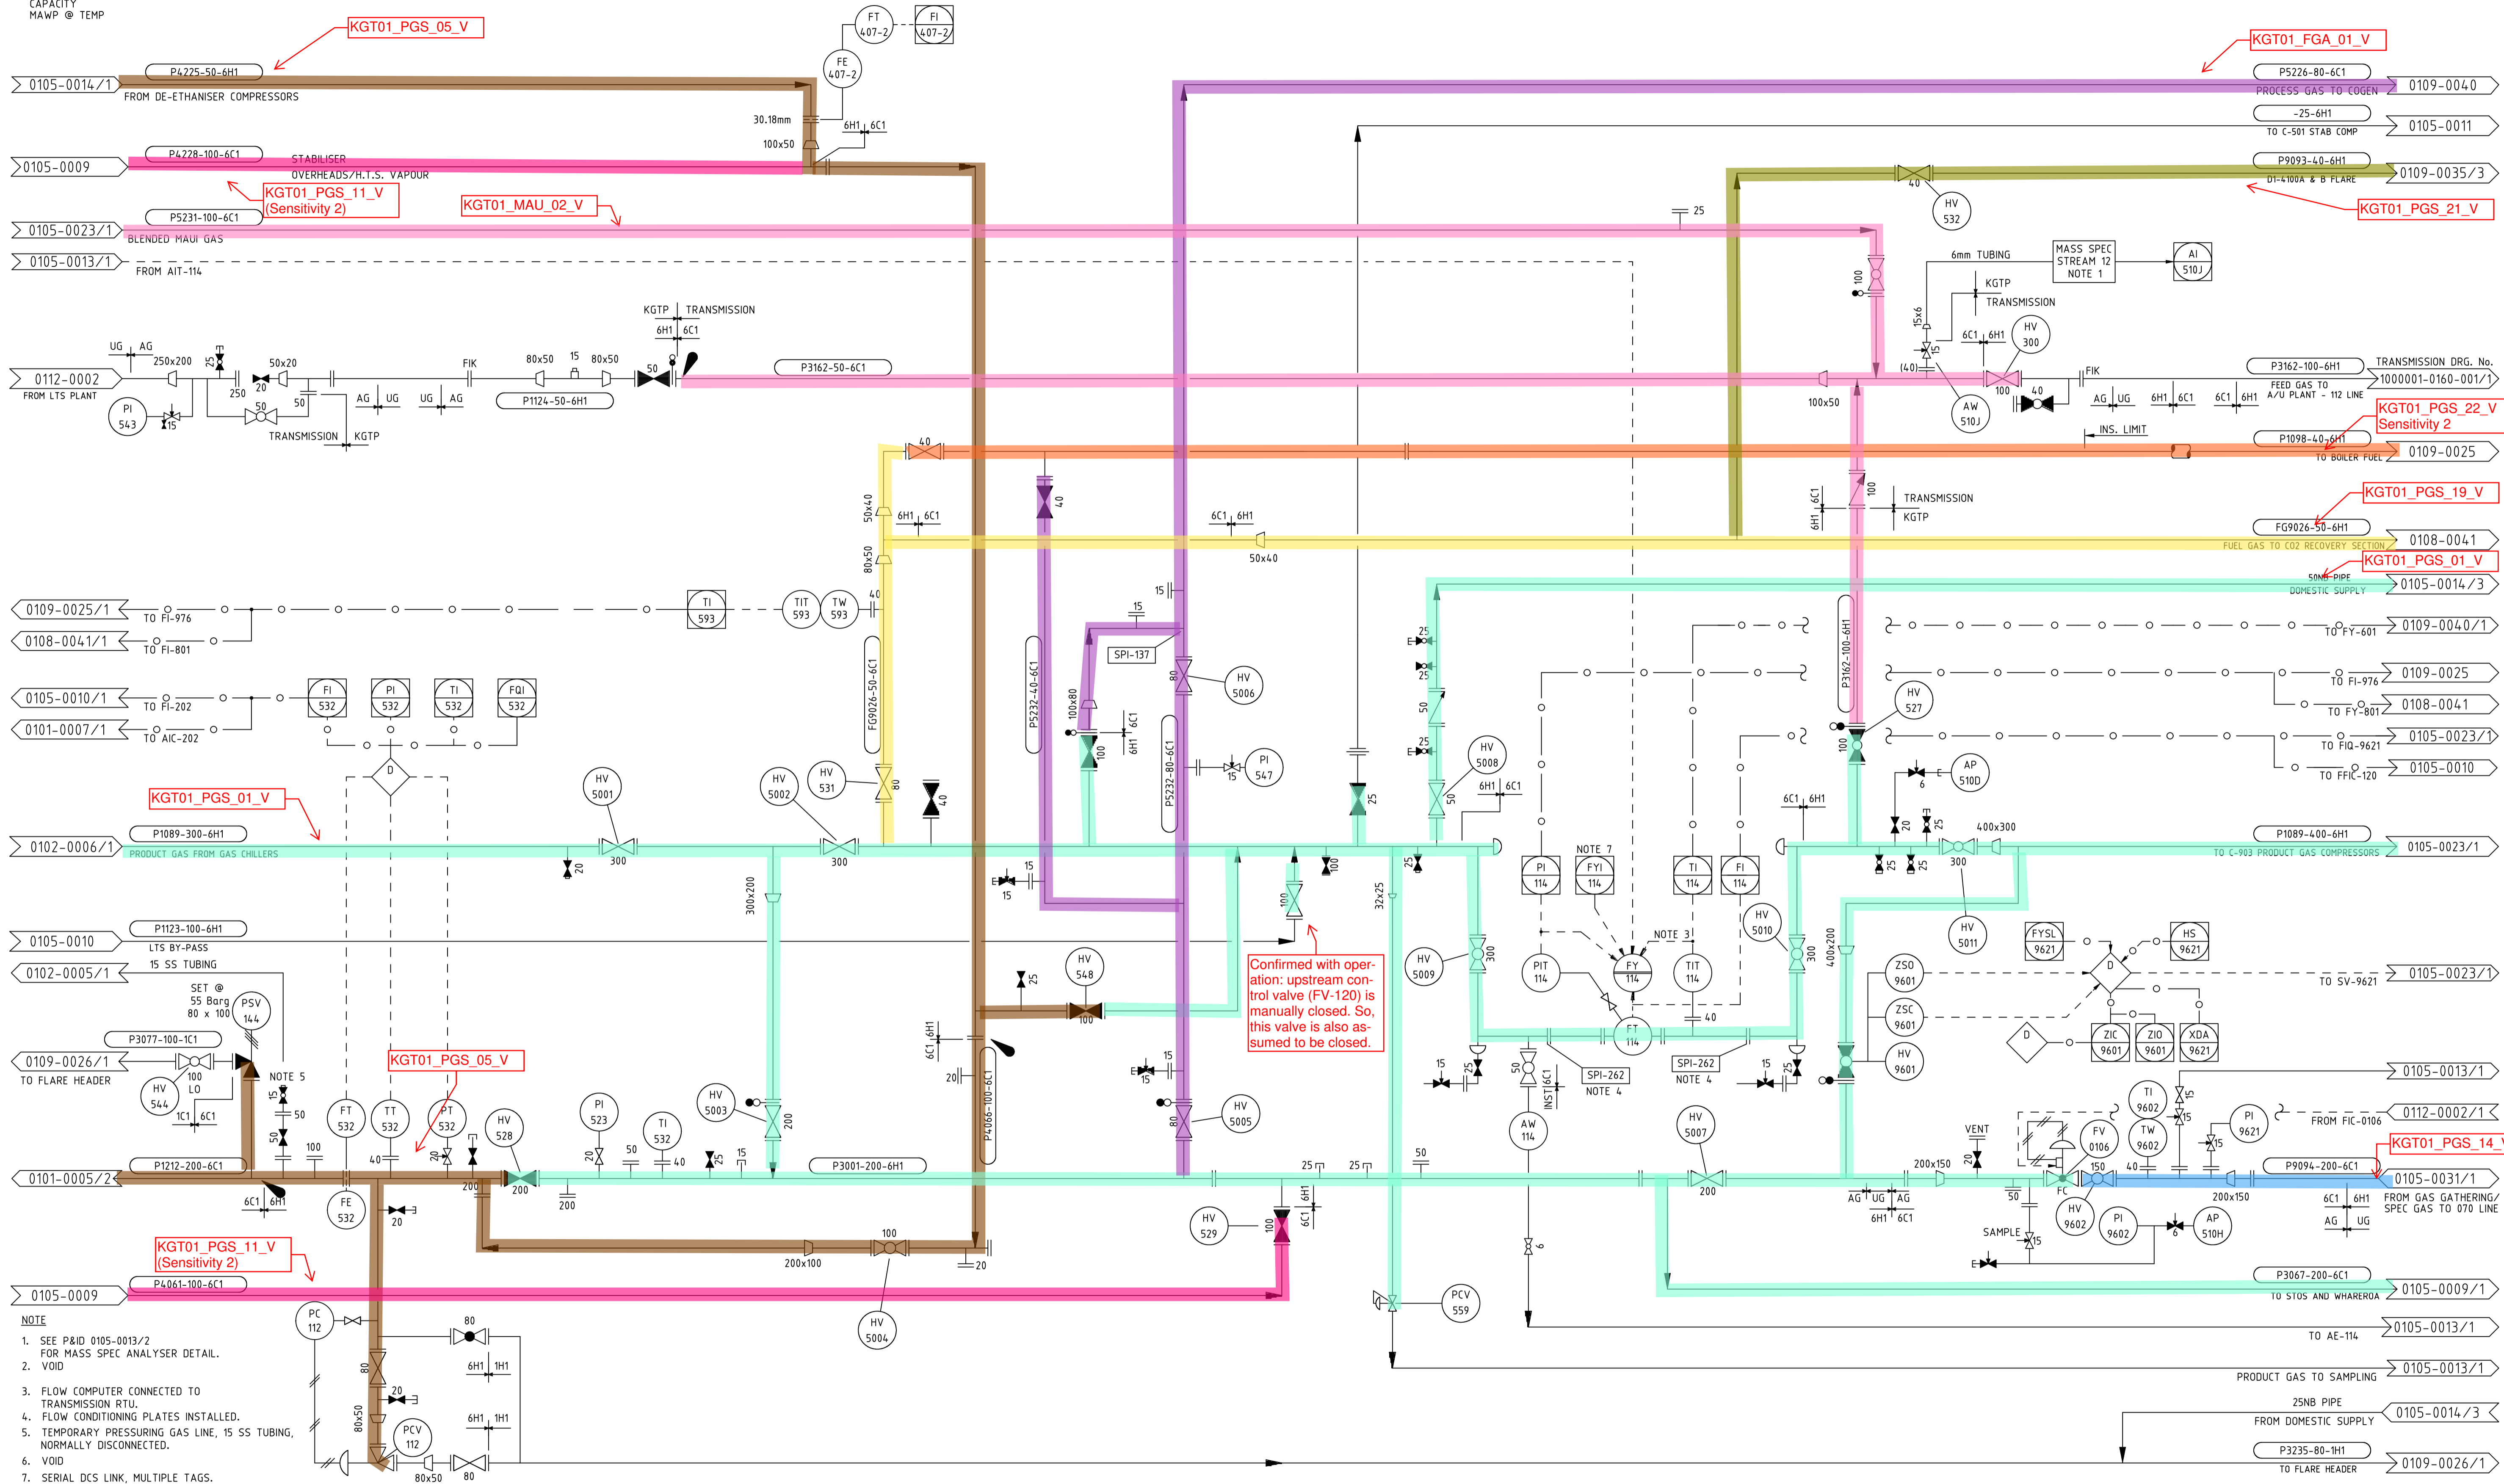

VECTOR KAPUNI LIMITED
PRIVATE BAG 2020
NEW PLYMOUTH 4342
PHONE 0800 734 567



REFERENCE DRAWINGS


DRN	P.RAWLES	23/01/1988	ENG	DATE
CHK	R.THAMBYAH	23/01/1988	APP	J.STUART 10/02/1988

PRODUCT LINES AND COMPRESSORS
PIPING & INSTRUMENT DIAGRAM
PRODUCT GAS LINES
P&ID SPLIT FROM 0105-0014-01


SCALE:	JOB NO.	SERIES	DRG. NO	SHT 02	REVISION
NONE	1000000	0105	0014	OF 03 SHTS	2

EQUIPMENT No.
DESCRIPTION
CAPACITY
MAWP @ TEMP

F-521
PORTABLE ODORANT TANK
0.05m³
31.0 Barg @ -29/100°C

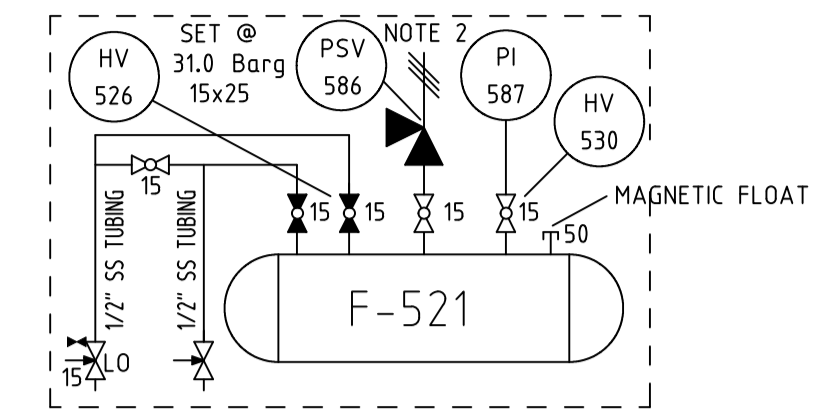

F-521 ARRANGEMENT WHEN DISCONNECTED FOR TRANSPORT/FILLING

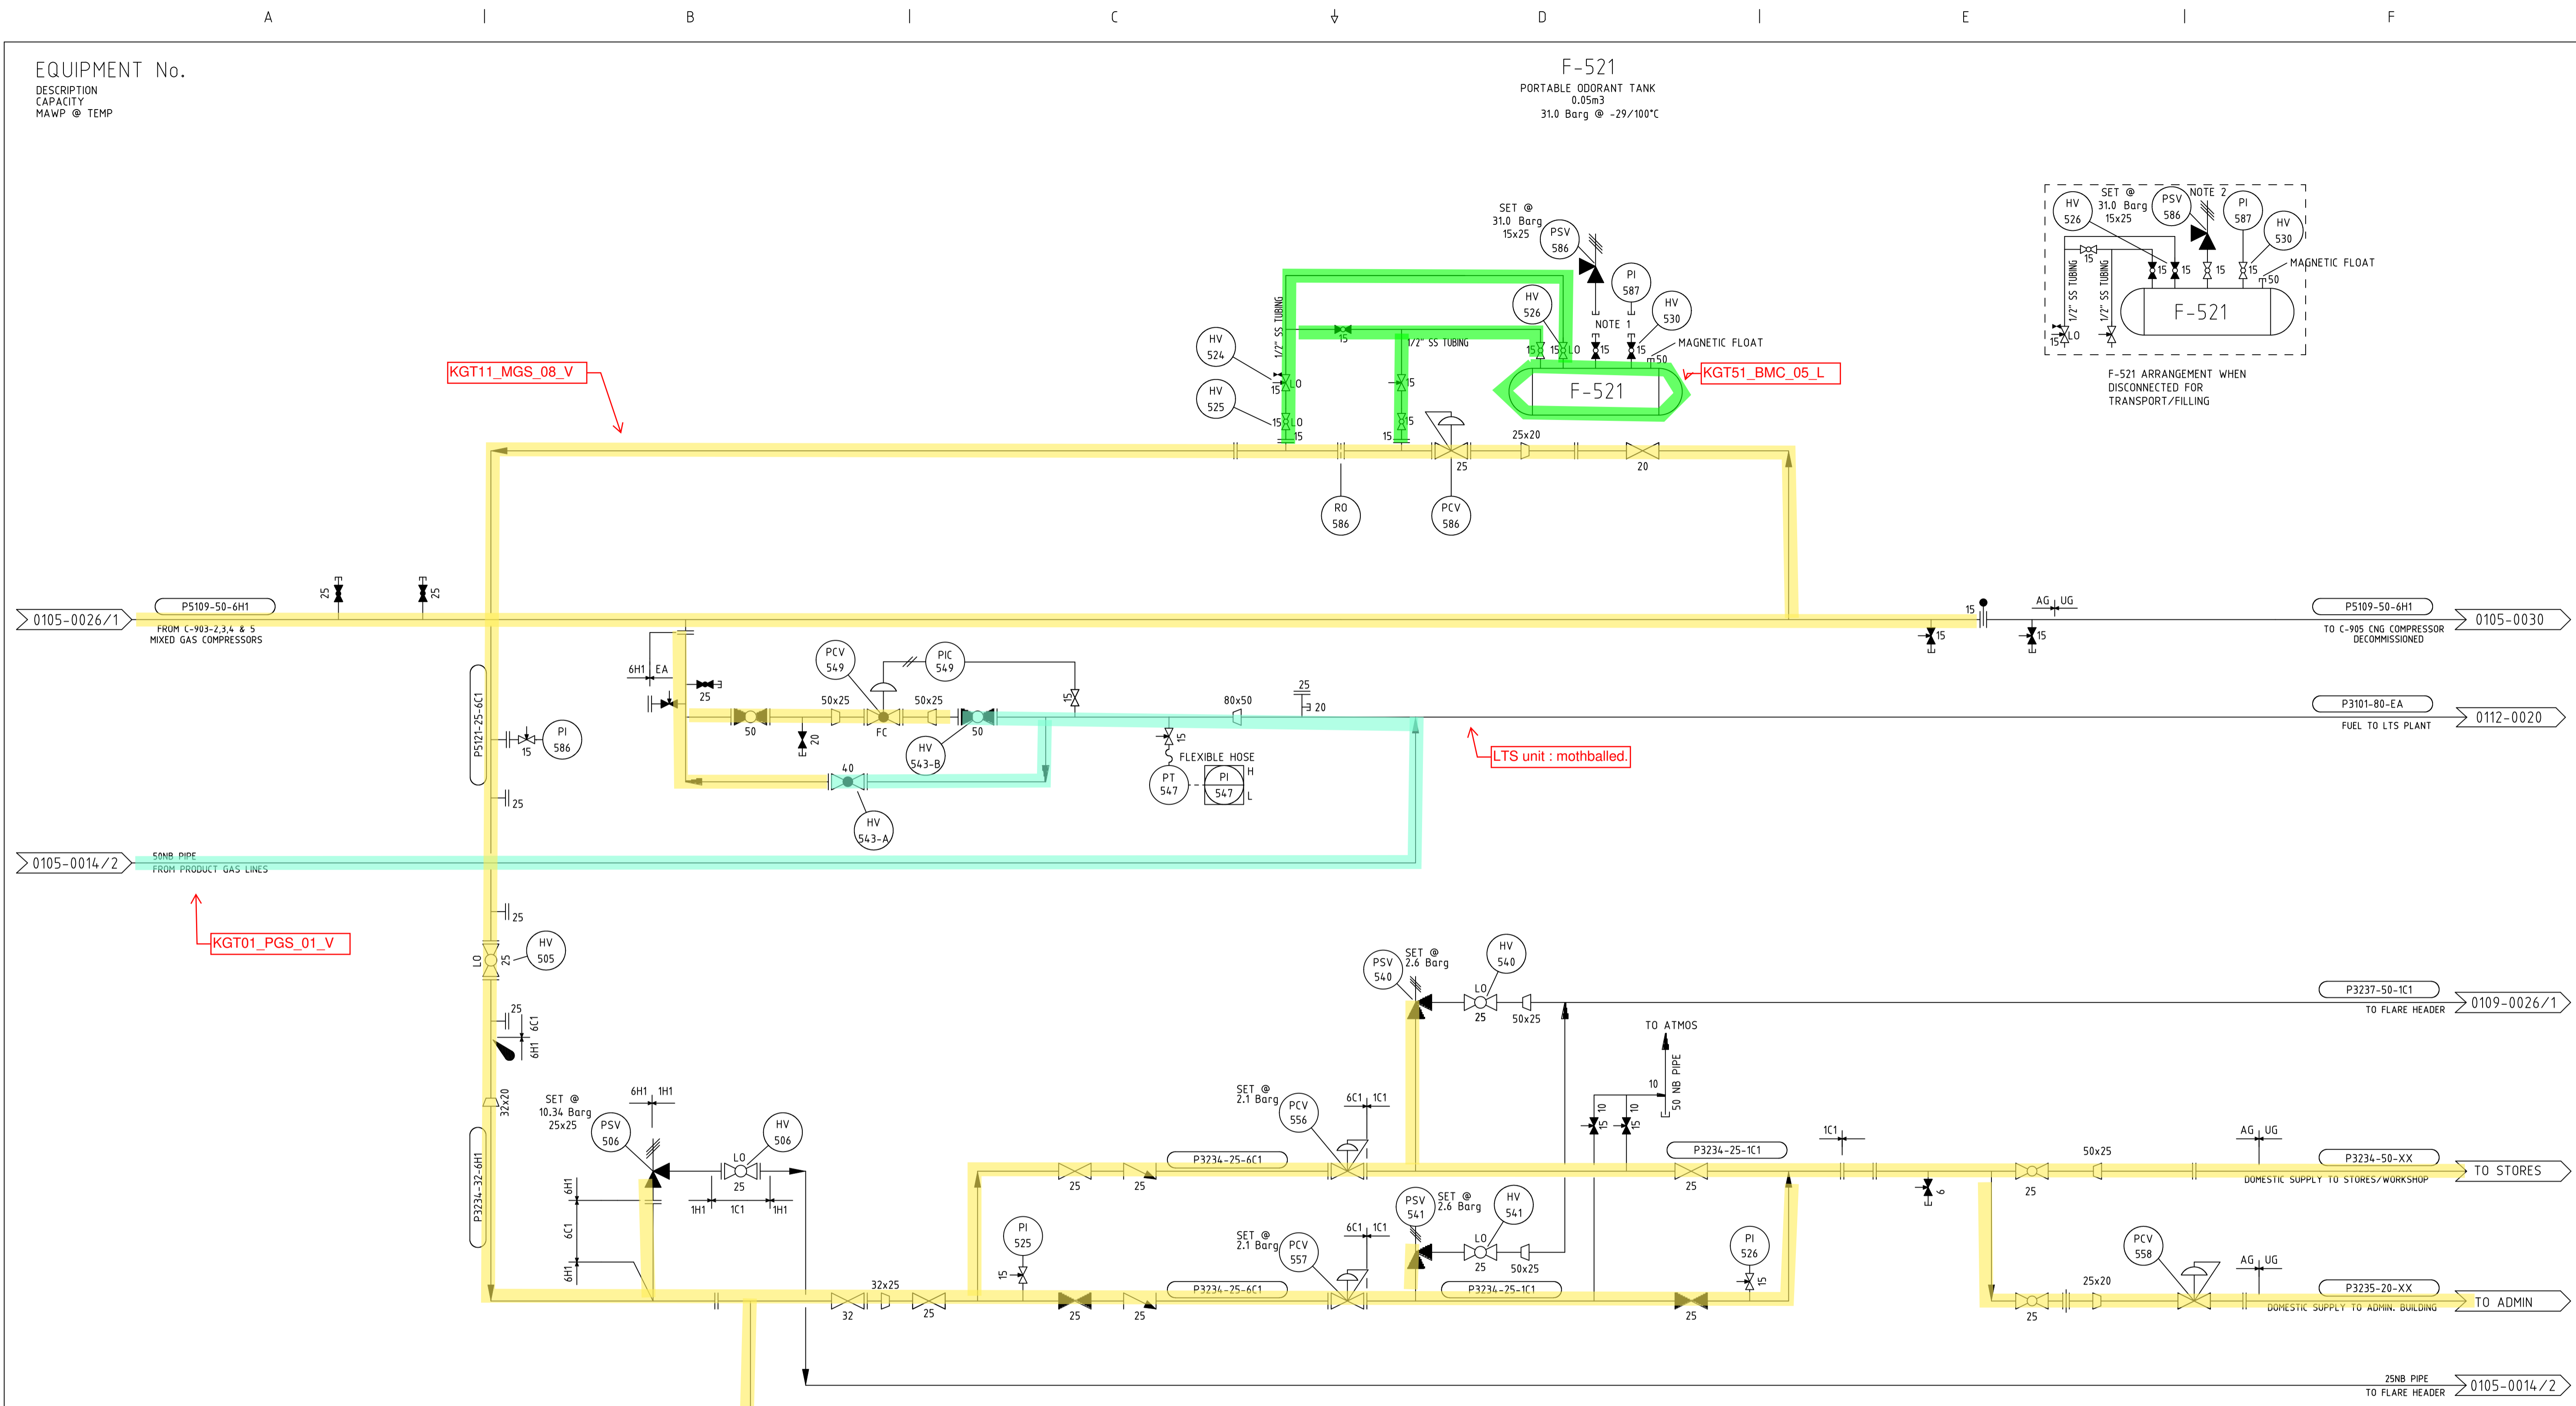

- NOTE
1. PSV-586 AND PI-587 TO BE DISCONNECTED AND LOCATED IN TANK ENCLOSURE WHILE TANK IS CONNECTED TO SYSTEM.
 2. PSV-586 AND PI-587 TO BE CONNECTED DURING TRANSPORT.

REV	AMENDMENT	BY	CHK	ENG	APP	DATE	REV	AMENDMENT	BY	CHK	ENG	APP	DATE
1	P&ID SPLIT 0105-0014-01, CHANGED NOTE 1, ADDED NOTE 2	JCC	RL	NM	SES	05/2016							

VECTOR KAPUNI LIMITED
PRIVATE BAG 2020
NEW PLYMOUTH 4342
PHONE 0800 734 567

COPYRIGHT The copyright in this document is vested in Vector Kapuni Limited. The contents of this document shall not be reproduced, either in whole or part, by any means whatsoever without the prior written consent of Vector Kapuni Limited.

REFERENCE DRAWINGS			
DRN	P.RAWLES	DATE	DATE
CHK	R.THAMBYAH	23/01/1988	10/02/1988

PRODUCT LINES AND COMPRESSORS PIPING & INSTRUMENT DIAGRAM DOMESTIC SUPPLY AND PORTABLE ODORANT P&ID SPLIT FROM 0105-0014-01					
SCALE:	JOB NO.	SERIES	DRG. NO	SHT OF 03 SHTS	REVISION
NONE	1000000	0105	0014	03	1

EQUIPMENT No.

DESCRIPTION
CAPACITY
MAWP @ TEMP

1000001-0110-001-01
(TRANSMISSION P&ID)
GAS FLOW SIGNAL FROM FY-09004A

1000001-0110-001-01
(TRANSMISSION P&ID)
FROM FI-09004A

B-552

PORTABLE FLARE

G-553

ODORANT FLUSHING PUMP
FLOW XXSm³/Hr @ XX hp
MAWP XXXBarG @ XX°C

F-553


ODORANT INJECTION TANK
38m³
3.8 Barg @ 50/0°C

G-552-A

ODORANT INJECTION PUMP
3.5 l/h
86 Barg

G-552-B

ODORANT INJECTION PUMP
3.5 l/h
86 Barg

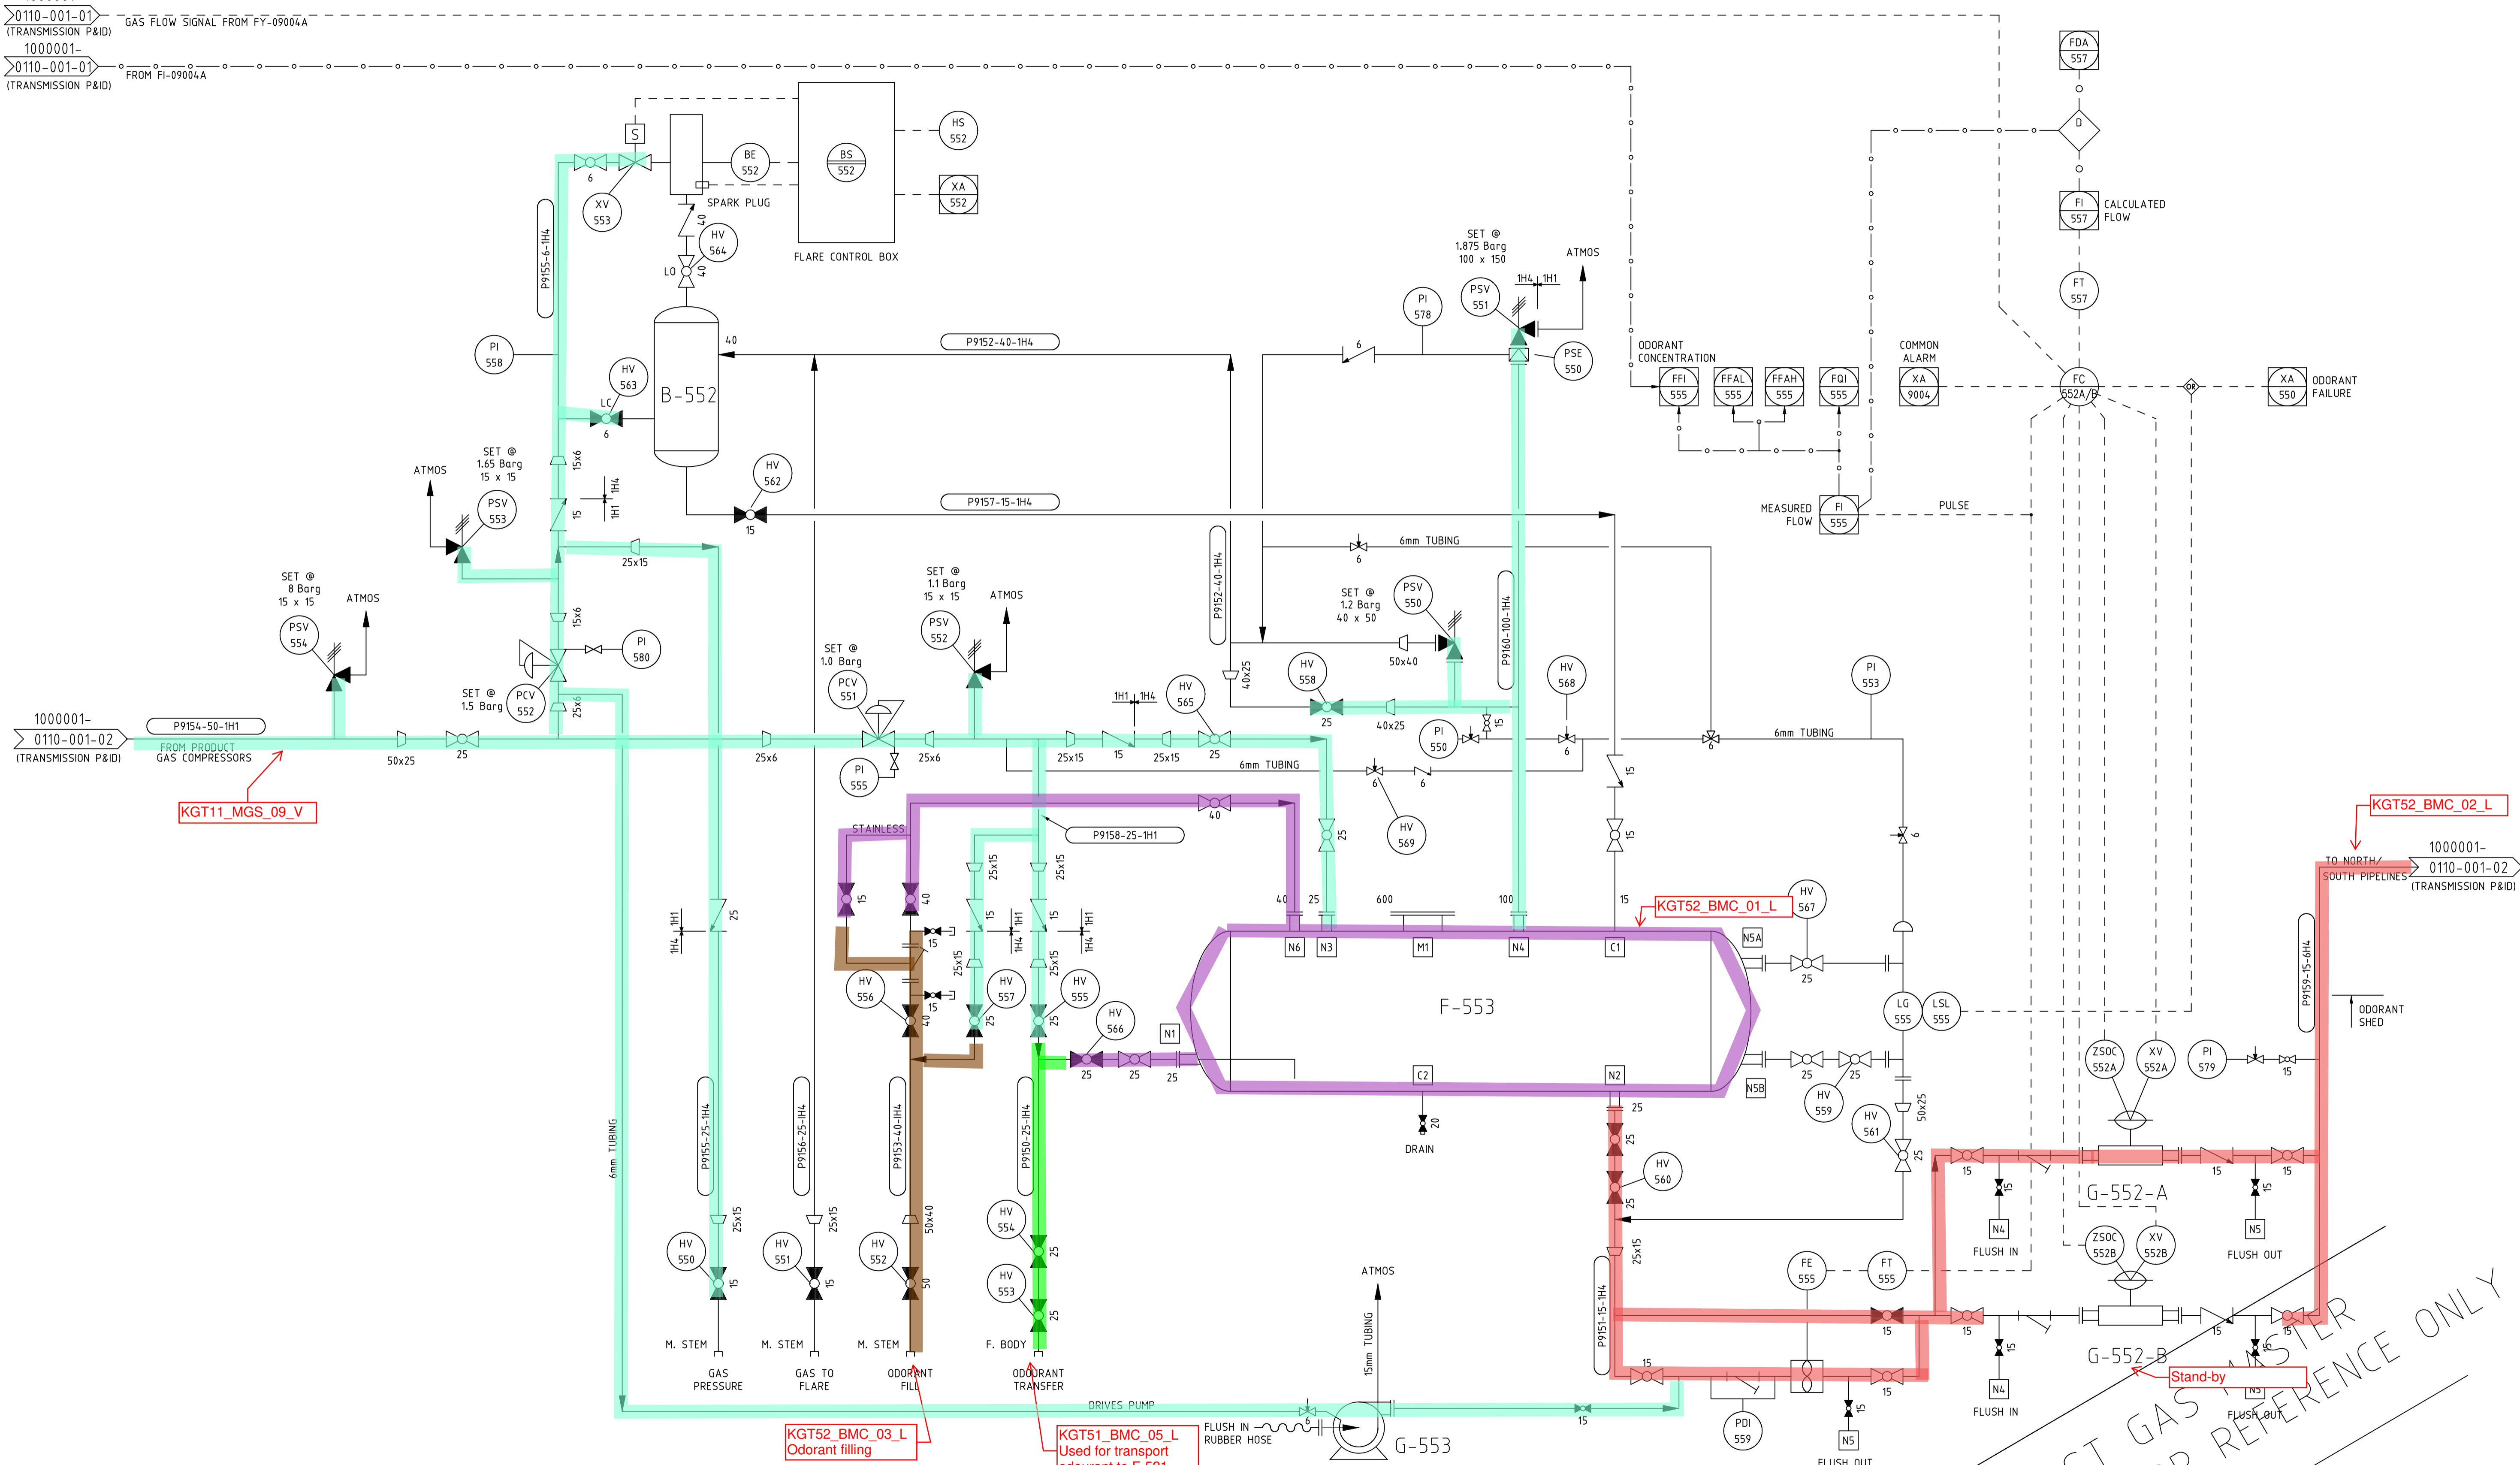

REV	AMENDMENT	BY	CHK	ENG	APP	DATE	REV	AMENDMENT	BY	CHK	ENG	APP	DATE
11	KGTP/TRANSMISSION DEMARCATION UPDATE	ES	AvG	LH	PJR	01/07							
10	KGTP/TRANSMISSION DEMARCATION UPDATE	SKM	RH	LH	PJR	11/2005							
9	AS-BUILT TO W/O #793881	ST	MB	PB	EL	06/05							
8	DESIGN DATA RATIONALISED FOR F-553	CMW	RL	AvG	AIM	08/02							
7	G-553 NUMBER & DESCRIPTION ADDED	VB	RL	EJH	RS	10/98							
6	AS BUILT FOR REFURBISHMENT PROJECT	V.B.	G.R.	K.E.	G.M.	02/98							
5	P9157-15-1H4 NOW FROM BOTTOM OF B-552	J.B.H.	R.L.	D.T.	AvG	20/11/95							
4	0105-0023 WAS TO PRODUCT GAS COMP.	P.T.D	R.L.	A.V.G.	J.B.G.	9/95							
13	AS BUILT FFAL-555 & FFAH-555 ADDED	RL	JCC	AM	SES	02/2016							
12	AS BUILT COMMENTS RE PSE SYMBOL & NOTE 1 DELETED	RL	JCC	AM	SES	04/2015							
	REDRAWN ON AUTOPLANT	V.B.	J.C.	G.M.	C.J.	9/94							

VECTOR KAPUNI LIMITED
PRIVATE BAG 2020
NEW PLYMOUTH 4342
PHONE 0800 734 567

sjio

COPYRIGHT The copyright in this document is vested in Vector Kapuni Limited
The contents of this document shall not be reproduced, either in whole or part, by any
means whatsoever without the prior written consent of Vector Kapuni Limited.


AUTOCAD ORIGINAL SHEET SIZE A1

DRN	MF	DATE	ENG	G.G.	DATE
CHK	R.S.	01/12/1987	APP	G.G.	01/05/1988

SCALE:	JOB NO.	SERIES	DRG. NO	SHT	REVISION
NTS	1000000	0105	0022	01 OF 01 SHTS	14

EQUIPMENT No.
DESCRIPTION
CAPACITY
MAWP @ TEMP

M-512
DRY GAS IN-LINE FILTER
1600 m³
68 Barg @ 20°C

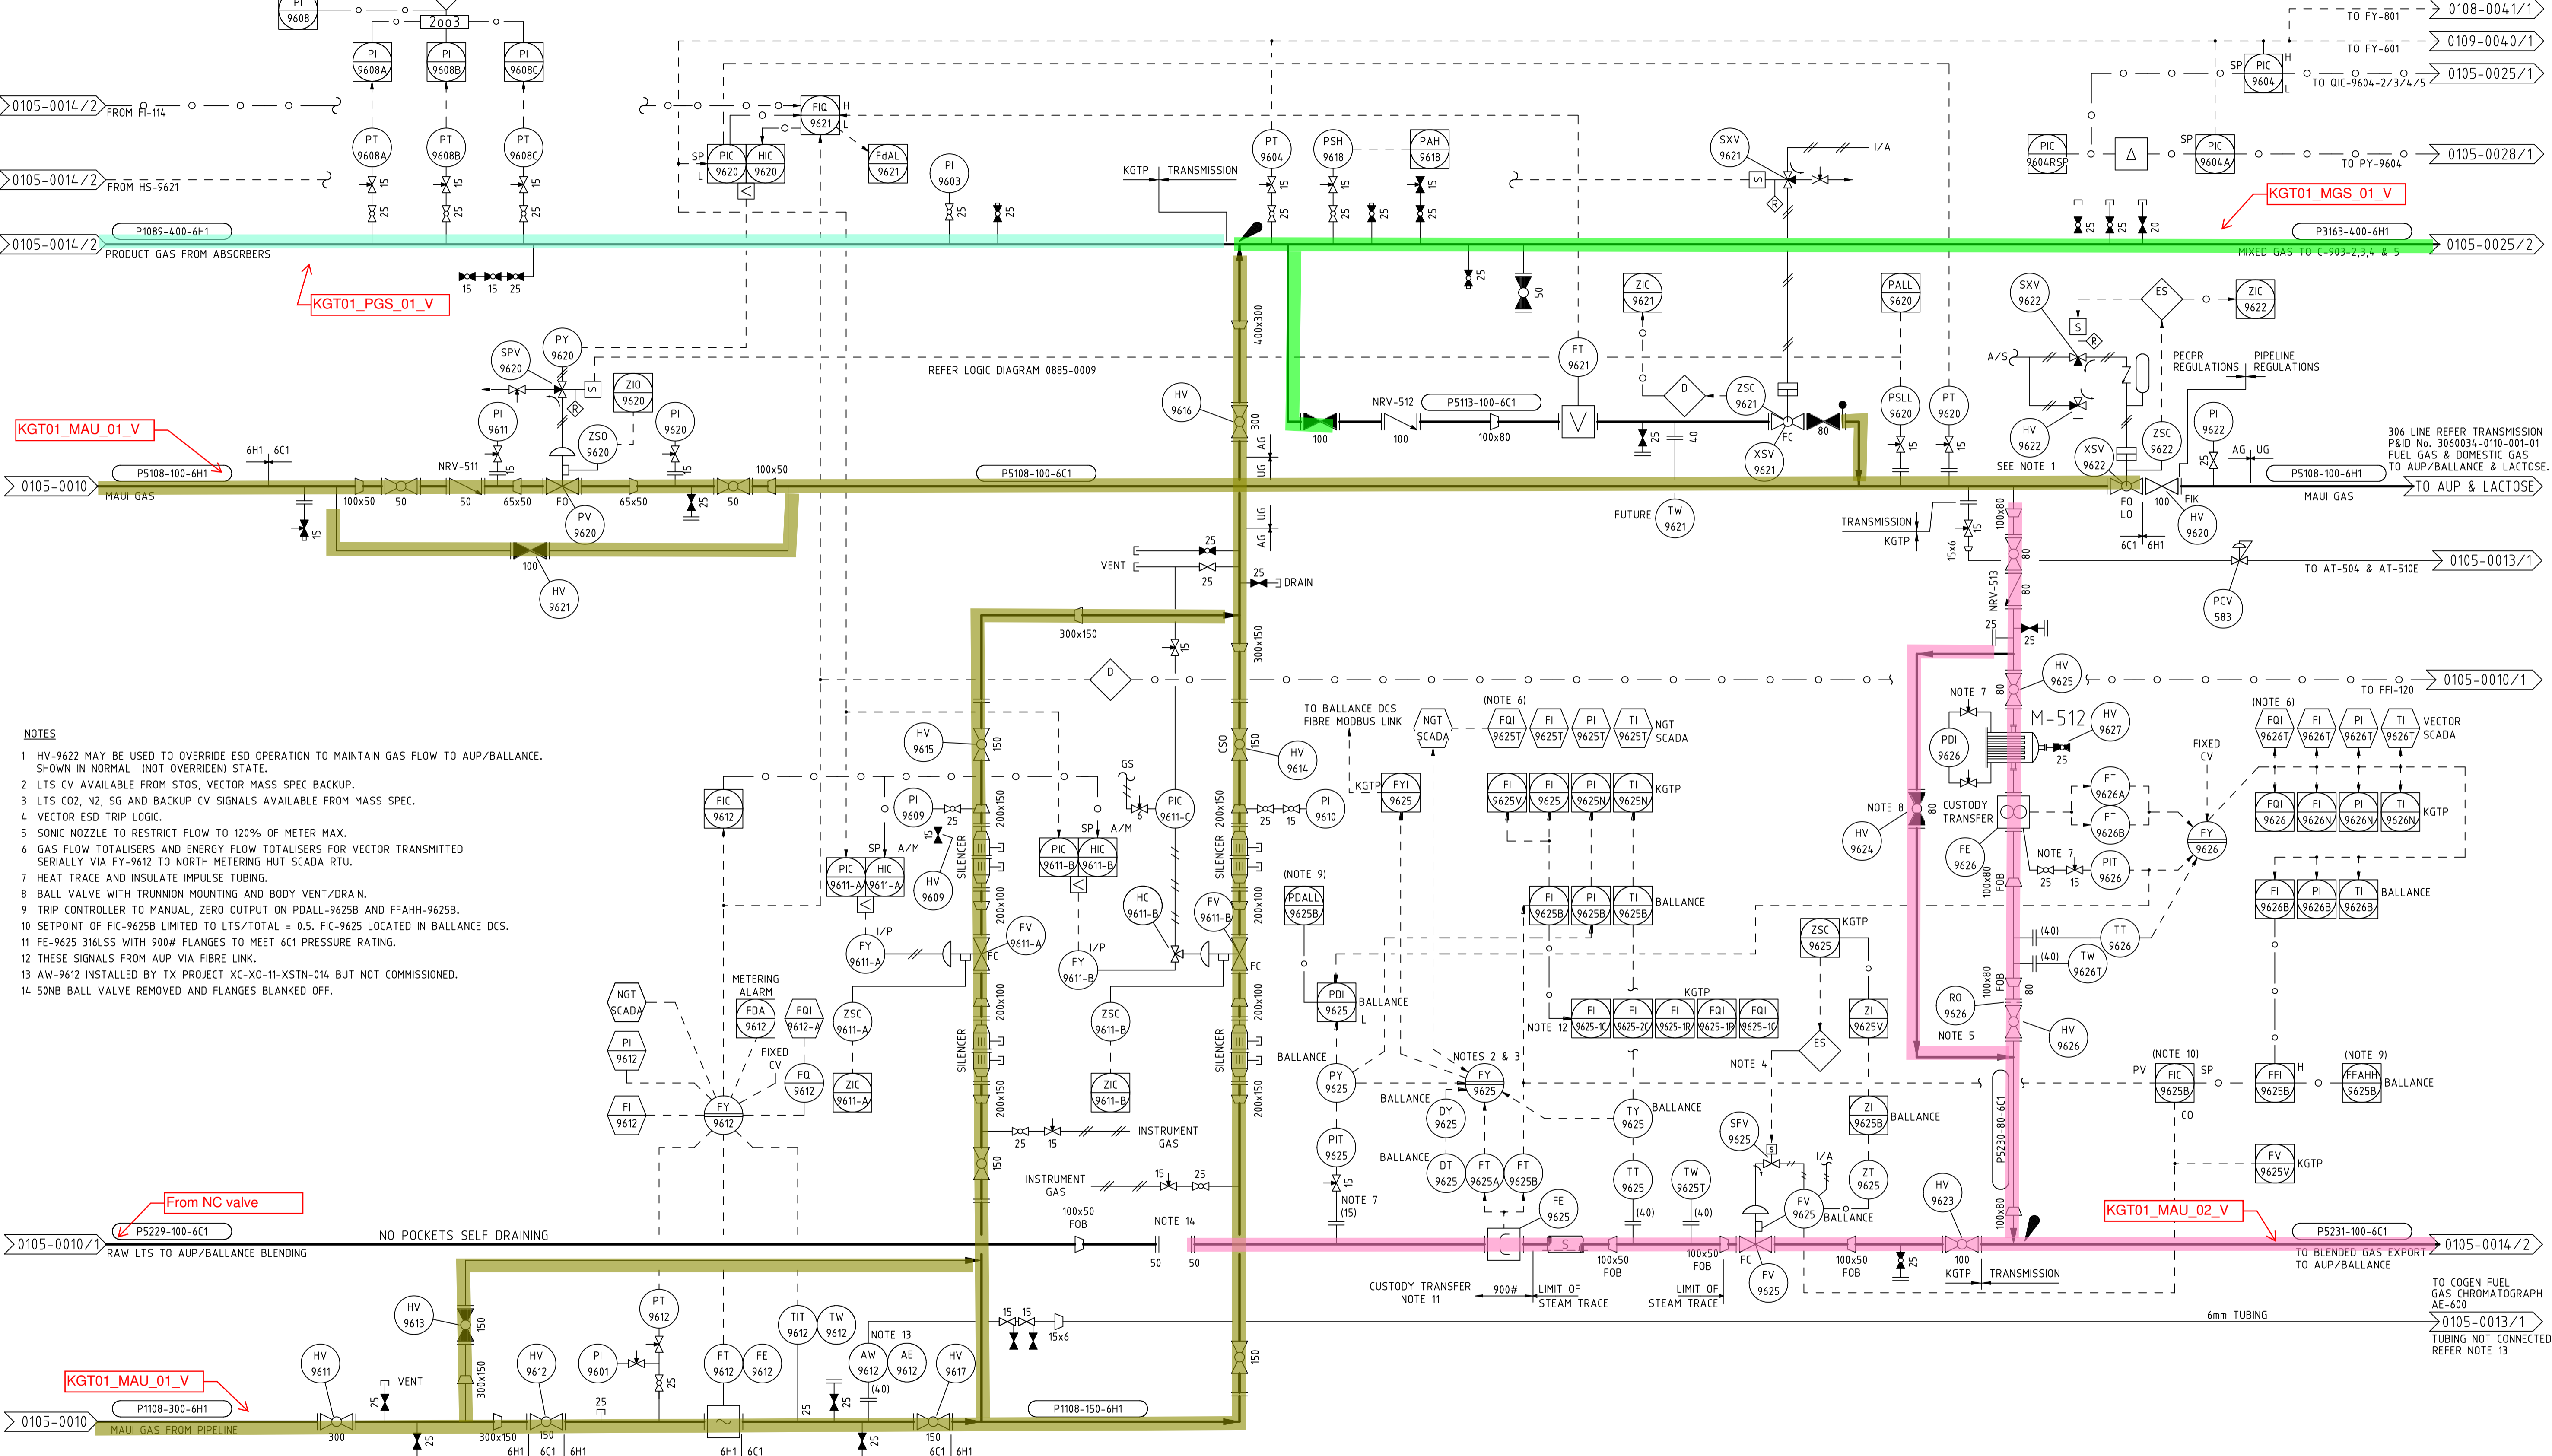

REV	AMENDMENT	BY	CHK	ENG	APP	DATE	REV	AMENDMENT	BY	CHK	ENG	APP	DATE
23	AS BUILT FOR W596701 CHANGE XSV-9621 RESET LATCH	JMP	LH	MP	PJR	05/07	33	AS BUILT FOR PIPELINE DEMARCATION, NRV No's ETC.	RL	JCC	AM	SES	02/2016
22	AS BUILT FOR W5160575 BALANCE RAW LTS FLOW	ES	AAB	LH	PJR	05/07	32	AS BUILT P84-055 WHAREROA HIGH PRESSURE LINE TRIP	AJA	PMO	AM	SES	07/2015
							31	HAND VALVE NUMBERS ADDED FOR ISOLATIONS	RL/ES	CR	AM	SES	04/2013
							30	DRG No. REVISED FOR EXP. COMP. RE-NUMBERING. WAS 0105-0025/01	RL/ES	MH	AM	SES	05/12
39	HIGH POINT VENT ADDED TO LINE P5230-80-6C1	RL	JCC	AM	RC	01/2019	29	AS BUILT DRAIN ADDED TO P5320 & NGC REPLACED WITH VECTOR	RL/ES	JR	AM	SES	02/2012
38	HAND VALVE NUMBER HV-9621 ADDED TO BYPASS VALVE	RL	JCC	AM	RC	01/2019	28	NOTE & TRANS P&ID ADDED TO CLARIFY -TO AUP & LACTOSE	RL/ES	JY/MB	JS	SES	09/2011
37	AS BUILT CLOSED BLIND SPADE ADDED TO ISOLATE FT-9621	RL	JCC	AM	TC	12/2016	27	AS BUILT HAND VALVE HV-9617 NUMBER ADDED	RL	ES	LH	SES	04/2011
36	AS BUILT BALL VALVE REMOVED FROM LINE P5229-50-6C1	RL	JCC	AM	TC	11/2016	26	AS BUILT W51467593 IMPROVE PROD COMP SUCT PRESS CTRL	ES	AAB	LH	SES	08/09
35	AS BUILT XC-XO-11-XSTN-014 FT-9612 ANALYSER PROBE	RL	JC/MM	AM	SES	09/2016	25	HAND VALVE NUMBERS ADDED FOR FLANGE INSUL. KITS	RL	ES	LH	SES	08/2009
34	TRANSMISSION / KGTP DEMARCATION ADDED RE INCIDENT ACTION	RL	JC	AM	SES	05/2016	24	AS BUILT W51214596 LOCAL CONTROL OF MAUI BYPASS	VB	KC	KS	LH	12/07

VECTOR KAPUNI LIMITED
PRIVATE BAG 2020
NEW PLYMOUTH 4342
PHONE 0800 734 567

ssj°

COPYRIGHT The copyright in this document is vested in Vector Kapuni Limited. The contents of this document shall not be reproduced, either in whole or part, by any means whatsoever without the prior written consent of Vector Kapuni Limited.

AUTOCAD ORIGINAL SHEET SIZE A1

REFERENCE DRAWINGS

DRAWING NUMBER WAS 0105-0025/01
0105-0029/01 - COMPRESSOR LUBRICATION & VENTS P&ID
0885-0009/01 - LOGIC DIAGRAM
121-X0101/1 BALANCE FEED GAS DESUPERHEATERS

DRN	W. BAKER	01/12/1985	ENG	DATE
CHK			APP	

PRODUCT LINES AND COMPRESSORS
PIPING & INSTRUMENT DIAGRAM
PRODUCT GAS COMPRESSORS MAUI BYPASS
DRAWING NUMBER WAS 1000000-0105-0025/01

SCALE:	JOB NO.	SERIES	DRG. NO	SHT 01	REVISION
N/A	1000000	0105	0023	01	39

1000000-0105-0023-01.dwg

EQUIPMENT No.

DESCRIPTION
CAPACITY
MAWP @ TEMP

CF-903-2A/CF-903-2B
SUCTION PULSATION BOTTLES

CF-903-2C/CF-903-2D
DISCHARGE PULSATION BOTTLES


CD-903-2
PRODUCT GAS COMPRESSOR

C-903-2
PRODUCT GAS COMPRESSOR UNIT
12.6 Sm³/s @ 41 Barg, 29°C
100 Barg @ HOLD°C

CF-903-2
PRODUCT GAS COMPRESSOR ENGINE

CE-903-2
DISCHARGE AFTERCOOLER UNIT

CE-903-2-FAN
PRODUCT GAS COMPRESSOR FAN

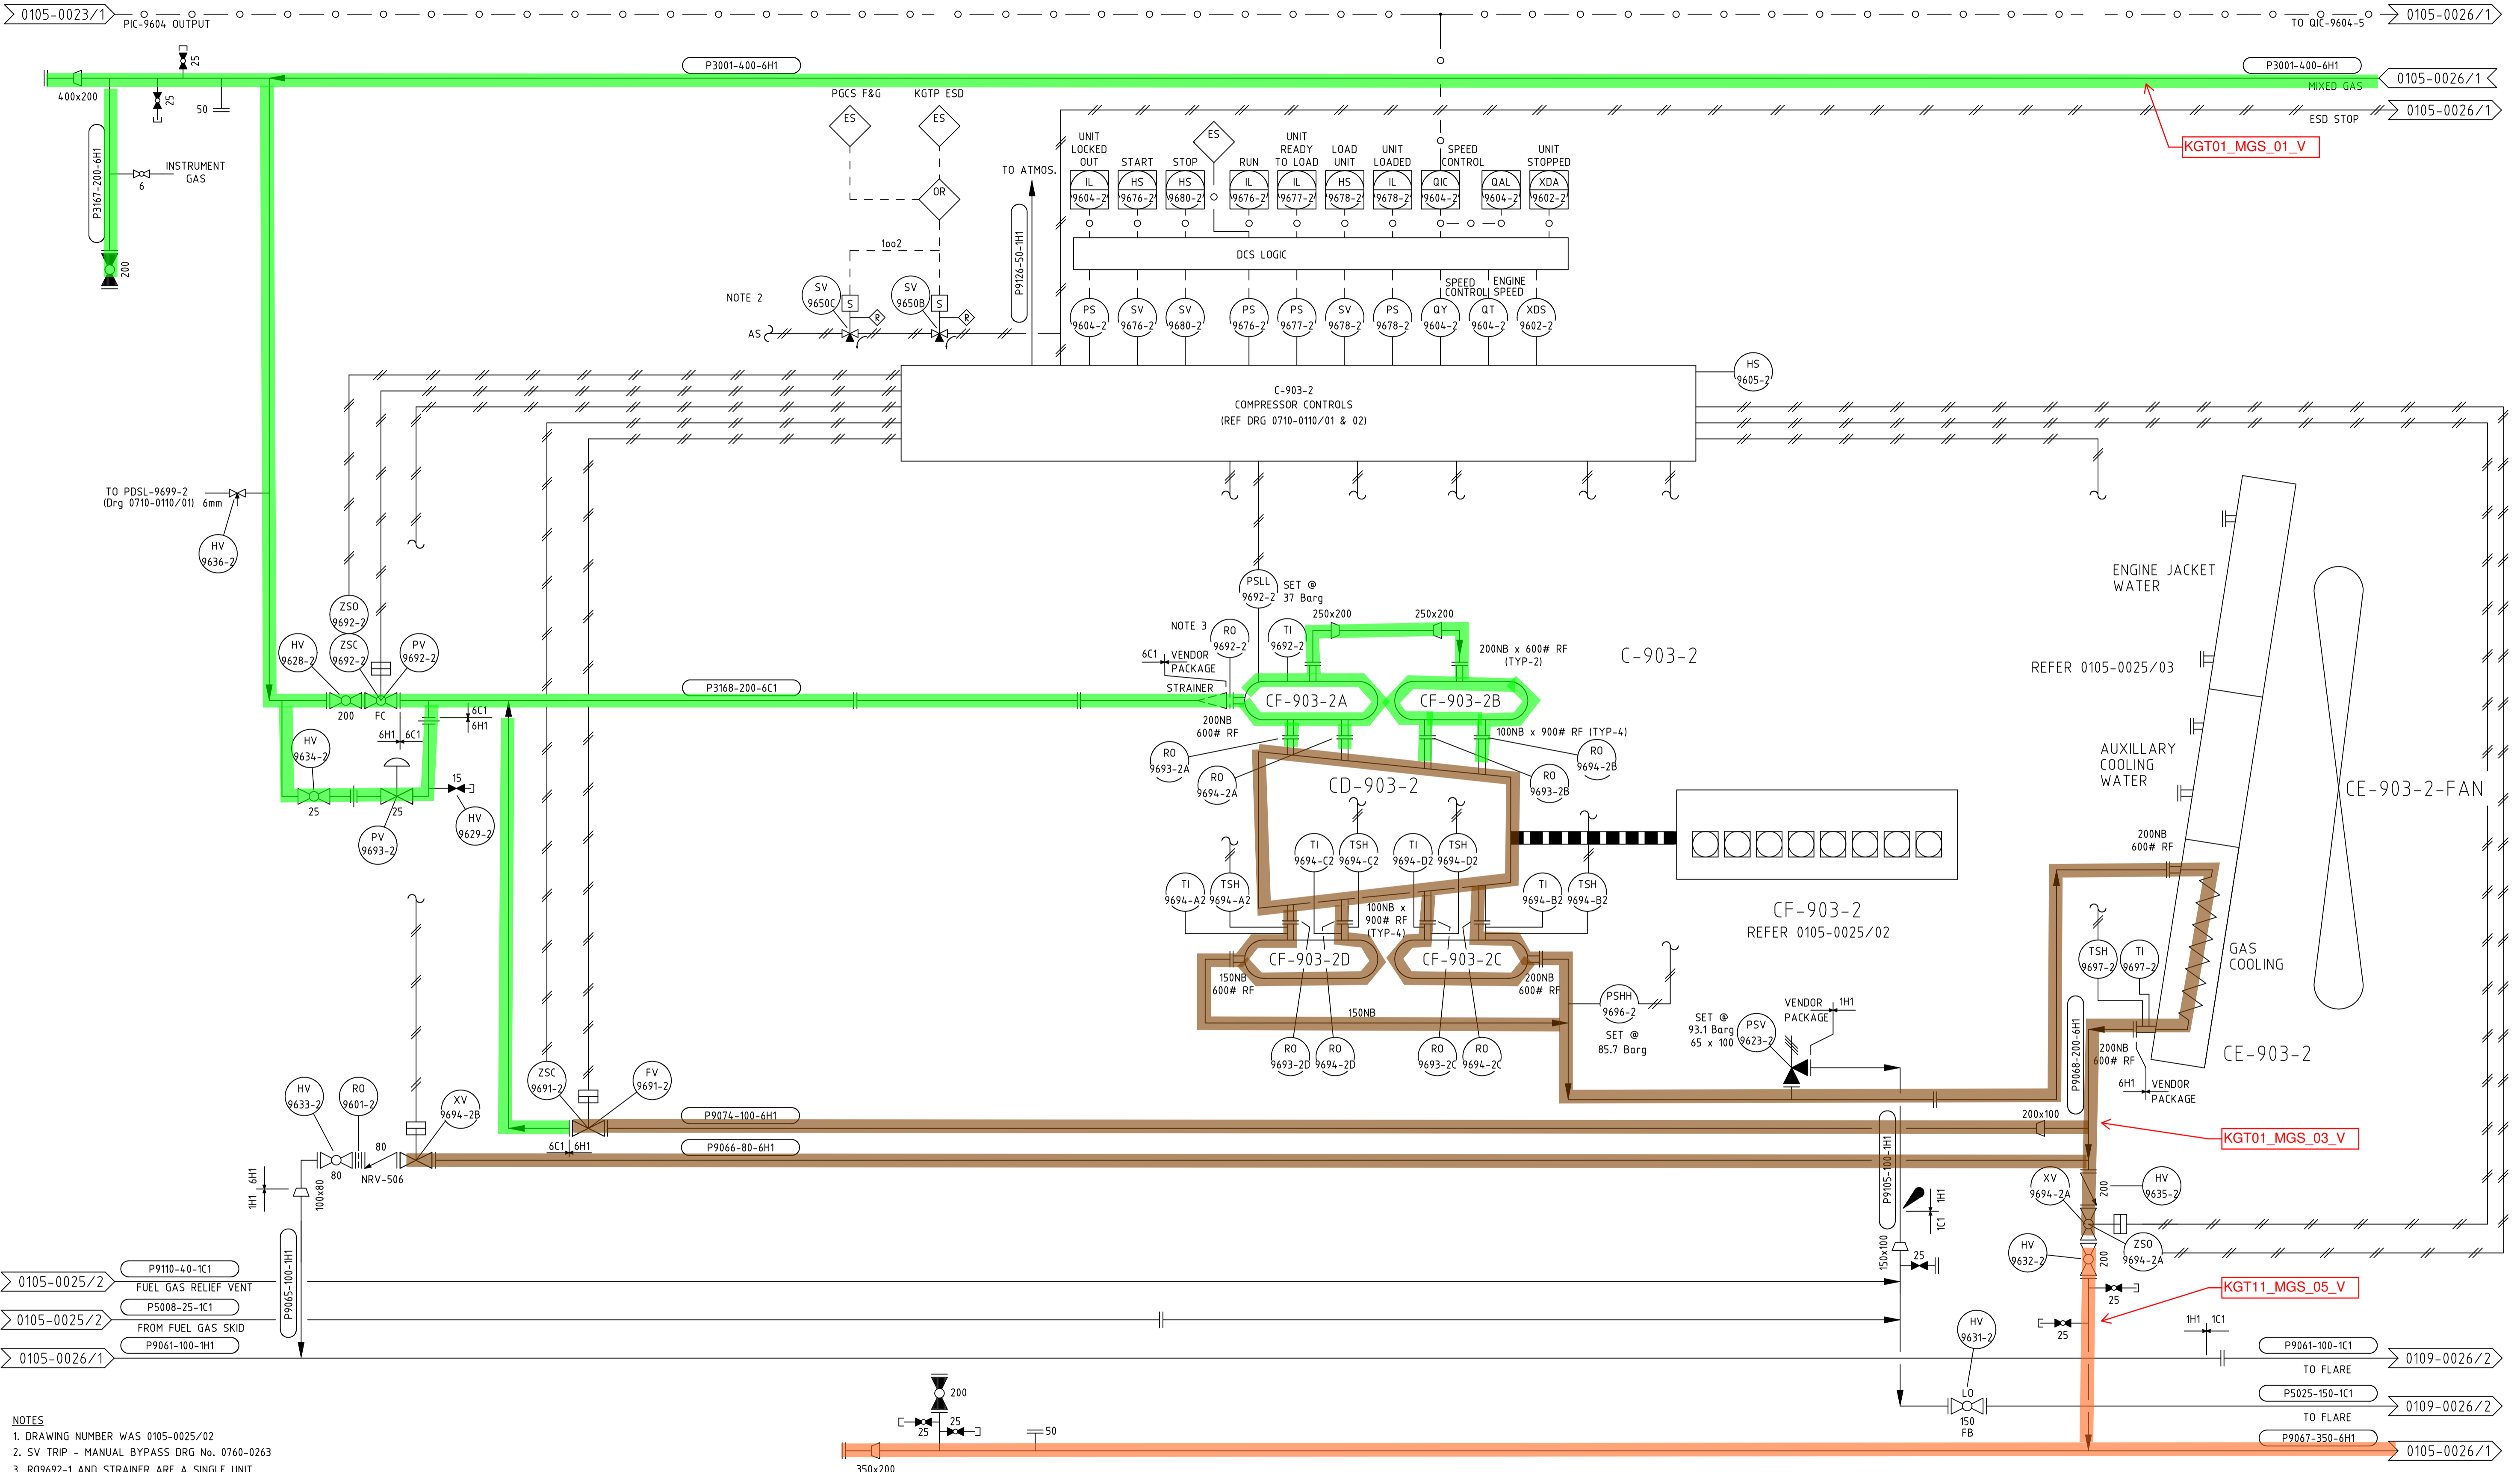

- NOTES
- DRAWING NUMBER WAS 0105-0025/02
 - SV TRIP - MANUAL BYPASS DRG No. 0760-0263
 - RO9692-1 AND STRAINER ARE A SINGLE UNIT

REV	AMENDMENT	BY	CHK	ENG	APP	DATE	REV	AMENDMENT	BY	CHK	ENG	APP	DATE
22	AS BUILT P84-1506 PSH-9696-2 CHANGED FROM 89.6 BARG	RL	JCC	AM	TC	06/2019	13	DRG No. REVISED FOR EXP. COMP. RE-NUMBERING. WAS 0105-0025/02	RL/ES	MH	AM	SES	05/2012
21	ADD 8 RO'S TO PULSATION BOTTLES & DELETE XT-018	RL	JC	AM	SES	06/2016	11	AS BUILT NOTE TO PDSL-9699-2 ADDED	ES	JY	LH	SES	12/08
20	AS-BUILT - PRODUCT GAS COMP. CONTROL IMPROVEMENTS	JCC	RL/AC	AM	SES	04/2016	10	MAC UNIONS & 15NB VENT ADDED TO PV-9693-2	ES	RL	LH	SES	05/08
19	AS-BUILT DRAIN ADDED TO LINE P9105 & NRV No. ADDED	RL	JC	AM	SES	02/2016	9	AS BUILT WS133145, A-910 PRESSURE PROTECTION PROJECT	RL	DC	LH	RJW	10/01
18	AS-BUILT P84-1128 KGTP#2 PGC PULSATION	JB	CJ	AM	SES	10/2014	8	AS BUILT COMMENTS ADDED	VB	RL	EJH	RS	10/98
17	AS BUILT P84-2085 CONTROL HUT RW PENSTOCK	ES/RL	TC	AM	SES	01/2014	7	AS BUILT FOR REFIRBISHMENT PROJECT	V.B.	G.R.	K.E.	G.M.	10/97
16	HAND VALVE NUMBERS ADDED FOR ISOLATIONS	RL	CR	AM	SES	10/2013	6	AS BUILT - AUP GAS SUPPLY MODS	J.W.	B.T.	G.E.	A.V.G.	12/95
15	AS BUILT P84-1041 FLARE GAS MEASUREMENT	ES/RL	TC	AM	SES	09/2012	5	AS BUILT McKEE STAGE 1, ZSOC-9606, 8 & SLU REMOVED	J.B.H.	R.L.	AvG	J.B.G.	10/95
14	COMPRESSOR VENDOR PACKAGE DETAILED ADDING AFTERCOOLER ETC.	RL/ES	AC	AM	SES	07/2012	4	AS BUILT COMMENTS INCORPORATED	V.B.	B.T.	A.V.G.	C.J.	5/95
								REDRAWN ON AUTOPLANT, NOW 4 SHEETS.	D.R.	J.C.	G.M.	C.J.	09/94

VECTOR KAPUNI LIMITED
PRIVATE BAG 2020
NEW PLYMOUTH 4342
PHONE 0800 734 567


ssj^o

COPYRIGHT The copyright in this document is vested in Vector Kapuni Limited
The contents of this document shall not be reproduced, either in whole or part, by any
means whatsoever without the prior written consent of Vector Kapuni Limited.

AUTOCAD ORIGINAL SHEET SIZE A1

DRN	DATE	ENG	APP
W.BAKER	01/12/1985		
CHK			

SCALE:	JOB NO.	SERIES	DRG. NO	SHT	REVISION
NTS	1000000	0105	0025	01 OF 02 SHTS	22

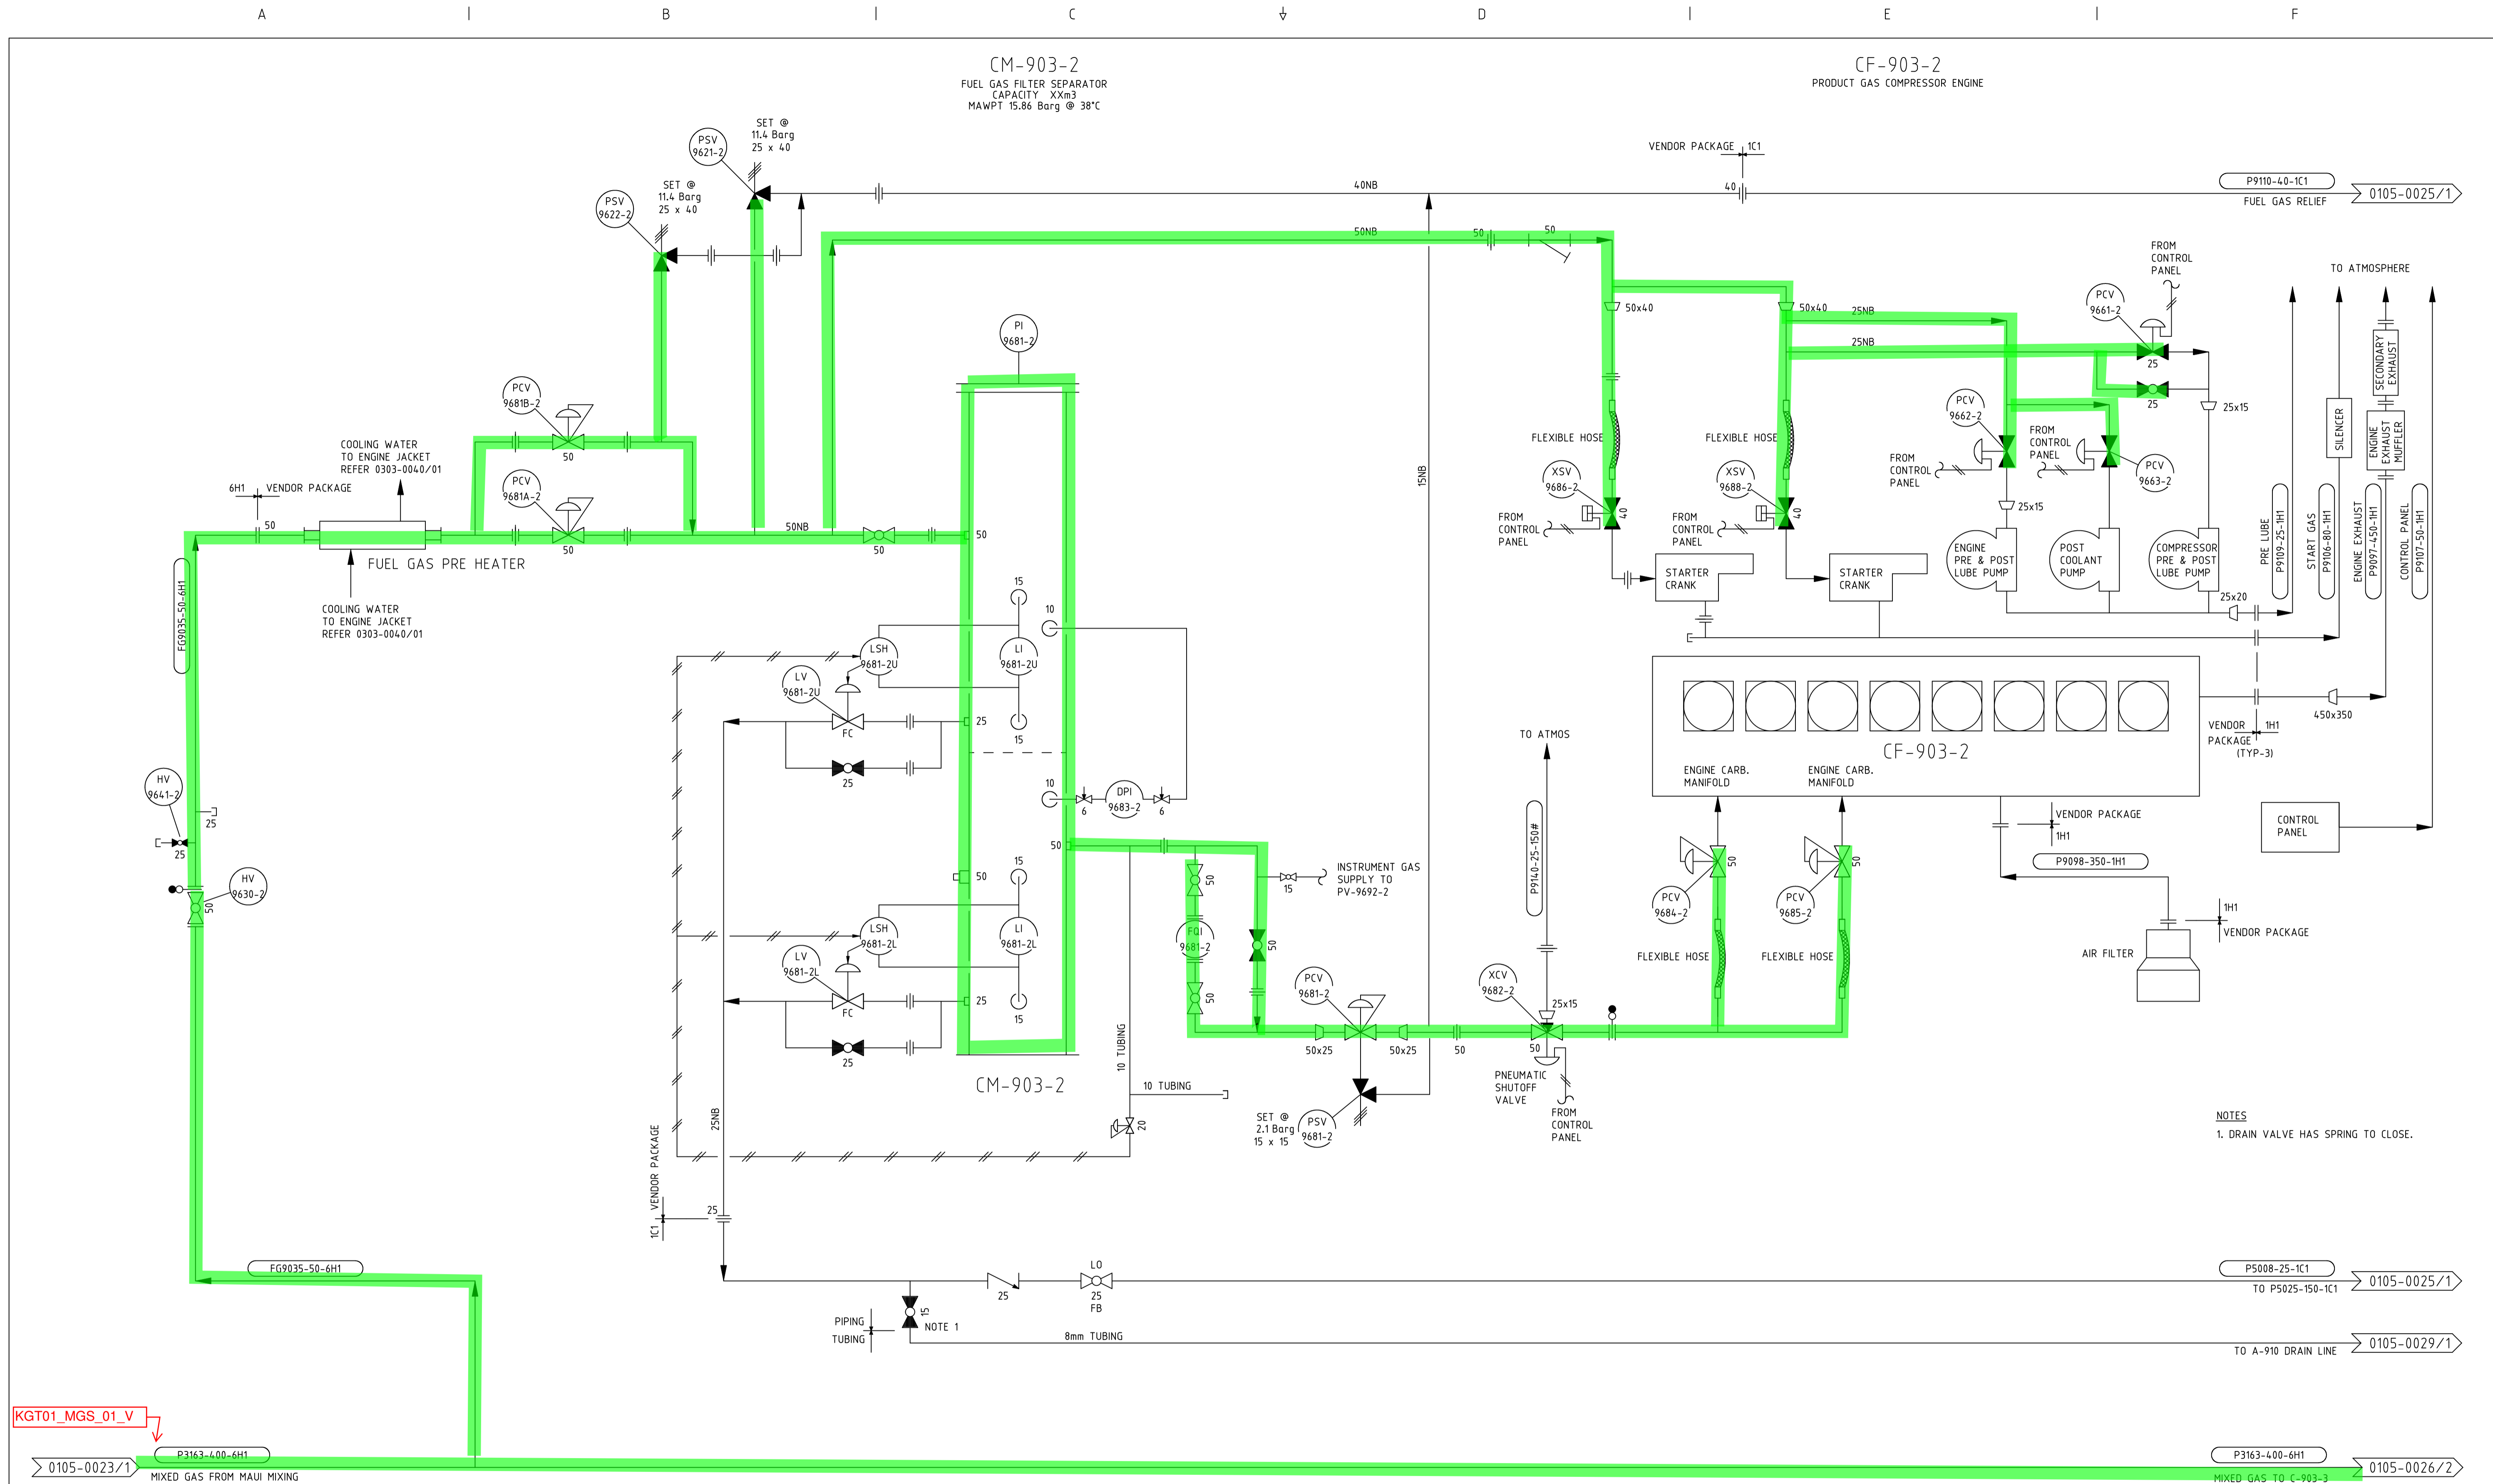

NOTES
1. DRAIN VALVE HAS SPRING TO CLOSE.



REV	AMENDMENT	BY	CHK	ENG	APP	DATE	REV	AMENDMENT	BY	CHK	ENG	APP	DATE
9	AS BUILT HAND VALVE NUMBER HV-9641-2 ADDED	RL	JCC	AM	TC	12/2019							
8	AS BUILT P84-1436 EXTERNAL VENT FROM XCV-9682-2	RL	JC	AM	TC	08/2018							
7	AS BUILT P84-055 WHAREROA HIGH PRESSURE LINE TRIP	AJA	PMO	AM	SES	07/2015							
6	HAND VALVE NUMBERS ADDED FOR ISOLATIONS	RL	CR	AM	SES	10/2013							
5	COMPRESSOR VENDOR PACKAGE DETAILED ADDING ENGINE ETC.	RL/ES	AC	AM	SES	07/2012							
4	DRG No. REVISED FOR EXP. COMP. RE-NUMBERING. WAS 0105-0026/01	RL/ES	MH	AM	SES	05/2012							
3	PGC HAZOP MARK UPS WS 1324841	MW	ES	JS	SES	08/11							
2	PSV-9621-2 & 9622-2 WERE 11.38 Barg	CMW	RL	AVG	AIM	08/02							
1	AS BUILT WS133145, A-910 PRESSURE PROTECTION PROJECT	RL	DC	LH	RJW	10/01							

VECTOR KAPUNI LIMITED
PRIVATE BAG 2020
NEW PLYMOUTH 4342
PHONE 0800 734 567


sjio

COPYRIGHT The copyright in this document is vested in Vector Kapuni Limited
The contents of this document shall not be reproduced, either in whole or part, by any
means whatsoever without the prior written consent of Vector Kapuni Limited.

AUTOCAD ORIGINAL SHEET SIZE A1

REFERENCE DRAWINGS			
DRAWING NUMBER WAS 1000000-0105-0026/01			
COMPRESSOR PROCESS GAS SYSTEM - 0105-0025/01			
COMPRESSOR VENDOR PACKAGE - 0303-0040/01			
DATE	ENG	APP	DATE
18/12/2000	V.BRENNAN	R.LOCHHEAD	18/12/2000

PRODUCT LINES AND COMPRESSORS PIPING & INSTRUMENT DIAGRAM PRODUCT GAS COMPRESSOR C-903-2 FUEL GAS AND START GAS SYSTEM					
SCALE:	JOB NO.	SERIES	DRG. NO	SHT 02	REVISION
NTS	1000000	0105	0025	02	9

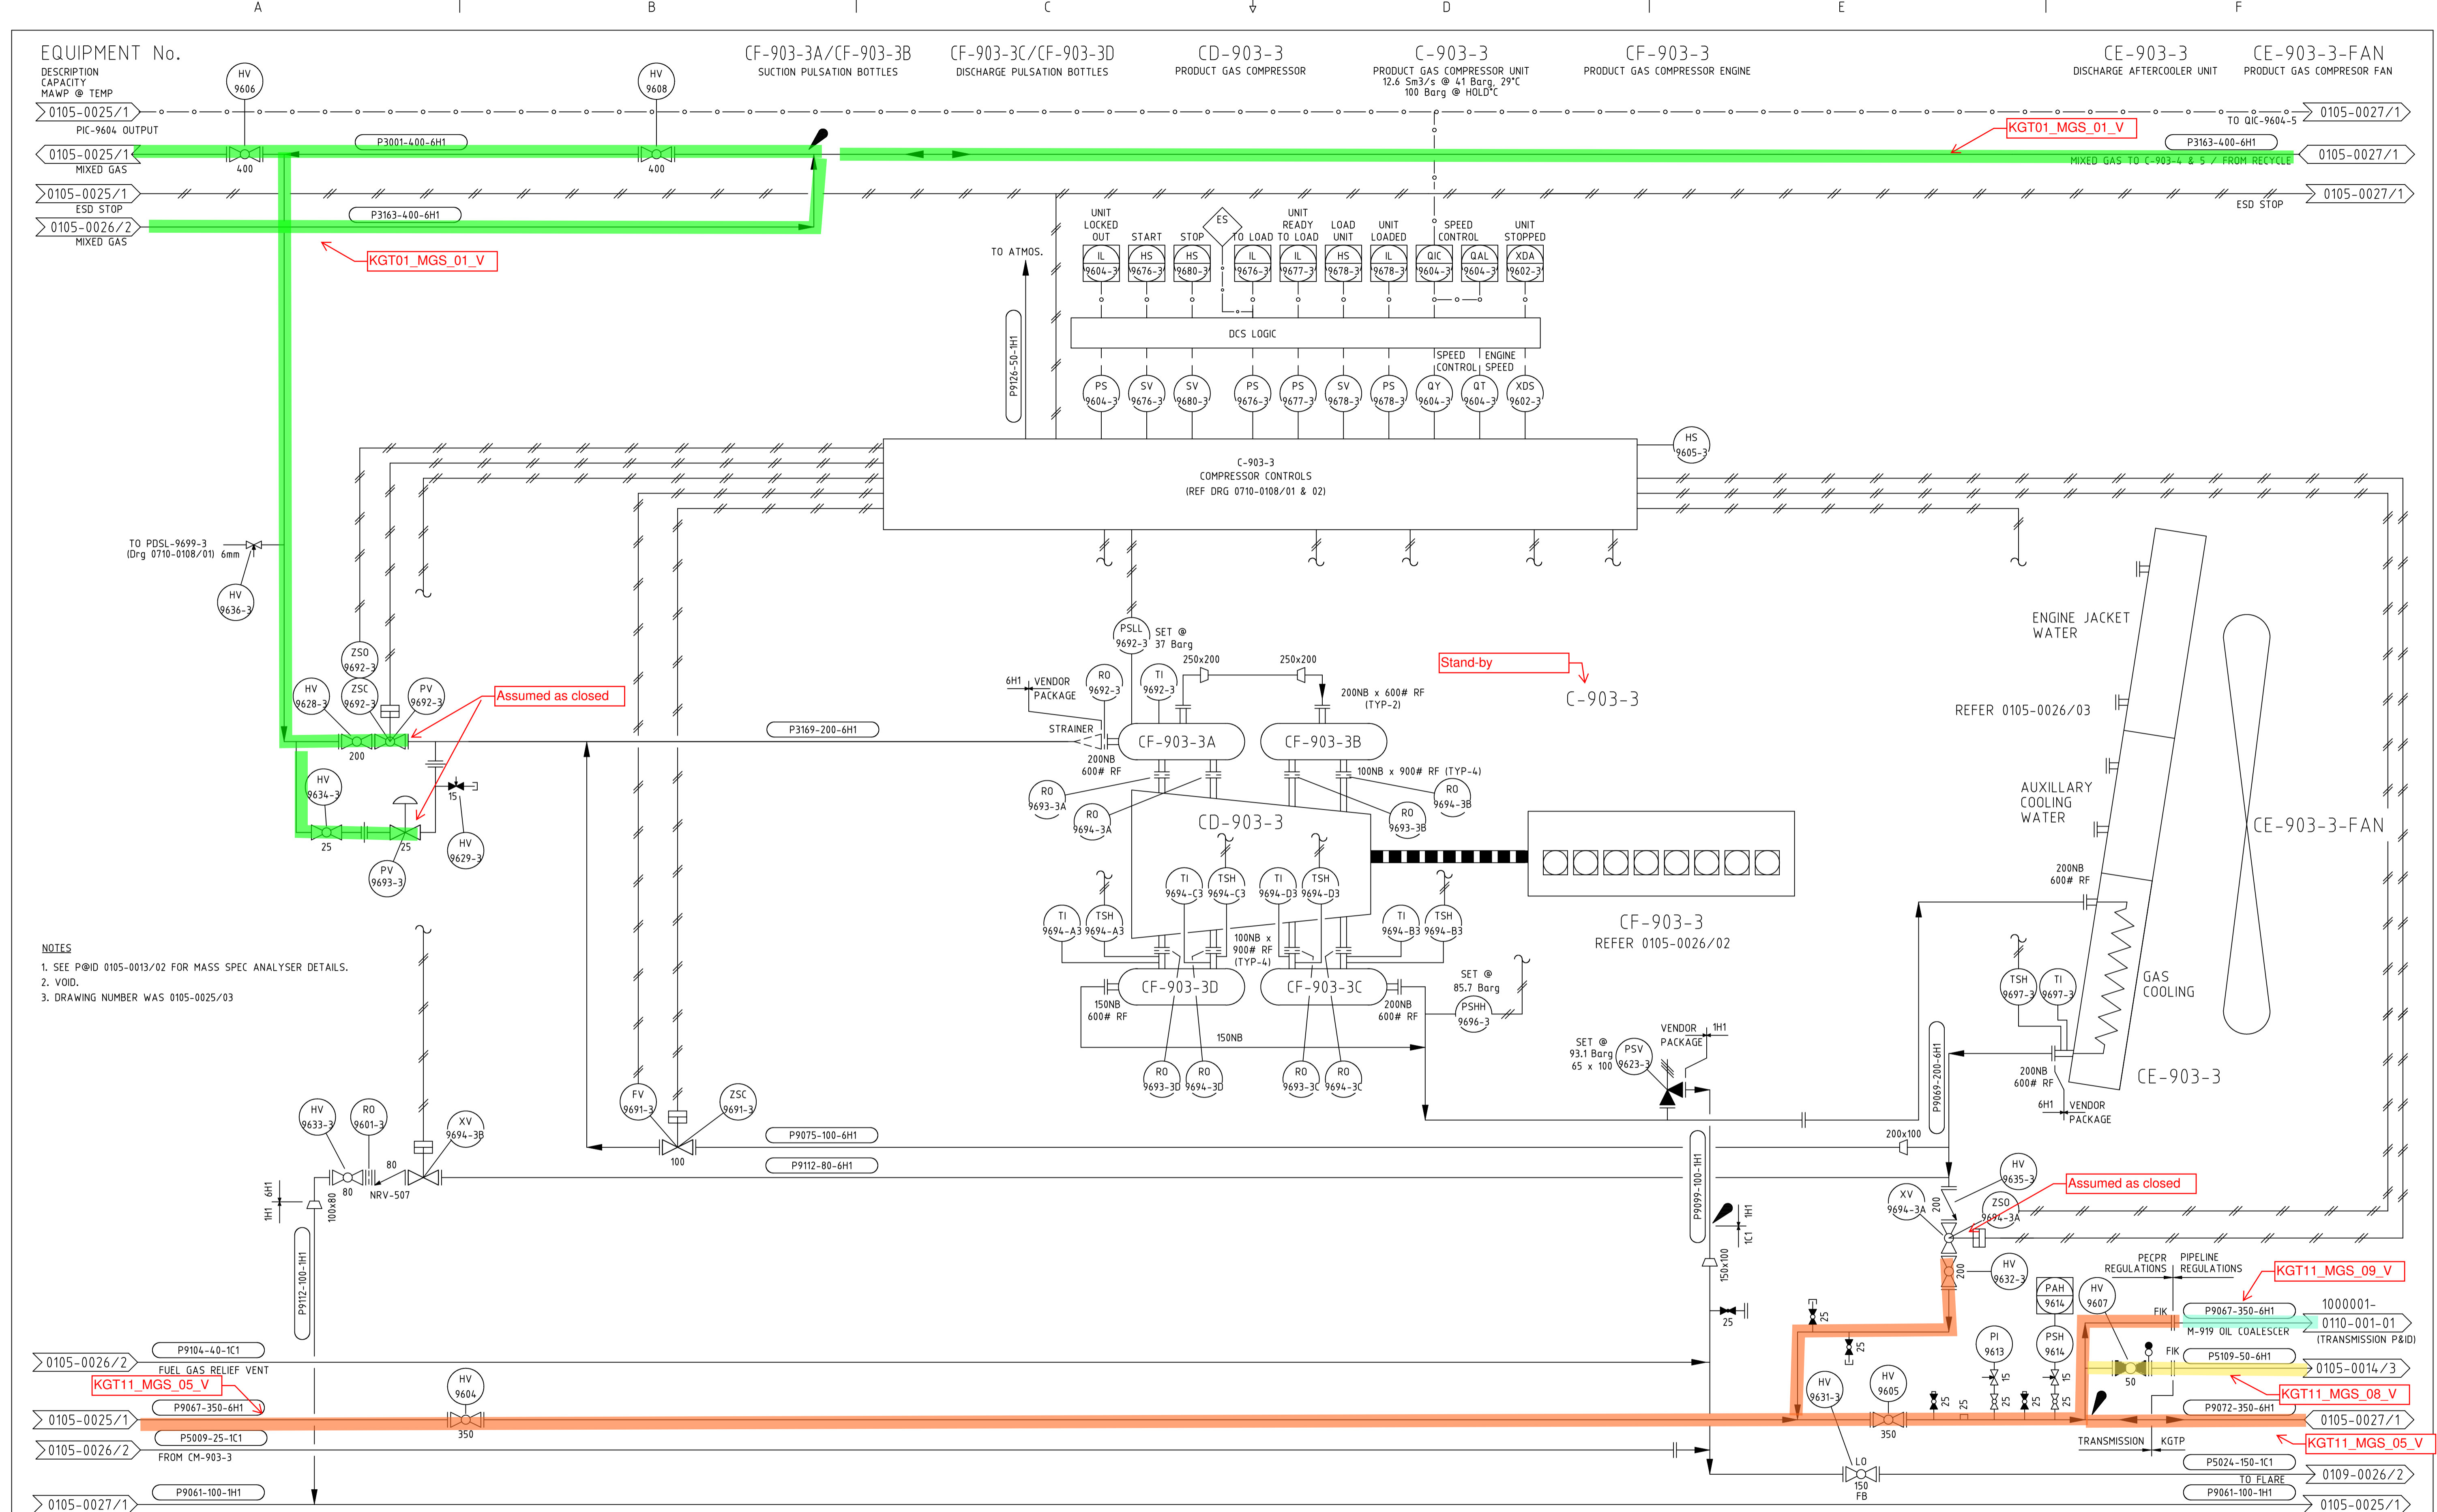

EQUIPMENT No.
DESCRIPTION
CAPACITY
MAWP @ TEMP

0105-0025/1 PIC-9604 OUTPUT MIXED GAS	0105-0025/1 ESD STOP	0105-0026/2 MIXED GAS	CF-903-3A/CF-903-3B SUCTION PULSATION BOTTLES	CF-903-3C/CF-903-3D DISCHARGE PULSATION BOTTLES	CD-903-3 PRODUCT GAS COMPRESSOR	C-903-3 PRODUCT GAS COMPRESSOR UNIT 12.6 Sm ³ /s @ 4.1 Barg, 29°C 100 Barg @ HOLD°C	CF-903-3 PRODUCT GAS COMPRESSOR ENGINE	CE-903-3 DISCHARGE AFTERCOOLER UNIT	CE-903-3-FAN PRODUCT GAS COMPRESSOR FAN	0105-0027/1 TO QIC-9604-5	0105-0027/1 MIXED GAS TO C-903-3 & 5 / FROM RECYCLE	0105-0027/1 ESD STOP
---	-------------------------	--------------------------	--	--	------------------------------------	---	---	--	--	------------------------------	--	-------------------------

- NOTES
- SEE P@ID 0105-0013/02 FOR MASS SPEC ANALYSER DETAILS.
 - VOID.
 - DRAWING NUMBER WAS 0105-0025/03

REV	AMENDMENT	BY	CHK	ENG	APP	DATE	REV	AMENDMENT	BY	CHK	ENG	APP	DATE
23	PIPELINE / PECPR REGULATION DEMARICATION ADDED ETC.	RL	JC/NM	AM	SES	01/2016	13	KGTP/TRANSMISSION DEMARICATION UPDATE	SKM	RH	LH	PJR	11/2005
22	HAND VALVE NUMBERS ADDED FOR ISOLATIONS	RL	CR	AM	SES	10/2013	12	DESIGN DATA & LINE NUMBERS RATIONALISED	JBH	RL	AvG	AM	08/02
21	AS BUILT P84-1041 FLARE GAS MEASUREMENT	ES/RL	TC	AM	SES	09/2012	11	AS BUILT WS133145_A-910 PRESSURE PROTECTION PROJECT	RL	DC	LH	RJW	10/01
20	COMPRESSOR VENDOR PACKAGE DETAILED ADDING AFTERCOOLER ETC.	RL/ES	AC	AM	SES	07/2012	10	ANALYSER INSTRUMENTATION MOVED TO 0105-0013/1	VB	RL	EJH	RS	11/98
19	DRG No. REVISED FOR EXP. COMP. RE-NUMBERING. WAS 0105-0025/03	RL/ES	MH	AM	SES	05/2012							
18	PSV-9590 & 9591 SET PRESSURE ADDED	ES	RL	LH	SES	11/09							
17	AS BUILT NOTE TO PDSL-9699-3 ADDED	ES	JY	LH	SES	12/08	27	AS BUILT P84-1506. PSH-9696-3 CHANGED FROM 89.6 BARG	RL	JCC	AM	TC	06/2019
16	MAC UNIONS & 15NB VENT ADDED TO PV-9693-3	ES	RL	LH	SES	05/08	26	ADD 8 RO'S TO PULSATION BOTTLES & DELETE XT-019	RL	JC	AM	SES	06/2016
15	AS BUILT WS141075 DOMESTIC GAS METERING SUPPLY	VB	LH	KC	PJR	11/07	25	TRANSMISSION / KGTP DEMARICATION ADDED RE INCIDENT ACTION	RL	JC	AM	SES	05/2016
14	AS BUILT WS1042819-BENFIELD SYSTEM HAZARD REPORT	ES	CP	LH	PJR	01/07	24	AS BUILT - PRODUCT GAS COMP. CONTROL IMPROVEMENTS	JCC	RL/AC	AM	SES	04/2016

VECTOR KAPUNI LIMITED
PRIVATE BAG 2020
NEW PLYMOUTH 4342
PHONE 0800 734 567

REFERENCE DRAWINGS
COMPRESSOR CONTROLS - 0710-0108/01 & 02
CAUSE & EFFECTS - 0780-0092/01
FUEL GAS AND START GAS SYSTEM - 0105-0026/02
COOLING WATER, LUBE OIL, UTILITIES - 0105-0026/03
COMPRESSOR VENDOR PACKAGE - 0303-0040/01

PRODUCT LINES AND COMPRESSORS
PIPING & INSTRUMENT DIAGRAM
PRODUCT GAS COMPRESSOR C-903-3
PRODUCT GAS SYSTEM

SCALE: NTS
JOB NO. 1000000
SERIES 0105
DRG. NO 0026
SHT 01 OF 02 SHTS
REVISION 27


DATE: 02/12/1985
DATE: []
DATE: []

DRN: W.BAKER
CHK: []

APP: []

AUTOCAD ORIGINAL SHEET SIZE A1

DATE: []

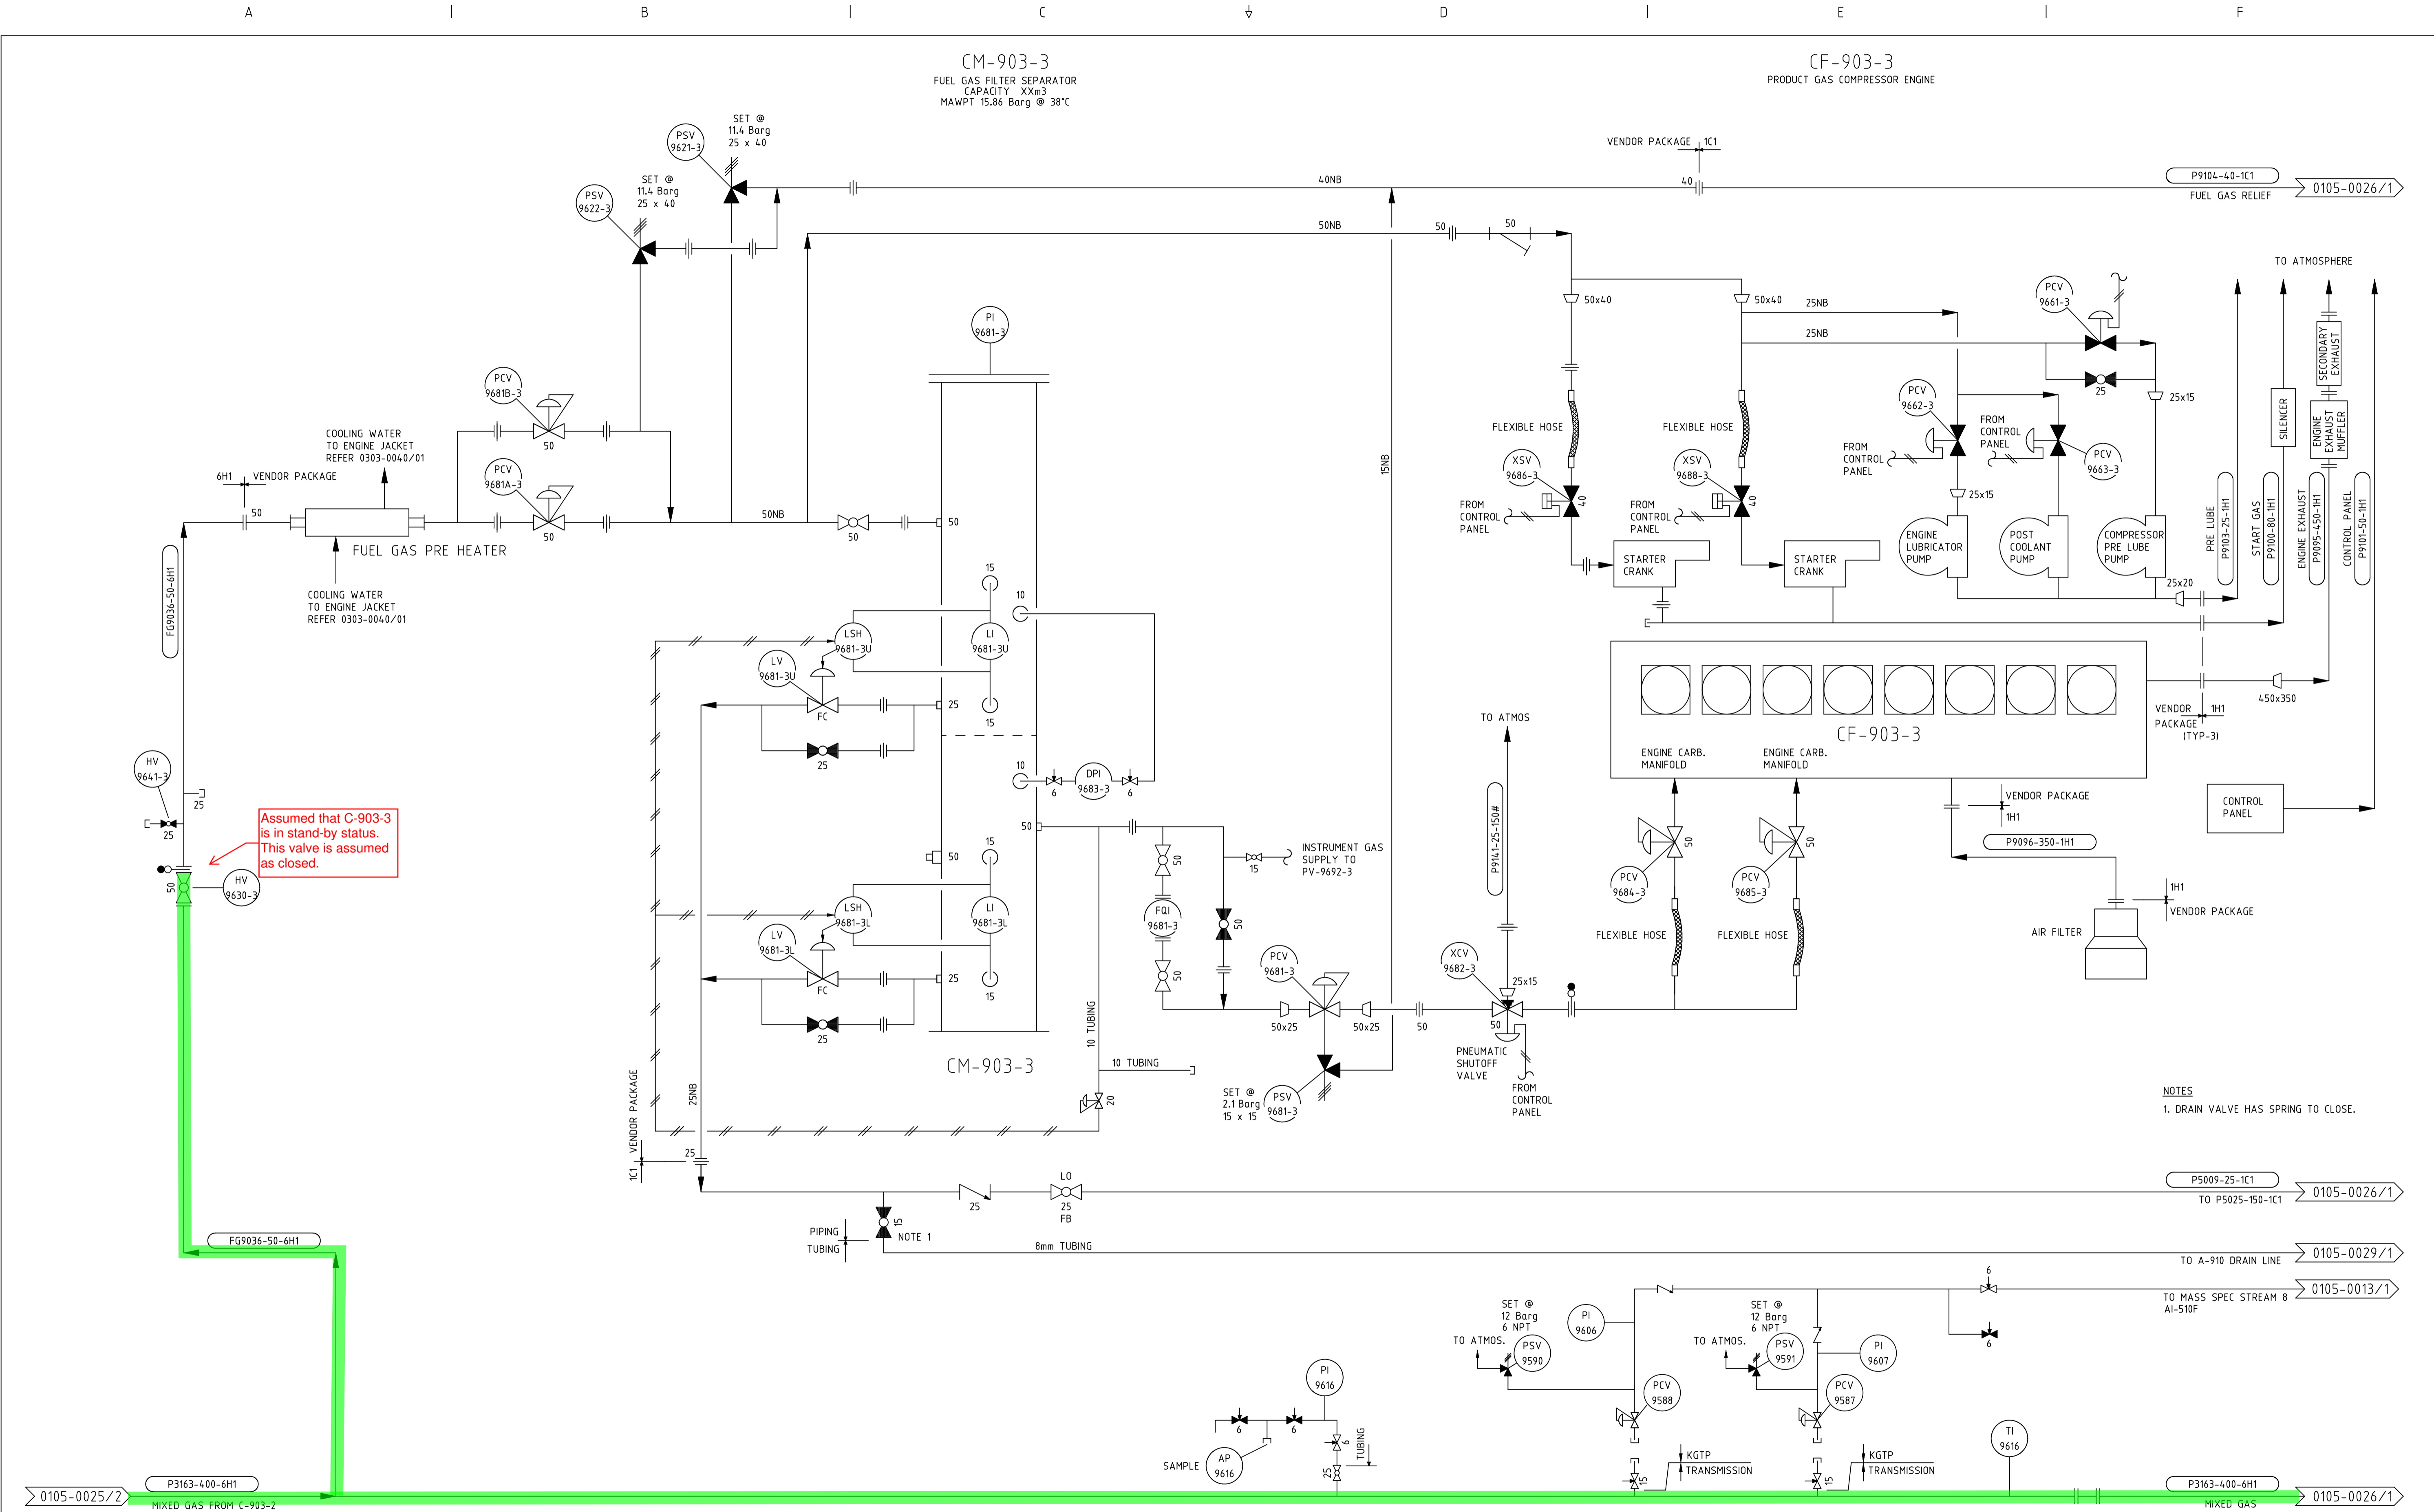

NOTES
1. DRAIN VALVE HAS SPRING TO CLOSE.

REV	AMENDMENT	BY	CHK	ENG	APP	DATE	REV	AMENDMENT	BY	CHK	ENG	APP	DATE
10	AS BUILT HAND VALVE NUMBER HV-9641-3 ADDED	RL	JCC	AM	TC	12/2019							
9	AS BUILT SAMPLE STREAM LINES CAPPED OFF AT PCV-9587 & 9588	RL	JCC	AM	TC	06/2019							
8	AS BUILT P84-1436 EXTERNAL VENT FROM XCV-9682-2	RL	JC	AM	TC	08/2018							
7	TRANSMISSION / KGTP DEMARCATION ADDED RE INCIDENT ACTION	RL	JC	AM	SES	05/2016							
6	HAND VALVE NUMBERS ADDED FOR ISOLATIONS	RL	CR	AM	SES	10/2013							
5	COMPRESSOR VENDOR PACKAGE DETAILED ADDING ENGINE ETC.	RL/ES	AC	AM	SES	07/2012							
4	DRG No. REVISED FOR EXP. COMP. RE-NUMBERING. WAS 0105-0027/01	RL/ES	MH	AM	SES	05/2012							
3	PGC HAZOP MARK UPS WS 1324841	RL	ES	AC	SES	09/2011							
2	PSV-9621-3 & 9622-3 WERE 11.38 Barg	CMW	RL	AvG	AIM	08/02							
1	AS BUILT WS133145, A-910 PRESSURE PROTECTION PROJECT	RL	DC	LH	RJW	10/01							

VECTOR KAPUNI LIMITED
PRIVATE BAG 2020
NEW PLYMOUTH 4342
PHONE 0800 734 567


sj^o

COPYRIGHT The copyright in this document is vested in Vector Kapuni Limited. The contents of this document shall not be reproduced, either in whole or part, by any means whatsoever without the prior written consent of Vector Kapuni Limited.

AUTOCAD ORIGINAL SHEET SIZE A1

REFERENCE DRAWINGS			
DRAWING NUMBER WAS 1000000-0105-0027/01			
COMPRESSOR PROCESS GAS SYSTEM - 0105-0026/01			
COMPRESSOR VENDOR PACKAGE - 0303-0040/01			
DRN	DATE	ENG	DATE
V.BRENNAN	18/12/2000	ENG	18/12/2000
CHK	DATE	APP	DATE
R.LOCHHEAD	18/12/2000	APP	18/12/2000

PRODUCT LINES AND COMPRESSORS PIPING & INSTRUMENT DIAGRAM					
PRODUCT GAS COMPRESSOR C-903-3 FUEL GAS AND START GAS SYSTEM					
SCALE:	JOB NO.	SERIES	DRG. NO	SHT 02 OF 02 SHTS	REVISION
NTS	1000000	0105	0026		10

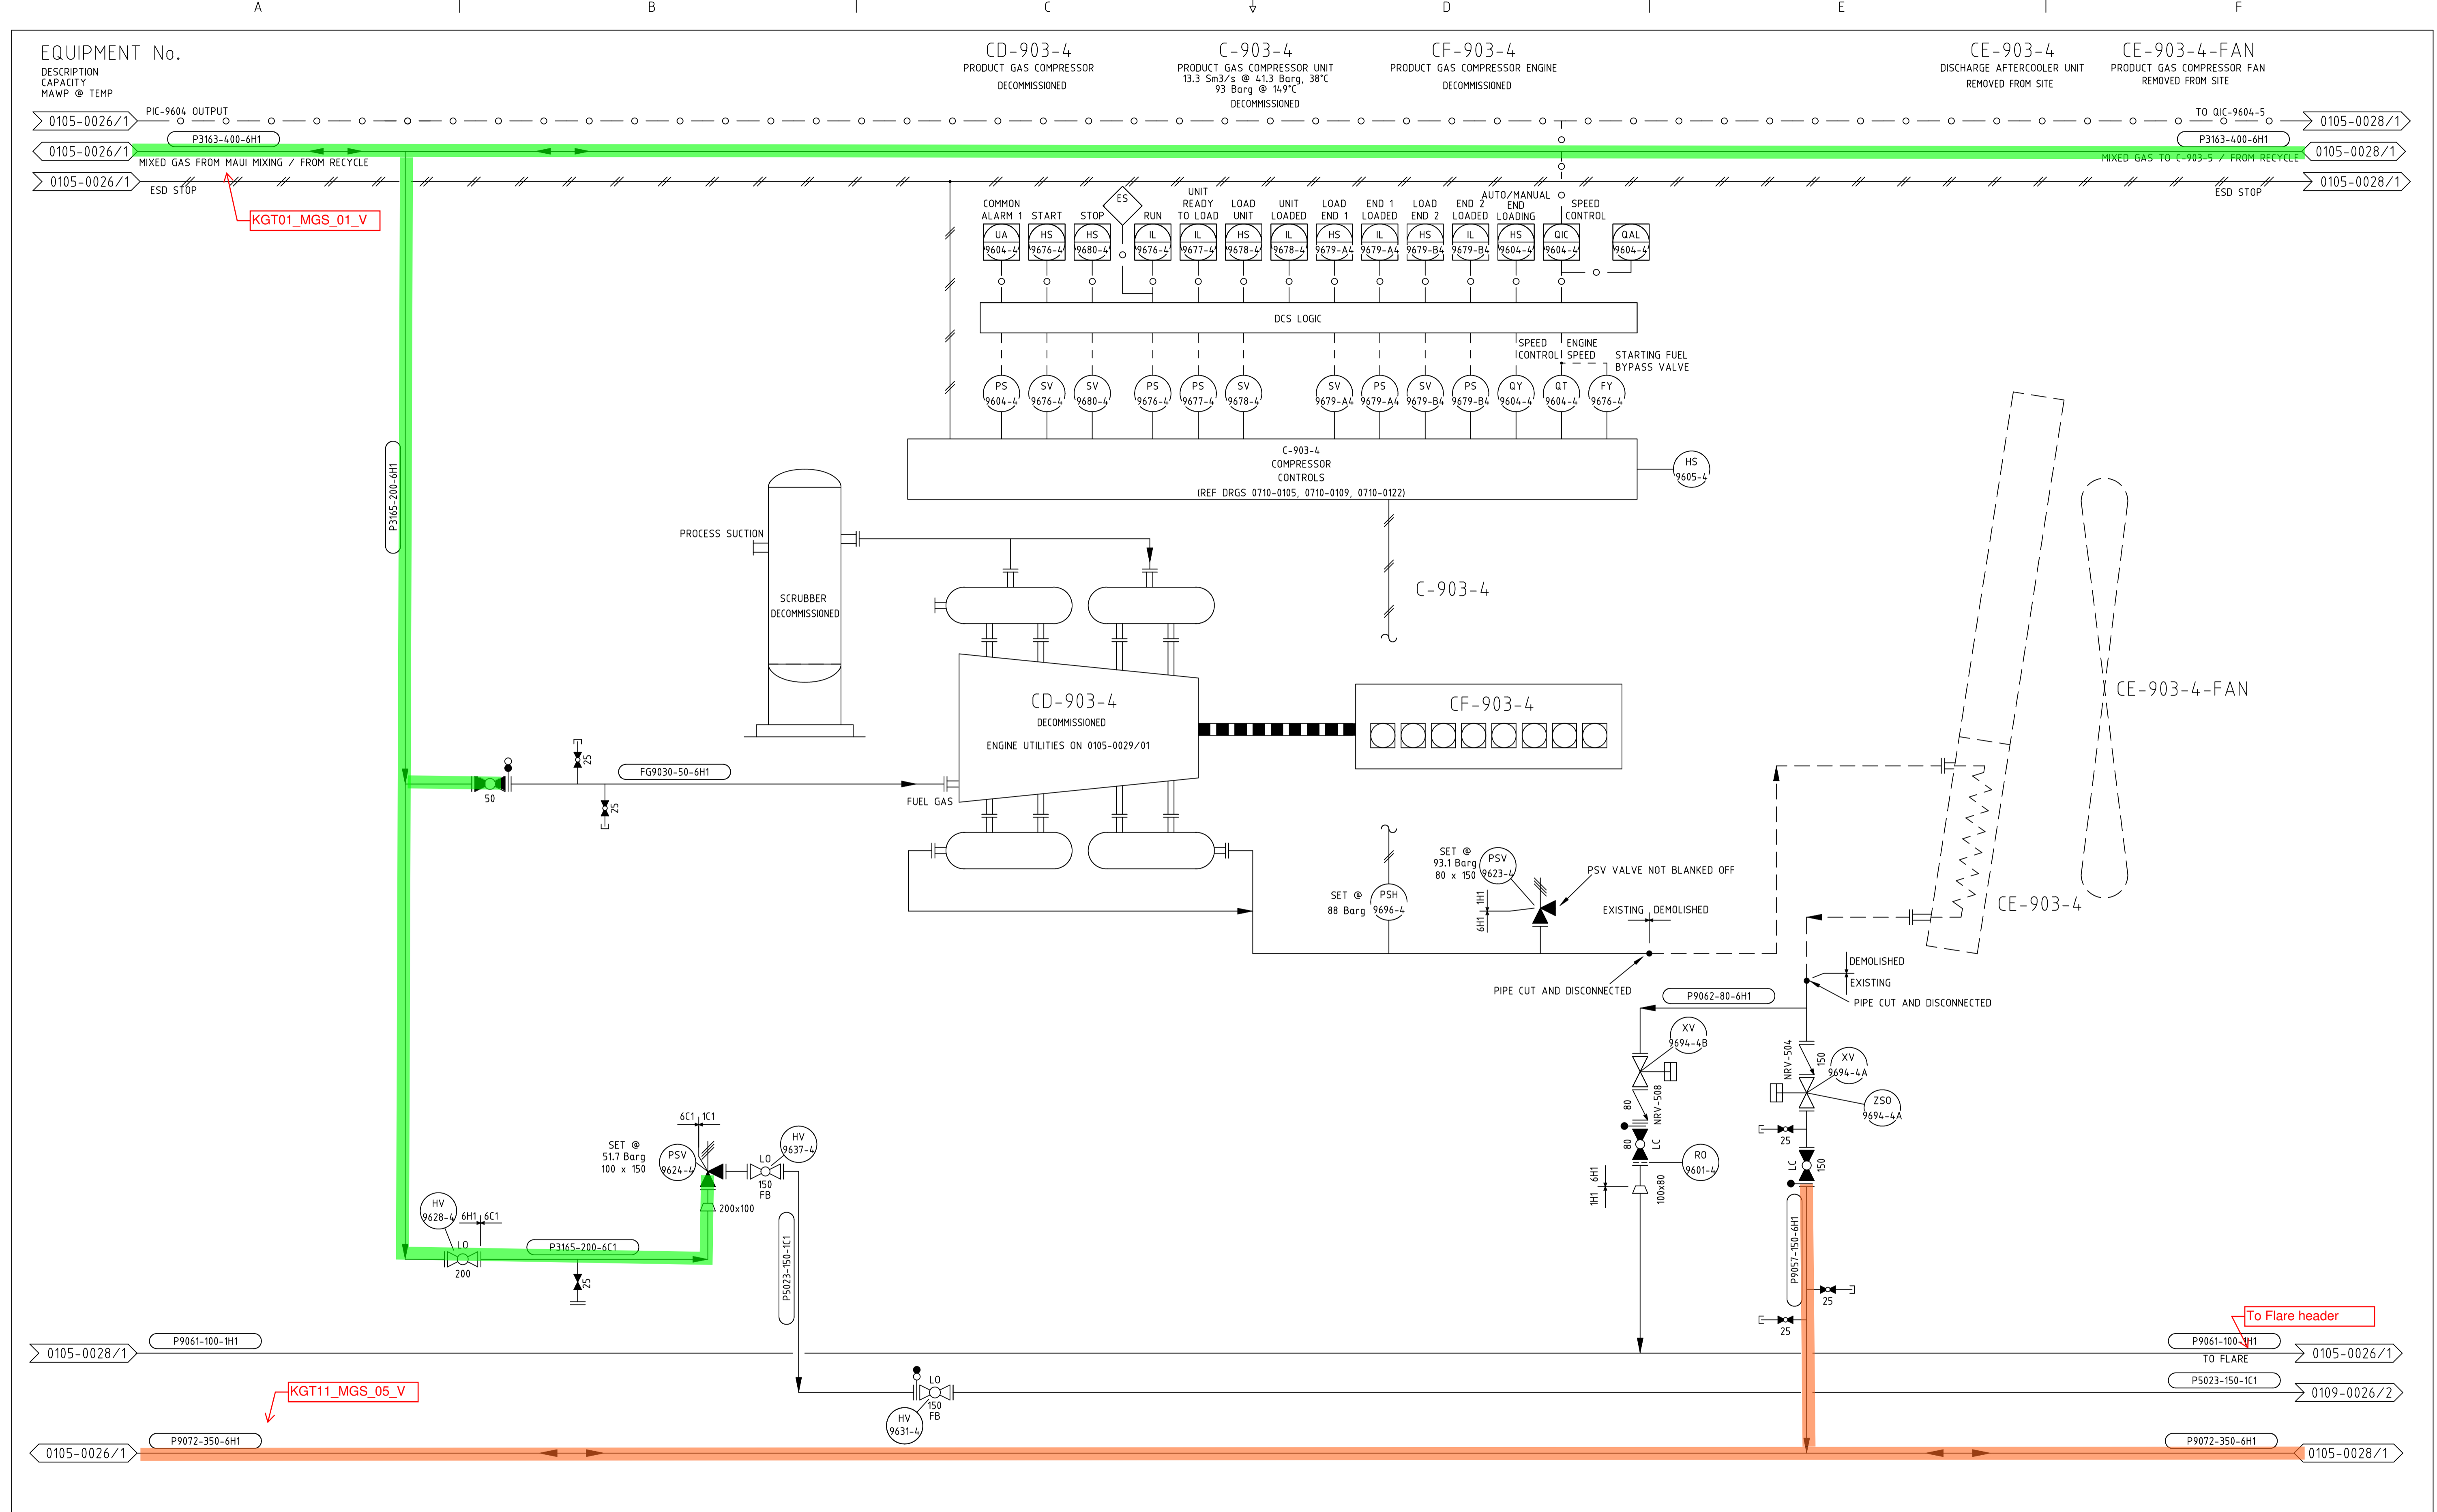

REV	AMENDMENT	BY	CHK	ENG	APP	DATE	REV	AMENDMENT	BY	CHK	ENG	APP	DATE
13	AS-BUILT FLOW PATH CORRECTIONS AND NRV No's ADDED	RL	JC/NM	AM	SES	01/2015							
12	AS-BUILT TO SHOW STATUS OF EXISTING AND DEMOLISHED ASSETS	RL	JC/NA	AM	SES	12/2014							
11	AS-BUILT WBS XC-XO-13-XCOM-010 OVERPRESSURE PROTECTION	LC	CJ	AM	SES	11/2014							
10	DRG No. REVISED FOR EXP. COMP. RE-NUMBERING. WAS 0105-0025/04	RL/ES	MH	AM	SES	05/2012							
9	AS BUILT COMMENTS ADDED	VB	RL	EJH	RS	10/98							
8	AS BUILT FOR REFURBISHMENT PROJECT	V.B.	G.R.	K.E.	G.M.	10/97							
7	AS BUILT - AUP GAS SUPPLY MODS	J.W.	B.T.	G.E.	A.V.G.	12/95							
6	AS BUILT MCKEE STAGE 1. ZSOC-9606, 8 & SLU REMOVED	J.B.H.	R.L.	AvG	J.B.G.	10/95							
5	AS BUILT COMMENTS INCORPORATED	V.B.	B.T.	A.V.G.	C.J.	5/95							
14	AS-BUILT - PRODUCT GAS COMP. CONTROL IMPROVEMENTS	JCC	RL/AQ	AM	SES	04/2016							
15	AS-BUILT - LINE No. P3165-200-6H1 WAS SHOWN AS 6C1	RL	JCC	AM	SES	02/2017							
14	AS-BUILT - PRODUCT GAS COMP. CONTROL IMPROVEMENTS	JCC	RL/AQ	AM	SES	04/2016							
4	REDRAWN ON AUTOPLANT, NOW 4 SHEETS.	D.R.	J.C.	G.M.	C.J.	09/94							

VECTOR KAPUNI LIMITED
 PRIVATE BAG 2020
 NEW PLYMOUTH 4342
 PHONE 0800 734 567

sjio

COPYRIGHT The copyright in this document is vested in Vector Kapuni Limited
 The contents of this document shall not be reproduced, either in whole or part, by any
 means whatsoever without the prior written consent of Vector Kapuni Limited.

AUTOCAD ORIGINAL SHEET SIZE A1

DRN	W.BAKER	02/12/1985	ENG			
CHK			APP			

SCALE:	JOB NO.	SERIES	DRG. NO	SHT 01	REVISION
NTS	1000000	0105	0027	01	15

EQUIPMENT No.

DESCRIPTION
CAPACITY
MAWP @ TEMP

CM-903-5
SUCTION SCRUBBER
1219 OD X 1800 T/T
51.7 BARG @ 14.9°C


C-903-5
PRODUCT GAS COMPRESSOR
13.3 Sm³/S @ 41.3 BARG, 38°C
93 BARG @ 14.9°C

CE-903-5B
GAS COOLER
1488 kW
94.8 BARG @ 177°C

NOTES

- ASSOCIATED EQUIPMENT NUMBERS:
- CD-903-5 - PRODUCT GAS COMPRESSOR
 - CE-903-5 - DISCHARGE AFTERCOOLER UNIT
 - CE-903-5A - JACKET WATER COOLER
 - CE-903-5-FAN - PRODUCT GAS COMPRESSOR FAN
 - CF-903-5 - PRODUCT GAS COMPRESSOR ENGINE
 - CF-903-5A - SUCTION PULSATION BOTTLE (WEST)
 - CF-903-5B - SUCTION PULSATION BOTTLE (EAST)
 - CF-903-5C - DISCHARGE PULSATION BOTTLE (WEST)
 - CF-903-5D - DISCHARGE PULSATION BOTTLE (EAST)

- P9073-150-6C1* FLANGE RATING AS PER ASME B16.5 CL900.
- P9058-150-6C1 CONTAINS CL900 FLANGE SET.

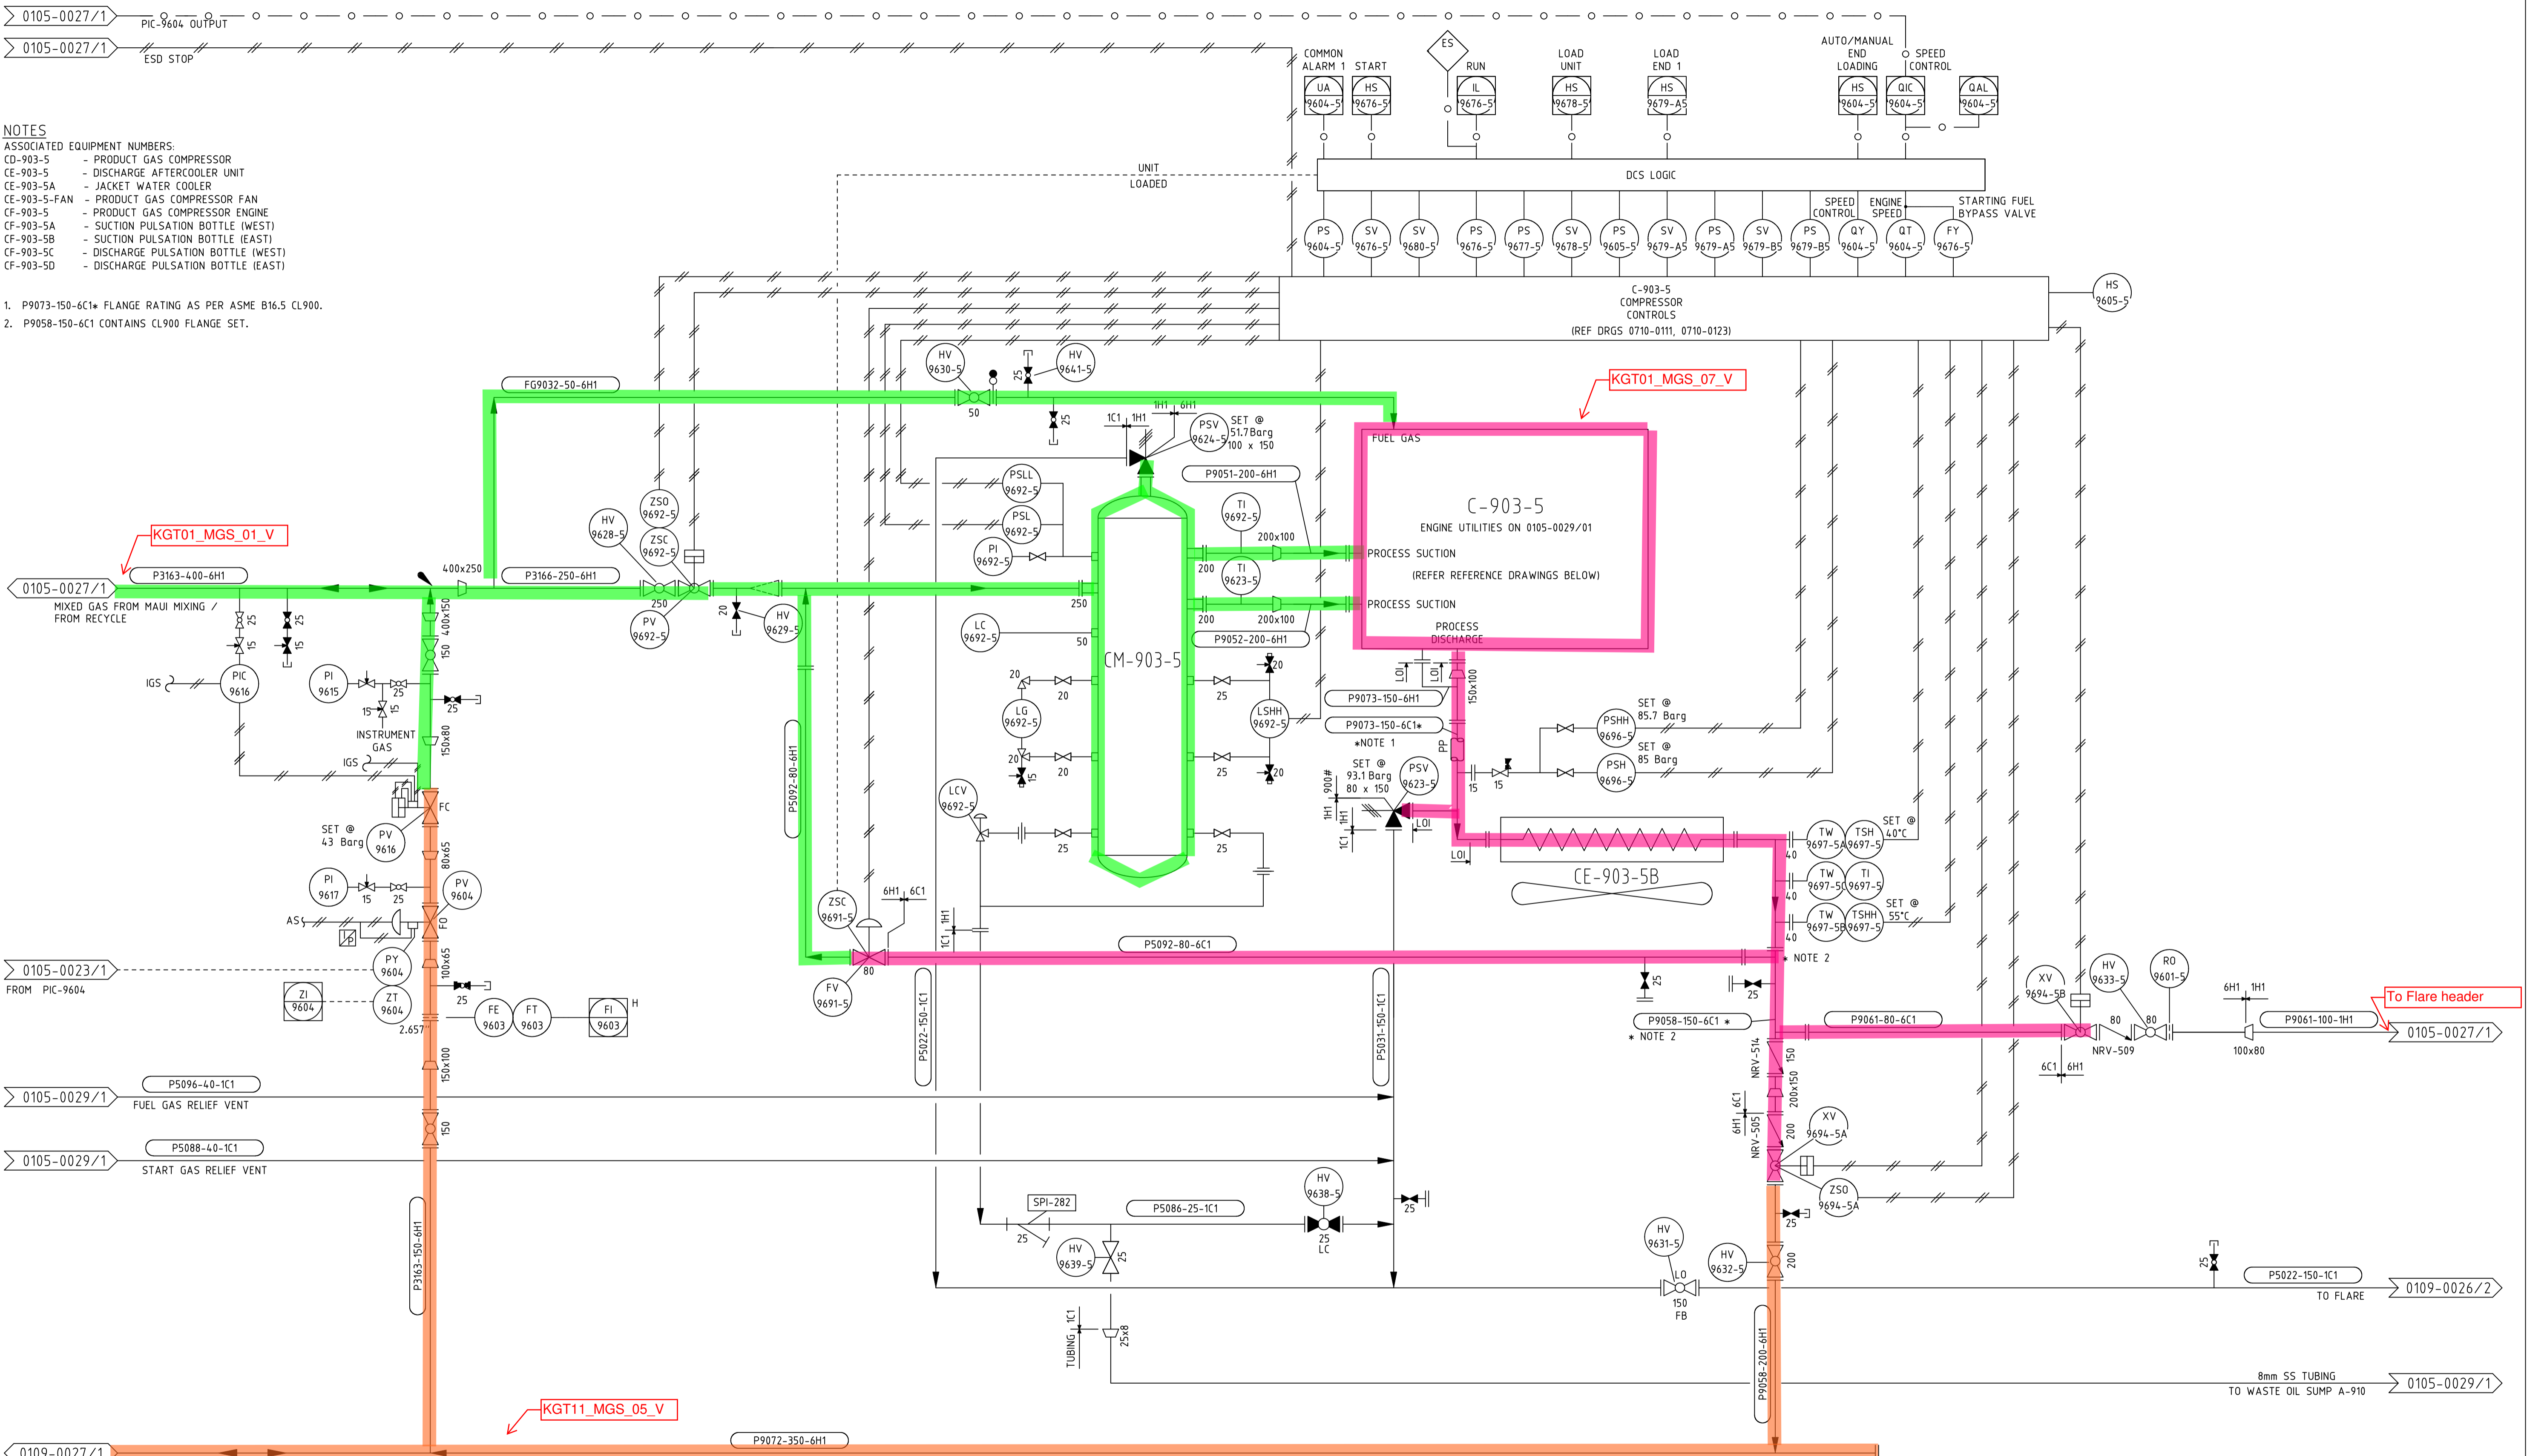

REV	AMENDMENT	BY	CHK	ENG	APP	DATE	REV	AMENDMENT	BY	CHK	ENG	APP	DATE
23	AS BUILT XC-X0-12-XCOM-002 COMPR COOLER REPLACEMENT	RL	KS	AM	SS/DS	01/2013							
22	AS BUILT P84-1041 FLARE GAS MEASUREMENT	ES/RL	TC	AM	SES	09/12/13	32	AS BUILT HAND VALVE TAG NUMBER HV-9641-5 ADDED	RL	JCC	AM	TC	12/2019
21	DRG No. REVISED FOR EXP. COMP. RE-NUMBERING. WAS 0105-0025/05	RL/ES	MH	AM	SES	05/2012	31	AS BUILT P84-1506 FIRST GAS LOWERED PIPELINE RATING	RL	JCC	AM	TC	06/2019
20	PARTIAL AS BUILT V118 #5 COOLER REPLACEMENT	NK	CJ	JS	AS	10/10/10	30	AS BUILT-DRAIN ADDED TO LINE P5031-150-1C1 & XT-017 REMOVED	RL	JCC	AM	SES	05/2017
19	PARTIAL AS BUILT P84-3208 NEW RO FOR #5 PGC	SA	CJ	WB	LH	10/10/10	29	AS BUILT - P84-1294 LO REMOVED FROM VALVE HV-9639-5	RL	JCC	AM	SES	02/2017
18	AS BUILT WS1467593 IMPROVE PROD COMP SUCT PRESS CTRL	ES	AAB	LH	SES	08/09/09	28	AS BUILT - P84-1294 MODIFY #5 PGC SCRUBBER OIL DRAIN	JB	CJ	AM	TC	11/2016
17	AS BUILT TO WS146704 CRIT. CONTROL VALVE FEEDBACK	KN	LH	MP	PJR	09/07/07	27	AS BUILT - PRODUCT GAS COMP. CONTROL IMPROVEMENTS	JCC	RL/AC	AM	SES	04/2016
16	AS BUILT ZSO/ZSC-9692-5 ADDED	VB	ES	AAB	PJR	11/06/06	26	AS BUILT FLOW PATH PV-9616 SET PRESSURE & NRV No's ADDED	RL	JC/MY	AM	SES	01/2016
15	AS BUILT RE JULY SHUTDOWN COMP 5 INCIDENT	VB	CP	LH	PJR	08/06/06	25	AS BUILT WBS XC-X0-13-XCOM-010 KGTP SUCTION OVERPRESSURE	JS	CJ	AM	SES	09/2015
14	PSV-9623-5 WAS SET AT 93.1 BARG	CMW	RL	DC	AIM	08/02/02	24	HAND VALVE NUMBERS ADDED FOR ISOLATIONS	RL	CR	AM	SES	10/2013

VECTOR KAPUNI LIMITED
PRIVATE BAG 2020
NEW PLYMOUTH 4342
PHONE 0800 734 567




COPYRIGHT The copyright in this document is vested in Vector Kapuni Limited. The contents of this document shall not be reproduced, either in whole or part, by any means whatsoever without the prior written consent of Vector Kapuni Limited.

REFERENCE DRAWINGS
DRAWING WAS 0105-0025/05
COMPRESSOR VENDOR PACKAGE P&ID'S - 0303-0002/01, 2, 3 & 4


DRN	W.BAKER	DATE	ENG	DATE
CHK		02/12/1985	APP	

SCALE:	JOB NO.	SERIES	DRG. NO	SHT	REVISION
NTS	1000000	0105	0028	01 OF 01 SHTS	32

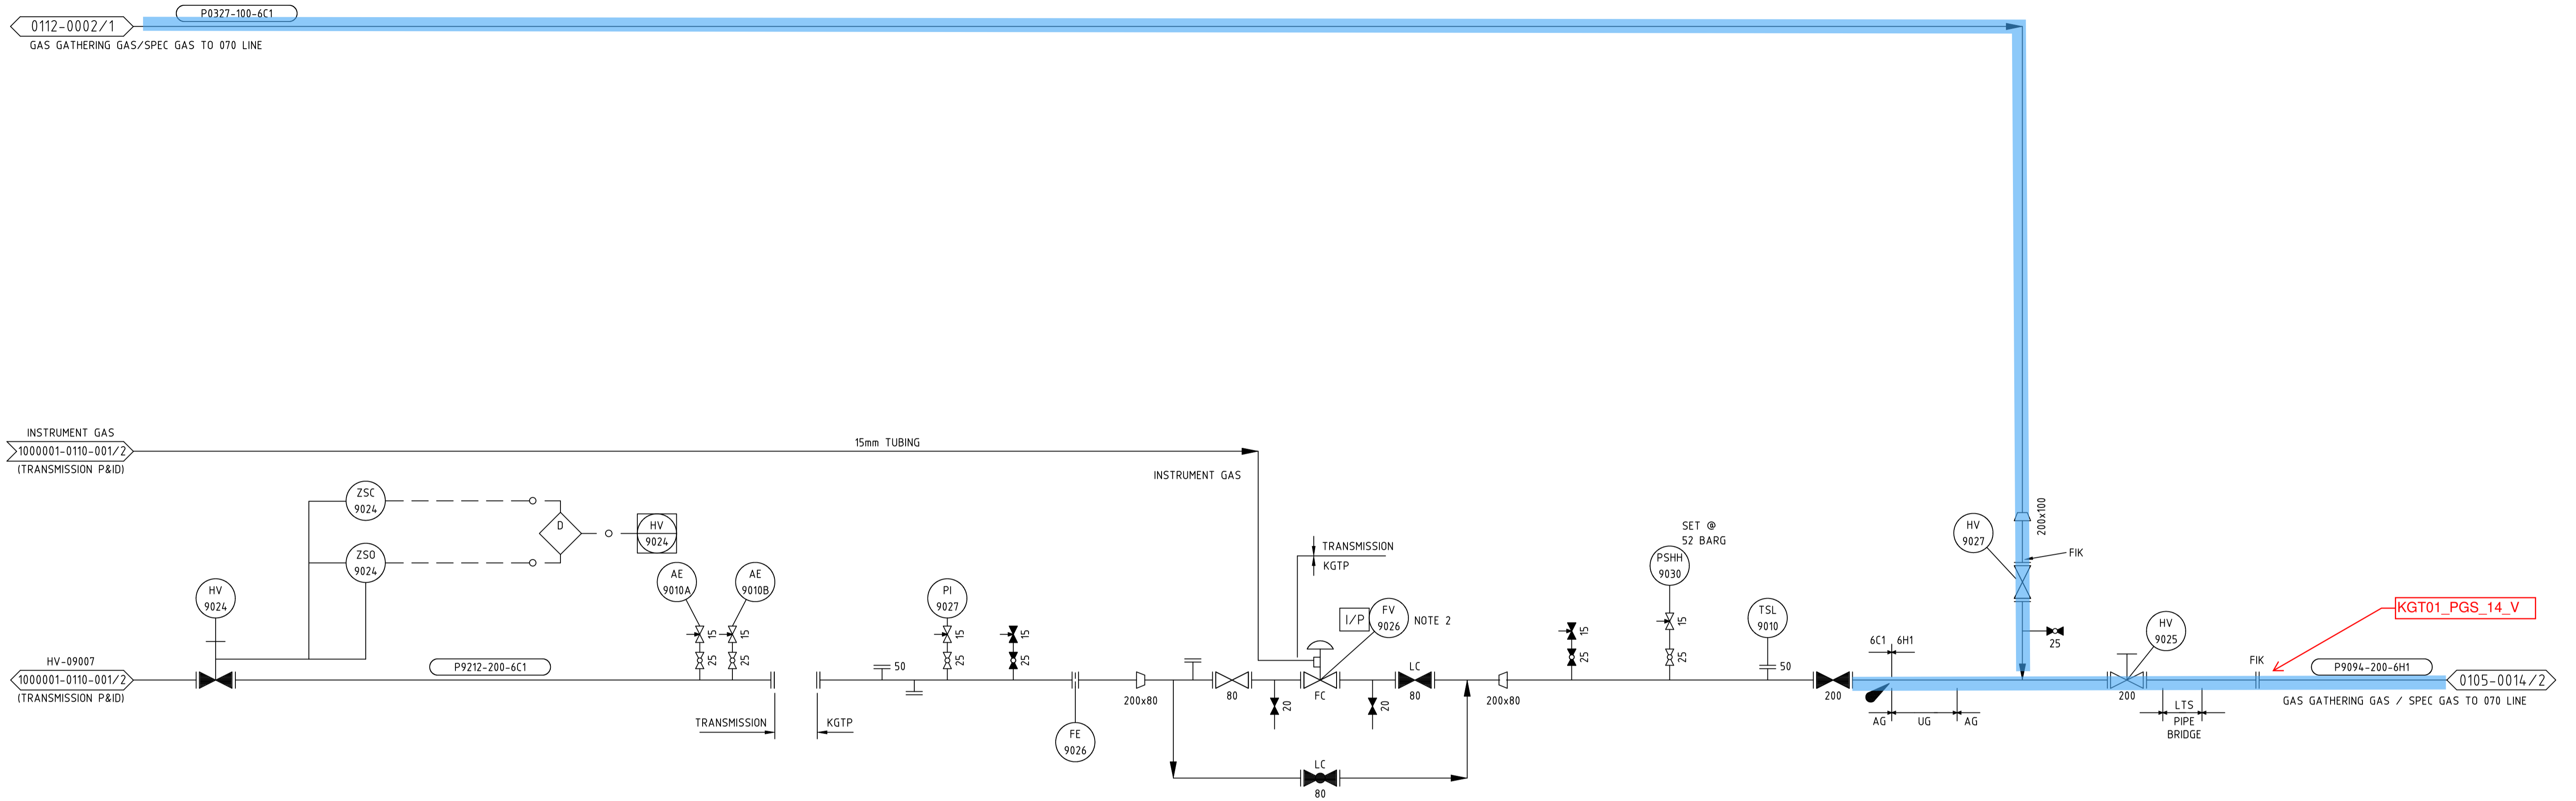

REV	AMENDMENT	BY	CHK	ENG	APP	DATE	REV	AMENDMENT	BY	CHK	ENG	APP	DATE
9	GAS GATHERING MODE	RL	ES	LH	PJR	06/2006							
8	AS BUILT TO NGC ENGINEERING MARK-UP	ES	KC	LH	PJR	06/05							
7	WS971915 AS BUILT. GAS TO METHANEX	JBH	RL	LH	PJR	03/02/05							
6	AS BUILT FOR WS860238 GAS GATHERING / KGTP TIE IN'S	RL	DT	LH	PJR	11/2004							
5	AS BUILT FOR LTS OVERHEADS PROJECT	RL	JBH	EJH	RS	05/00							
4	REVISED FOR NEW PRINT. DRAWING CONTENT NOT CHANGED	VB	RL	EJH	RS	10/99							
3	AS BUILT FOR REFURBISHMENT PROJECT	V.B.	G.R.	K.E.	G.M.	10/97							
2	AS BUILT COMMENTS INCORPORATED	V.B.	B.T.	A.V.G.	C.J.	6/95							
1	AS-BUILT FOR MCKEE GAS PROJECT STAGE 1	J.T.	M.C.	R.V.	C.J.	5/95							
0	ISSUED FOR CONSTRUCTION	J.T.	M.C.	R.V.		3/95							

VECTOR KAPUNI LIMITED
 PRIVATE BAG 2020
 NEW PLYMOUTH 4342
 PHONE 0800 734 567

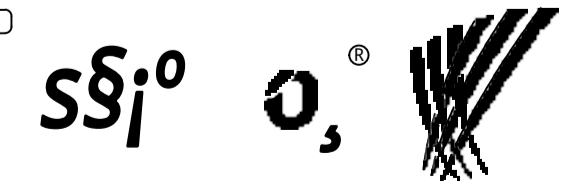

COPYRIGHT The copyright in this document is vested in Vector Kapuni Limited
 The contents of this document shall not be reproduced, either in whole or part, by any means whatsoever without the prior written consent of Vector Kapuni Limited.

AUTOCAD ORIGINAL SHEET SIZE A1

DRN	DATE	ENG	APP	DATE
J.TERRILL	22/02/1995	ENG	R. VERNON	22/02/1995
D. AITKEN	22/02/1995	APP	C. JANATA	01/03/1995


SCALE:	JOB NO.	SERIES	DRG. NO	SHT 01 OF 01 SHTS	REVISION
N/A	1000000	0105	0031		12

EQUIPMENT No.

DESCRIPTION
CAPACITY
MAWP @ TEMP

M-628-A
FUEL GAS FILTER
CAPACITY 0.063 m³
MAWP 44 BarG @ 93 °C

M-628-B
FUEL GAS FILTER
CAPACITY 0.063 m³
MAWP 44 BarG @ 93 °C

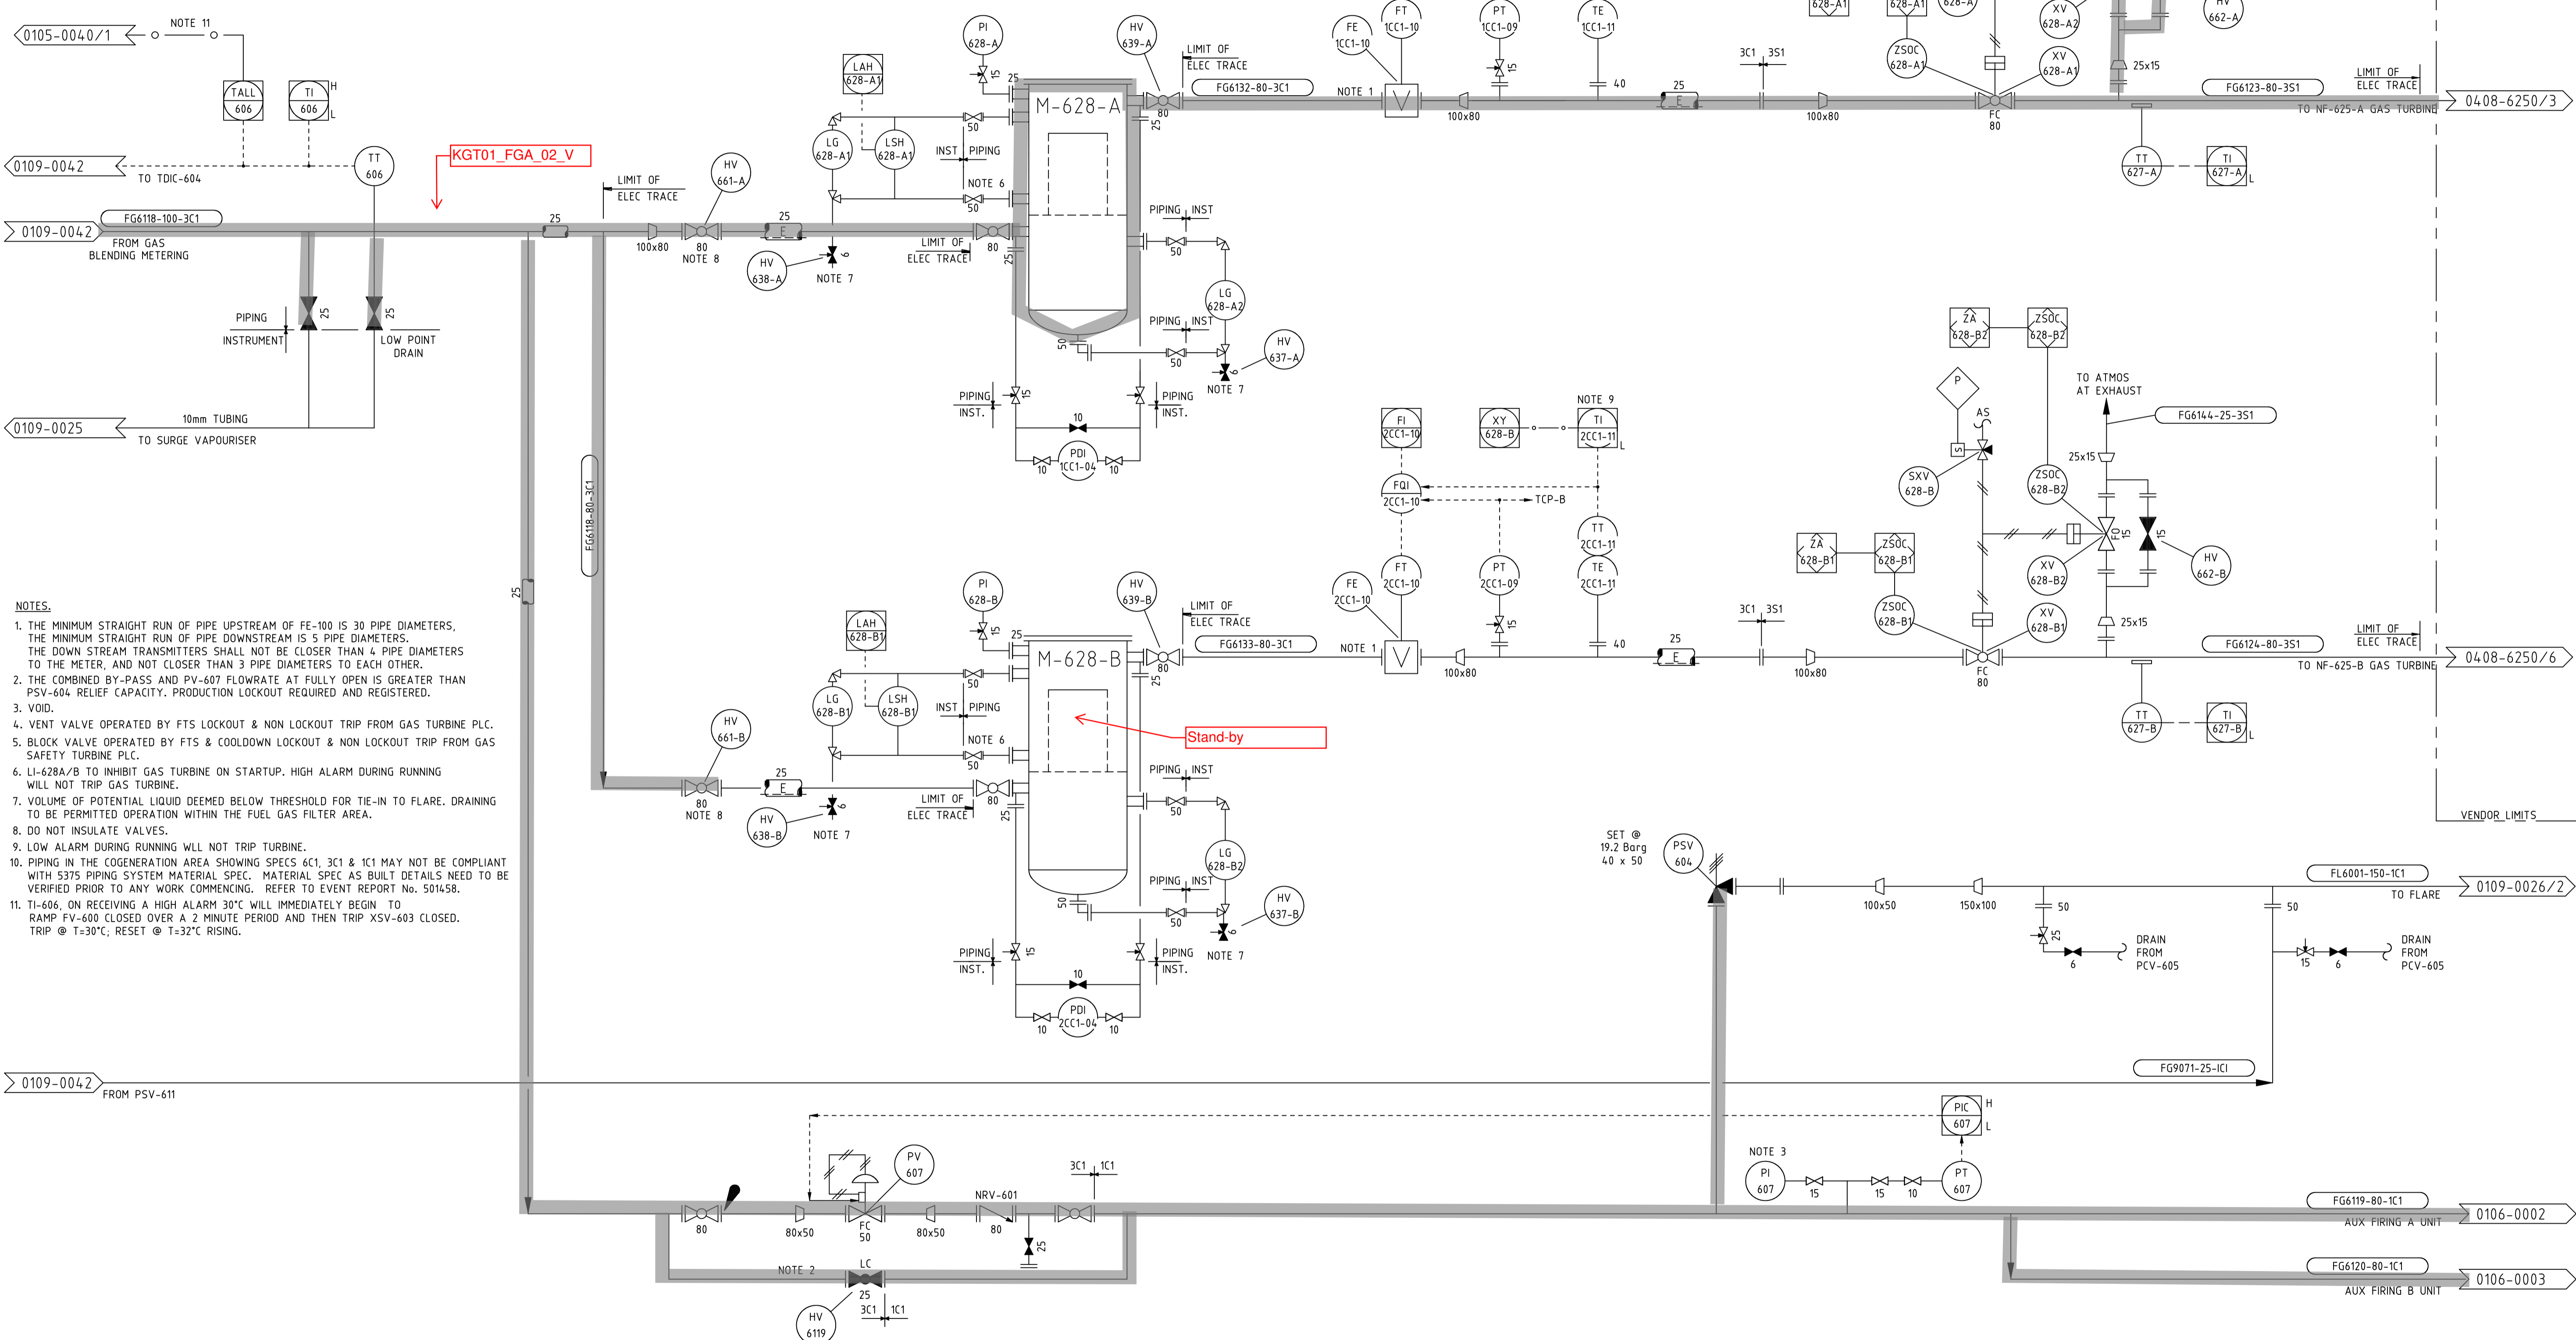

- NOTES:
1. THE MINIMUM STRAIGHT RUN OF PIPE UPSTREAM OF FE-100 IS 30 PIPE DIAMETERS. THE MINIMUM STRAIGHT RUN OF PIPE DOWNSTREAM IS 5 PIPE DIAMETERS. THE DOWN STREAM TRANSMITTERS SHALL NOT BE CLOSER THAN 4 PIPE DIAMETERS TO THE METER, AND NOT CLOSER THAN 3 PIPE DIAMETERS TO EACH OTHER.
 2. THE COMBINED BY-PASS AND PV-607 FLOWRATE AT FULLY OPEN IS GREATER THAN PSV-604 RELIEF CAPACITY. PRODUCTION LOCKOUT REQUIRED AND REGISTERED.
 3. VOID.
 4. VENT VALVE OPERATED BY FTS LOCKOUT & NON LOCKOUT TRIP FROM GAS TURBINE PLC.
 5. BLOCK VALVE OPERATED BY FTS & COOLDOWN LOCKOUT & NON LOCKOUT TRIP FROM GAS SAFETY TURBINE PLC.
 6. LI-628A/B TO INHIBIT GAS TURBINE ON STARTUP. HIGH ALARM DURING RUNNING WILL NOT TRIP GAS TURBINE.
 7. VOLUME OF POTENTIAL LIQUID DEEMED BELOW THRESHOLD FOR TIE-IN TO FLARE. DRAINING TO BE PERMITTED OPERATION WITHIN THE FUEL GAS FILTER AREA.
 8. DO NOT INSULATE VALVES.
 9. LOW ALARM DURING RUNNING WILL NOT TRIP TURBINE.
 10. PIPING IN THE COGENERATION AREA SHOWING SPECS 6C1, 3C1 & 1C1 MAY NOT BE COMPLIANT WITH 5375 PIPING SYSTEM MATERIAL SPEC. MATERIAL SPEC AS BUILT DETAILS NEED TO BE VERIFIED PRIOR TO ANY WORK COMMENCING. REFER TO EVENT REPORT No. 501458.
 11. TI-606, ON RECEIVING A HIGH ALARM 30°C WILL IMMEDIATELY BEGIN TO RAMP FV-600 CLOSED OVER A 2 MINUTE PERIOD AND THEN TRIP XSV-603 CLOSED. TRIP @ T=30°C; RESET @ T=32°C RISING.

REV	AMENDMENT	BY	CHK	ENG	APP	DATE	REV	AMENDMENT	BY	CHK	ENG	APP	DATE
10	AS BUILT WS998333 COGEN FUEL SUPPLY	PJ	LH	MP	PJR	05/07	9	NOTE 10 ADDED RE INCIDENT REPORT NUMBER 501458	RL	DS	LH	PJR	04/2007
18	PDI-1CC1 & PDI-2CC1 WERE SHOWN CLOSED & COD No. REVISED	RL	JCC	AM	TC	08/2019	8	AS BUILT FOR WS1062668 IMPLEMENT KVAERNER REPORT	VB	LH	MP	PJR	03/07
17	HAND VALVE NUMBERS ADDED FOR ISOLATIONS	RL	JCC	AM	TC	09/2016	7	PROCESS ISOLATION POINTS ADDED ON INDIVIDUAL LAYERS	CMW	RL	LH/CM	AIM	11/02
16	NON RETURN VALVE NUMBER NRV-601 ADDED	RL	JC	AM	SES	07/2015	6	AS BUILT WS156953 COGEN AUX. FUEL	CMW	RL	DC	AIM	11/02
15	HAND VALVE NUMBERS ADDED FOR ISOLATIONS & PROCESS CONDITIONS UPDATED FOR M-628-A AND B	RL/ES	CR	AM	SES	08/2013	5	WS189886 GT FUEL GAS TEMPERATURES TO DCS AS BUILT	JBH	RL	AAB	PJR	08/02
14	AS BUILT P84-3017. REPLACE PV-607.	RL	SAR	AM	SES	02/2012	4	FLOW & TEMPERATURE TAGS RATIONALISED	JBH	RL	AvG	AIM	08/02
13	AS BUILT P84-3021 GT GAS FLOW TO DCS	ES	AAB	LH	SES	10/10	3	6mm TUBING CORRECTED TO 10mm	VB	RL	EJH	RS	10/99
12	AS BUILT WS2006877 KEJV SOLAR 50/50 SPLIT	ES	AAB	LH	SES	05/09	2	AS BUILT COMMENTS INCORPORATED	VB	RL	EJH	RS	06/99
11	AS BUILT INCIDENT REPORT 503502 -3S1 LINE No.s REVISED	RL	MD	LH	PJR	07/07	1	REDRAWN ON CAD FROM SOLAR DRAWING	VB	RL	EJH	RS	11/98

VECTOR KAPUNI LIMITED
PRIVATE BAG 2020
NEW PLYMOUTH 4342
PHONE 0800 734 567

COPYRIGHT The copyright in this document is vested in Vector Kapuni Limited. The contents of this document shall not be reproduced, either in whole or part, by any means whatsoever without the prior written consent of Vector Kapuni Limited.

REFERENCE DRAWINGS
SOLAR DRAWING 5163-1500-F001

DRN	V BRENNAN	16/11/1998	ENG	E J HURLEY	14/05/1999
CHK	R LOCHHEAD	14/05/1999	APP	R SUMBALY	14/05/1999

COGENERATION AREA
PIPING & INSTRUMENT DIAGRAM
FUEL GAS FILTERS

SCALE:	JOB NO.	SERIES	DRG. NO	SHT	REVISION
N/A	1000000	0106	0001	01 OF 01 SHTS	18

EQUIPMENT No.
DESCRIPTION
CAPACITY
MAWP @ TEMP


C-624-1
COOLING AIR FAN
FLOW XXSm³/Hr @ XX hp
MAWP XXXBarg @ XX°C

C-624-2
COOLING AIR FAN
FLOW XXSm³/Hr @ XX hp
MAWP XXXBarg @ XX°C

B-604-A1
DUCT BURNER
CAPACITY XXm³
MAWP XXXBarg @ XXX°C

B-604-A2
DUCT BURNER
CAPACITY XXm³
MAWP XXXBarg @ XXX°C

B-604-A3
DUCT BURNER
CAPACITY XXm³
MAWP XXXBarg @ XXX°C

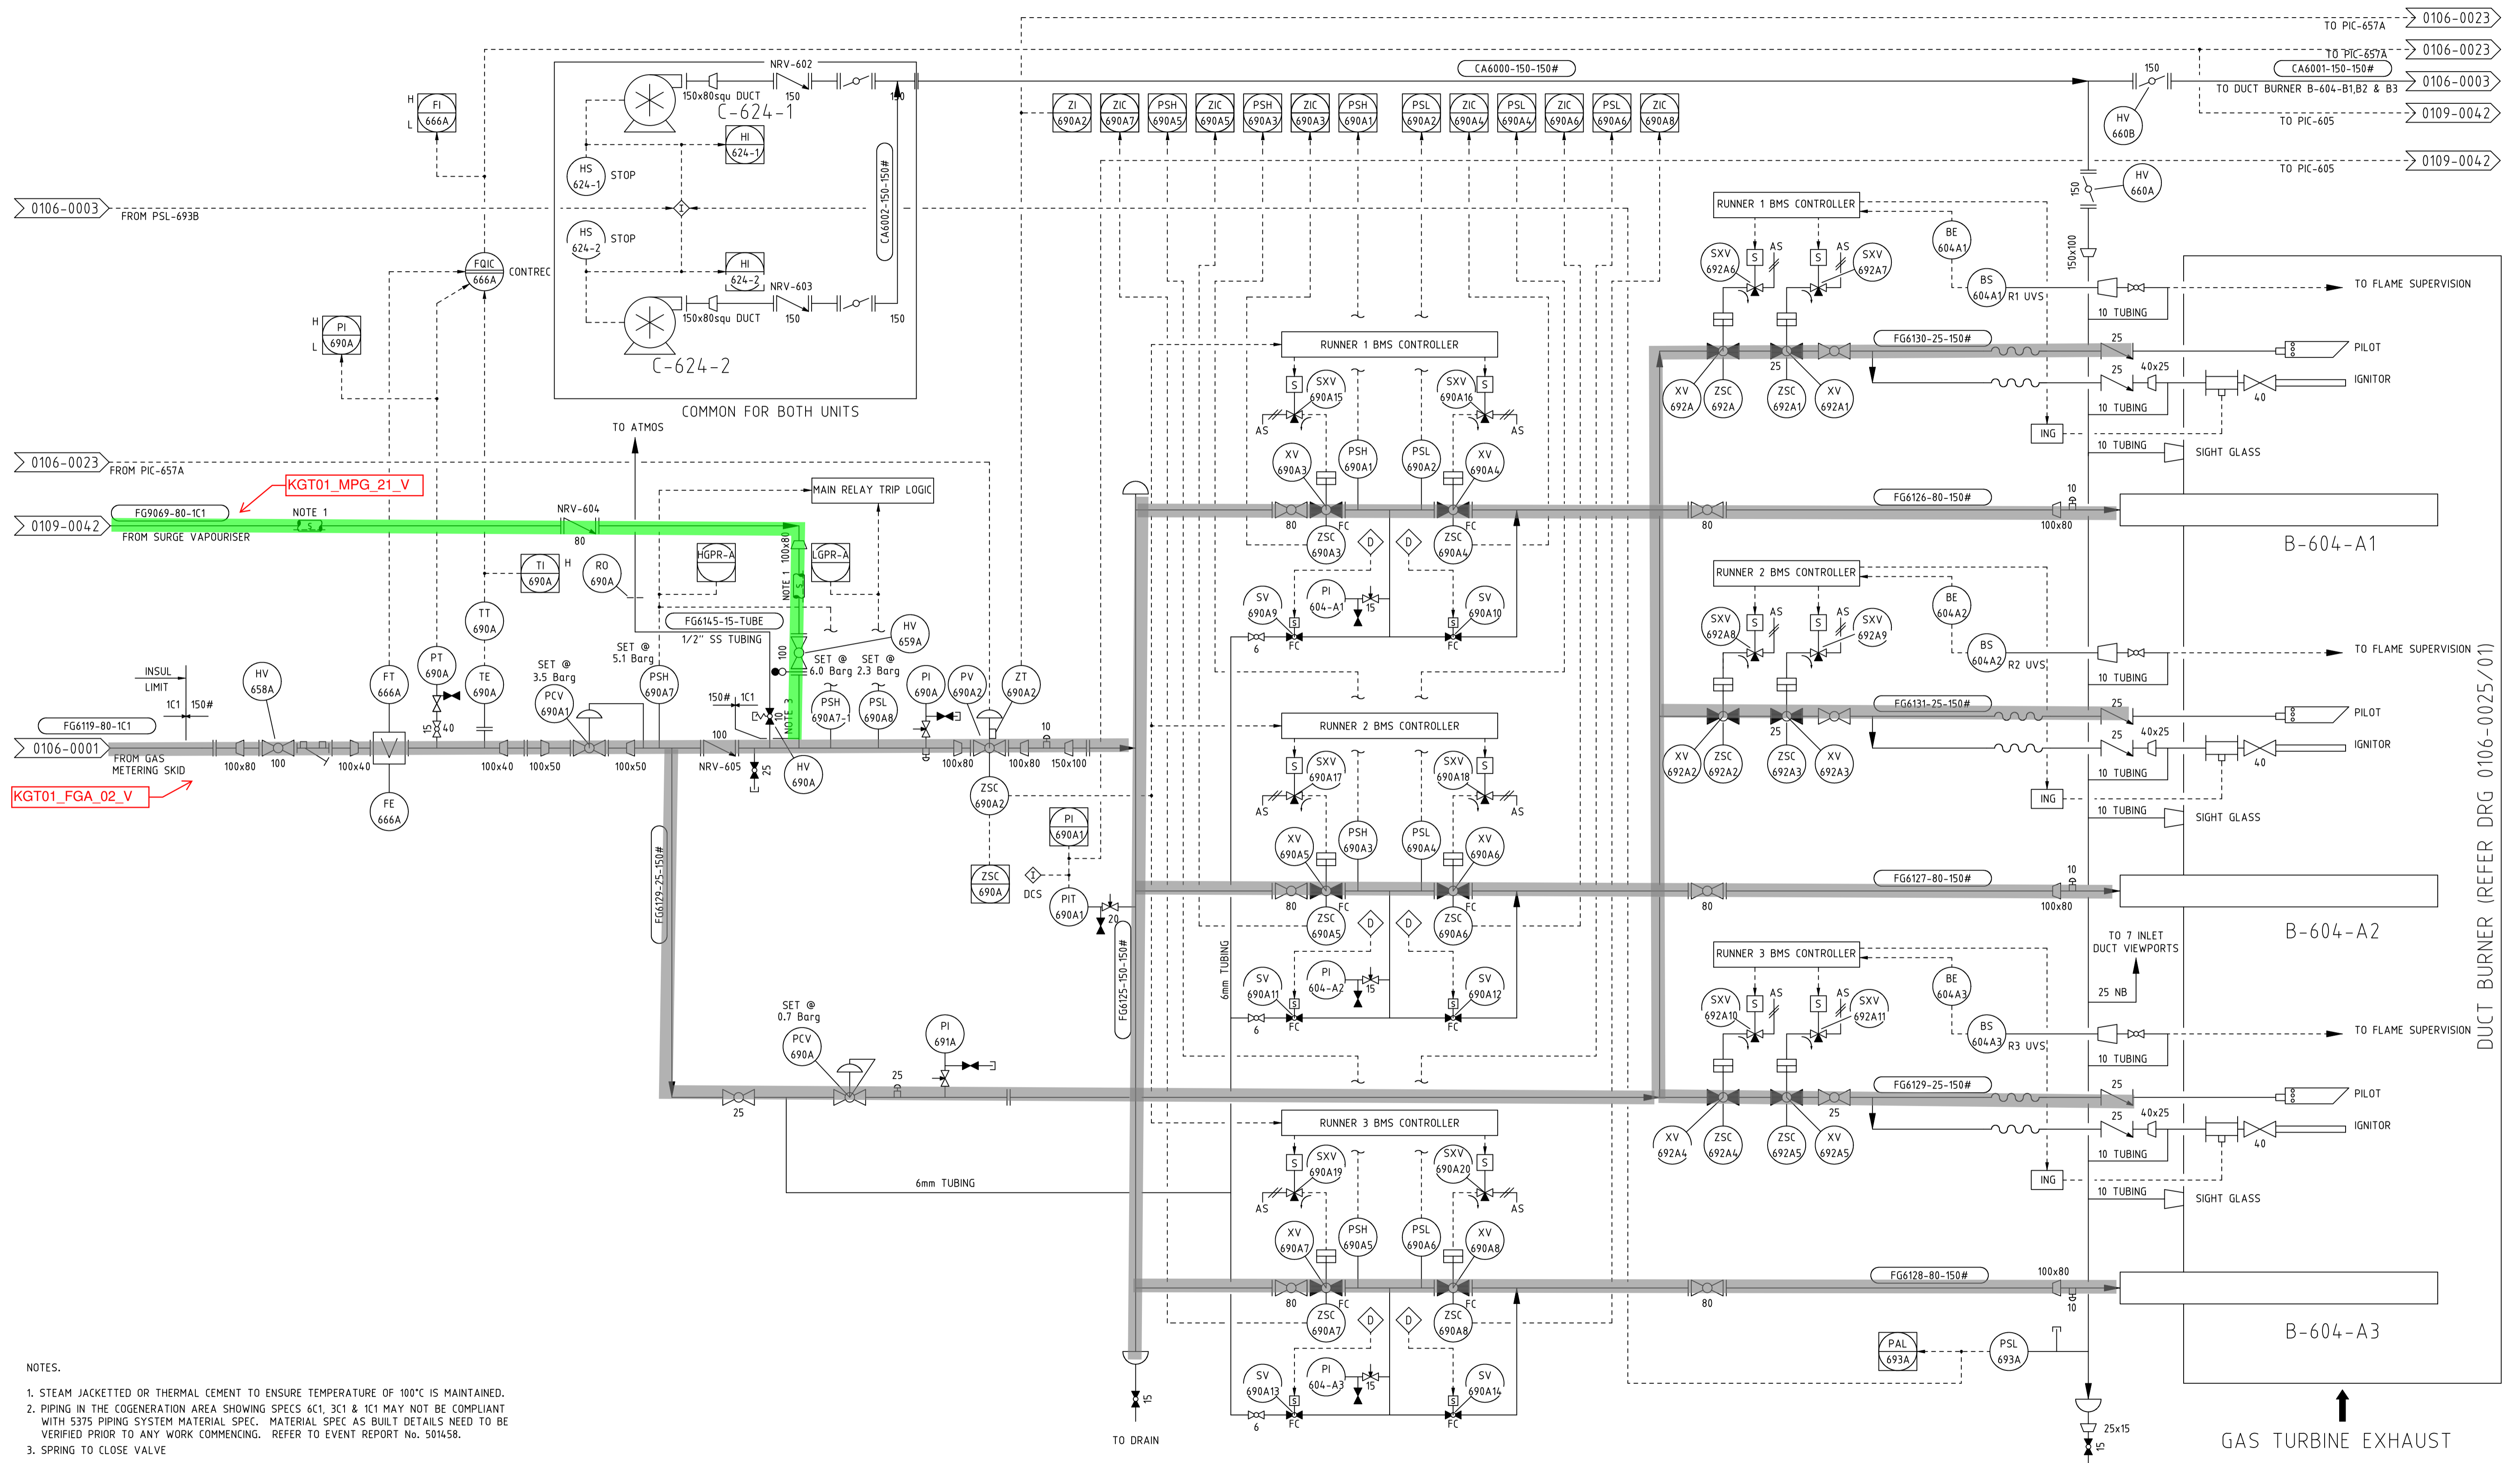

- NOTES.
- STEAM JACKETED OR THERMAL CEMENT TO ENSURE TEMPERATURE OF 100°C IS MAINTAINED.
 - PIPING IN THE COGENERATION AREA SHOWING SPECS 6C1, 3C1 & 1C1 MAY NOT BE COMPLIANT WITH 5375 PIPING SYSTEM MATERIAL SPEC. MATERIAL SPEC AS BUILT DETAILS NEED TO BE VERIFIED PRIOR TO ANY WORK COMMENCING. REFER TO EVENT REPORT No. 501458.
 - SPRING TO CLOSE VALVE

REV	AMENDMENT	BY	CHK	ENG	APP	DATE	REV	AMENDMENT	BY	CHK	ENG	APP	DATE
13	NON RETURN VALVE (NRV) NUMBERS ADDED	RL	JCC	AM	TC	09/2019	3	PI-690A SIGNAL CORRECTED FROM TT-690A TO PT-690A	VB	RL	EJH	RS	10/99
12	HAND VALVE NUMBERS ADDED FOR ISOLATIONS	RL	CR	AM	SES	08/2013	2	AS BUILT COMMENTS INCORPORATED	VB	RL	EJH	RS	06/99
11	AS BUILT P&L-1061 VENT LINE	LN	RL	AM	SES	04/2013	1	REDRAWN ON CAD FROM SENIOR DWG	VB	RL	EJH	RS	11/98

REV	AMENDMENT	BY	CHK	ENG	APP	DATE
10	P84-1061 HRSG PLC UPGRADE - PARTIAL AS BUILT	LN	CJ	AM	SES	07/2012
9	AS BUILT P84-1152 PI-604-A1, A2 AND A3 ADDED	RL	WB	LH	SES	08/2010
8	NOTE 2 ADDED RE INCIDENT REPORT NUMBER 501458	RL	SR	LH	PJR	01/2007
7	AS BUILT - GAS PRESSURE SWITCH MODS	ES	AAB	LH	PJR	11/05
6	EQUIP. No. FOR HRSG MOVED TO 0106-0025/01	PL	RL	DT	PJR	24/06/03
5	PROCESS ISOLATION POINTS ADDED ON INDIVIDUAL LAYERS	CMW	RL	CM	AIM	10/02
4	WS184313 SURGE VAPOURISER TO COGEN FUEL AS BUILT	JBH	RL	AVG	AIM	06/08/02

VECTOR LIMITED
PRIVATE BAG 2020
NEW PLYMOUTH 4620
PHONE 0800 734 567

REFERENCE DRAWINGS
SENIOR DRAWING No. 4256 B1 TC

COPYRIGHT The copyright in this document is vested in Vector Limited
The contents of this document shall not be reproduced, either in whole or part, by any means whatsoever without the prior written consent of Vector Limited.

AUTOCAD ORIGINAL SHEET SIZE A1

DATE	DATE
09/11/1998	14/05/1999
14/05/1999	14/05/1999

COGENERATION AREA
PIPING & INSTRUMENT DIAGRAM
DUCT BURNERS FOR HRSG 'A'

SCALE: NTS

JOB NO. 1000000

SERIES 0106

DRG. NO 0002

SHT 01 OF 01 SHTS

REVISION 13


1000000-0106-0002-01.dwg

EQUIPMENT No.
DESCRIPTION
CAPACITY
MAWP @ TEMP

B-604-B1
DUCT BURNER
CAPACITY XXm³
MAWP XXXBarg @ XXX°C

B-604-B2
DUCT BURNER
CAPACITY XXm³
MAWP XXXBarg @ XXX°C

B-604-B3
DUCT BURNER
CAPACITY XXm³
MAWP XXXBarg @ XXX°C

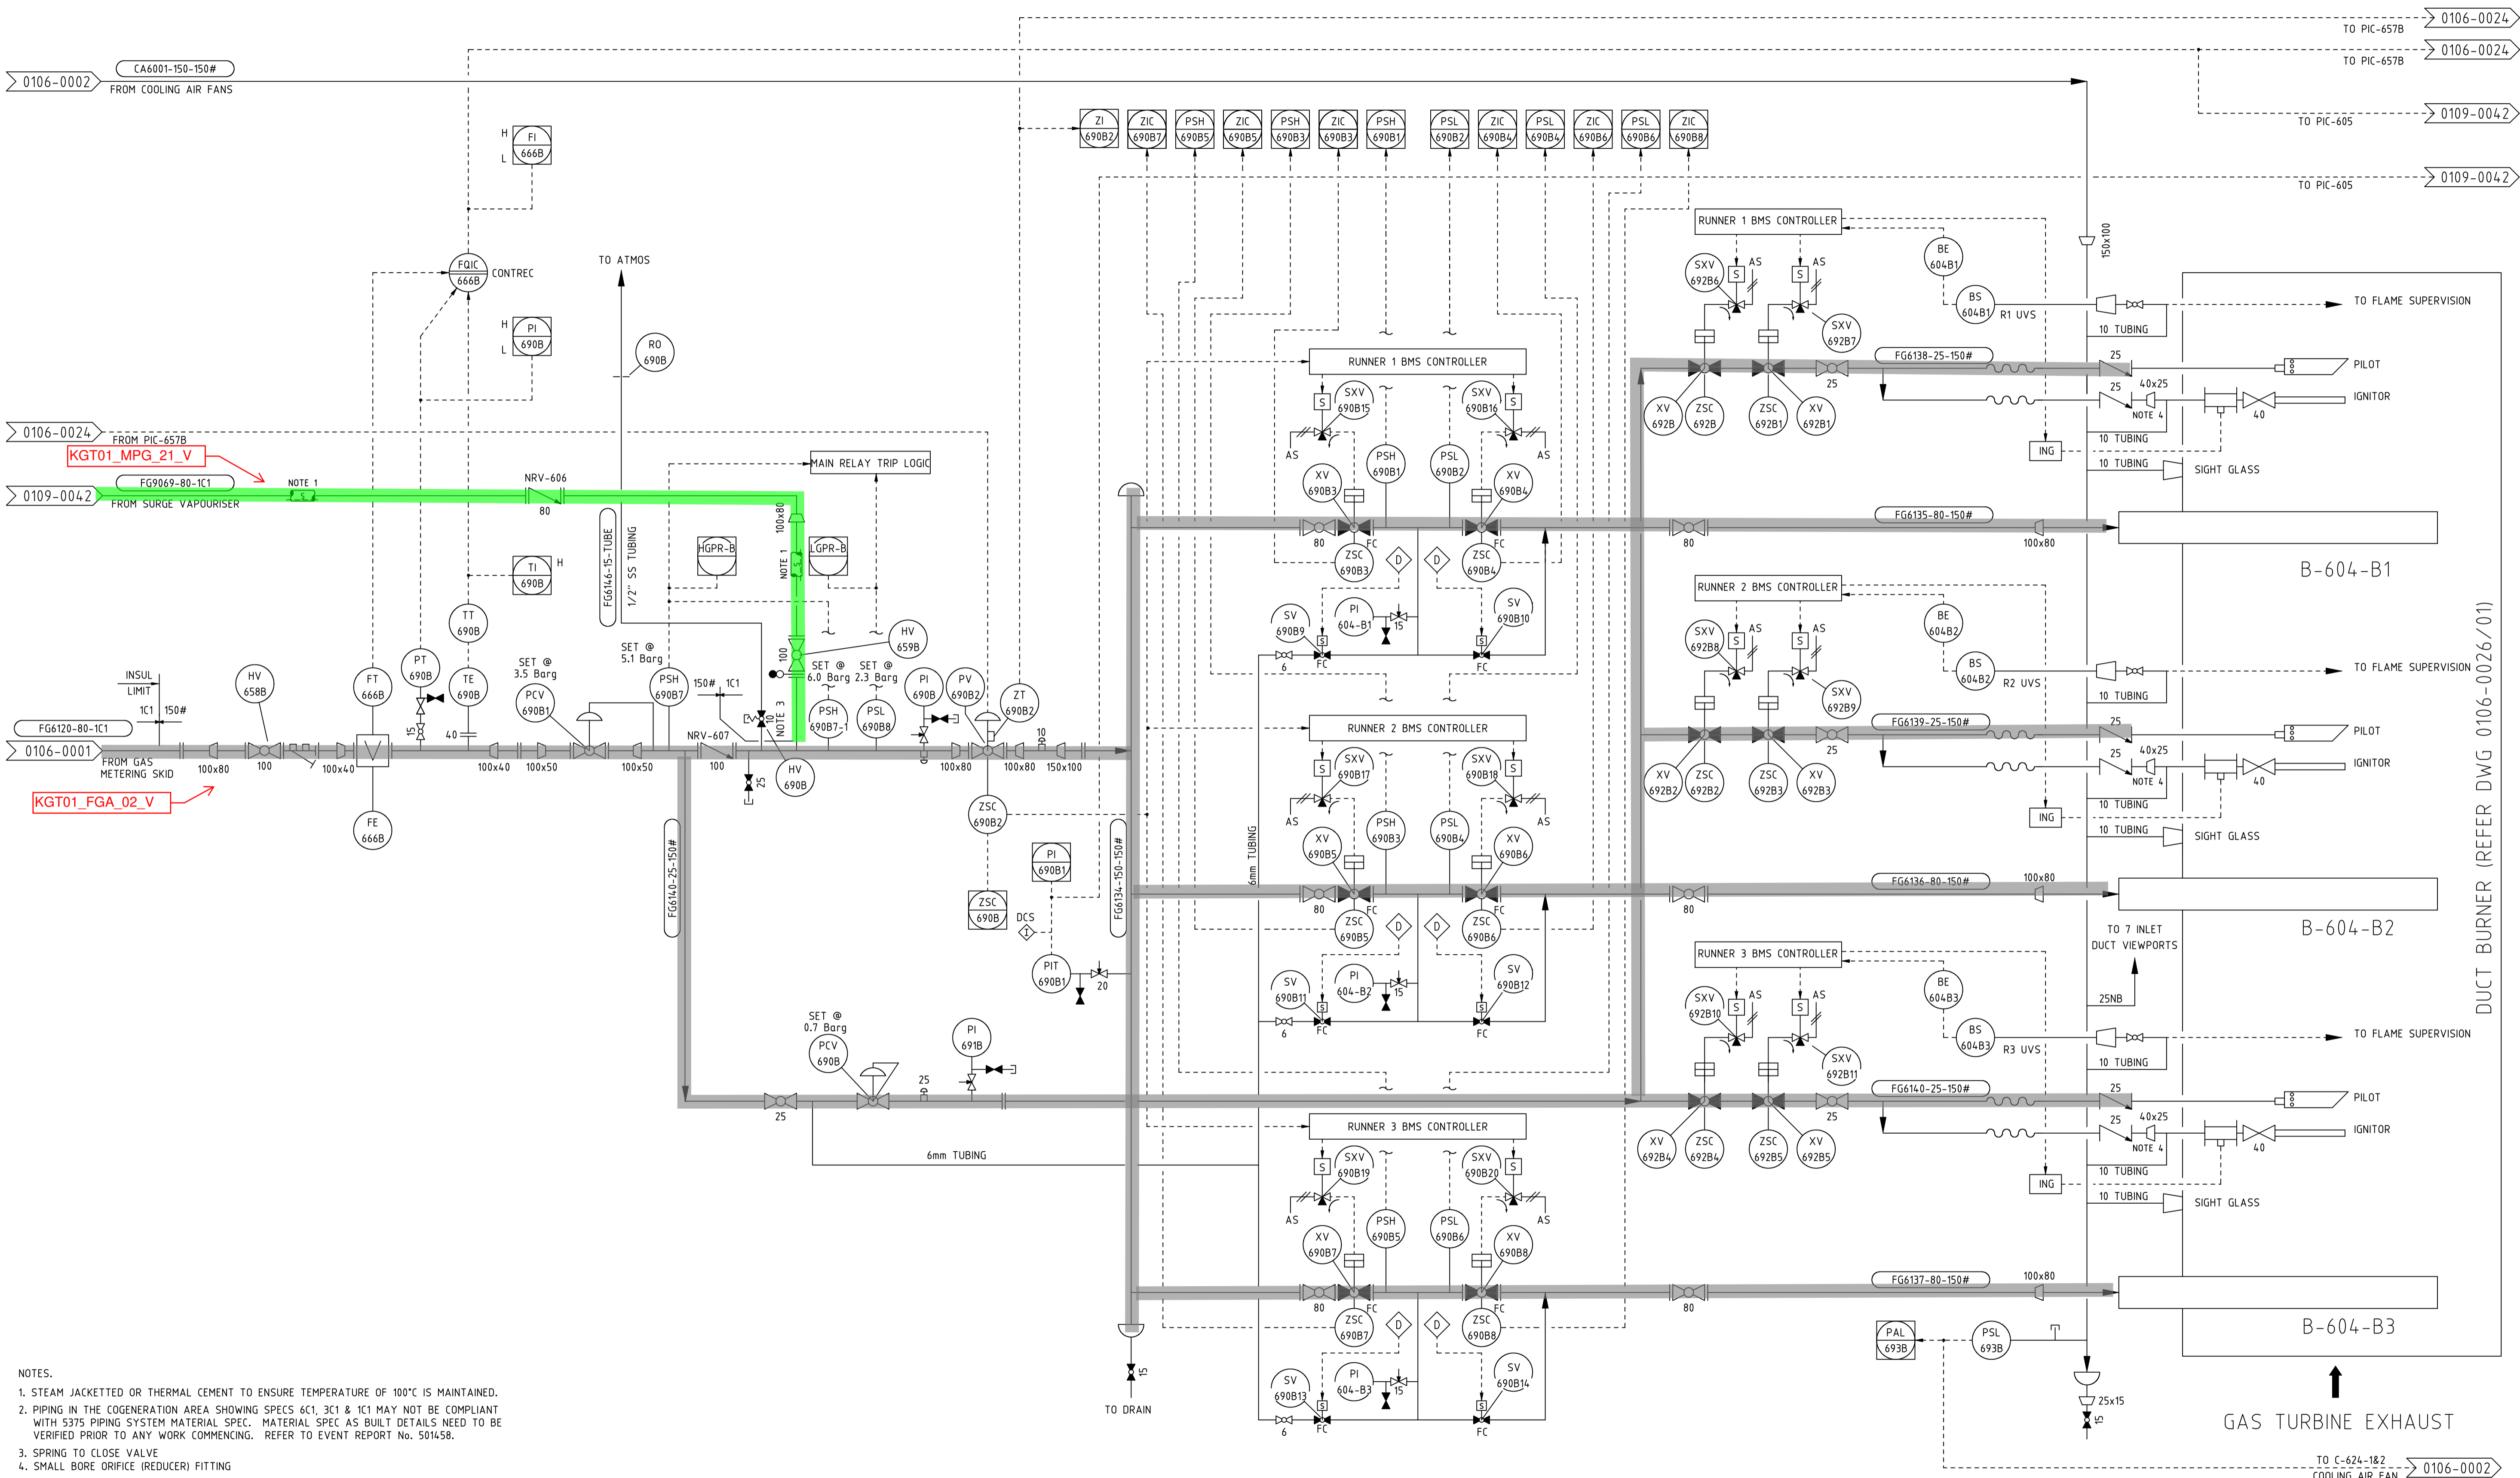

- NOTES.
1. STEAM JACKETED OR THERMAL CEMENT TO ENSURE TEMPERATURE OF 100°C IS MAINTAINED.
 2. PIPING IN THE COGENERATION AREA SHOWING SPECS 6C1, 3C1 & 1C1 MAY NOT BE COMPLIANT WITH 5375 PIPING SYSTEM MATERIAL SPEC. MATERIAL SPEC AS BUILT DETAILS NEED TO BE VERIFIED PRIOR TO ANY WORK COMMENCING. REFER TO EVENT REPORT No. 501458.
 3. SPRING TO CLOSE VALVE
 4. SMALL BORE ORIFICE (REDUCER) FITTING

REV	AMENDMENT	BY	CHK	ENG	APP	DATE	REV	AMENDMENT	BY	CHK	ENG	APP	DATE
13	AS BUILT - NOTE 4 SMALL BORE ORIFICE REDUCER	JCC	RL/TW	AM	SES	11/2016	3	PI-690B SIGNAL CORRECTED FROM TT-690B TO PT-690B	VB	RL	EJH	RS	10/99
12	HAND VALVE NUMBERS ADDED FOR ISOLATIONS	RL	CR	AM	SES	08/2013	2	AS BUILT COMMENTS INCORPORATED	VB	RL	EJH	RS	06/99
11	AS BUILT P84-1061 VENT LINE	LN	RL	AM	SES	04/2013	1	REDRAWN ON CAD FROM SENIOR DRAWING	VB	RL	EJH	RS	11/98

10	P84-1061 HRSG PLC UPGRADE - PARTIAL AS BUILT	LN	CJ	AM	SES	07/2012							
9	AS BUILT P84-1152 PI-604-B1, B2 AND B3 ADDED	RL	WB	LH	SES	08/2010							
8	NOTE 2 ADDED RE INCIDENT REPORT NUMBER 501458	RL	SR	LH	PJR	01/2007							
7	AS BUILT - GAS PRESSURE SWITCH MODES	ES	AAB	LH	PJR	11/05							
6	EQUIP. No. FOR HRSG MOVED TO 0106-0026/01	PL	RL	DT	PJR	06/03							
5	PROCESS ISOLATION POINTS ADDED ON INDIVIDUAL LAYERS	CMW	RL	CM	AIM	10/02							
4	WS184313 SURGE VAPOURISER TO COGEN FUEL AS BUILT	JBH	RL	AVG	AIM	06/08/02							

VECTOR LIMITED
PRIVATE BAG 2020
NEW PLYMOUTH 4620
PHONE 0800 734 567

COPYRIGHT The copyright in this document is vested in Vector Limited
The contents of this document shall not be reproduced, either in whole or part, by any means whatsoever without the prior written consent of Vector Limited.

AUTOCAD ORIGINAL SHEET SIZE A1

REFERENCE DRAWINGS
SENIOR DRAWING 4344 B1 TC

DRN	DATE	ENG	APP	DATE
V BRENNAN	19/11/1998	E J HURLEY		14/05/1999
R LOCHHEAD	14/04/1999	R SUMBALY		14/05/1999


COGENERATION AREA
PIPING & INSTRUMENT DIAGRAM
DUCT BURNERS FOR HRSG 'B'

SCALE: NTS

JOB NO.	SERIES	DRG. NO	SHT	REVISION
1000000	0106	0003	01 OF 01 SHTS	13

1000000-0106-0003-01.dwg

DUCT BURNER (REFER DWG 0106-0026/01)

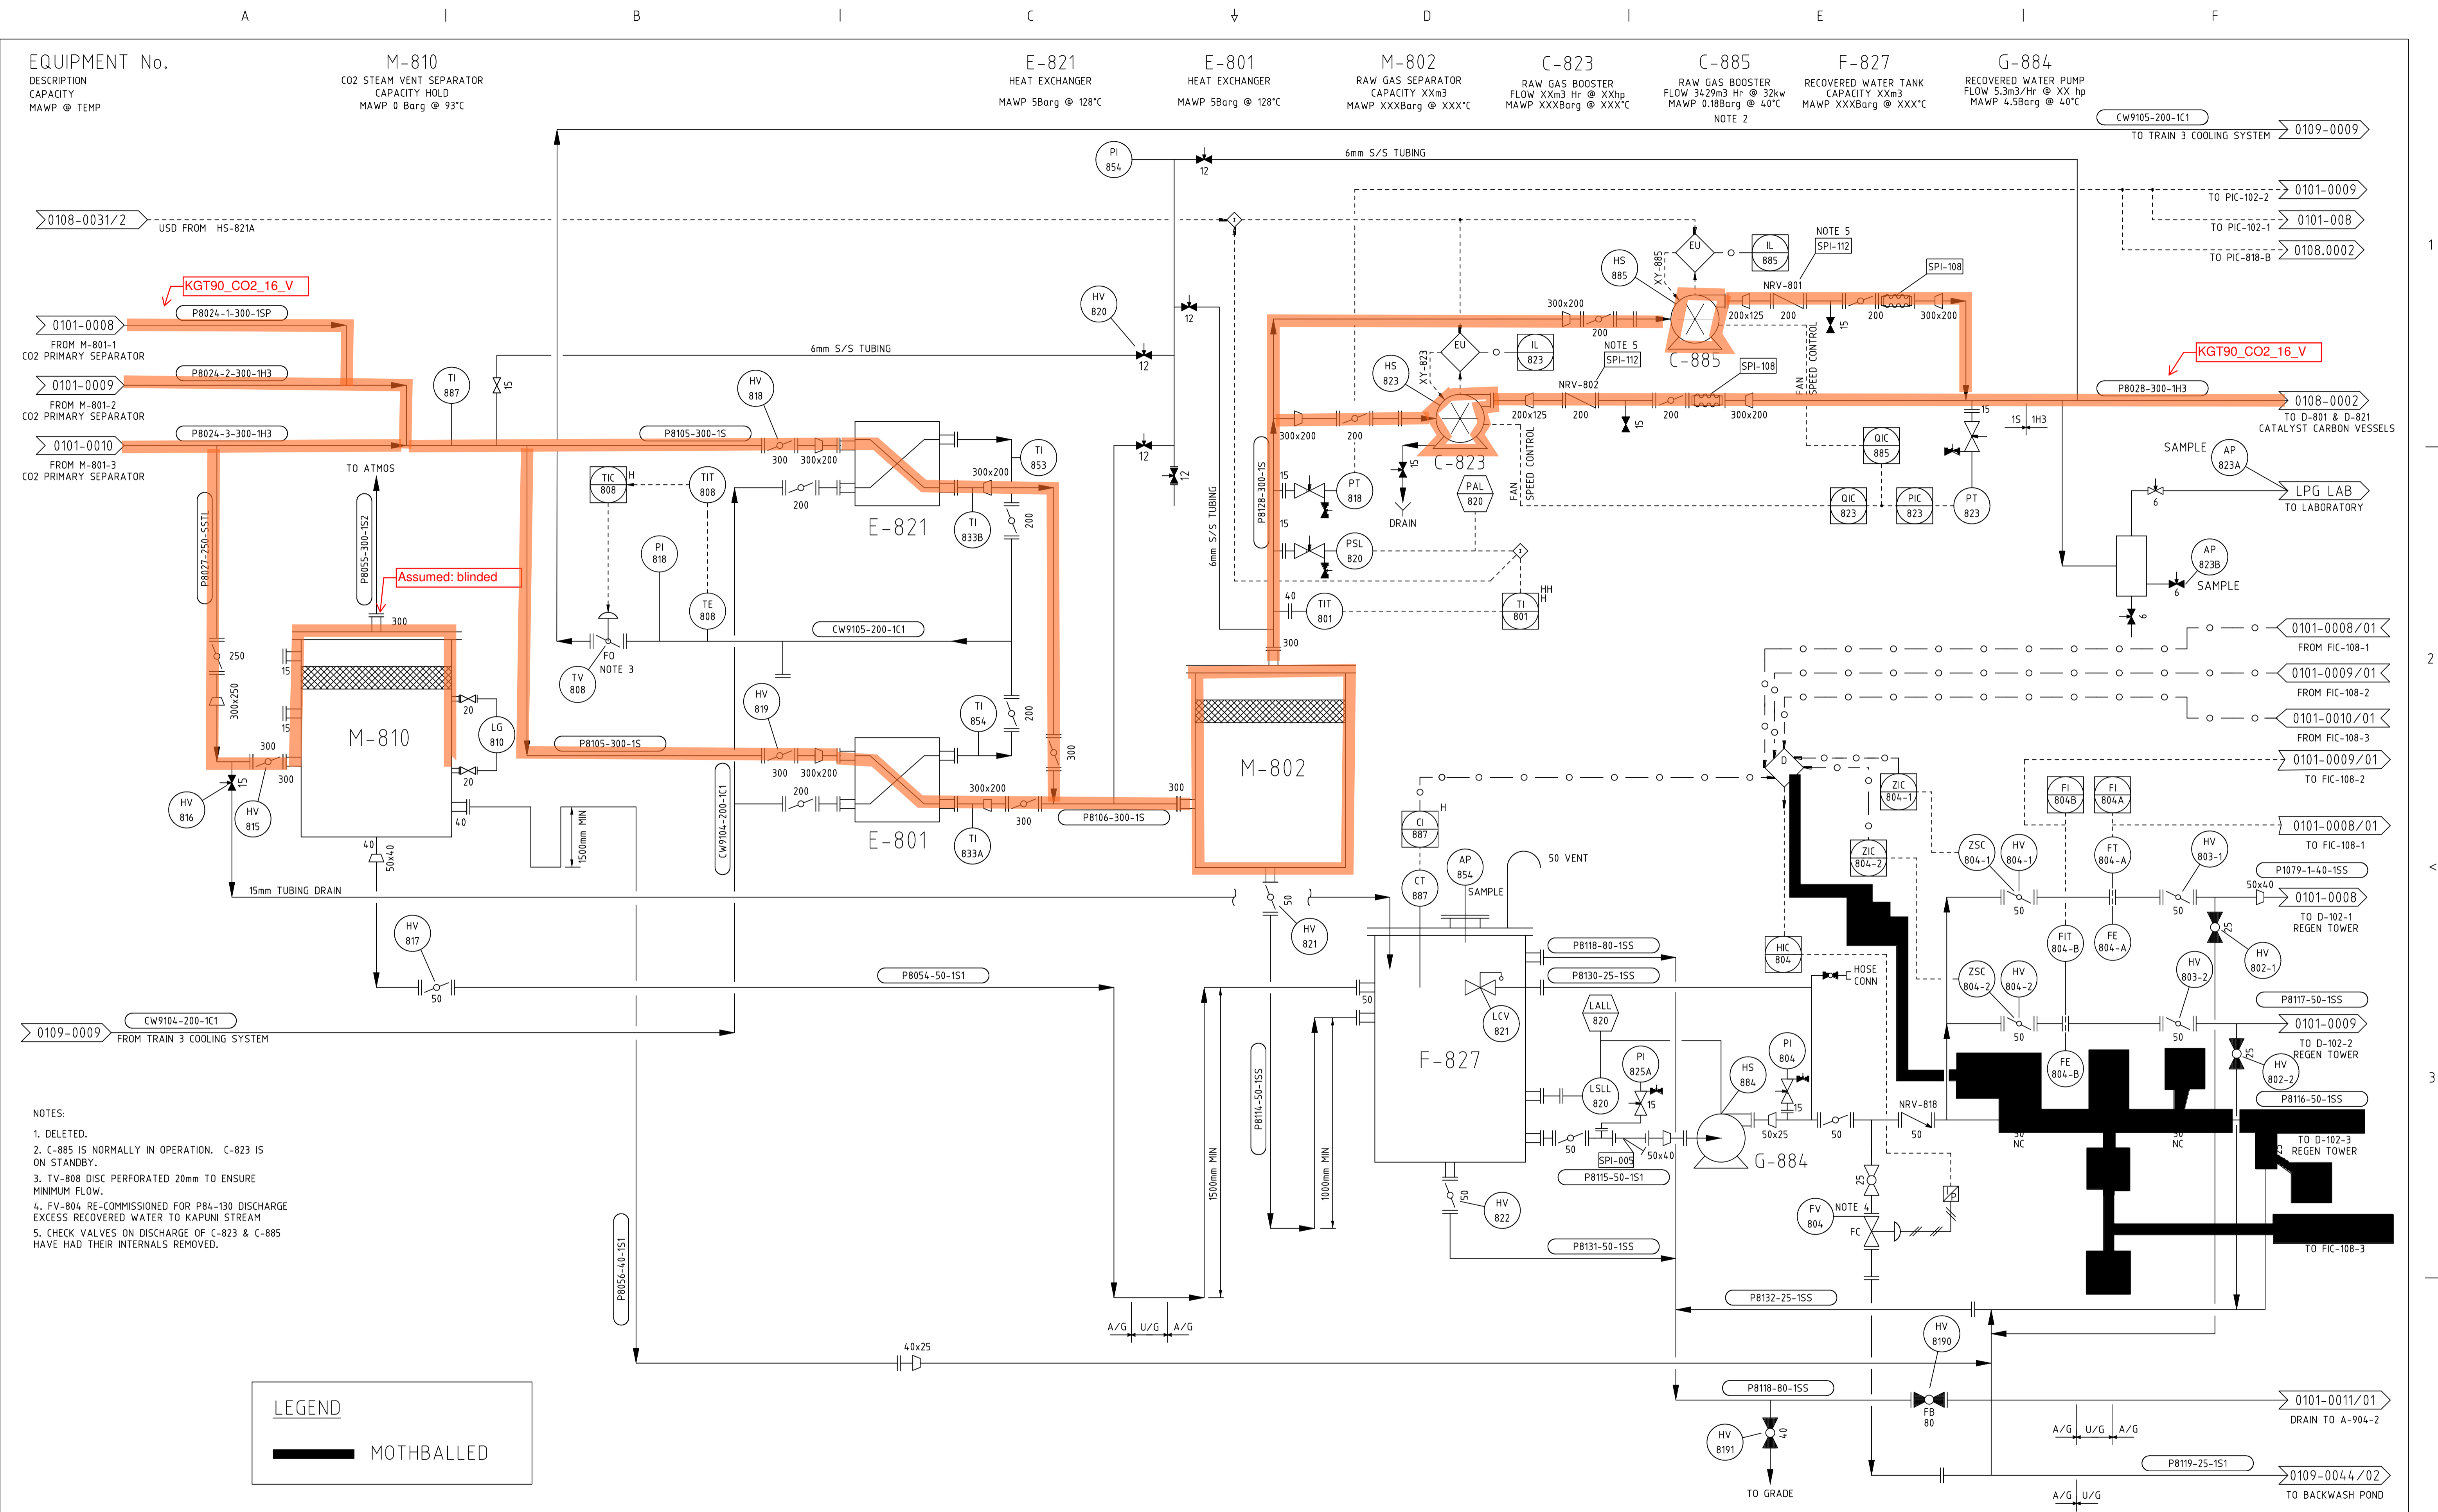

REV	DESCRIPTION	BY	CHK	ENG	APP	DATE	REV	DESCRIPTION	BY	CHK	ENG	APP	DATE
26	AS BUILT W51236269 CTRL RECOVERED WATER TO REGENS	ES	TC	LH	PJR	01/07	36	AS BUILT P84-1367 MOTHBALL BENFIELD TRAIN 3	JB	CJ	AM	TC	09/2019
25	AS BUILT TRAIN 1, 2, 3 WASH WATER W5993196	ES	RL	LH	ST	12/06	35	AS BUILT P84-1142 PV-102-3 REMOVED, ADDED NRV NUMBERS	JCC	RL/TC	AM	SES	05/2015
24	AS BUILT W51043230 CATT VENT & W5112602 RECOV WTR	RL	ES	LH	ST	04/06	34	HAND VALVE NUMBERS ADDED FOR ISOLATIONS	RL	CR	AM	SES	16/2013
23	AS BUILT FOR W5884521 CO2 UPGRADE PCN004	WXB	CL	MP	LH	02/06	33	HAND VALVE NUMBERS FOR G-884 DISCHARGE RE-ASSIGNED	RL	AC	AM	SES	12/2012
22	AS BUILT FOR W5884521 CO2 UPGRADE	JMP	VB	MP	CF	09/05	32	AS BUILT P84-130 DISCH EXCESS RECOVERED WATER TO STREAM	LN	CJ	AM	SES	11/2012
21	AS BUILT FOR PEP PROJECT	RL	RH	CP/LH	PJR	02/2004	31	P84-130 DEMOLITION AS BUILT	CJ	JG	AM	SES	06/2012
							30	HAND VALVE NUMBERS ADDED FOR ISOLATIONS	RL/ES	CR	AM	SES	06/2012
							29	INCIDENT 511093. CHECK VALVE INTERNALS AS NOTE 5	RL/ES	CA	LH	SES	11/2010
38	AS BUILT P84-1418 INSTRUMENTS & SITE AS BUILDING MODS	RL	JC/MM	AM	TC	11/2019	28	TAG NOS. MODIFIED	ES	CB/RL	LH	SES	07/08
37	AS BUILT P84-1418 DISCHARGE RECOVERED WATER TO RIVER	RL	JC/MM	AM	TC	10/2019	27	VALVES SWAPPED-LINE P8119-25-1S1, PI-818 ADDED	ES	RL	LH	SES	01/08
	AMENDMENT	BY	CHK	ENG	APP	DATE	REV	AMENDMENT	BY	CHK	ENG	APP	DATE

EQUIPMENT No.
DESCRIPTION
CAPACITY
MAWP @ TEMP


F-804
SEAL POT
CAPACITY XXm³
MAWP XXXBarg @ XXX°C

D-821
CATALYST CARBON VESSEL
CAPACITY 7.955 m³
0.345 Barg @ 60°C

F-825
SEAL POT
CAPACITY 0.15m³
MAWP 0.0Barg @ 60°C

D-801
CATALYST CARBON VESSEL
CAPACITY XXm³
MAWP XXXBarg @ XXX°C

F-805
SEAL POT
CAPACITY XXm³
MAWP XXXBarg @ XXX°C

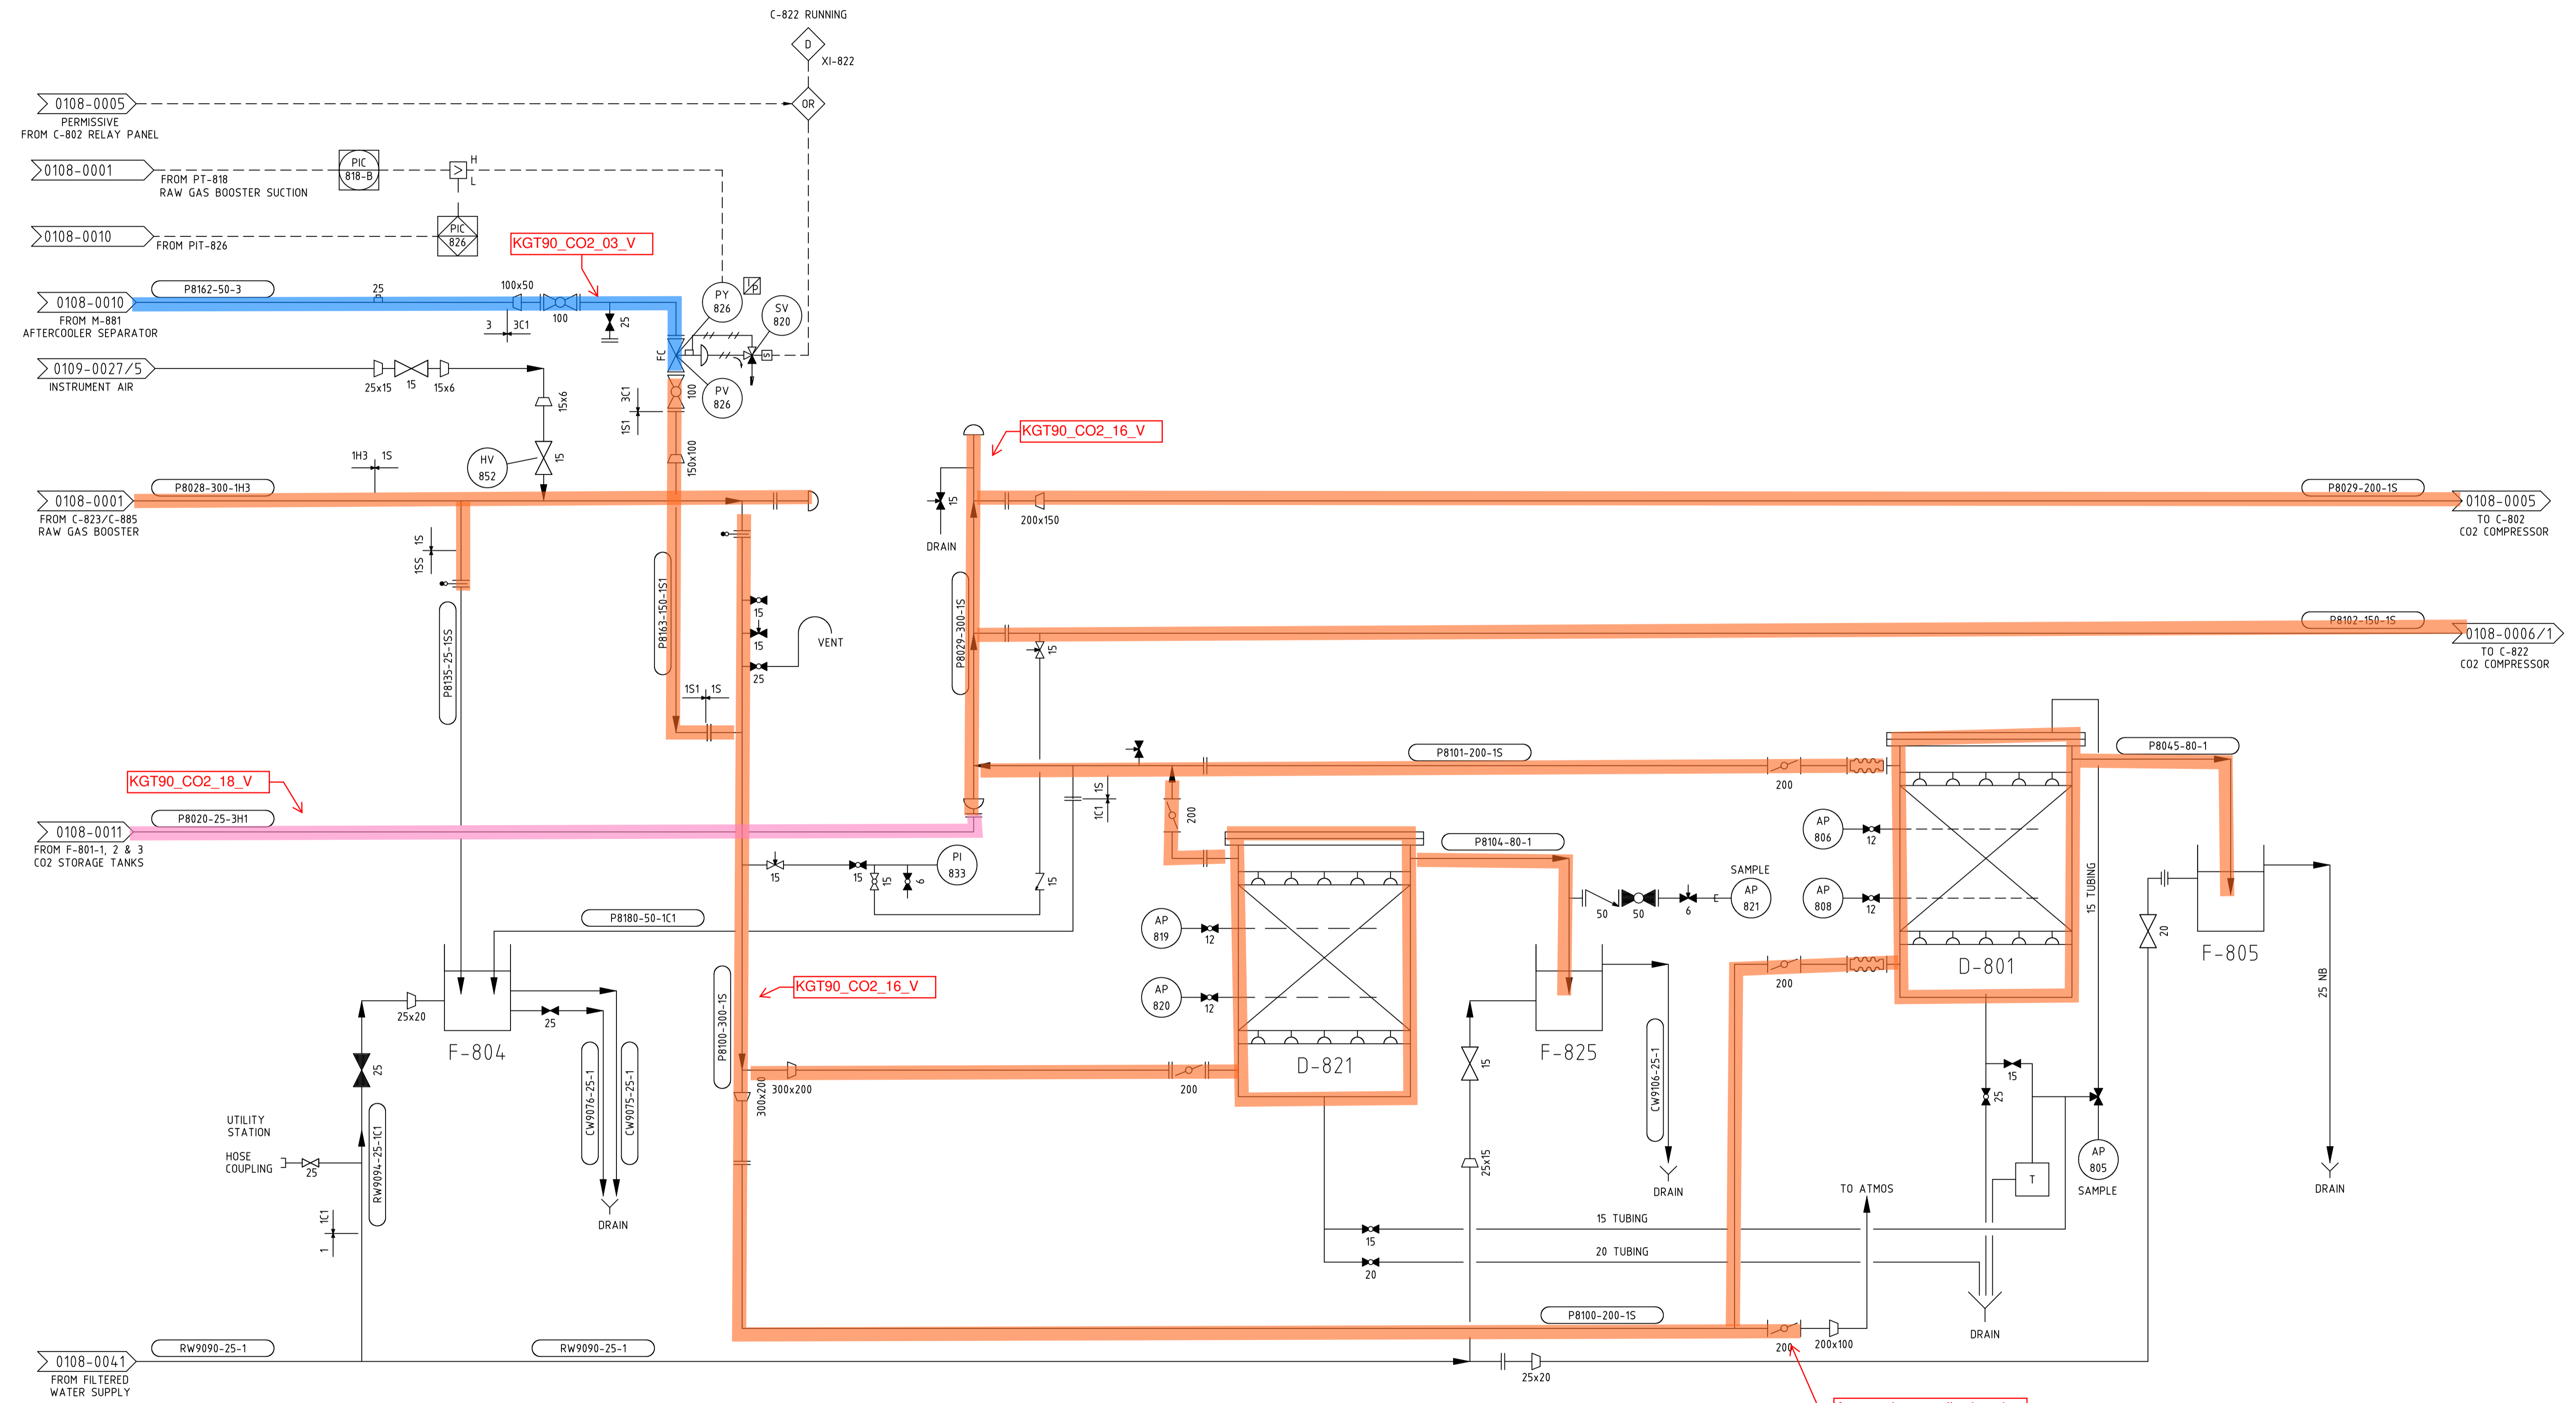

REV	AMENDMENT	BY	CHK	ENG	APP	DATE	REV	AMENDMENT	BY	CHK	ENG	APP	DATE
11	PROCESS ISOLATION POINTS ADDED ON INDIVIDUAL LAYERS	CMW	RL	CM	AIM	10/02							
10	D-821 DESIGN DATA RATIONALISED	JBH	RL	AvG	AIM	08/02							
9	SAFETY SHOWER REMOVED, GARDEN HOSE ADDED	VB	RL	EJH	RS	10/99							
8	DWG No. WAS 0108-0025/01 & SAMPLE POINTS ADDED	GMF	RL	EJH	RS	10/98							
7	AS BUILT FOR NEW S.S. CO2 SUCTION LINES	J.B.H.	R.L.	AvG	A.M.B.	20/08/96							
6	SV-826 NOW SV-820	J.B.H.	R.L.	AvG	J.B.G.	10/95							
5	AS BUILT COMMENTS INCORPORATED	V.B.	B.T.	A.V.G.	C.J.	5/95							
4	REVISED FOR CONTINUITY CHECK	J.B.H.	O.G.M.	A.V.G.	C.J.	10/94							
3	AS BUILT, SAFETY SHOWER ADDED	P.T.D.	P.M.	D.T.	A.V.G.	09/94							
2	AS BUILT USING PID VERSION 11.52	B.A.T.	J.S.T.	T.H.	J.R.S.	04/94							

VECTOR KAPUNI LIMITED
PRIVATE BAG 2020
NEW PLYMOUTH 4342
PHONE 0800 734 567

COPYRIGHT The copyright in this document is vested in Vector Kapuni Limited
The contents of this document shall not be reproduced, either in whole or part, by any
means whatsoever without the prior written consent of Vector Kapuni Limited.

DRN	P.MILLS	28/04/1980	ENG	DATE
CHK	R.LOGAN	28/04/1980	APP <td>DATE</td>	DATE

SCALE:	JOB NO.	SERIES	DRG. NO	SHT 01 OF 01 SHTS	REVISION
N/A	1000000	0108	0002	01	17

EQUIPMENT No.
DESCRIPTION
CAPACITY
MAWP @ TEMP


E-807
INTERCOOLER
XXm³
XXXBarg @ XXX°C

C-802
CO₂ COMPRESSOR
XXm³
XXXBarg @ XX°C

F-806
PULSATION VESSEL
295mm ID
17Barg @ 200°C


M-830
INTERSTAGE SEPARATOR
CAPACITY 31.2 litres
MAWP 4.5 Barg @ 100°C

CE-802
CO₂ COMPRESSOR MOTOR

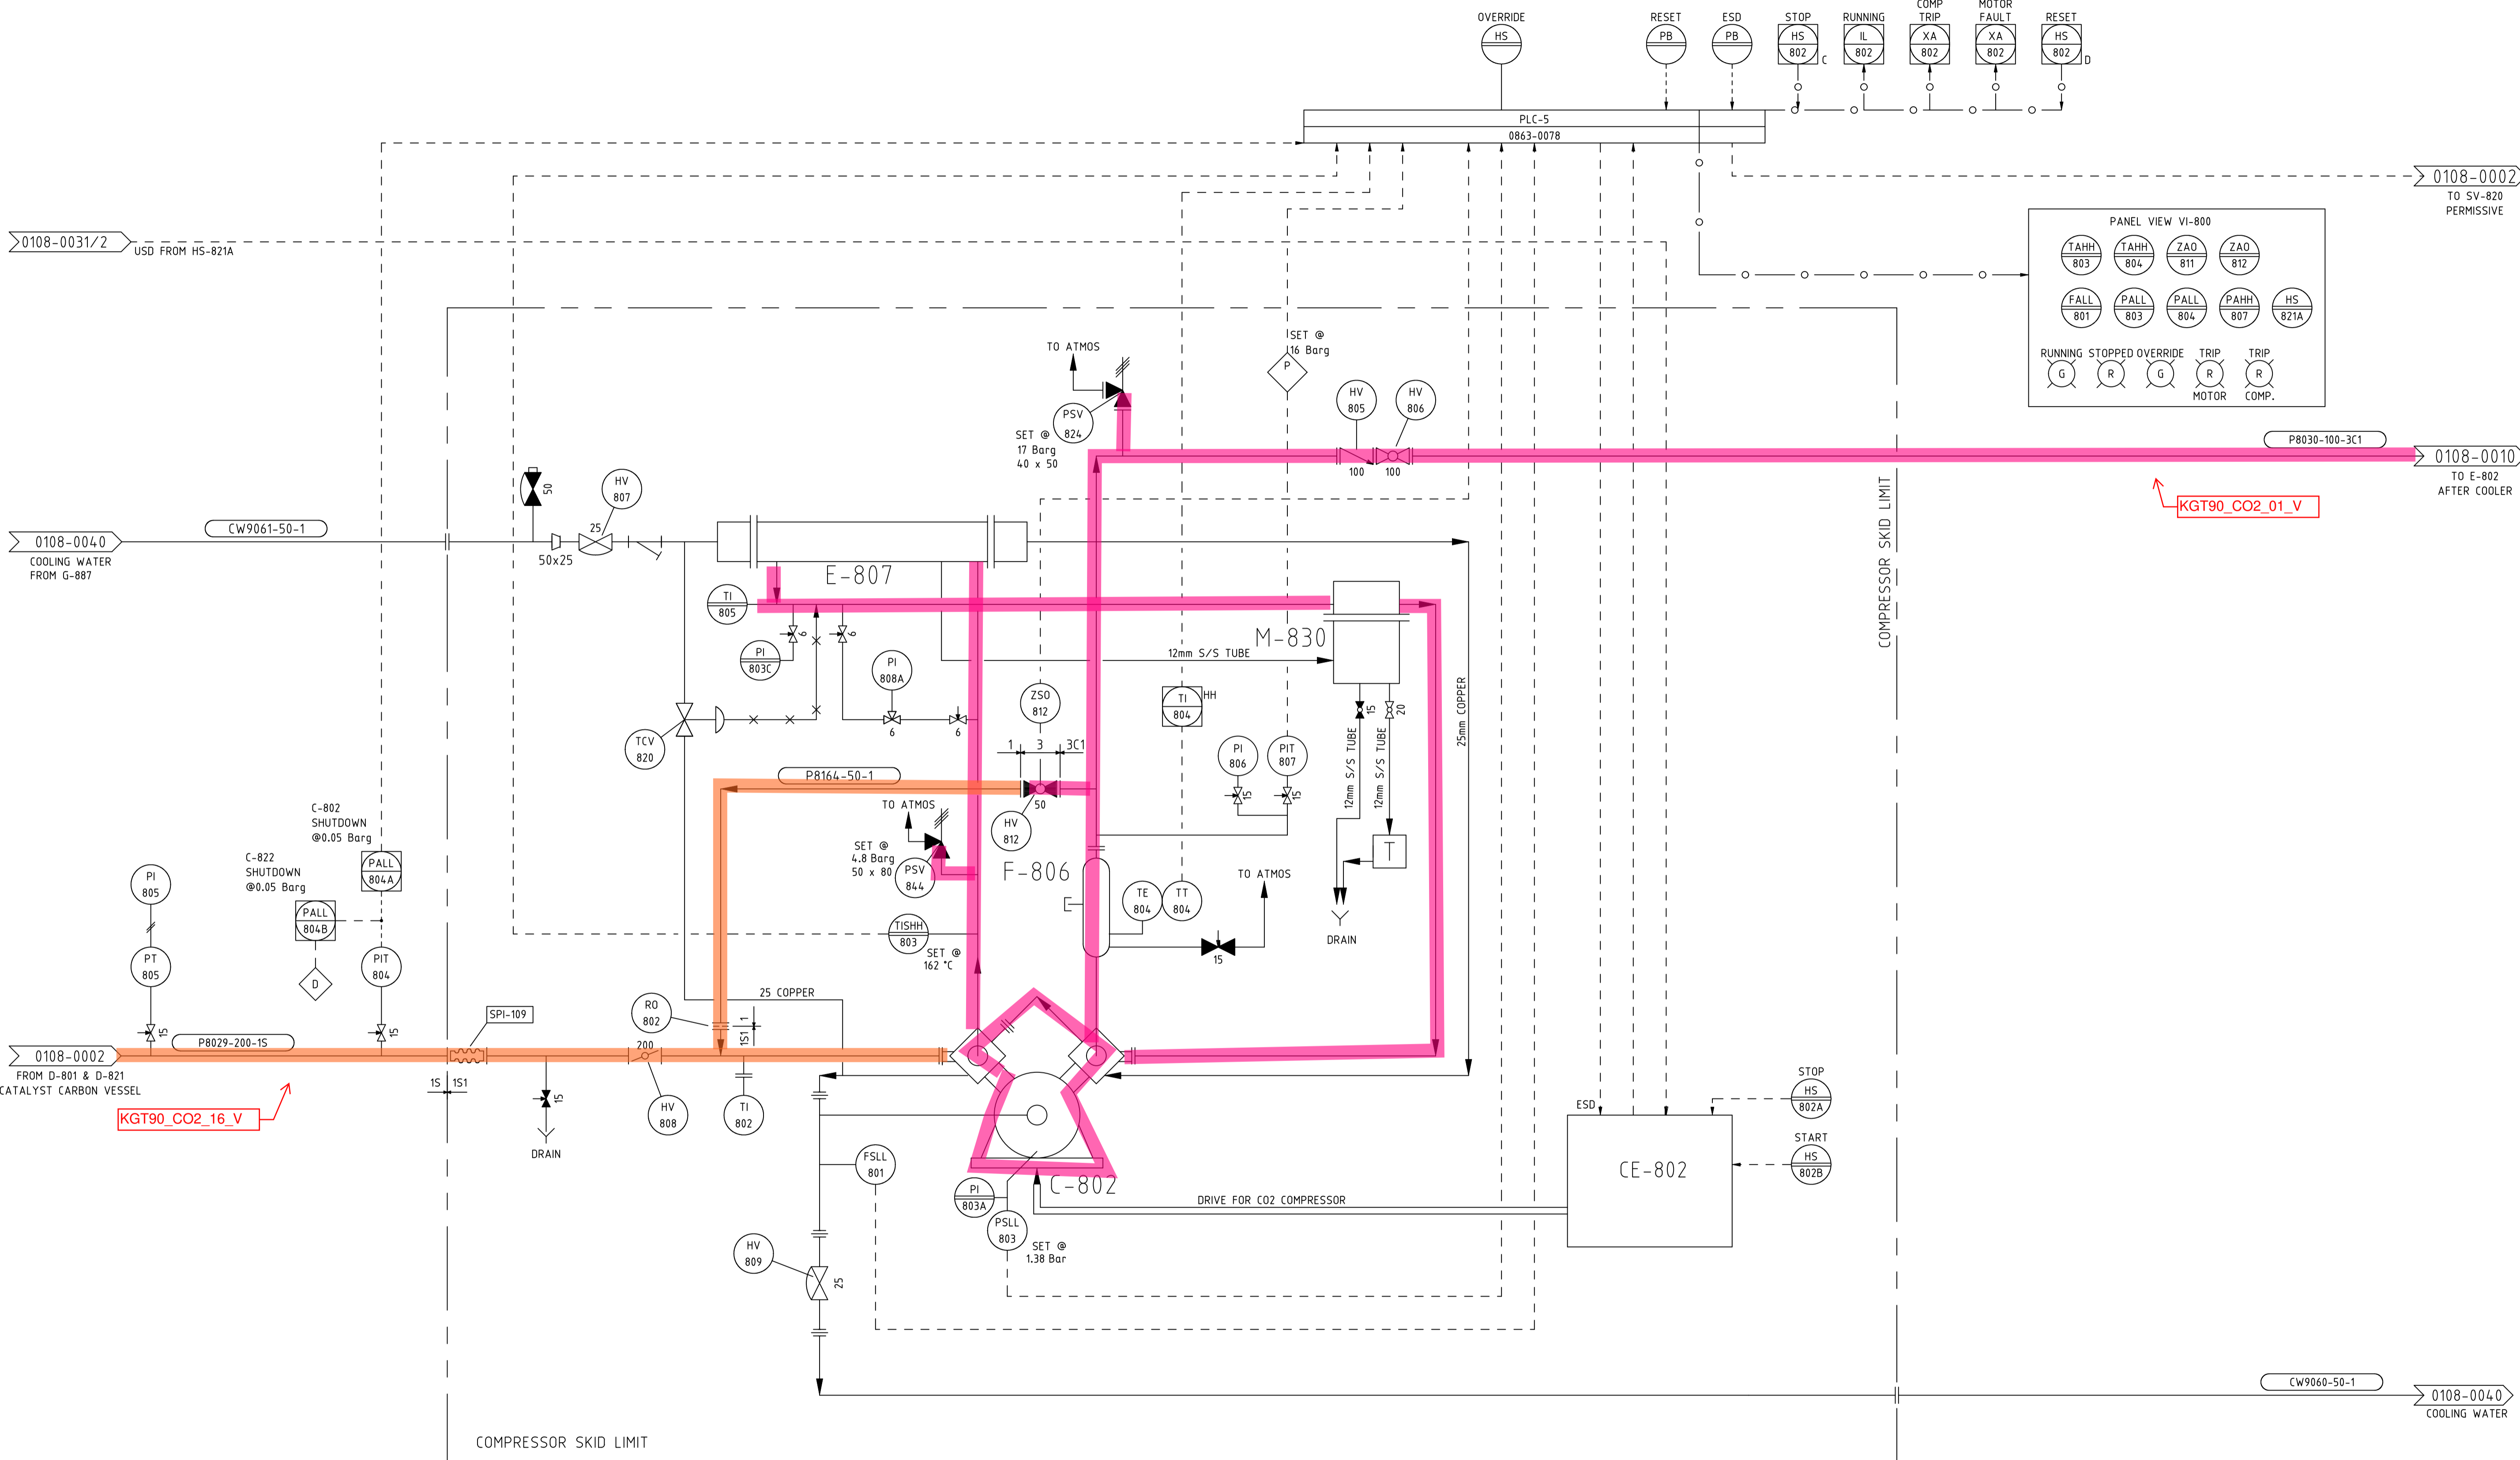

REV	AMENDMENT	BY	CHK	ENG	APP	DATE	REV	AMENDMENT	BY	CHK	ENG	APP	DATE
23	AS BUILT P84-1555 PI-806 MOVED & NEEDLE VALVES ADDED	RL	JCC	AM	TC	09/2019	14	AS BUILT FOR W5884521 CO2 UPGRADE	JMP	VB	MP	CF	09/05
22	AS BUILT P84-860 CO2 PLANT CONTROL UPGRADE	WPG	SHA	AM	SES	08/2017	12	PROCESS ISOLATION POINTS ADDED ON INDIVIDUAL LAYERS	CMW	RL	CM	AIM	10/02
21	AS BUILT M-830 ADDED	RL	JCC	AM	SES	05/2017	11	PI-805 TAG REMOVED, PSV-844 NOW 3.8 BARG	VB	RL	EJH	RS	10/99
20	AS BUILT PI-808-A, HV-812, REMO ZSO-811	JCC	RL	AM	SES	01/2016	10	DRG No. WAS 0108-0002/01 & RO-802, AP-802 ADDED	GMF	DV	EJH	HG	10/98
19	PALL 804A & B SETPOINT CORRECTED	JCC	RL	AM	SES	10/2015	9	REVISED FOLLOWING I&E MAINTENANCE SURVEY	J.B.H.	R.L.	AvG	A.M.B.	08/08/96
18	AS BUILT P84-846 REPLACE C-822 MICROGUARD PLC	RL/ES	AB	AM	SES	10/2013	8	AS BUILT DISCHARGE LINE	P.T.D.	R.L.	A.V.G.	J.B.G.	08/95
17	HAND VALVE NUMBERS ADDED FOR ISOLATIONS	RL/ES	CR	AM	SES	04/2013	7	AS BUILT COMMENTS INCORPORATED	V.B.	B.T.	A.V.G.	C.J.	5/95
16	AS BUILT TIE IN POINT FOR ZSO-811 RELOCATED	RL/ES	CR	AM	SES	08/2012	6	REVISED FOR CONTINUITY CHECK	J.B.H.	O.G.M.	A.V.G.	C.J.	10/94
15	AS BUILT P84-3263, PSV-844 REPLACEMENT	RL/ES	AM	SRH	SES	02/2012	5	NOTE AND TIS-818 ADDED ON CE-802	P.T.D.	P.M.	D.T.	A.V.G.	09/94
								AS BUILT USING PID VERSION 11.52	B.A.T.	J.S.T.	T.H.	J.R.S.	04/94

VECTOR KAPUNI LIMITED
PRIVATE BAG 2020
NEW PLYMOUTH 4342
PHONE 0800 734 567

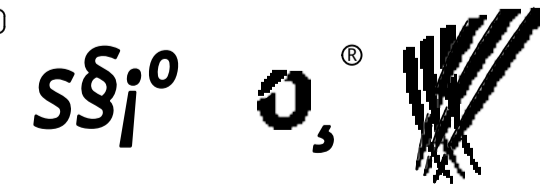

COPYRIGHT The copyright in this document is vested in Vector Kapuni Limited
The contents of this document shall not be reproduced, either in whole or part, by any
means whatsoever without the prior written consent of Vector Kapuni Limited.

REFERENCE DRAWINGS
CAUSE & EFFECTS - 0780-0090/2
DRAWING NUMBER WAS 0108-0002/01

DRN	P.MILLS	29/08/1980	ENG		DATE
CHK	R.LOGAN	29/08/1980	APP		DATE

CO₂ RECOVERY
PIPING & INSTRUMENTATION DIAGRAM
CO₂ COMPRESSION TRAIN A C-802 AND CE-802

SCALE:	JOB NO.	SERIES	DRG. NO	SHT 01	REVISION
NTS	1000000	0108	0005	01 OF 01 SHTS	23

EQUIPMENT No.


DESCRIPTION
CAPACITY
MAWP @ TEMP

E-827
INTERCOOLER
CAPACITY XXm³
MAWP XXXBarg @ XXX°C

C-822
CO₂ COMPRESSOR
CAPACITY XXm³
MAWP XXXBarg @ XXX°C

M-829
INTERSTAGE SEPARATOR
CAPACITY XXm³
MAWP 4.50 Barg @ 100/XX°C

F-826
PULSATION VESSEL
CAPACITY 0.034m³
MAWP 26.0Barg @ -10/200°C

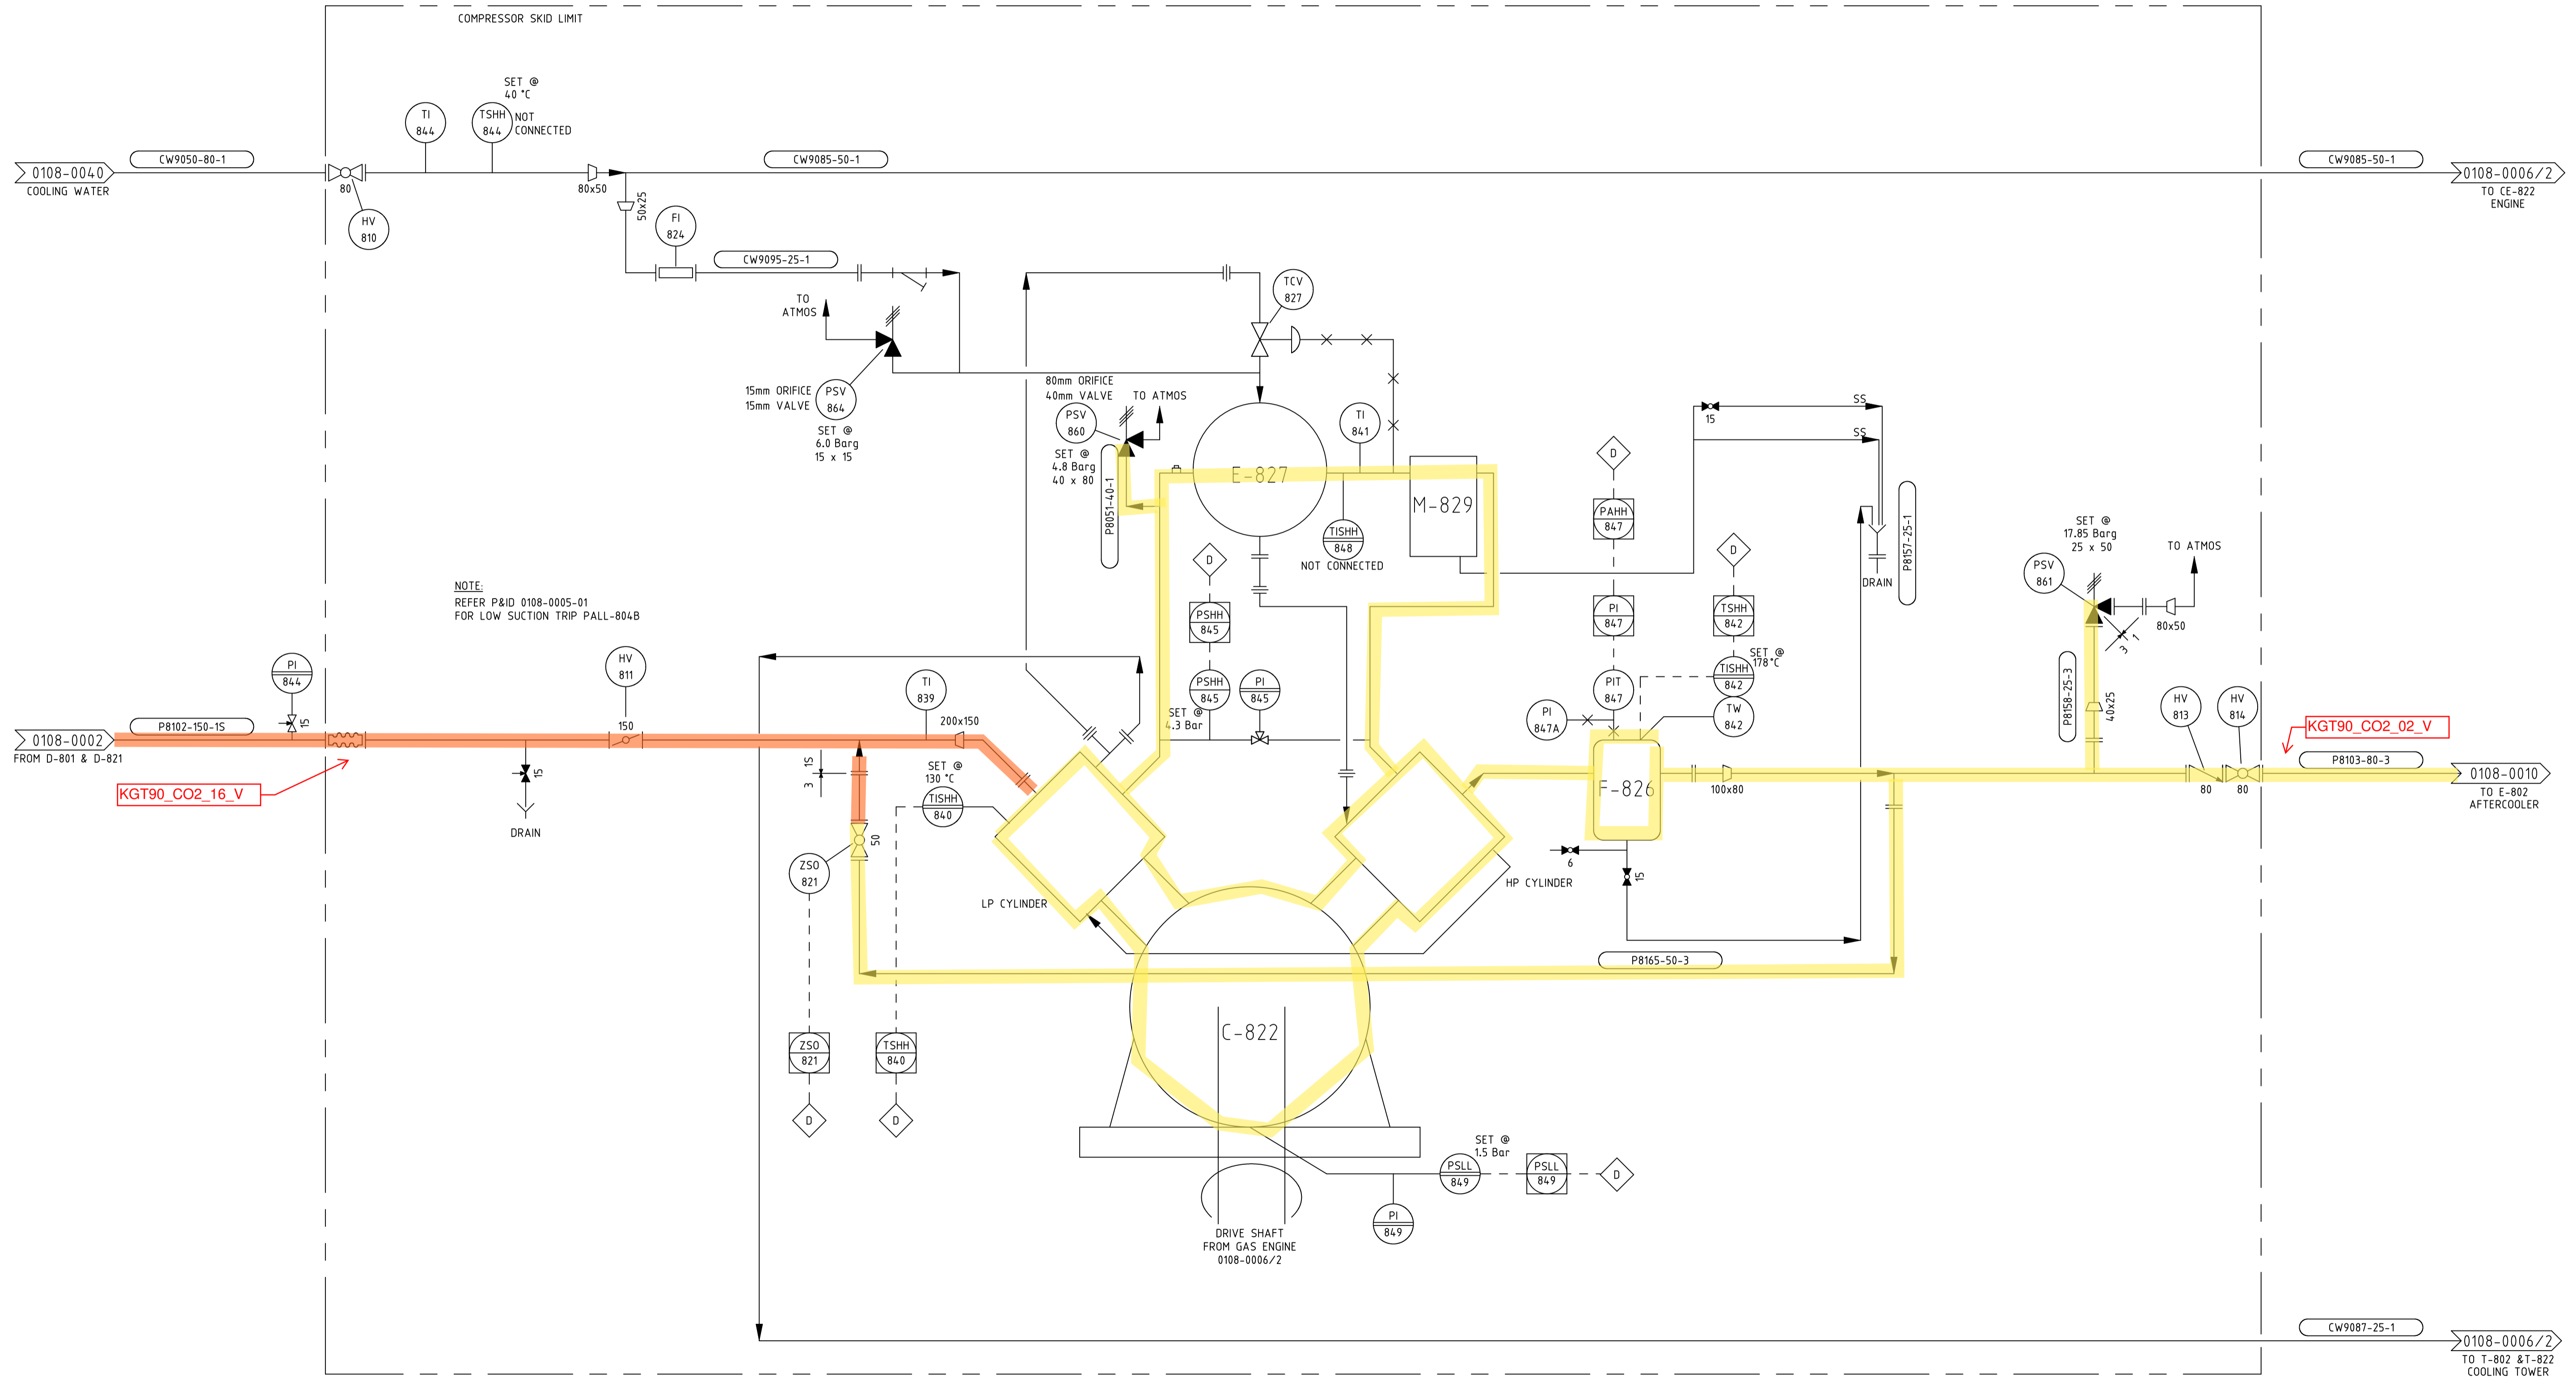

NOTE:
REFER P&ID 0108-0005-01
FOR LOW SUCTION TRIP PALL-804B

REV	AMENDMENT	BY	CHK	ENG	APP	DATE	REV	AMENDMENT	BY	CHK	ENG	APP	DATE
9	AS BUILT FOR W5884521 CO2 UPGRADE PCN006	PJ	WXB	MP	CF	01/06							
8	PROCESS ISOLATION POINTS ADDED ON INDIVIDUAL LAYERS	CMW	RL	CM	AIM	10/02							
7	DESIGN DATA RATIONALISED FOR M-829 & F-826	CMW	RL	AvG	AIM	08/02							
6	INLET AND OUTLET SIZE ADDED TO PSV-861	VB	RL	EJH	RJW	02/01							
5	PI-847B ADDED	VB	RL	EJH	RS	10/99							
4	DRAWING NUMBER WAS 0108-0033/01	GMF	DV	EJH	MB	10/98							
3	REVISED FOLLOWING I&E MAINTENANCE SURVEY	J.B.H.	R.L.	AvG	A.M.B.	21/08/96							
2	AS BUILT COMMENTS INCORPORATED	V.B.	B.T.	A.V.G.	C.J.	5/95							
1	REVISED FOR CONTINUITY CHECK	J.B.H.	O.G.M.	A.V.G.	C.J.	10/94							
10	PSV-864 & PSV-861 SET PRESSURE AND SIZES AS BUILT AS BUILT USING PID VERSION 11.52	B.A.T.	P.H.	J.R.	J.R.S.	04/94							

VECTOR KAPUNI LIMITED
PRIVATE BAG 2020
NEW PLYMOUTH 4342
PHONE 0800 734 567

COPYRIGHT The copyright in this document is vested in Vector Kapuni Limited
The contents of this document shall not be reproduced, either in whole or part, by any
means whatsoever without the prior written consent of Vector Kapuni Limited.


DRN	J.HAYCOCK	01/05/1992	ENG		DATE	DATE
CHK			APP			

SCALE:	JOB NO.	SERIES	DRG. NO	SHT 01 OF 02 SHTS	REVISION
NTS	1000000	0108	0006		15

EQUIPMENT No. F-829
 DESCRIPTION LUBE OIL HEADER TANK
 CAPACITY 4 x 140 LITRE
 MAWP @ TEMP ATMOSPHERE

X-822-E1
 AUXILIARY COOLER
 CAPACITY XXm3
 MAWP XXXBarG @ XXX°C

CF-822
 CO2 COMPRESSOR ENGINE
 CAPACITY XXm3
 MAWP XXXBarG @ XXX°C

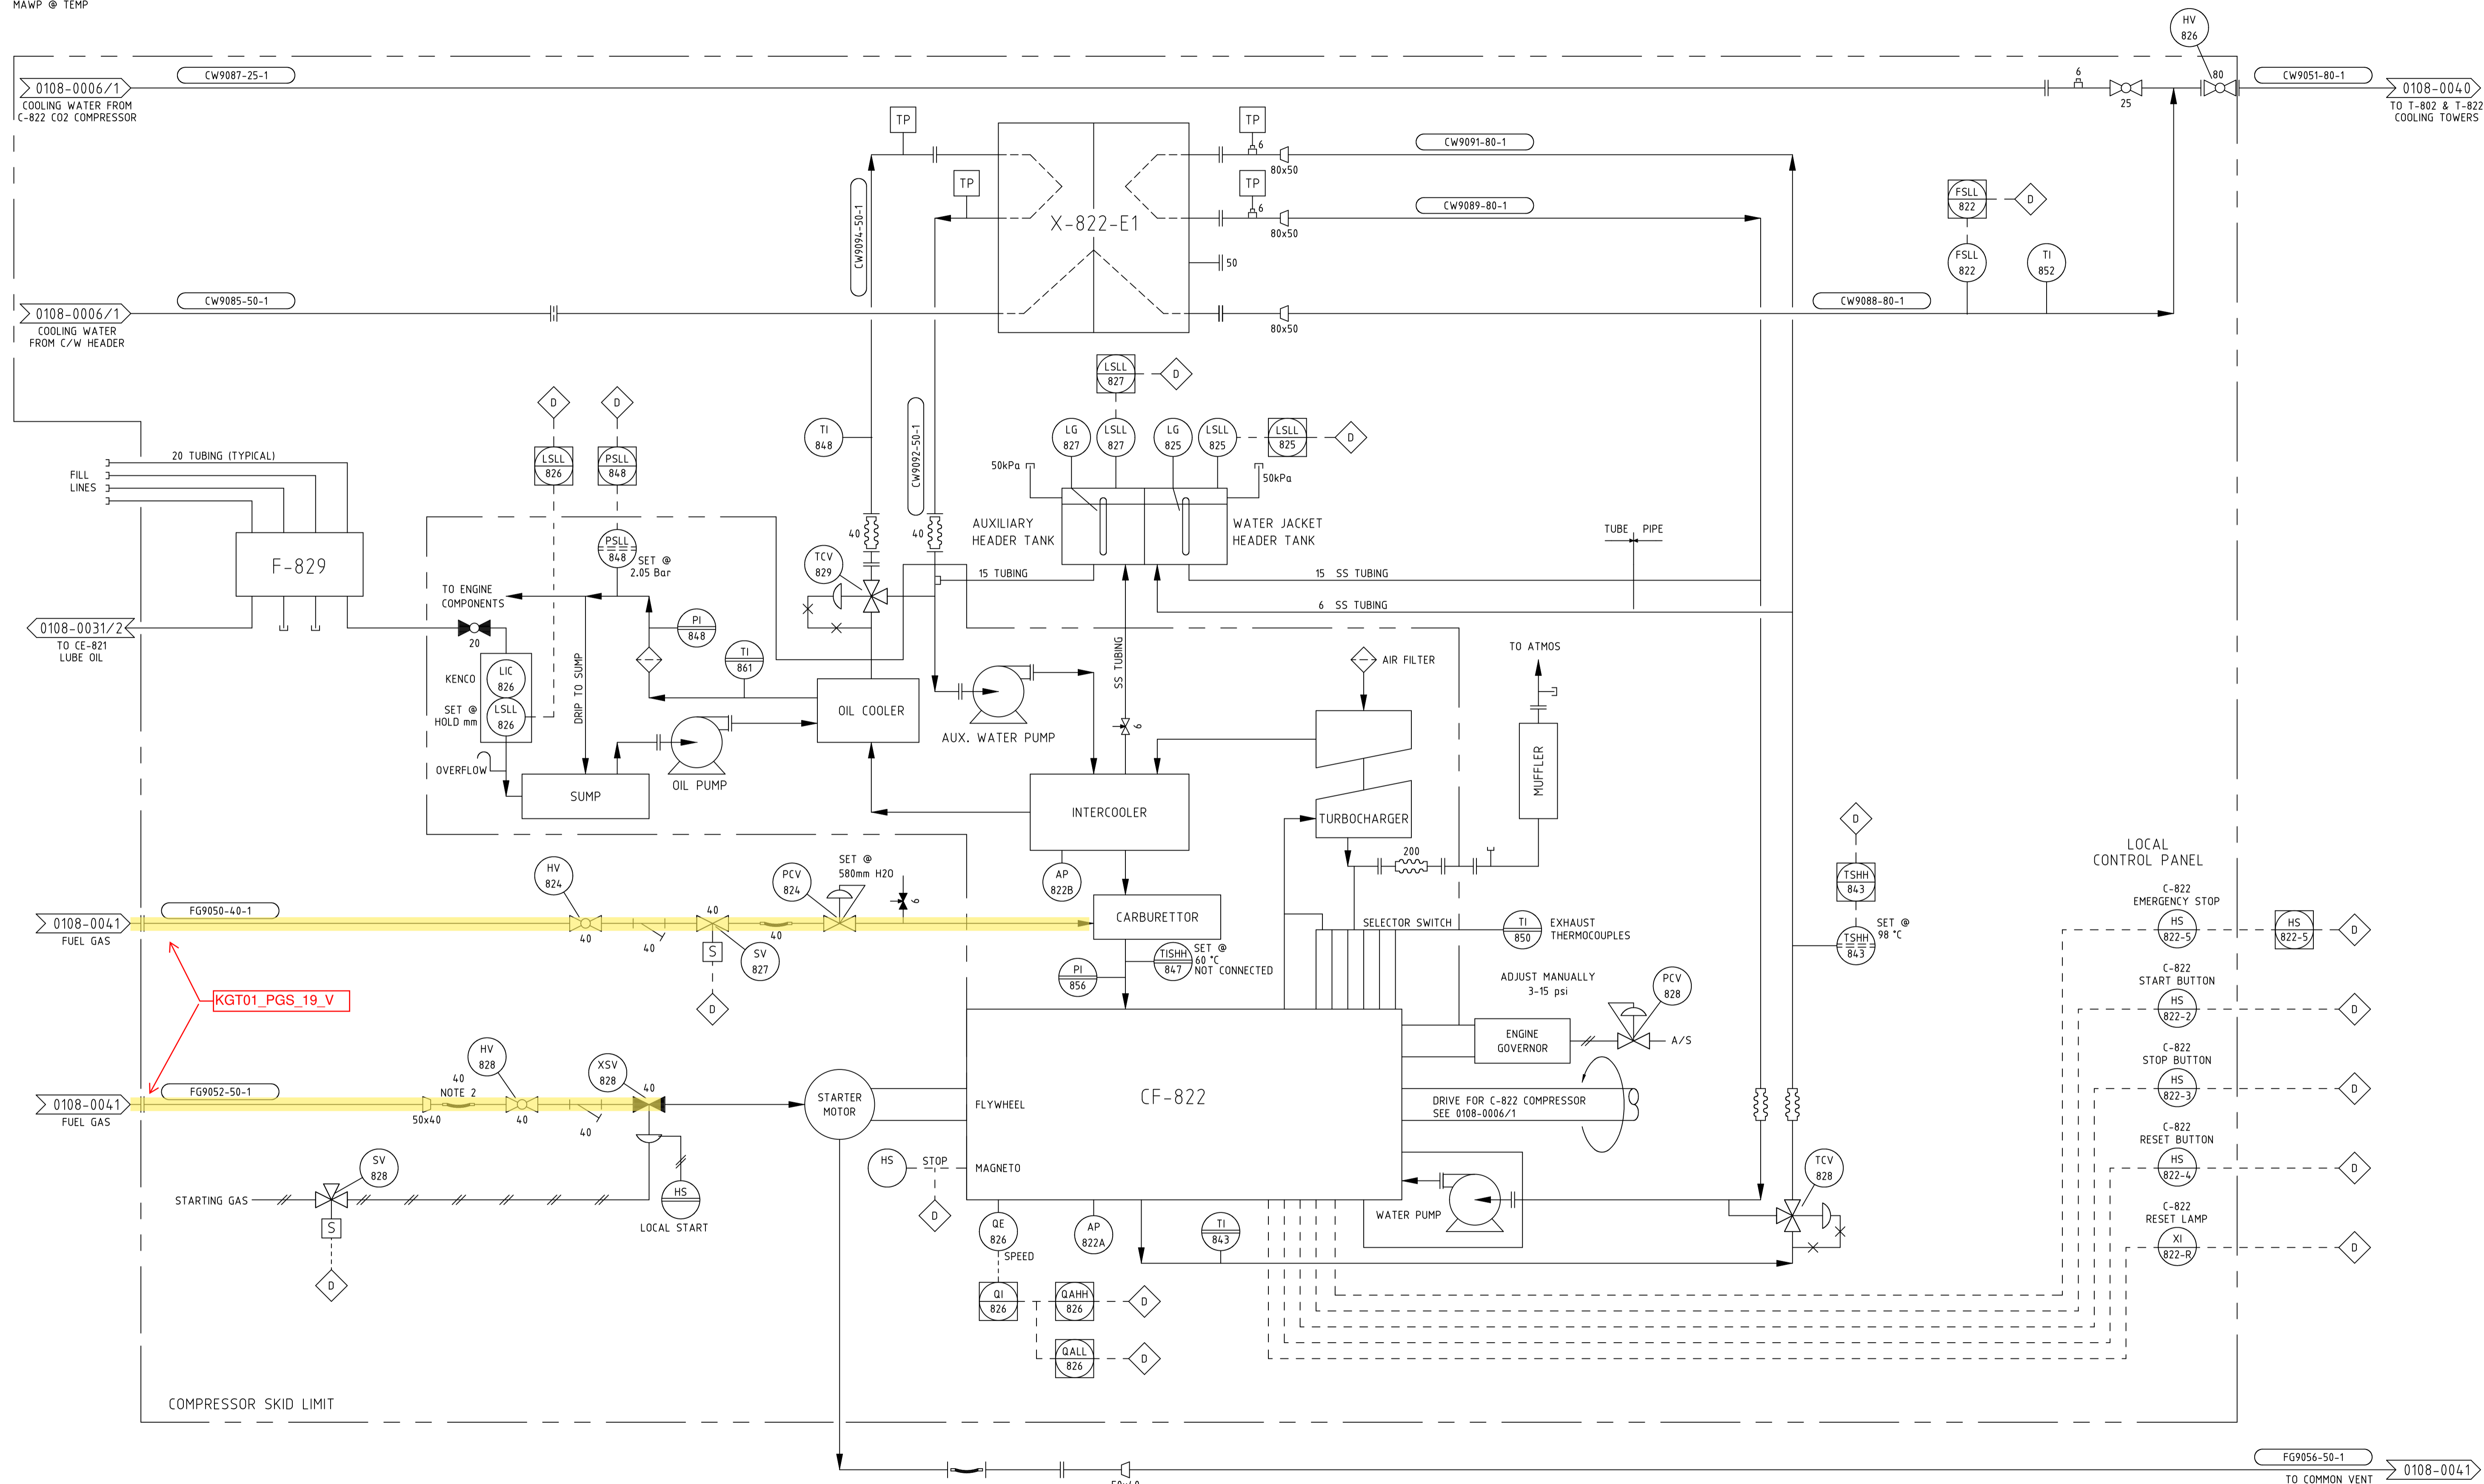

REV	AMENDMENT	BY	CHK	ENG	APP	DATE	REV	AMENDMENT	BY	CHK	ENG	APP	DATE
9	AS BUILT P84-846 REPLACE C-822 MICROGUARD PLC	RL	ES	AB	AM	10/2013			RL/ES	AB	AM	SES	10/2013
8	HAND VALVE NUMBERS ADDED FOR ISOLATIONS	RL	CR	AM	SES	07/2013			RL	CR	AM	SES	07/2013
7	AS BUILT PALL-804B WAS PSLL-844	ES/RL	AC	AM	SES	11/12			ES/RL	AC	AM	SES	11/12
6	PROCESS ISOLATION POINTS ADDED ON INDIVIDUAL LAYERS	CMW	RL	CM	AIM	10/02			CMW	RL	CM	AIM	10/02
5	SPEED HIGH TRIP AMENDED TO 1980 RPM	VB	RL	EJH	RS	10/99			VB	RL	EJH	RS	10/99
4	DRG No. WAS 0108-0034/01 AND AP-822A & B ADDED	GMF	DV	EJH	HG	10/98			GMF	DV	EJH	HG	10/98
3	REVISED FOLLOWING I&E MAINTENANCE SURVEY	J.B.H.	R.L.	AvG	A.M.B.	27/08/96			J.B.H.	R.L.	AvG	A.M.B.	27/08/96
2	AS BUILT COMMENTS INCORPORATED	V.B.	B.T.	A.V.G.	C.J.	5/95			V.B.	B.T.	A.V.G.	C.J.	5/95
1	REVISED FOR CONTINUITY CHECK	J.B.H.	D.G.H.	A.V.G.	C.J.	10/94			J.B.H.	D.G.H.	A.V.G.	C.J.	10/94
	AS BUILT USING PID VERSION 11.52	B.A.T.	J.S.T.	J.R.	J.R.S.	04/94			B.A.T.	J.S.T.	J.R.	J.R.S.	04/94

VECTOR KAPUNI LIMITED
 PRIVATE BAG 2020
 NEW PLYMOUTH 4342
 PHONE 0800 734 567

sjio

COPYRIGHT The copyright in this document is vested in Vector Kapuni Limited
 The contents of this document shall not be reproduced, either in whole or part, by any
 means whatsoever without the prior written consent of Vector Kapuni Limited.

AUTOCAD ORIGINAL SHEET SIZE A1

DRN	JH	01/04/1994	ENG	E.DRUMMOND	01/04/1994
CHK	R.LOGAN	01/04/1994	APP	J. STUART	01/04/1994

SCALE:	JOB NO.	SERIES	DRG. NO	SHT 02	REVISION
NTS	1000000	0108	0006	OF 02 SHTS	10


EQUIPMENT No.
DESCRIPTION
CAPACITY
MAWP @ TEMP

E-802
CO2 AFTERCOOLER
CAPACITY 0.47m3
TUBE: 6.89 Barg @ -29/200°C
SHELL: 24.13 Barg @ -46/200°C

M-881
AFTERCOOLER SEPARATOR
CAPACITY 0.25 m3
24.13 Barg @ 175/-3°C

E-803
CO2 CHILLER
CAPACITY 0.43 m3
TUBE: 24.13 Barg @ 35/2°C
SHELL: 20.68 Barg @ 35/2°C

M-882
CHILLER SEPARATOR
CAPACITY 0.25m3
24.3 Barg @ 50/-3°C

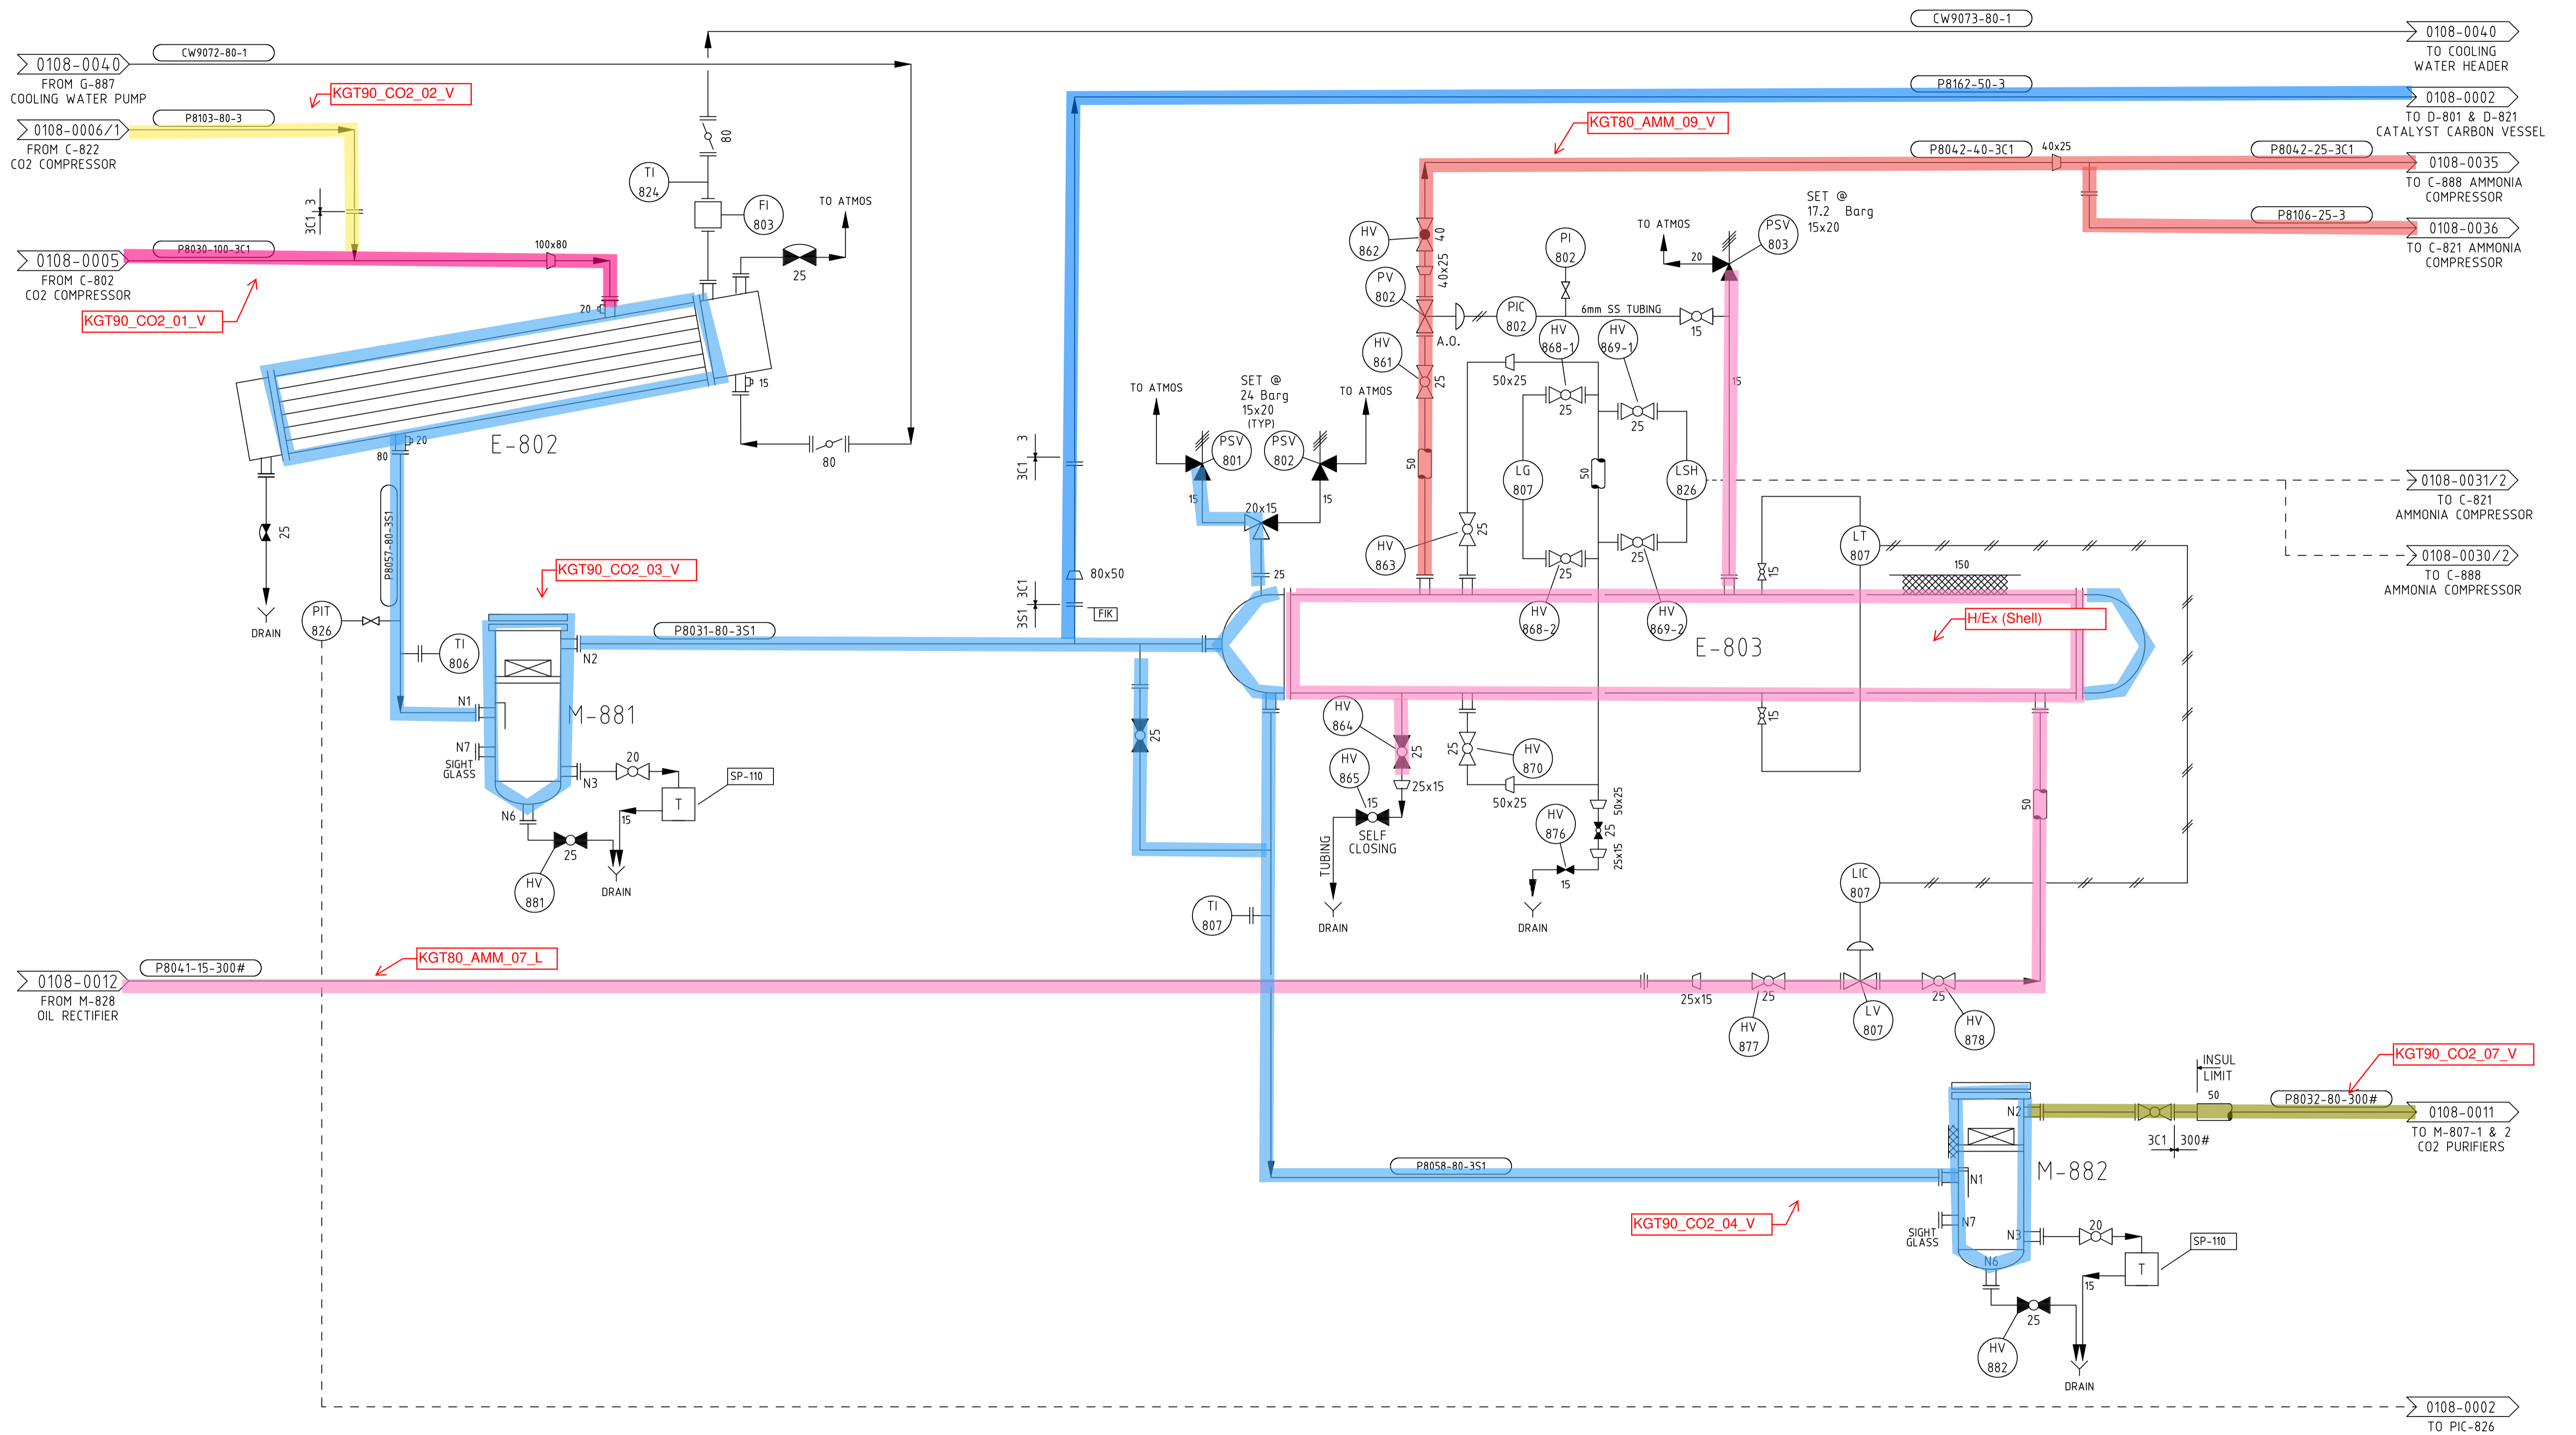

REV	AMENDMENT	BY	CHK	ENG	APP	DATE	REV	AMENDMENT	BY	CHK	ENG	APP	DATE
15	AS BUILT FOR W5884521 CO2 UPGRADE	JMP	VB	MP	CF	09/05							
14	PROCESS ISOLATION PONITS ADDED ON INDIVIDUAL LAYERS	CMW	RL	CM	AIM	10/02							
13	DESIGN DATA RATIONALISED FOR E-802,803 & 804 - M-803	CMW	RL	AvG	AIM	08/02							
12	LINE P8106-25-3 REMOVED RE DUPLICATION	VB	RL	EJH	RJW	09/00							
11	DRAWING NUMBER WAS 0108-0003/01	GMF	DV	EJH	MB	10/98							
10	PCV-802 AND LCV-807 NOW PV-802 AND LCV-807	J.B.H.	R.L.	AvG	A.M.B.	09/08/96							
9	PIC-807 NOW 802, P8031-80 NOW 300#	J.B.H.	R.L.	AvG	J.B.G.	10/95							
8	AS BUILT COMMENTS INCORPORATED	V.B.	B.T.	A.V.G.	C.J.	5/95							
7	REVISED FOR CONTINUITY CHECK	J.B.H.	O.G.M.	A.V.G.	C.J.	10/94							
6	AS BUILT USING PID VERSION 11.52	J.S.T.	P.H.	J.R.	J.R.S.	04/94							

VECTOR KAPUNI LIMITED
PRIVATE BAG 2020
NEW PLYMOUTH 4342
PHONE 0800 734 567


COPYRIGHT The copyright in this document is vested in Vector Kapuni Limited
The contents of this document shall not be reproduced, either in whole or part, by any
means whatsoever without the prior written consent of Vector Kapuni Limited.

REFERENCE DRAWINGS
DRAWING NUMBER WAS 0108-0003/01

CO2 RECOVERY
PIPING & INSTRUMENT DIAGRAM
CO2 COOLING AND CHILLING

DRN	P.MILLS	28/04/1980	ENG	DATE	DATE
CHK	R.LOGAN	28/04/1980	APP		

SCALE:	JOB NO.	SERIES	DRG. NO	SHT 01	REVISION
NTS	1000000	0108	0010	01 OF 01 SHTS	21

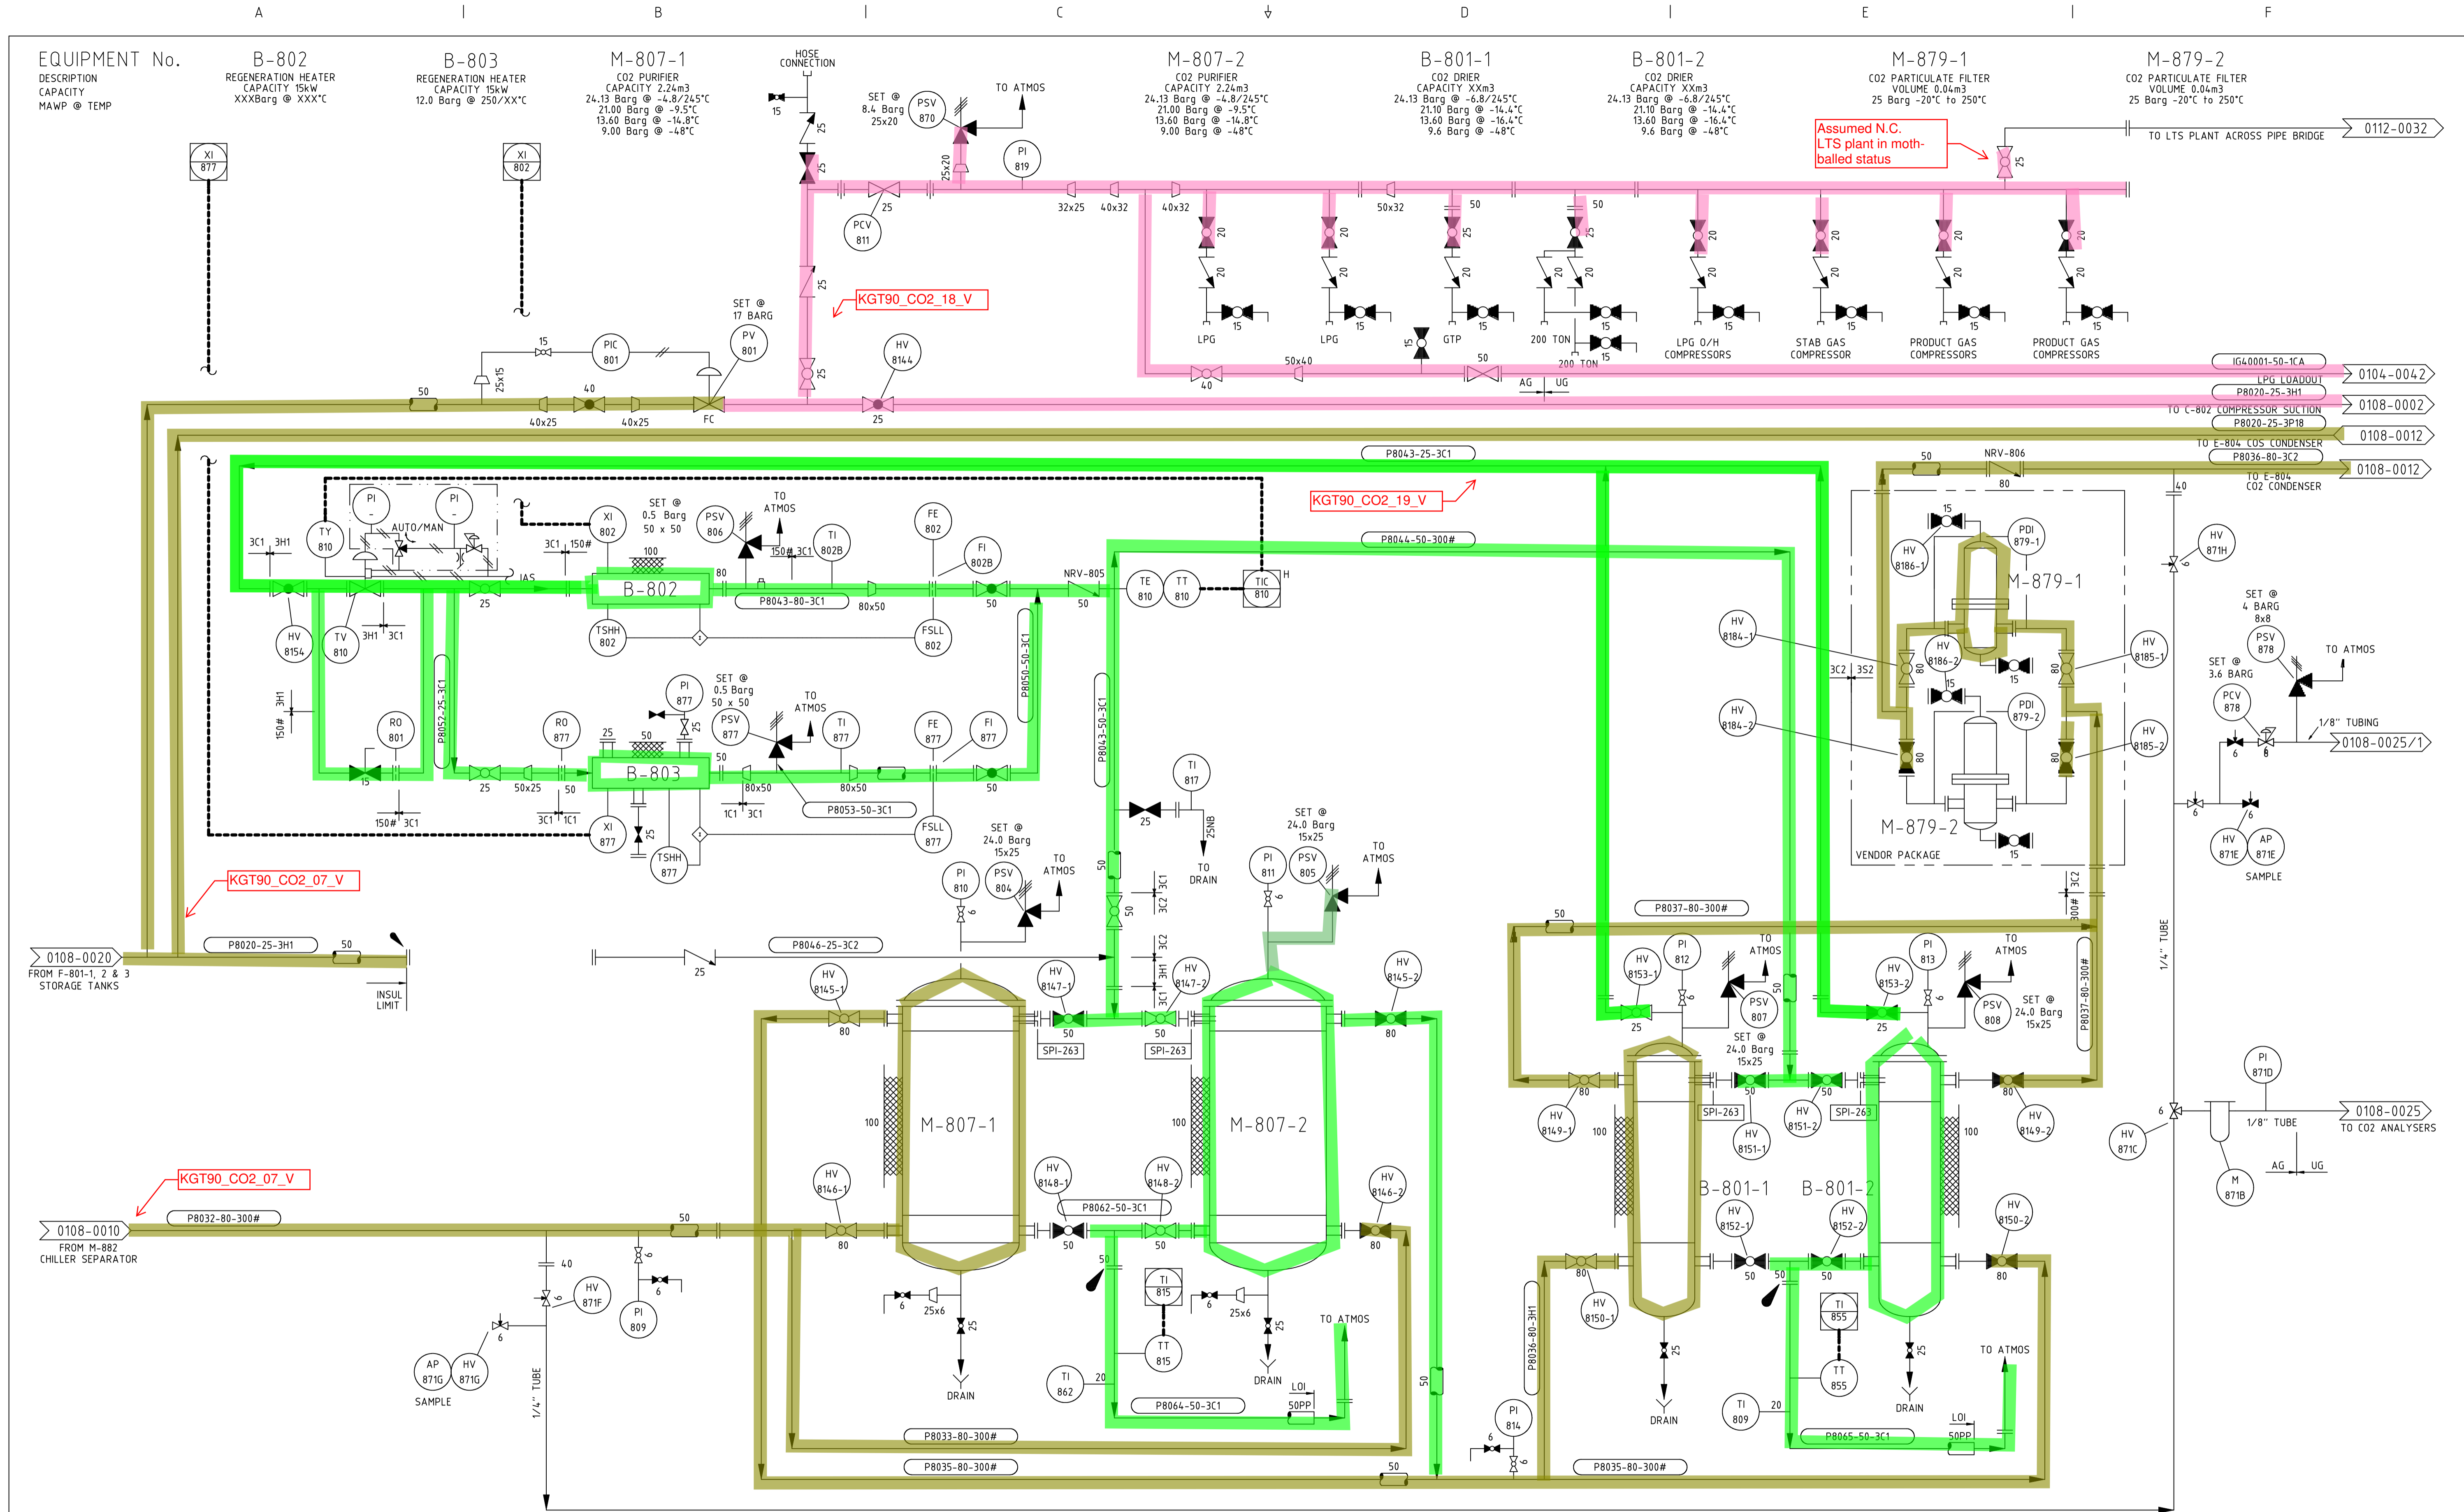

REV	AMENDMENT	BY	CHK	ENG	APP	DATE	REV	AMENDMENT	BY	CHK	ENG	APP	DATE
22	HAND VALVE NUMBERS ADDED FOR ISOLATIONS	RL	CR	AM	SES	03/2014	12	DESIGN DATA RATIONALISED	CMW	RL	AvG	AIM	08/02
21	AS BUILT P84-2908 CO2 PLANT VENT DRIER & PURIFIER	LN	CJ	AM	SES	01/14	11	SET PRESSURE ADDED FOR PSV-870	VB	RL	EJH	RJW	09/00
20	AS BUILT MODS TO B-801-1 & 2 VALVES & M-879-1 & 2	RL/ES	CR	AM	SES	04/2013	10	DRG No. WAS 0108-0004/01 AND AP-871 E & G ADDED	GMF	DV	EJH	HG	10/98
19	AS BUILT P84-2587 CO2 PURIFIER AND DRIER RERATE	LN	CJ	AM	SES	11/12							
18	AS BUILT WS1418134 CO2 NON COMPLIANT VALVE & FLANGES	VB	WF	PWM	LH	10/08							
17	AS BUILT WS1335996 VECTOR CO2 FILTERS	VB	KC	PWM	LH	04/08							
16	AS BUILT TO SITE MARK UP	VB	RL	LH	SES	03/08	26	AS BUILT MOISTURE ANALYSER AIT-877 & AI-877 REMOVED	RL	JCC	AM	TC	09/2019
15	AS BUILT NRV CO2 PURGE SYSTEM WS1013735	VB	MS	LH	PJR	09/07	25	AS BUILT P84-860 CO2 PLANT CONTROL UPGRADE	WPG	SHA	AM	SES	08/2017
14	AS BUILT TO SITE MARK-UP	VB	ES	NH	PJP	10/06	24	HAND VALVE NUMBERS ADDED FOR ISOLATIONS	RL	JCC	AM	TC	11/2016
13	PROCESS ISOLATION POINTS ADDED TO INDIVIDUAL LAYERS	CMW	RL	CM	AIM	10/02	23	ADDED NRV-805, NRV-806, CHANGED HV-8152-2	JCC	RL	AM	SES	04/2015

VECTOR KAPUNI LIMITED
 PRIVATE BAG 2020
 NEW PLYMOUTH 4342
 PHONE 0800 734 567

sjio

COPYRIGHT The copyright in this document is vested in Vector Kapuni Limited
 The contents of this document shall not be reproduced, either in whole or part, by any
 means whatsoever without the prior written consent of Vector Kapuni Limited.


AUTOCAD ORIGINAL SHEET SIZE A1

REFERENCE DRAWINGS			
DRN	P.MILLS	28/04/1980	ENG
CHK	R.LOGAN	28/04/1980	APP
DRAWING NUMBER WAS 0108-0004/01			
DATE	ENG	DATE	

CO2 RECOVERY PIPING & INSTRUMENT DIAGRAM CO2 PURIFICATION AND DRYING					
SCALE:	JOB NO.	SERIES	DRG. NO	SHT 01	REVISION
NTS	1000000	0108	0011	01	26
				OF	
				SHTS	

EQUIPMENT No.

DESCRIPTION
CAPACITY
MAWP @ TEMP

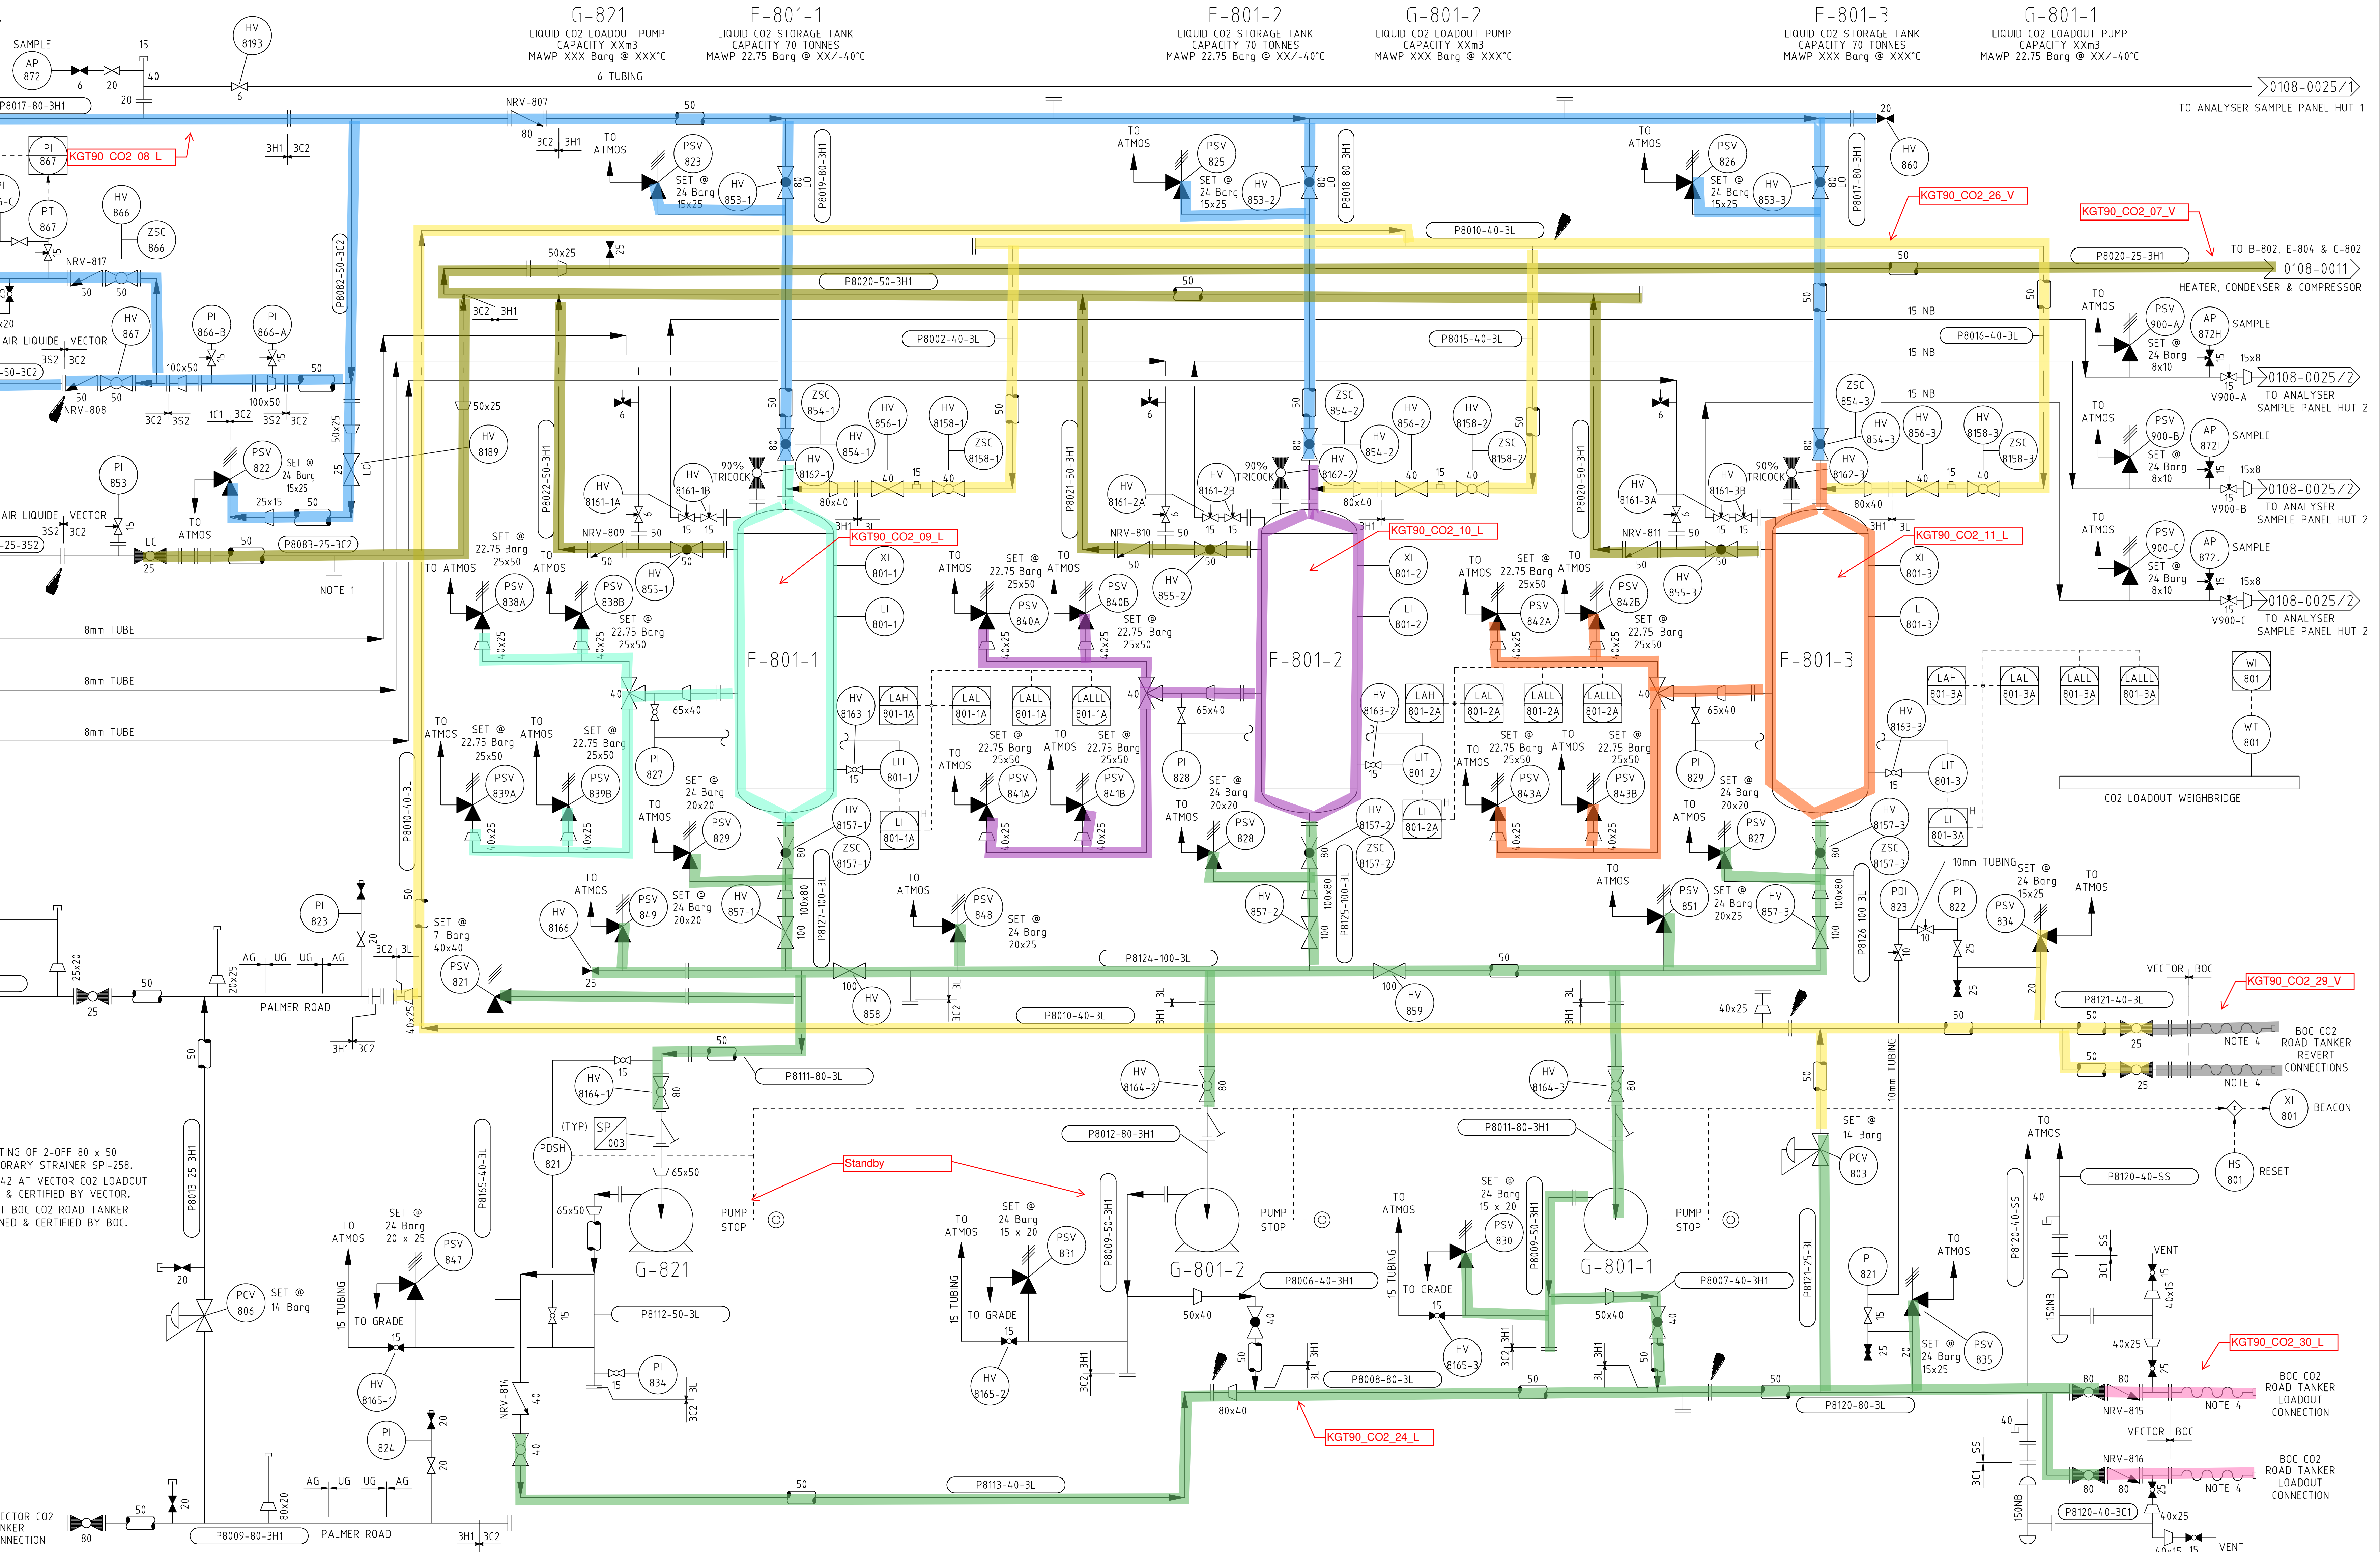

- NOTES:
1. FUTURE TIE-IN.
 2. TEMPORARY SPOOL CONSISTING OF 2-OFF 80 x 50 REDUCERS TO HOUSE TEMPORARY STRAINER SPI-258.
 3. FLEXIBLE HOSE No. VKA-1242 AT VECTOR CO2 LOADOUT CONNECTION IS MAINTAINED & CERTIFIED BY VECTOR.
 4. FLEXIBLE HOSES (4-OFF) AT BOC CO2 ROAD TANKER CONNECTIONS ARE MAINTAINED & CERTIFIED BY BOC.

REV	DESCRIPTION	BY	CHK	ENG	APP	DATE	REV	DESCRIPTION	BY	CHK	ENG	APP	DATE
45	RESPONSIBILITY OF CO2 LOADOUT HOSES CLARIFIED	RL	JCC	AM	SES	07/2019	35	AS BUILT P84-1096 PROXIMITY SWITCHES	JCC	RL	AM	SES	04/2015
44	HAND VALVE NUMBER HV-8193 ADDED FOR ISOLATIONS	RL	JCC	AM	SES	06/2018	34	HAND VALVE NUMBERS ADDED FOR ISOLATIONS	RL	CR	AM	SES	02/2014
43	AS BUILT PSV-900-A, B & C AND 3 LO'S REMOVED	RL	JCC	AM	SES	04/2018	33	AS BUILT REVERT LINES AND ANALYSER SAMPLE LINES ADDED	ES/RL	CB	AM	SES	02/2014
42	AS BUILT SCR 702 CO2 STORAGE	JCC	RL/PQ	AM	SES	11/2016	32	AS BUILT P84-217 RESOLVE PSV-822 ICING ISSUES	SE	CJ	AM	SES	01/2014
41	AS BUILT COMMENTS FROM SITE CHECK, GA & ISO DRAWINGS	RL	JC	AM	SES	06/2016	31	AS BUILT P84-3312 WEIGHBRIDGE & TEMP STRAINERS REMOVED	RL	AB	AM	SES	07/2013
40	AS BUILT P84-1138 CO2 RAIL LOADING STATION	JSI	BK	AM	SES	06/2016	30	PSV-833, PSV-846 & RAIL TANKER LOADOUT REMOVED P84-3275	RL/ES	SR	AM	SES	06/2012
39	P84-1271 CO2 LOADOUT VENT MODS AS BUILT	RL	JC/CR	AM	SES	05/2016	29	SET PRESSURES ADDED FOR PSV-830 & PSV-831	RL/ES	CR	AM	SES	05/2012
38	P84-1292 CO2 OVERPRESSURE PROTECTION AS BUILT	AJA	LEL	AM	SES	02/2016	28	AS BUILT P84-910 CO2 CONN ADDED FOR VECTOR GAS	RL/ES	LR	KR	SES	05/2011
37	AS BUILT FOR LOCKED OPEN VALVES AND FLANGED VALVES	RL	JC	AM	SES	10/2015	27	PI-853 WAS PI-858, P8083 WAS P8082, PSV SIZES ADDED	RL/ES	WB	LH	SES	10/2010
36	AS BUILT P84-1105 & NRV & HV NUMBERS ADDED	RL	JC	AM	SES	05/2015	26	AS BUILT WS1476959 CO2 LOADOUT PUMP GAUGES	ES	RL/KS	LH	SES	07/09

VECTOR KAPUNI LIMITED
PRIVATE BAG 2020
NEW PLYMOUTH 4342
PHONE 0800 734 567

COPYRIGHT The copyright in this document is vested in Vector Kapuni Limited. The contents of this document shall not be reproduced, either in whole or part, by any means whatsoever without the prior written consent of Vector Kapuni Limited.

AUTOCAD ORIGINAL SHEET SIZE A1

REFERENCE DRAWINGS
DRAWING NUMBER WAS 0108-0008/01

DRN	DATE	ENG	APP
P.MILLS	28/04/1980	ENG	
R.LOGAN	28/04/1980	APP	


CO2 RECOVERY
PIPING & INSTRUMENT DIAGRAM
CO2 STORAGE

SCALE:	JOB NO.	SERIES	DRG. NO	SHT	REVISION
NONE	1000000	0108	0020	01 OF 02 SHTS	45

EQUIPMENT No.
DESCRIPTION
CAPACITY
MAWP @ TEMP

G-812
LIQUID CO2 LOADOUT PUMP
CAPACITY 16m³/hr
DESIGN 27.6 Barg @ -40/85°C
DIFFERENTIAL PRESSURE OP/MAX: 3.5/5 bar

F-811
LIQUID CO2 STORAGE VESSEL
CAPACITY 18 TONNES
MAWP 20 Barg @ -196°C

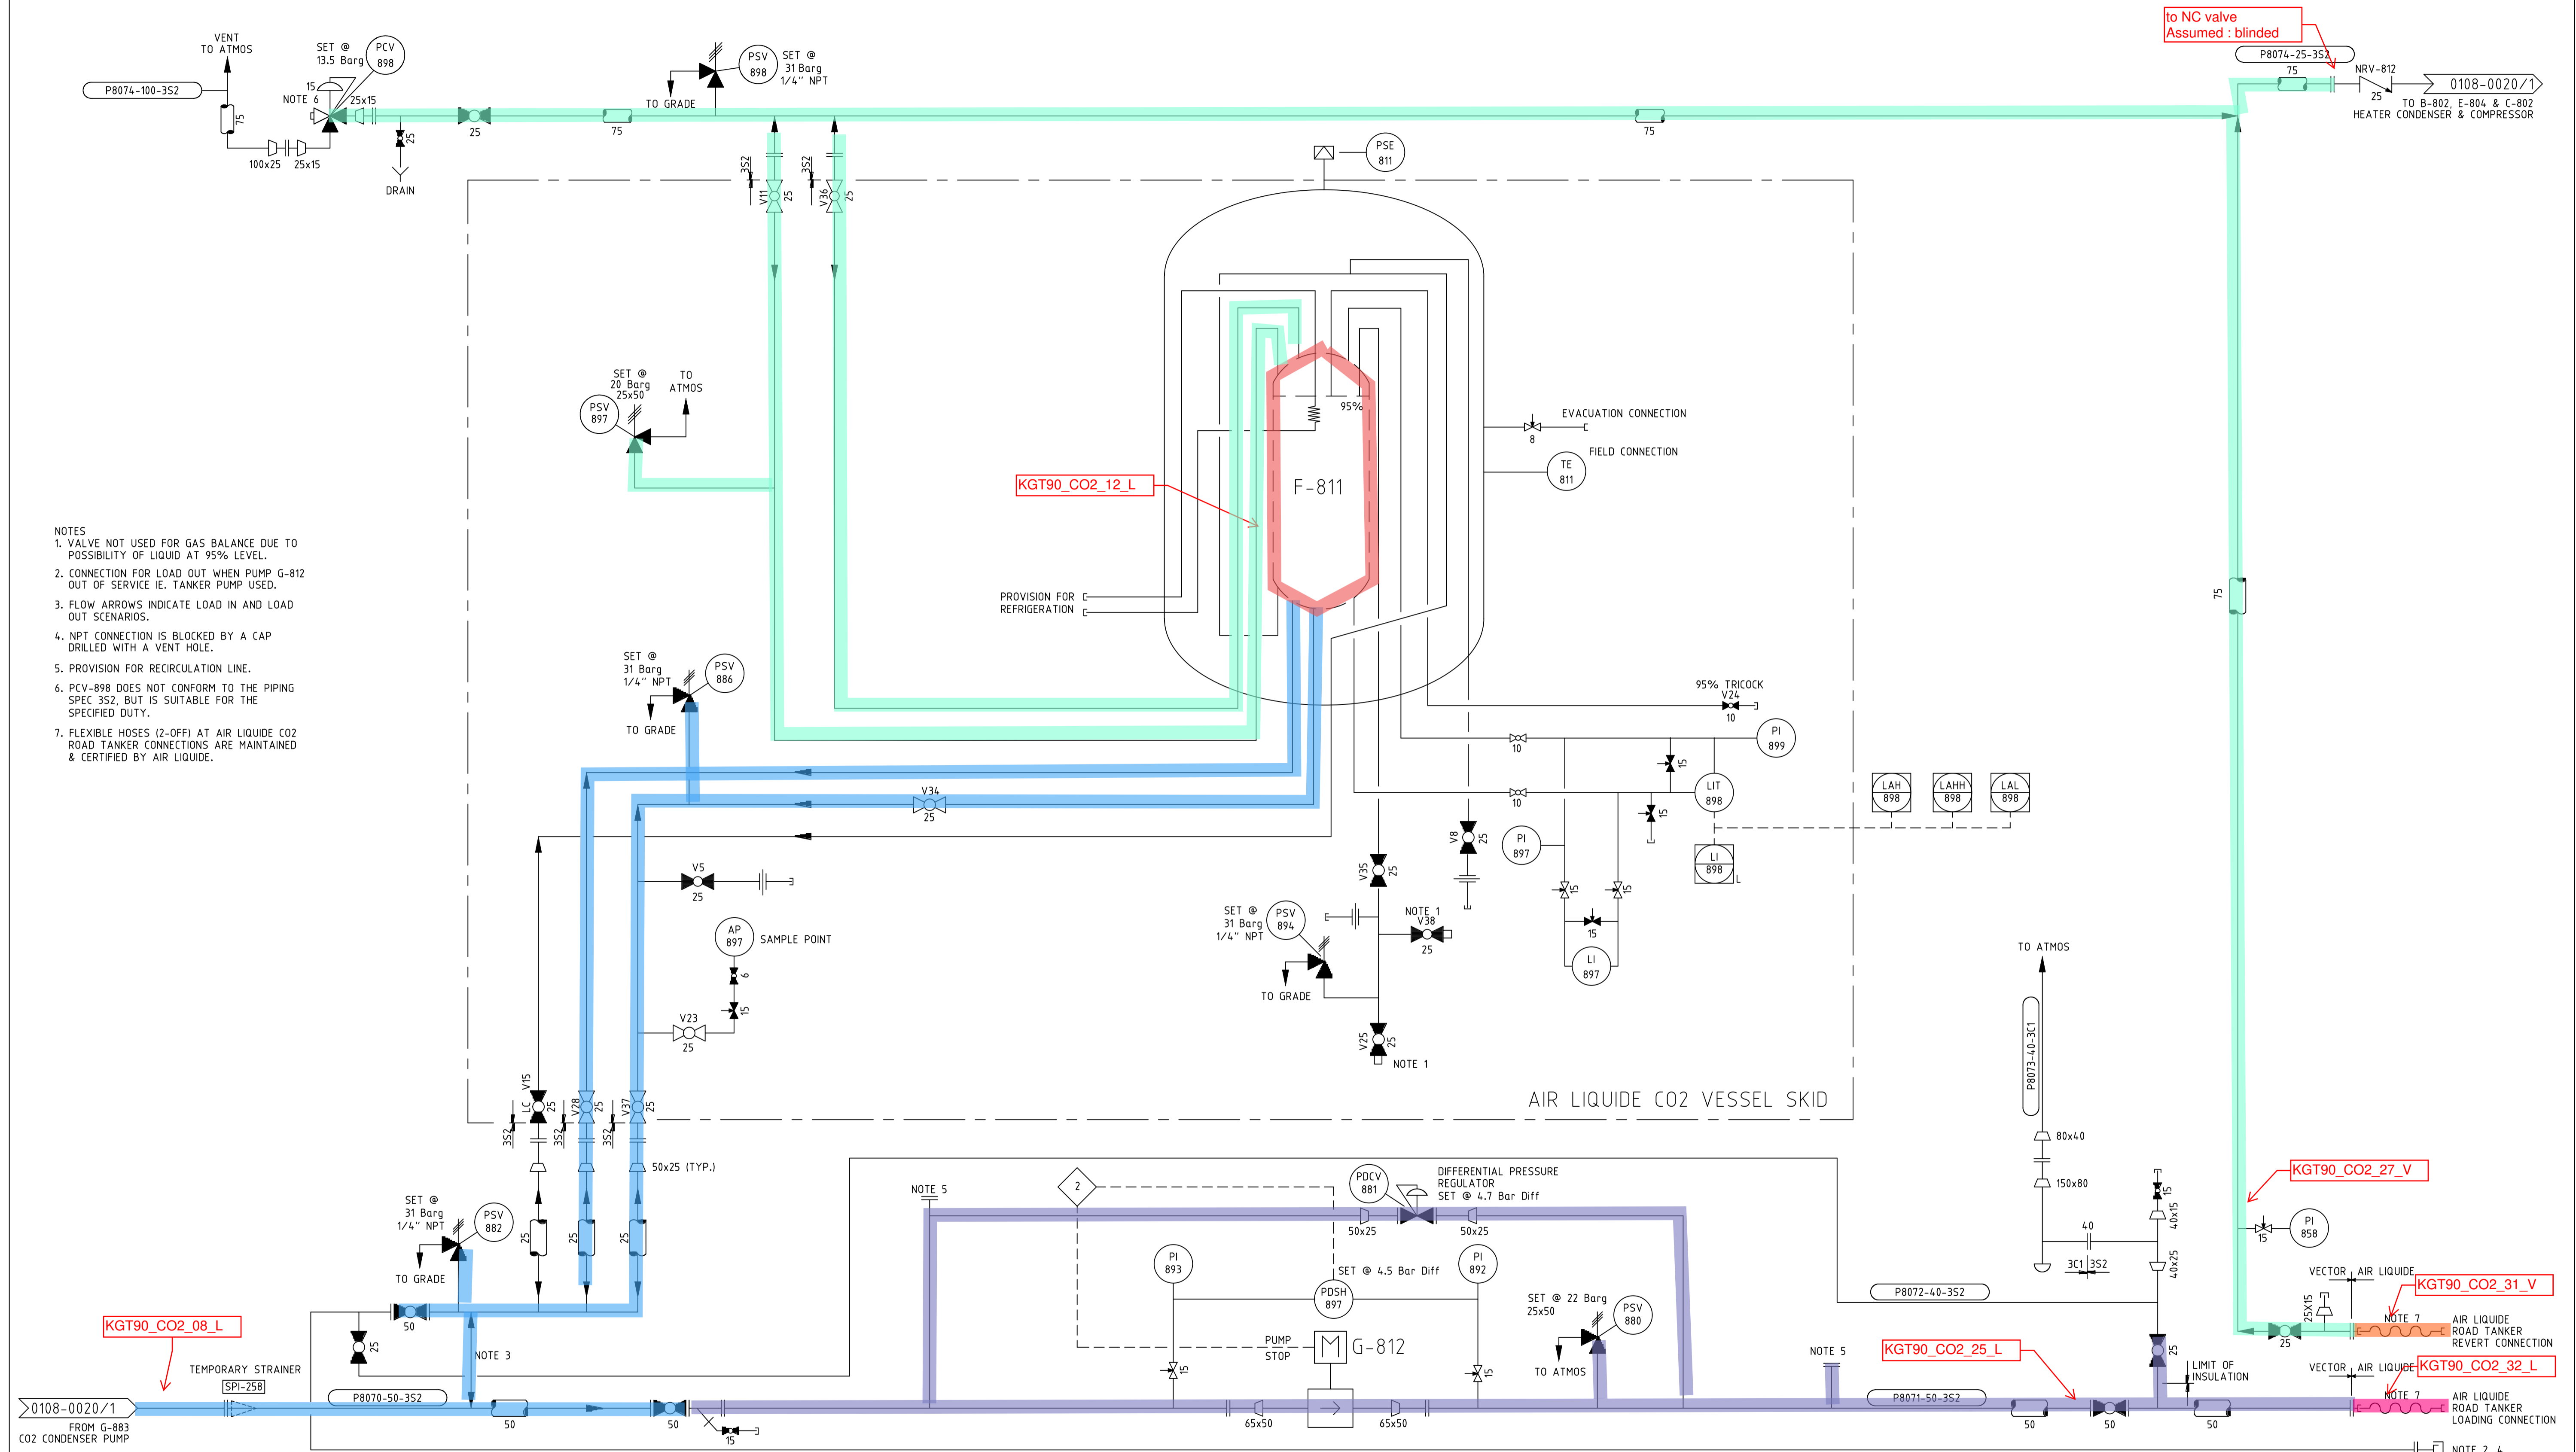

- NOTES
1. VALVE NOT USED FOR GAS BALANCE DUE TO POSSIBILITY OF LIQUID AT 95% LEVEL.
 2. CONNECTION FOR LOAD OUT WHEN PUMP G-812 OUT OF SERVICE IE. TANKER PUMP USED.
 3. FLOW ARROWS INDICATE LOAD IN AND LOAD OUT SCENARIOS.
 4. NPT CONNECTION IS BLOCKED BY A CAP DRILLED WITH A VENT HOLE.
 5. PROVISION FOR RECIRCULATION LINE.
 6. PCV-898 DOES NOT CONFORM TO THE PIPING SPEC 352, BUT IS SUITABLE FOR THE SPECIFIED DUTY.
 7. FLEXIBLE HOSES (2-OFF) AT AIR LIQUIDE CO2 ROAD TANKER CONNECTIONS ARE MAINTAINED & CERTIFIED BY AIR LIQUIDE.

REV	AMENDMENT	BY	CHK	ENG	APP	DATE	REV	AMENDMENT	BY	CHK	ENG	APP	DATE
13	RESPONSIBILITY OF CO2 LOADOUT HOSES CLARIFIED	RL	JCC	AM	TC	07/2019							
12	AS BUILT P84-1449 AIR LIQUIDE TANK THERMAL PSV REPLACEMENT	RL	JCC	AM	TC	10/2018							
11	F-811 CAPACITY WAS SHOWN AS 22m ³ & CONTIN NOTES UPDATED	RL	MB	AM	SES	07/2013							
10	CO2 TANK OWNERSHIP CHANGED FROM ASCO TO AIR LIQUIDE	RL/ES	TVG	AM	SES	06/2012							
9	AS BUILT WS2007229 FINAL MOD. PCV-898 WAS SET 15 BARG	RL/ES	WB	LH	SES	11/2010							
8	PARTIAL AS BUILT P84-1064 REMOVE NRV ON ASCO REVERT LINE	CJ	GH	WB	LH	09/2010							
7	AS BUILT WS2007229 - ASCO TANK PRESSURE	RL	KS	LH	SES	04/2010							
6	AS BUILT WS1418193 - ASCO CO2 STORAGE SAMPLE POINT	RL	ES	LH	SES	12/08							
5	AS BUILT WS141041 - ASCO CO2 STORAGE VESSEL	ES	RL	LM	LH	12/07							

VECTOR KAPUNI LIMITED
PRIVATE BAG 2020
NEW PLYMOUTH 4342
PHONE 0800 734 567

sjio

COPYRIGHT The copyright in this document is vested in Vector Kapuni Limited. The contents of this document shall not be reproduced, either in whole or part, by any means whatsoever without the prior written consent of Vector Kapuni Limited.

AUTOCAD ORIGINAL SHEET SIZE A1

REFERENCE DRAWINGS

DRN	E STARNS	DATE	ENG	L McLELLAN	DATE
CHK	R LOCHHEAD	13/12/2007	APP	L HUNT	13/12/2007

KAPUNI GAS TREATMENT PLANT
PIPING & INSTRUMENT DIAGRAM
AIR LIQUIDE CO2 STORAGE VESSEL

SCALE:	JOB NO.	SERIES	DRG. NO	SHT	REVISION
NTS	1000000	0108	0020	02 OF 02 SHTS	13

EQUIPMENT No.
DESCRIPTION
CAPACITY
MAWP @ TEMP

C-821
AMMONIA COMPRESSOR
CAPACITY XXm3
MAWP XXXBarg @ XXX°C

X-821-M1
OIL FILTER
CAPACITY XXm3
MAWP 20.70 Barg @ 149/-29°C

F-821
LUBE OIL SUPPLY TANK
CAPACITY 0.06m3
MAWP ATMOS


G-820
LUBE OIL FILL PUMP
FLOW 0.168m3/Hr
MAWP XXXBarg @ XX°C

X-821-M2
OIL FILTER
CAPACITY XXm3
MAWP 20.70 Barg @ 149/-29°C

M-825
OIL SEPARATOR
CAPACITY XXm3
MAWP 20.70 Barg @ 149/-29°C


X-821-E1
OIL COOLER
CAPACITY XXm3
MAWP XXXBarg @ XXX°C

X-821-G1
OIL PUMP
FLOW XXSm3/Hr @ XX hp
MAWP XXXBarg @ XX°C

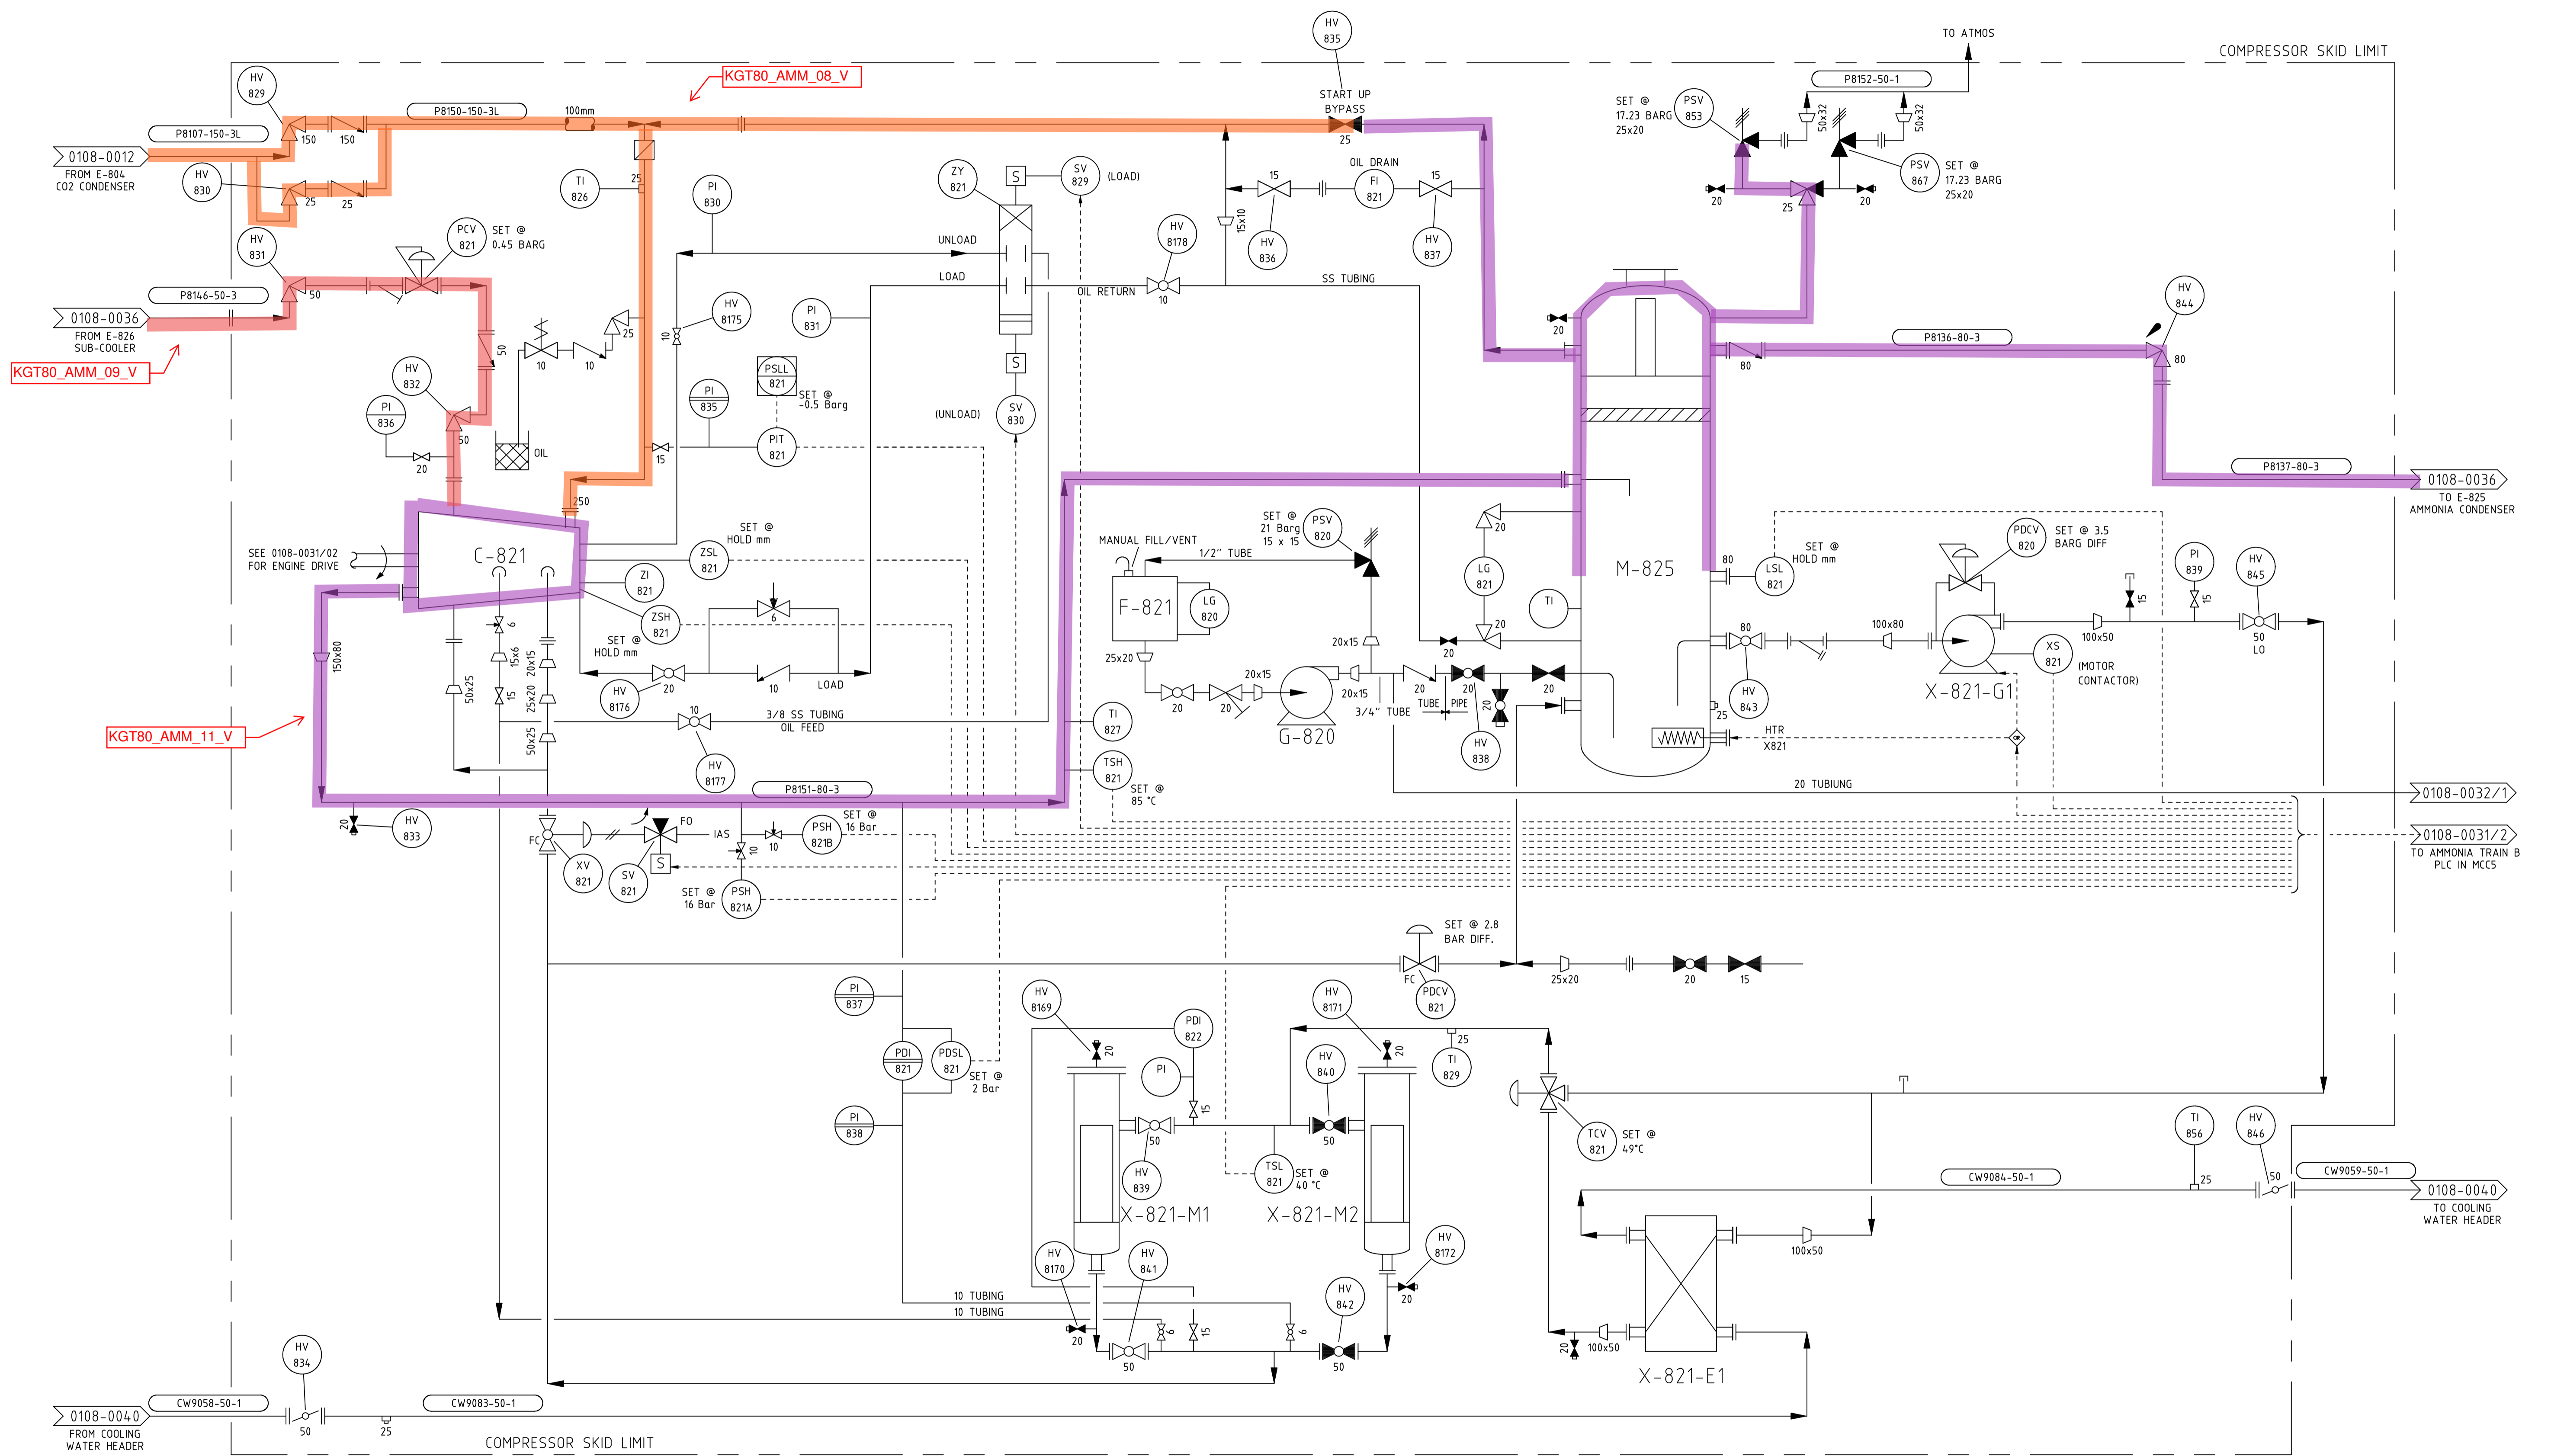

REV	AMENDMENT	BY	CHK	ENG	APP	DATE	REV	AMENDMENT	BY	CHK	ENG	APP	DATE
18	P84-2010 REPLACE PSL-821	JCC	RL/CB	AM	SES	03/2018	9	AS BUILT FOR W5884521 CO2 UPGRADE	JMP	VB	MP	CF	09/05
17	P84-1323 - LOADER SOL VLV SYMBOL, ADDED PI-TAGS	JCC	RL/CB	AM	SES	07/2016	7	PROCESS ISOLATION POINTS ADDED ON INDIVIDUAL LAYERS	CMW	RL	CM	AIM	10/02
16	HAND VALVE NUMBERS ADDED FOR NEW ISOLATIONS	RL	JC	AM	SES	05/2016	6	PSV SET POINTS & DESIGN DATA RATIONALISED	GJHI	DJP	AvG	AIM	09/02
15	HAND VALVE NUMBERS ADDED FOR NEW ISOLATIONS	RL	JC	AM	SES	07/2015	5	LINE NUMBER P8137-80-3 ADDED	VB	RL	EJH	RJW	02/01
14	AS BUILT P84-836 PSV-854 REMOVAL	RL	NA	AM	SES	07/2014	4	REVISED FOR NEW PRINT, DRAWING CONTENT NOT CHANGED	VB	RL	EJH	RS	10/99
13	AS BUILT P84-821 WAS 0.5 BAR A	RL	NA	AM	SES	07/2014	4	DRAWING NUMBER WAS 0108-0030/01	GMF	DV	EJH	MB	10/98
12	HAND VALVE NUMBERS ADDED FOR ISOLATIONS	ES/RL	MY	AM	SES	03/2014	3	AS BUILT FOR LUBE OIL FILLING SYSTEM & I&E SURVEY	J.B.H.	R.L.	AvG	A.M.B.	21/08/96
11	AS BUILT DRAIN RELOCATED ON P8151 & P8152 WAS P1852	ES	RL	AM	SES	10/2013	2	AS BUILT COMMENTS INCORPORATED	V.B.	B.T.	A.V.G.	C.J.	5/95
10	AS BUILT	ES	RL	LH	PJR	06/06	D	REVISED FOR CONTINUITY CHECK	J.B.H.	O.G.H.	A.V.G.	C.J.	10/94
9	AS BUILT	ES	RL	LH	PJR	06/06	D	AS BUILT USING PID VERSION 11.52	B.A.T.	J.S.T.	J.R.	J.R.S.	04/94

VECTOR KAPUNI LIMITED
PRIVATE BAG 2020
NEW PLYMOUTH 4342
PHONE 0800 734 567

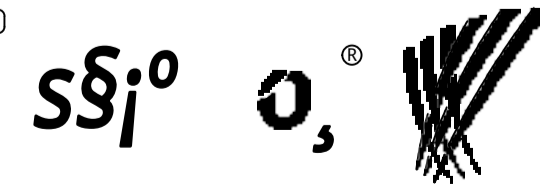

COPYRIGHT The copyright in this document is vested in Vector Kapuni Limited
The contents of this document shall not be reproduced, either in whole or part, by any
means whatsoever without the prior written consent of Vector Kapuni Limited.

REFERENCE DRAWINGS
CAUSE & EFFECTS - 0780-0090/5
DRAWING NUMBER WAS 0108-0030/01
0108-0031/02 COMPRESSOR ENGINE P&ID

DRN	DATE	ENG	APP	DATE
D.WHITMORE	07/05/1994	ENG	E.DRUMMOND	07/05/1994
R.LOGAN	07/05/1994	APP	J. STUART	07/05/1994


CO2 RECOVERY
PIPING & INSTRUMENT DIAGRAM
AMMONIA COMPRESSION TRAIN B

SCALE:	JOB NO.	SERIES	DRG. NO	SHT 01	REVISION
NTS	1000000	0108	0031	OF 02 SHTS	18

EQUIPMENT No.
DESCRIPTION
CAPACITY
MAWP @ TEMP

X-821-E2
AUXILIARY COOLER
CAPACITY XXm3
MAWP XXXBarG @ XXX°C

CE-821
AMMONIA COMPRESSOR ENGINE
CAPACITY XXm3
MAWP XXXBarG @ XXX°C

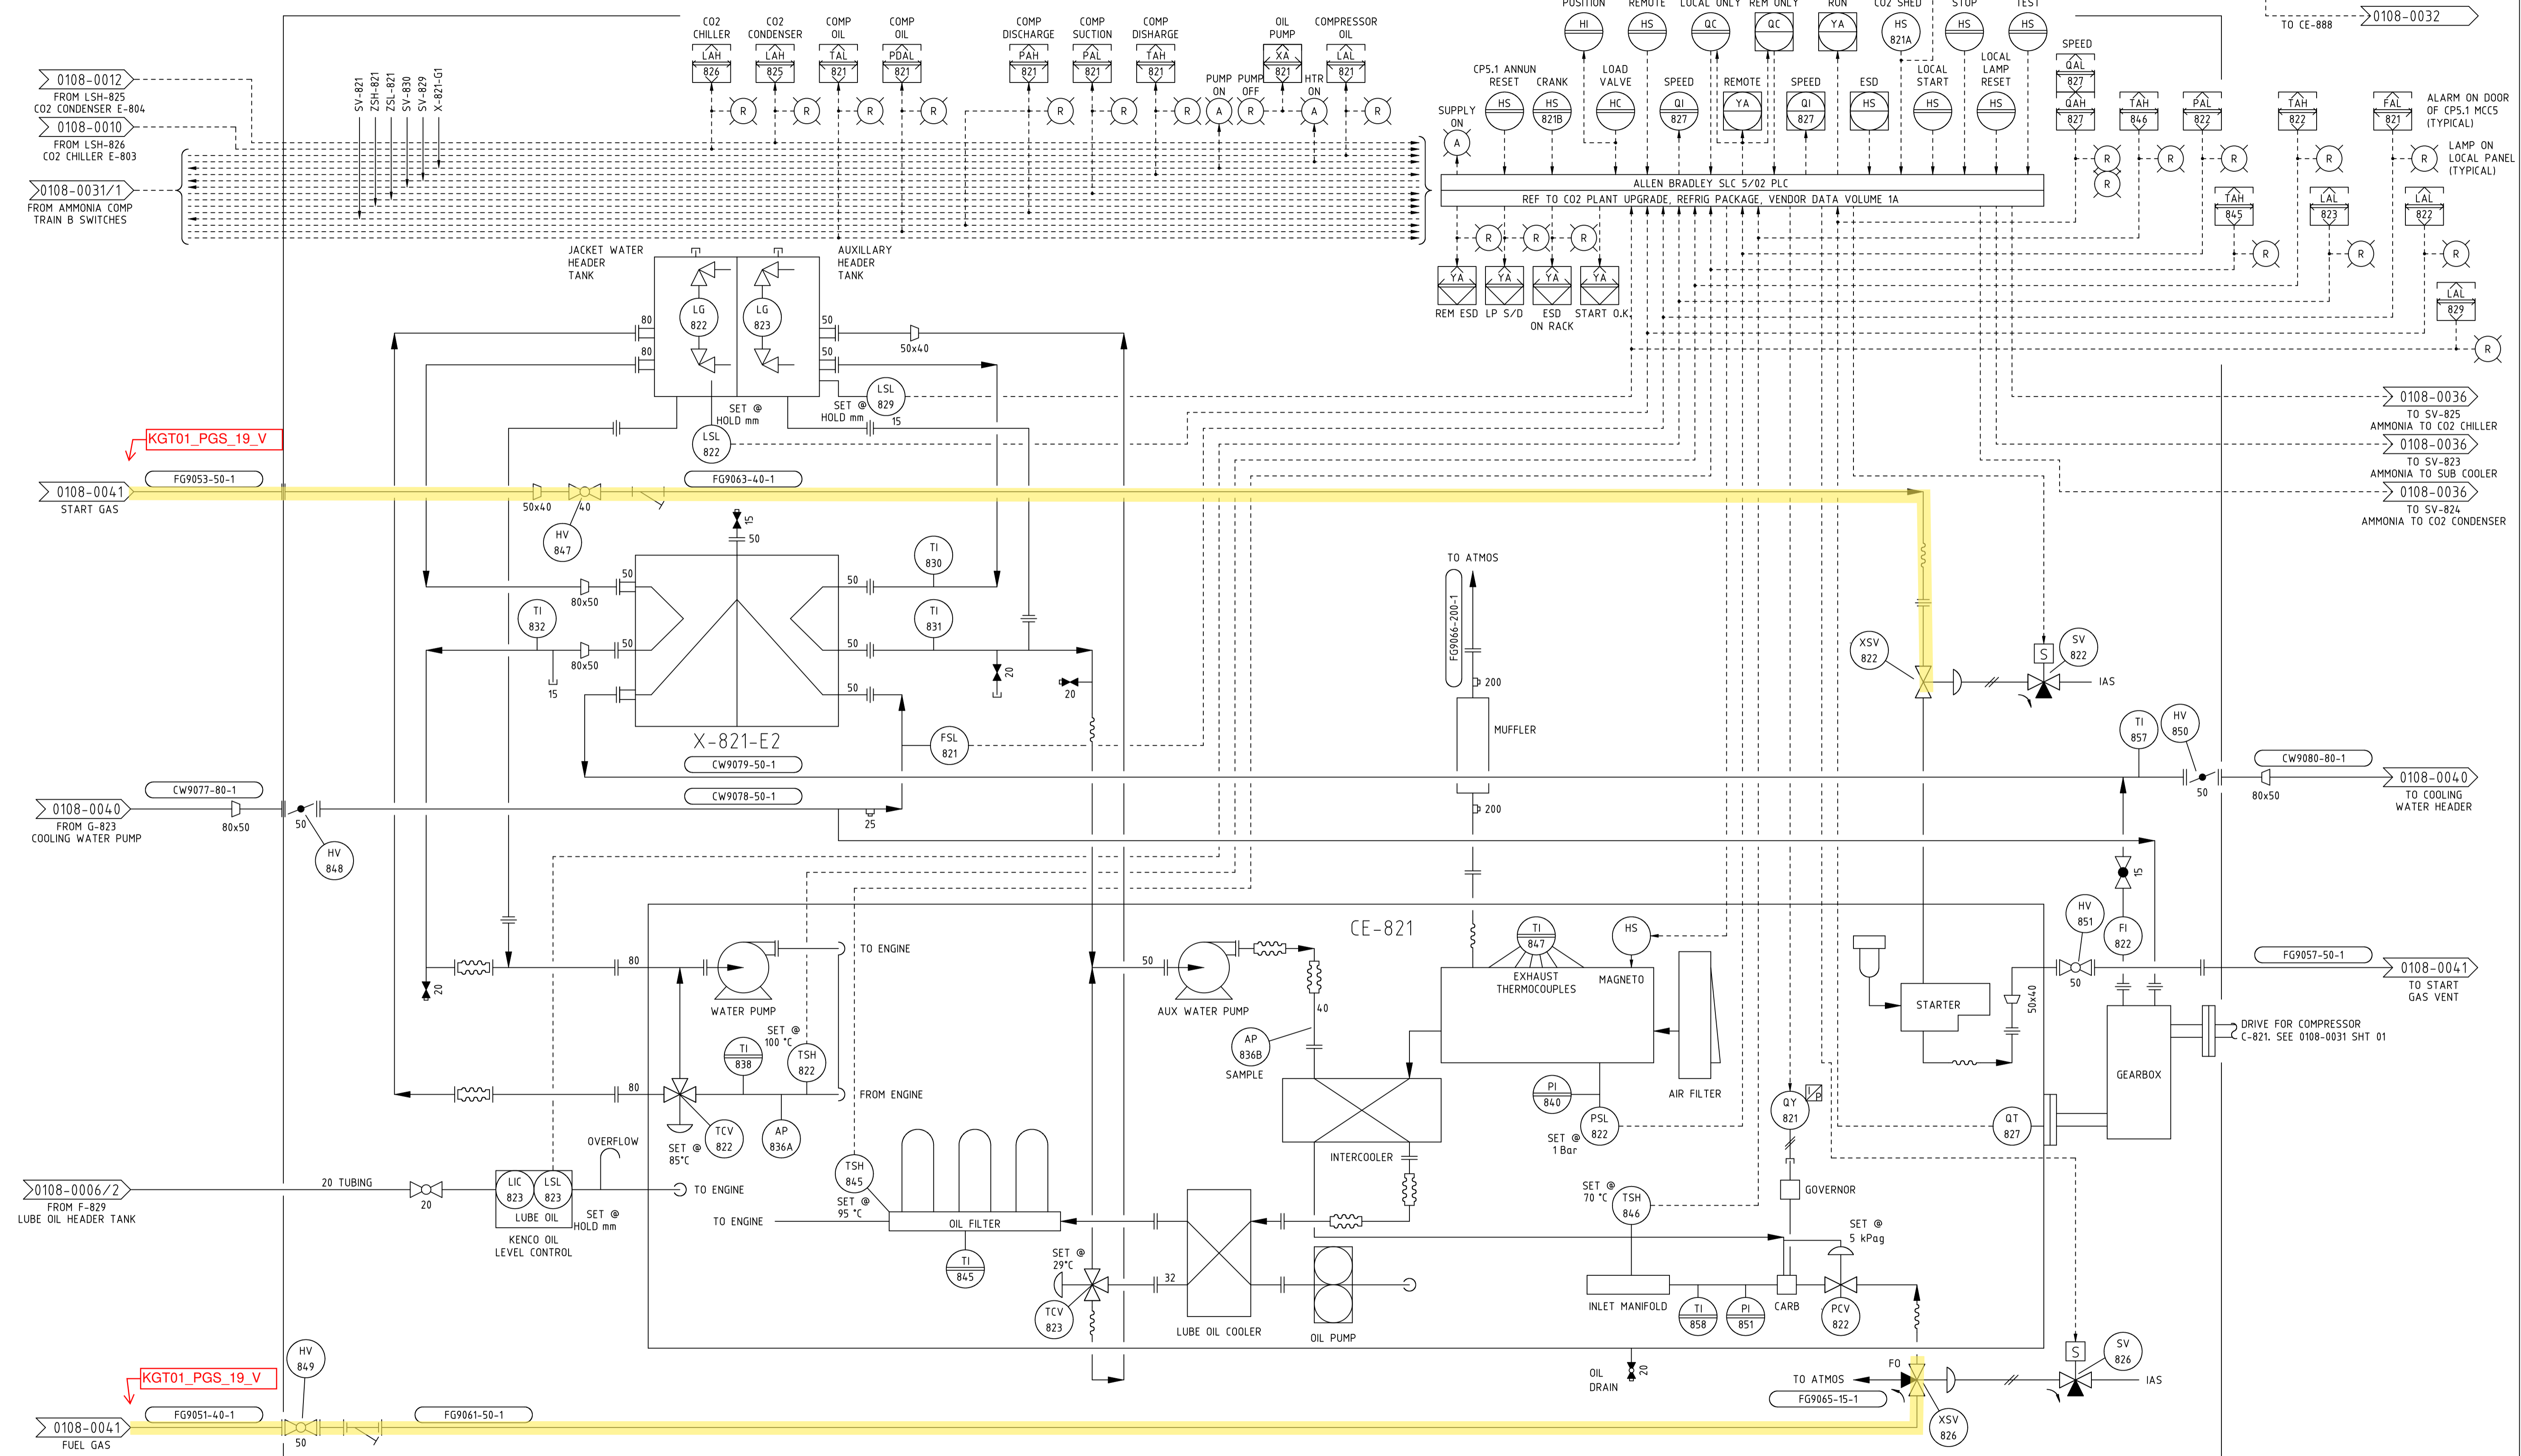

REV	AMENDMENT	BY	CHK	ENG	APP	DATE	REV	AMENDMENT	BY	CHK	ENG	APP	DATE
9	COD 0108-0041 NOTE CHANGED FROM FUEL GAS TO START GAS	RL	JCC	AM	TC	09/2019							
8	HAND VALVE NUMBERS ADDED FOR ISOLATIONS	RL	AC	AM	SES	10/2013							
7	AS BUILT FOR WS884521 CO2 UPGRADE	JMP	VB	MP	CF	09/05							
6	PROCESS ISOLATION POINTS ADDED ON INDIVIDUAL LAYERS	CMW	RL	CM	AIM	10/02							
5	TITLE BLOCKED REVISED	VB	RL	EJH	RS	10/99							
4	DRG No. WAS 0108-0032/01 AND AP-836 A & B ADDED	GMF	DV	EJH	HG	10/98							
3	REVISED FOLLOWING I&E MAINTENANCE SURVEY	J.B.H.	R.L.	AvG	A.M.B.	21/08/96							
2	AS BUILT COMMENTS INCORPORATED	V.B.	B.T.	A.V.G.	C.J.	5/95							
1	REVISED FOR CONTINUITY CHECK	J.B.H.	O.G.H.	A.V.G.	C.J.	10/94							
D	AS BUILT USING PID VERSION 11.52	B.A.T.	P.H.	J.R.	J.R.S.	04/94							

VECTOR KAPUNI LIMITED
PRIVATE BAG 2020
NEW PLYMOUTH 4342
PHONE 0800 734 567




COPYRIGHT The copyright in this document is vested in Vector Kapuni Limited
The contents of this document shall not be reproduced, either in whole or part, by any
means whatsoever without the prior written consent of Vector Kapuni Limited.

REFERENCE DRAWINGS
CAUSE & EFFECTS - 0780-0090/5
DRAWING NUMBER WAS 0108-0032/01
0108-0031/01 COMPRESSOR P&ID

CO2 RECOVERY
PIPING & INSTRUMENT DIAGRAM
TRAIN B AMMONIA COMPRESSION ENGINE CE-821

DRN	DATE	DATE
D.WHITMORE	01/05/1992	ENG
CHK		APP

SCALE:	JOB NO.	SERIES	DRG. NO	SHT	REVISION
NTS	1000000	0108	0031	02 OF 02 SHTS	9

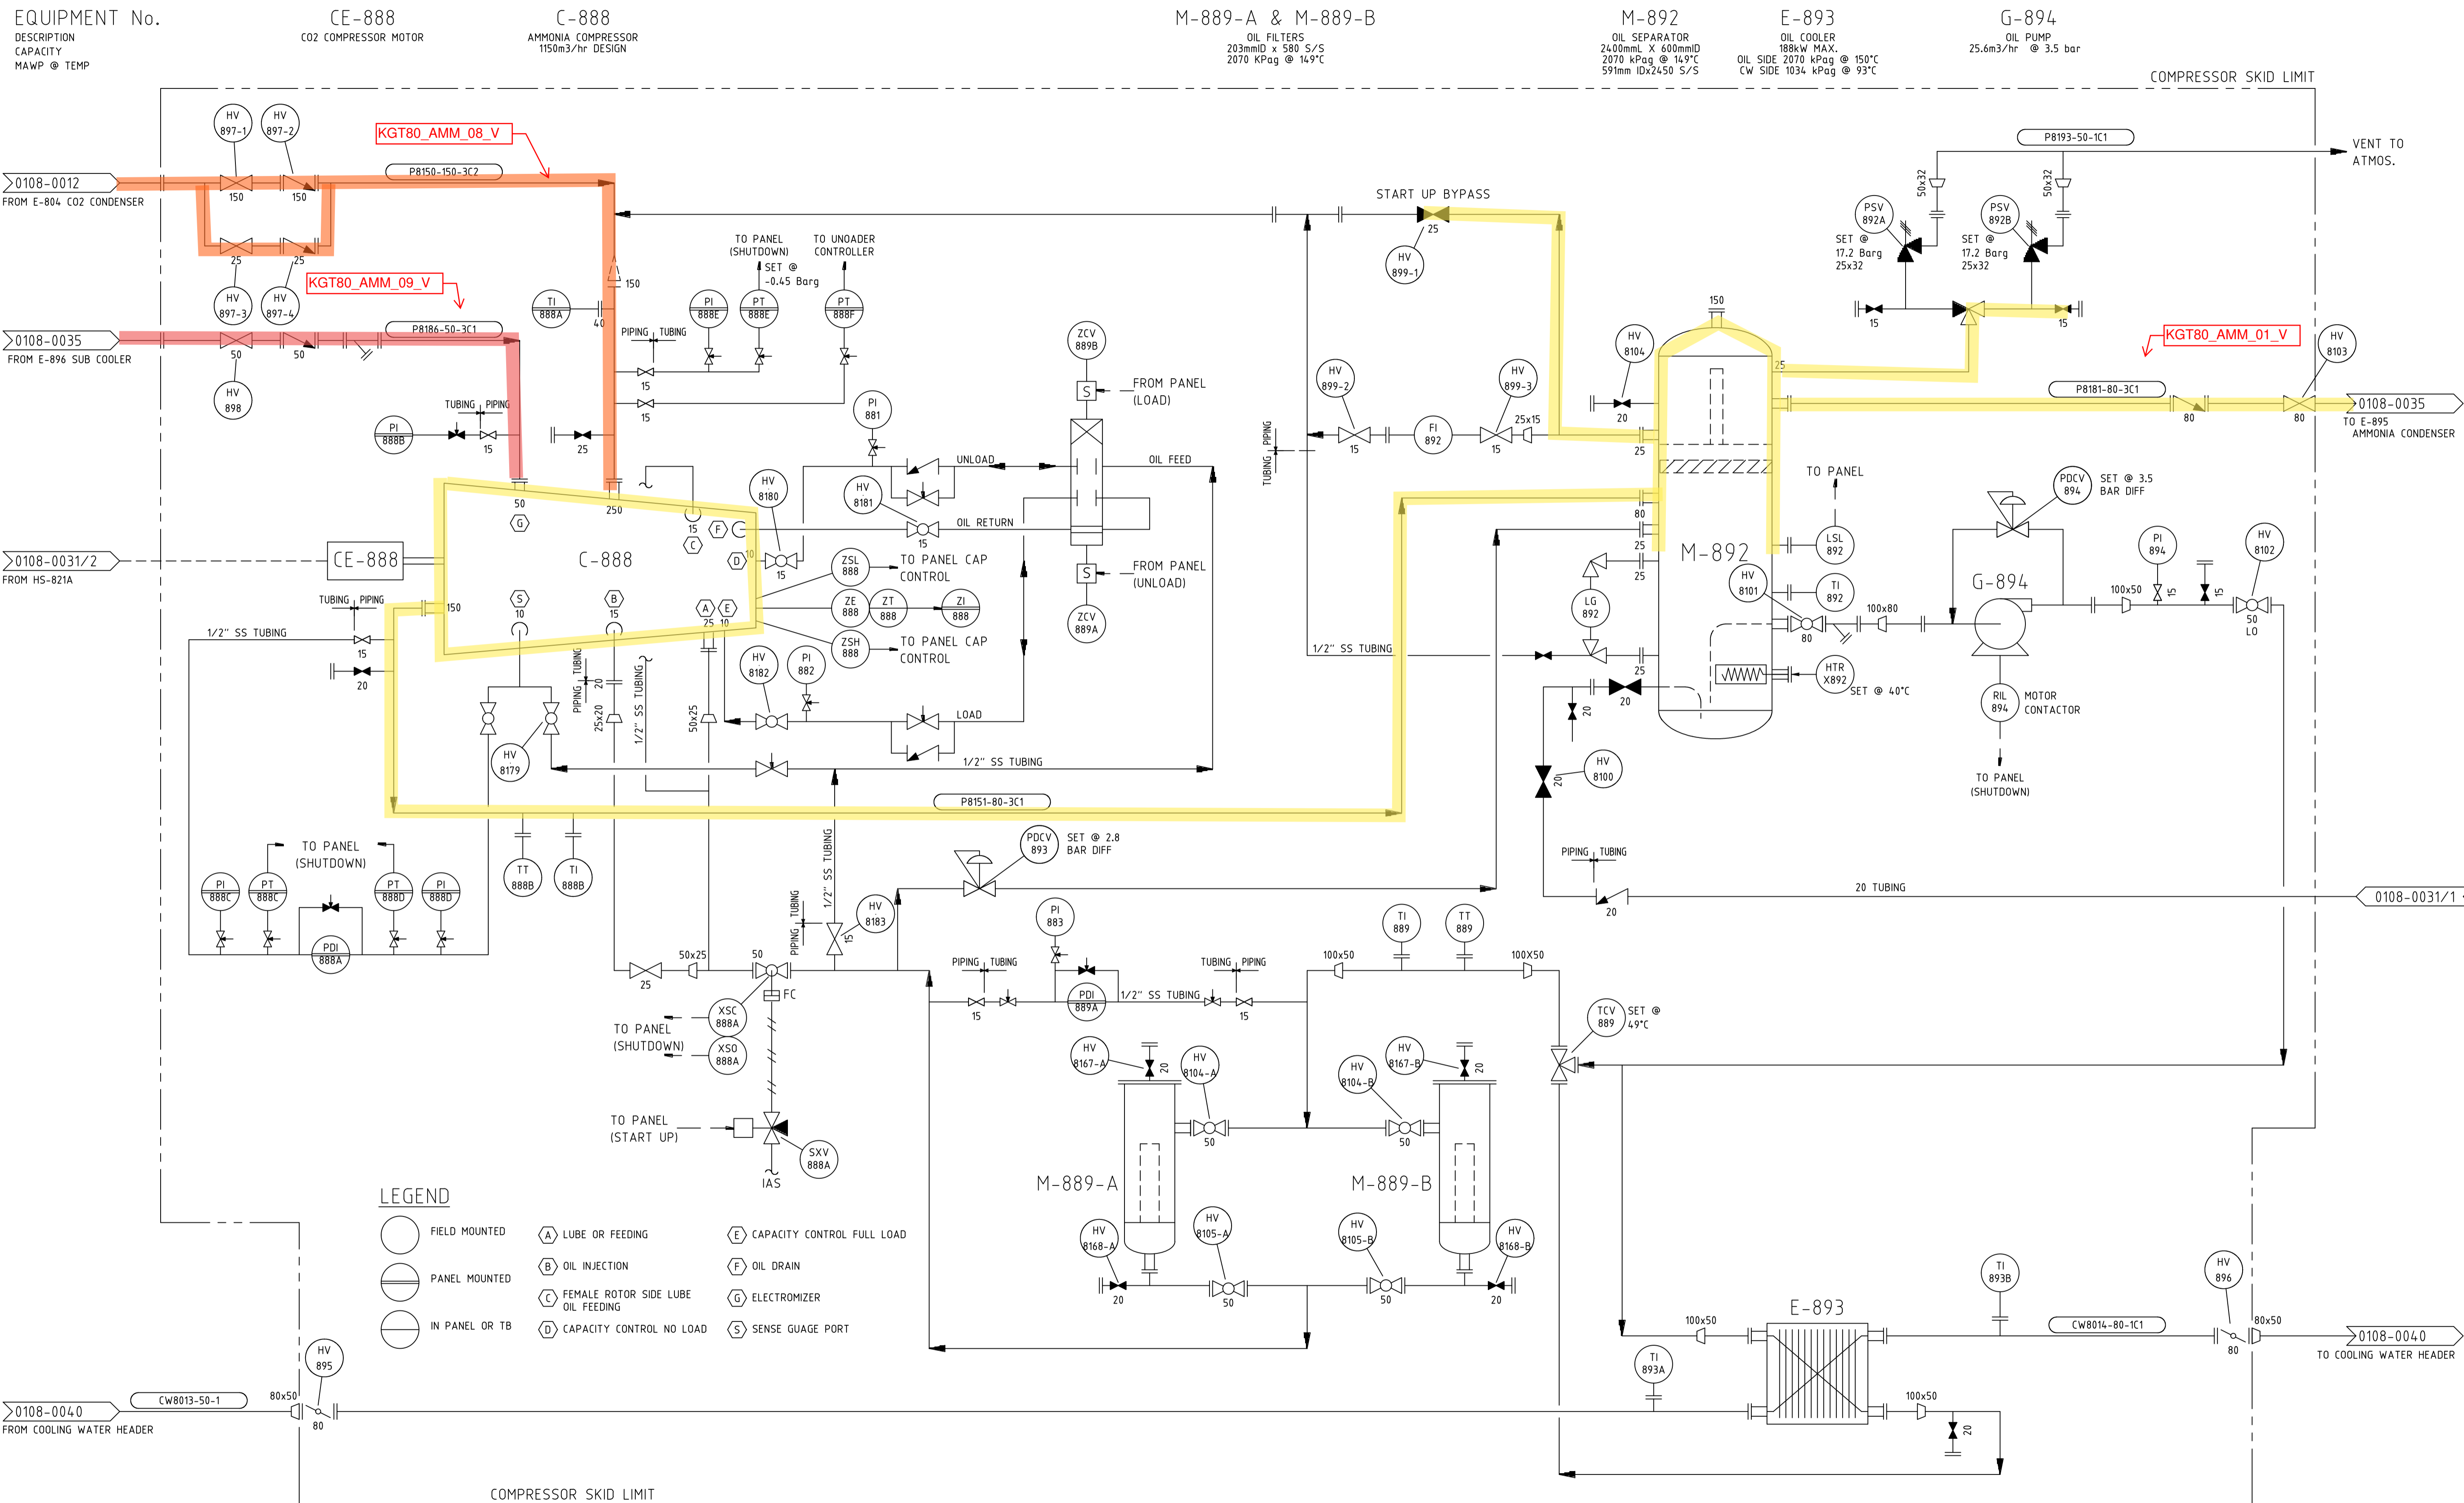

LEGEND

	FIELD MOUNTED		LUBE OR FEEDING		CAPACITY CONTROL FULL LOAD
	PANEL MOUNTED		OIL INJECTION		OIL DRAIN
	IN PANEL OR TB		FEMALE ROTOR SIDE LUBE OIL FEEDING		ELECTROMIZER
			CAPACITY CONTROL NO LOAD		SENSE GAUGE PORT

1000000-0108-0032-01.DWG

REV	AMENDMENT	BY	CHK	ENG	APP	DATE	REV	AMENDMENT	BY	CHK	ENG	APP	DATE
14	HAND VALVE NUMBERS ADDED FOR NEW ISOLATIONS	RL	JC	AM	SES	05/2016	4	M-892 HEATER SYMBOL ADDED & M-889-A WAS M-889A	RL	ES	LH	PJR	03/2007
13	VALVE NUMBERS ADDED FOR NEW ISOLATIONS	RL	JC	AM	SES	07/2015	3	LINE No. P8186 WAS P8146 & TYPO ERRORS AS BUILT	RL	ES	LH	PJR	10/2006
12	AS BUILT PI-881, 882 & 883 ADDED	RL	JCC	AM	SES	10/2014	2	AS BUILT	ES	RL	LH	PJR	06/06
11	AS BUILT P84-836 PSV-854 REMOVAL	RL	NA	AM	SES	07/2014	1	AS BUILT FOR WS884521 CO2 UPGRADE	JMP	VB	MP	CF	09/05

REV	AMENDMENT	BY	CHK	ENG	APP	DATE
10	AS BUILT PT-888E WAS -0.3 BARG	ES/RL	MY	AM	SES	03/2014
9	VALVE NUMBERS ADDED FOR ISOLATIONS	RL	CR	AM	SES	03/2014
8	TI-888B & TT-888B ADDED. PROCESS COND. OF E-893 REVISED	ES/RL	CR	AM	SES	12/12
7	20NB VLV ON TUBING TO M-892 REVISED TO NORM. CLOSED	RL/ES	RL	SRH	SES	11/2011
6	WITCHES HAT STRAINER ADDED TO P8150	ES/RL	MB	JS	SES	05/11
5	AS BUILT - PDI-889A WAS PDI-888A	ES	RL	LH	DS	11/07

VECTOR LIMITED
PRIVATE BAG 2020
NEW PLYMOUTH 4620
PHONE 0800 734 567

ssj^o

COPYRIGHT The copyright in this document is vested in Vector Limited
The contents of this document shall not be reproduced, either in whole or part, by any means whatsoever without the prior written consent of Vector Limited.

AUTOCAD ORIGINAL SHEET SIZE A1


DRN	DATE	DATE	DATE
D VOSS	01/11/2004	01/11/2004	01/11/2004
K GILKISON	01/11/2004	01/11/2004	01/11/2004

REFERENCE DRAWINGS
CAUSE & EFFECTS - 0780-0090/4


CO2 RECOVERY
PIPING & INSTRUMENT DIAGRAM
AMMONIA COMPRESSION TRAIN A


SCALE:	JOB NO.	SERIES	DRG. NO	SHT	REVISION
NTS	1000000	0108	0032	01 OF 01 SHTS	14

EQUIPMENT No.
DESCRIPTION
CAPACITY
MAWP @ TEMP

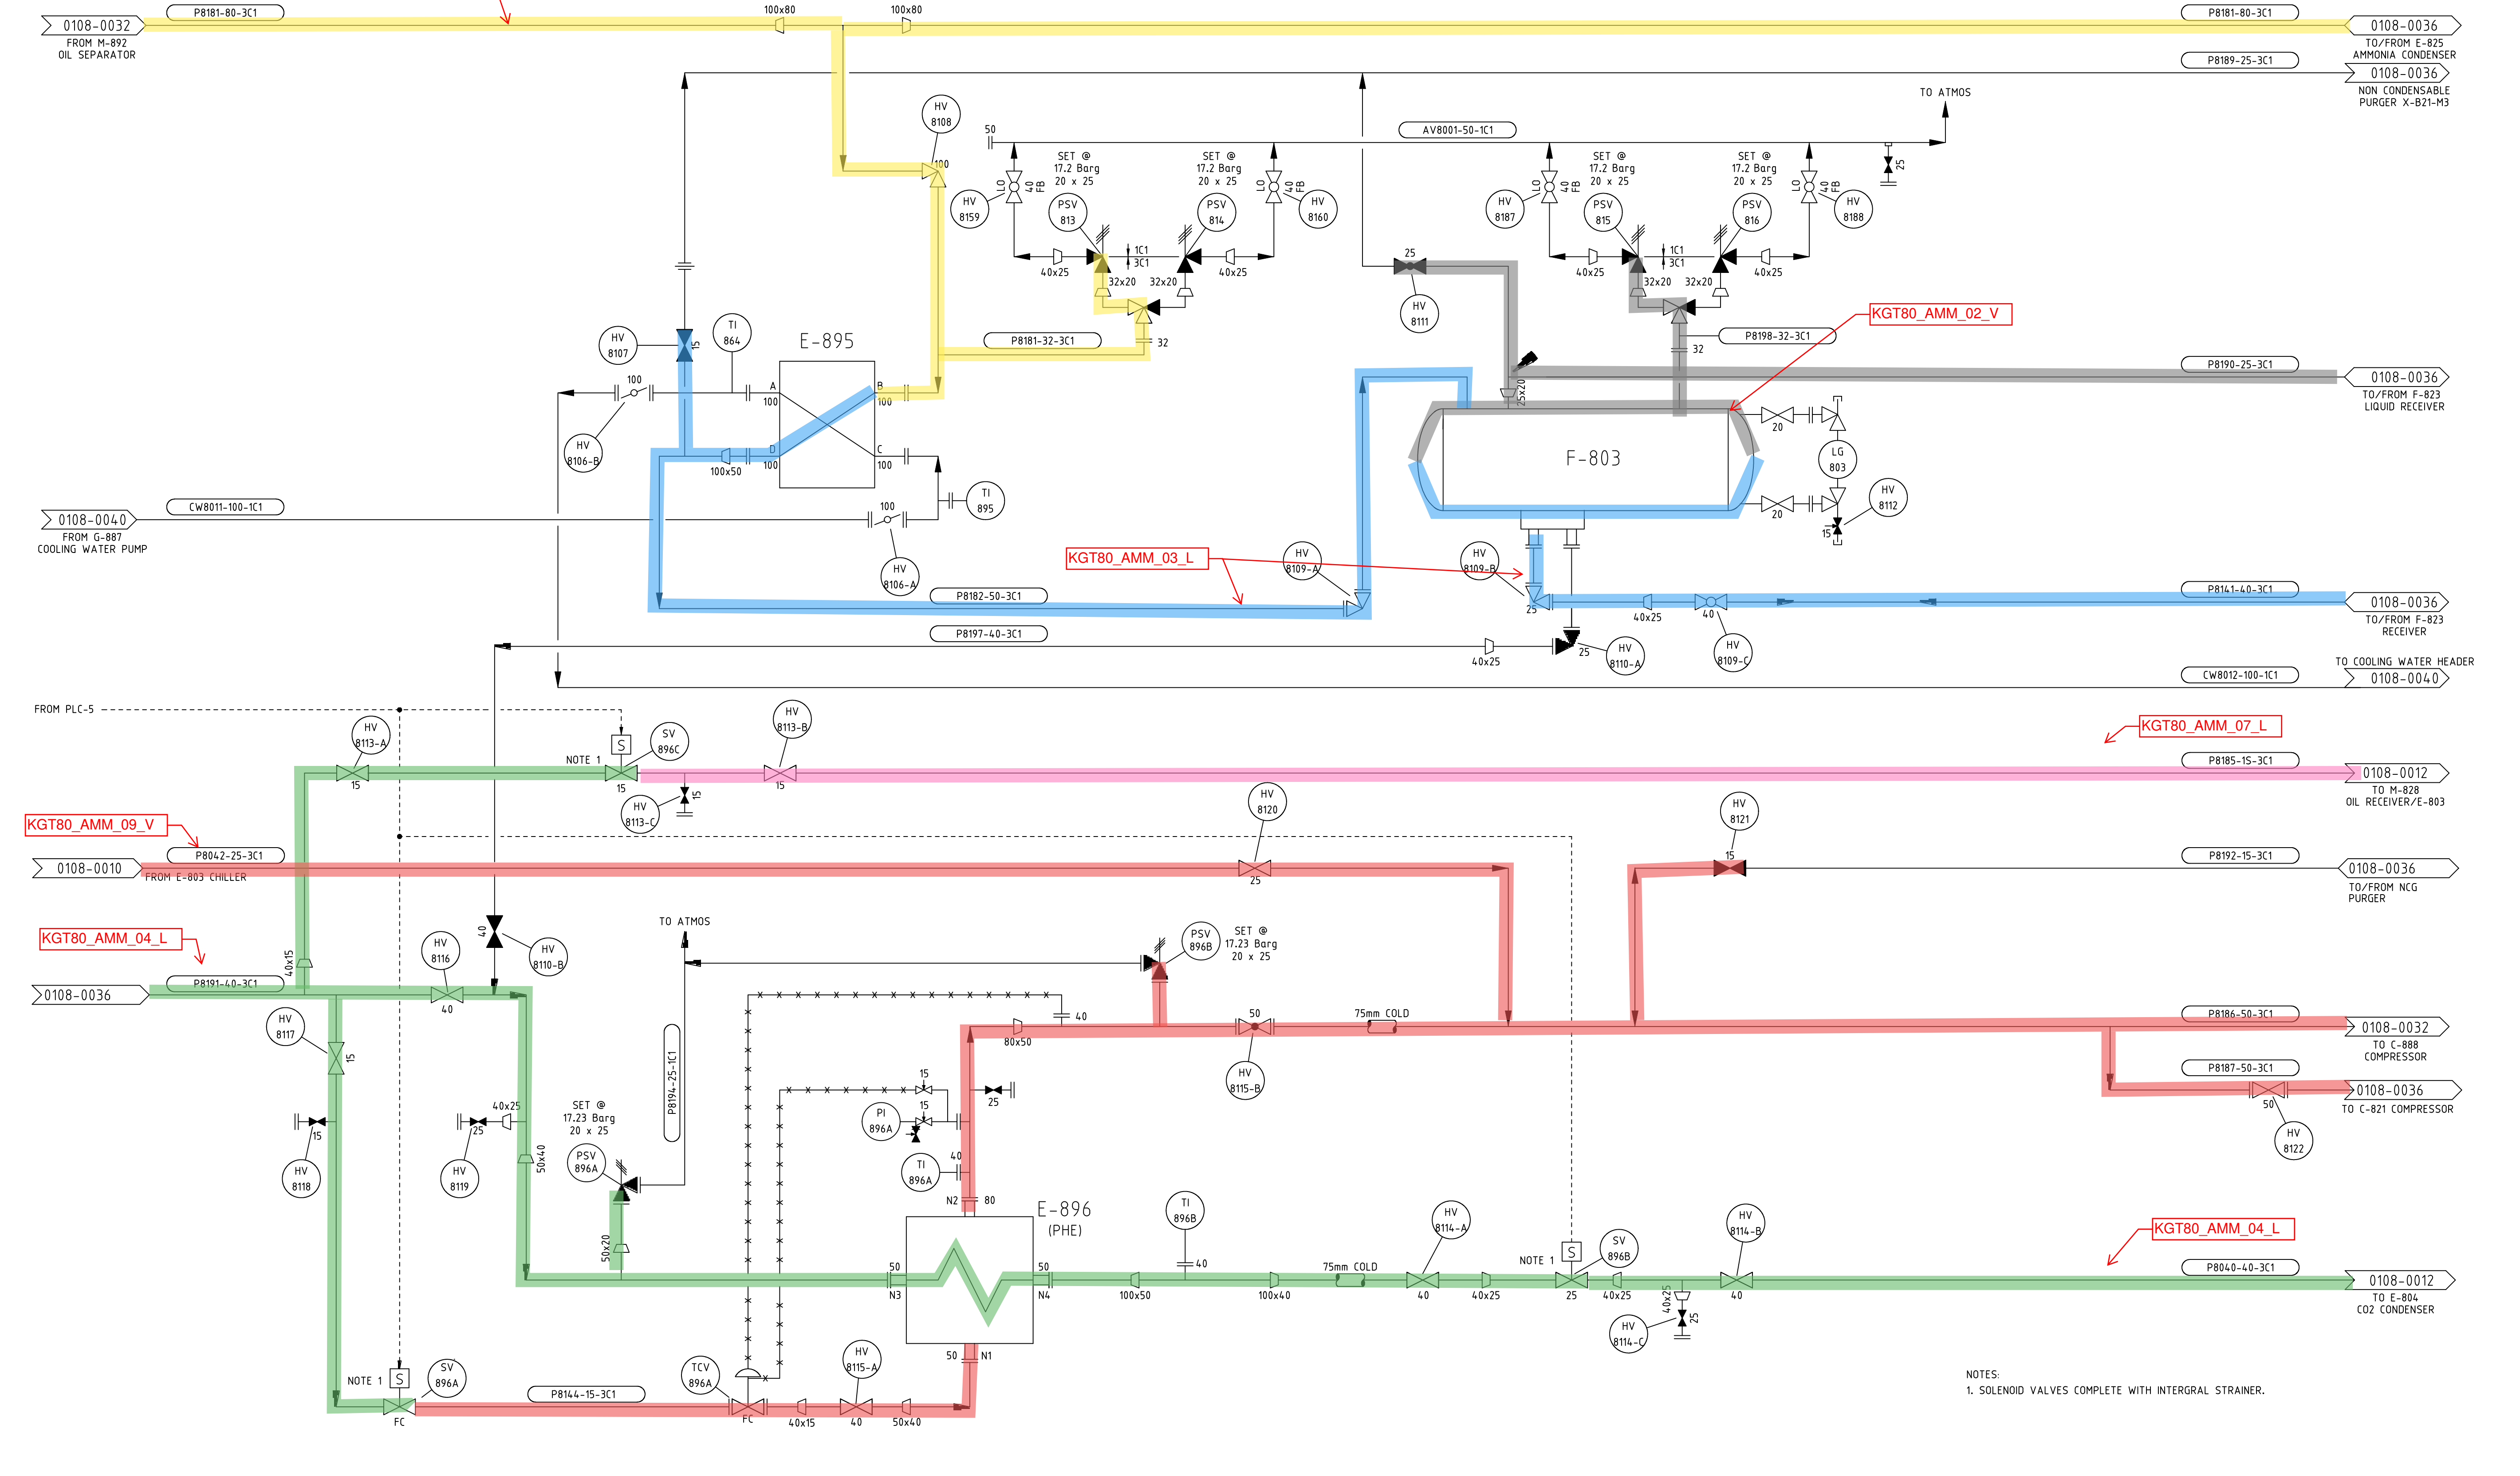

NOTES:
1. SOLENOID VALVES COMPLETE WITH INTEGRAL STRAINER.

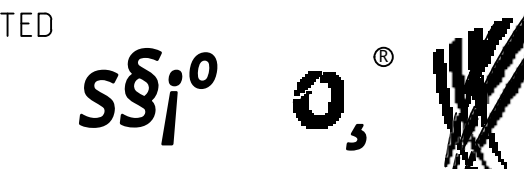16	AS BUILT P84-859 CO2 PLANT AMMONIA SAFETY VALVES	JB	CJ	AM	SES	11/13	VECTOR KAPUNI LIMITED PRIVATE BAG 2020 NEW PLYMOUTH 4342 PHONE 0800 734 567 	REFERENCE DRAWINGS DRAWING NUMBER WAS 0108-0006/01	CO2 RECOVERY PIPING & INSTRUMENT DIAGRAM AMMONIA CONDENSING TRAIN A CONDENSER SUB-COOLER										
15	40NB VALVE ADDED TO P8197-40-3C1 & VENT RELOCATED	RL	ES	LH	SES	07/2008			DRN	P.MILLS	DATE	DATE	SCALE:	JOB NO.	SERIES	DRG. NO	SHT	OF	REVISION
14	AS BUILT WS1014156 LG-803 REPLACEMENT	RL	JM	LH	PJR	02/06			CHK	R.LOGAN	28/04/1980	APP		NTS	1000000	0108	0035	01	19
13	AS BUILT FOR WS884521 CO2 UPGRADE	JMP	VB	MP	CF	09/05													
12	PROCESS ISOLATION POINTS ADDED ON INDIVIDUAL LAYERS	CMW	RL	CM	AIM	10/02													
11	PSV SET POINTS & DESIGN DATA RATIONALISED	GJH	RL	AVG	AIM	09/02													
10	DRAWING NUMBER WAS 0108-0006/01	GMF	DV	EJH	MB	10/98													
9	AS BUILT COMMENTS INCORPORATED	V.B	B.T.	A.V.G.	C.J.	5/95													
18	HAND VALVES HV-8107 & HV-8111 WERE SHOWN NORMALLY OPEN	RL	JA	AM	SES	11/2014													
17	HAND VALVE NUMBERS ADDED FOR ISOLATIONS	RL	CR	AM	SES	03/2014													
REV	AMENDMENT	BY	CHK	ENG	APP	DATE	REV	AMENDMENT	BY	CHK	ENG	APP	DATE	AUTOCAD	ORIGINAL SHEET SIZE				

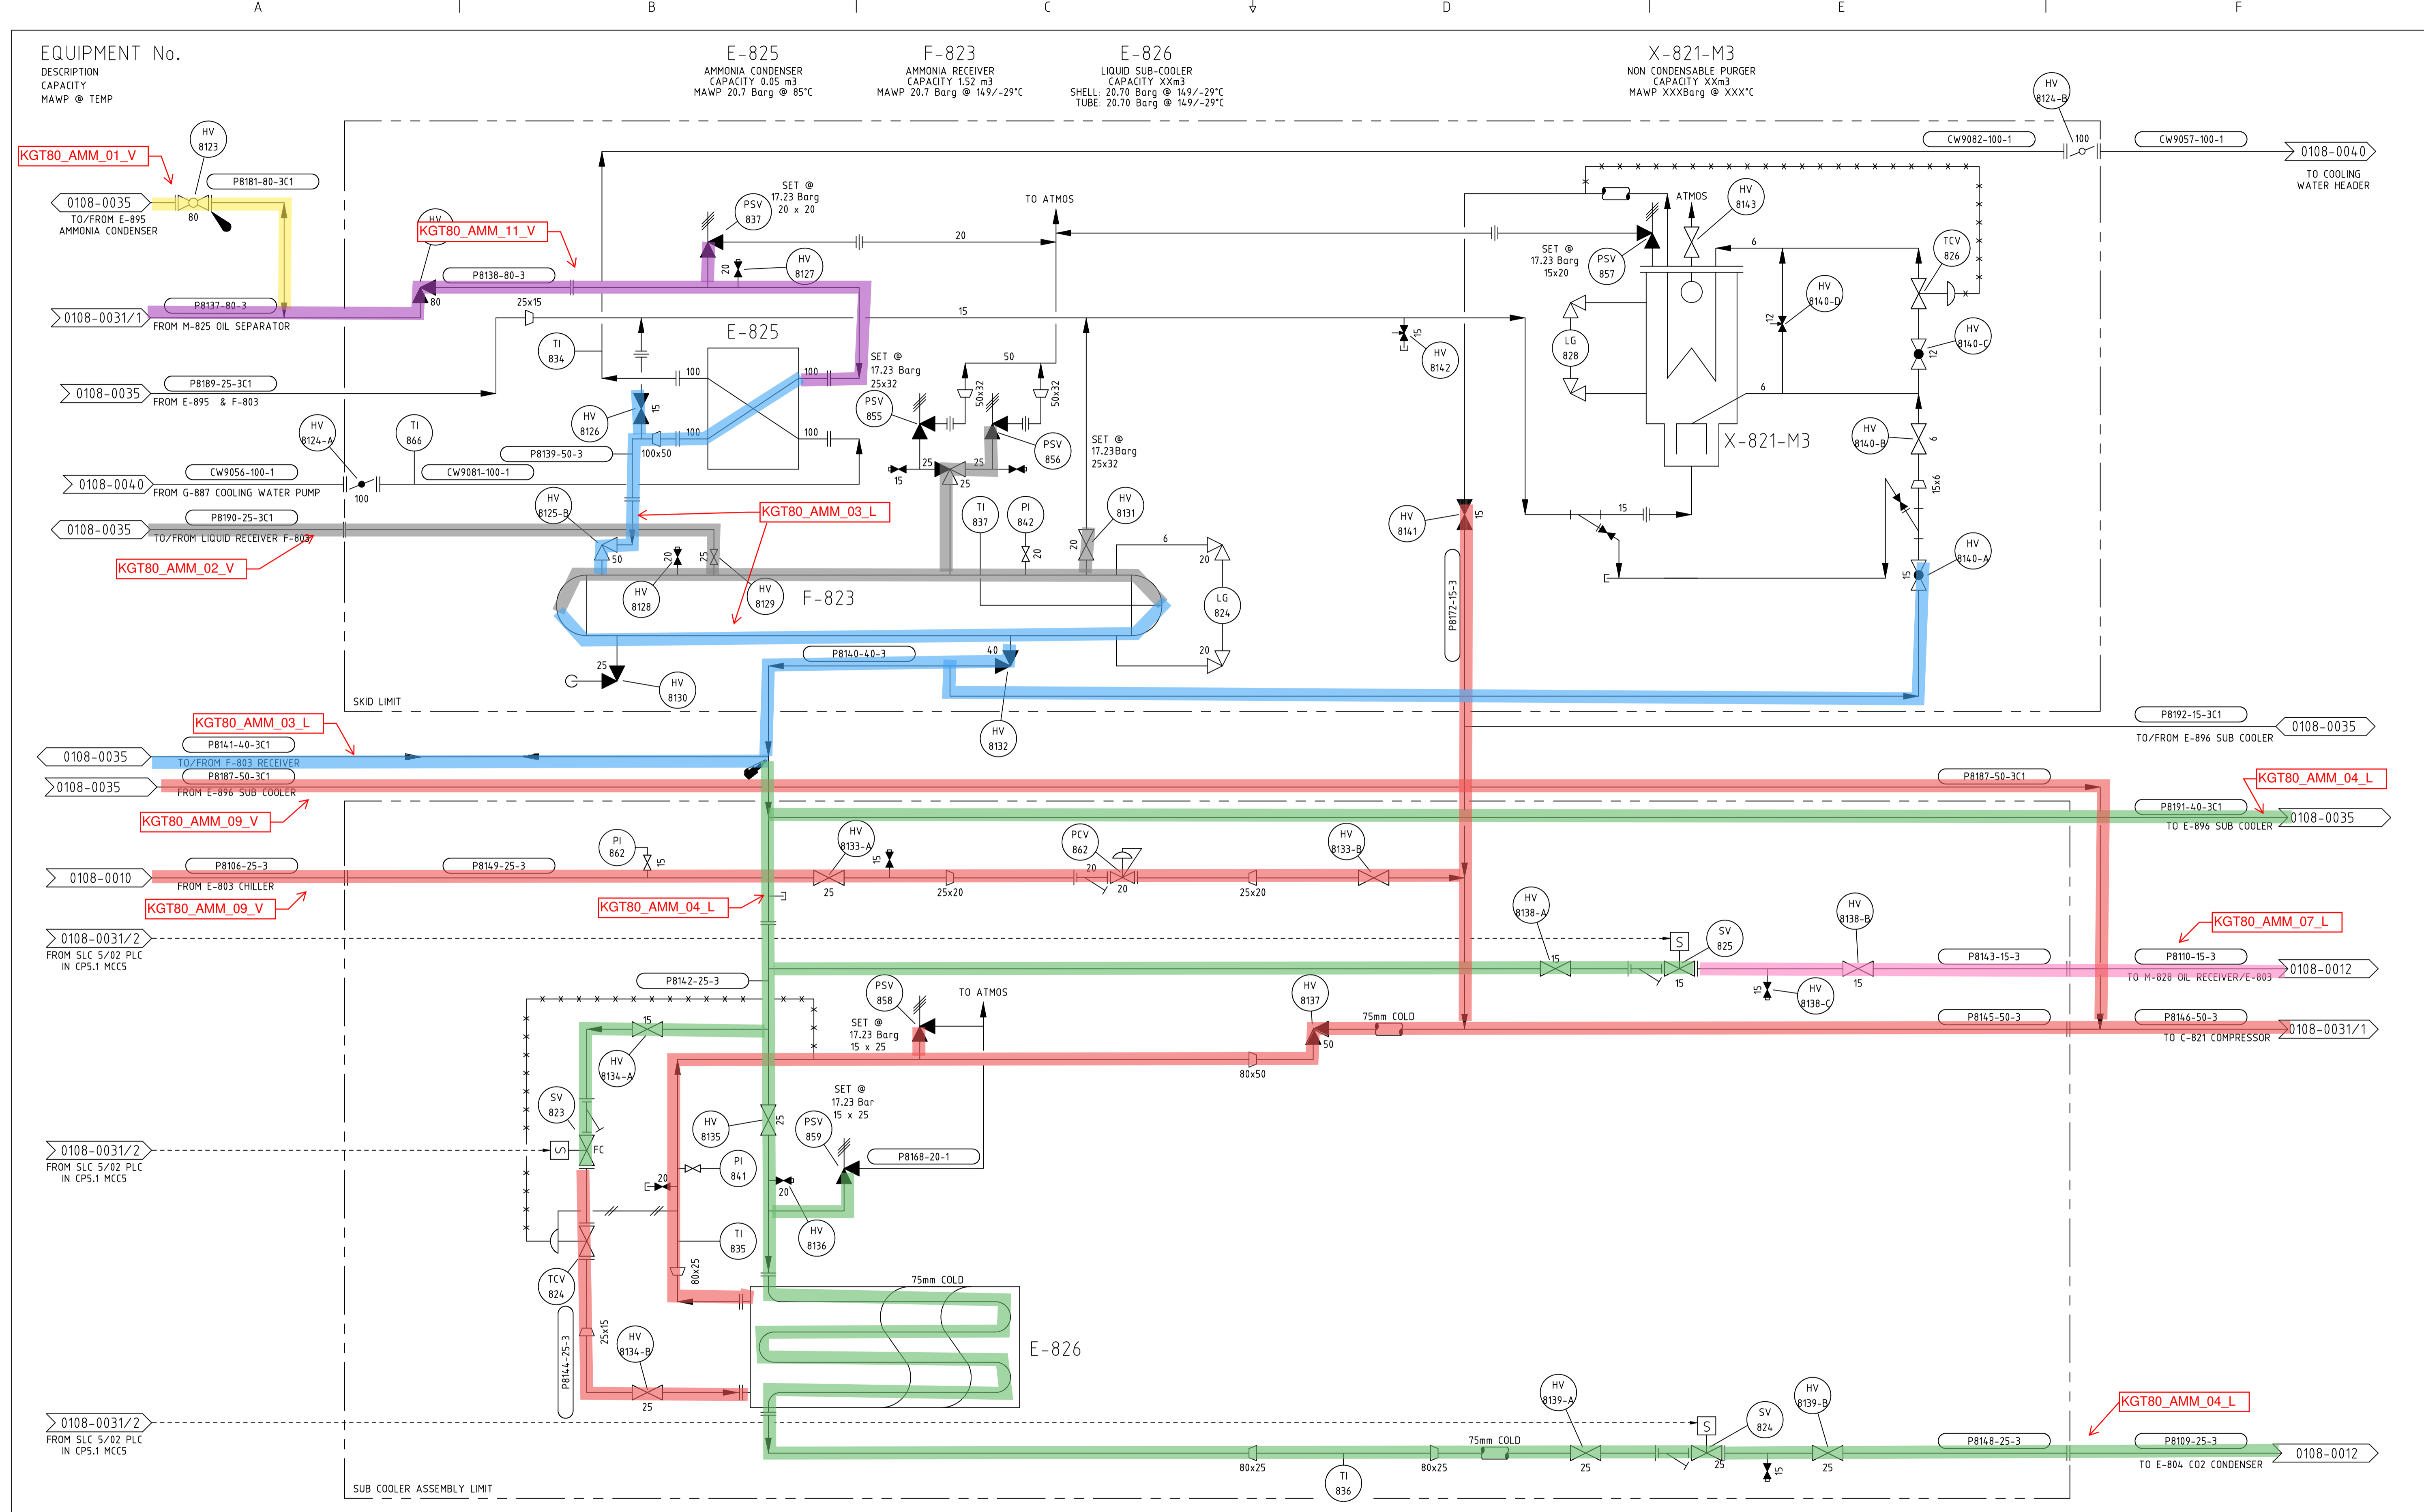

EQUIPMENT No.
DESCRIPTION
CAPACITY
MAWP @ TEMP

E-825
AMMONIA CONDENSER
CAPACITY 0.05 m³
MAWP 20.7 Barg @ 85°C

F-823
AMMONIA RECEIVER
CAPACITY 1.52 m³
MAWP 20.7 Barg @ 14.9/-29°C

E-826
LIQUID SUB-COOLER
CAPACITY XXm³
SHELL: 20.70 Barg @ 14.9/-29°C
TUBE: 20.70 Barg @ 14.9/-29°C

X-821-M3
NON CONDENSABLE PURGER
CAPACITY XXm³
MAWP XXXBarg @ XXX°C

REV	AMENDMENT	BY	CHK	ENG	APP	DATE	REV	AMENDMENT	BY	CHK	ENG	APP	DATE
9	AS BUILT FOR W5884521 CO2 UPGRADE	JMP	VB	MP	CF	09/05							
8	PROCESS ISOLATION POINTS ADDED ON INDIVIDUAL LAYERS	CMW	RL	CM	AIM	10/02							
7	DESIGN DATA RATIONALISED	GJH	DJP	AvG	AIM	09/02							
6	AS BUILT	VB	RL	EJH	RJW	09/00							
5	PSV-857 ADDED	VB	RL	EJH	RS	10/99							
4	DRG No. WAS 0108-0031/01 & PROCESS CONDITIONS ADDED	GMF	DV	EJH	HG	10/98							
3	PCV-823 SET PRESS NOW 1.6 & SOLENOID SIGNALS ADDED	J.B.H.	R.L.	AvG	A.M.B.	21/08/96							
2	AS BUILT COMMENTS INCORPORATED	V.B.	B.T.	A.V.G.	C.J.	5/95							
1	REVISED FOR CONTINUITY CHECK	J.B.H.	O.G.M.	A.V.G.	C.J.	10/94							
0	AS BUILT USING PID VERSION 11.52	B.A.T.	P.H.	J.R.	J.R.S.	04/94							

VECTOR KAPUNI LIMITED
PRIVATE BAG 2020
NEW PLYMOUTH 4342
PHONE 0800 734 567


sjio

COPYRIGHT The copyright in this document is vested in Vector Kapuni Limited
The contents of this document shall not be reproduced, either in whole or part, by any
means whatsoever without the prior written consent of Vector Kapuni Limited.

AUTOCAD ORIGINAL SHEET SIZE A1

DRN	D.WHITMORE	DATE	17/03/1994	ENG	DATE
CHK				APP	

SCALE:	JOB NO.	SERIES	DRG. NO	SHT 01	REVISION
NTS	1000000	0108	0036	01	15

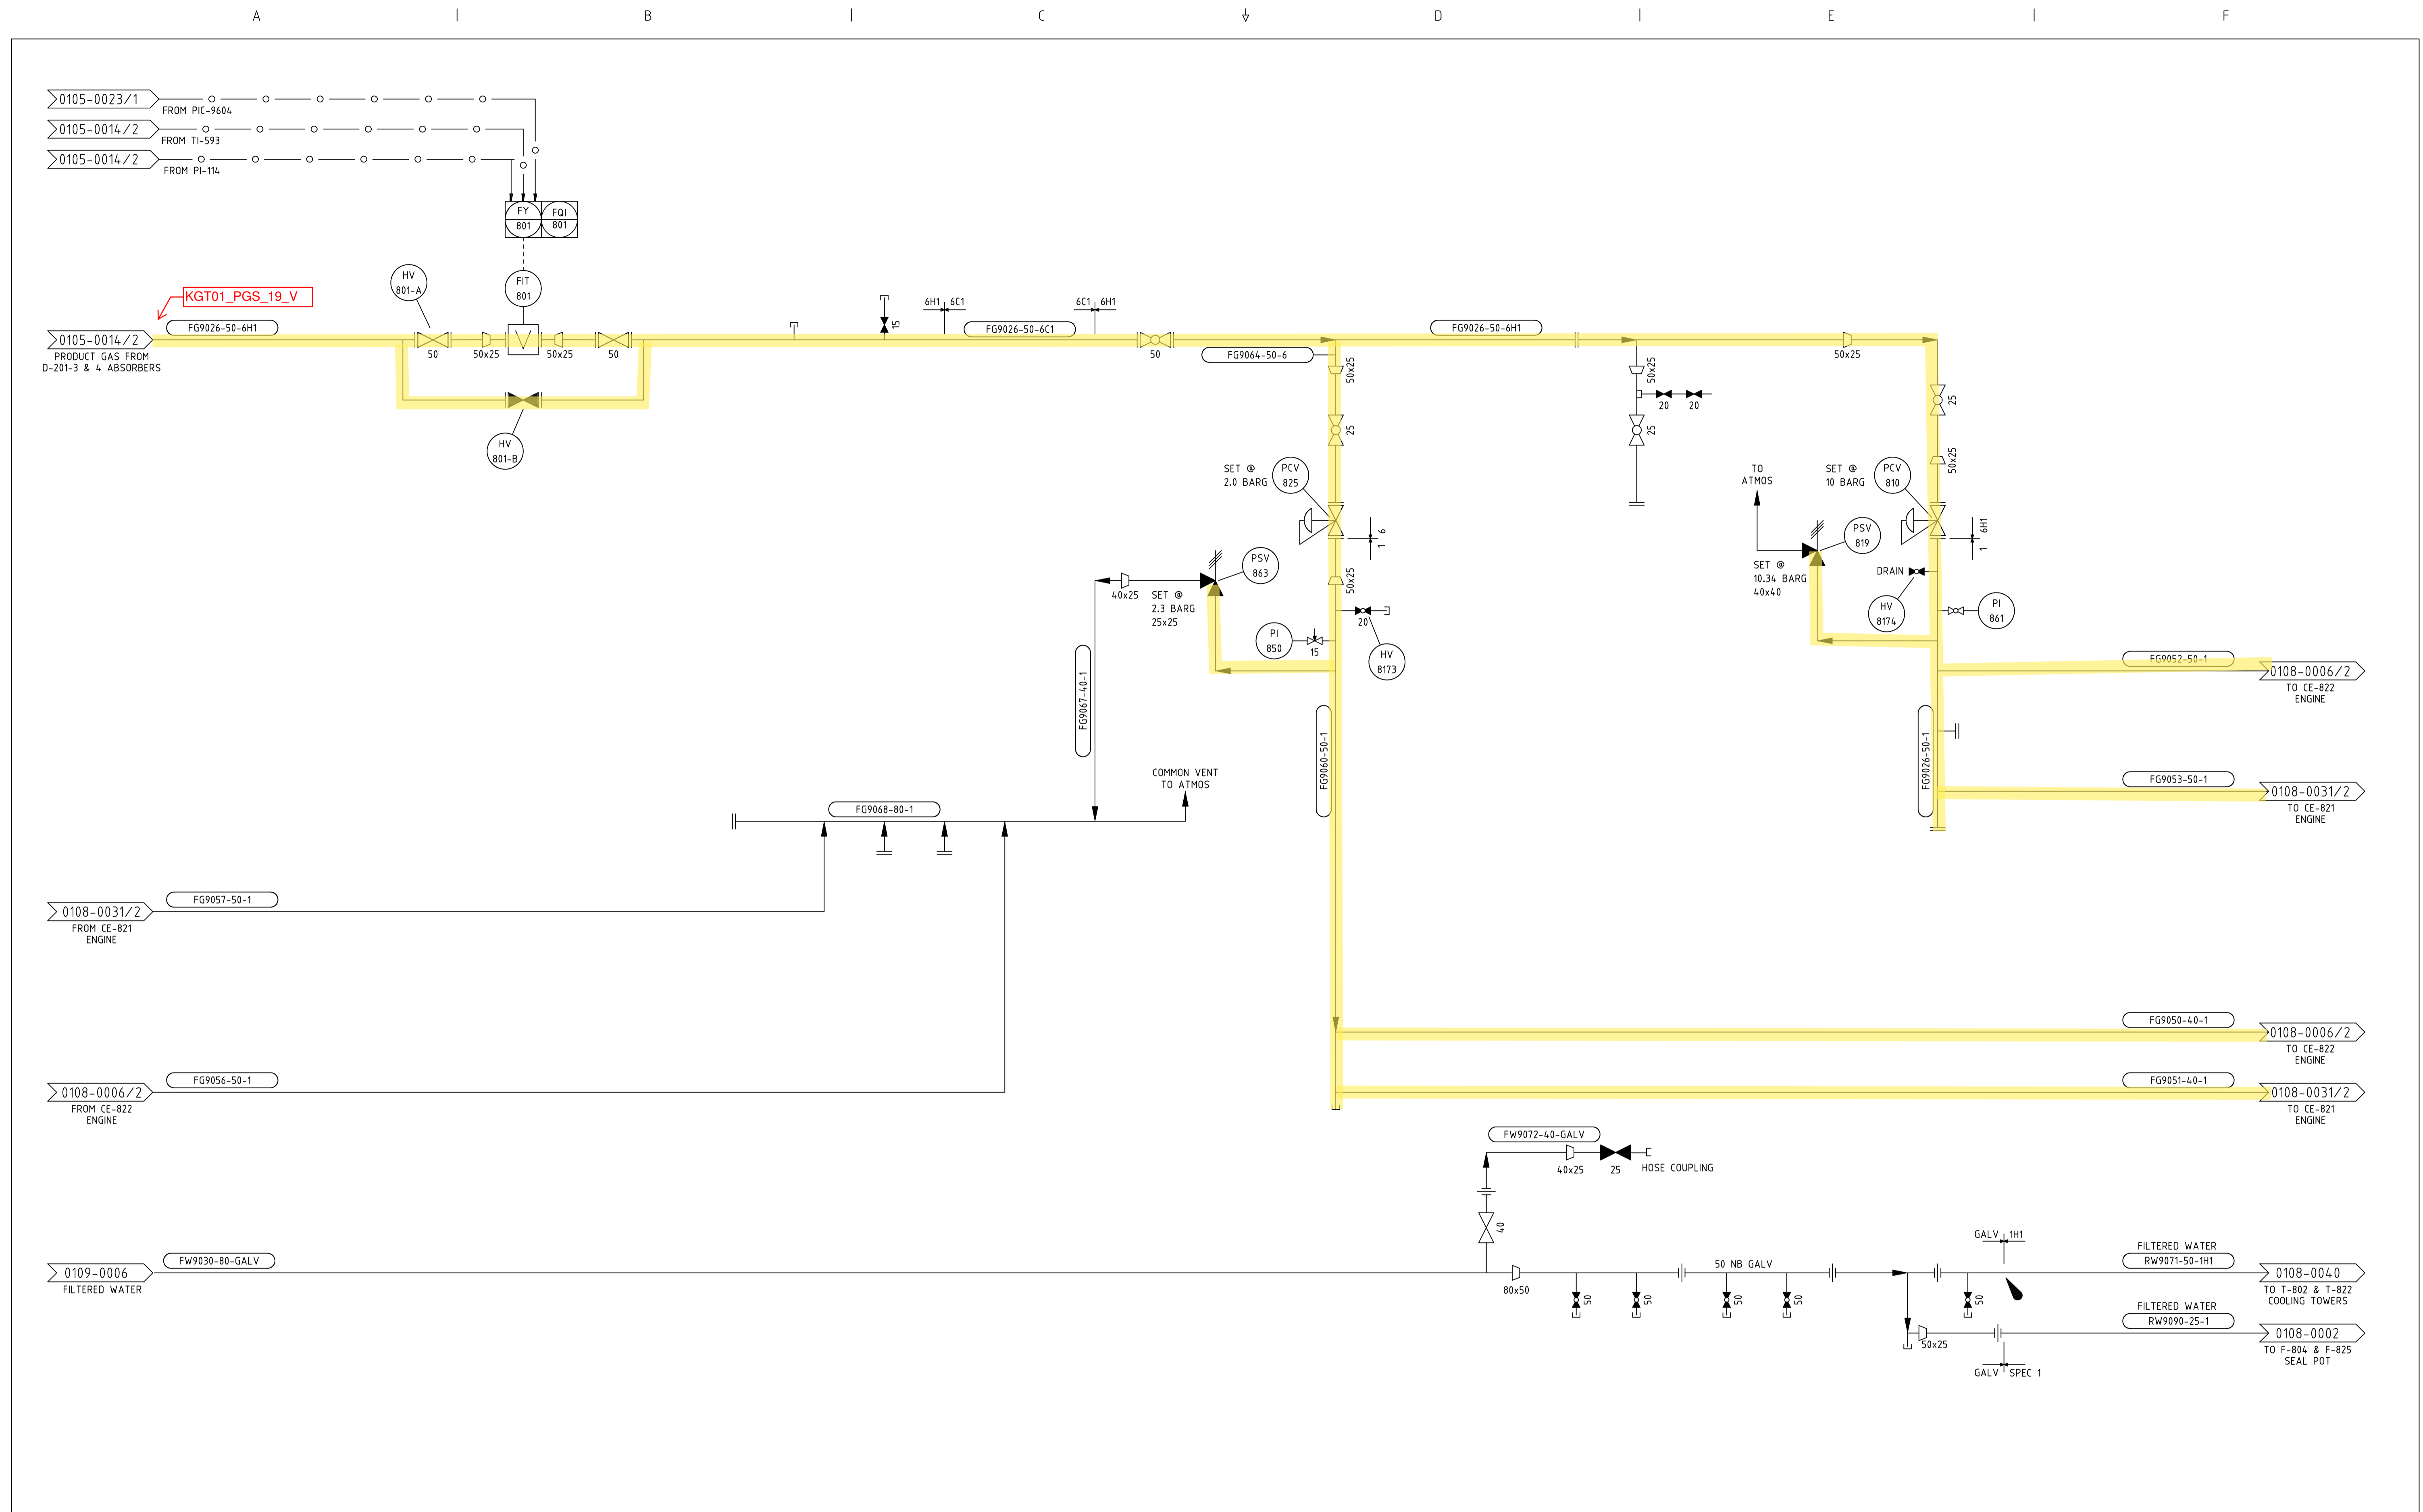

REV	AMENDMENT	BY	CHK	ENG	APP	DATE	REV	AMENDMENT	BY	CHK	ENG	APP	DATE
10	AS BUILT WS185498 DEMO PRIMARY COOLING TOWER T-821	RL	ES	LH	PJR	05/2006							
9	AS BUILT FOR WS884521 CO2 UPGRADE VO12	WXB	PR	MP	LH	02/06							
8	AS BUILT FILTERED WATER LINE WAS TO 0109-0024	RL	ES	LH	PJR	09/2005							
7	AS BUILT FOR WS884521 CO2 UPGRADE	JMP	VB	MP	CF	09/05							
6	PROCESS ISOLATION POINTS ADDED ON INDIVIDUAL LAYERS	CMW	RL	CM	AIM	10/02							
5	DRG No. WAS 0108-0026/01 & FILT'D WATER LINE ADDED	GMF	DV	EJH	HG	10/98							
14	HAND VALVE No's ADDED FOR ISOLATIONS & PIPE SPEC REVISED	RL	JCC	AM	TC	11/2016							
13	P&ID SPLITTING CONTINUATION FROM 0105-0014-02	JCC	RL	AM	SES	06/2016							
12	CONTIN. DRG. No. REVISED FOR EXPORT COMPRESSOR RE-NUMBERING	RL/ES	MH	AM	SES	05/2012							
11	AS BUILT FOR WS993217 FT-114 TO CUSTOMER METER STD.	VB	LH	MP	PJR	03/07							

VECTOR KAPUNI LIMITED
 PRIVATE BAG 2020
 NEW PLYMOUTH 4342
 PHONE 0800 734 567

sjio

COPYRIGHT The copyright in this document is vested in Vector Kapuni Limited
 The contents of this document shall not be reproduced, either in whole or part, by any
 means whatsoever without the prior written consent of Vector Kapuni Limited.

AUTOCAD ORIGINAL SHEET SIZE A1

REFERENCE DRAWINGS		DATE		DATE	
DRN	P.MILLS	28/04/1980	ENG		
CHK	R.LOGAN	28/04/1980	APP		

CO2 RECOVERY PIPING & INSTRUMENT DIAGRAM FUEL GAS & RAW WATER					
SCALE:	JOB NO.	SERIES	DRG. NO	SHT	REVISION
NTS	1000000	0108	0041	01 OF 01 SHTS	14

EQUIPMENT No.

DESCRIPTION
CAPACITY
MAWP @ TEMP

BG-901-1
BOILER STACK


B-901-1
BOILER

204.12 kg/hr
BOILER DRUM DESIGN PRESSURE 35.85 Barg @ 274°C
SUPERHEATER DESIGN PRESSURE 35.85 Barg @ 343°C


COOLING WATER SUPPLY
RW9014-15-011

0109-0010

0109-0023

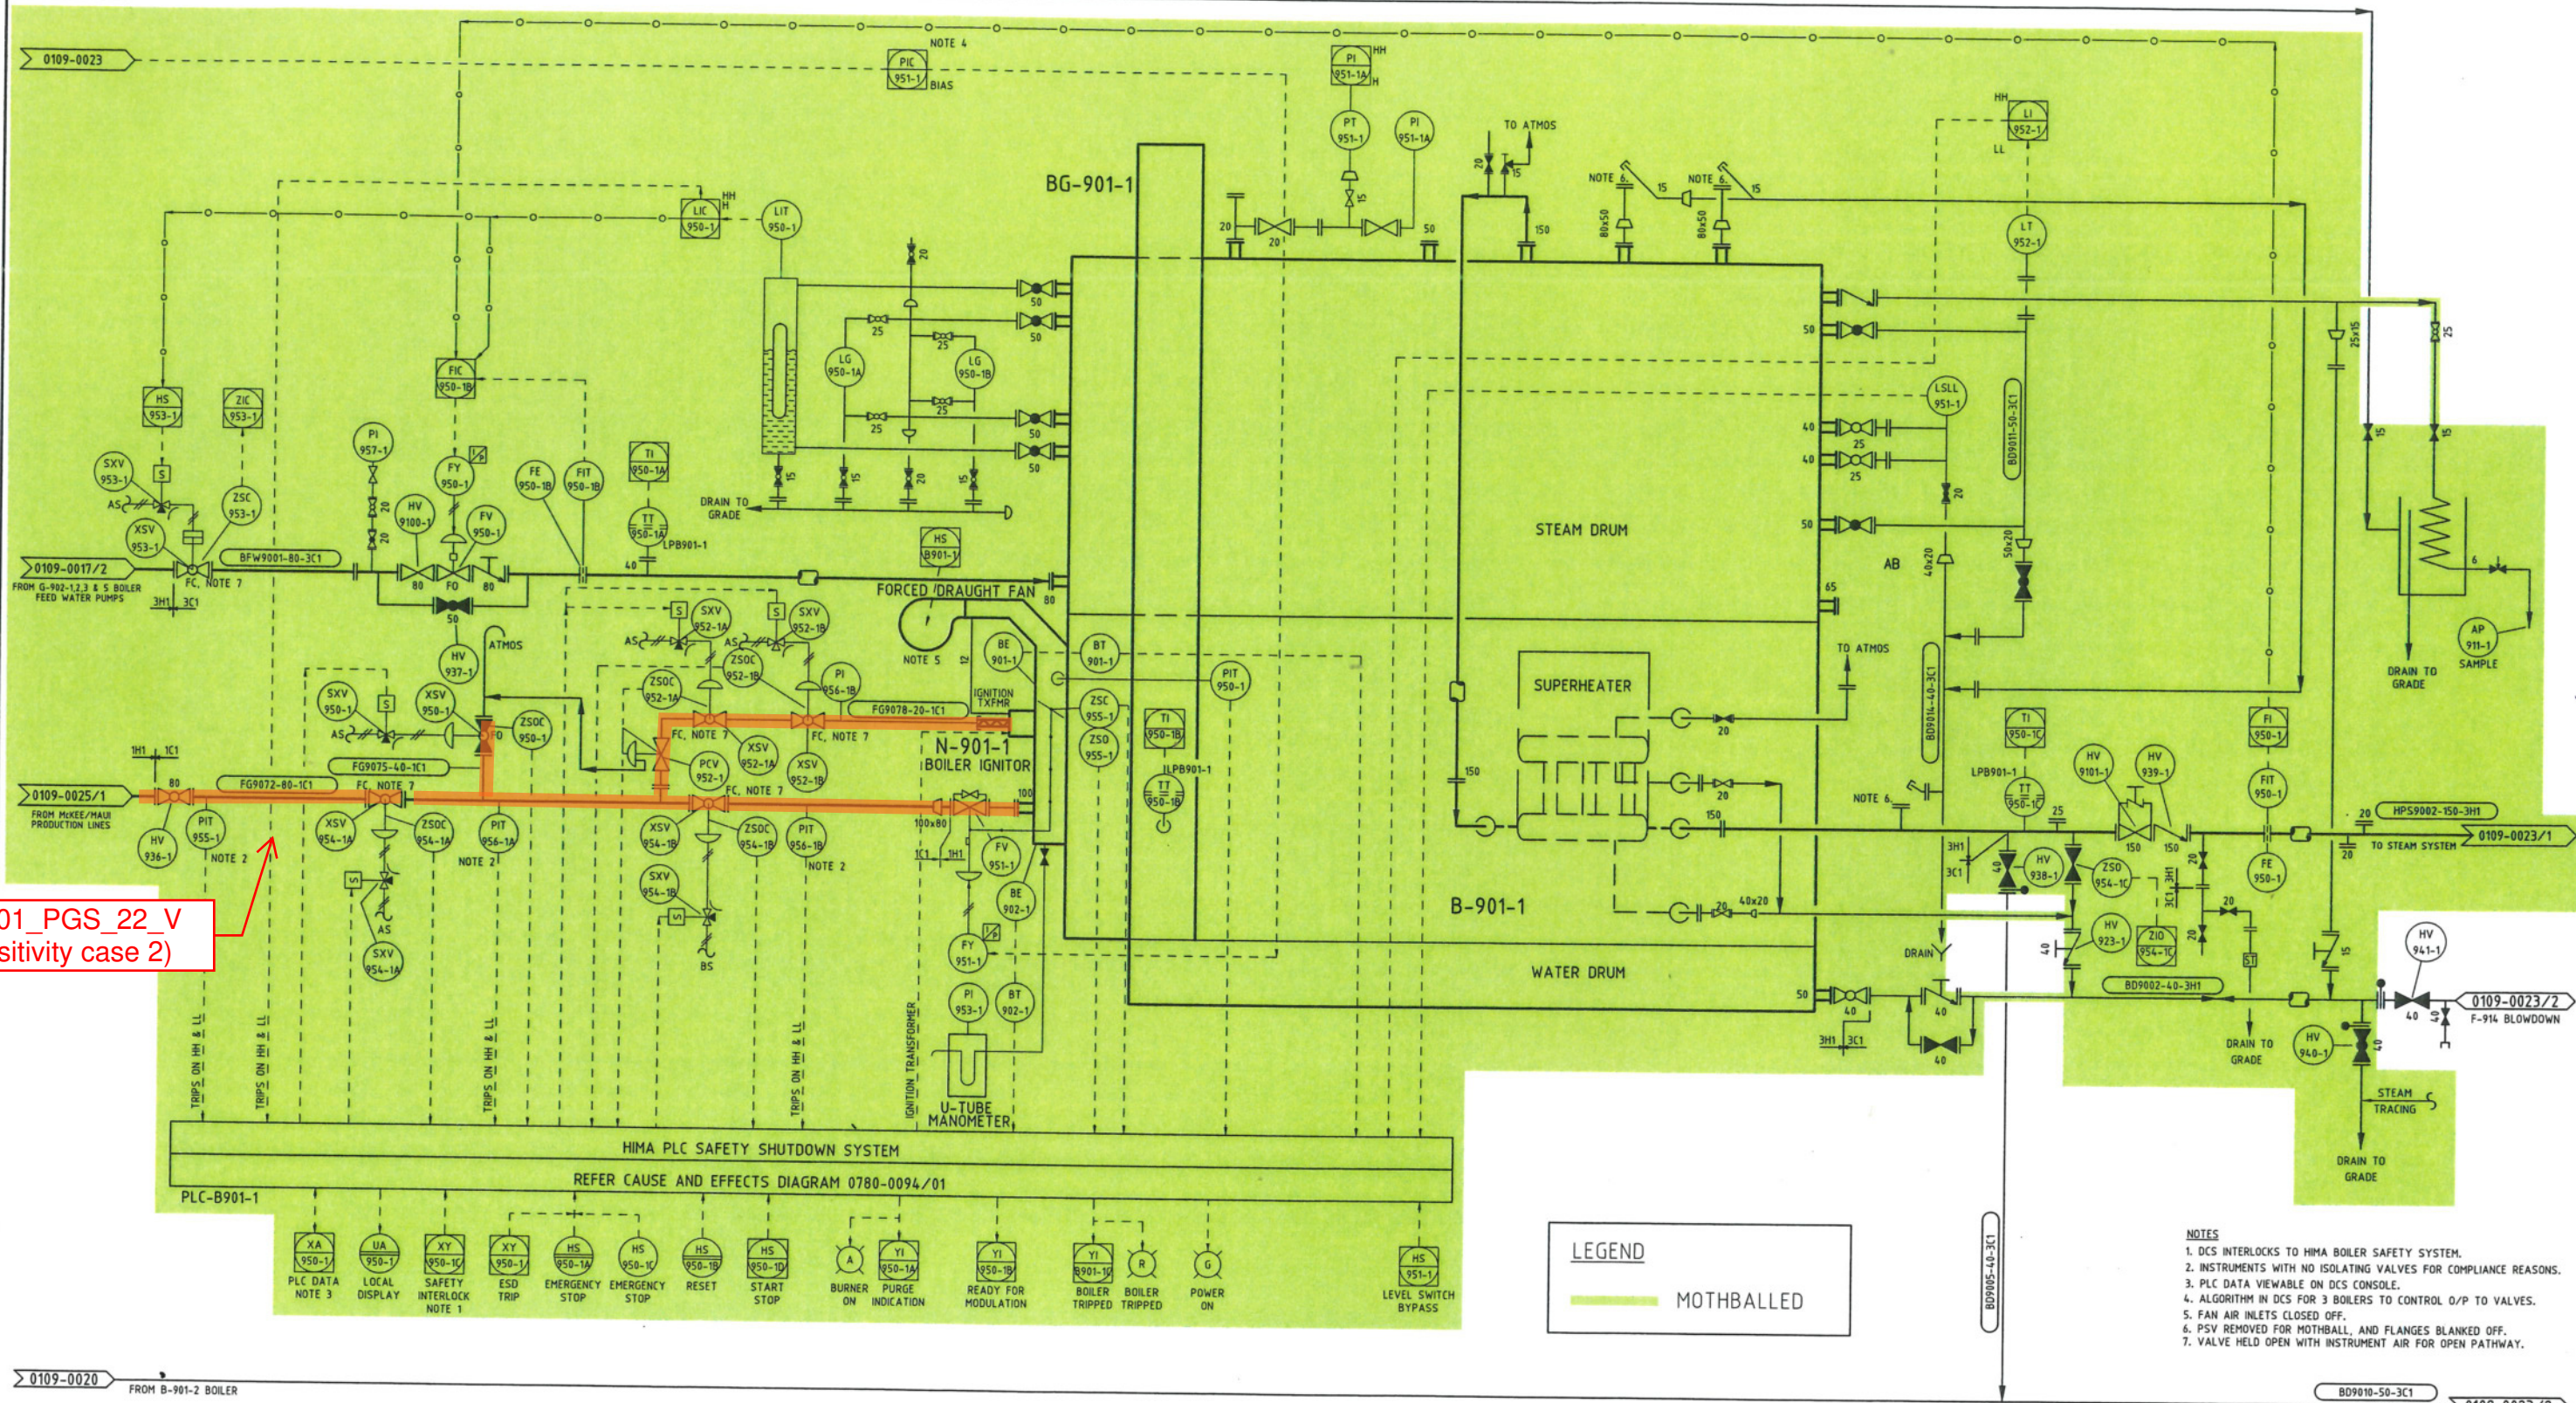

KGT01_PGS_22_V
(Sensitivity case 2)

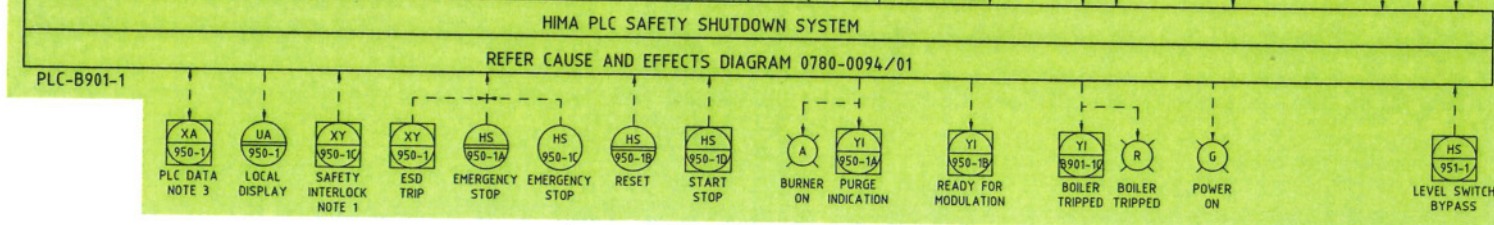

- NOTES
- DCS INTERLOCKS TO HIMA BOILER SAFETY SYSTEM.
 - INSTRUMENTS WITH NO ISOLATING VALVES FOR COMPLIANCE REASONS.
 - PLC DATA VIEWABLE ON DCS CONSOLE.
 - ALGORITHM IN DCS FOR 3 BOILERS TO CONTROL O/P TO VALVES.
 - FAN AIR INLETS CLOSED OFF.
 - PSV REMOVED FOR MOTHBALL, AND FLANGES BLANKED OFF.
 - VALVE HELD OPEN WITH INSTRUMENT AIR FOR OPEN PATHWAY.

REV	AMENDMENT	BY	CHK	ENG	APP	DATE	REV	AMENDMENT	BY	CHK	ENG	APP	DATE
21	SAMPLE POINT AP-911-1 ADDED	RL	MY	AM	SES	01/2014	11	PSV SET POINTS & DESIGN DATA RATIONALISED	G.JH	D.JP	AvG	AIM	09/02
20	AS BUILT P84-2017 DOWN STEAM TRAPS	JB	CJ	AM	SES	12/13	10	AS BUILT FOR WS104731 INLET & COOLING WATER MOODS.	VB	RL	LH	DC	01/02
19	HAND VALVE NUMBERS ADDED FOR ISOLATIONS	RL	CR	AM	SES	07/2013	9	BD9007 NOW BD9005 AND LT-951-1 NOW LSSL-951-1	JBH	RL	E.JH	RW	1/07/00
18	BOILER PROCESS CONDITIONS & PSV SIZES AS BUILT	RL/ES	AM	SRH	SES	02/2012							
17	AS BUILT 1141024 UPDATE ADV CONTROL DESC'S	ES	CJ	LH	SES	02/08							
16	AS BUILT W5998510 BOILER RELIABILITY	KN	LH	MP	PJR	10/07							
15	AS BUILT WS1236285 - BOILER MANOMETER ADDED	ES	SR	LH	DS	09/07	25	AS BUILT P84-1348 MOTHBALL BOILERS	JB	CJ	SM	SES	09/2017
14	AS BUILT FOR WS917716 B-901.2&3 BOILER FEED WATER	PJ	MP	CF	LH	03/06	24	REVISED FOR LOCKED VALVE REGISTER	RL	JCC	AM	TC	11/2016
13	WS823841 AS BUILT, BOILER CONTROL UPGRADE	JBH	RL	LH	PJR	06/07/04	23	AS BUILT P84-1229 REPLACE GWR TRANSMITTER	LN	CJ	SES	AM	05/2015
12	PROCESS ISOLATION POINTS ADDED ON INDIVIDUAL LAYERS	CMW	RL	CM	AIM	11/02	22	HAND VALVE NUMBERS ADDED FOR ISOLATIONS & CSO	RL	JCC	AM	SES	04/2015

VECTOR KAPUNI LIMITED
PRIVATE BAG 2020
NEW PLYMOUTH 4342
PHONE 0800 734 567

Vector

COPYRIGHT The copyright in this document is vested in Vector Kapuni Limited
The contents of this document shall not be reproduced, either in whole or part, by any
means whatsoever without the prior written consent of Vector Kapuni Limited.

AUTOCAD ORIGINAL SHEET SIZE A1

REFERENCE DRAWINGS
CAUSE & EFFECT 0780-0094/1

DRN	P.RAWLES	DATE	ENG	DATE
CHK	A vanGAMEREN		APP	J.F.STUART 10/02/1988

UTILITIES
PIPING & INSTRUMENT DIAGRAM
B-901-1 BOILER NO. 1

SCALE: N/A

JOB NO.	SERIES	DRG. NO	SHT 01	REVISION
1000000	0109	0019	01 OF 01 SHTS	25

EQUIPMENT No.

DESCRIPTION
CAPACITY
MAWP @ TEMP

BG-901-2
BOILER STACK

B-901-2
BOILER

284.12 kg/hr
BOILER DRUM DESIGN PRESSURE 35.85 Barg @ 271°C
SUPERHEATER DESIGN PRESSURE 35.85 Barg @ 343°C

COOLING WATER SUPPLY
RW9015-15-011


0109-0010

0109-0023

KGTO1_PGS_22_V
(Sensitivity case 2)

0109-0025

0109-0021

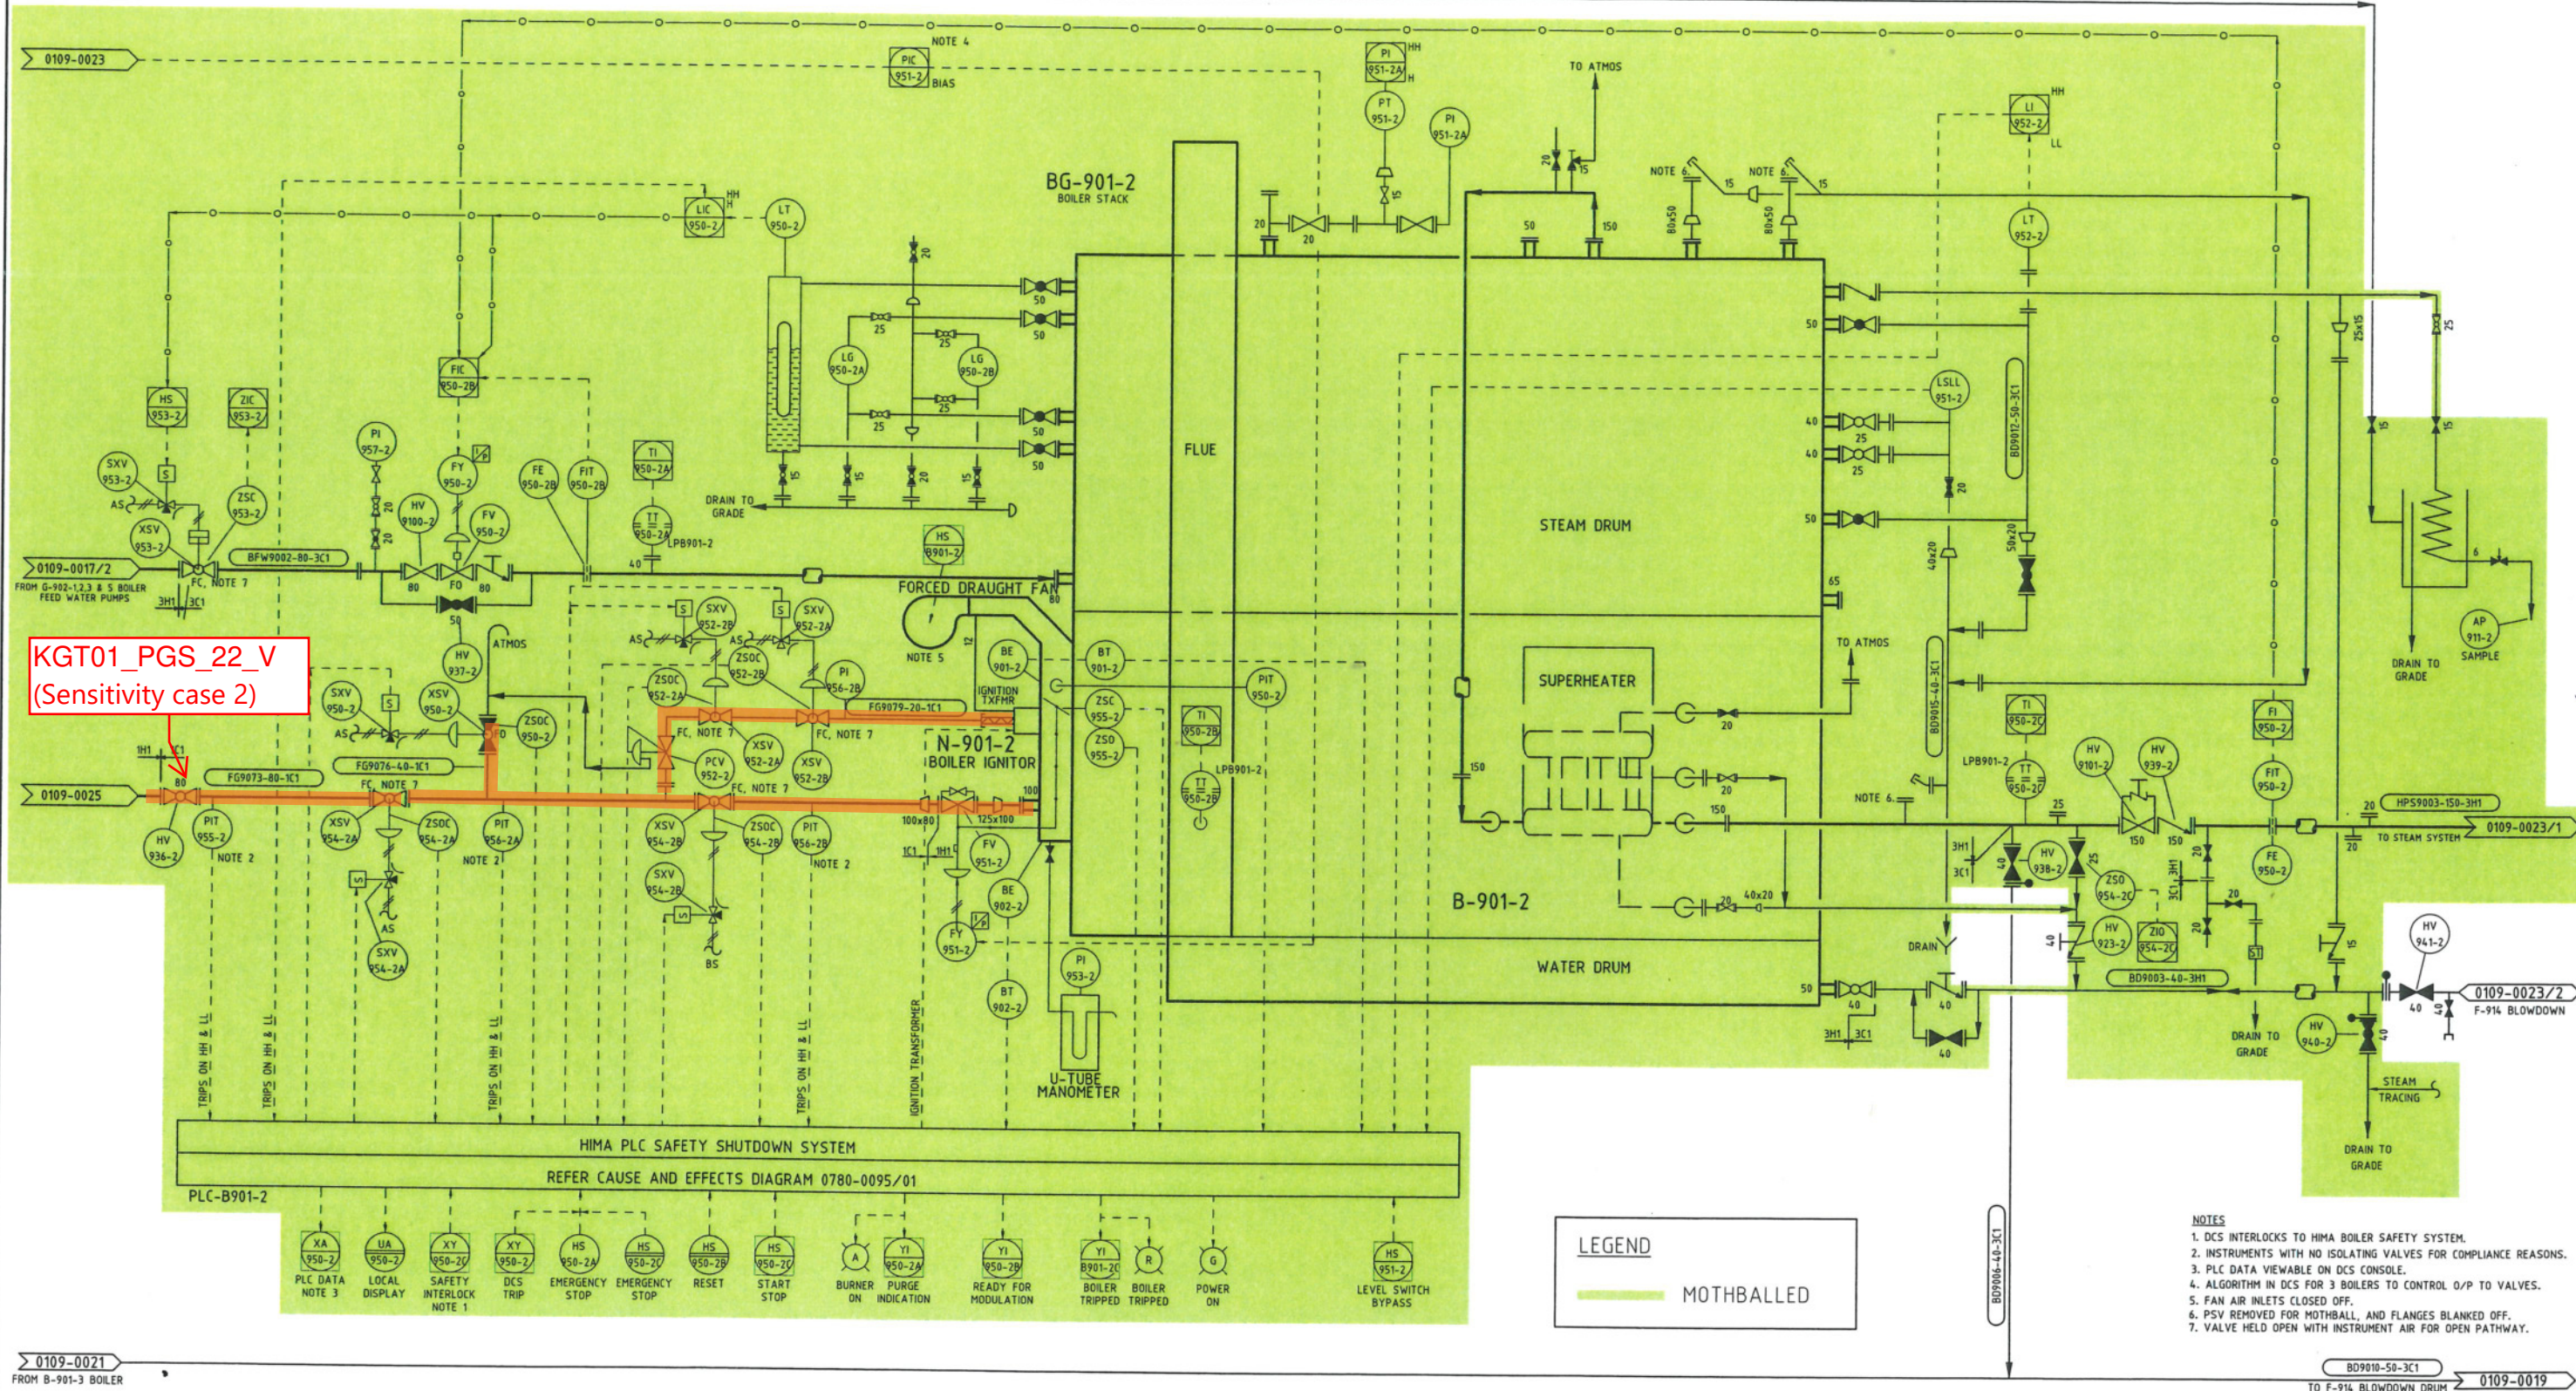

HIMA PLC SAFETY SHUTDOWN SYSTEM
REFER CAUSE AND EFFECTS DIAGRAM 0780-0095/01

PLC-B901-2	XA 950-2	UA 950-2	XY 950-2	XY 950-2	HS 950-2A	HS 950-2B	HS 950-2C	HS 950-2D	A	YI 950-2A	YI 950-2B	YI 950-2C	R	G	HS 951-2
	PLC DATA NOTE 3	LOCAL DISPLAY	SAFETY INTERLOCK NOTE 1	DCS TRIP	EMERGENCY STOP	EMERGENCY STOP	RESET	START STOP	BURNER ON	PURGE INDICATION	READY FOR MODULATION	BOILER TRIPPED	BOILER TRIPPED	POWER ON	LEVEL SWITCH BYPASS

LEGEND
MOTHBALLED

- NOTES
- DCS INTERLOCKS TO HIMA BOILER SAFETY SYSTEM.
 - INSTRUMENTS WITH NO ISOLATING VALVES FOR COMPLIANCE REASONS.
 - PLC DATA VIEWABLE ON DCS CONSOLE.
 - ALGORITHM IN DCS FOR 3 BOILERS TO CONTROL O/P TO VALVES.
 - FAN AIR INLETS CLOSED OFF.
 - PSV REMOVED FOR MOTHBALL, AND FLANGES BLANKED OFF.
 - VALVE HELD OPEN WITH INSTRUMENT AIR FOR OPEN PATHWAY.

REV	AMENDMENT	BY	CHK	ENG	APP	DATE	REV	AMENDMENT	BY	CHK	ENG	APP	DATE
21	AS BUILT P84-2017 DOWN STREAM STEAM TRAPS	JB	CJ	AM	SES	12/2013	11	PSV SET POINTS & DESIGN DATA RATIONALISED	GJH	DJP	AvG	AIM	09/02
20	HAND VALVE NUMBERS ADDED FOR ISOLATIONS	RL	CR	AM	SES	07/2013	10	AS BUILT FOR WS104731 INLET & COOLING WATER MODS.	VB	RL	LH	DC	01/02
19	BOILER PROCESS CONDITIONS & PSV SIZES AS BUILT	RL/ES	AM	SRH	SES	02/2012							
18	PSV-953-2 EXCHANGED FOR PSV-953-3 FROM BOILER 3	RL/ES	MK	CR	SES	09/2011							
17	AS BUILT WS998510 BOILER RELIABILITY	VB	WF	PWM	LH	08/08							
16	AS BUILT 1141024 UPDATE ADV CONTROL DESC'S	ES	CJ	LH	SES	02/08	26	AS BUILT P84-1348 MOTHBALL BOILERS	JB	CJ	AM	SES	09/2017
15	AS BUILT WS1236285 - BOILER MANOMETER ADDED	ES	SR	LH	DS	09/07	25	REVISED FOR LOCKED VALVE REGISTER	RL	JCC	AM	TC	11/2016
14	AS BUILT FOR WS917716 B-901,2&3 BOILER FEED WATER	PJ	MP	CF	LH	03/06	24	AS BUILT P84-1229 REPLACE GWR TRANSMITTER	LN	CJ	AM	SES	05/2015
13	WS823841 AS BUILT - BOILER CONTROL UPGRADE	JBH	RL	LH	PJR	16/09/04	23	HAND VALVE NUMBERS ADDED FOR ISOLATIONS & CSO	RL	JCC	AM	SES	04/2015
12	PROCESS ISOLATION POINTS ADDED ON INDIVIDUAL LAYERS	CHW	RL	CM	AIM	11/02	22	SAMPLE POINT AP-911-2 ADDED	RL	MY	AM	SES	01/2014

VECTOR KAPUNI LIMITED
PRIVATE BAG 2020
NEW PLYMOUTH 4342
PHONE 0800 734 567

Vector

COPYRIGHT The copyright in this document is vested in Vector Kapuni Limited
The contents of this document shall not be reproduced, either in whole or part, by any
means whatsoever without the prior written consent of Vector Kapuni Limited.


AUTOCAD ORIGINAL SHEET SIZE A1

REFERENCE DRAWINGS
CAUSE & EFFECT 0780-0095/1

DRN	P.RAWLES	ENG	DATE
CHK	A.vanGAMEREN	APP	J.F.STUART 10/02/1986

UTILITIES
PIPING & INSTRUMENT DIAGRAM
B-901-2 BOILER NO. 2

SCALE:	JOB NO.	SERIES	DRG. NO	SHT	OF	REVISION
N/A	1000000	0109	0020	01	01	26

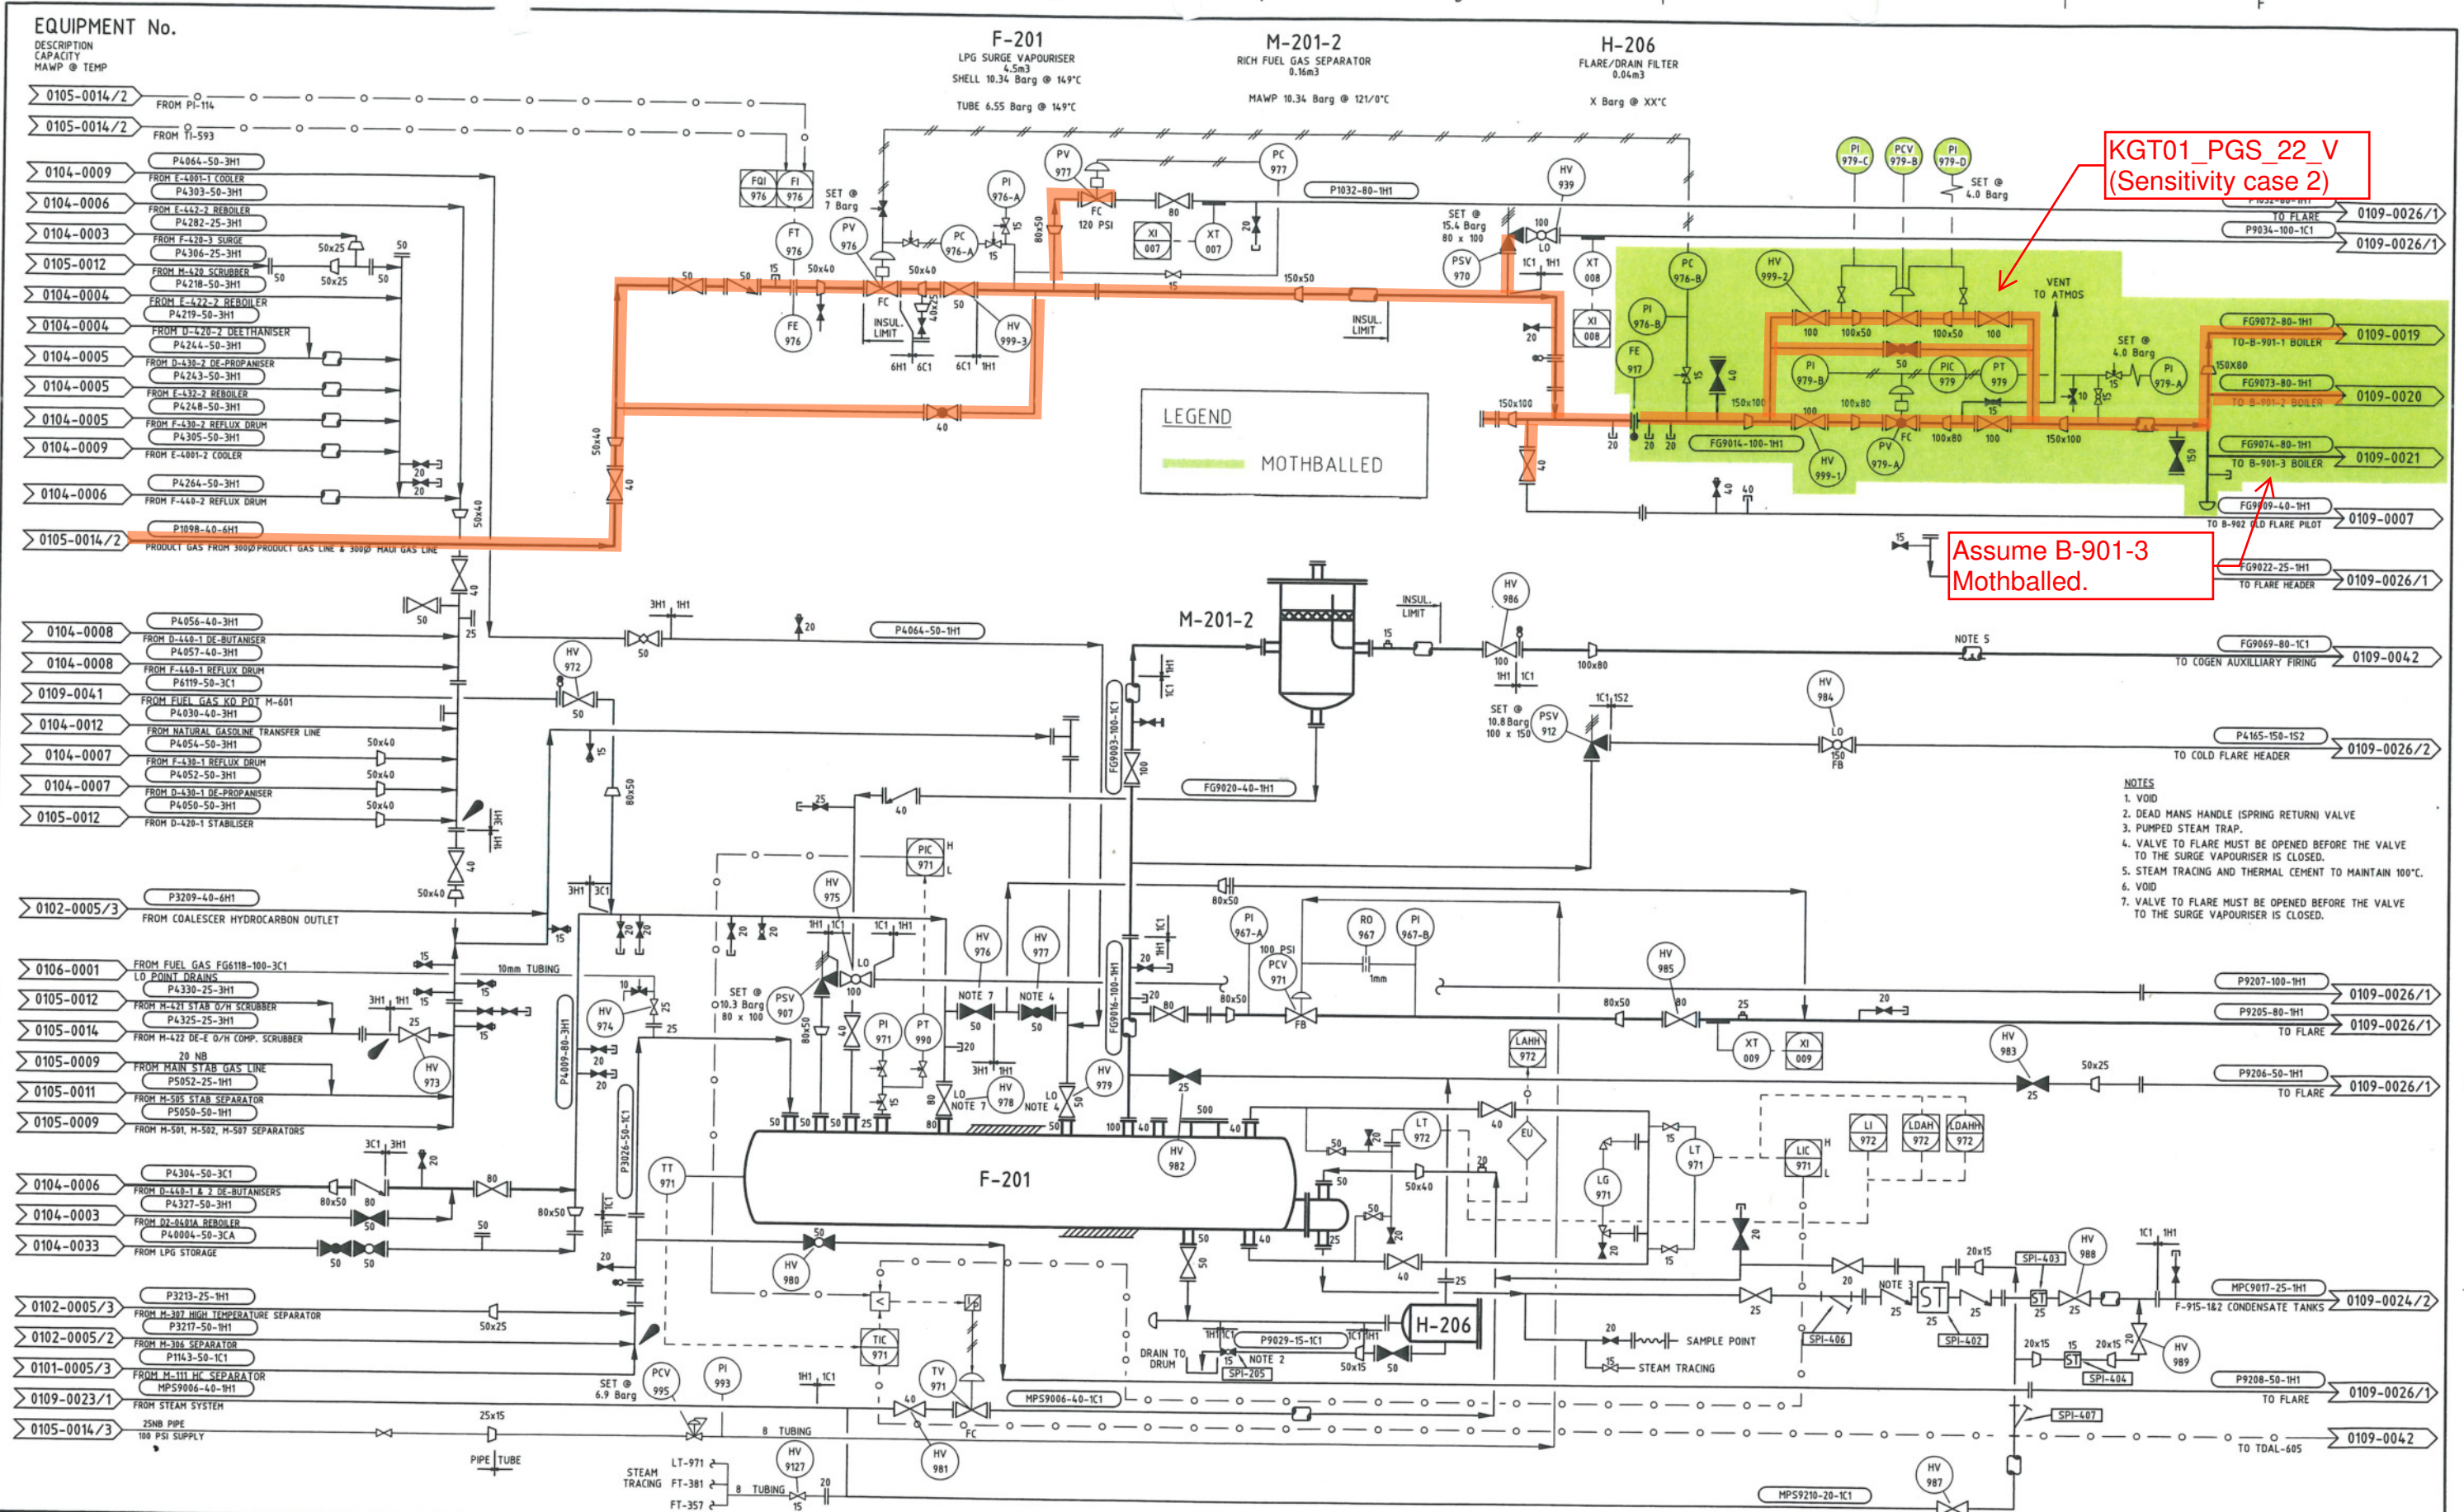

REV	DESCRIPTION	BY	CHK	ENG	APP	DATE	REV	DESCRIPTION	BY	CHK	ENG	APP	DATE
23	AS BUILT W51043299 UPGRADE DOMESTIC GAS SUPPLY	RL	MD	LH	SES	11/2007	33	REVISED FOR P&ID SPLITTING. CONT. DRG. No's REVISED	RL	JCC	AM	SES	01/2015
22	AS BUILT FOR W5993217 FT-114 TO CUSTODY METER	VB	LH	MP	PJR	03/07	32	HAND VALVE NUMBERS ADDED FOR ISOLATIONS	RL	CR	AM	SES	04/2014
							31	AS BUILT & SITE CHECKED	ES/RL	TC	AM	SES	11/12
							30	AS BUILT P84-1041 FLARE GAS MEASUREMENT	ES/RL	TC	AM	SES	09/12
							29	AS BUILT P84-3007 ESD LEVEL TRANS DEVIATION ALARMS	ES/RL	TC	AM	SES	03/10
							28	AS BUILT W51285853 - BOILER DEAD LEG TRIP HAZARD	ES	MS	LH	SES	04/09
							27	PI-979-A & D MODIFIED FOR OVER PRESSURE PROTECTION	RL	MD	LH	SES	06/08
							26	AS BUILT PCV-971 PER INCIDENT REPORT No. 506675	ES	JY	LH	SES	05/08
							25	AS BUILT W51266020 VENT NGC BOILER FUEL ON START	RL	EJ	LH	SES	04/2008
							24	PI-979-C, PI-979-D, PIC-979 ADDED	ES	CB	LH	SES	01/08

VECTOR KAPUNI LIMITED
PRIVATE BAG 2020
NEW PLYMOUTH 4342
PHONE 0800 734 567

REFERENCE DRAWINGS

DRN	DATE	ENG	APP
P.RAWLES	09/12/1987	ENG	
P.THAMBYAH	09/12/1987	APP	J.F.STUART

SCALE: NTS

JOB NO. 1000000

SHT 01 OF 01 SHTS


REVISION 38

1000000-0109-0025-01.DWG

UTILITIES	PIPING & INSTRUMENT DIAGRAM	LPG SURGE VAPOURISER & FUEL SYSTEM
SCALE: NTS	JOB NO. 1000000	SHT 01 OF 01 SHTS
DRN	DATE	REVISION
CHK	DATE	38

EQUIPMENT No.

DESCRIPTION
CAPACITY
MAWP @ TEMP

 

REV	AMENDMENT	BY	CHK	ENG	APP	DATE	REV	AMENDMENT	BY	CHK	ENG	APP	DATE
23	AS BUILT WS1043299 UPGRADE DOMESTIC GAS SUPPLY	RL	MD	LH	SES	11/2007	33	REVISED FOR P&ID SPLITTING. CONT. DRG. No's REVISED	RL	JCC	AM	SES	01/2015
22	AS BUILT FOR WS993217 FT-114 TO CUSTODY METER	VB	LH	MP	PJR	03/07	32	HAND VALVE NUMBERS ADDED FOR ISOLATIONS	RL	CR	AM	SES	04/2014
							31	AS BUILT & SITE CHECKED	ES/RL	TC	AM	SES	11/12
							30	AS BUILT P84-1041 FLARE GAS MEASUREMENT	ES/RL	TC	AM	SES	09/12
							29	AS BUILT P84-3007 ESD LEVEL TRANS DEVIATION ALARMS	ES	TC	LH	SES	03/10
38	AS BUILT P84-1348 MOTHBALL BOILERS AM SES	JB	CJ	AM	SES	09/2017	28	AS BUILT WS1285853 - BOILER DEAD LEG TRIP HAZARD	ES	MS	LH	SES	04/09
37	AS BUILT P84-1309 RELOCATE STEAM TRACING SOURCE ON LT-971	RL	JCC	AM	TC	11/2016	27	PI-979-A & D MODIFIED FOR OVER PRESSURE PROTECTION	ES	MD	LH	SES	06/08
36	CONTINUATION P&ID SPLITTING 0104-0004 & 0105-0014	JCC	RL	AM	SES	06/2016	26	AS BUILT PCV-971 PER INCIDENT REPORT No. 506675	ES	JY	LH	SES	05/08
35	VALVES REMOVED FROM LINE P3209-40-6H1 & CSO FROM HV-980	RL	JCC/AM	AM	SES	10/2015	25	AS BUILT WS1266020 VENT NGC BOILER FUEL ON START	ES	CB	LH	SES	04/2008
34	ADDED HV-939, HV-999-1,2,3, LEVEL BRIDLE LT-972	JCC	RL/AM	AM	SES	04/2015	24	PI-979-C, PI-979-D, PIC-979 ADDED	ES	CB	LH	SES	01/08

REV	AMENDMENT	BY	CHK	ENG	APP	DATE
23	AS BUILT WS1043299 UPGRADE DOMESTIC GAS SUPPLY	RL	MD	LH	SES	11/2007
22	AS BUILT FOR WS993217 FT-114 TO CUSTODY METER	VB	LH	MP	PJR	03/07

VECTOR KAPUNI LIMITED
PRIVATE BAG 2020
NEW PLYMOUTH 4342
PHONE 0800 734 567

REFERENCE DRAWINGS

DRN	P.RAWLES	09/12/1987	ENG	DATE
CHK	P.THAMBYAH	08/12/1987	APP	J.F.STUART 21/12/1987

UTILITIES
PIPING & INSTRUMENT DIAGRAM
LPG SURGE VAPOURISER & FUEL SYSTEM


SCALE: NTS

JOB NO.	SERIES	DRG. NO	SHT	REVISION
1000000	0109	0025	01 OF 01 SHTS	38

COPYRIGHT The copyright in this document is vested in Vector Kapuni Limited. The contents of this document shall not be reproduced, either in whole or part, by any means whatsoever without the prior written consent of Vector Kapuni Limited.

AUTOCAD ORIGINAL SHEET SIZE A1

D1-4100B
 GAS FLARE SYSTEM BURNER
 CAPACITY 3.6m³/h
 MAWP 20.7BarG @ 16°C

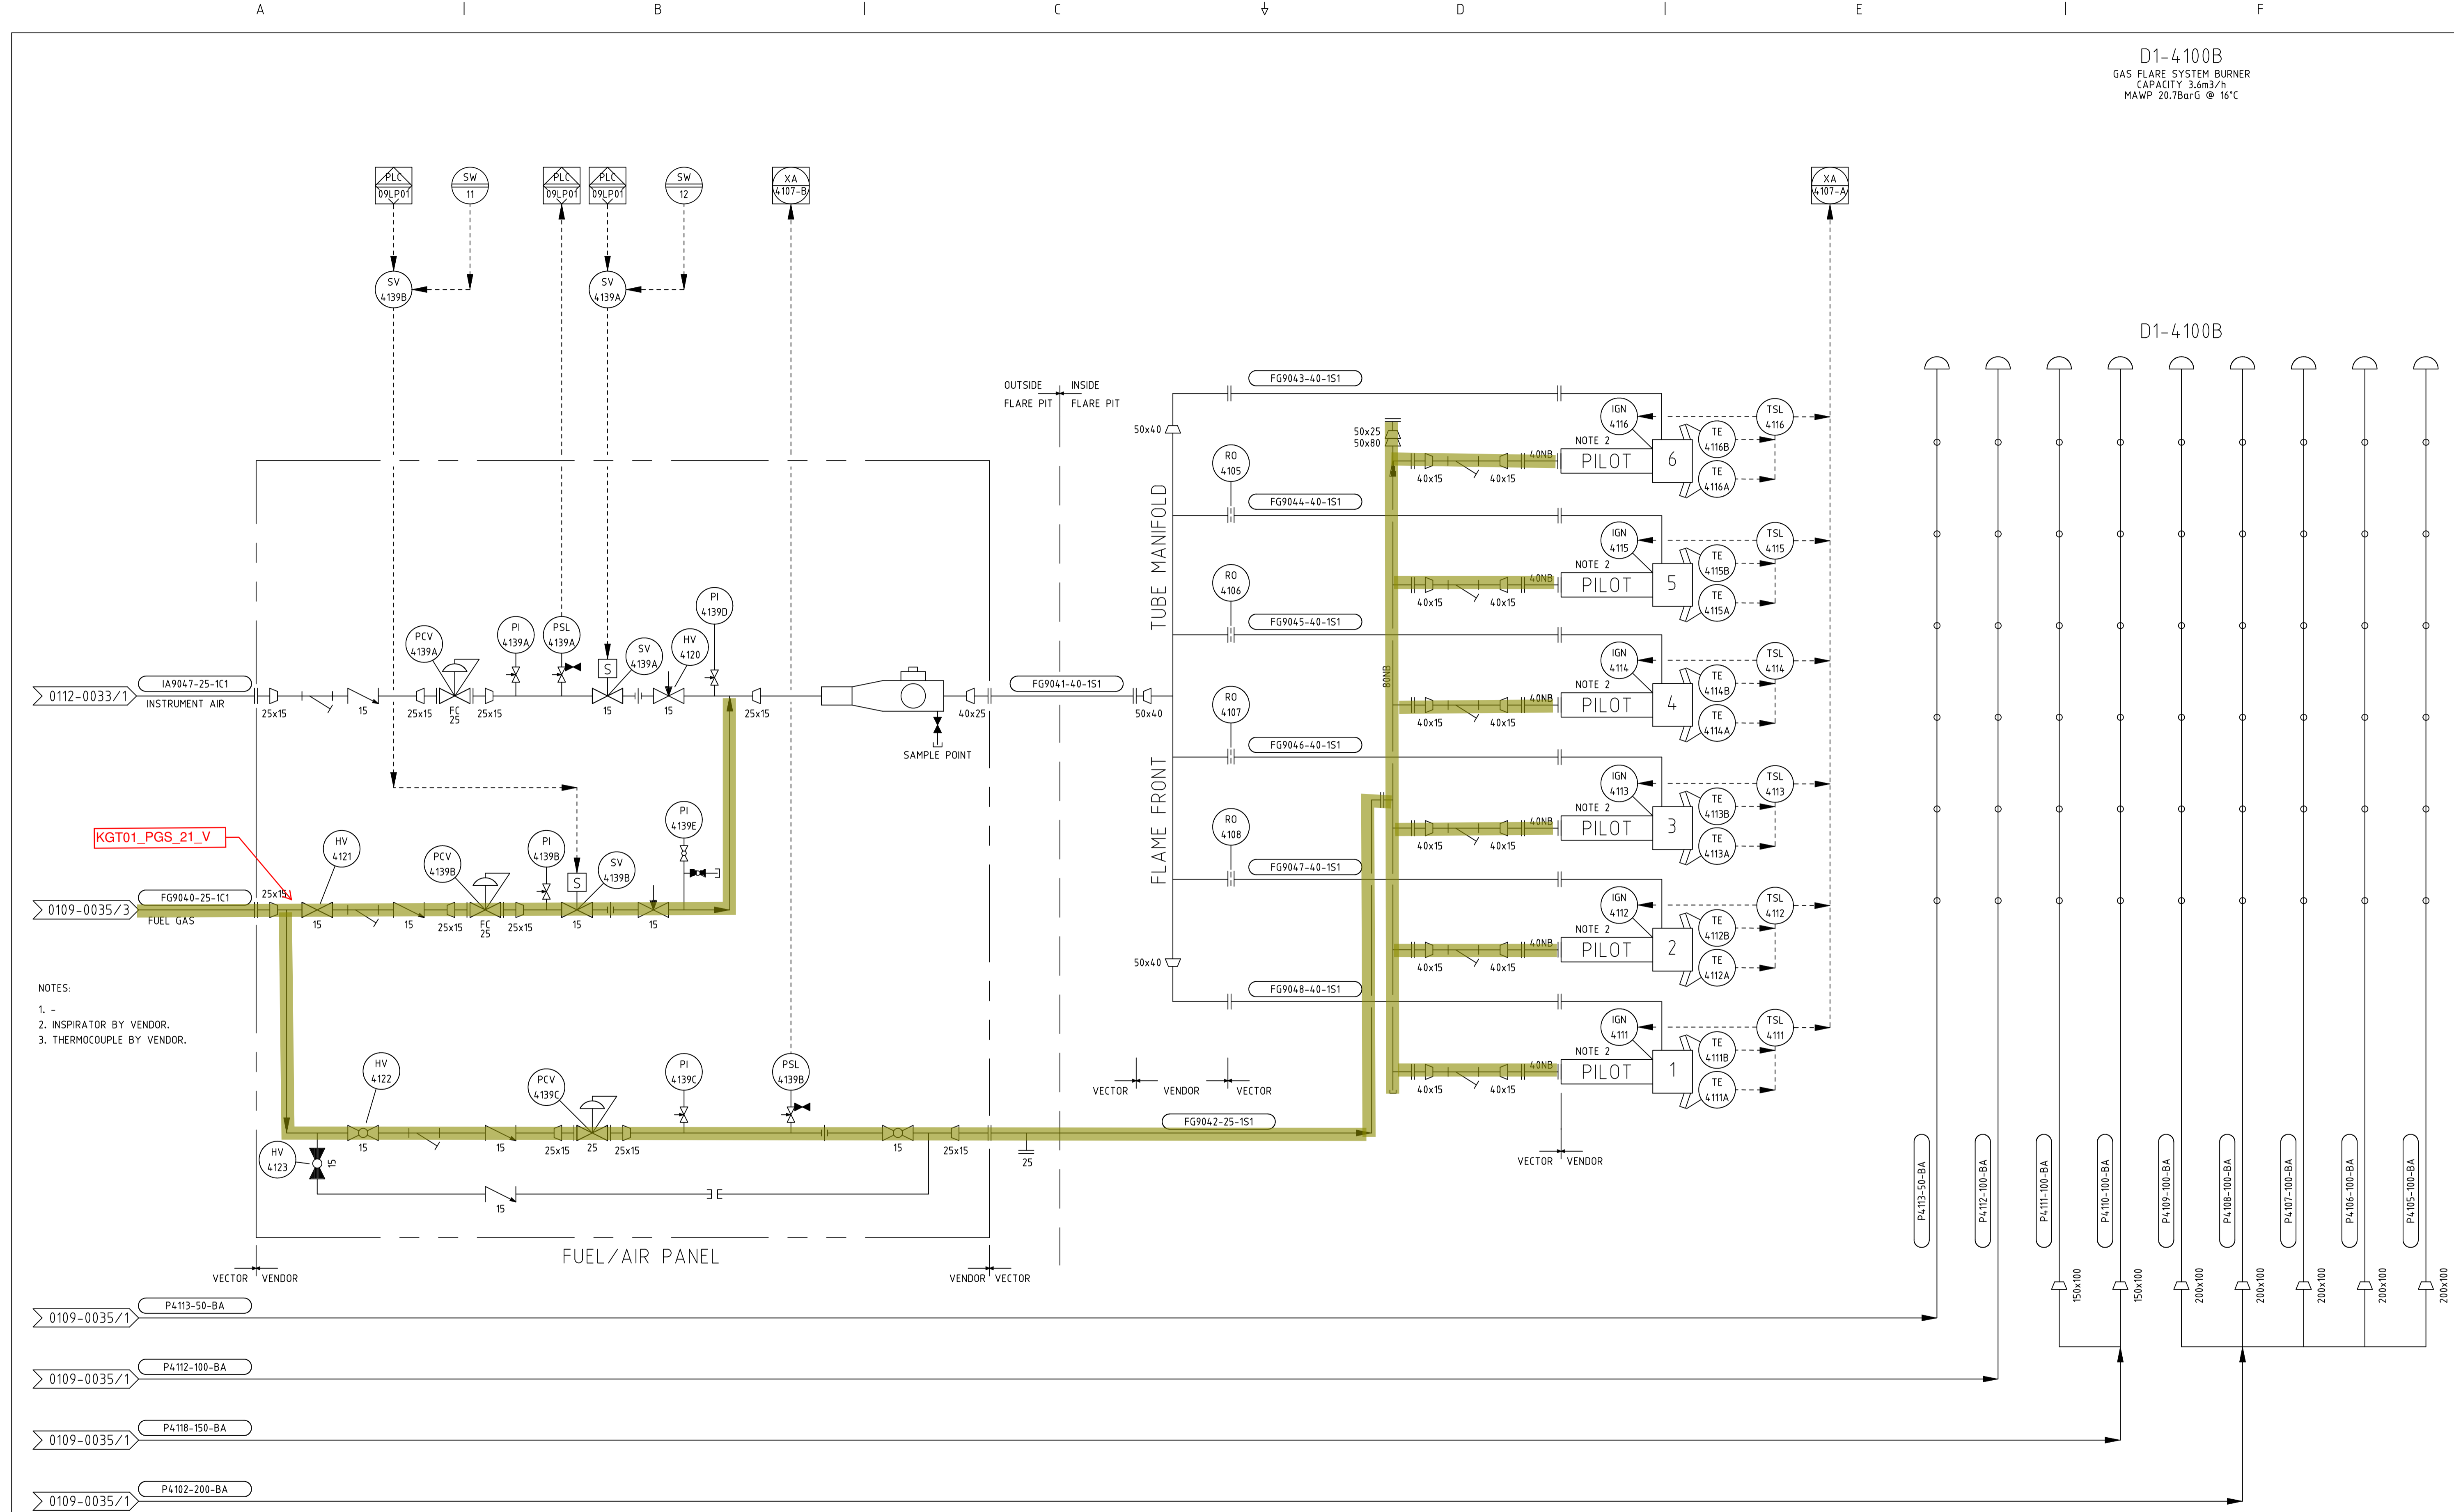

- NOTES:
- - INSPIRATOR BY VENDOR.
 - THERMOCOUPLE BY VENDOR.

- 0109-0035/1 P4113-50-BA
- 0109-0035/1 P4112-100-BA
- 0109-0035/1 P4118-150-BA
- 0109-0035/1 P4102-200-BA

REV	AMENDMENT	BY	CHK	ENG	APP	DATE	REV	AMENDMENT	BY	CHK	ENG	APP	DATE
9	AS BUILT P84-1193 GROUND FLARE MODIFICATIONS	LN	JT	AM	SES	12/14							
8	HAND VALVE NUMBERS ADDED FOR ISOLATIONS	RL	CR	AM	SES	12/2013							
7	09LP01 ADDED	ES	CB/RL	LH	SES	07/08							
6	JUNCTION BOX 09JB04 WAS 09JB01	ES	RL	LH	DS	10/07							
5	AS BUILT FOR W5969591 GROUND FLARE MODS	VB	MK	ST	LH	09/06							
4	AS-BUILT W5969831	KJ	AS	CL	LH	11/05							
3	AS BUILT TO SITE MARK-UP	ES	WN	LH	PJR	10/05							
2	PCV DESIGN DATA RATIONALISED	GJH	DJP	AvG	AIM	09/02							
11	AS BUILT P84-1536 DEMOLISHED GROUND FLARE EXCITER JB	JCC	RL	AM	TC	03/2020							
10	AS BUILT P84-1234 RENEW GROUND FLARE FLAME FRONT GENERATOR	CJ	JT	AM	SES	10/2015							
1	AS BUILT FOR GAS FLARE FLAMEFRONT IGNITION SYSTEM	JBH	RL	EJH	RS	03/04/00							
	APPROVED FOR CONSTRUCTION	VB	PM	JL	GE	02/99							



VECTOR KAPUNI LIMITED
 PRIVATE BAG 2020
 NEW PLYMOUTH 4342
 PHONE 0800 734 567

REFERENCE DRAWINGS			
DRN	DATE	DATE	DATE
V BRENNAN	16/02/1999	ENG	J LOMAX
P MILLS	16/02/1999	APP	G EATON

UTILITIES PIPING & INSTRUMENT DIAGRAM FLARE					
SCALE:	JOB NO.	SERIES	DRG. NO	SHT 02 OF 03 SHTS	REVISION
	1000000	0109	0035		11

A I B I C ↓ D I E I F

EQUIPMENT No.
DESCRIPTION
CAPACITY
MAWP @ TEMP

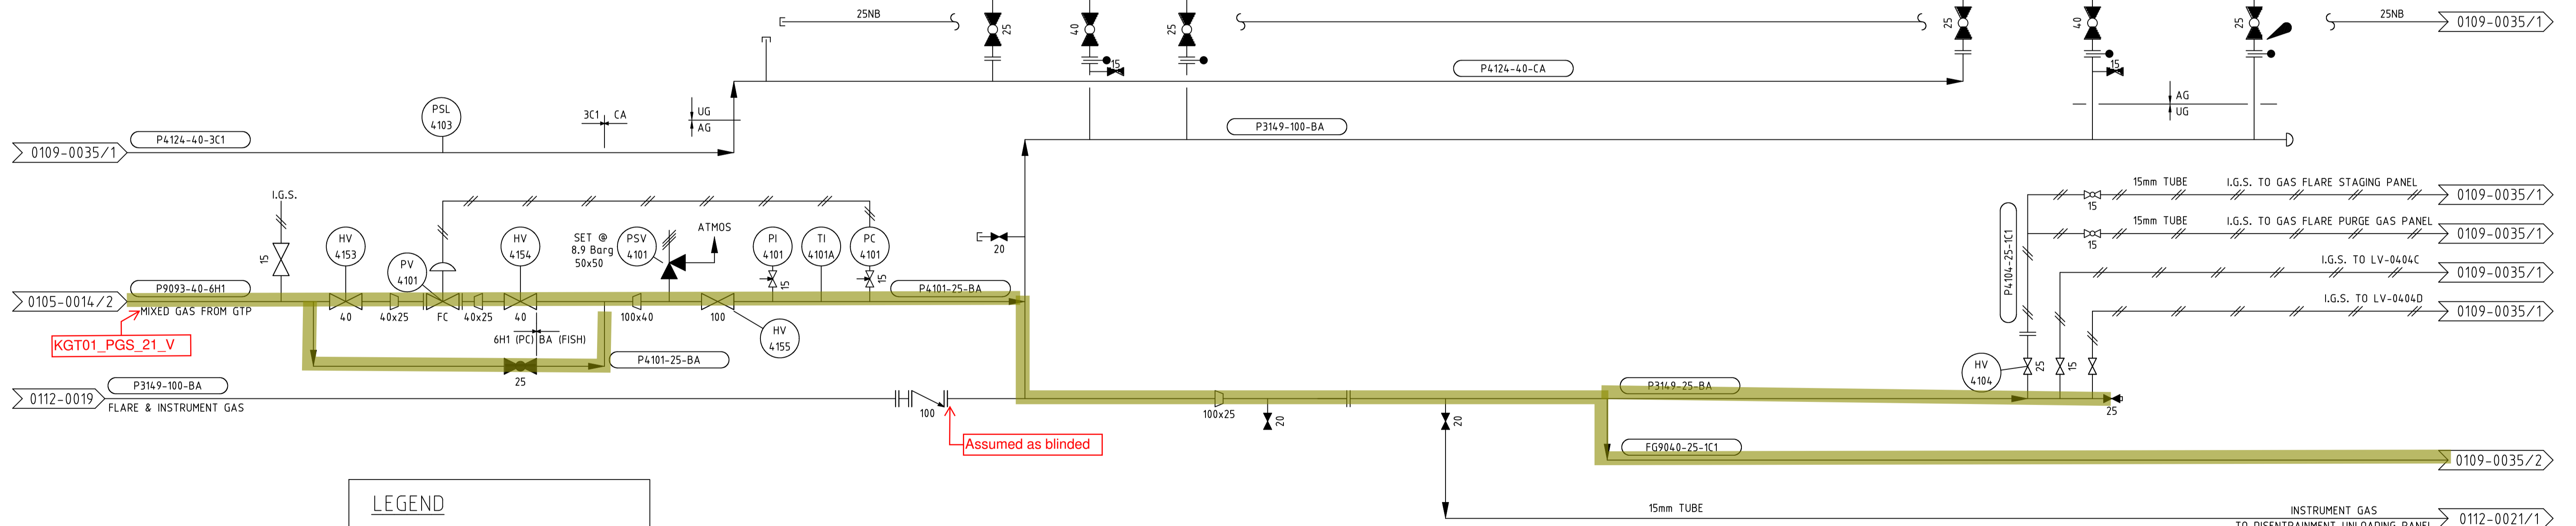 

LEGEND
 DECOMMISSIONED & ABANDONED IN PLACE

NOTES
1. VOID.

REV	AMENDMENT	BY	CHK	ENG	APP	DATE	REV	AMENDMENT	BY	CHK	ENG	APP	DATE
4	AS BUILT FOR P84-1419 MOTHBALL THE LIQUID FLARE	BJS	CJ	WB	AM	12/2019							
3	AS BUILT FOR I.G.S. TUBING TO GAS FLARE SYSTEM	RL	JCC	AM	TC	08/2019							
2	P&ID SPLITTING 0105-0014/2 CONTINUATION	JCC	RL	AM	SES	09/2016							
1	CREATED FROM SHEET 01 SPLIT	NK	RL	AM	SES	12/2013							

VECTOR KAPUNI LIMITED
PRIVATE BAG 2020
NEW PLYMOUTH 4342
PHONE 0800 734 567


REFERENCE DRAWINGS
0780-0082/06 EDP CAUSE AND EFFECTS

UTILITIES
PIPING & INSTRUMENT DIAGRAM
FLARE - BURNER SYSTEM

COPYRIGHT The copyright in this document is vested in Vector Kapuni Limited
The contents of this document shall not be reproduced, either in whole or part, by any means whatsoever without the prior written consent of Vector Kapuni Limited.

DRN	DATE	ENG	APP	DATE
N KNIGHT	02/12/2013	ENG	A MANN	02/12/2013
R LOCHHEAD	02/12/2013	APP	S SMITH	02/12/2013

SCALE:	JOB NO.	SERIES	DRG. NO	SHT OF SHTS	REVISION
N/A	1000000	0109	0035	03 OF 03	4

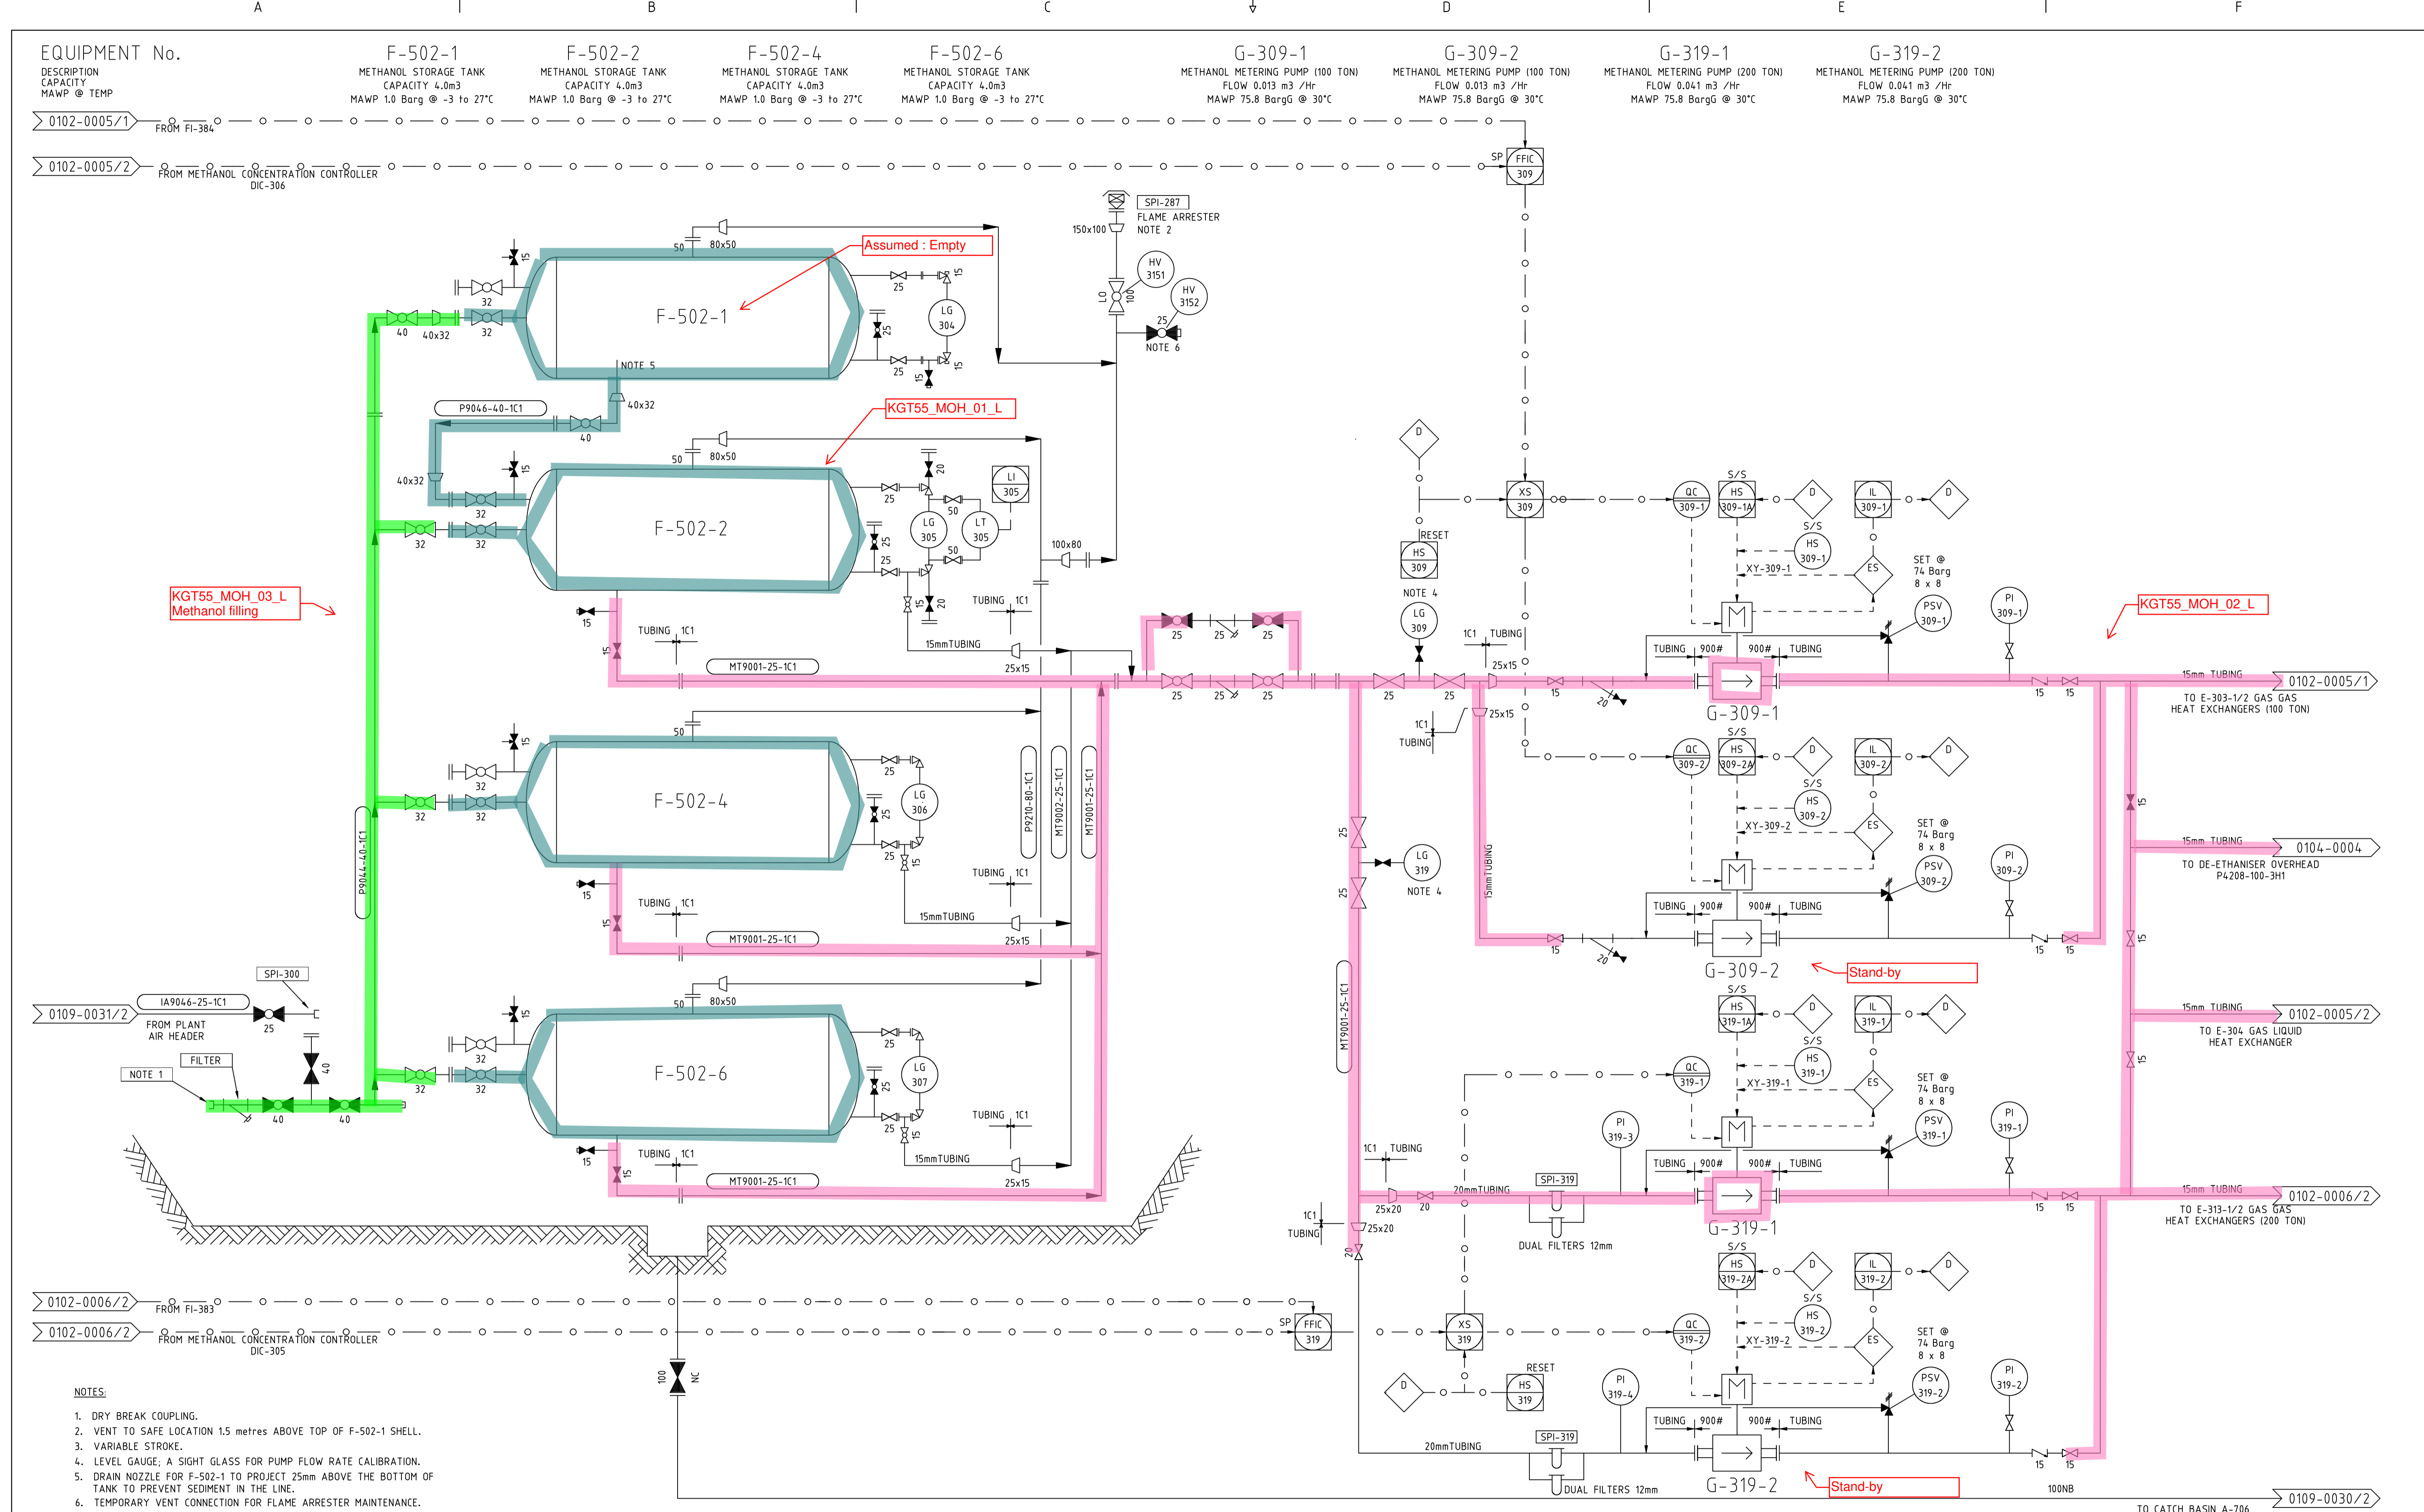

- NOTES:**
1. DRY BREAK COUPLING.
 2. VENT TO SAFE LOCATION 1.5 metres ABOVE TOP OF F-502-1 SHELL.
 3. VARIABLE STROKE.
 4. LEVEL GAUGE, A SIGHT GLASS FOR PUMP FLOW RATE CALIBRATION.
 5. DRAIN NOZZLE FOR F-502-1 TO PROJECT 25mm ABOVE THE BOTTOM OF TANK TO PREVENT SEDIMENT IN THE LINE.
 6. TEMPORARY VENT CONNECTION FOR FLAME ARRESTER MAINTENANCE.

REV	AMENDMENT	BY	CHK	ENG	APP	DATE	REV	AMENDMENT	BY	CHK	ENG	APP	DATE
8	AS BUILT P84-1458 METHANOL STORAGE FLAME ARRESTER	CJ	GH	SH	AM	09/2019							
7	SPI-287 NUMBER ADDED & SIZES FOR PSV'S	RL	JCC	AM	SES	03/2018							
6	AS BUILT WS1324664 METH PIPE SUCTION LINE UPGRADE	ES	RL	LH	SES	02/08							
5	AS BUILT	ES	RL	LH	PJR	06/06							
4	AS BUILT WS121380 METHANOL DOSING	RL	ES	LH	PJR	10/2005							
3	AS BUILT WS187805 METHANOL STORAGE TANK ADDED	RL	PL	LH	PJR	07/03							
2	FW9011 & SAFETY SHOWER REMOVED	VB	RL	EJH	RS	10/99							
1	AS BUILT FOR REFURBISHMENT PROJECT	V.B.	G.R.	K.E.	G.M.	10/97							

VECTOR KAPUNI LIMITED
 PRIVATE BAG 2020
 NEW PLYMOUTH 4342
 PHONE 0800 734 567

COPYRIGHT The copyright in this document is vested in Vector Kapuni Limited
 The contents of this document shall not be reproduced, either in whole or part, by any
 means whatsoever without the prior written consent of Vector Kapuni Limited.

REFERENCE DRAWINGS			
CAUSE AND EFFECT - 0780-0082/5			
DRN	J.WELLS	9/08/1996	ENG
CHK	M.LU		APP

UTILITIES PIPING & INSTRUMENT DIAGRAM METHANOL STORAGE AND METERING					
SCALE:	JOB NO.	SERIES	DRG. NO	SHT 01 OF 01 SHTS	REVISION
NTS	1000000	0109	0036		8

1000000-0109-0036-01

EQUIPMENT No.

DESCRIPTION
CAPACITY
MAWP @ TEMP

0112-0002/1 FROM TT-0102

MEDIAN PRESSURE

0109-0042/1

0105-0023/1 FROM PT-9604

0105-0014/2 FROM TT-114

0109-0042/1 FROM FT-606-MAX

0105-0014/2

0105-0013/1

0106-0001/1

0105-0010/1

0109-0009/1

0104-0008

0104-0006

- NOTES:
- SET POINT BIASED + 0.2 BAR TO LEAD CONTROLLER.
 - TRANSMITTERS ARE REVERSE ACTING TO DRIVE VALVES SHUT IN THE EVENT OF A FAILURE.
 - DECOMMISSIONED
 - DECOMMISSIONED
 - DECOMMISSIONED
 - VOID
 - DECOMMISSIONED
 - VOID
 - VALVES FITTED WITH MECHANICAL MAXIMUM STOP, TO 73% OPEN MAX FLOW = 15000 kg/hr
 - VOID
 - VOID
 - FLOW SIGNAL INFERRED FROM VALVE FV-600 DEMAND BELOW 5% OPEN.
 - CALCULATED FT-601 USED AS FT-601 UNREADABLE AT LOW FLOWS. -MASS FLOW RATE DISPLAYED AS KG/HR.
 - BUTANE RATIO CONTROLS DE-COMMISSIONED.
 - INSTRUMENT SIGNAL FROM MEDIAN SELECT TRANSMITTERS PT-601A, B & C.

KG101_FGA_01_V


KG101_RGS_01_V

G-441

BUTANE INJECTION PUMP
FLOW 4.1m³/Hr @ 4.90m DIFFERENTIAL HEAD

REV	AMENDMENT	BY	CHK	ENG	APP	DATE	REV	AMENDMENT	BY	CHK	ENG	APP	DATE
20	HAND VALVE NUMBERS ADDED FOR ISOLATIONS	RL	CR	AM	SES	10/2013	10	WS853855 AS BUILT. CONDITIONED LTS GAS NOW RAW	JBH	AK	LH	PJR	20/07/04
19	CONTIN. DRG. No. REVISED FOR EXPORT COMPRESSOR RE-NUMBERING	RL/ES	MH	AM	SES	05/2012	9	PROCESS ISOLATION POINTS ADDED ON INDIVIDUAL LAYERS	CMW	RL	CM	AIM	11/02
18	SPEC BLINDS AS BUILT AT HV-412-182 AND HV-413-182	RL	ES	LH	SES	07/2009							
17	AS BUILT WS1191988 RAW GAS BYPASS TO CHILLERS	ES	AAB	LH	SES	12/07							
16	AS BUILT WS1191988 RAW GAS LTS BYPASS TO CHILLERS	KN	LH	MP	PJR	10/07	26	CONTINUATION FROM P&ID SPLITTING 0105-0014	JCC	RL	AM	SES	06/2016
15	AS BUILT WS98333 COGEN FUEL SUPPLY	PJ	LH	MP	PJR	05/07	25	AS BUILT P84-871 DEMOLITION OF KGTP EQUIP & NRV No's ADDED	RL	JC/NA	AM	SES	04/2016
14	AS BUILT FOR BUTANE FUEL DELETION	VB	SS	AAB	LH	09/06	24	AS BUILT P84-871 BUTANE INJECTION PUMP DEMO PROJ.	JCC	RL/CB	AM	SES	11/2015
13	AS BUILT COMMENTS INCORPORATED	VB	RL	LH	PJR	06/06	23	AS BUILT LO VALVE & EQUIPMENT ISOLATIONS	RL	NM/NA	AM	SES	08/2015
12	AS BUILT TO SITE LOGIC	JM	AAB	LH	PJR	21/11/05	22	HAND VALVE NUMBER ADDED FOR ISOLATIONS	RL	JC	AM	SES	07/2015
11	AS BUILT WS853855 MAUI LTS BLENDING TO BALANCE	VB	RH	LH	PJR	8/2004	21	REVISED FOR P&ID SPLITTING. DRG. No's REVISED	RL	JCC	AM	SES	01/2015

VECTOR KAPUNI LIMITED
PRIVATE BAG 2020
NEW PLYMOUTH 4342
PHONE 0800 734 567

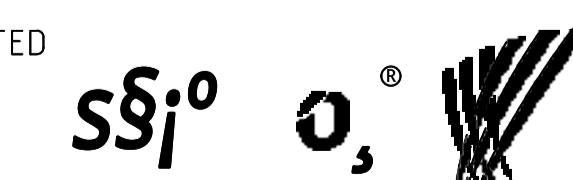

REFERENCE DRAWINGS
0780-0178/01 CAUSE & EFFECTS


UTILITIES
PIPING & INSTRUMENT DIAGRAM
COGENERATION GAS BLENDING METERING

COPYRIGHT The copyright in this document is vested in Vector Kapuni Limited
The contents of this document shall not be reproduced, either in whole or part, by any
means whatsoever without the prior written consent of Vector Kapuni Limited.

DRN	J. WELLS	11/10/1998	ENG	K. ALLUM
CHK	K. EDEN		APP	G. MUIR

SCALE:	JOB NO.	SERIES	DRG. NO	SHT 01	REVISION
N/A	1000000	0109	0040	01	26

1000000-0109-0040-01.DWG

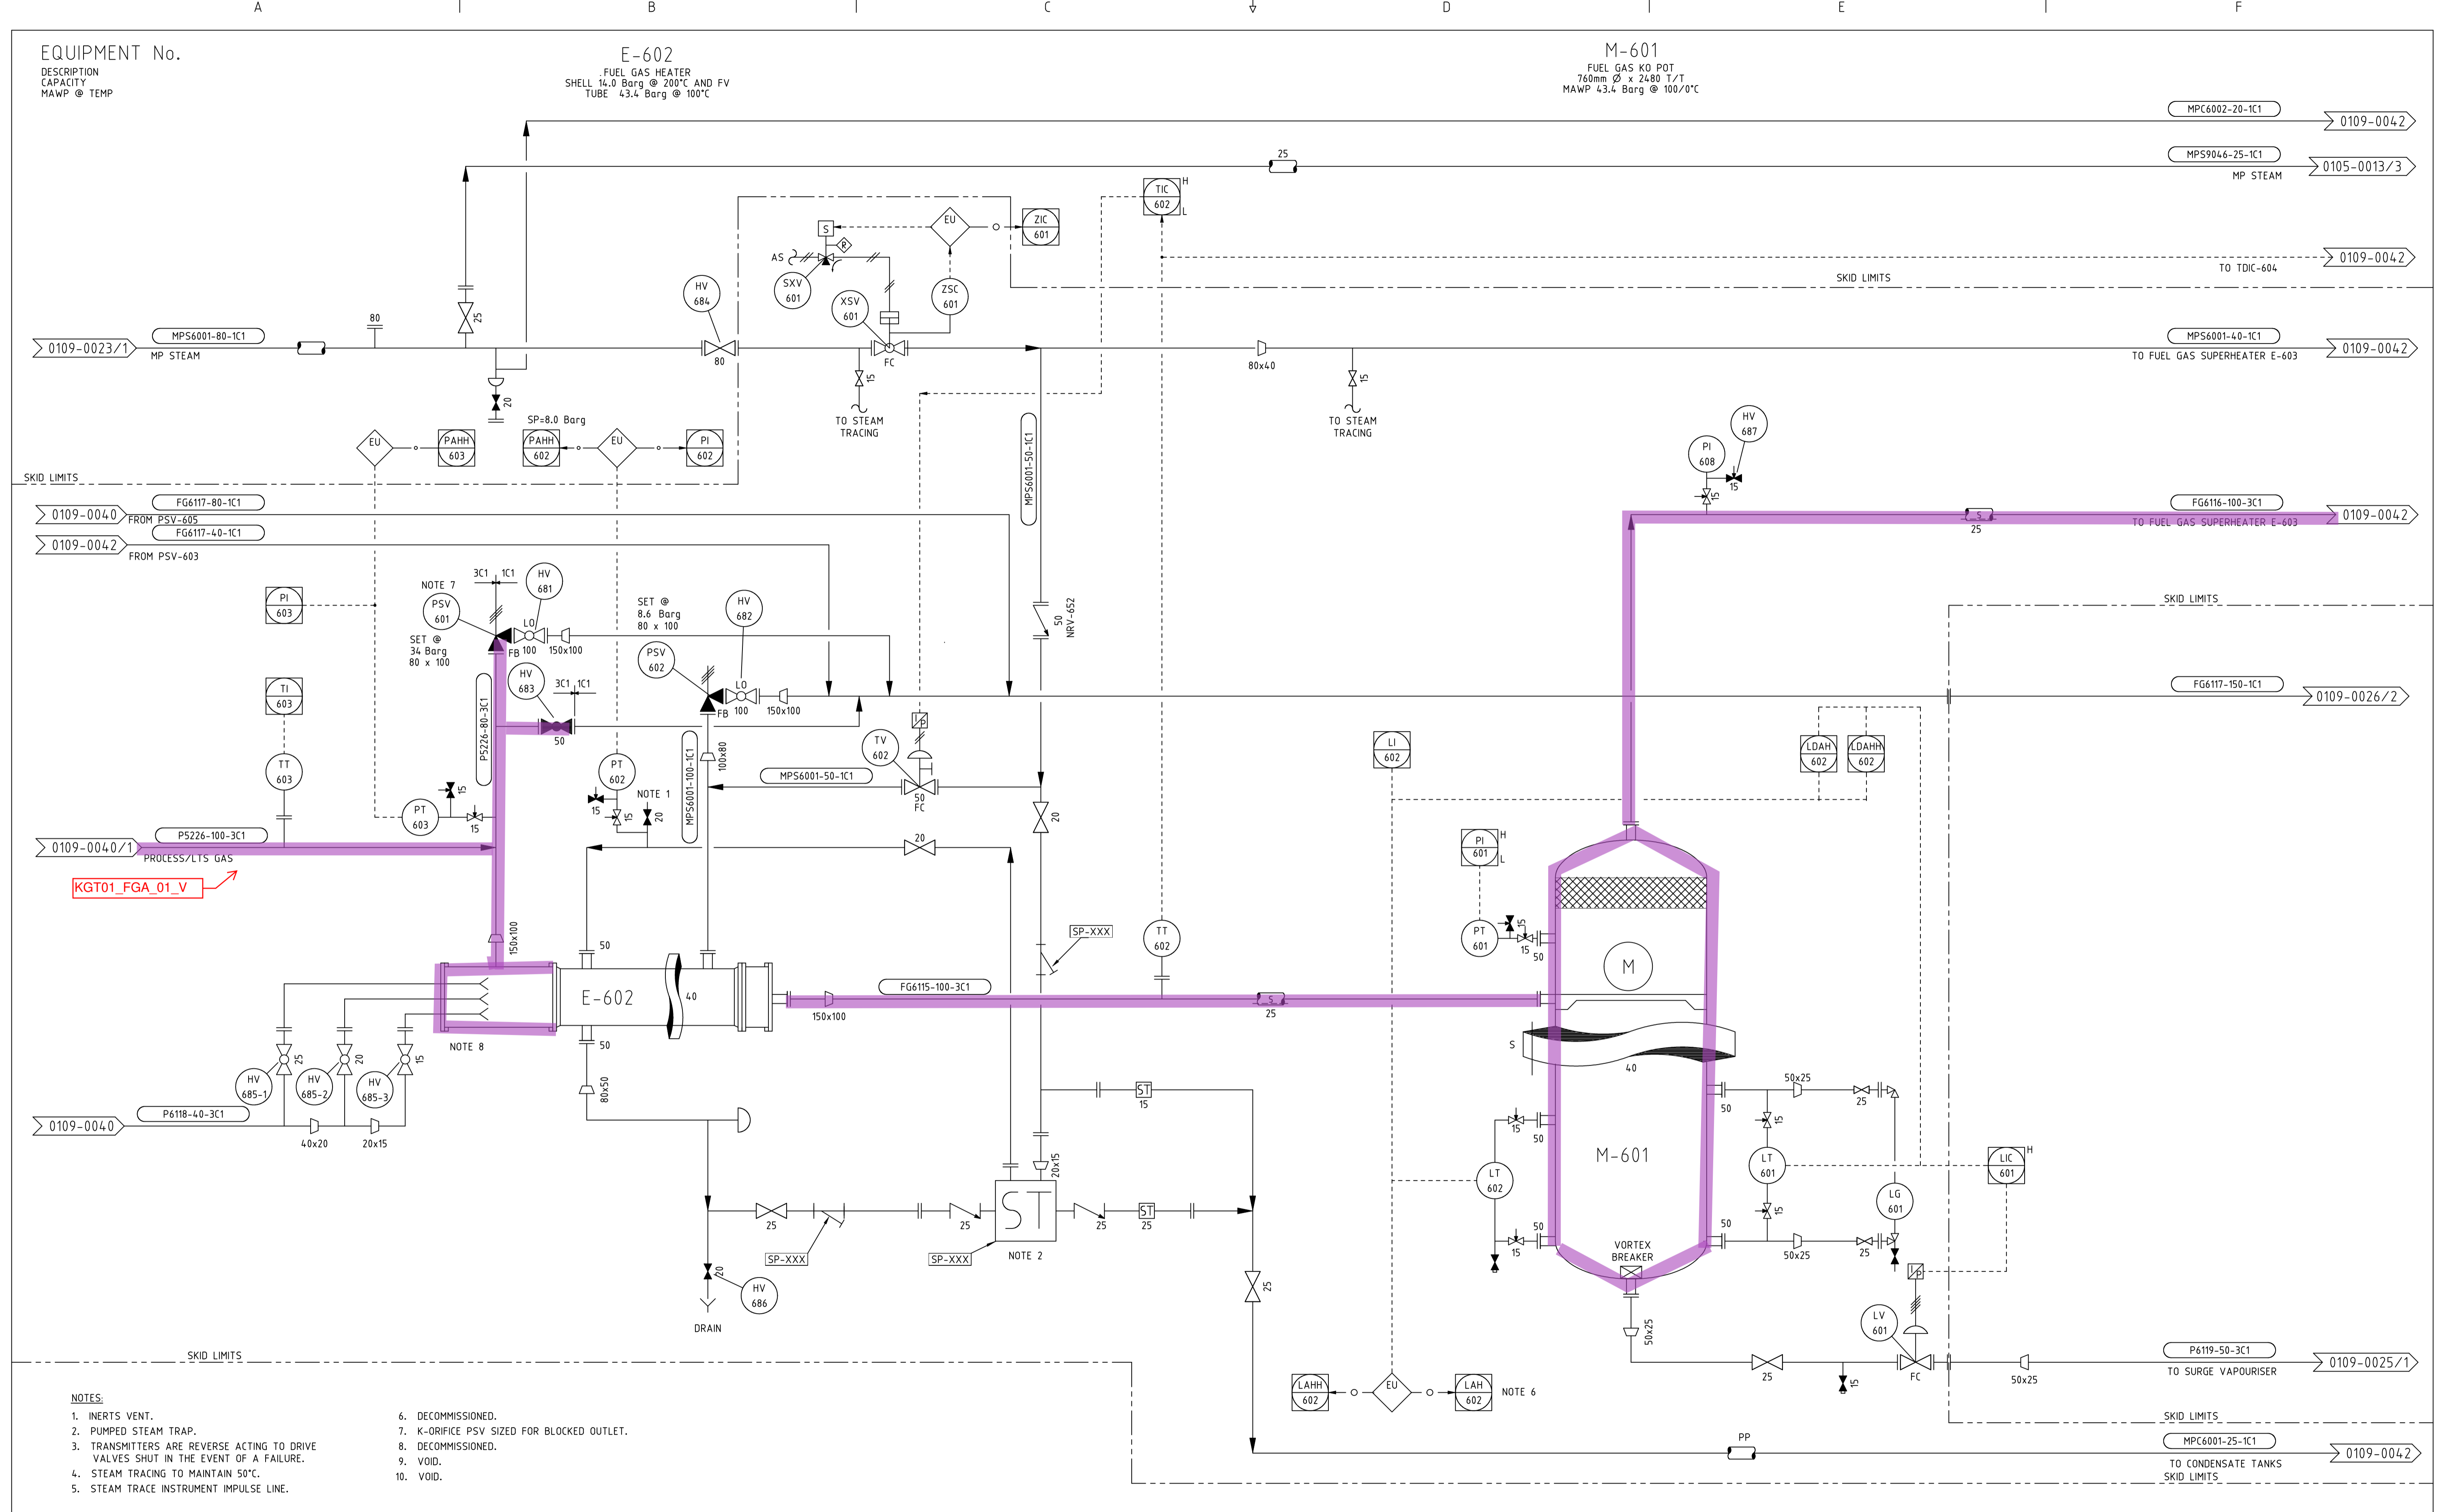

EQUIPMENT No.
DESCRIPTION
CAPACITY
MAWP @ TEMP

E-602
FUEL GAS HEATER
SHELL 14.0 Barg @ 200°C AND FV
TUBE 43.4 Barg @ 100°C

M-601
FUEL GAS KO POT
760mm Ø x 2480 T/T
MAWP 43.4 Barg @ 100/0°C

- NOTES:
1. INERTS VENT.
 2. PUMPED STEAM TRAP.
 3. TRANSMITTERS ARE REVERSE ACTING TO DRIVE VALVES SHUT IN THE EVENT OF A FAILURE.
 6. DECOMMISSIONED.
 7. K-ORIFICE PSV SIZED FOR BLOCKED OUTLET.
 8. DECOMMISSIONED.
 9. VOID.
 10. VOID.

REV	AMENDMENT	BY	CHK	ENG	APP	DATE	REV	AMENDMENT	BY	CHK	ENG	APP	DATE
10	AS BUILT P84-1041 FLARE GAS MEASUREMENT					09/12			ES/RL	TC	AM	SES	09/12
9	AS BUILT P84-3007 ESD LEVEL TRANS DEVIATION ALARMS					03/10			ES	TC	LH	SES	03/10
8	AS BUILT WS1334854 FLANGES ADDED TO STEAM TRAP					10/09			ES	RL	LH	SES	10/09
7	AS BUILT WS998333 COGEN FUEL SUPPLY					05/07			PJ	LH	MP	PJR	05/07
6	AS BUILT TO SITE LOGIC					21/11/05			JM	AAB	LH	PJR	21/11/05
5	DESIGN DATA RATIONALISED					09/02			GJH	DJP	AvG	AIM	09/02
4	BARG FOR PAHH-602 MODIFIED					02/01			VB	RL	EJH	RJW	02/01
3	AS BUILT FOR COGEN FUEL GAS SKID BYPASS LINE					05/00			RL	JBH	EJH	RS	05/00
2	REVISED FOR NEW PRINT. DRAWING CONTENT NOT CHANGED	JCC	RL/AC	AM	SES	04/2018			VB	RL	EJH	RS	10/99
11	HAND VALVE NUMBERS ADDED FOR ISOLATIONS	RL	CR	AM	SES	04/2014			V.B.	G.R.	K.A.	G.M.	02/98

VECTOR KAPUNI LIMITED
PRIVATE BAG 2020
NEW PLYMOUTH 4342
PHONE 0800 734 567

COPYRIGHT The copyright in this document is vested in Vector Kapuni Limited. The contents of this document shall not be reproduced, either in whole or part, by any means whatsoever without the prior written consent of Vector Kapuni Limited.

AUTOCAD ORIGINAL SHEET SIZE A1

REFERENCE DRAWINGS
CAUSE & EFFECT 0780-0178/01

DRN	J. WELLS	14/10/1996	ENG	K. ALLUM	14/10/1996
CHK	K. EDEN	14/10/1996	APP	G. MUIR	14/10/1996

UTILITIES
PIPING & INSTRUMENT DIAGRAM
COGENERATION GAS BLENDING METERING


SCALE:	JOB NO.	SERIES	DRG. NO	SHT 01 OF 01 SHTS	REVISION
NONE	1000000	0109	0041		12

EQUIPMENT No.

DESCRIPTION
CAPACITY
MAWP @ TEMP

E-603

FUEL GAS SUPERHEATER
SHELL 14.0 BarG @ 200°C
TUBE 43.4 BarG @ 100°C

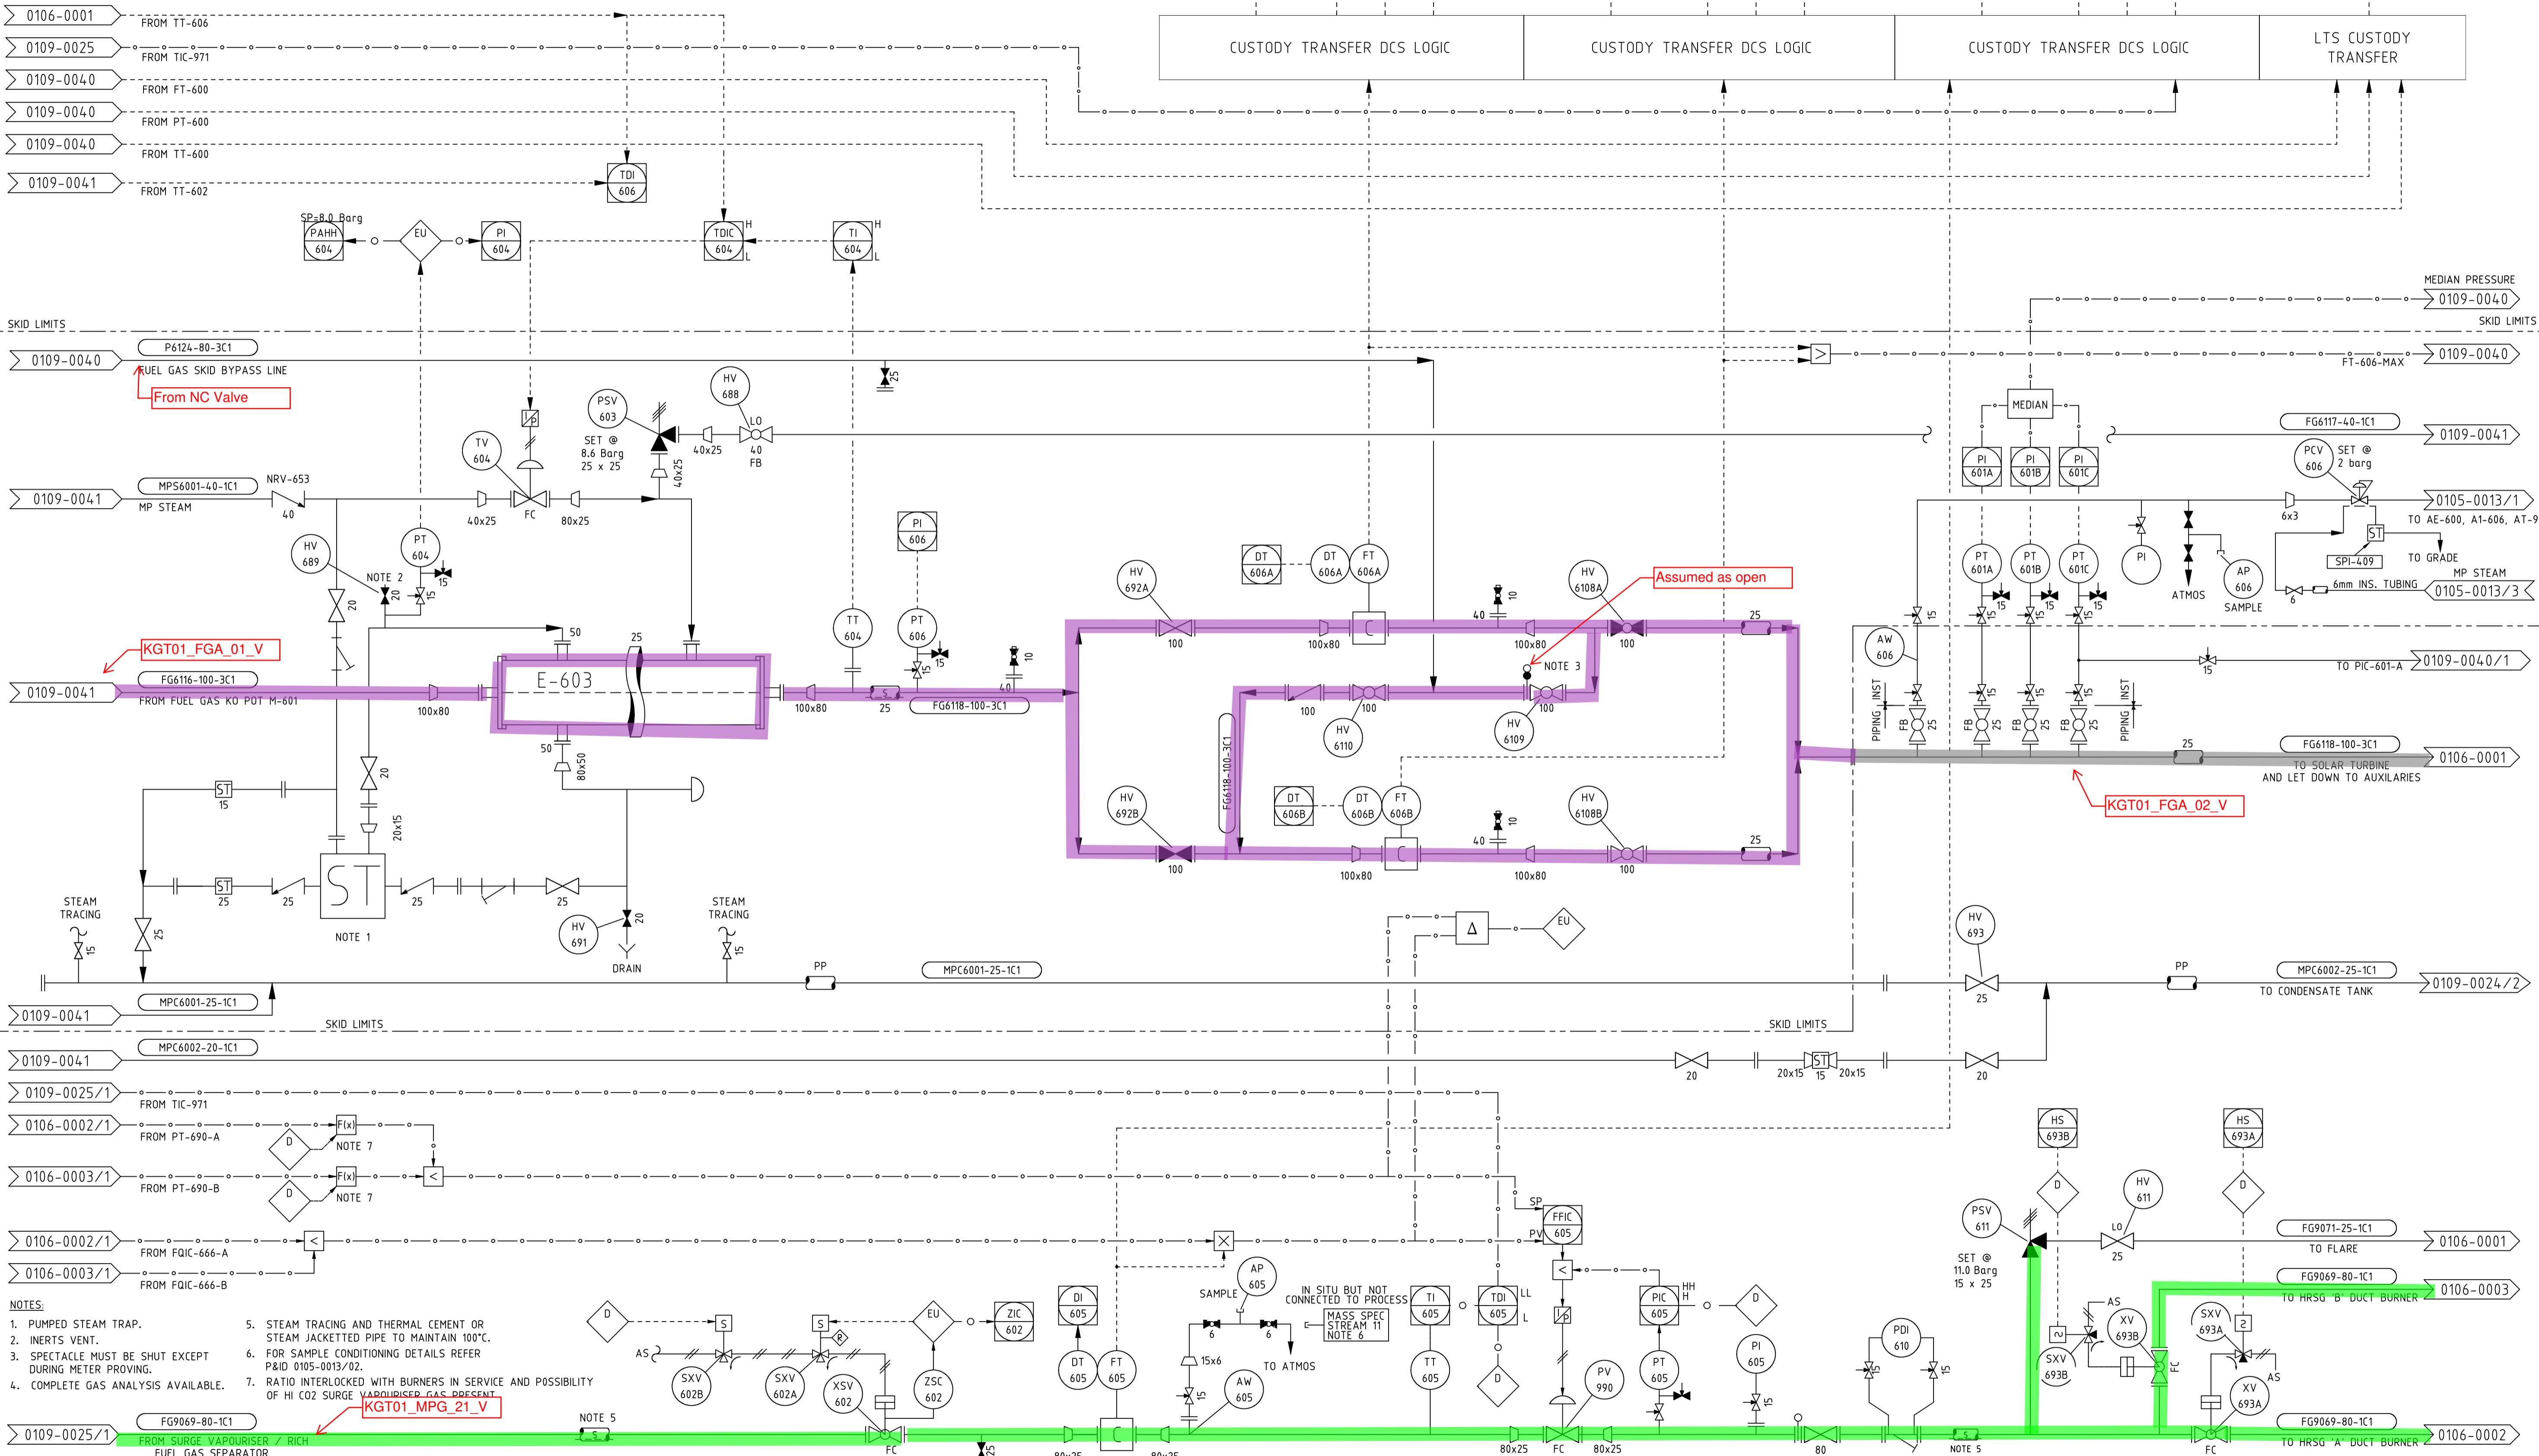

- NOTES:
1. PUMPED STEAM TRAP.
 2. INERTS VENT.
 3. SPECTACLE MUST BE SHUT EXCEPT DURING METER PROVING.
 4. COMPLETE GAS ANALYSIS AVAILABLE.
 5. STEAM TRACING AND THERMAL CEMENT OR STEAM JACKETED PIPE TO MAINTAIN 100°C.
 6. FOR SAMPLE CONDITIONING DETAILS REFER P&ID 0105-0013/02.
 7. RATIO INTERLOCKED WITH BURNERS IN SERVICE AND POSSIBILITY OF HI CO2 SURGE VAPOURISER GAS PRESENT.

REV	AMENDMENT	BY	CHK	ENG	APP	DATE	REV	AMENDMENT	BY	CHK	ENG	APP	DATE
20	AS BUILT HS-693A AND B ADDED	RL	ES/AB	LH	SES	04/2010	10	CONTINUATION NAMES REVISED	RL	JBH	LH	PJR	09/03
19	AS BUILT P84-3085 SURGE VAP TO HRSG BURN LAB S/P	ES	RL	LH	SES	10/09	9	AS BUILT-BLOCK VALVE ADDED DOWNSTREAM OF PSV-611	PL	RL	LH	AIM	01/03
18	AS BUILT WS1334854	ES	RL	LH	SES	10/09	8	AS BUILT WS156953 COGEN AUX. FUEL	CMW	RL	DC	AIM	11/02
17	PCV-606 TAKEN FROM P&ID 0105-0013/1	ES	JY	LH	SES	02/09	7	WS184313 SURGE VAPOURISER TO COGEN FUEL AS BUILT	JBH	RL	AAB	PJR	07/08/02
16	AS BUILT WS1042819 BENFIELD SYSTEM HAZARD REPORT	ES	CP	LH	DS	10/07	6	COGEN FUEL TRIP MODS ADDED	JBH	AB	LH	RJW	30/05/01
15	AS BUILT WS998333 COGEN FUEL SUPPLY	PJ	LH	MP	PJR	05/07							
14	AS BUILT FOR WS998333 FUEL GAS HOT TAPS	VB	MP	PR	LH	10/06							
13	AS BUILT TO SITE LOGIC	JM	AAB	LH	PJR	21/11/05	23	VALVE OPEN CLOSED STATUS CHANGED FOR FT-606-A & B	RL	CF	AM	TC	03/2020
12	WS184313 SURGE VAPOURISER TO COGEN FUEL AS BUILT	ES	AAB	LH	PJR	08/05	22	HAND VALVE NUMBERS ADDED FOR ISOLATIONS	RL	JC	AM	SES	07/2015
11	TDI-606 ADDED. AS BUILT WS861110 SAMPLE POINT	JBH	RL	LH	PJR	12/2004	21	HAND VALVE NUMBERS ADDED FOR ISOLATIONS	RL	CR	AM	SES	04/2014

VECTOR KAPUNI LIMITED
PRIVATE BAG 2020
NEW PLYMOUTH 4342
PHONE 0800 734 567

ssj^o

COPYRIGHT The copyright in this document is vested in Vector Kapuni Limited. The contents of this document shall not be reproduced, either in whole or part, by any means whatsoever without the prior written consent of Vector Kapuni Limited.


AUTOCAD ORIGINAL SHEET SIZE A1

REFERENCE DRAWINGS
CAUSE & EFFECT 0780-0178/01

DRN	J. WELLS	15/10/1996	ENG	K. ALLUM	15/10/1996
CHK	K. EDEN	15/10/1996	APP	G. MUIR	15/10/1996

UTILITIES
PIPING & INSTRUMENT DIAGRAM
COGENERATION GAS BLENDING METERING

SCALE:	JOB NO.	SERIES	DRG. NO	SHT	REVISION
NONE	1000000	0109	0042	01 OF 01 SHTS	23

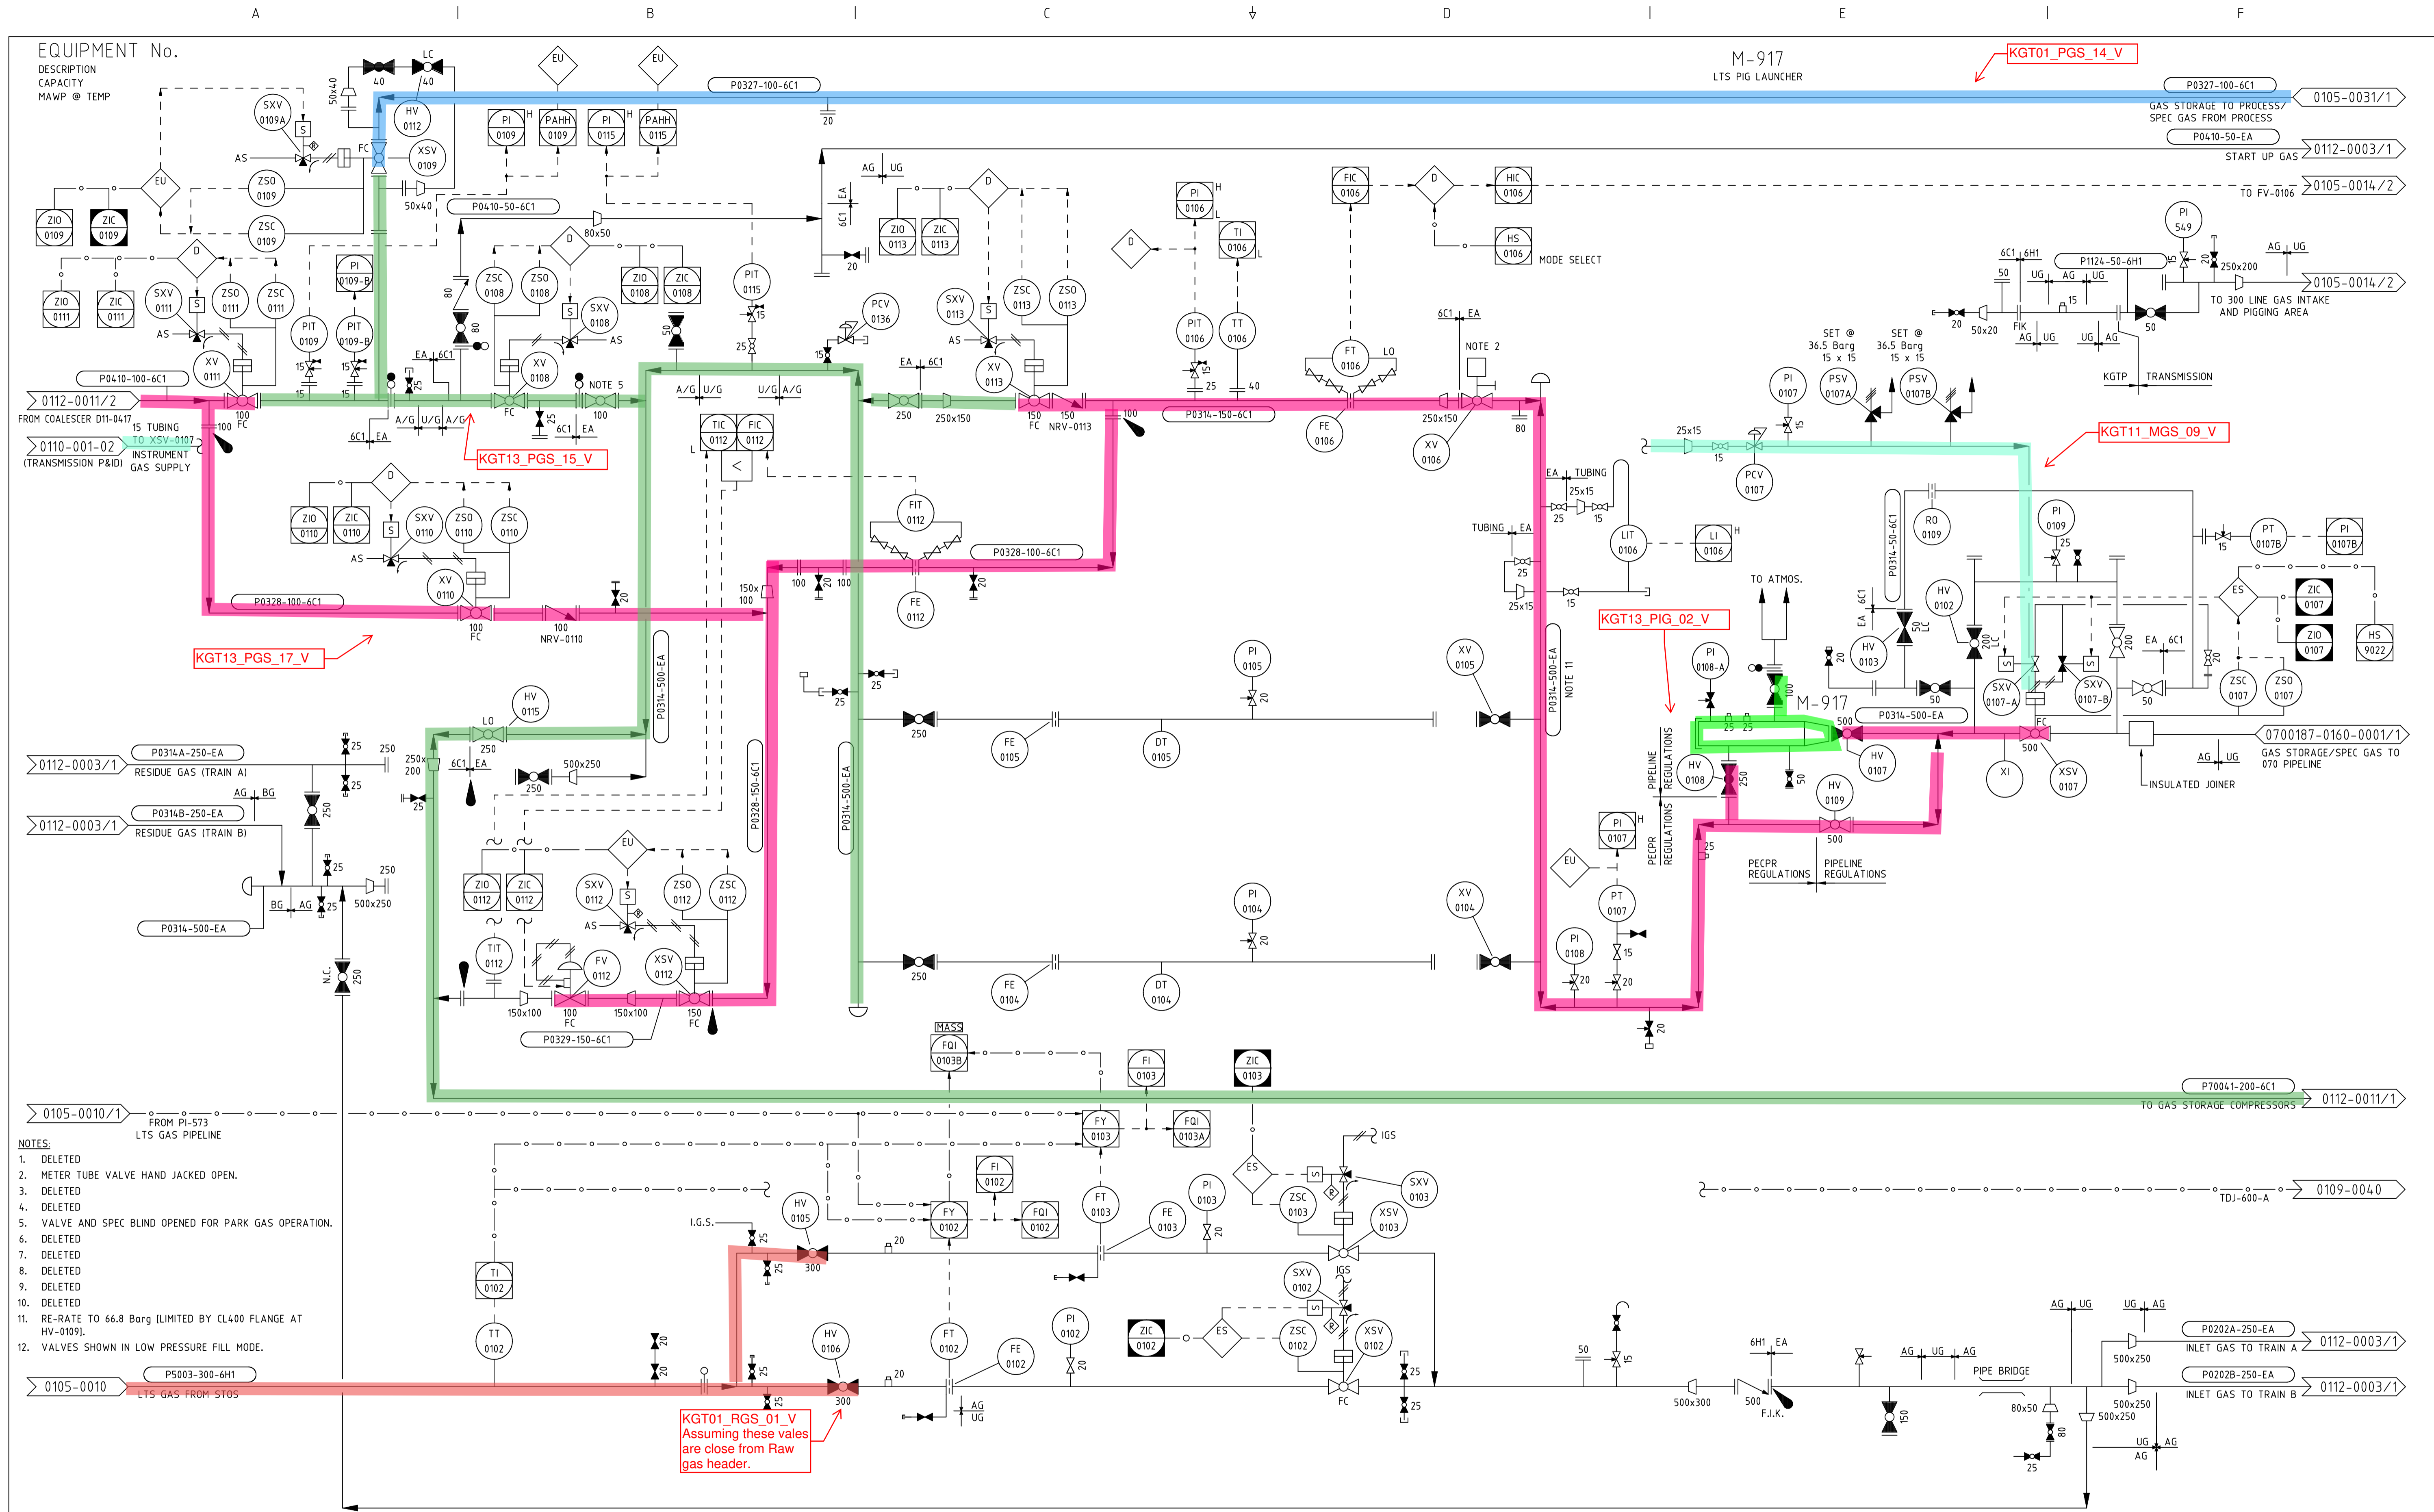

- NOTES:**
- DELETED
 - METER TUBE VALVE HAND JACKED OPEN.
 - DELETED
 - DELETED
 - VALVE AND SPEC BLIND OPENED FOR PARK GAS OPERATION.
 - DELETED
 - DELETED
 - DELETED
 - DELETED
 - DELETED
 - RE-RATE TO 66.8 Barg (LIMITED BY CL400 FLANGE AT HV-0109).
 - VALVES SHOWN IN LOW PRESSURE FILL MODE.

REV	DESCRIPTION	BY	CHK	ENG	APP	DATE	REV	DESCRIPTION	BY	CHK	ENG	APP	DATE
20	METHANEX METERING DECOMMISSIONED	ES	TC	LH	SES	08/09	30	AS BUILT P84-1423 SPEC BLIND ON M-917 VENT & NRV No's ADDED	RL	JCC	AM	TC	09/2018
19	AS BUILT - TODD - PO-K3P-09-KGTH-002	PJB	MAW	CRP	LH	08/09	29	TRANSMISSION / KGTP DEMARCATION ADDED RE INCIDENT ACTION	RL	JCC	AM	SES	05/2016
18	AS BUILT WS1467198 PARK GAS/IMPORT GAS	ES	TC	LH	SES	11/08	28	AS BUILT FOR PIPELINE DEMARCATION & HAND VALVE NUMBERS	RL	JCC	AM	SES	02/2016
17	AS BUILT REVISIONS IE. PAL-0107B & PAH-0107B ADDED	RL	CP	LH	DS	10/2007	27	VALVE STATUS REVISED FOR HV-0102 & 0108 REGARDING LO, LC	RL	JCC	AM	SES	08/2015
16	KGTP/TRANSMISSION DEMARCATION UPDATE	ES	AVG	LH	PJR	01/07	26	ADDED HV TAG NUMBERS, ADDED PSV 0107A/B SIZE, MOVE PIT-0115	JCC	RL	AM	SES	05/2015
15	GAS GATHERING MODE	RL	ES	LH	PJR	07/2006	25	CONTIN. DRG. No. REVISED FROM 1000001-010-001/2 TO 3000188-010-001/1	RL/ES	CR	AM	SES	06/2012
							24	CONTIN. DRG. No. REVISED FOR EXPORT COMPRESSOR RE-NUMBERING	RL/ES	MH	AM	SES	05/2012
							23	AS BUILT GAS STORAGE-REDUNDANT GAS METERING INST'S/RL	CB	AM	SES	02/12	
							22	AS BUILT P84-2749 ENHANCED GAS	SA	CJ	JS	SES	08/11
							21	AS BUILT P84-920 PARK GAS	CJ	GH	JS	LH	09/10
31	CONTINUATION DRAWING No. REVISED FOR 070 PIPELINE	RL	JCC	AM	TC	02/2019	21						
REV	AMENDMENT	BY	CHK	ENG	APP	DATE	REV	AMENDMENT	BY	CHK	ENG	APP	DATE

VECTOR KAPUNI LIMITED
 PRIVATE BAG 2020
 NEW PLYMOUTH 4342
 PHONE 0800 734 567

ssj^o

COPYRIGHT The copyright in this document is vested in Vector Kapuni Limited. The contents of this document shall not be reproduced, either in whole or part, by any means whatsoever without the prior written consent of Vector Kapuni Limited.

AUTOCAD ORIGINAL SHEET SIZE A1


REFERENCE DRAWINGS

CAUSE & EFFECT 0780-0149/1
 CAUSE & EFFECT 0780-0081/2

DRN	DATE	ENG	APP
G.ROBERTSON	01/07/1986	ENG	
B.CLARKE	01/07/1986	APP	

LTS CONDITIONING PLANT
 PIPING & INSTRUMENT DIAGRAM
 METERING & LTS GAS OUT

SCALE:	JOB NO.	SERIES	DRG. NO	SHT 01	REVISION
NTS	1000000	0112	0002	01	31

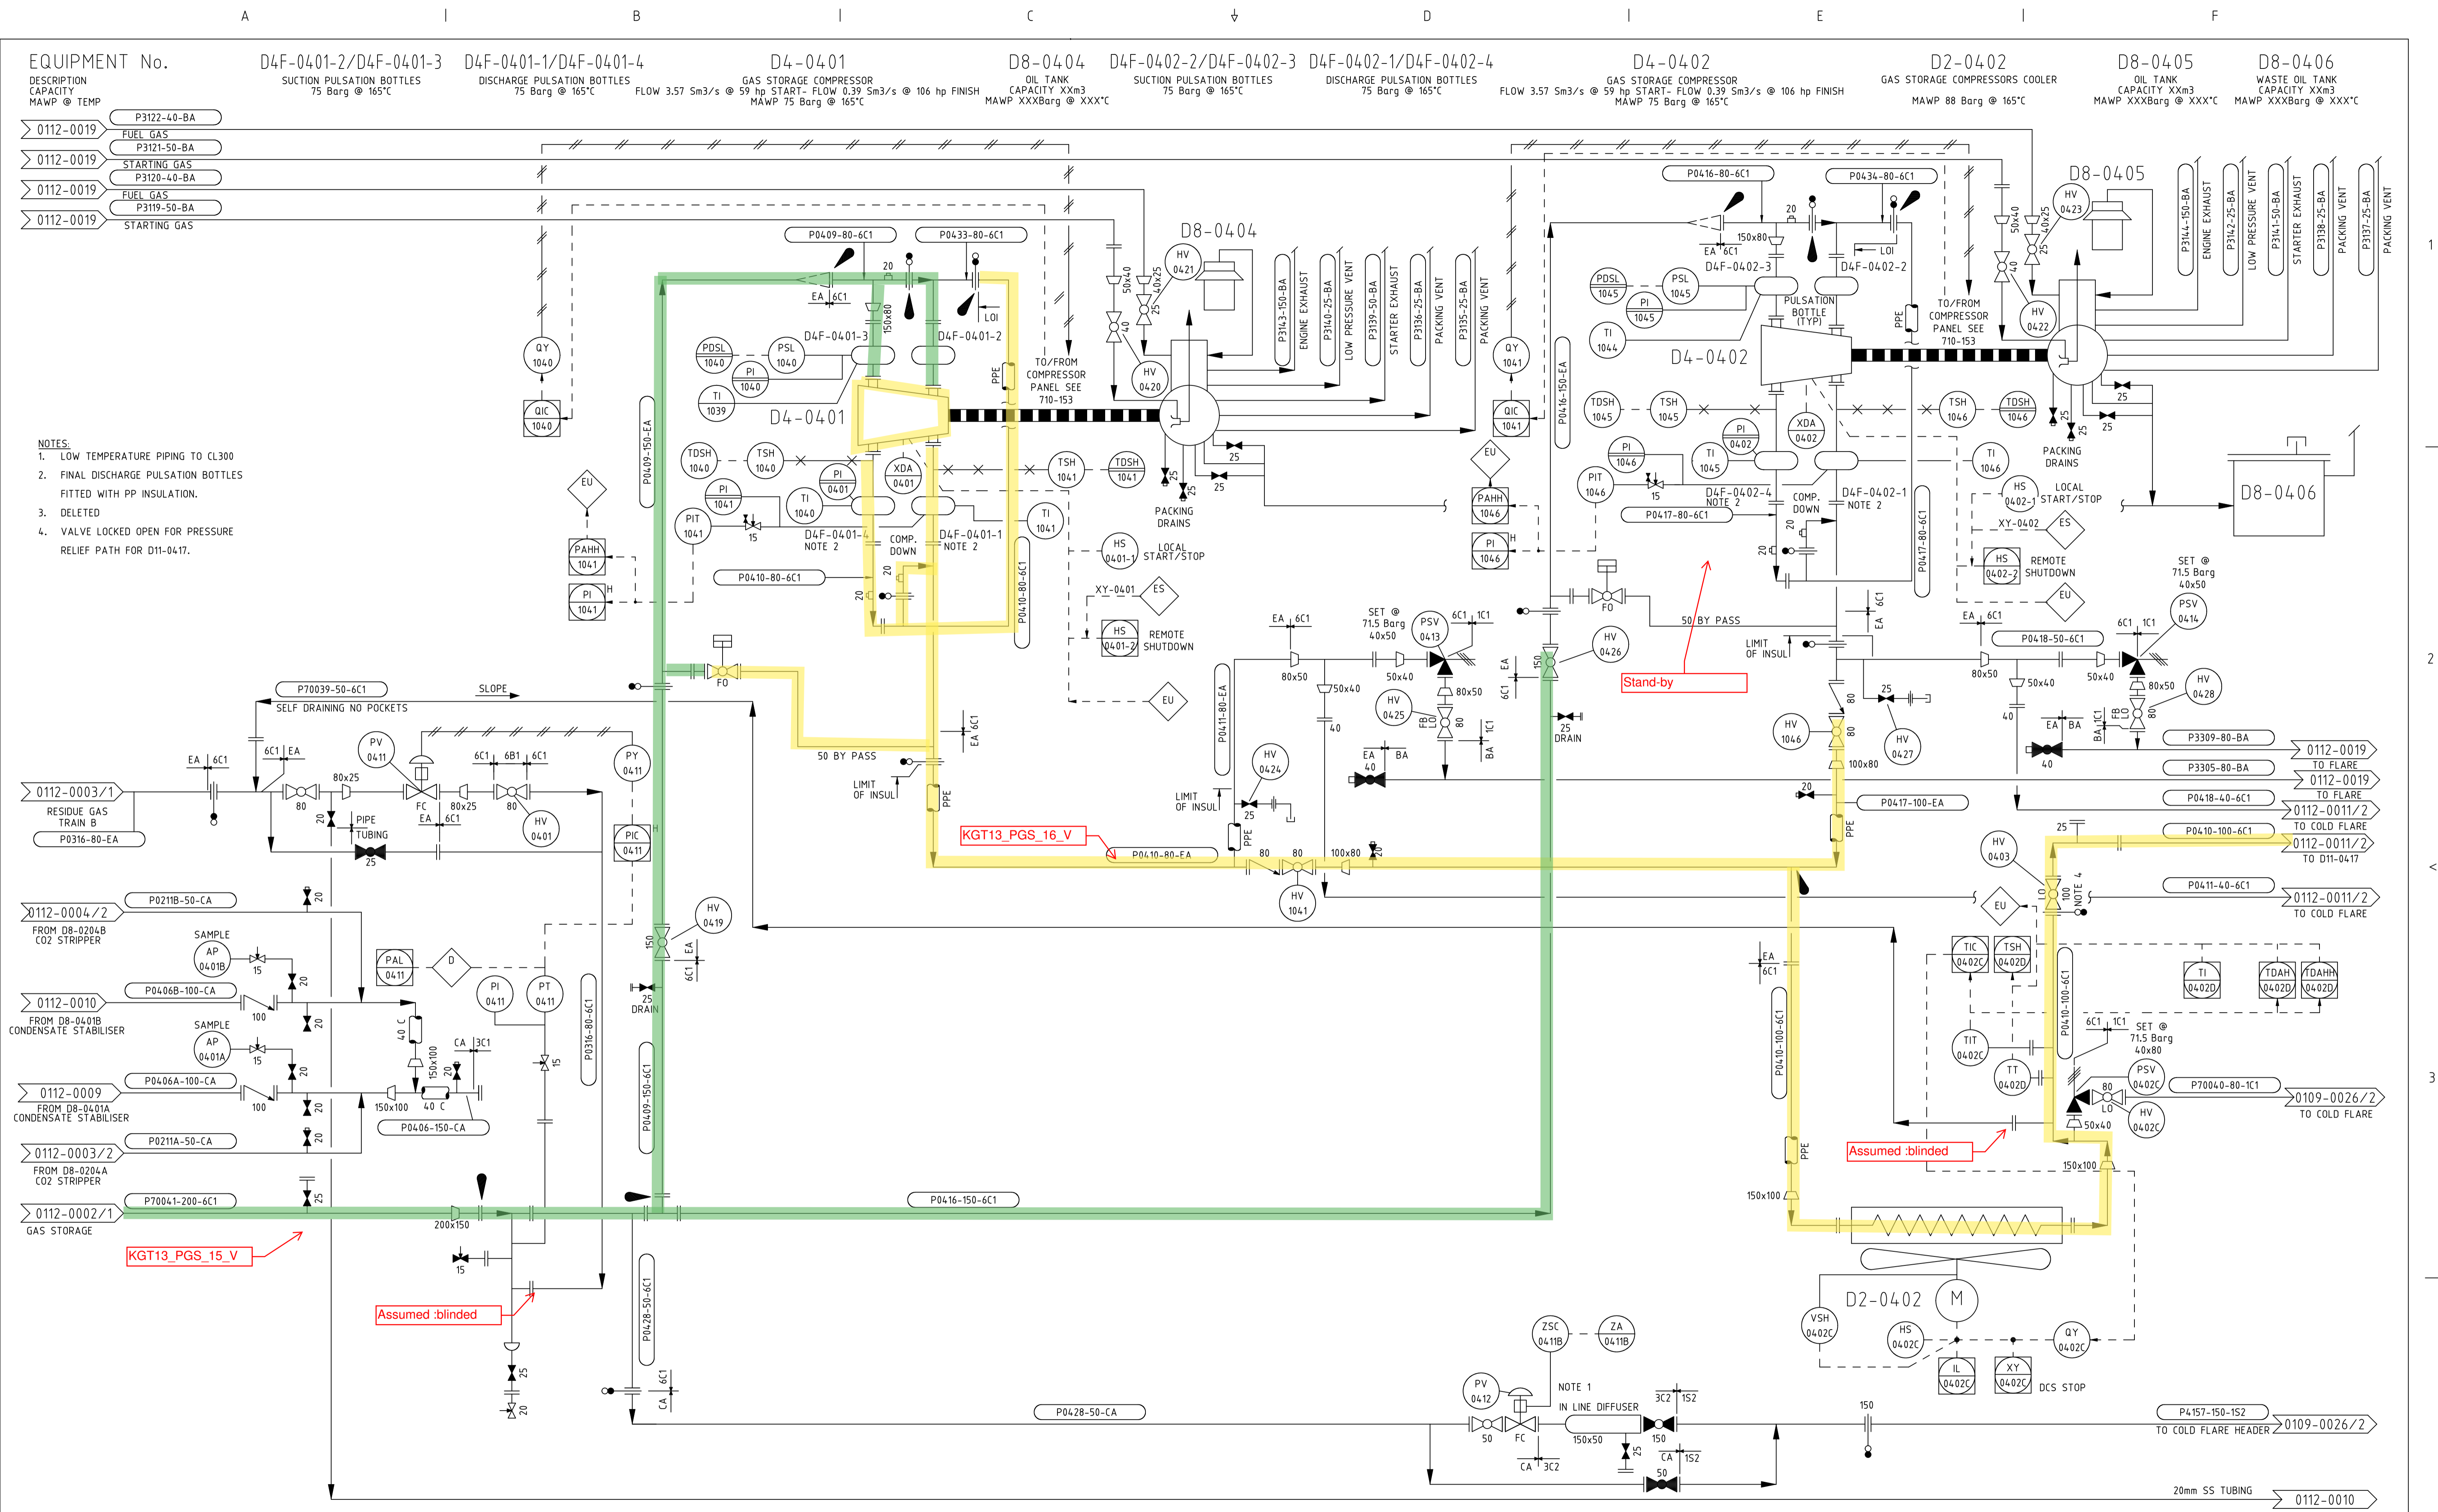

- NOTES:
1. LOW TEMPERATURE PIPING TO CL300
 2. FINAL DISCHARGE PULSATION BOTTLES FITTED WITH PP INSULATION.
 3. DELETED
 4. VALVE LOCKED OPEN FOR PRESSURE RELIEF PATH FOR D11-0417.

REV	AMENDMENT	BY	CHK	ENG	APP	DATE	REV	AMENDMENT	BY	CHK	ENG	APP	DATE
17	LINES P4158, P4159, P5109 & P5110 MOVED TO SHEET 02	RL	ES	LH	SES	11/2010	7	RETURNED TO NGC POST KAHILI GAS GATHERING WS860238	RL	DT	LH	PJR	11/2004
16	PULSATION BOTTLE EQUIPMENT NUMBERS REVISED	CJ	GH	JS	LH	09/10	6	DESIGN DATA RATIONALISED	GJH	DJP	AVG	AIM	09/02
15	AS BUILT P84-920 PARK GAS	CJ	GH	JS	LH	08/10	5	UNDERGROUND AREA DEFINED FOR P0410	VB	RL	EJH	RS	10/99
14	AS BUILT P84-3007 ESD LEVEL TRANS DEVIATION ALARMS	ES	TC	LH	SES	04/10							
13	AS BUILT WS1460367 RECOVER GATHERED GAS TO LPG SV	RL	MB	LH	SES	07/09							
12	AS BUILT WS1498656 - REPLACEMENT OF MOD30 DCS	ES	TC	LH	SES	06/09	22	AS BUILT P84-3407 & HV-0403 VALVE NUMBER	JCC	RL	AM	SES	10/2015
11	AS BUILT WS1467198 - PARK GAS/IMPORT GAS	ES	TC	LH	SES	11/08	21	HAND VALVE NUMBERS ADDED FOR ISOLATIONS	RL	CR	AM	SES	07/2013
10	AS BUILT WS 1023482	ES	AAB	TC	PJR	12/06	20	AS-BUILT VALVES ADDED TO LINES P3120 & P3119	RL/ES	MB	SRH	SES	12/2011
9	GAS GATHERING MODE	ES	RL	LH	PJR	06/06	19	AS-BUILT P84-2749 ENHANCED GAS COMMISSIONING	SA	CJ	JS	SES	08/2011
8	WS971015 AS BUILT. GAS TO METHANEX	JBH	RL	LH	PJR	03/02/05	18	AS BUILT P84-2749 ENHANCED GAS INTERIM WORKSCOPE	RL/ES	JG	JS	SES	05/2011

VECTOR KAPUNI LIMITED
PRIVATE BAG 2020
NEW PLYMOUTH 4342
PHONE 0800 734 567

REFERENCE DRAWINGS
CAUSE & EFFECT 0780-0081/2
PANEL PNEUMATICS 0710-0153 01/02

LTS CONDITIONING PLANT
PIPING & INSTRUMENT DIAGRAM
GAS STORAGE COMPRESSION

SCALE: NONE

JOB NO. 1000000

SERIES 0112

DRG. NO 0011

SHT 01 OF 02 SHTS

REVISION 22


DRN G.ROBERTSON 08/06/1986 ENG

CHK B.CLARKE 08/06/1986 APP

DATE DATE

AUTOCAD ORIGINAL SHEET SIZE A1

COPYRIGHT The copyright in this document is vested in Vector Kapuni Limited
The contents of this document shall not be reproduced, either in whole or part, by any means whatsoever without the prior written consent of Vector Kapuni Limited.

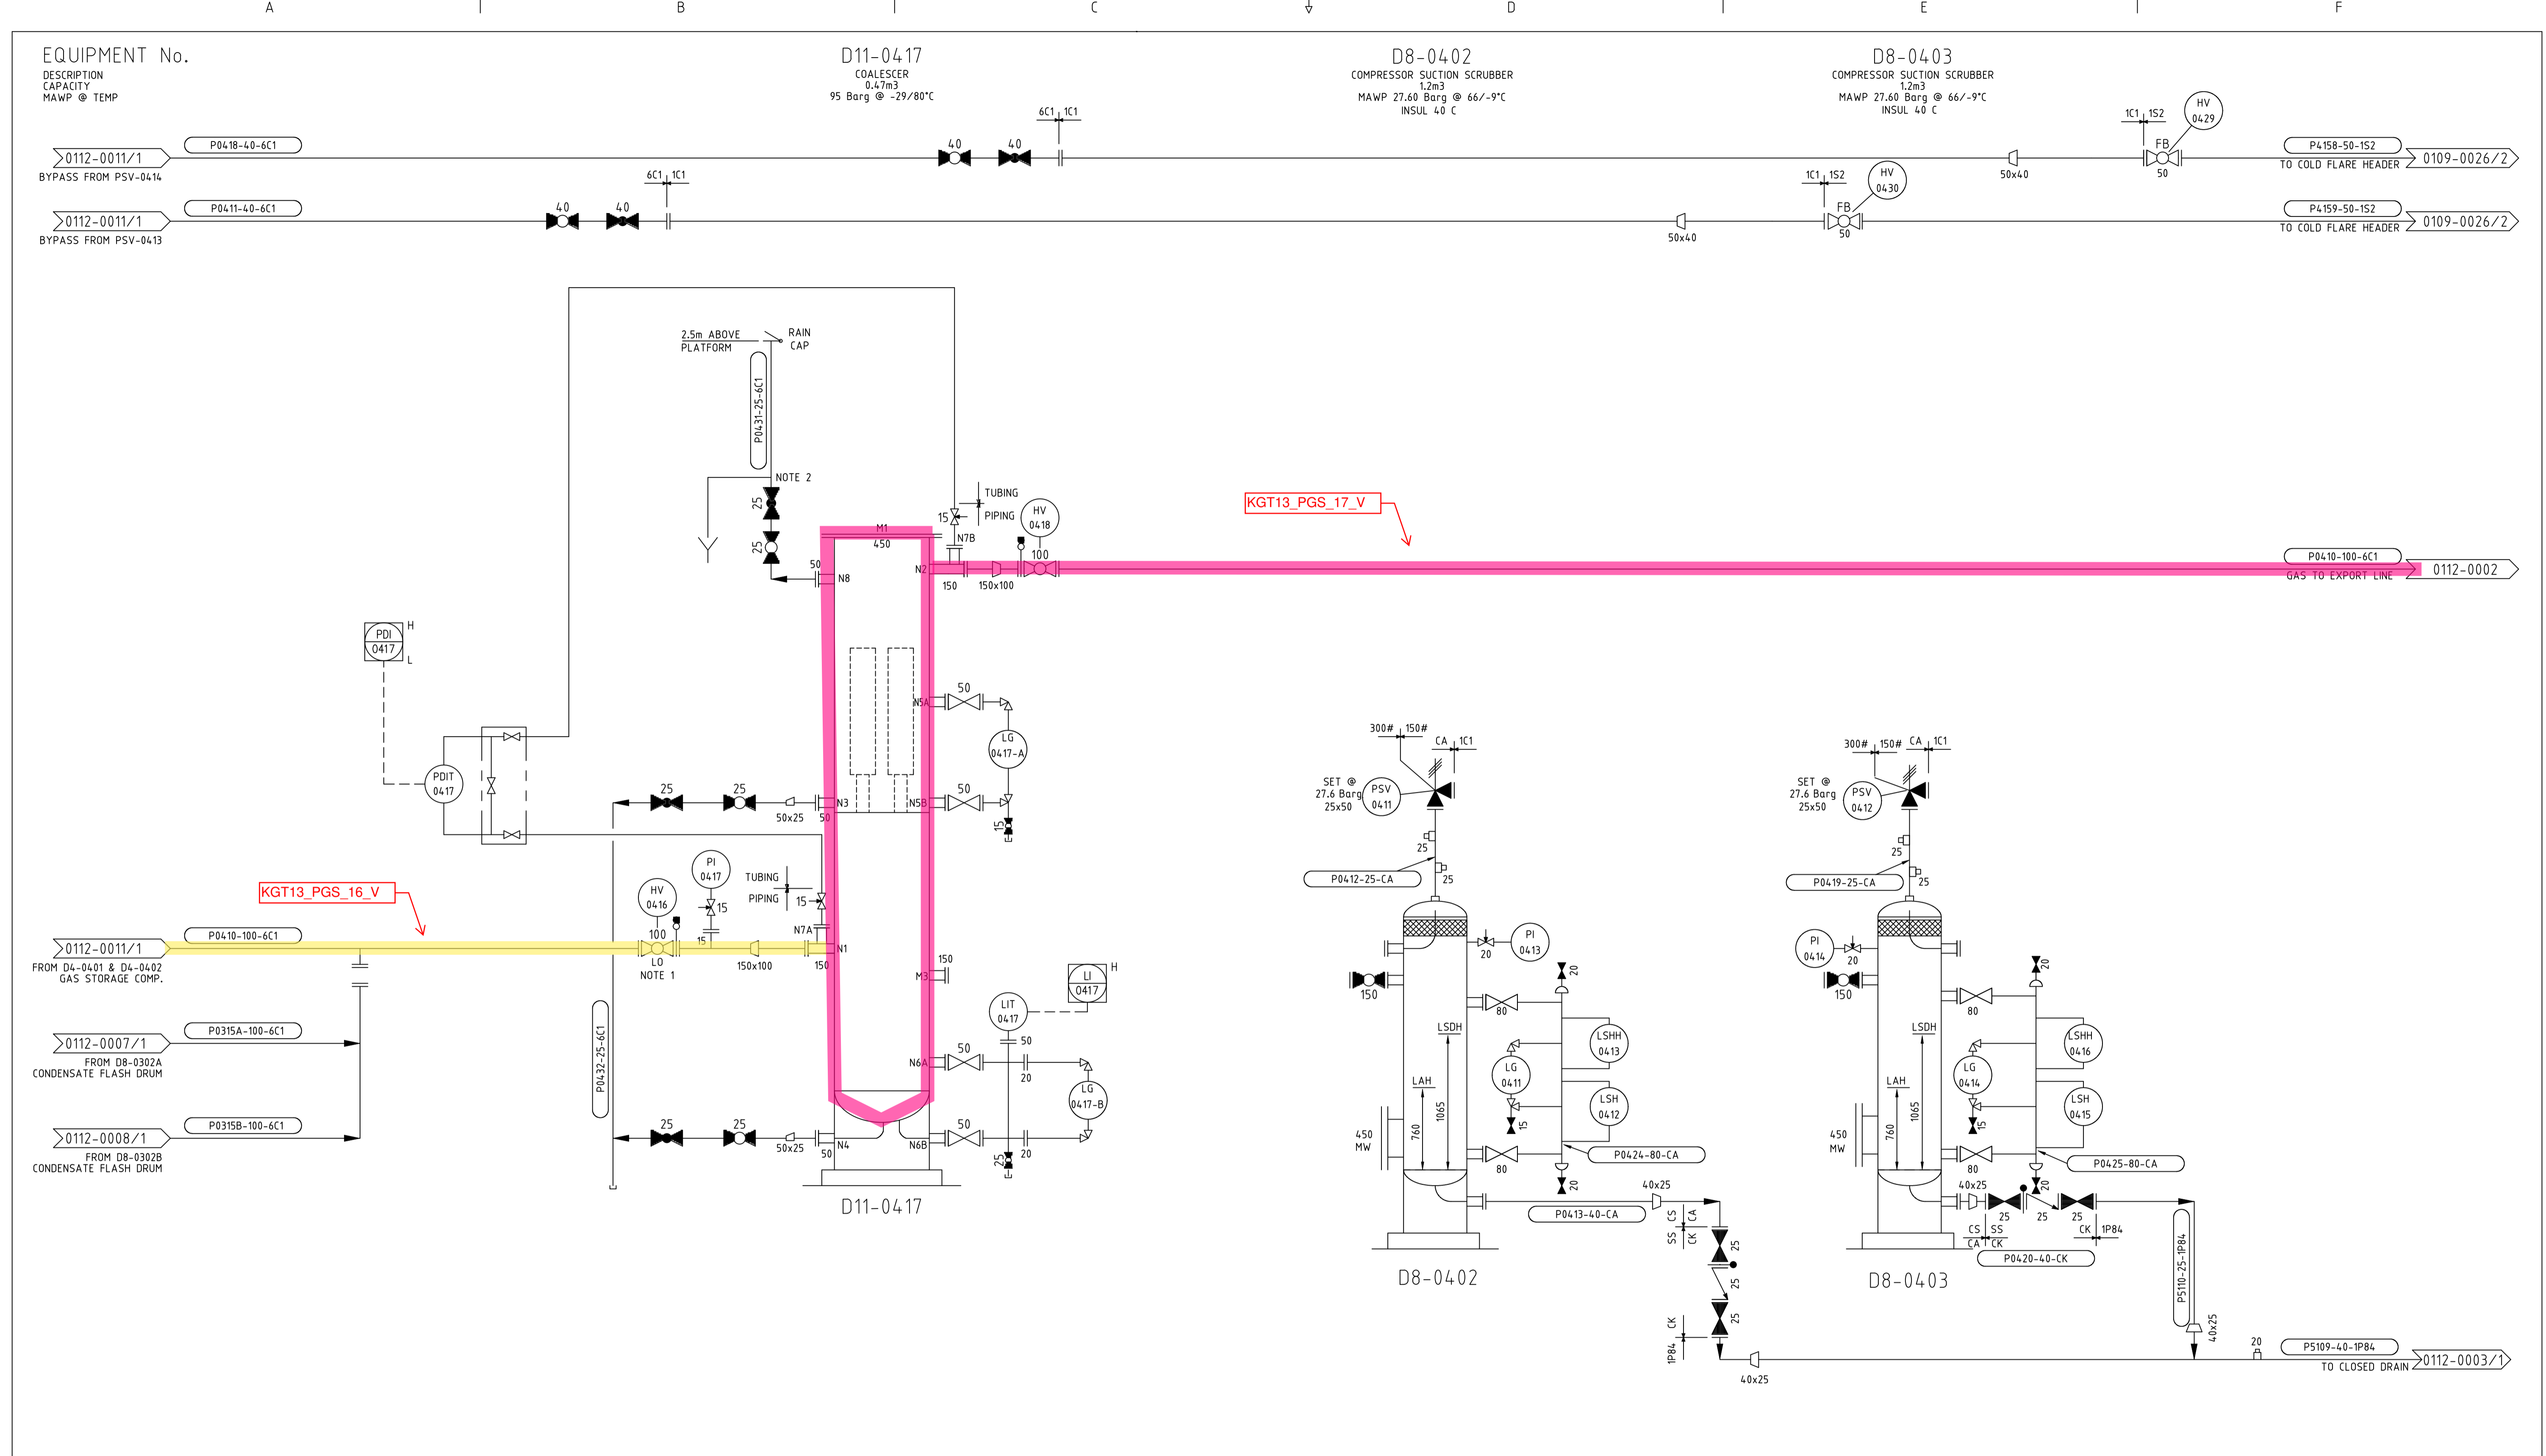

NOTES:
 1. VALVE IS LOCKED OPEN TO PROVIDE RELIEF PATH FOR COALESCER D11-0417.
 2. DRILL 1/4" HOLE IN THE VENT PIPE AS CLOSE ABOVE VALVE AS POSSIBLE. INSTALL TUBING TO DISCHARGE DOWNWARDS TO A SAFE LOCATION

REV	AMENDMENT	BY	CHK	ENG	APP	DATE	REV	AMENDMENT	BY	CHK	ENG	APP	DATE
5	HAND VALVE NUMBER HV-0429 WAS TAGGED HV-0419	RL	CR	AM	SES	10/2013							
4	HAND VALVE NUMBERS ADDED FOR ISOLATIONS	RL	CR	AM	SES	07/2013							
3	AS BUILT 50NB VALVES ON LINE P4158 & P4159 WERE LO	RL/ES	MB	AM	SES	04/2012							
2	AS-BUILT P84-2749 ENHANCED GAS	SA	CJ	JS	SES	08/11							
1	D8-0402 AND 0403 RELOCATED FROM SHEET 01	RL	ES	LH	SES	11/2010							

VECTOR KAPUNI LIMITED
 PRIVATE BAG 2020
 NEW PLYMOUTH 4342
 PHONE 0800 734 567

COPYRIGHT The copyright in this document is vested in Vector Kapuni Limited. The contents of this document shall not be reproduced, either in whole or part, by any means whatsoever without the prior written consent of Vector Kapuni Limited.

AUTOCAD ORIGINAL SHEET SIZE A1

REFERENCE DRAWINGS		DATE	DATE
DRN	R LOCHHEAD	18/11/2010	18/11/2010
CHK	E STARNS	18/11/2010	18/11/2010

LTS CONDITIONING PLANT PIPING & INSTRUMENT DIAGRAM GAS STORAGE COALESCER					
SCALE:	JOB NO.	SERIES	DRG. NO	SHT 02	REVISION
NONE	1000000	0112	0011	OF 02 SHTS	5

DEMARCATON KEY

KGTP ASSETS

ALL ELSE = TRANSMISSION ASSETS


DEMARCATON AGREEMENT:

DATE: 1 MARCH 2016

DRAWN: R LOCHHEAD

TRANSMISSION: R PHIPPS

KGTP: S SMITH

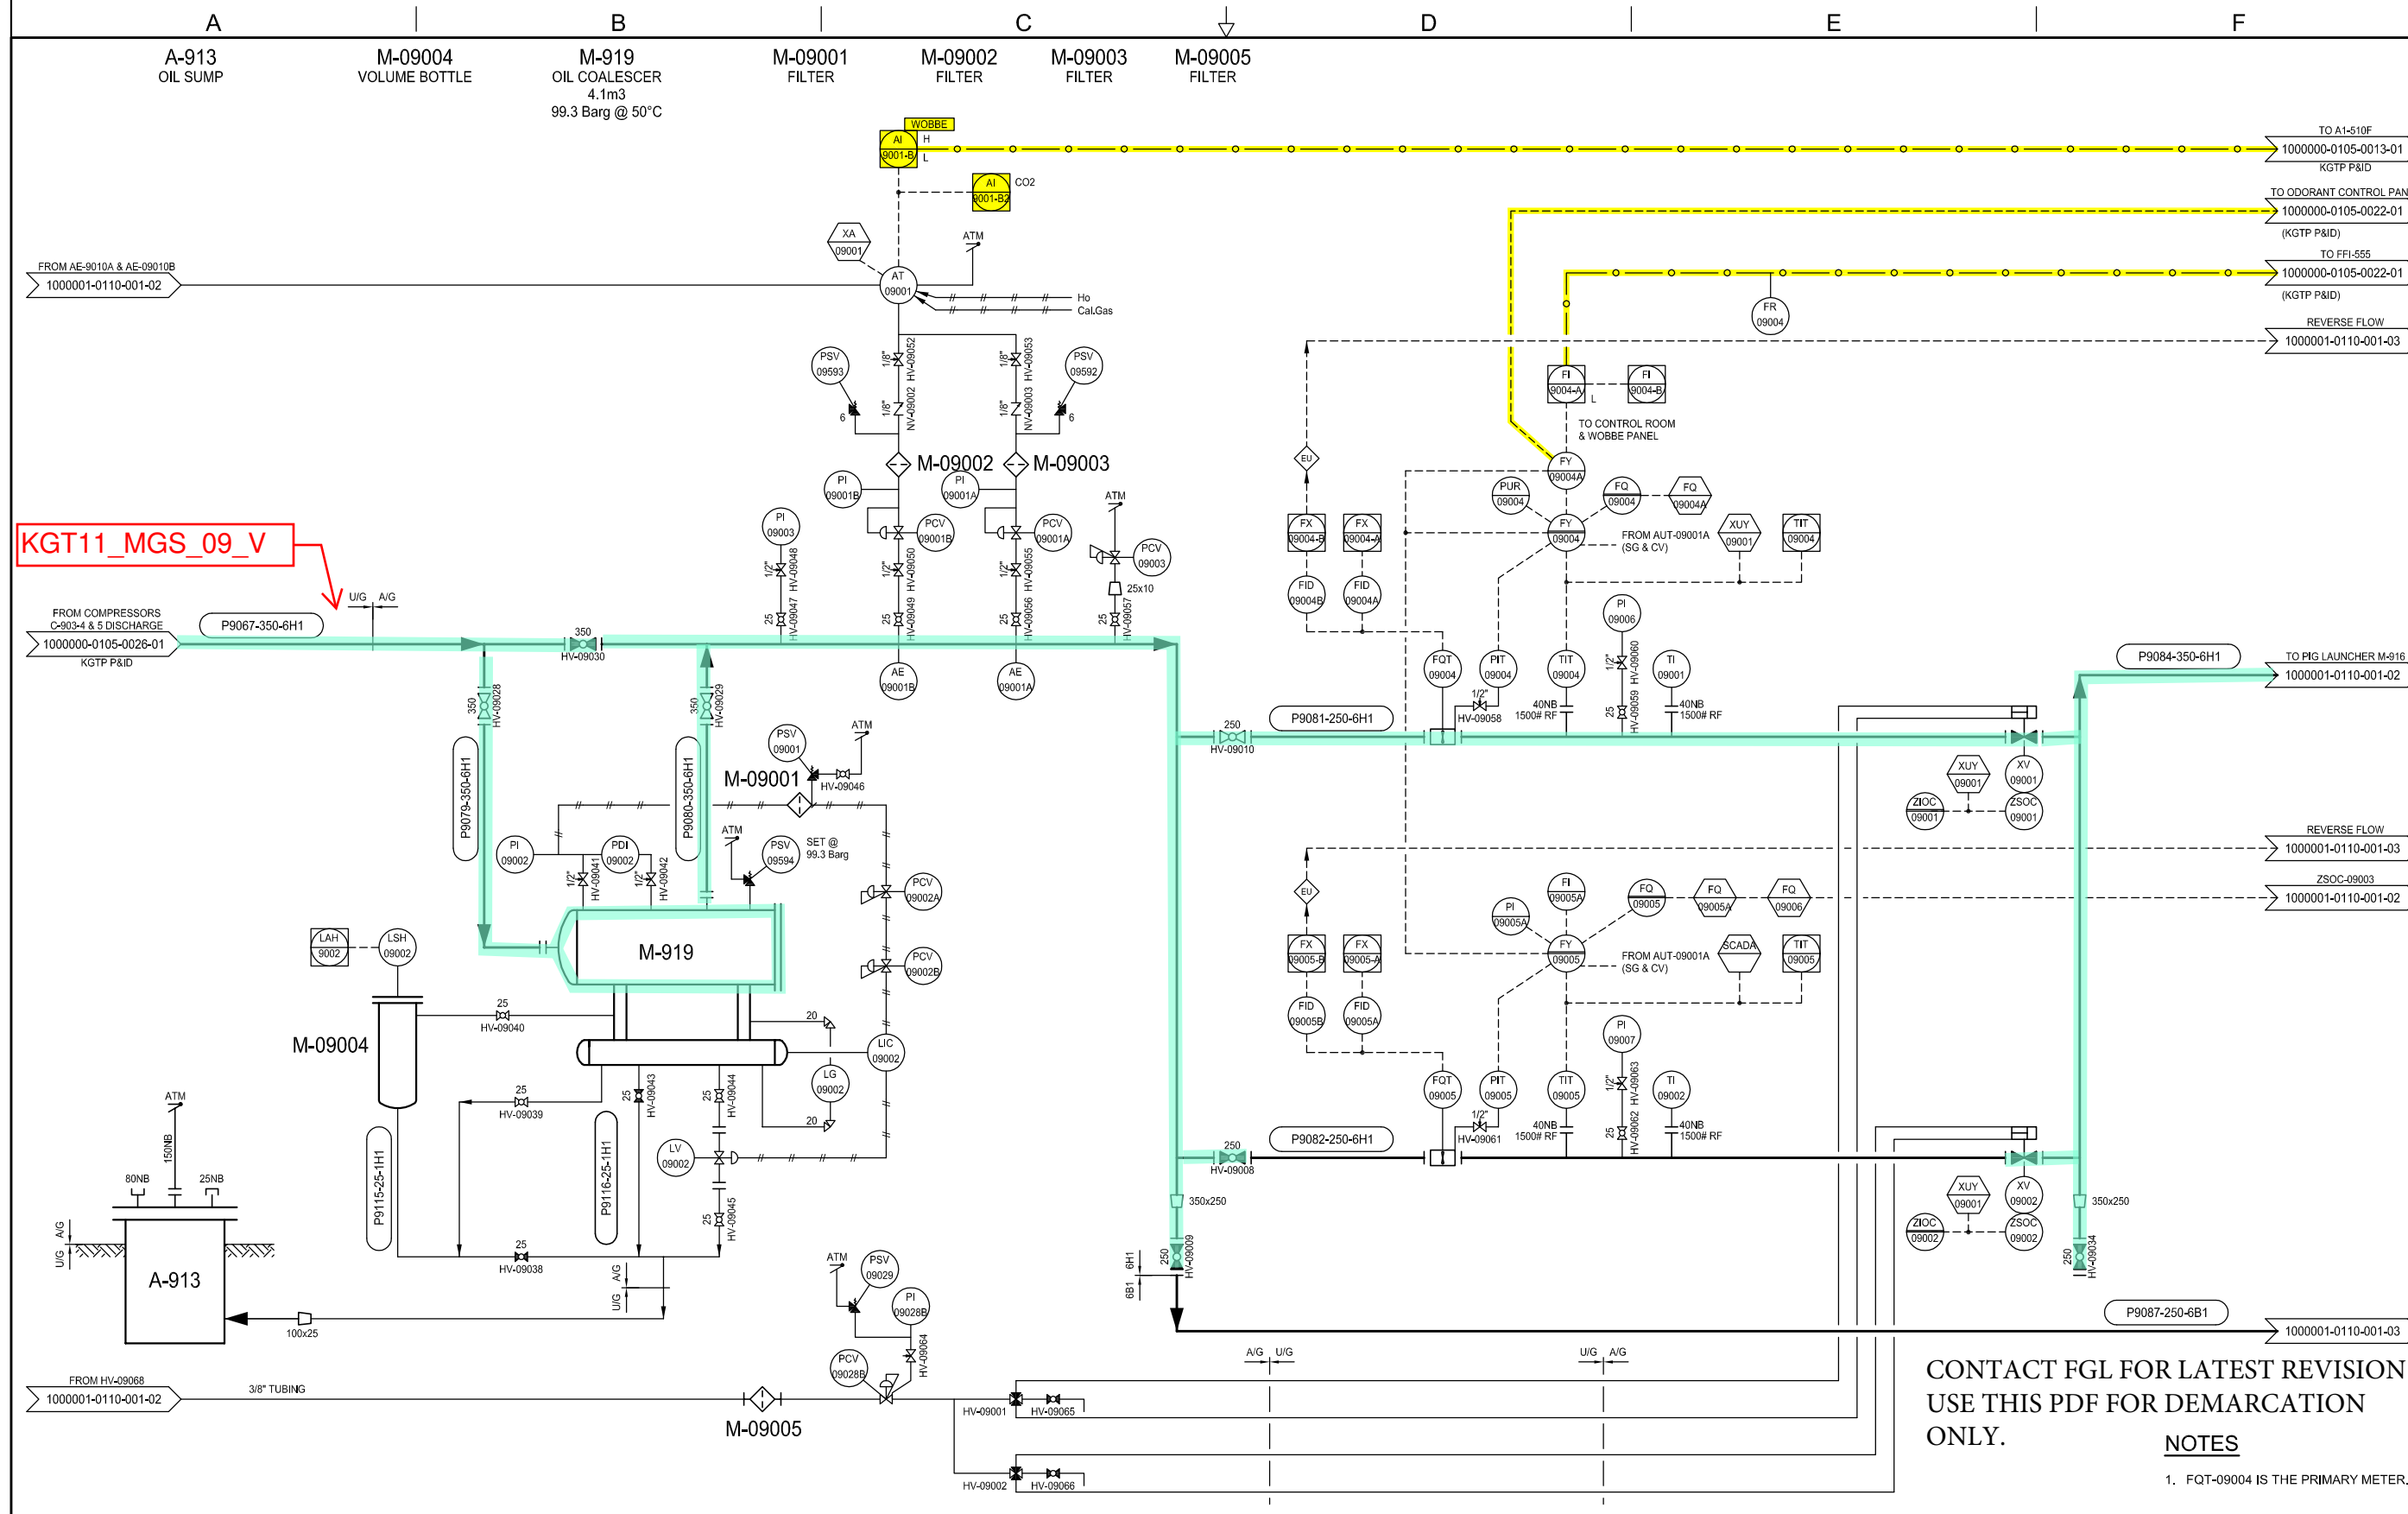

CONTACT FGL FOR LATEST REVISION
USE THIS PDF FOR DEMARCATON ONLY.

NOTES

1. FQT-09004 IS THE PRIMARY METER.

REV	AMENDMENT	DRAWN	CHKD	ENG	APPR	DATE
13	METER TAG NUMBERS CORRECTED	SKM	AMS	DT	RS	08/2015
12	REVISED XV-9001 & 9002	JCC	RL / RH	DT	RS	06/2015
11	REVISED XV-9001 & 9002	NK	RH	DT	RS	01/2015
10	AS BUILT P84-318	ES	AC	TC	DI	07/2012
9	CONTIN DRG No. 0105-0026-01 REVISED	RL	SKM	DT	DS	05/2012
8	NOTE 1 ADDED	SKM	LR	DT	DI	02/2012
7	GENERAL AS BUILT	MW	SKM	DT	BJP	08/2011
6	DEMARCATON REMOVED	SKM	AJW	DT	BJP	12/2009
5	AS BUILT WS1131993 RAW GAS WOBBE CTL	ES	AAB	SES	DI	12/2007
4	FLOW CONTINUATIONS REVISED	RH	SKM	DT	PJR	09/2007
3	KGTP/TRANS DEMARCATON UPDATE	ES	AvG	LH	PJR	04/2007

COPYRIGHT:
The copyright in this document is vested in Vector Gas Limited.

The contents of this document may not be reproduced either in whole or in part, by any means whatsoever without the prior written consent of Vector Gas Limited.



VECTOR GAS LIMITED
PRIVATE BAG 2020
NEW PLYMOUTH 4342
PHONE 0800 734 567

ACTUAL DRAWING SIZE : A1 FRAME A1-ENGFR

REFERENCE DRAWINGS	
1000001-0110-001-02	PIG TRAPS
1000001-0110-001-03	300 LINE METERING

	BY	DATE
DRAWN	JST	08/05/1998
CHECKED	KJL	08/05/1998
ENGINEER	RCG	08/05/1998
APPROVED	DT	30/11/1999

KAPUNI GTP OUTLET METER STATION					
FLOWSHEET - PIPING & INSTRUMENTATION DIAGRAM					
M-919 OIL COALESCER & METERING					
SCALES:	JOB NO.	SERIES	DRG NO.	SHT 01	REV
NTS	1000001	0110	001	OF	13
DO NOT SCALE OFF DRG				03	SHTS

DEMARICATION KEY

KGTP ASSETS

ALL ELSE = TRANSMISSION ASSETS

DEMARICATION AGREEMENT:

DATE: 1 MARCH 2016

DRAWN: R LOCHHEAD

TRANSMISSION: R PHIPPS

KGTP: S SMITH

A B C D E F

- NOTE
- RO-09023 TO FLOW 1m3/SEC FROM 86 BARG TO 45 BARG
 - DELETED
 - M-915 / M-916 1300mm MAJOR BARREL EXTENSION NOT ALWAYS INSTALLED. ONE OFF DN 25 CL 600 RF BARREL EXTENSION TO BE INTERCHANGEABLE BETWEEN BOTH LAUNCHERS, FOR TEMPORARY ILLI TOOL FACILITIES.


*** FAULTY VALVE**

KGT11_PIG_03_V

KGT11_PIG_04_V

KGT52_BMC_02_L

KGT11_MGS_09_V

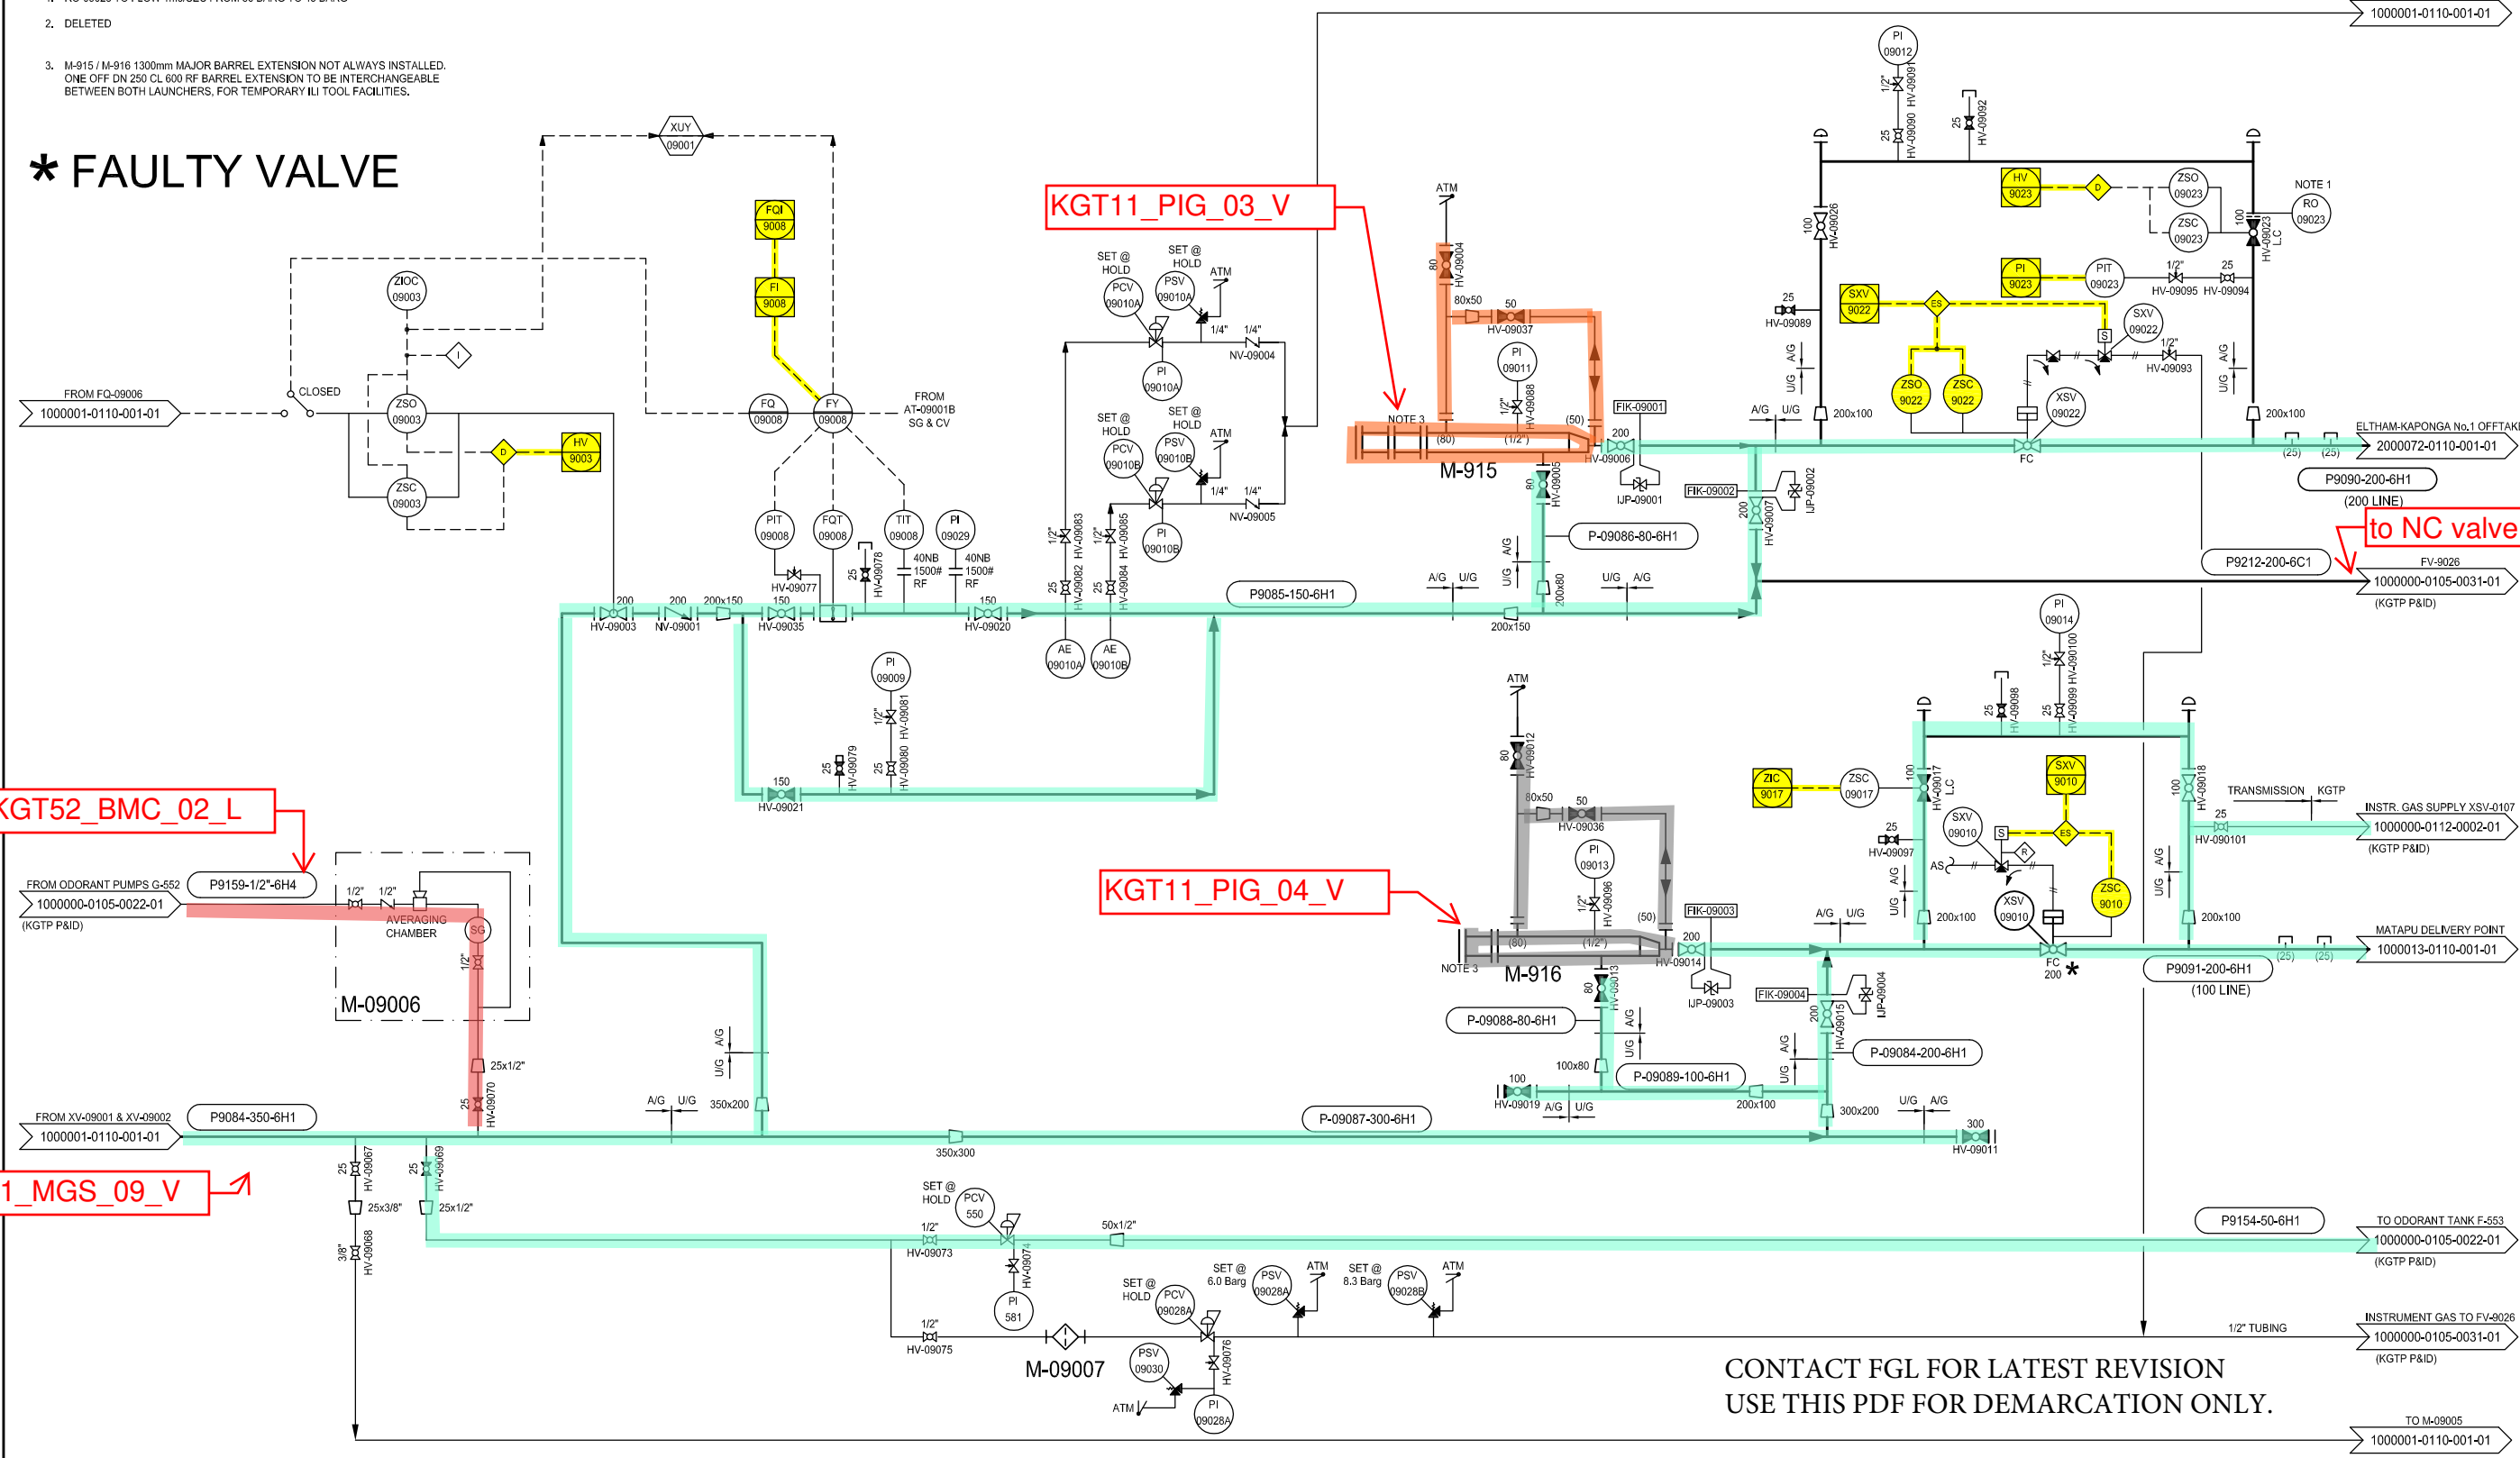

CONTACT FGL FOR LATEST REVISION
USE THIS PDF FOR DEMARICATION ONLY.

REV	AMENDMENT	DRAWN	CHKD	ENG	APPR	DATE
11	METER TAG NUMBERS REVISED	SKM	AMS	DT	RS	08/2015
10	REVISED FOR DEMARICATION	JCC	RL / RH	DT	RS	06/2015
9	REVISED XV-9001 & 9002	NK	RH	DT	RS	01/2015
8	REVISED FOR M-915 & 916 MODS XC-XO-14-XPLN-009	CSM	RH	JF	SFI	07/2014
7	ISSUED FOR FAULTY VALVE	NK	RH	RS	RS	11/2013
6	CONTIN DRG No. 0105-0031-01 REVISED	RL	SKM	DT	DS	05/2012
5	PGC/AFEXOL HAZOP MARK UPS WS 1324841	M/W	SKM	DT	BJP	08/2011
4	FLOW CONTINUATIONS REVISED	RH	SKM	DT	PJR	09/2007
3	KGTP/TRANS DEMARICATION UPDATE	ES	AvG	LH	PJR	04/2007
2	AS BUILT WS062568 300 LINE REVERSE	SKM	RH	DT	SFI	11/2005
1	ISSUED AS BUILT	JST	KJL	RCG	DT	05/1998

COPYRIGHT:
The copyright in this document is vested in Vector Gas Limited.

The contents of this document may not be reproduced either in whole or in part, by any means whatsoever without the prior written consent of Vector Gas Limited.



VECTOR GAS LIMITED
PRIVATE BAG 2020
NEW PLYMOUTH 4342
PHONE 0800 734 567

ACTUAL DRAWING SIZE : A1 FRAME A1-ENGFR

REFERENCE DRAWINGS	
1000001-0110-001-01	M-919 COALESCER
1000001-0110-001-03	300 LINE METERING

BY	DATE
DRAWN: JST	08/05/1998
CHECKED: KJL	08/05/1998
ENGINEER: RCG	08/05/1998
APPROVED: DT	19/11/2014

KAPUNI GTP OUTLET METER STATION					
FLOWSHEET - PIPING & INSTRUMENTATION DIAGRAM					
M-915 & M-916 PIG TRAPS					
SCALES:	JOB NO.	SERIES	DRG NO.	SHT 02	REV
NTS	1000001	0110	001	OF 03 SHTS	11
DO NOT SCALE OFF DRG					

Appendix 2.

Parts Count Sheets

Raw Gas and Maui Gas Lines

Equipment	Size	KGT01_RGS_01_V	KGT01_RCS_01_L	KGT01_MAU_01_V	KGT01_MAU_02_V
Process Pipe	0-2"	0	0	0	0
	3"-6"	0	0	0	63
	7"-12"	0	0	0	0
	13"-18"	0	0	0	0
	19"-24"	0	0	0	0
	25"-36"	0	0	0	0
Process Pipe (Inter-unit)	0-2"	0	0	0	0
	3"-6"	0	218	0	0
	7"-12"	0	0	0	0
	13"-18"	0	0	0	0
	19"-24"	259	0	111	0
	25"-36"	0	0	0	0
Flange	0-2"	13	16	8	8
	3"-6"	29	2	25	24
	7"-12"	41	0	22	0
	13"-18"	10	0	0	0
	19"-24"	2	0	1	0
	25"-36"	0	0	0	0
Manual Valves	0-2"	34	21	23	3
	3"-6"	10	1	9	9
	7"-12"	14	0	8	0
	13"-18"	3	0	0	0
	19"-24"	0	0	2	0
	25"-36"	0	0	0	0
Actuated Valves	0-2"	5	2	1	1
	3"-6"	2	0	4	0
	7"-12"	0	0	0	0
	13"-18"	0	0	0	0
	19"-24"	0	0	1	0
	25"-36"	0	0	0	0
Small Bore Fittings	2"	19	2	18	10
Process Vessel	<= 6"	1	0.5	0	0
	> 6 "	0.5	0	0	0
Centrifugal Pump	<= 6"	0	0	0	0
	> 6 "	0	0	0	0
Reciprocating Pump	<= 6"	0	0	0	0
	> 6 "	0	0	0	0
Centrifugal Compressor	<= 6"	0	0	0	0
	> 6 "	0	0	0	0
Reciprocating Compressor	<= 6"	0	0	0	0
	> 6 "	0	0	0	0
Shell Side Heat Exchanger	<= 6"	0	0	0	0
	> 6 "	0	0	0	0
Tube Side Heat Exchanger	<= 6"	0	0	0	0
	> 6 "	0	0	0	0
Plate Heat Exchanger	<= 6"	0	0	0	0
	> 6 "	0	0	0	0
Air Cooled Heat Exchanger	<= 6"	0	0	0	0
	> 6 "	0	0	0	0
Filters	<= 6"	0	0	0	1
	> 6 "	0	0	0	0
Pig Trap	<= 6"	0	0	0	0
	> 6 "	0	0	0	0

CO2 Removal

Equipment	Size	KGT02_TGS_01_V	KGT03_TGS_04_V	KGT05_RGS_07_V	KGT05_TGS_16_V
Process Pipe	0-2"	0	0	0	0
	3"-6"	0	0	0	0
	7"-12"	15	15	15	15
	13"-18"	0	0	0	0
	19"-24"	0	0	0	0
	25"-36"	0	0	0	0
Process Pipe (Inter-unit)	0-2"	0	0	0	0
	3"-6"	0	0	0	0
	7"-12"	0	0	0	0
	13"-18"	0	0	0	0
	19"-24"	0	0	0	0
	25"-36"	0	0	0	0
Flange	0-2"	9	9	2	19
	3"-6"	15	18	8	19
	7"-12"	4	4	17	12
	13"-18"	0	0	0	0
	19"-24"	0	0	0	0
	25"-36"	0	0	0	0
Manual Valves	0-2"	5	5	5	10
	3"-6"	1	3	0	3
	7"-12"	0	0	4	0
	13"-18"	0	0	0	0
	19"-24"	0	0	0	0
	25"-36"	0	0	0	0
Actuated Valves	0-2"	2	2	0	2
	3"-6"	3	3	2	2
	7"-12"	0	0	0	0
	13"-18"	0	0	0	0
	19"-24"	0	0	0	0
	25"-36"	0	0	0	0
Small Bore Fittings	2"	12	11	7	19
Process Vessel	<= 6"	0.5	0	0	0
	> 6 "	0.5	1	0	1
Centrifugal Pump	<= 6"	0	0	0	0
	> 6 "	0	0	0	0
Reciprocating Pump	<= 6"	0	0	0	0
	> 6 "	0	0	0	0
Centrifugal Compressor	<= 6"	0	0	0	0
	> 6 "	0	0	0	0
Reciprocating Compressor	<= 6"	0	0	0	0
	> 6 "	0	0	0	0
Shell Side Heat Exchanger	<= 6"	0	0	0	0
	> 6 "	0	0	1	0
Tube Side Heat Exchanger	<= 6"	1	1	0	0
	> 6 "	0	0	0	1
Plate Heat Exchanger	<= 6"	0	0	0	0
	> 6 "	0	0	0	0
Air Cooled Heat Exchanger	<= 6"	0	0	0	0
	> 6 "	0	0	0	0
Filters	<= 6"	0	0	0	0
	> 6 "	0	0	0	0
Pig Trap	<= 6"	0	0	0	0
	> 6 "	0	0	0	0

Dehydration and Dewpoint Control

Equipment	Size	KGT01_TGS_07_V	KGT01_TGS_10_V	KGT01_TGS_12_V	KGT01_PGS_02_V	KGT04_PGS_07_V	KGT01_MPG_01_L	KGT04_MPG_03_L
Process Pipe	0-2"	0	0	0	0	0	0	0
	3"-6"	0	0	0	0	15	15	35
	7"-12"	48	48	49	15	0	0	0
	13"-18"	0	0	0	0	0	0	0
	19"-24"	0	0	0	0	0	0	0
	25"-36"	0	0	0	0	0	0	0
Process Pipe (Inter-unit)	0-2"	0	0	0	0	0	0	0
	3"-6"	0	0	0	0	0	0	0
	7"-12"	0	0	0	0	0	0	0
	13"-18"	0	0	0	0	0	0	0
	19"-24"	0	0	0	0	0	0	0
	25"-36"	0	0	0	0	0	0	0
Flange	0-2"	17	4	1	3	2	6	12
	3"-6"	28	2	20	10	9	5	12
	7"-12"	29	13	8	6	0	0	0
	13"-18"	0	0	0	0	0	0	0
	19"-24"	0	0	0	0	0	0	0
	25"-36"	0	0	0	0	0	0	0
Manual Valves	0-2"	17	3	5	1	1	3	8
	3"-6"	9	1	8	0	2	0	4
	7"-12"	7	3	0	0	0	0	0
	13"-18"	0	0	0	0	0	0	0
	19"-24"	0	0	0	0	0	0	0
	25"-36"	0	0	0	0	0	0	0
Actuated Valves	0-2"	2	0	0	0	1	1	0
	3"-6"	2	0	1	3	1	0	0
	7"-12"	0	0	0	0	0	0	0
	13"-18"	0	0	0	0	0	0	0
	19"-24"	0	0	0	0	0	0	0
	25"-36"	0	0	0	0	0	0	0
Small Bore Fittings	2"	20	12	7	8	5	5	1
Process Vessel	<= 6"	0.5	0	0	0.5	0.5	1	0
	> 6 "	0.5	0	0	0.5	0	0	0
Centrifugal Pump	<= 6"	0	0	0	0	0	0	0
	> 6 "	0	0	0	0	0	0	0
Reciprocating Pump	<= 6"	0	0	0	0	0	0	0
	> 6 "	0	0	0	0	0	0	0
Centrifugal Compressor	<= 6"	0	0	0	0	0	0	0
	> 6 "	0	0	0	0	0	0	0
Reciprocating Compressor	<= 6"	0	0	0	0	0	0	0
	> 6 "	0	0	0	0	0	0	0
Shell Side Heat Exchanger	<= 6"	0	0	0	0	0	0	1
	> 6 "	0	0	0	2	0	0	0
Tube Side Heat Exchanger	<= 6"	0	0	0	0	0	0	0
	> 6 "	0	3	1	0	0	0	0
Plate Heat Exchanger	<= 6"	0	0	0	0	0	0	0
	> 6 "	0	0	0	0	0	0	0
Air Cooled Heat Exchanger	<= 6"	0	0	0	0	0	0	0
	> 6 "	0	0	0	0	0	0	0
Filters	<= 6"	0	0	0	0	0	0	0
	> 6 "	0	0	0	0	0	0	0
Pig Trap	<= 6"	0	0	0	0	0	0	0
	> 6 "	0	0	0	0	0	0	0

Equipment	Size	KGT04_MPG_04_L	KGT04_MPG_05_L	KGT04_MPG_06_L	KGT01_TGS_11_V	KGT01_PGS_03_V	KGT01_MPG_02_L
Process Pipe	0-2"	0	0	0	0	0	v
	3"-6"	15	15	15	0	15	15
	7"-12"	0	0	0	43	0	0
	13"-18"	0	0	0	0	0	0
	19"-24"	0	0	0	0	0	0
	25"-36"	0	0	0	0	0	v
Process Pipe (Inter-unit)	0-2"	0	0	0	0	0	0
	3"-6"	0	0	0	0	0	0
	7"-12"	0	0	0	0	0	0
	13"-18"	0	0	0	0	0	0
	19"-24"	0	0	0	0	0	0
	25"-36"	0	0	0	0	0	0
Flange	0-2"	2	9	10	2	5	6
	3"-6"	7	7	14	13	7	2
	7"-12"	0	0	0	0	0	0
	13"-18"	0	0	0	0	0	0
	19"-24"	0	0	0	0	0	0
	25"-36"	0	0	0	0	0	0
Manual Valves	0-2"	2	2	7	1	2	3
	3"-6"	2	3	2	2	0	0
	7"-12"	0	0	0	0	0	0
	13"-18"	0	0	0	0	0	0
	19"-24"	0	0	0	0	0	0
	25"-36"	0	0	0	0	0	0
Actuated Valves	0-2"	0	0	3	0	2	1
	3"-6"	0	0	1	0	1	0
	7"-12"	0	0	0	0	0	0
	13"-18"	0	0	0	0	0	0
	19"-24"	0	0	0	0	0	0
	25"-36"	0	0	0	0	0	0
Small Bore Fittings	2"	2	1	9	7	11	4
Process Vessel	<= 6"	0.5	0	1	0	0.5	0.5
	> 6 "	0	0	0	0	0	0
Centrifugal Pump	<= 6"	0	1	0	0	0	0
	> 6 "	0	0	0	0	0	0
Reciprocating Pump	<= 6"	0	0	0	0	0	0
	> 6 "	0	0	0	0	0	0
Centrifugal Compressor	<= 6"	0	0	0	0	0	0
	> 6 "	0	0	0	0	0	0
Reciprocating Compressor	<= 6"	0	0	0	0	0	0
	> 6 "	0	0	0	0	0	0
Shell Side Heat Exchanger	<= 6"	0	0	0	0	2	0
	> 6 "	0	0	0	0	0	0
Tube Side Heat Exchanger	<= 6"	0	0	0	3	0	0
	> 6 "	0	0	0	0	0	0
Plate Heat Exchanger	<= 6"	0	0	0	0	0	0
	> 6 "	0	0	0	0	0	0
Air Cooled Heat Exchanger	<= 6"	0	0	0	0	0	0
	> 6 "	0	0	0	0	0	0
Filters	<= 6"	1	0	0	0	0	0
	> 6 "	0	0	0	0	0	0
Pig Trap	<= 6"	0	0	0	0	0	0
	> 6 "	0	0	0	0	0	0

Product Gas Lines and Compressors

Equipment	Size	KGT01_PGS_01_V	KGT01_PGS_13_V	KGT01_PGS_14_V	KGT13_PGS_15_V	KGT13_PGS_16_V	KGT13_PGS_17_V	KGT01_MGS_01_V
Process Pipe	0-2"	0	0	0	0	0	0	0
	3"-6"	0	15	0	0	51	0	0
	7"-12"	0	0	0	0	0	0	0
	13"-18"	0	0	0	0	0	0	91
	19"-24"	0	0	0	56	0	51	0
	25"-36"	0	0	0	0	0	0	0
Process Pipe (Inter-unit)	0-2"	0	0	0	0	0	0	0
	3"-6"	0	0	0	0	0	0	0
	7"-12"	0	0	274	0	0	0	0
	13"-18"	229	0	0	0	0	0	0
	19"-24"	0	0	0	0	0	0	0
	25"-36"	0	0	0	0	0	0	0
Flange	0-2"	24	20	3	4	6	0	45
	3"-6"	28	1	3	32	28	25	11
	7"-12"	46	0	7	4	0	2	31
	13"-18"	0	0	0	0	0	0	6
	19"-24"	0	0	0	0	0	1	0
	25"-36"	0	0	0	0	0	0	0
Manual Valves	0-2"	34	10	1	10	3	6	34
	3"-6"	12	0	1	5	5	3	2
	7"-12"	13	0	2	3	0	4	5
	13"-18"	0	0	0	0	0	0	2
	19"-24"	0	0	0	0	0	2	0
	25"-36"	0	0	0	0	0	0	0
Actuated Valves	0-2"	3	4	0	0	2	0	16
	3"-6"	2	0	1	1	1	5	2
	7"-12"	0	0	0	0	0	1	3
	13"-18"	0	0	0	0	0	0	0
	19"-24"	0	0	0	0	0	1	0
	25"-36"	0	0	0	0	0	0	0
Small Bore Fittings	2"	26	6	2	6	10	17	33
Process Vessel	<= 6"	0	0.5	0	2	2	1	1
	> 6 "	0	0	0	0	0	0	3
Centrifugal Pump	<= 6"	0	0	0	0	0	0	0
	> 6 "	0	0	0	0	0	0	0
Reciprocating Pump	<= 6"	0	0	0	0	0	0	0
	> 6 "	0	0	0	0	0	0	0
Centrifugal Compressor	<= 6"	0	0	0	0	1	0	0
	> 6 "	0	0	0	0	0	0	0
Reciprocating Compressor	<= 6"	0	0	0	0	0	0	0
	> 6 "	0	0	0	0	0	0	0
Shell Side Heat Exchanger	<= 6"	0	0	0	0	0	0	0
	> 6 "	0	0	0	0	0	0	0
Tube Side Heat Exchanger	<= 6"	0	0	0	0	0	0	0
	> 6 "	0	0	0	0	0	0	0
Plate Heat Exchanger	<= 6"	0	0	0	0	0	0	0
	> 6 "	0	0	0	0	0	0	0
Air Cooled Heat Exchanger	<= 6"	0	0	0	0	1	0	0
	> 6 "	0	0	0	0	0	0	0
Filters	<= 6"	0	0	0	1	0	0	1
	> 6 "	0	0	0	0	0	0	2
Pig Trap	<= 6"	0	0	0	0	0	0	0
	> 6 "	0	0	0	0	0	0	0

Equipment	Size	KGT01_MGS_03_V	KGT01_MGS_07_V	KGT11_MGS_05_V	KGT11_MGS_08_V	KGT11_MGS_09_V
Process Pipe	0-2"	0	0	0	0	0
	3"-6"	0	0	0	0	0
	7"-12"	15	15	0	0	0
	13"-18"	0	0	91	0	0
	19"-24"	0	0	0	0	0
	25"-36"	0	0	0	0	0
Process Pipe (Inter-unit)	0-2"	0	0	0	251	0
	3"-6"	0	0	0	0	0
	7"-12"	0	0	0	0	0
	13"-18"	0	0	0	0	278
	19"-24"	0	0	0	0	0
	25"-36"	0	0	0	0	0
Flange	0-2"	0	0	1	37	2
	3"-6"	12	13	8	0	26
	7"-12"	4	3	8	0	23
	13"-18"	0	0	6	0	8
	19"-24"	0	0	0	0	0
	25"-36"	0	0	0	0	0
Manual Valves	0-2"	0	2	12	24	29
	3"-6"	0	1	1	0	10
	7"-12"	1	1	4	0	11
	13"-18"	0	0	2	0	3
	19"-24"	0	0	0	0	0
	25"-36"	0	0	0	0	0
Actuated Valves	0-2"	0	0	0	9	13
	3"-6"	3	3	2	0	1
	7"-12"	1	1	0	0	4
	13"-18"	0	0	0	0	0
	19"-24"	0	0	0	0	0
	25"-36"	0	0	0	0	0
Small Bore Fittings	2"	13	4	5	5	31
Process Vessel	<= 6"	1	0	0	0	0
	> 6 "	1	0	0	0	1
Centrifugal Pump	<= 6"	0	0	0	0	0
	> 6 "	0	0	0	0	0
Reciprocating Pump	<= 6"	0	0	0	0	0
	> 6 "	0	0	0	0	0
Centrifugal Compressor	<= 6"	1	1	0	0	0
	> 6 "	0	0	0	0	0
Reciprocating Compressor	<= 6"	0	0	0	0	0
	> 6 "	0	0	0	0	0
Shell Side Heat Exchanger	<= 6"	0	0	0	0	0
	> 6 "	0	0	0	0	0
Tube Side Heat Exchanger	<= 6"	0	0	0	0	0
	> 6 "	0	0	0	0	0
Plate Heat Exchanger	<= 6"	0	0	0	0	0
	> 6 "	0	0	0	0	0
Air Cooled Heat Exchanger	<= 6"	0	1	0	0	0
	> 6 "	1	0	0	0	0
Filters	<= 6"	0	0	0	0	0
	> 6 "	0	0	0	0	0
Pig Trap	<= 6"	0	0	0	0	0
	> 6 "	0	0	0	0	0

Pigging

Equipment	Size	KGT01_PIG_01_V	KGT13_PIG_02_V	KGT11_PIG_03_V	KGT11_PIG_04_V
Process Pipe	0-2"	0	0	0	0
	3"-6"	0	0	0	0
	7"-12"	0	0	0	0
	13"-18"	0	0	0	0
	19"-24"	0	0	0	0
	25"-36"	0	0	0	0
Process Pipe (Inter-unit)	0-2"	0	0	0	0
	3"-6"	0	0	0	0
	7"-12"	0	0	0	0
	13"-18"	0	0	0	0
	19"-24"	0	0	0	0
	25"-36"	0	0	0	0
Flange	0-2"	2	1	3	3
	3"-6"	2	1	3	3
	7"-12"	1	1	1	1
	13"-18"	0	0	0	0
	19"-24"	0	0	0	0
	25"-36"	0	0	0	0
Manual Valves	0-2"	3	3	1	1
	3"-6"	1	1	1	1
	7"-12"	0	0	0	0
	13"-18"	0	0	0	0
	19"-24"	0	0	0	0
	25"-36"	0	0	0	0
Actuated Valves	0-2"	0	0	0	0
	3"-6"	0	0	0	0
	7"-12"	0	0	0	0
	13"-18"	0	0	0	0
	19"-24"	0	0	0	0
	25"-36"	0	0	0	0
Small Bore Fittings	2"	2	1	1	1
Process Vessel	<= 6"	0	0	0	0
	> 6 "	0	0	0	0
Centrifugal Pump	<= 6"	0	0	0	0
	> 6 "	0	0	0	0
Reciprocating Pump	<= 6"	0	0	0	0
	> 6 "	0	0	0	0
Centrifugal Compressor	<= 6"	0	0	0	0
	> 6 "	0	0	0	0
Reciprocating Compressor	<= 6"	0	0	0	0
	> 6 "	0	0	0	0
Shell Side Heat Exchanger	<= 6"	0	0	0	0
	> 6 "	0	0	0	0
Tube Side Heat Exchanger	<= 6"	0	0	0	0
	> 6 "	0	0	0	0
Plate Heat Exchanger	<= 6"	0	0	0	0
	> 6 "	0	0	0	0
Air Cooled Heat Exchanger	<= 6"	0	0	0	0
	> 6 "	0	0	0	0
Filters	<= 6"	0	0	0	0
	> 6 "	0	0	0	0
Pig Trap	<= 6"	0	0	0	0
	> 6 "	1	1	1	1

Utilities and Cogen Unit

Equipment	Size	KGT01_MPG_21_V	KGT01_MPG_22_L	KGT01_MPG_23_L	KGT01_FGA_01_V	KGT01_FGA_02_V	KGT01_PGS_19_V	KGT01_PGS_21_V	KGT01_PGS_22_V
Process Pipe	0-2"	0	15	50	0	0	0	0	0
	3"-6"	78	0	0	38	0	0	0	50
	7"-12"	0	0	0	0	0	0	0	0
	13"-18"	0	0	0	0	0	0	0	0
	19"-24"	0	0	0	0	0	0	0	0
	25"-36"	0	0	0	0	0	0	0	0
Process Pipe (Inter-unit)	0-2"	0	0	0	0	0	154	0	0
	3"-6"	0	0	0	0	138	0	274	0
	7"-12"	0	0	0	0	0	0	0	0
	13"-18"	0	0	0	0	0	0	0	0
	19"-24"	0	0	0	0	0	0	0	0
	25"-36"	0	0	0	0	0	0	0	0
Flange	0-2"	12	8	13	21	27	25	36	27
	3"-6"	33	0	0	51	89	2	1	41
	7"-12"	0	0	0	0	0	0	0	0
	13"-18"	0	0	0	0	0	0	0	0
	19"-24"	0	0	0	0	0	0	0	0
	25"-36"	0	0	0	0	0	0	0	0
Manual Valves	0-2"	7	2	5	9	35	15	17	17
	3"-6"	8	0	0	16	23	1	1	7
	7"-12"	0	0	0	0	0	0	0	0
	13"-18"	0	0	0	0	0	0	0	0
	19"-24"	0	0	0	0	0	0	0	0
	25"-36"	0	0	0	0	0	0	0	0
Actuated Valves	0-2"	4	0	1	2	19	9	5	9
	3"-6"	4	0	0	3	15	0	0	10
	7"-12"	0	0	0	0	0	0	0	0
	13"-18"	0	0	0	0	0	0	0	0
	19"-24"	0	0	0	0	0	0	0	0
	25"-36"	0	0	0	0	0	0	0	0
Small Bore Fittings	2"	13	0	1	20	56	7	9	13
Process Vessel	<= 6"	1.5	0.5	0.25	1	1	0	0	0
	> 6 "	0	0	0	0	0	0	0	0
Centrifugal Pump	<= 6"	0	0	0	0	0	0	0	0
	> 6 "	0	0	0	0	0	0	0	0
Reciprocating Pump	<= 6"	0	0	0	0	0	0	0	0
	> 6 "	0	0	0	0	0	0	0	0
Centrifugal Compressor	<= 6"	0	0	0	0	0	0	0	0
	> 6 "	0	0	0	0	0	0	0	0
Reciprocating Compressor	<= 6"	0	0	0	0	0	0	0	0
	> 6 "	0	0	0	0	0	0	0	0
Shell Side Heat Exchanger	<= 6"	0	0	0	0	0	0	0	0
	> 6 "	0	0	0	0	0	0	0	0
Tube Side Heat Exchanger	<= 6"	0	0	0	2	0	0	0	0
	> 6 "	0	0	0	0	0	0	0	0
Plate Heat Exchanger	<= 6"	0	0	0	0	0	0	0	0
	> 6 "	0	0	0	0	0	0	0	0
Air Cooled Heat Exchanger	<= 6"	0	0	0	0	0	0	0	0
	> 6 "	0	0	0	0	0	0	0	0
Filters	<= 6"	1	1	0	0	2	4	8	0
	> 6 "	0	0	0	0	0	0	0	0
Pig Trap	<= 6"	0	0	0	0	0	0	0	0
	> 6 "	0	0	0	0	0	0	0	0

LPG Production Facility - Stabiliser, De-C2

Equipment	Size	KGT01_MPG_07_L	KGT01_DET_01_V	KGT01_PGS_04_V	KGT01_PGS_05_V	KGT01_DEX_01_L	KGT01_DEB_01_L	KGT01_MPG_09_L
Process Pipe	0-2"	0	0	0	0	0	0	0
	3"-6"	0	15	0	0	15	15	22
	7"-12"	0	0	0	0	0	0	0
	13"-18"	0	0	0	0	0	0	0
	19"-24"	0	0	0	0	0	0	0
	25"-36"	0	0	0	0	0	0	0
Process Pipe (Inter-unit)	0-2"	0	0	0	0	0	0	0
	3"-6"	194	0	110	0	0	0	0
	7"-12"	0	0	0	143	0	0	0
	13"-18"	0	0	0	0	0	0	0
	19"-24"	0	0	0	0	0	0	0
	25"-36"	0	0	0	0	0	0	0
Flange	0-2"	3	3	8	22	30	5	9
	3"-6"	18	19	5	15	1	18	36
	7"-12"	0	0	0	7	0	0	0
	13"-18"	0	0	0	0	0	0	0
	19"-24"	0	0	0	0	0	0	0
	25"-36"	0	0	0	0	0	0	0
Manual Valves	0-2"	7	6	6	9	19	9	14
	3"-6"	8	4	2	5	0	6	12
	7"-12"	0	0	0	2	0	0	0
	13"-18"	0	0	0	0	0	0	0
	19"-24"	0	0	0	0	0	0	0
	25"-36"	0	0	0	0	0	0	0
Actuated Valves	0-2"	2	3	1	3	1	1	0
	3"-6"	0	1	0	1	0	0	2
	7"-12"	0	0	0	0	0	0	0
	13"-18"	0	0	0	0	0	0	0
	19"-24"	0	0	0	0	0	0	0
	25"-36"	0	0	0	0	0	0	0
Small Bore Fittings	2"	5	7	7	10	5	10	11
Process Vessel	<= 6"	0	1	2	1	0.5	0.5	0.5
	> 6 "	0	0	0	0	0	0	0
Centrifugal Pump	<= 6"	0	0	0	0	1	0	0
	> 6 "	0	0	0	0	0	0	0
Reciprocating Pump	<= 6"	0	0	0	0	0	0	0
	> 6 "	0	0	0	0	0	0	0
Centrifugal Compressor	<= 6"	0	0	0	0	0	0	0
	> 6 "	0	0	0	0	0	0	0
Reciprocating Compressor	<= 6"	0	0	0	1	0	0	0
	> 6 "	0	0	0	0	0	0	0
Shell Side Heat Exchanger	<= 6"	0	0	0	0	0	1	0
	> 6 "	0	0	0	0	0	0	0
Tube Side Heat Exchanger	<= 6"	1	1	0	0	0	0	0
	> 6 "	0	0	0	0	0	0	0
Plate Heat Exchanger	<= 6"	0	0	0	0	0	0	0
	> 6 "	0	0	0	0	0	0	0
Air Cooled Heat Exchanger	<= 6"	0	0	0	1	0	0	0
	> 6 "	0	0	0	0	0	0	0
Filters	<= 6"	0	0	0	0	1	0	0
	> 6 "	0	0	0	0	0	0	0
Pig Trap	<= 6"	0	0	0	0	0	0	0
	> 6 "	0	0	0	0	0	0	0

Equipment	Size	KGT01_MPG_10_V	KGT01_MPG_13_L	KGT01_STT_01_V	KGT01_PGS_10_V	KGT01_PGS_11_V	KGT01_STB_01_L
Process Pipe	0-2"	0	0	0	0	0	0
	3"-6"	15	0	15	90	15	15
	7"-12"	0	0	0	0	0	0
	13"-18"	0	0	0	0	0	0
	19"-24"	0	0	0	0	0	0
	25"-36"	0	0	0	0	0	0
Process Pipe (Inter-unit)	0-2"	0	0	0	0	0	0
	3"-6"	0	144	0	0	0	0
	7"-12"	0	0	0	0	0	0
	13"-18"	0	0	0	0	0	0
	19"-24"	0	0	0	0	0	0
	25"-36"	0	0	0	0	0	0
Flange	0-2"	22	6	4	9	13	18
	3"-6"	1	10	16	17	21	4
	7"-12"	0	0	0	0	0	0
	13"-18"	0	0	0	0	0	0
	19"-24"	0	0	0	0	0	0
	25"-36"	0	0	0	0	0	0
Manual Valves	0-2"	11	4	3	6	8	9
	3"-6"	0	2	2	7	8	0
	7"-12"	0	0	0	0	0	0
	13"-18"	0	0	0	0	0	0
	19"-24"	0	0	0	0	0	0
	25"-36"	0	0	0	0	0	0
Actuated Valves	0-2"	2	2	2	1	2	1
	3"-6"	0	0	1	0	0	0
	7"-12"	0	0	0	0	0	0
	13"-18"	0	0	0	0	0	0
	19"-24"	0	0	0	0	0	0
	25"-36"	0	0	0	0	0	0
Small Bore Fittings	2"	4	2	19	12	3	20
Process Vessel	<= 6"	0.5	0	1.5	2	1	0.5
	> 6 "	0	0	0	0	0	0
Centrifugal Pump	<= 6"	0	0	0	0	0	0
	> 6 "	0	0	0	0	0	0
Reciprocating Pump	<= 6"	0	0	0	0	0	0
	> 6 "	0	0	0	0	0	0
Centrifugal Compressor	<= 6"	0	0	0	0	0	0
	> 6 "	0	0	0	0	0	0
Reciprocating Compressor	<= 6"	0	0	0	0	1	0
	> 6 "	0	0	0	0	0	0
Shell Side Heat Exchanger	<= 6"	0	0	0	0	0	1
	> 6 "	0	0	0	0	0	0
Tube Side Heat Exchanger	<= 6"	0	0	0	0	0	0
	> 6 "	0	0	0	0	0	0
Plate Heat Exchanger	<= 6"	0	0	0	0	0	0
	> 6 "	0	0	0	0	0	0
Air Cooled Heat Exchanger	<= 6"	0	0	0	0	1	0
	> 6 "	0	0	0	0	0	0
Filters	<= 6"	0	0	0	0	0	0
	> 6 "	0	0	0	0	0	0
Pig Trap	<= 6"	0	0	0	0	0	0
	> 6 "	0	0	0	0	0	0

LPG Production Facility - De-C3

Equipment	Size	KGT01_DPT_11_V	KGT01_DPX_11_L	KGT01_PC3_02_L	KGT01_DPB_11_L	KGT01_DPT_01_V	KGT01_DPX_01_L	KGT01_PC3_01_L	KGT01_DPB_01_L
Process Pipe	0-2"	0	0	15	0	0	0	22	0
	3"-6"	15	15	0	56	15	15	0	44
	7"-12"	0	0	0	0	0	0	0	0
	13"-18"	0	0	0	0	0	0	0	0
	19"-24"	0	0	0	0	0	0	0	0
	25"-36"	0	0	0	0	0	0	0	0
Process Pipe (Inter-unit)	0-2"	0	0	0	0	0	0	0	0
	3"-6"	0	0	0	0	0	0	0	0
	7"-12"	0	0	0	0	0	0	0	0
	13"-18"	0	0	0	0	0	0	0	0
	19"-24"	0	0	0	0	0	0	0	0
	25"-36"	0	0	0	0	0	0	0	0
Flange	0-2"	11	16	30	44	15	22	25	36
	3"-6"	12	21	1	11	11	11	0	4
	7"-12"	0	0	0	0	0	0	0	0
	13"-18"	0	0	0	0	0	0	0	0
	19"-24"	0	0	0	0	0	0	0	0
	25"-36"	0	0	0	0	0	0	0	0
Manual Valves	0-2"	6	10	17	29	8	10	13	21
	3"-6"	0	7	0	4	0	5	0	0
	7"-12"	0	0	0	0	0	0	0	0
	13"-18"	0	0	0	0	0	0	0	0
	19"-24"	0	0	0	0	0	0	0	0
	25"-36"	0	0	0	0	0	0	0	0
Actuated Valves	0-2"	2	1	3	2	2	1	2	2
	3"-6"	3	0	1	0	3	0	0	0
	7"-12"	0	0	0	0	0	0	0	0
	13"-18"	0	0	0	0	0	0	0	0
	19"-24"	0	0	0	0	0	0	0	0
	25"-36"	0	0	0	0	0	0	0	0
Small Bore Fittings	2"	8	8	8	12	26	10	5	16
Process Vessel	<= 6"	1	0.5	0	0.5	1	0.5	0	0.5
	> 6"	0	0	0	0	0	0	0	0
Centrifugal Pump	<= 6"	0	1	0	0	0	1	0	0
	> 6"	0	0	0	0	0	0	0	0
Reciprocating Pump	<= 6"	0	0	0	0	0	0	0	0
	> 6"	0	0	0	0	0	0	0	0
Centrifugal Compressor	<= 6"	0	0	0	0	0	0	0	0
	> 6"	0	0	0	0	0	0	0	0
Reciprocating Compressor	<= 6"	0	0	0	0	0	0	0	0
	> 6"	0	0	0	0	0	0	0	0
Shell Side Heat Exchanger	<= 6"	0	0	1	1	0	0	1	1
	> 6"	0	0	0	0	0	0	0	0
Tube Side Heat Exchanger	<= 6"	0	0	0	0	0	0	0	0
	> 6"	0	0	0	0	0	0	0	0
Plate Heat Exchanger	<= 6"	0	0	0	0	0	0	0	0
	> 6"	0	0	0	0	0	0	0	0
Air Cooled Heat Exchanger	<= 6"	1	0	0	0	1	0	0	0
	> 6"	0	0	0	0	0	0	0	0
Filters	<= 6"	0	0	0	0	0	0	0	0
	> 6"	0	0	0	0	0	0	0	0
Pig Trap	<= 6"	0	0	0	0	0	0	0	0
	> 6"	0	0	0	0	0	0	0	0

LPG Production Facility - De-C4

Equipment	Size	KGT01_DBT_11_V	KGT01_DBX_11_L	KGT01_NGL_01_L	KGT01_NGL_02_L	KGT01_DBT_01_V	KGT01_DBX_01_L	KGT01_DBB_01_L
Process Pipe	0-2"	0	0	0	0	0	0	0
	3"-6"	0	15	42	23	15	15	15
	7"-12"	0	0	0	0	0	0	0
	13"-18"	0	0	0	0	0	0	0
	19"-24"	0	0	0	0	0	0	0
	25"-36"	0	0	0	0	0	0	0
Process Pipe (Inter-unit)	0-2"	0	0	0	0	0	0	0
	3"-6"	168	0	0	0	0	0	0
	7"-12"	0	0	0	0	0	0	0
	13"-18"	0	0	0	0	0	0	0
	19"-24"	0	0	0	0	0	0	0
	25"-36"	0	0	0	0	0	0	0
Flange	0-2"	31	49	33	32	49	30	12
	3"-6"	18	6	4	1	6	6	4
	7"-12"	0	0	0	0	0	0	0
	13"-18"	0	0	0	0	0	0	0
	19"-24"	0	0	0	0	0	0	0
	25"-36"	0	0	0	0	0	0	0
Manual Valves	0-2"	26	28	18	15	10	18	7
	3"-6"	3	2	0	0	0	2	0
	7"-12"	0	0	0	0	0	0	0
	13"-18"	0	0	0	0	0	0	0
	19"-24"	0	0	0	0	0	0	0
	25"-36"	0	0	0	0	0	0	0
Actuated Valves	0-2"	2	4	2	5	2	2	1
	3"-6"	3	0	0	0	2	0	0
	7"-12"	0	0	0	0	0	0	0
	13"-18"	0	0	0	0	0	0	0
	19"-24"	0	0	0	0	0	0	0
	25"-36"	0	0	0	0	0	0	0
Small Bore Fittings	2"	8	15	16	14	15	12	9
Process Vessel	<= 6"	1	0.5	0.5	0	1	0.5	0.5
	> 6 "	0	0	0	0	0	0	0
Centrifugal Pump	<= 6"	0	1	0	0	0	1	0
	> 6 "	0	0	0	0	0	0	0
Reciprocating Pump	<= 6"	0	0	0	0	0	0	0
	> 6 "	0	0	0	0	0	0	0
Centrifugal Compressor	<= 6"	0	0	0	0	0	0	0
	> 6 "	0	0	0	0	0	0	0
Reciprocating Compressor	<= 6"	0	0	0	0	0	0	0
	> 6 "	0	0	0	0	0	0	0
Shell Side Heat Exchanger	<= 6"	0	0	1	1	0	0	1
	> 6 "	0	0	0	0	0	0	0
Tube Side Heat Exchanger	<= 6"	0	0	0	0	0	0	0
	> 6 "	0	0	0	0	0	0	0
Plate Heat Exchanger	<= 6"	0	0	0	0	0	0	0
	> 6 "	0	0	0	0	0	0	0
Air Cooled Heat Exchanger	<= 6"	1	0	0	1	1	0	0
	> 6 "	0	0	0	0	0	0	0
Filters	<= 6"	0	1	0	1	0	0	0
	> 6 "	0	0	0	0	0	0	0
Pig Trap	<= 6"	0	0	0	0	0	0	0
	> 6 "	0	0	0	0	0	0	0

Equipment	Size	KGT01_PC4_12_L	KGT01_PC3_13_L	KGT01_LPG_04_L
Process Pipe	0-2"	0	15	0
	3"-6"	41	0	0
	7"-12"	0	0	0
	13"-18"	0	0	0
	19"-24"	0	0	0
	25"-36"	0	0	0
Process Pipe (Inter-unit)	0-2"	0	0	232
	3"-6"	0	0	0
	7"-12"	0	0	0
	13"-18"	0	0	0
	19"-24"	0	0	0
	25"-36"	0	0	0
Flange	0-2"	14	9	36
	3"-6"	0	0	0
	7"-12"	0	0	0
	13"-18"	0	0	0
	19"-24"	0	0	0
	25"-36"	0	0	0
Manual Valves	0-2"	13	10	23
	3"-6"	0	0	0
	7"-12"	0	0	0
	13"-18"	0	0	0
	19"-24"	0	0	0
	25"-36"	0	0	0
Actuated Valves	0-2"	6	5	6
	3"-6"	0	0	0
	7"-12"	0	0	0
	13"-18"	0	0	0
	19"-24"	0	0	0
	25"-36"	0	0	0
Small Bore Fittings	2"	5	3	11
Process Vessel	<= 6"	0	0	0
	> 6 "	0	0	0
Centrifugal Pump	<= 6"	0	0	0
	> 6 "	0	0	0
Reciprocating Pump	<= 6"	0	0	0
	> 6 "	0	0	0
Centrifugal Compressor	<= 6"	0	0	0
	> 6 "	0	0	0
Reciprocating Compressor	<= 6"	0	0	0
	> 6 "	0	0	0
Shell Side Heat Exchanger	<= 6"	0	0	0
	> 6 "	0	0	0
Tube Side Heat Exchanger	<= 6"	1	0	0
	> 6 "	0	0	0
Plate Heat Exchanger	<= 6"	0	0	0
	> 6 "	0	0	0
Air Cooled Heat Exchanger	<= 6"	0	0	0
	> 6 "	0	0	0
Filters	<= 6"	0	0	0
	> 6 "	0	0	0
Pig Trap	<= 6"	0	0	0
	> 6 "	0	0	0

LPG Production Facility - Product Export and Loadout

Equipment	Size	KGT32_NGL_05_L	KGT33_NGL_06_L	KGT34_NGL_07_L	KGT35_NGL_09_L	KGT36_NGL_10_L	KGT36_NGL_11_L	KGT37_PC3_05_L	KGT39_PC3_07_V
Process Pipe	0-2"	0	0	0	0	0	0	0	0
	3"-6"	0	0	0	15	15	0	0	0
	7"-12"	0	0	0	0	0	0	0	0
	13"-18"	0	0	0	0	0	0	0	0
	19"-24"	0	0	0	0	0	0	0	0
	25"-36"	0	0	0	0	0	0	0	0
Process Pipe (Inter-unit)	0-2"	210	0	0	0	0	0	0	0
	3"-6"	0	103	0	0	0	0	81	0
	7"-12"	0	0	0	0	0	0	0	0
	13"-18"	0	0	0	0	0	0	0	0
	19"-24"	0	0	0	0	0	0	0	0
	25"-36"	0	0	0	0	0	0	0	0
Flange	0-2"	4	9	0	3	0	0	1	0
	3"-6"	0	4	0	12	16	0	14	0
	7"-12"	0	0	0	0	0	0	0	0
	13"-18"	0	0	0	0	0	0	0	0
	19"-24"	0	0	0	0	0	0	0	0
	25"-36"	0	0	0	0	0	0	0	0
Manual Valves	0-2"	6	10	0	4	2	0	4	0
	3"-6"	0	2	0	2	3	0	3	0
	7"-12"	0	0	0	0	0	0	0	0
	13"-18"	0	0	0	0	0	0	0	0
	19"-24"	0	0	0	0	0	0	0	0
	25"-36"	0	0	0	0	0	0	0	0
Actuated Valves	0-2"	1	3	0	1	1	0	3	0
	3"-6"	0	0	0	2	1	0	3	0
	7"-12"	0	0	0	0	0	0	0	0
	13"-18"	0	0	0	0	0	0	0	0
	19"-24"	0	0	0	0	0	0	0	0
	25"-36"	0	0	0	0	0	0	0	0
Small Bore Fittings	2"	1	6	0	2	3	0	1	0
Process Vessel/ Storage Tank	<= 6"	0	0	1	0	1	0	0	0.5
	> 6"	0	0	0	0	0	0	0	0
Centrifugal Pump	<= 6"	0	0	0	1	0	0	0	0
	> 6"	0	0	0	0	0	0	0	0
Reciprocating Pump	<= 6"	0	0	0	0	0	0	0	0
	> 6"	0	0	0	0	0	0	0	0
Centrifugal Compressor	<= 6"	0	0	0	0	0	0	0	0
	> 6"	0	0	0	0	0	0	0	0
Reciprocating Compressor	<= 6"	0	0	0	0	0	0	0	0
	> 6"	0	0	0	0	0	0	0	0
Shell Side Heat Exchanger	<= 6"	0	0	0	0	0	0	0	0
	> 6"	0	0	0	0	0	0	0	0
Tube Side Heat Exchanger	<= 6"	0	0	0	0	0	0	0	0
	> 6"	0	0	0	0	0	0	0	0
Plate Heat Exchanger	<= 6"	0	0	0	0	0	0	0	0
	> 6"	0	0	0	0	0	0	0	0
Air Cooled Heat Exchanger	<= 6"	0	0	0	0	0	0	0	0
	> 6"	0	0	0	0	0	0	0	0
Filters	<= 6"	0	0	0	1	0	0	0	0
	> 6"	0	0	0	0	0	0	0	0
Pig Trap	<= 6"	0	0	0	0	0	0	0	0
	> 6"	0	0	0	0	0	0	0	0
Loading Hose	-	0	0	0	0	0	1	0	0
Loading Arm	-	0	0	0	0	0	0	0	0

Equipment	Size	KGT39_PC3_08_L	KGT40_PC3_09_V	KGT40_PC3_10_L	KGT41_PC4_04_L	KGT43_PC4_06_V	KGT43_PC4_07_L	KGT44_PC4_08_V	KGT44_PC4_09_L
Process Pipe	0-2"	0	0	0	0	0	0	0	0
	3"-6"	0	0	0	0	0	0	0	0
	7"-12"	0	0	0	0	0	0	0	0
	13"-18"	0	0	0	0	0	0	0	0
	19"-24"	0	0	0	0	0	0	0	0
	25"-36"	0	0	0	0	0	0	0	0
Process Pipe (Inter-unit)	0-2"	0	0	0	0	0	0	0	0
	3"-6"	0	0	0	87	0	0	0	0
	7"-12"	0	0	0	0	0	0	0	0
	13"-18"	0	0	0	0	0	0	0	0
	19"-24"	0	0	0	0	0	0	0	0
	25"-36"	0	0	0	0	0	0	0	0
Flange	0-2"	0	0	0	4	0	0	0	0
	3"-6"	0	0	0	11	0	0	0	0
	7"-12"	0	0	0	0	0	0	0	0
	13"-18"	0	0	0	0	0	0	0	0
	19"-24"	0	0	0	0	0	0	0	0
	25"-36"	0	0	0	0	0	0	0	0
Manual Valves	0-2"	0	0	0	8	0	0	0	0
	3"-6"	0	0	0	3	0	0	0	0
	7"-12"	0	0	0	0	0	0	0	0
	13"-18"	0	0	0	0	0	0	0	0
	19"-24"	0	0	0	0	0	0	0	0
	25"-36"	0	0	0	0	0	0	0	0
Actuated Valves	0-2"	0	0	0	5	0	0	0	0
	3"-6"	0	0	0	2	0	0	0	0
	7"-12"	0	0	0	0	0	0	0	0
	13"-18"	0	0	0	0	0	0	0	0
	19"-24"	0	0	0	0	0	0	0	0
	25"-36"	0	0	0	0	0	0	0	0
Small Bore Fittings	2"	0	0	0	1	0	0	0	0
Process Vessel/ Storage Tank	<= 6"	0.5	0.5	0.5	0	0.5	0.5	0.5	0.5
	> 6 "	0	0	0	0	0	0	0	0
Centrifugal Pump	<= 6"	0	0	0	0	0	0	0	0
	> 6 "	0	0	0	0	0	0	0	0
Reciprocating Pump	<= 6"	0	0	0	0	0	0	0	0
	> 6 "	0	0	0	0	0	0	0	0
Centrifugal Compressor	<= 6"	0	0	0	0	0	0	0	0
	> 6 "	0	0	0	0	0	0	0	0
Reciprocating Compressor	<= 6"	0	0	0	0	0	0	0	0
	> 6 "	0	0	0	0	0	0	0	0
Shell Side Heat Exchanger	<= 6"	0	0	0	0	0	0	0	0
	> 6 "	0	0	0	0	0	0	0	0
Tube Side Heat Exchanger	<= 6"	0	0	0	0	0	0	0	0
	> 6 "	0	0	0	0	0	0	0	0
Plate Heat Exchanger	<= 6"	0	0	0	0	0	0	0	0
	> 6 "	0	0	0	0	0	0	0	0
Air Cooled Heat Exchanger	<= 6"	0	0	0	0	0	0	0	0
	> 6 "	0	0	0	0	0	0	0	0
Filters	<= 6"	0	0	0	0	0	0	0	0
	> 6 "	0	0	0	0	0	0	0	0
Pig Trap	<= 6"	0	0	0	0	0	0	0	0
	> 6 "	0	0	0	0	0	0	0	0
Loading Hose	-	0	0	0	0	0	0	0	0
Loading Arm	-	0	0	0	0	0	0	0	0

Equipment	Size	KGT45_PC3_12_L	KGT46_PC4_11_L	KGT47_LPG_01_L	KGT47_LPG_02_L	KGT47_LPG_05_L
Process Pipe	0-2"	0	0	0	0	0
	3"-6"	0	0	15	0	0
	7"-12"	15	15	0	0	0
	13"-18"	0	0	0	0	0
	19"-24"	0	0	0	0	0
	25"-36"	0	0	0	0	0
Process Pipe (Inter-unit)	0-2"	0	0	0	0	0
	3"-6"	0	0	0	0	0
	7"-12"	0	0	0	0	0
	13"-18"	0	0	0	0	0
	19"-24"	0	0	0	0	0
	25"-36"	0	0	0	0	0
Flange	0-2"	6	2	0	0	0
	3"-6"	18	12	11	0	0
	7"-12"	8	6	0	0	0
	13"-18"	0	0	0	0	0
	19"-24"	0	0	0	0	0
	25"-36"	0	0	0	0	0
Manual Valves	0-2"	13	6	4	0	0
	3"-6"	3	2	3	0	0
	7"-12"	2	2	0	0	0
	13"-18"	0	0	0	0	0
	19"-24"	0	0	0	0	0
	25"-36"	0	0	0	0	0
Actuated Valves	0-2"	5	4	2	0	0
	3"-6"	5	3	0	0	0
	7"-12"	0	0	0	0	0
	13"-18"	0	0	0	0	0
	19"-24"	0	0	0	0	0
	25"-36"	0	0	0	0	0
Small Bore Fittings	2"	4	3	3	0	0
Process Vessel/ Storage Tank	<= 6"	0	0	0	0	0
	> 6 "	0	0	0	0	0
Centrifugal Pump	<= 6"	1	1	0	0	0
	> 6 "	0	0	0	0	0
Reciprocating Pump	<= 6"	0	0	0	0	0
	> 6 "	0	0	0	0	0
Centrifugal Compressor	<= 6"	0	0	0	0	0
	> 6 "	0	0	0	0	0
Reciprocating Compressor	<= 6"	0	0	0	0	0
	> 6 "	0	0	0	0	0
Shell Side Heat Exchanger	<= 6"	0	0	0	0	0
	> 6 "	0	0	0	0	0
Tube Side Heat Exchanger	<= 6"	0	0	0	0	0
	> 6 "	0	0	0	0	0
Plate Heat Exchanger	<= 6"	0	0	0	0	0
	> 6 "	0	0	0	0	0
Air Cooled Heat Exchanger	<= 6"	0	0	0	0	0
	> 6 "	0	0	0	0	0
Filters	<= 6"	0	0	0	0	0
	> 6 "	1	1	0	0	0
Pig Trap	<= 6"	0	0	0	0	0
	> 6 "	0	0	0	0	0
Loading Hose	-	0	0	0	0	1
Loading Arm	-	0	0	0	1	0

Propane Refrigeration

Equipment	Size	KGT70_REF_01_V	KGT70_REF_02_L	KGT70_REF_03_V	KGT70_REF_04_L	KGT70_REF_05_L	KGT70_REF_07_L	KGT70_REF_11_V
Process Pipe	0-2"	0	0	0	0	0	0	0
	3"-6"	15	15	22	0	15	15	0
	7"-12"	0	0	0	0	0	0	0
	13"-18"	0	0	0	0	0	0	0
	19"-24"	0	0	0	0	0	0	0
	25"-36"	0	0	0	0	0	0	0
Process Pipe (Inter-unit)	0-2"	0	0	0	0	0	0	0
	3"-6"	0	0	0	0	0	0	0
	7"-12"	0	0	0	174	0	0	154
	13"-18"	0	0	0	0	0	0	0
	19"-24"	0	0	0	0	0	0	0
	25"-36"	0	0	0	0	0	0	0
Flange	0-2"	3	6	3	21	5	3	7
	3"-6"	1	8	23	1	3	2	13
	7"-12"	0	0	0	3	0	0	24
	13"-18"	0	0	0	0	0	0	0
	19"-24"	0	0	0	0	0	0	0
	25"-36"	0	0	0	0	0	0	0
Manual Valves	0-2"	2	2	2	15	1	1	12
	3"-6"	0	3	7	0	0	1	5
	7"-12"	0	0	0	0	0	0	6
	13"-18"	0	0	0	0	0	0	0
	19"-24"	0	0	0	0	0	0	0
	25"-36"	0	0	0	0	0	0	0
Actuated Valves	0-2"	1	1	1	6	0	0	3
	3"-6"	1	0	1	0	0	0	1
	7"-12"	0	0	0	0	0	0	0
	13"-18"	0	0	0	0	0	0	0
	19"-24"	0	0	0	0	0	0	0
	25"-36"	0	0	0	0	0	0	0
Small Bore Fittings	2"	3	3	4	5	5	2	7
Process Vessel	<= 6"	0.5	0.5	0.5	0	0	0	0
	> 6"	0	0	0	0.5	0	0	0.5
Centrifugal Pump	<= 6"	0	0	0	0	0	0	0
	> 6"	0	0	0	0	0	0	0
Reciprocating Pump	<= 6"	0	0	0	0	0	0	0
	> 6"	0	0	0	0	0	0	0
Centrifugal Compressor	<= 6"	0	0	0	0	0	0	0
	> 6"	0	0	0	0	0	0	0
Reciprocating Compressor	<= 6"	0	0	0	0	0	0	0
	> 6"	0	0	0	0	0	0	0
Shell Side Heat Exchanger	<= 6"	0	0	0	0	1	1	0
	> 6"	0	0	0	0	0	0	0
Tube Side Heat Exchanger	<= 6"	0	0	0	0	0	0	0
	> 6"	0	0	0	0	0	0	0
Plate Heat Exchanger	<= 6"	0	0	0	0	0	0	0
	> 6"	0	0	0	0	0	0	0
Air Cooled Heat Exchanger	<= 6"	0	0	0	0	0	0	0
	> 6"	0	0	0	0	0	0	0
Filters	<= 6"	0	0	2	0	0	0	0
	> 6"	0	0	0	0	0	0	2
Pig Trap	<= 6"	0	0	0	0	0	0	0
	> 6"	0	0	0	0	0	0	0

Equipment	Size	KGT70_REF_14_V	KGT70_REF_15_L	KGT70_REF_06_L
Process Pipe	0-2"	0	0	0
	3"-6"	0	0	64
	7"-12"	65	28	0
	13"-18"	0	0	0
	19"-24"	0	0	0
	25"-36"	0	0	0
Process Pipe (Inter-unit)	0-2"	0	0	0
	3"-6"	0	0	0
	7"-12"	0	0	0
	13"-18"	0	0	0
	19"-24"	0	0	0
	25"-36"	0	0	0
Flange	0-2"	13	1	5
	3"-6"	22	4	8
	7"-12"	1	1	0
	13"-18"	0	0	0
	19"-24"	0	0	0
	25"-36"	0	0	0
Manual Valves	0-2"	7	5	1
	3"-6"	4	1	3
	7"-12"	0	0	0
	13"-18"	0	0	0
	19"-24"	0	0	0
	25"-36"	0	0	0
Actuated Valves	0-2"	2	0	0
	3"-6"	1	0	0
	7"-12"	0	0	0
	13"-18"	0	0	0
	19"-24"	0	0	0
	25"-36"	0	0	0
Small Bore Fittings	2"	20	8	4
Process Vessel	<= 6"	2	0	0
	> 6 "	0	0	0
Centrifugal Pump	<= 6"	0	0	0
	> 6 "	0	0	0
Reciprocating Pump	<= 6"	0	0	0
	> 6 "	0	0	0
Centrifugal Compressor	<= 6"	0	0	0
	> 6 "	0	0	0
Reciprocating Compressor	<= 6"	0	0	0
	> 6 "	2	0	0
Shell Side Heat Exchanger	<= 6"	0	0	1
	> 6 "	0	0	0
Tube Side Heat Exchanger	<= 6"	0	0	0
	> 6 "	0	0	0
Plate Heat Exchanger	<= 6"	0	0	0
	> 6 "	0	0	0
Air Cooled Heat Exchanger	<= 6"	0	2	0
	> 6 "	0	1	0
Filters	<= 6"	0	0	0
	> 6 "	0	0	0
Pig Trap	<= 6"	0	0	0
	> 6 "	0	0	0

Mercaptans and Methanol Injection System

Equipment	Size	KGT50 EMC_01_L	KGT50 EMC_02_L	KGT51 BMC_05_L	KGT52 BMC_01_L	KGT52 BMC_02_L	KGT52 BMC_03_L	KGT55 MOH_01_L	KGT55 MOH_02_L	KGT55 MOH_03_L
Process Pipe	0-2"	15	0	0	0	15	0	0	0	0
	3"-6"	0	0	0	0	0	0	0	0	0
	7"-12"	0	0	0	0	0	0	0	0	0
	13"-18"	0	0	0	0	0	0	0	0	0
	19"-24"	0	0	0	0	0	0	0	0	0
	25"-36"	0	0	0	0	0	0	0	0	0
Process Pipe (Inter-unit)	0-2"	0	0	0	0	0	0	0	343	0
	3"-6"	0	0	0	0	0	0	0	0	0
	7"-12"	0	0	0	0	0	0	0	0	0
	13"-18"	0	0	0	0	0	0	0	0	0
	19"-24"	0	0	0	0	0	0	0	0	0
	25"-36"	0	0	0	0	0	0	0	0	0
Flange	0-2"	0	0	0	0	3	0	0	17	0
	3"-6"	0	0	0	0	0	0	0	0	0
	7"-12"	0	0	0	0	0	0	0	0	0
	13"-18"	0	0	0	0	0	0	0	0	0
	19"-24"	0	0	0	0	0	0	0	0	0
	25"-36"	0	0	0	0	0	0	0	0	0
Manual Valves	0-2"	19	0	0	0	17	0	0	55	0
	3"-6"	0	0	0	0	0	0	0	0	0
	7"-12"	0	0	0	0	0	0	0	0	0
	13"-18"	0	0	0	0	0	0	0	0	0
	19"-24"	0	0	0	0	0	0	0	0	0
	25"-36"	0	0	0	0	0	0	0	0	0
Actuated Valves	0-2"	3	0	0	0	0	0	0	2	0
	3"-6"	0	0	0	0	0	0	0	0	0
	7"-12"	0	0	0	0	0	0	0	0	0
	13"-18"	0	0	0	0	0	0	0	0	0
	19"-24"	0	0	0	0	0	0	0	0	0
	25"-36"	0	0	0	0	0	0	0	0	0
Small Bore Fittings	2"	3	0	0	0	6	0	0	9	0
Storage Tank /Portable Drum	<= 6"	0	1	1	1	0	0	4	0	0
	> 6"	0	0	0	0	0	0	0	0	0
Centrifugal Pump	<= 6"	1	0	0	0	0	0	0	0	0
	> 6"	0	0	0	0	0	0	0	0	0
Reciprocating Pump	<= 6"	0	0	0	0	1	0	0	2	0
	> 6"	0	0	0	0	0	0	0	0	0
Centrifugal Compressor	<= 6"	0	0	0	0	0	0	0	0	0
	> 6"	0	0	0	0	0	0	0	0	0
Reciprocating Compressor	<= 6"	0	0	0	0	0	0	0	0	0
	> 6"	0	0	0	0	0	0	0	0	0
Shell Side Heat Exchanger	<= 6"	0	0	0	0	0	0	0	0	0
	> 6"	0	0	0	0	0	0	0	0	0
Tube Side Heat Exchanger	<= 6"	0	0	0	0	0	0	0	0	0
	> 6"	0	0	0	0	0	0	0	0	0
Plate Heat Exchanger	<= 6"	0	0	0	0	0	0	0	0	0
	> 6"	0	0	0	0	0	0	0	0	0
Air Cooled Heat Exchanger	<= 6"	0	0	0	0	0	0	0	0	0
	> 6"	0	0	0	0	0	0	0	0	0
Filters	<= 6"	1	0	0	0	2	0	0	4	0
	> 6"	0	0	0	0	0	0	0	0	0
Pig Trap	<= 6"	1	0	0	0	0	0	0	0	0
	> 6"	0	0	0	0	0	0	0	0	0
Loading Hose	-	0	0	0	0	0	1	0	0	1
Loading Arm	-	0	0	0	0	0	0	0	0	0

CO2 Recovery - Ammonia

Equipment	Size	KGT80_AMM_01_V	KGT80_AMM_11_V	KGT80_AMM_02_V	KGT80_AMM_03_L	KGT80_AMM_04_L	KGT80_AMM_07_L	KGT80_AMM_08_V	KGT80_AMM_09_V
Process Pipe	0-2"	0	0	15	0	0	38	0	0
	3"-6"	15	15	0	15	21	0	0	48
	7"-12"	0	0	0	0	0	0	15	0
	13"-18"	0	0	0	0	0	0	0	0
	19"-24"	0	0	0	0	0	0	0	0
	25"-36"	0	0	0	0	0	0	0	0
Process Pipe (Inter-unit)	0-2"	0	0	0	0	0	0	0	0
	3"-6"	0	0	0	0	0	0	0	0
	7"-12"	0	0	0	0	0	0	0	0
	13"-18"	0	0	0	0	0	0	0	0
	19"-24"	0	0	0	0	0	0	0	0
	25"-36"	0	0	0	0	0	0	0	0
Flange	0-2"	6	2	2	6	21	8	6	37
	3"-6"	9	7	0	2	0	0	10	1
	7"-12"	0	0	0	0	0	0	4	0
	13"-18"	0	0	0	0	0	0	0	0
	19"-24"	0	0	0	0	0	0	0	0
	25"-36"	0	0	0	0	0	0	0	0
Manual Valves	0-2"	12	8	7	9	21	14	12	21
	3"-6"	4	3	0	0	0	0	4	0
	7"-12"	0	0	0	0	0	0	1	0
	13"-18"	0	0	0	0	0	0	0	0
	19"-24"	0	0	0	0	0	0	0	0
	25"-36"	0	0	0	0	0	0	0	0
Actuated Valves	0-2"	1	2	2	0	9	2	1	7
	3"-6"	0	0	0	0	0	0	0	0
	7"-12"	0	0	0	0	0	0	0	0
	13"-18"	0	0	0	0	0	0	0	0
	19"-24"	0	0	0	0	0	0	0	0
	25"-36"	0	0	0	0	0	0	0	0
Small Bore Fittings	2"	6	7	4	2	6	4	4	7
Process Vessel	<= 6"	0.5	0.5	1	1	0	0	0	0
	> 6 "	0	0	0	0	0	0	0	0
Centrifugal Pump	<= 6"	0	0	0	0	0	0	0	0
	> 6 "	0	0	0	0	0	0	0	0
Reciprocating Pump	<= 6"	0	0	0	0	0	0	0	0
	> 6 "	0	0	0	0	0	0	0	0
Centrifugal Compressor	<= 6"	0	0	0	0	0	0	0	0
	> 6 "	0	0	0	0	0	0	0	0
Reciprocating Compressor	<= 6"	0	0	0	0	0	0	0	0
	> 6 "	1	1	0	0	0	0	0	0
Shell Side Heat Exchanger	<= 6"	0	0	0	0	1	1	1	0
	> 6 "	0	0	0	0	0	0	0	0
Tube Side Heat Exchanger	<= 6"	0	0	0	0	0	0	0	0
	> 6 "	0	0	0	0	0	0	0	0
Plate Heat Exchanger	<= 6"	0	0	0	2	2	0	0	2
	> 6 "	0	0	0	0	0	0	0	0
Air Cooled Heat Exchanger	<= 6"	0	0	0	0	0	0	0	0
	> 6 "	0	0	0	0	0	0	0	0
Filters	<= 6"	0	0	0	0	3	0	1	2
	> 6 "	0	0	0	0	0	0	0	0
Pig Trap	<= 6"	0	0	0	0	0	0	0	0
	> 6 "	0	0	0	0	0	0	0	0

CO2 Recovery - CO2

Equipment	Size	KGT90_CO2_01_V	KGT90_CO2_02_V	KGT90_CO2_03_V	KGT90_CO2_07_V	KGT90_CO2_08_L	KGT90_CO2_16_V	KGT90_CO2_18_V	KGT90_CO2_19_V	KGT90_CO2_23_V
Process Pipe	0-2"	0	0	0	0	0	0	0	0	0
	3"-6"	15	15	31	89	71	0	0	15	0
	7"-12"	0	0	0	0	0	0	0	0	15
	13"-18"	0	0	0	0	0	0	0	0	0
	19"-24"	0	0	0	0	0	0	0	0	0
	25"-36"	0	0	0	0	0	0	0	0	0
Process Pipe (Inter-unit)	0-2"	0	0	0	0	0	0	321	0	0
	3"-6"	0	0	0	0	0	0	0	0	0
	7"-12"	0	0	0	0	0	180	0	0	0
	13"-18"	0	0	0	0	0	0	0	0	0
	19"-24"	0	0	0	0	0	0	0	0	0
	25"-36"	0	0	0	0	0	0	0	0	0
Flange	0-2"	2	4	5	33	35	11	30	44	0
	3"-6"	9	6	15	26	11	11	0	5	2
	7"-12"	0	0	0	0	0	60	0	0	3
	13"-18"	0	0	0	0	0	0	0	0	0
	19"-24"	0	0	0	0	0	0	0	0	0
	25"-36"	0	0	0	0	0	0	0	0	0
Manual Valves	0-2"	3	5	3	18	23	18	33	22	1
	3"-6"	2	2	1	15	7	2	0	1	0
	7"-12"	0	0	0	0	0	18	0	0	0
	13"-18"	0	0	0	0	0	0	0	0	0
	19"-24"	0	0	0	0	0	0	0	0	0
	25"-36"	0	0	0	0	0	0	0	0	0
Actuated Valves	0-2"	2	2	1	1	12	0	2	5	0
	3"-6"	0	0	1	0	0	2	0	0	1
	7"-12"	0	0	0	0	0	2	0	0	1
	13"-18"	0	0	0	0	0	0	0	0	0
	19"-24"	0	0	0	0	0	0	0	0	0
	25"-36"	0	0	0	0	0	0	0	0	0
Small Bore Fittings	2"	9	9	6	9	9	25	2	19	1
Process Vessel/ Storage Tank	<= 6"	2	2	2	2	1	0	0	2	0
	> 6"	0	0	0	0	0	5.5	0	0	1
Centrifugal Pump	<= 6"	0	0	0	0	1	0	0	0	0
	> 6"	0	0	0	0	0	0	0	0	0
Reciprocating Pump	<= 6"	0	0	0	0	0	0	0	0	0
	> 6"	0	0	0	0	0	0	0	0	0
Centrifugal Compressor	<= 6"	0	0	0	0	0	0	0	0	0
	> 6"	0	0	0	0	0	2	0	0	0
Reciprocating Compressor	<= 6"	0	0	0	0	0	0	0	0	0
	> 6"	1	1	0	0	0	0	0	0	0
Shell Side Heat Exchanger	<= 6"	0	0	1	0	0	0	0	0	0
	> 6"	0	0	0	0	0	0	0	0	0
Tube Side Heat Exchanger	<= 6"	1	1	1	0	1	0	0	0	0
	> 6"	0	0	0	0	0	0	0	0	0
Plate Heat Exchanger	<= 6"	0	0	0	0	0	2	0	0	0
	> 6"	0	0	0	0	0	0	0	0	0
Air Cooled Heat Exchanger	<= 6"	0	0	0	0	0	0	0	2	0
	> 6"	0	0	0	0	0	0	0	0	0
Filters	<= 6"	0	0	0	1	1	0	0	0	0
	> 6"	0	0	0	0	0	0	0	0	0
Pig Trap	<= 6"	0	0	0	0	0	0	0	0	0
	> 6"	0	0	0	0	0	0	0	0	0
Loading Hose	-	0	0	0	0	0	0	0	0	0
Loading Arm	-	0	0	0	0	0	0	0	0	0

Equipment	Size	KGT90_CO2_09_L	KGT90_CO2_10_L	KGT90_CO2_11_L	KGT90_CO2_12_L	KGT90_CO2_24_L	KGT90_CO2_25_L	KGT90_CO2_26_V
Process Pipe	0-2"	0	0	0	0	0	15	23
	3"-6"	0	0	0	0	71	0	0
	7"-12"	0	0	0	0	0	0	0
	13"-18"	0	0	0	0	0	0	0
	19"-24"	0	0	0	0	0	0	0
	25"-36"	0	0	0	0	0	0	0
Process Pipe (Inter-unit)	0-2"	0	0	0	0	0	0	0
	3"-6"	0	0	0	0	0	0	0
	7"-12"	0	0	0	0	0	0	0
	13"-18"	0	0	0	0	0	0	0
	19"-24"	0	0	0	0	0	0	0
	25"-36"	0	0	0	0	0	0	0
Flange	0-2"	0	0	0	0	4	11	7
	3"-6"	0	0	0	0	17	0	0
	7"-12"	0	0	0	0	0	0	0
	13"-18"	0	0	0	0	0	0	0
	19"-24"	0	0	0	0	0	0	0
	25"-36"	0	0	0	0	0	0	0
Manual Valves	0-2"	0	0	0	0	5	3	11
	3"-6"	0	0	0	0	13	0	0
	7"-12"	0	0	0	0	0	0	0
	13"-18"	0	0	0	0	0	0	0
	19"-24"	0	0	0	0	0	0	0
	25"-36"	0	0	0	0	0	0	0
Actuated Valves	0-2"	0	0	0	0	10	2	1
	3"-6"	0	0	0	0	0	0	0
	7"-12"	0	0	0	0	0	0	0
	13"-18"	0	0	0	0	0	0	0
	19"-24"	0	0	0	0	0	0	0
	25"-36"	0	0	0	0	0	0	0
Small Bore Fittings	2"	0	0	0	0	1	2	1
Process Vessel/ Storage Tank	<= 6"	1	1	1	1	0	0	0
	> 6"	0	0	0	0	0	0	0
Centrifugal Pump	<= 6"	0	0	0	0	1	0	0
	> 6"	0	0	0	0	0	0	0
Reciprocating Pump	<= 6"	0	0	0	0	0	1	0
	> 6"	0	0	0	0	0	0	0
Centrifugal Compressor	<= 6"	0	0	0	0	0	0	0
	> 6"	0	0	0	0	0	0	0
Reciprocating Compressor	<= 6"	0	0	0	0	0	0	0
	> 6"	0	0	0	0	0	0	0
Shell Side Heat Exchanger	<= 6"	0	0	0	0	0	0	0
	> 6"	0	0	0	0	0	0	0
Tube Side Heat Exchanger	<= 6"	0	0	0	0	0	0	0
	> 6"	0	0	0	0	0	0	0
Plate Heat Exchanger	<= 6"	0	0	0	0	0	0	0
	> 6"	0	0	0	0	0	0	0
Air Cooled Heat Exchanger	<= 6"	0	0	0	0	0	0	0
	> 6"	0	0	0	0	0	0	0
Filters	<= 6"	0	0	0	0	1	1	0
	> 6"	0	0	0	0	0	0	0
Pig Trap	<= 6"	0	0	0	0	0	0	0
	> 6"	0	0	0	0	0	0	0
Loading Hose	-	0	0	0	0	0	0	0
Loading Arm	-	0	0	0	0	0	0	0

Equipment	Size	KGT90_CO2_27_V	KGT90_CO2_28_L	KGT90_CO2_29_V	KGT90_CO2_30_L	KGT90_CO2_31_V	KGT90_CO2_32_L
Process Pipe	0-2"	15	0	0	0	0	0
	3"-6"	0	0	0	0	0	0
	7"-12"	0	0	0	0	0	0
	13"-18"	0	0	0	0	0	0
	19"-24"	0	0	0	0	0	0
	25"-36"	0	0	0	0	0	0
Process Pipe (Inter-unit)	0-2"	0	0	0	0	0	0
	3"-6"	0	0	0	0	0	0
	7"-12"	0	0	0	0	0	0
	13"-18"	0	0	0	0	0	0
	19"-24"	0	0	0	0	0	0
	25"-36"	0	0	0	0	0	0
Flange	0-2"	5	0	0	0	0	0
	3"-6"	0	0	0	0	0	0
	7"-12"	0	0	0	0	0	0
	13"-18"	0	0	0	0	0	0
	19"-24"	0	0	0	0	0	0
	25"-36"	0	0	0	0	0	0
Manual Valves	0-2"	6	0	0	0	0	0
	3"-6"	0	0	0	0	0	0
	7"-12"	0	0	0	0	0	0
	13"-18"	0	0	0	0	0	0
	19"-24"	0	0	0	0	0	0
	25"-36"	0	0	0	0	0	0
Actuated Valves	0-2"	3	0	0	0	0	0
	3"-6"	0	0	0	0	0	0
	7"-12"	0	0	0	0	0	0
	13"-18"	0	0	0	0	0	0
	19"-24"	0	0	0	0	0	0
	25"-36"	0	0	0	0	0	0
Small Bore Fittings	2"	1	0	0	0	0	0
Process Vessel/ Storage Tank	<= 6"	0	0	0	0	0	0
	> 6"	0	0	0	0	0	0
Centrifugal Pump	<= 6"	0	0	0	0	0	0
	> 6"	0	0	0	0	0	0
Reciprocating Pump	<= 6"	0	0	0	0	0	0
	> 6"	0	0	0	0	0	0
Centrifugal Compressor	<= 6"	0	0	0	0	0	0
	> 6"	0	0	0	0	0	0
Reciprocating Compressor	<= 6"	0	0	0	0	0	0
	> 6"	0	0	0	0	0	0
Shell Side Heat Exchanger	<= 6"	0	0	0	0	0	0
	> 6"	0	0	0	0	0	0
Tube Side Heat Exchanger	<= 6"	0	0	0	0	0	0
	> 6"	0	0	0	0	0	0
Plate Heat Exchanger	<= 6"	0	0	0	0	0	0
	> 6"	0	0	0	0	0	0
Air Cooled Heat Exchanger	<= 6"	0	0	0	0	0	0
	> 6"	0	0	0	0	0	0
Filters	<= 6"	0	0	0	0	0	0
	> 6"	0	0	0	0	0	0
Pig Trap	<= 6"	0	0	0	0	0	0
	> 6"	0	0	0	0	0	0
Loading Hose	-	0	1	1	1	1	1
Loading Arm	-	0	0	0	0	0	0

Appendix 3.

Estimated Piping Lengths

Table A3- 1: Estimated Piping Lengths

From	To	Estimated length (m) ^{Note1}	After applied 25% Safety Factor (m)
Raw Gas from (M-507)	Absorber Towers (D-101-1/2) inlet Valves (PV-101-1/2) and bypass to Separator (D-201-4) top line	207	259
Inlet Separator (M-507)	LPG Surge Vaporiser (F-201)	174	218
300 line & 309 line (XSV-594)	AUP/ Ballance & Lactose Plant -306 line (up to XSV-9622)	88.7	111
High Temperature Separator (M-307)	KPS and Whareroa (up to KPS/KGTP Site Boundary)	183	229
Product Gas header near LTS pipe bridge	Gas Storage Compressors in LTS unit (via LTS pipe bridge)	219	274
Product Gas compressors (C-903-2/3/5)	Stores/ Workshop/ Admin. Building (end of pipe rack)	201	251
Product Gas compressors (C-903-2/3/5)	100/200 Pipelines in Transmission metering area (via LTS pipe bridge)	222	278
Fuel Gas Superheater (E-603)	HRSG A/B Burners (B-604-A-1/2/3, B-604-B1/2/3)	111	138
Product Gas header from Gas Treatment Plant	Ammonia/ CO ₂ Compressor Engines (CE-821/822) in CO ₂ Recovery Unit	123	154
Product Gas header from Gas Treatment Plant	Gas Flare System Burners (D1-4100B)	219	274
High Temperature Separator (M-307)	De-ethaniser (D-420-2)	155	194
De-Ethaniser(D-420-2)	OVHD Compressor (C-421-1/2)	88	110
De-Ethaniser OVHD Compressor (C-421-1)	Absorber Towers (D-101-1/2) and Decanted Water Strippers (D-201-3/4)	115	143
Wash Water Coalescer (M-302)	Stabiliser (D-420-1)	115	144
De-Butaniser (D-440-2)	Surge Vaporiser (F-201)	134	168
60/40 Condensing Tank (M-430)	XSV-434 on KPS export line (up to KPS/KGTP Site Boundary)	186	232
Gasoline Cooler (E-460)	KPS (up to KPS/KGTP Site Boundary)	168	210
Gasoline Cooler (E-460)	NGL Storage Tank (F-4033)	83 (aboveground) 475 (underground) ^{Note2}	578 ^{Note2}
Propane Product Coolers (E-4001-1/2)	Propane Storage Vessels (F-4003, F-4004)	81 (aboveground) 475 (underground) ^{Note2}	556 ^{Note2}
De-Butaniser Reflux Pumps (G-440-3/4)	Butane Storage Vessels (F-4001, F-4002)	70 (aboveground) 475 (underground) ^{Note2}	562 ^{Note2}
Propane Refrigerant Economiser (D-315-2)	Gas Chiller (E-313-3), De-Ethaniser Overhead Condenser (E-420-2)	140	174
Gas Chiller (E-313-3), De-Ethaniser Overhead Condenser (E-420-2)	Compressors (C-330-1/ 2)	123	154
Methanol Storage Tanks (F-502-1/2/4/6)	De-ethaniser (D-420-2), HT Separator Condensate Pumps (G-30101/2), Gas/gas Heat Exchanger (E-313-1/2)	274	343
Raw Gas Boosters (C-885 / C-823)	CO ₂ Compressors (C-802/822)	144	180
CO ₂ storages (F-801-1/2/3)	Utility CO ₂ users: Product Gas Compressor Shelter and LPG Storage tanks	257 (aboveground) 475 (underground) ^{Note2}	796 ^{Note2}

Note:

1. The piping lengths are measured from KGTP Layout drawings using scale. A safety factor of 1.25 has been applied to all lengths measured from the map to account for bends and elevations which could not be determined from the 2D map.
2. Underground length (475m) is indicated on P&ID (1000000-0104-0033-01). 25% safety factor is only applied to aboveground section, assuming no bend and elevation change for underground piping section.

Appendix 4.

Leak Frequencies

Table A4- 1: Leak Frequencies

No	Node Section	Base Case/ Sensitivity Case 1 Release Frequencies (per year)							Sensitivity 2 (Future Production) Release Frequencies (per year)						
		1 - 3 mm (2 mm)	3 - 10 mm (6 mm)	10 - 50 mm (22 mm)	50 - 150 mm (85 mm)	> 150 mm (Rupture)	Total	% Contribution	1 - 3 mm (2 mm)	3 - 10 mm (6 mm)	10 - 50 mm (22 mm)	50 - 150 mm (85 mm)	> 150 mm (Rupture)	Total	% Contribution
Raw Gas and Maui Gas Lines															
1	KGT01_RGS_01_V	6.06E-03	2.72E-03	1.52E-03	2.82E-04	5.65E-05	1.06E-02	1.19%	6.06E-03	2.72E-03	1.52E-03	2.82E-04	5.65E-05	1.06E-02	1.00%
2	KGT01_RCS_01_L	1.31E-03	6.00E-04	3.07E-04	1.04E-04	2.44E-06	2.32E-03	0.26%	1.31E-03	6.00E-04	3.07E-04	1.04E-04	2.44E-06	2.32E-03	0.22%
3	KGT01_MAU_01_V	4.12E-03	1.83E-03	1.02E-03	1.39E-04	3.51E-05	7.14E-03	0.80%	4.12E-03	1.83E-03	1.02E-03	1.39E-04	3.51E-05	7.14E-03	0.67%
4	KGT01_MAU_02_V	3.54E-03	1.43E-03	6.57E-04	8.28E-05	9.16E-06	5.72E-03	0.64%	3.54E-03	1.43E-03	6.57E-04	8.28E-05	9.16E-06	5.72E-03	0.54%
CO₂ Removal															
5	KGT02_TGS_01_V	3.09E-03	1.42E-03	7.86E-04	1.97E-04	1.46E-05	5.51E-03	0.61%	3.09E-03	1.42E-03	7.86E-04	1.97E-04	1.46E-05	5.51E-03	0.52%
6	KGT03_TGS_04_V	3.03E-03	1.40E-03	7.73E-04	1.87E-04	2.11E-05	5.41E-03	0.60%	3.03E-03	1.40E-03	7.73E-04	1.87E-04	2.11E-05	5.41E-03	0.51%
7	KGT05_RGS_07_V	0.00E+00	0.00E+00	0.00E+00	0.00E+00	0.00E+00	0.00E+00	0.00%	2.50E-03	1.13E-03	6.03E-04	9.17E-05	3.21E-05	4.36E-03	0.41%
8	KGT05_TGS_16_V	0.00E+00	0.00E+00	0.00E+00	0.00E+00	0.00E+00	0.00E+00	0.00%	4.14E-03	1.86E-03	1.04E-03	1.35E-04	4.91E-05	7.23E-03	0.68%
Dehydration and Dewpoint Control															
9	KGT01_TGS_07_V	4.84E-03	2.14E-03	1.17E-03	1.55E-04	3.03E-05	8.34E-03	0.93%	4.84E-03	2.14E-03	1.17E-03	1.55E-04	3.03E-05	8.34E-03	0.79%
10	KGT01_TGS_10_V	3.37E-03	1.65E-03	9.73E-04	1.88E-04	1.03E-04	6.28E-03	0.70%	3.37E-03	1.65E-03	9.73E-04	1.88E-04	1.03E-04	6.28E-03	0.59%
11	KGT01_TGS_12_V	2.19E-03	1.03E-03	5.89E-04	9.96E-05	4.51E-05	3.95E-03	0.44%	2.19E-03	1.03E-03	5.89E-04	9.96E-05	4.51E-05	3.95E-03	0.37%
12	KGT01_PGS_02_V	3.63E-03	1.68E-03	8.67E-04	1.66E-04	5.65E-05	6.40E-03	0.71%	3.63E-03	1.68E-03	8.67E-04	1.66E-04	5.65E-05	6.40E-03	0.60%
13	KGT04_PGS_07_V	1.25E-03	5.44E-04	2.82E-04	4.54E-05	3.86E-06	2.12E-03	0.24%	1.25E-03	5.44E-04	2.82E-04	4.54E-05	3.86E-06	2.12E-03	0.20%
14	KGT01_MPG_01_L	1.32E-03	5.88E-04	3.08E-04	6.92E-05	1.44E-06	2.29E-03	0.25%	1.32E-03	5.88E-04	3.08E-04	6.92E-05	1.44E-06	2.29E-03	0.22%
15	KGT04_MPG_03_L	1.68E-03	7.74E-04	3.88E-04	1.33E-04	4.74E-06	2.98E-03	0.33%	1.68E-03	7.74E-04	3.88E-04	1.33E-04	4.74E-06	2.98E-03	0.28%
16	KGT04_MPG_04_L	1.87E-03	7.41E-04	3.10E-04	7.55E-05	2.13E-06	3.00E-03	0.33%	1.87E-03	7.41E-04	3.10E-04	7.55E-05	2.13E-06	3.00E-03	0.28%
17	KGT04_MPG_05_L	3.13E-03	8.28E-04	2.39E-04	3.09E-05	2.48E-06	4.23E-03	0.47%	3.13E-03	8.28E-04	2.39E-04	3.09E-05	2.48E-06	4.23E-03	0.40%
18	KGT04_MPG_06_L	2.33E-03	1.02E-03	5.32E-04	1.01E-04	3.86E-06	3.99E-03	0.45%	2.33E-03	1.02E-03	5.32E-04	1.01E-04	3.86E-06	3.99E-03	0.38%
19	KGT01_TGS_11_V	0.00E+00	0.00E+00	0.00E+00	0.00E+00	0.00E+00	0.00E+00	0.00%	2.52E-03	1.28E-03	7.71E-04	3.57E-04	1.02E-05	4.94E-03	0.47%
20	KGT01_PGS_03_V	0.00E+00	0.00E+00	0.00E+00	0.00E+00	0.00E+00	0.00E+00	0.00%	3.89E-03	1.75E-03	8.83E-04	2.48E-04	3.17E-06	6.78E-03	0.64%
21	KGT01_MPG_02_L	0.00E+00	0.00E+00	0.00E+00	0.00E+00	0.00E+00	0.00E+00	0.00%	1.01E-03	4.44E-04	2.28E-04	4.47E-05	1.44E-06	1.73E-03	0.16%
Product Gas Lines and Compressors															
22	KGT01_PGS_01_V	5.87E-03	2.59E-03	1.44E-03	1.84E-04	3.56E-05	1.01E-02	1.13%	5.87E-03	2.59E-03	1.44E-03	1.84E-04	3.56E-05	1.01E-02	0.96%
23	KGT01_PGS_13_V	1.83E-03	7.99E-04	3.99E-04	8.55E-05	1.44E-06	3.12E-03	0.35%	1.83E-03	7.99E-04	3.99E-04	8.55E-05	1.44E-06	3.12E-03	0.29%
24	KGT01_PGS_14_V	7.70E-04	3.48E-04	1.90E-04	2.66E-05	1.02E-05	1.34E-03	0.15%	7.70E-04	3.48E-04	1.90E-04	2.66E-05	1.02E-05	1.34E-03	0.13%
25	KGT13_PGS_15_V	3.71E-03	1.68E-03	8.83E-04	2.47E-04	5.23E-05	6.57E-03	0.73%	3.71E-03	1.68E-03	8.83E-04	2.47E-04	5.23E-05	6.57E-03	0.62%
26	KGT13_PGS_16_V	7.35E-03	3.16E-03	1.49E-03	4.24E-04	8.35E-06	1.24E-02	1.39%	7.35E-03	3.16E-03	1.49E-03	4.24E-04	8.35E-06	1.24E-02	1.17%
27	KGT13_PGS_17_V	3.88E-03	1.80E-03	1.01E-03	1.76E-04	6.43E-05	6.93E-03	0.77%	3.88E-03	1.80E-03	1.01E-03	1.76E-04	6.43E-05	6.93E-03	0.65%

No	Node Section	Base Case/ Sensitivity Case 1 Release Frequencies (per year)							Sensitivity 2 (Future Production) Release Frequencies (per year)						
		1 - 3 mm (2 mm)	3 - 10 mm (6 mm)	10 - 50 mm (22 mm)	50 - 150 mm (85 mm)	> 150 mm (Rupture)	Total	% Contribution	1 - 3 mm (2 mm)	3 - 10 mm (6 mm)	10 - 50 mm (22 mm)	50 - 150 mm (85 mm)	> 150 mm (Rupture)	Total	% Contribution
28	KGT01_MGS_01_V	1.38E-02	5.91E-03	2.89E-03	5.52E-04	1.22E-04	2.33E-02	2.60%	1.38E-02	5.91E-03	2.89E-03	5.52E-04	1.22E-04	2.33E-02	2.20%
29	KGT01_MGS_03_V	7.12E-03	3.08E-03	1.47E-03	3.68E-04	2.68E-05	1.21E-02	1.34%	7.12E-03	3.08E-03	1.47E-03	3.68E-04	2.68E-05	1.21E-02	1.14%
30	KGT01_MGS_07_V	5.42E-03	2.31E-03	1.05E-03	3.11E-04	1.11E-05	9.10E-03	1.01%	5.42E-03	2.31E-03	1.05E-03	3.11E-04	1.11E-05	9.10E-03	0.86%
31	KGT11_MGS_05_V	2.16E-03	1.07E-03	6.38E-04	1.48E-04	7.01E-05	4.09E-03	0.46%	2.16E-03	1.07E-03	6.38E-04	1.48E-04	7.01E-05	4.09E-03	0.39%
32	KGT11_MGS_08_V	2.76E-03	1.20E-03	5.70E-04	1.56E-04	0.00E+00	4.68E-03	0.52%	2.76E-03	1.20E-03	5.70E-04	1.56E-04	0.00E+00	4.68E-03	0.44%
33	KGT11_MGS_09_V	8.16E-03	3.57E-03	1.87E-03	2.89E-04	5.86E-05	1.39E-02	1.56%	8.16E-03	3.57E-03	1.87E-03	2.89E-04	5.86E-05	1.39E-02	1.32%
Pigging															
34	KGT01_PIG_01_V	9.52E-07	4.86E-07	2.70E-07	6.52E-08	2.91E-08	1.80E-06	0.00%	9.52E-07	4.86E-07	2.70E-07	6.52E-08	2.91E-08	1.80E-06	0.00%
35	KGT13_PIG_02_V	8.80E-07	4.56E-07	2.53E-07	6.52E-08	2.91E-08	1.68E-06	0.00%	8.80E-07	4.56E-07	2.53E-07	6.52E-08	2.91E-08	1.68E-06	0.00%
36	KGT11_PIG_03_V	8.76E-07	4.53E-07	2.52E-07	6.23E-08	2.91E-08	1.67E-06	0.00%	8.76E-07	4.53E-07	2.52E-07	6.23E-08	2.91E-08	1.67E-06	0.00%
37	KGT11_PIG_04_V	8.76E-07	4.53E-07	2.52E-07	6.23E-08	2.91E-08	1.67E-06	0.00%	8.76E-07	4.53E-07	2.52E-07	6.23E-08	2.91E-08	1.67E-06	0.00%
Utilities and Cogen Unit															
38	KGT01_MPG_21_V	5.40E-03	2.28E-03	1.08E-03	2.10E-04	1.72E-05	8.98E-03	1.00%	5.40E-03	2.28E-03	1.08E-03	2.10E-04	1.72E-05	8.98E-03	0.85%
39	KGT01_MPG_22_L	1.66E-03	6.53E-04	2.58E-04	8.39E-05	0.00E+00	2.65E-03	0.30%	1.66E-03	6.53E-04	2.58E-04	8.39E-05	0.00E+00	2.65E-03	0.25%
40	KGT01_MPG_23_L	1.22E-03	5.37E-04	2.53E-04	8.31E-05	0.00E+00	2.10E-03	0.23%	1.22E-03	5.37E-04	2.53E-04	8.31E-05	0.00E+00	2.10E-03	0.20%
41	KGT01_FGA_01_V	5.24E-03	2.41E-03	1.34E-03	3.48E-04	1.44E-05	9.35E-03	1.04%	5.24E-03	2.41E-03	1.34E-03	3.48E-04	1.44E-05	9.35E-03	0.88%
42	KGT01_FGA_02_V	1.51E-02	6.35E-03	3.12E-03	4.50E-04	3.52E-05	2.50E-02	2.79%	1.51E-02	6.35E-03	3.12E-03	4.50E-04	3.52E-05	2.50E-02	2.36%
43	KGT01_PGS_19_V	7.50E-03	2.91E-03	1.15E-03	2.79E-04	3.46E-07	1.18E-02	1.32%	7.50E-03	2.91E-03	1.15E-03	2.79E-04	3.46E-07	1.18E-02	1.12%
44	KGT01_PGS_21_V	1.21E-02	4.59E-03	1.73E-03	4.04E-04	2.98E-06	1.88E-02	2.10%	1.21E-02	4.59E-03	1.73E-03	4.04E-04	2.98E-06	1.88E-02	1.77%
45	KGT01_PGS_22_V	0.00E+00	0.00E+00	0.00E+00	0.00E+00	0.00E+00	0.00E+00	0.00%	4.86E-03	2.11E-03	1.05E-03	1.77E-04	2.45E-05	8.23E-03	0.78%
LPG Production Facility - Stabiliser, De-C2															
46	KGT01_MPG_07_L	1.83E-03	8.53E-04	4.70E-04	1.57E-04	4.63E-06	3.32E-03	0.37%	1.83E-03	8.53E-04	4.70E-04	1.57E-04	4.63E-06	3.32E-03	0.31%
47	KGT01_DET_01_V	2.51E-03	1.16E-03	6.33E-04	2.10E-04	4.55E-06	4.52E-03	0.50%	2.51E-03	1.16E-03	6.33E-04	2.10E-04	4.55E-06	4.52E-03	0.43%
48	KGT01_PGS_04_V	1.94E-03	8.86E-04	4.73E-04	1.27E-04	1.75E-06	3.43E-03	0.38%	1.94E-03	8.86E-04	4.73E-04	1.27E-04	1.75E-06	3.43E-03	0.32%
49	KGT01_PGS_05_V	1.04E-02	4.62E-03	2.15E-03	7.04E-04	8.73E-06	1.79E-02	2.00%	1.04E-02	4.62E-03	2.15E-03	7.04E-04	8.73E-06	1.79E-02	1.69%
50	KGT01_DEX_01_L	5.37E-03	1.75E-03	6.47E-04	1.45E-04	1.44E-06	7.91E-03	0.88%	5.37E-03	1.75E-03	6.47E-04	1.45E-04	1.44E-06	7.91E-03	0.75%
51	KGT01_DEB_01_L	2.93E-03	1.32E-03	6.85E-04	1.63E-04	3.51E-06	5.10E-03	0.57%	2.93E-03	1.32E-03	6.85E-04	1.63E-04	3.51E-06	5.10E-03	0.48%
52	KGT01_MPG_09_L	2.56E-03	1.13E-03	6.19E-04	8.89E-05	9.72E-06	4.41E-03	0.49%	2.56E-03	1.13E-03	6.19E-04	8.89E-05	9.72E-06	4.41E-03	0.42%
53	KGT01_MPG_10_V	1.34E-03	5.95E-04	3.06E-04	7.36E-05	1.44E-06	2.31E-03	0.26%	1.34E-03	5.95E-04	3.06E-04	7.36E-05	1.44E-06	2.31E-03	0.22%
54	KGT01_MPG_13_L	0.00E+00	0.00E+00	0.00E+00	0.00E+00	0.00E+00	0.00E+00	0.00%	8.47E-04	3.63E-04	1.80E-04	3.18E-05	2.07E-06	1.42E-03	0.13%
55	KGT01_STT_01_V	0.00E+00	0.00E+00	0.00E+00	0.00E+00	0.00E+00	0.00E+00	0.00%	3.49E-03	1.51E-03	8.04E-04	1.07E-04	3.86E-06	5.91E-03	0.56%
56	KGT01_PGS_10_V	0.00E+00	0.00E+00	0.00E+00	0.00E+00	0.00E+00	0.00E+00	0.00%	3.46E-03	1.52E-03	7.82E-04	1.57E-04	1.11E-05	5.94E-03	0.56%

No	Node Section	Base Case/ Sensitivity Case 1 Release Frequencies (per year)							Sensitivity 2 (Future Production) Release Frequencies (per year)						
		1 - 3 mm (2 mm)	3 - 10 mm (6 mm)	10 - 50 mm (22 mm)	50 - 150 mm (85 mm)	> 150 mm (Rupture)	Total	% Contribution	1 - 3 mm (2 mm)	3 - 10 mm (6 mm)	10 - 50 mm (22 mm)	50 - 150 mm (85 mm)	> 150 mm (Rupture)	Total	% Contribution
57	KGT01_PGS_11_V	0.00E+00	0.00E+00	0.00E+00	0.00E+00	0.00E+00	0.00E+00	0.00%	9.26E-03	4.12E-03	1.89E-03	6.85E-04	4.20E-06	1.60E-02	1.51%
58	KGT01_STB_01_L	0.00E+00	0.00E+00	0.00E+00	0.00E+00	0.00E+00	0.00E+00	0.00%	3.99E-03	1.75E-03	9.17E-04	1.58E-04	1.44E-06	6.82E-03	0.64%
LPG Production Facility - De-C3															
59	KGT01_DPT_11_V	3.06E-03	1.27E-03	6.12E-04	1.26E-04	6.62E-06	5.08E-03	0.57%	3.06E-03	1.27E-03	6.12E-04	1.26E-04	6.62E-06	5.08E-03	0.48%
60	KGT01_DPX_11_L	4.59E-03	1.47E-03	5.91E-04	8.80E-05	3.86E-06	6.75E-03	0.75%	4.59E-03	1.47E-03	5.91E-04	8.80E-05	3.86E-06	6.75E-03	0.64%
61	KGT01_PC3_02_L	2.98E-03	1.34E-03	6.74E-04	1.84E-04	1.73E-06	5.17E-03	0.58%	2.98E-03	1.34E-03	6.74E-04	1.84E-04	1.73E-06	5.17E-03	0.49%
62	KGT01_DPB_11_L	4.09E-03	1.84E-03	9.47E-04	2.36E-04	6.76E-06	7.12E-03	0.79%	4.09E-03	1.84E-03	9.47E-04	2.36E-04	6.76E-06	7.12E-03	0.67%
63	KGT01_DPT_01_V	0.00E+00	0.00E+00	0.00E+00	0.00E+00	0.00E+00	0.00E+00	0.00%	5.26E-03	2.19E-03	1.11E-03	1.31E-04	6.62E-06	8.70E-03	0.82%
64	KGT01_DPX_01_L	0.00E+00	0.00E+00	0.00E+00	0.00E+00	0.00E+00	0.00E+00	0.00%	4.76E-03	1.54E-03	6.22E-04	8.62E-05	3.17E-06	7.01E-03	0.66%
65	KGT01_PC3_01_L	0.00E+00	0.00E+00	0.00E+00	0.00E+00	0.00E+00	0.00E+00	0.00%	2.42E-03	1.09E-03	5.45E-04	1.69E-04	0.00E+00	4.22E-03	0.40%
66	KGT01_DPB_01_L	0.00E+00	0.00E+00	0.00E+00	0.00E+00	0.00E+00	0.00E+00	0.00%	4.18E-03	1.86E-03	9.57E-04	2.07E-04	4.22E-06	7.21E-03	0.68%
LPG Production Facility - De-C4															
67	KGT01_DBT_11_V	3.56E-03	1.52E-03	7.58E-04	1.83E-04	7.83E-06	6.03E-03	0.67%	3.56E-03	1.52E-03	7.58E-04	1.83E-04	7.83E-06	6.03E-03	0.57%
68	KGT01_DBX_11_L	7.28E-03	2.56E-03	1.07E-03	1.93E-04	2.13E-06	1.11E-02	1.24%	7.28E-03	2.56E-03	1.07E-03	1.93E-04	2.13E-06	1.11E-02	1.05%
69	KGT01_NGL_01_L	4.11E-03	1.82E-03	9.36E-04	1.98E-04	4.03E-06	7.06E-03	0.79%	4.11E-03	1.82E-03	9.36E-04	1.98E-04	4.03E-06	7.06E-03	0.67%
70	KGT01_NGL_02_L	5.96E-03	2.45E-03	1.11E-03	2.48E-04	2.21E-06	9.77E-03	1.09%	5.96E-03	2.45E-03	1.11E-03	2.48E-04	2.21E-06	9.77E-03	0.92%
71	KGT01_DBT_01_V	0.00E+00	0.00E+00	0.00E+00	0.00E+00	0.00E+00	0.00E+00	0.00%	3.88E-03	1.62E-03	8.01E-04	1.32E-04	4.90E-06	6.44E-03	0.61%
72	KGT01_DBX_01_L	0.00E+00	0.00E+00	0.00E+00	0.00E+00	0.00E+00	0.00E+00	0.00%	5.21E-03	1.74E-03	7.23E-04	1.12E-04	2.13E-06	7.78E-03	0.73%
73	KGT01_DBB_01_L	0.00E+00	0.00E+00	0.00E+00	0.00E+00	0.00E+00	0.00E+00	0.00%	2.61E-03	1.17E-03	6.03E-04	1.53E-04	1.44E-06	4.54E-03	0.43%
74	KGT01_PC4_12_L	0.00E+00	0.00E+00	0.00E+00	0.00E+00	0.00E+00	0.00E+00	0.00%	2.48E-03	1.12E-03	5.66E-04	2.02E-04	3.94E-06	4.37E-03	0.41%
75	KGT01_PC3_13_L	0.00E+00	0.00E+00	0.00E+00	0.00E+00	0.00E+00	0.00E+00	0.00%	1.47E-03	6.34E-04	2.96E-04	7.85E-05	0.00E+00	2.48E-03	0.23%
76	KGT01_LPG_04_L	0.00E+00	0.00E+00	0.00E+00	0.00E+00	0.00E+00	0.00E+00	0.00%	3.01E-03	1.30E-03	6.52E-04	1.29E-04	0.00E+00	5.10E-03	0.48%
LPG Production Facility - Product Export and Loadout															
77	KGT32_NGL_05_L	6.83E-04	2.98E-04	1.42E-04	4.45E-05	0.00E+00	1.17E-03	0.13%	6.83E-04	2.98E-04	1.42E-04	4.45E-05	0.00E+00	1.17E-03	0.11%
78	KGT33_NGL_06_L	1.49E-03	6.41E-04	3.22E-04	5.40E-05	1.68E-06	2.51E-03	0.28%	1.49E-03	6.41E-04	3.22E-04	5.40E-05	1.68E-06	2.51E-03	0.24%
79	KGT34_NGL_07_L	0.00E+00	1.00E-04	5.00E-06	0.00E+00	5.00E-06	1.10E-04	0.01%	0.00E+00	1.00E-04	5.00E-06	0.00E+00	5.00E-06	1.10E-04	0.01%
80	KGT35_NGL_09_L	4.77E-03	1.46E-03	4.84E-04	9.03E-05	5.59E-06	6.81E-03	0.76%	4.77E-03	1.46E-03	4.84E-04	9.03E-05	5.59E-06	6.81E-03	0.64%
81	KGT36_NGL_10_L	1.24E-03	5.63E-04	2.96E-04	7.35E-05	4.20E-06	2.18E-03	0.24%	1.24E-03	5.63E-04	2.96E-04	7.35E-05	4.20E-06	2.18E-03	0.21%
82	KGT36_NGL_11_L	0.00E+00	5.72E-02	0.00E+00	0.00E+00	5.72E-03	6.29E-02	7.02%	0.00E+00	8.00E-02	0.00E+00	0.00E+00	8.00E-03	8.80E-02	8.30%
82A	KGT36_NGL_12_L	0.00E+00	0.00E+00	0.00E+00	8.16E-08	8.16E-08	1.63E-07	0.00%	0.00E+00	0.00E+00	0.00E+00	1.14E-07	1.14E-07	2.28E-07	0.00%
83	KGT37_PC3_05_L	1.07E-03	4.68E-04	2.26E-04	5.09E-05	7.00E-06	1.82E-03	0.20%	1.07E-03	4.68E-04	2.26E-04	5.09E-05	7.00E-06	1.82E-03	0.17%
84	KGT39_PC3_07_V	0.00E+00	5.00E-06	2.50E-07	0.00E+00	2.50E-07	5.50E-06	0.00%	0.00E+00	5.00E-06	2.50E-07	0.00E+00	2.50E-07	5.50E-06	0.00%

No	Node Section	Base Case/ Sensitivity Case 1 Release Frequencies (per year)							Sensitivity 2 (Future Production) Release Frequencies (per year)						
		1 - 3 mm (2 mm)	3 - 10 mm (6 mm)	10 - 50 mm (22 mm)	50 - 150 mm (85 mm)	> 150 mm (Rupture)	Total	% Contribution	1 - 3 mm (2 mm)	3 - 10 mm (6 mm)	10 - 50 mm (22 mm)	50 - 150 mm (85 mm)	> 150 mm (Rupture)	Total	% Contribution
85	KGT39_PC3_08_L	0.00E+00	5.00E-06	2.50E-07	0.00E+00	2.50E-07	5.50E-06	0.00%	0.00E+00	5.00E-06	2.50E-07	0.00E+00	2.50E-07	5.50E-06	0.00%
86	KGT40_PC3_09_V	0.00E+00	5.00E-06	2.50E-07	0.00E+00	2.50E-07	5.50E-06	0.00%	0.00E+00	5.00E-06	2.50E-07	0.00E+00	2.50E-07	5.50E-06	0.00%
87	KGT40_PC3_10_L	0.00E+00	5.00E-06	2.50E-07	0.00E+00	2.50E-07	5.50E-06	0.00%	0.00E+00	5.00E-06	2.50E-07	0.00E+00	2.50E-07	5.50E-06	0.00%
88	KGT41_PC4_04_L	1.33E-03	5.78E-04	2.70E-04	7.22E-05	5.33E-06	2.25E-03	0.25%	1.33E-03	5.78E-04	2.70E-04	7.22E-05	5.33E-06	2.25E-03	0.21%
89	KGT43_PC4_06_V	0.00E+00	5.00E-06	2.50E-07	0.00E+00	2.50E-07	5.50E-06	0.00%	0.00E+00	5.00E-06	2.50E-07	0.00E+00	2.50E-07	5.50E-06	0.00%
90	KGT43_PC4_07_L	0.00E+00	5.00E-06	2.50E-07	0.00E+00	2.50E-07	5.50E-06	0.00%	0.00E+00	5.00E-06	2.50E-07	0.00E+00	2.50E-07	5.50E-06	0.00%
91	KGT44_PC4_08_V	0.00E+00	5.00E-06	2.50E-07	0.00E+00	2.50E-07	5.50E-06	0.00%	0.00E+00	5.00E-06	2.50E-07	0.00E+00	2.50E-07	5.50E-06	0.00%
92	KGT44_PC4_09_L	0.00E+00	5.00E-06	2.50E-07	0.00E+00	2.50E-07	5.50E-06	0.00%	0.00E+00	5.00E-06	2.50E-07	0.00E+00	2.50E-07	5.50E-06	0.00%
93	KGT45_PC3_12_L	6.16E-03	2.08E-03	7.99E-04	1.52E-04	2.13E-05	9.22E-03	1.03%	6.16E-03	2.08E-03	7.99E-04	1.52E-04	2.13E-05	9.22E-03	0.87%
94	KGT46_PC4_11_L	5.54E-03	1.80E-03	6.51E-04	1.16E-04	1.75E-05	8.13E-03	0.91%	5.54E-03	1.80E-03	6.51E-04	1.16E-04	1.75E-05	8.13E-03	0.77%
95	KGT47_LPG_01_L	9.71E-04	4.15E-04	2.06E-04	3.29E-05	2.48E-06	1.63E-03	0.18%	9.71E-04	4.15E-04	2.06E-04	3.29E-05	2.48E-06	1.63E-03	0.15%
96	KGT47_LPG_02_L	0.00E+00	8.71E-04	0.00E+00	0.00E+00	8.71E-05	9.58E-04	0.11%	0.00E+00	1.79E-03	0.00E+00	0.00E+00	1.79E-04	1.97E-03	0.19%
96A	KGT47_LPG_03_L	0.00E+00	0.00E+00	0.00E+00	1.66E-07	1.66E-07	3.32E-07	0.00%	0.00E+00	0.00E+00	0.00E+00	3.41E-07	3.41E-07	6.82E-07	0.00%
97	KGT47_LPG_05_L	0.00E+00	6.24E-04	0.00E+00	0.00E+00	6.24E-05	6.86E-04	0.08%	0.00E+00	1.20E-03	0.00E+00	0.00E+00	1.20E-04	1.32E-03	0.12%
97A	KGT47_LPG_06_L	0.00E+00	0.00E+00	0.00E+00	8.90E-10	8.90E-10	1.78E-09	0.00%	0.00E+00	0.00E+00	0.00E+00	1.71E-09	1.71E-09	3.42E-09	0.00%
Propane Refrigeration System															
98	KGT70_REF_01_V	9.37E-04	4.14E-04	2.08E-04	4.63E-05	3.17E-06	1.61E-03	0.18%	9.37E-04	4.14E-04	2.08E-04	4.63E-05	3.17E-06	1.61E-03	0.15%
99	KGT70_REF_02_L	9.71E-04	4.28E-04	2.21E-04	4.47E-05	2.48E-06	1.67E-03	0.19%	9.71E-04	4.28E-04	2.21E-04	4.47E-05	2.48E-06	1.67E-03	0.16%
100	KGT70_REF_03_V	3.80E-03	1.50E-03	6.23E-04	1.33E-04	6.26E-06	6.05E-03	0.68%	3.80E-03	1.50E-03	6.23E-04	1.33E-04	6.26E-06	6.05E-03	0.57%
101	KGT70_REF_04_L	2.12E-03	9.36E-04	4.65E-04	1.06E-04	9.60E-06	3.63E-03	0.41%	2.12E-03	9.36E-04	4.65E-04	1.06E-04	9.60E-06	3.63E-03	0.34%
102	KGT70_REF_05_L	1.70E-03	7.66E-04	3.87E-04	1.05E-04	1.44E-06	2.96E-03	0.33%	1.70E-03	7.66E-04	3.87E-04	1.05E-04	1.44E-06	2.96E-03	0.28%
103	KGT70_REF_07_L	1.34E-03	6.17E-04	3.05E-04	1.05E-04	1.79E-06	2.37E-03	0.26%	1.34E-03	6.17E-04	3.05E-04	1.05E-04	1.79E-06	2.37E-03	0.22%
104	KGT70_REF_11_V	4.91E-03	1.99E-03	9.02E-04	1.49E-04	3.14E-05	7.98E-03	0.89%	4.91E-03	1.99E-03	9.02E-04	1.49E-04	3.14E-05	7.98E-03	0.75%
105	KGT70_REF_14_V	1.80E-02	8.15E-03	3.84E-03	8.13E-04	2.48E-04	3.10E-02	3.46%	1.80E-02	8.15E-03	3.84E-03	8.13E-04	2.48E-04	3.10E-02	2.93%
106	KGT70_REF_15_L	4.01E-03	1.52E-03	6.46E-04	1.03E-04	1.10E-05	6.28E-03	0.70%	4.01E-03	1.52E-03	6.46E-04	1.03E-04	1.10E-05	6.28E-03	0.59%
107	KGT70_REF_06_L	0.00E+00	0.00E+00	0.00E+00	0.00E+00	0.00E+00	0.00E+00	0.00%	2.13E-03	9.46E-04	4.61E-04	1.23E-04	7.18E-06	3.67E-03	0.35%
Mercaptans and Methanol															
108	KGT50 EMC_01_L	5.77E-03	1.95E-03	7.39E-04	2.37E-04	0.00E+00	8.70E-03	0.97%	5.77E-03	1.95E-03	7.39E-04	2.37E-04	0.00E+00	8.70E-03	0.82%
109	KGT50 EMC_02_L	1.20E-04	2.88E-05	0.00E+00	0.00E+00	4.00E-06	1.53E-04	0.02%	1.20E-04	2.88E-05	0.00E+00	0.00E+00	4.00E-06	1.53E-04	0.01%
110	KGT51 BMC_05_L	1.00E-06	2.40E-07	0.00E+00	0.00E+00	2.00E-06	3.24E-06	0.00%	1.00E-06	2.40E-07	0.00E+00	0.00E+00	2.00E-06	3.24E-06	0.00%
111	KGT52 BMC_01_L	0.00E+00	1.00E-05	5.00E-07	0.00E+00	5.00E-07	1.10E-05	0.00%	0.00E+00	1.00E-05	5.00E-07	0.00E+00	5.00E-07	1.10E-05	0.00%
112	KGT52 BMC_02_L	4.42E-03	1.97E-03	1.01E-03	5.79E-04	0.00E+00	7.98E-03	0.89%	4.42E-03	1.97E-03	1.01E-03	5.79E-04	0.00E+00	7.98E-03	0.75%

No	Node Section	Base Case/ Sensitivity Case 1 Release Frequencies (per year)							Sensitivity 2 (Future Production) Release Frequencies (per year)						
		1 - 3 mm (2 mm)	3 - 10 mm (6 mm)	10 - 50 mm (22 mm)	50 - 150 mm (85 mm)	> 150 mm (Rupture)	Total	% Contribution	1 - 3 mm (2 mm)	3 - 10 mm (6 mm)	10 - 50 mm (22 mm)	50 - 150 mm (85 mm)	> 150 mm (Rupture)	Total	% Contribution
113	KGT52_BMC_03_L	0.00E+00	2.66E-05	0.00E+00	0.00E+00	2.66E-06	2.93E-05	0.00%	0.00E+00	2.66E-05	0.00E+00	0.00E+00	2.66E-06	2.93E-05	0.00%
113A	KGT52_BMC_04_L	0.00E+00	0.00E+00	0.00E+00	3.80E-11	7.60E-10	7.98E-10	0.00%	0.00E+00	0.00E+00	0.00E+00	3.80E-11	7.60E-10	7.98E-10	0.00%
114	KGT55_MOH_01_L	0.00E+00	4.00E-05	2.00E-06	0.00E+00	2.00E-06	4.40E-05	0.00%	0.00E+00	4.00E-05	2.00E-06	0.00E+00	2.00E-06	4.40E-05	0.00%
115	KGT55_MOH_02_L	9.19E-03	4.12E-03	2.10E-03	1.23E-03	0.00E+00	1.66E-02	1.86%	9.19E-03	4.12E-03	2.10E-03	1.23E-03	0.00E+00	1.66E-02	1.57%
116	KGT55_MOH_03_L	0.00E+00	8.40E-03	0.00E+00	0.00E+00	8.40E-04	9.24E-03	1.03%	0.00E+00	1.20E-02	0.00E+00	0.00E+00	1.20E-03	1.32E-02	1.25%
116A	KGT55_MOH_04_L	0.00E+00	0.00E+00	0.00E+00	1.20E-08	2.40E-07	2.52E-07	0.00%	0.00E+00	0.00E+00	0.00E+00	1.71E-08	3.42E-07	3.59E-07	0.00%
CO2 Recovery - Ammonia															
117	KGT80_AMM_01_V	8.30E-03	3.77E-03	1.75E-03	3.93E-04	1.18E-04	1.43E-02	1.60%	8.30E-03	3.77E-03	1.75E-03	3.93E-04	1.18E-04	1.43E-02	1.35%
118	KGT80_AMM_11_V	8.46E-03	3.82E-03	1.77E-03	3.88E-04	1.18E-04	1.46E-02	1.62%	8.46E-03	3.82E-03	1.77E-03	3.88E-04	1.18E-04	1.46E-02	1.37%
119	KGT80_AMM_02_V	1.43E-03	6.42E-04	3.24E-04	9.75E-05	0.00E+00	2.49E-03	0.28%	1.43E-03	6.42E-04	3.24E-04	9.75E-05	0.00E+00	2.49E-03	0.24%
120	KGT80_AMM_03_L	1.21E-02	4.42E-03	1.58E-03	4.18E-04	1.44E-06	1.85E-02	2.06%	1.21E-02	4.42E-03	1.58E-03	4.18E-04	1.44E-06	1.85E-02	1.75%
121	KGT80_AMM_04_L	1.83E-02	6.86E-03	2.55E-03	6.83E-04	2.02E-06	2.84E-02	3.17%	1.83E-02	6.86E-03	2.55E-03	6.83E-04	2.02E-06	2.84E-02	2.68%
122	KGT80_AMM_07_L	2.48E-03	1.12E-03	5.45E-04	1.87E-04	0.00E+00	4.32E-03	0.48%	2.48E-03	1.12E-03	5.45E-04	1.87E-04	0.00E+00	4.32E-03	0.41%
123	KGT80_AMM_08_V	3.27E-03	1.40E-03	6.46E-04	1.89E-04	5.75E-06	5.51E-03	0.61%	3.27E-03	1.40E-03	6.46E-04	1.89E-04	5.75E-06	5.51E-03	0.52%
124	KGT80_AMM_09_V	1.64E-02	6.07E-03	2.23E-03	5.41E-04	4.61E-06	2.52E-02	2.81%	1.64E-02	6.07E-03	2.23E-03	5.41E-04	4.61E-06	2.52E-02	2.38%
CO2 Recovery - CO2															
125	KGT90_CO2_01_V	9.50E-03	4.37E-03	2.09E-03	5.57E-04	1.17E-04	1.66E-02	1.86%	9.50E-03	4.37E-03	2.09E-03	5.57E-04	1.17E-04	1.66E-02	1.57%
126	KGT90_CO2_02_V	9.52E-03	4.38E-03	2.10E-03	5.63E-04	1.17E-04	1.67E-02	1.86%	9.52E-03	4.38E-03	2.10E-03	5.63E-04	1.17E-04	1.67E-02	1.57%
127	KGT90_CO2_03_V	3.37E-03	1.60E-03	8.57E-04	3.36E-04	5.05E-06	6.17E-03	0.69%	3.37E-03	1.60E-03	8.57E-04	3.36E-04	5.05E-06	6.17E-03	0.58%
128	KGT90_CO2_07_V	4.78E-03	2.05E-03	9.86E-04	2.35E-04	1.37E-05	8.06E-03	0.90%	4.78E-03	2.05E-03	9.86E-04	2.35E-04	1.37E-05	8.06E-03	0.76%
129	KGT90_CO2_08_L	8.75E-03	3.25E-03	1.37E-03	3.95E-04	9.24E-06	1.38E-02	1.54%	8.75E-03	3.25E-03	1.37E-03	3.95E-04	9.24E-06	1.38E-02	1.30%
130	KGT90_CO2_16_V	2.50E-02	1.02E-02	4.48E-03	8.92E-04	1.99E-04	4.08E-02	4.55%	2.50E-02	1.02E-02	4.48E-03	8.92E-04	1.99E-04	4.08E-02	3.85%
131	KGT90_CO2_18_V	1.63E-03	7.45E-04	3.80E-04	1.36E-04	0.00E+00	2.89E-03	0.32%	1.63E-03	7.45E-04	3.80E-04	1.36E-04	0.00E+00	2.89E-03	0.27%
132	KGT90_CO2_19_V	6.14E-03	2.55E-03	1.23E-03	2.56E-04	1.79E-06	1.02E-02	1.13%	6.14E-03	2.55E-03	1.23E-03	2.56E-04	1.79E-06	1.02E-02	0.96%
133	KGT90_CO2_23_V	0.00E+00	0.00E+00	0.00E+00	0.00E+00	0.00E+00	0.00E+00	0.00%	8.01E-04	3.82E-04	2.04E-04	4.31E-05	1.78E-05	1.45E-03	0.14%
134	KGT90_CO2_09_L	0.00E+00	1.00E-05	5.00E-07	0.00E+00	5.00E-07	1.10E-05	0.00%	0.00E+00	1.00E-05	5.00E-07	0.00E+00	5.00E-07	1.10E-05	0.00%
135	KGT90_CO2_10_L	0.00E+00	1.00E-05	5.00E-07	0.00E+00	5.00E-07	1.10E-05	0.00%	0.00E+00	1.00E-05	5.00E-07	0.00E+00	5.00E-07	1.10E-05	0.00%
136	KGT90_CO2_11_L	0.00E+00	1.00E-05	5.00E-07	0.00E+00	5.00E-07	1.10E-05	0.00%	0.00E+00	1.00E-05	5.00E-07	0.00E+00	5.00E-07	1.10E-05	0.00%
137	KGT90_CO2_12_L	0.00E+00	1.00E-05	5.00E-07	0.00E+00	5.00E-07	1.10E-05	0.00%	0.00E+00	1.00E-05	5.00E-07	0.00E+00	5.00E-07	1.10E-05	0.00%
138	KGT90_CO2_24_L	6.53E-03	2.19E-03	7.77E-04	1.78E-04	1.13E-05	9.69E-03	1.08%	6.53E-03	2.19E-03	7.77E-04	1.78E-04	1.13E-05	9.69E-03	0.91%
139	KGT90_CO2_25_L	2.85E-03	1.35E-03	7.40E-04	5.17E-04	0.00E+00	5.45E-03	0.61%	2.85E-03	1.35E-03	7.40E-04	5.17E-04	0.00E+00	5.45E-03	0.51%
140	KGT90_CO2_26_V	8.01E-04	3.57E-04	1.74E-04	6.00E-05	0.00E+00	1.39E-03	0.16%	8.01E-04	3.57E-04	1.74E-04	6.00E-05	0.00E+00	1.39E-03	0.13%

No	Node Section	Base Case/ Sensitivity Case 1 Release Frequencies (per year)							Sensitivity 2 (Future Production) Release Frequencies (per year)						
		1 - 3 mm (2 mm)	3 - 10 mm (6 mm)	10 - 50 mm (22 mm)	50 - 150 mm (85 mm)	> 150 mm (Rupture)	Total	% Contribution	1 - 3 mm (2 mm)	3 - 10 mm (6 mm)	10 - 50 mm (22 mm)	50 - 150 mm (85 mm)	> 150 mm (Rupture)	Total	% Contribution
141	KGT90_CO2_27_V	8.77E-04	3.78E-04	1.72E-04	5.31E-05	0.00E+00	1.48E-03	0.17%	8.77E-04	3.78E-04	1.72E-04	5.31E-05	0.00E+00	1.48E-03	0.14%
142	KGT90_CO2_28_L	0.00E+00	6.00E-03	0.00E+00	0.00E+00	6.00E-04	6.60E-03	0.74%	0.00E+00	6.00E-03	0.00E+00	0.00E+00	6.00E-04	6.60E-03	0.62%
143	KGT90_CO2_29_V	0.00E+00	2.40E-02	0.00E+00	0.00E+00	2.40E-03	2.64E-02	2.94%	0.00E+00	2.40E-02	0.00E+00	0.00E+00	2.40E-03	2.64E-02	2.49%
144	KGT90_CO2_30_L	0.00E+00	2.40E-02	0.00E+00	0.00E+00	2.40E-03	2.64E-02	2.94%	0.00E+00	2.40E-02	0.00E+00	0.00E+00	2.40E-03	2.64E-02	2.49%
145	KGT90_CO2_31_V	0.00E+00	4.60E-03	0.00E+00	0.00E+00	4.60E-04	5.06E-03	0.56%	0.00E+00	4.60E-03	0.00E+00	0.00E+00	4.60E-04	5.06E-03	0.48%
146	KGT90_CO2_32_L	0.00E+00	4.60E-03	0.00E+00	0.00E+00	4.60E-04	5.06E-03	0.56%	0.00E+00	4.60E-03	0.00E+00	0.00E+00	4.60E-04	5.06E-03	0.48%
147	KGT90_CO2_33_L	0.00E+00	0.00E+00	0.00E+00	8.56E-09	8.56E-09	1.71E-08	0.00%	0.00E+00	0.00E+00	0.00E+00	8.56E-09	8.56E-09	1.71E-08	0.00%
148	KGT90_CO2_34_L	0.00E+00	0.00E+00	0.00E+00	3.42E-08	3.42E-08	6.84E-08	0.00%	0.00E+00	0.00E+00	0.00E+00	3.42E-08	3.42E-08	6.84E-08	0.00%
149	KGT90_CO2_35_L	0.00E+00	0.00E+00	0.00E+00	6.56E-09	6.56E-09	1.31E-08	0.00%	0.00E+00	0.00E+00	0.00E+00	6.56E-09	6.56E-09	1.31E-08	0.00%
Total		4.53E-01	3.19E-01	8.79E-02	2.14E-02	1.51E-02	8.97E-01	100%	5.31E-01	3.80E-01	1.05E-01	2.52E-02	1.81E-02	1.06E+00	100%
% Contribution		50.5%	35.6%	9.8%	2.4%	1.7%	100%		50.2%	35.9%	9.9%	2.4%	1.7%	100%	

Appendix 5.

Ignited Event and Toxic Event Frequencies

Table A5- 1: Ignited and Toxic Event Frequencies

Line No.	Release Scenario	Release Rate (kg/s)	Explosion Probability	Base Case/ Sensitivity Case 1			Sensitivity 2 (Future Operation)		
				Immediate Ignition Event Frequency	Delayed Ignition Event Frequency	Unignited Event Frequency ^{Note 1}	Immediate Ignition Event Frequency	Delayed Ignition Event Frequency	Unignited Event Frequency ^{Note 1}
1	KGT01_RGS_01_V_2mm	0.03	0.04	1.82E-06	4.24E-06	6.05E-03	1.82E-06	4.24E-06	6.05E-03
2	KGT01_RGS_01_V_6mm	0.2	0.04	1.21E-06	2.83E-06	2.72E-03	1.21E-06	2.83E-06	2.72E-03
3	KGT01_RGS_01_V_22mm	3.1	0.12	3.56E-06	8.32E-06	1.51E-03	3.56E-06	8.32E-06	1.51E-03
4	KGT01_RGS_01_V_85mm	47	0.12	9.88E-06	2.30E-05	2.49E-04	9.88E-06	2.30E-05	2.49E-04
5	KGT01_RGS_01_V_274mm	485	0.3	1.10E-05	2.57E-05	1.98E-05	1.10E-05	2.57E-05	1.98E-05
6	KGT01_RCS_01_L_2mm	0.1	0.04	4.70E-07	1.10E-06	1.31E-03	4.70E-07	1.10E-06	1.31E-03
7	KGT01_RCS_01_L_6mm	1.1	0.12	5.04E-07	1.18E-06	5.99E-04	5.04E-07	1.18E-06	5.99E-04
8	KGT01_RCS_01_L_22mm	15	0.12	2.29E-06	5.34E-06	2.99E-04	2.29E-06	5.34E-06	2.99E-04
9	KGT01_RCS_01_L_71mm	160	0.3	4.14E-06	9.66E-06	9.23E-05	4.14E-06	9.66E-06	9.23E-05
10	KGT01_MAU_01_V_2mm	0.02	0.04	1.24E-06	2.88E-06	4.11E-03	1.24E-06	2.88E-06	4.11E-03
11	KGT01_MAU_01_V_6mm	0.2	0.04	7.98E-07	1.86E-06	1.83E-03	7.98E-07	1.86E-06	1.83E-03
12	KGT01_MAU_01_V_22mm	2.9	0.12	2.25E-06	5.24E-06	1.01E-03	2.25E-06	5.24E-06	1.01E-03
13	KGT01_MAU_01_V_85mm	44	0.12	4.57E-06	1.07E-05	1.23E-04	4.57E-06	1.07E-05	1.23E-04
14	KGT01_MAU_01_V_274mm	456	0.3	6.85E-06	1.60E-05	1.23E-05	6.85E-06	1.60E-05	1.23E-05
15	KGT01_MAU_02_V_2mm	0.02	0.04	1.06E-06	2.48E-06	3.54E-03	1.06E-06	2.48E-06	3.54E-03
16	KGT01_MAU_02_V_6mm	0.2	0.04	6.24E-07	1.46E-06	1.43E-03	6.24E-07	1.46E-06	1.43E-03
17	KGT01_MAU_02_V_22mm	2.9	0.12	1.45E-06	3.38E-06	6.52E-04	1.45E-06	3.38E-06	6.52E-04
18	KGT01_MAU_02_V_71mm	31	0.12	2.11E-06	4.93E-06	8.49E-05	2.11E-06	4.93E-06	8.49E-05
19	KGT02_TGS_01_V_2mm	0.02	0.04	9.28E-07	2.17E-06	3.09E-03	9.28E-07	2.17E-06	3.09E-03
20	KGT02_TGS_01_V_6mm	0.2	0.04	6.00E-07	1.40E-06	1.42E-03	6.00E-07	1.40E-06	1.42E-03
21	KGT02_TGS_01_V_22mm	2.7	0.12	1.58E-06	3.68E-06	7.80E-04	1.58E-06	3.68E-06	7.80E-04
22	KGT02_TGS_01_V_85mm	40	0.12	5.90E-06	1.38E-05	1.77E-04	5.90E-06	1.38E-05	1.77E-04
23	KGT02_TGS_01_V_212mm	249	0.3	2.73E-06	6.36E-06	5.52E-06	2.73E-06	6.36E-06	5.52E-06
24	KGT03_TGS_04_V_2mm	0.02	0.04	9.09E-07	2.12E-06	3.03E-03	9.09E-07	2.12E-06	3.03E-03
25	KGT03_TGS_04_V_6mm	0.2	0.04	5.90E-07	1.38E-06	1.40E-03	5.90E-07	1.38E-06	1.40E-03
26	KGT03_TGS_04_V_22mm	2.7	0.12	1.55E-06	3.63E-06	7.68E-04	1.55E-06	3.63E-06	7.68E-04
27	KGT03_TGS_04_V_85mm	40	0.12	5.60E-06	1.31E-05	1.68E-04	5.60E-06	1.31E-05	1.68E-04
28	KGT03_TGS_04_V_194mm	208	0.3	3.29E-06	7.68E-06	1.01E-05	3.29E-06	7.68E-06	1.01E-05
29	KGT05_RGS_07_V_2mm	0.03	0.04	0.00E+00	0.00E+00	0.00E+00	7.51E-07	1.75E-06	2.50E-03
30	KGT05_RGS_07_V_6mm	0.2	0.04	0.00E+00	0.00E+00	0.00E+00	5.04E-07	1.18E-06	1.13E-03
31	KGT05_RGS_07_V_22mm	3.1	0.12	0.00E+00	0.00E+00	0.00E+00	1.41E-06	3.30E-06	5.98E-04
32	KGT05_RGS_07_V_85mm	47	0.12	0.00E+00	0.00E+00	0.00E+00	3.21E-06	7.49E-06	8.10E-05
33	KGT05_RGS_07_V_212mm	290	0.3	0.00E+00	0.00E+00	0.00E+00	6.26E-06	1.46E-05	1.12E-05
34	KGT05_TGS_16_V_2mm	0.02	0.04	0.00E+00	0.00E+00	0.00E+00	1.24E-06	2.90E-06	4.14E-03
35	KGT05_TGS_16_V_6mm	0.2	0.04	0.00E+00	0.00E+00	0.00E+00	7.87E-07	1.84E-06	1.86E-03
36	KGT05_TGS_16_V_22mm	2.7	0.12	0.00E+00	0.00E+00	0.00E+00	2.09E-06	4.87E-06	1.03E-03
37	KGT05_TGS_16_V_85mm	40	0.12	0.00E+00	0.00E+00	0.00E+00	4.04E-06	9.43E-06	1.21E-04
38	KGT05_TGS_16_V_212mm	249	0.3	0.00E+00	0.00E+00	0.00E+00	9.16E-06	2.14E-05	1.85E-05
39	KGT01_TGS_07_V_2mm	0.02	0.04	1.45E-06	3.39E-06	4.83E-03	1.45E-06	3.39E-06	4.83E-03
40	KGT01_TGS_07_V_6mm	0.2	0.04	9.03E-07	2.11E-06	2.14E-03	9.03E-07	2.11E-06	2.14E-03
41	KGT01_TGS_07_V_22mm	2.7	0.12	2.36E-06	5.51E-06	1.17E-03	2.36E-06	5.51E-06	1.17E-03
42	KGT01_TGS_07_V_85mm	40	0.12	4.64E-06	1.08E-05	1.39E-04	4.64E-06	1.08E-05	1.39E-04
43	KGT01_TGS_07_V_212mm	249	0.3	5.66E-06	1.32E-05	1.15E-05	5.66E-06	1.32E-05	1.15E-05
44	KGT01_TGS_10_V_2mm	0.02	0.04	1.01E-06	2.36E-06	3.37E-03	1.01E-06	2.36E-06	3.37E-03
45	KGT01_TGS_10_V_6mm	0.2	0.04	6.95E-07	1.62E-06	1.65E-03	6.95E-07	1.62E-06	1.65E-03
46	KGT01_TGS_10_V_22mm	2.7	0.12	1.95E-06	4.56E-06	9.66E-04	1.95E-06	4.56E-06	9.66E-04
47	KGT01_TGS_10_V_85mm	40	0.12	5.63E-06	1.31E-05	1.69E-04	5.63E-06	1.31E-05	1.69E-04
48	KGT01_TGS_10_V_212mm	249	0.3	1.93E-05	4.50E-05	3.91E-05	1.93E-05	4.50E-05	3.91E-05
49	KGT01_TGS_12_V_2mm	0.02	0.04	6.57E-07	1.53E-06	2.19E-03	6.57E-07	1.53E-06	2.19E-03

Line No.	Release Scenario	Release Rate (kg/s)	Explosion Probability	Base Case/ Sensitivity Case 1			Sensitivity 2 (Future Operation)		
				Immediate Ignition Event Frequency	Delayed Ignition Event Frequency	Unignited Event Frequency ^{Note 1}	Immediate Ignition Event Frequency	Delayed Ignition Event Frequency	Unignited Event Frequency ^{Note 1}
50	KGT01_TGS_12_V_6mm	0.2	0.04	4.35E-07	1.02E-06	1.03E-03	4.35E-07	1.02E-06	1.03E-03
51	KGT01_TGS_12_V_22mm	2.7	0.12	1.18E-06	2.76E-06	5.85E-04	1.18E-06	2.76E-06	5.85E-04
52	KGT01_TGS_12_V_85mm	40	0.12	2.99E-06	6.97E-06	8.96E-05	2.99E-06	6.97E-06	8.96E-05
53	KGT01_TGS_12_V_173mm	166	0.3	5.60E-06	1.31E-05	2.64E-05	5.60E-06	1.31E-05	2.64E-05
54	KGT01_PGS_02_V_2mm	0.02	0.04	1.09E-06	2.54E-06	3.63E-03	1.09E-06	2.54E-06	3.63E-03
55	KGT01_PGS_02_V_6mm	0.2	0.04	7.03E-07	1.64E-06	1.68E-03	7.03E-07	1.64E-06	1.68E-03
56	KGT01_PGS_02_V_22mm	2.6	0.12	1.71E-06	3.98E-06	8.62E-04	1.71E-06	3.98E-06	8.62E-04
57	KGT01_PGS_02_V_85mm	39	0.12	4.88E-06	1.14E-05	1.50E-04	4.88E-06	1.14E-05	1.50E-04
58	KGT01_PGS_02_V_173mm	162	0.3	6.87E-06	1.60E-05	3.36E-05	6.87E-06	1.60E-05	3.36E-05
59	KGT04_PGS_07_V_2mm	0.02	0.04	3.74E-07	8.73E-07	1.25E-03	3.74E-07	8.73E-07	1.25E-03
60	KGT04_PGS_07_V_6mm	0.2	0.04	2.28E-07	5.32E-07	5.44E-04	2.28E-07	5.32E-07	5.44E-04
61	KGT04_PGS_07_V_22mm	2.6	0.12	5.54E-07	1.29E-06	2.80E-04	5.54E-07	1.29E-06	2.80E-04
62	KGT04_PGS_07_V_63mm	22	0.12	7.95E-07	1.85E-06	4.66E-05	7.95E-07	1.85E-06	4.66E-05
63	KGT01_MPG_01_L_2mm	0.1	0.04	4.25E-07	9.92E-07	1.32E-03	4.25E-07	9.92E-07	1.32E-03
64	KGT01_MPG_01_L_6mm	0.8	0.04	4.15E-07	9.68E-07	5.87E-04	4.15E-07	9.68E-07	5.87E-04
65	KGT01_MPG_01_L_22mm	11	0.12	1.78E-06	4.15E-06	3.02E-04	1.78E-06	4.15E-06	3.02E-04
66	KGT01_MPG_01_L_63mm	93	0.3	2.39E-06	5.58E-06	6.27E-05	2.39E-06	5.58E-06	6.27E-05
67	KGT04_MPG_03_L_2mm	0.1	0.04	5.41E-07	1.26E-06	1.68E-03	5.41E-07	1.26E-06	1.68E-03
68	KGT04_MPG_03_L_6mm	0.8	0.04	5.46E-07	1.27E-06	7.72E-04	5.46E-07	1.27E-06	7.72E-04
69	KGT04_MPG_03_L_22mm	11	0.12	2.24E-06	5.23E-06	3.80E-04	2.24E-06	5.23E-06	3.80E-04
70	KGT04_MPG_03_L_71mm	118	0.3	5.39E-06	1.26E-05	1.20E-04	5.39E-06	1.26E-05	1.20E-04
71	KGT04_MPG_04_L_2mm	0.1	0.04	6.03E-07	1.41E-06	1.87E-03	6.03E-07	1.41E-06	1.87E-03
72	KGT04_MPG_04_L_6mm	0.8	0.04	5.23E-07	1.22E-06	7.39E-04	5.23E-07	1.22E-06	7.39E-04
73	KGT04_MPG_04_L_22mm	11	0.12	1.79E-06	4.18E-06	3.04E-04	1.79E-06	4.18E-06	3.04E-04
74	KGT04_MPG_04_L_85mm	169	0.3	2.95E-06	6.87E-06	6.57E-05	2.95E-06	6.87E-06	6.57E-05
75	KGT04_MPG_04_L_150mm	527	0.3	8.31E-08	1.94E-07	1.85E-06	8.31E-08	1.94E-07	1.85E-06
76	KGT04_MPG_05_L_2mm	0.1	0.04	1.01E-06	2.36E-06	3.13E-03	1.01E-06	2.36E-06	3.13E-03
77	KGT04_MPG_05_L_6mm	0.8	0.04	5.84E-07	1.36E-06	8.26E-04	5.84E-07	1.36E-06	8.26E-04
78	KGT04_MPG_05_L_22mm	4.3	0.12	6.11E-07	1.43E-06	2.37E-04	6.11E-07	1.43E-06	2.37E-04
79	KGT04_MPG_05_L_71mm	4.3	0.12	8.54E-08	1.99E-07	3.31E-05	8.54E-08	1.99E-07	3.31E-05
80	KGT04_MPG_06_L_2mm	0.1	0.04	7.52E-07	1.75E-06	2.33E-03	7.52E-07	1.75E-06	2.33E-03
81	KGT04_MPG_06_L_6mm	0.8	0.04	7.23E-07	1.69E-06	1.02E-03	7.23E-07	1.69E-06	1.02E-03
82	KGT04_MPG_06_L_22mm	11	0.12	3.07E-06	7.16E-06	5.22E-04	3.07E-06	7.16E-06	5.22E-04
83	KGT04_MPG_06_L_71mm	118	0.3	4.08E-06	9.52E-06	9.10E-05	4.08E-06	9.52E-06	9.10E-05
84	KGT01_TGS_11_V_2mm	0.02	0.04	0.00E+00	0.00E+00	0.00E+00	7.56E-07	1.76E-06	2.52E-03
85	KGT01_TGS_11_V_6mm	0.2	0.04	0.00E+00	0.00E+00	0.00E+00	5.42E-07	1.27E-06	1.28E-03
86	KGT01_TGS_11_V_22mm	2.7	0.12	0.00E+00	0.00E+00	0.00E+00	1.55E-06	3.62E-06	7.66E-04
87	KGT01_TGS_11_V_85mm	40	0.12	0.00E+00	0.00E+00	0.00E+00	1.07E-05	2.50E-05	3.21E-04
88	KGT01_TGS_11_V_173mm	166	0.3	0.00E+00	0.00E+00	0.00E+00	1.27E-06	2.95E-06	5.97E-06
89	KGT01_PGS_03_V_2mm	0.02	0.04	0.00E+00	0.00E+00	0.00E+00	1.17E-06	2.72E-06	3.88E-03
90	KGT01_PGS_03_V_6mm	0.2	0.04	0.00E+00	0.00E+00	0.00E+00	7.35E-07	1.71E-06	1.75E-03
91	KGT01_PGS_03_V_22mm	2.6	0.12	0.00E+00	0.00E+00	0.00E+00	1.74E-06	4.05E-06	8.77E-04
92	KGT01_PGS_03_V_85mm	39	0.12	0.00E+00	0.00E+00	0.00E+00	7.27E-06	1.70E-05	2.23E-04
93	KGT01_PGS_03_V_150mm	122	0.3	0.00E+00	0.00E+00	0.00E+00	2.90E-07	6.76E-07	2.20E-06
94	KGT01_MPG_02_L_2mm	0.1	0.04	0.00E+00	0.00E+00	0.00E+00	3.27E-07	7.62E-07	1.01E-03
95	KGT01_MPG_02_L_6mm	0.8	0.04	0.00E+00	0.00E+00	0.00E+00	3.13E-07	7.31E-07	4.43E-04
96	KGT01_MPG_02_L_22mm	11	0.12	0.00E+00	0.00E+00	0.00E+00	1.31E-06	3.07E-06	2.23E-04
97	KGT01_MPG_02_L_71mm	118	0.3	0.00E+00	0.00E+00	0.00E+00	1.80E-06	4.20E-06	4.01E-05
98	KGT01_PGS_01_V_2mm	0.02	0.04	1.76E-06	4.11E-06	5.87E-03	1.76E-06	4.11E-06	5.87E-03
99	KGT01_PGS_01_V_6mm	0.2	0.04	1.08E-06	2.52E-06	2.58E-03	1.08E-06	2.52E-06	2.58E-03

Line No.	Release Scenario	Release Rate (kg/s)	Explosion Probability	Base Case/ Sensitivity Case 1			Sensitivity 2 (Future Operation)		
				Immediate Ignition Event Frequency	Delayed Ignition Event Frequency	Unignited Event Frequency ^{Note 1}	Immediate Ignition Event Frequency	Delayed Ignition Event Frequency	Unignited Event Frequency ^{Note 1}
100	KGT01_PGS_01_V_22mm	2.6	0.12	2.81E-06	6.56E-06	1.43E-03	2.81E-06	6.56E-06	1.43E-03
101	KGT01_PGS_01_V_85mm	39	0.12	5.36E-06	1.25E-05	1.66E-04	5.36E-06	1.25E-05	1.66E-04
102	KGT01_PGS_01_V_245mm	323	0.3	6.95E-06	1.62E-05	1.25E-05	6.95E-06	1.62E-05	1.25E-05
103	KGT01_PGS_13_V_2mm	0.02	0.04	5.50E-07	1.28E-06	1.83E-03	5.50E-07	1.28E-06	1.83E-03
104	KGT01_PGS_13_V_6mm	0.2	0.04	3.33E-07	7.78E-07	7.97E-04	3.33E-07	7.78E-07	7.97E-04
105	KGT01_PGS_13_V_22mm	2.6	0.12	7.78E-07	1.81E-06	3.96E-04	7.78E-07	1.81E-06	3.96E-04
106	KGT01_PGS_13_V_71mm	27	0.12	1.77E-06	4.12E-06	8.11E-05	1.77E-06	4.12E-06	8.11E-05
107	KGT01_PGS_14_V_2mm	0.02	0.04	2.31E-07	5.39E-07	7.69E-04	2.31E-07	5.39E-07	7.69E-04
108	KGT01_PGS_14_V_6mm	0.2	0.04	1.45E-07	3.39E-07	3.48E-04	1.45E-07	3.39E-07	3.48E-04
109	KGT01_PGS_14_V_22mm	2.6	0.12	3.70E-07	8.64E-07	1.88E-04	3.70E-07	8.64E-07	1.88E-04
110	KGT01_PGS_14_V_85mm	39	0.12	7.74E-07	1.80E-06	2.40E-05	7.74E-07	1.80E-06	2.40E-05
111	KGT01_PGS_14_V_173mm	161	0.3	1.23E-06	2.88E-06	6.12E-06	1.23E-06	2.88E-06	6.12E-06
112	KGT13_PGS_15_V_2mm	0.02	0.04	1.11E-06	2.59E-06	3.70E-03	1.11E-06	2.59E-06	3.70E-03
113	KGT13_PGS_15_V_6mm	0.2	0.04	7.03E-07	1.64E-06	1.68E-03	7.03E-07	1.64E-06	1.68E-03
114	KGT13_PGS_15_V_22mm	2.6	0.12	1.72E-06	4.02E-06	8.77E-04	1.72E-06	4.02E-06	8.77E-04
115	KGT13_PGS_15_V_85mm	39	0.12	7.18E-06	1.68E-05	2.23E-04	7.18E-06	1.68E-05	2.23E-04
116	KGT13_PGS_15_V_274mm	404	0.3	1.02E-05	2.38E-05	1.83E-05	1.02E-05	2.38E-05	1.83E-05
117	KGT13_PGS_16_V_2mm	0.02	0.04	2.20E-06	5.14E-06	7.34E-03	2.20E-06	5.14E-06	7.34E-03
118	KGT13_PGS_16_V_6mm	0.2	0.04	1.32E-06	3.08E-06	3.16E-03	1.32E-06	3.08E-06	3.16E-03
119	KGT13_PGS_16_V_22mm	2.6	0.12	2.90E-06	6.77E-06	1.48E-03	2.90E-06	6.77E-06	1.48E-03
120	KGT13_PGS_16_V_85mm	39	0.12	1.23E-05	2.88E-05	3.83E-04	1.23E-05	2.88E-05	3.83E-04
121	KGT13_PGS_16_V_150mm	121	0.3	7.58E-07	1.77E-06	5.83E-06	7.58E-07	1.77E-06	5.83E-06
122	KGT13_PGS_17_V_2mm	0.02	0.04	1.16E-06	2.72E-06	3.88E-03	1.16E-06	2.72E-06	3.88E-03
123	KGT13_PGS_17_V_6mm	0.2	0.04	7.51E-07	1.75E-06	1.79E-03	7.51E-07	1.75E-06	1.79E-03
124	KGT13_PGS_17_V_22mm	2.6	0.12	1.97E-06	4.60E-06	1.00E-03	1.97E-06	4.60E-06	1.00E-03
125	KGT13_PGS_17_V_85mm	39	0.12	5.12E-06	1.19E-05	1.59E-04	5.12E-06	1.19E-05	1.59E-04
126	KGT13_PGS_17_V_274mm	404	0.3	1.25E-05	2.93E-05	2.25E-05	1.25E-05	2.93E-05	2.25E-05
127	KGT01_MGS_01_V_2mm	0.02	0.04	4.14E-06	9.66E-06	1.38E-02	4.14E-06	9.66E-06	1.38E-02
128	KGT01_MGS_01_V_6mm	0.2	0.04	2.47E-06	5.76E-06	5.90E-03	2.47E-06	5.76E-06	5.90E-03
129	KGT01_MGS_01_V_22mm	2.6	0.12	5.63E-06	1.31E-05	2.87E-03	5.63E-06	1.31E-05	2.87E-03
130	KGT01_MGS_01_V_85mm	39	0.12	1.61E-05	3.75E-05	4.98E-04	1.61E-05	3.75E-05	4.98E-04
131	KGT01_MGS_01_V_245mm	323	0.3	2.38E-05	5.56E-05	4.28E-05	2.38E-05	5.56E-05	4.28E-05
132	KGT01_MGS_03_V_2mm	0.04	0.04	2.13E-06	4.98E-06	7.11E-03	2.13E-06	4.98E-06	7.11E-03
133	KGT01_MGS_03_V_6mm	0.3	0.04	1.55E-06	3.62E-06	3.07E-03	1.55E-06	3.62E-06	3.07E-03
134	KGT01_MGS_03_V_22mm	4.4	0.12	4.84E-06	1.13E-05	1.45E-03	4.84E-06	1.13E-05	1.45E-03
135	KGT01_MGS_03_V_85mm	66	0.3	1.81E-05	4.23E-05	3.08E-04	1.81E-05	4.23E-05	3.08E-04
136	KGT01_MGS_03_V_173mm	272	0.3	5.22E-06	1.22E-05	9.37E-06	5.22E-06	1.22E-05	9.37E-06
137	KGT01_MGS_07_V_2mm	0.04	0.04	1.63E-06	3.79E-06	5.41E-03	1.63E-06	3.79E-06	5.41E-03
138	KGT01_MGS_07_V_6mm	0.3	0.04	1.16E-06	2.71E-06	2.31E-03	1.16E-06	2.71E-06	2.31E-03
139	KGT01_MGS_07_V_22mm	4.4	0.12	3.46E-06	8.07E-06	1.04E-03	3.46E-06	8.07E-06	1.04E-03
140	KGT01_MGS_07_V_85mm	66	0.3	1.53E-05	3.56E-05	2.60E-04	1.53E-05	3.56E-05	2.60E-04
141	KGT01_MGS_07_V_173mm	272	0.3	2.17E-06	5.07E-06	3.90E-06	2.17E-06	5.07E-06	3.90E-06
142	KGT11_MGS_05_V_2mm	0.04	0.04	6.49E-07	1.52E-06	2.16E-03	6.49E-07	1.52E-06	2.16E-03
143	KGT11_MGS_05_V_6mm	0.3	0.04	5.41E-07	1.26E-06	1.07E-03	5.41E-07	1.26E-06	1.07E-03
144	KGT11_MGS_05_V_22mm	4.4	0.12	2.10E-06	4.90E-06	6.31E-04	2.10E-06	4.90E-06	6.31E-04
145	KGT11_MGS_05_V_85mm	66	0.3	7.26E-06	1.69E-05	1.23E-04	7.26E-06	1.69E-05	1.23E-04
146	KGT11_MGS_05_V_229mm	476	0.3	1.37E-05	3.19E-05	2.45E-05	1.37E-05	3.19E-05	2.45E-05
147	KGT11_MGS_08_V_2mm	0.04	0.04	8.28E-07	1.93E-06	2.76E-03	8.28E-07	1.93E-06	2.76E-03
148	KGT11_MGS_08_V_6mm	0.3	0.04	6.03E-07	1.41E-06	1.20E-03	6.03E-07	1.41E-06	1.20E-03
149	KGT11_MGS_08_V_22mm	4.4	0.12	1.88E-06	4.39E-06	5.64E-04	1.88E-06	4.39E-06	5.64E-04

Line No.	Release Scenario	Release Rate (kg/s)	Explosion Probability	Base Case/ Sensitivity Case 1			Sensitivity 2 (Future Operation)		
				Immediate Ignition Event Frequency	Delayed Ignition Event Frequency	Unignited Event Frequency ^{Note 1}	Immediate Ignition Event Frequency	Delayed Ignition Event Frequency	Unignited Event Frequency ^{Note 1}
150	KGT11_MGS_08_V_50mm	23	0.12	2.65E-06	6.18E-06	1.47E-04	2.65E-06	6.18E-06	1.47E-04
151	KGT11_MGS_09_V_2mm	0.04	0.04	2.45E-06	5.71E-06	8.15E-03	2.45E-06	5.71E-06	8.15E-03
152	KGT11_MGS_09_V_6mm	0.3	0.04	1.80E-06	4.19E-06	3.57E-03	1.80E-06	4.19E-06	3.57E-03
153	KGT11_MGS_09_V_22mm	4.4	0.12	6.17E-06	1.44E-05	1.85E-03	6.17E-06	1.44E-05	1.85E-03
154	KGT11_MGS_09_V_85mm	66	0.3	1.42E-05	3.32E-05	2.41E-04	1.42E-05	3.32E-05	2.41E-04
155	KGT11_MGS_09_V_229mm	476	0.3	1.14E-05	2.67E-05	2.05E-05	1.14E-05	2.67E-05	2.05E-05
156	KGT01_PIG_01_V_2mm	0.02	0.04	2.86E-10	6.67E-10	9.51E-07	2.86E-10	6.67E-10	9.51E-07
157	KGT01_PIG_01_V_6mm	0.2	0.04	2.12E-10	4.95E-10	4.85E-07	2.12E-10	4.95E-10	4.85E-07
158	KGT01_PIG_01_V_22mm	2.9	0.12	5.95E-10	1.39E-09	2.68E-07	5.95E-10	1.39E-09	2.68E-07
159	KGT01_PIG_01_V_85mm	44	0.12	2.15E-09	5.01E-09	5.80E-08	2.15E-09	5.01E-09	5.80E-08
160	KGT01_PIG_01_V_274mm	456	0.3	5.68E-09	1.32E-08	1.02E-08	5.68E-09	1.32E-08	1.02E-08
161	KGT13_PIG_02_V_2mm	0.02	0.04	2.64E-10	6.16E-10	8.79E-07	2.64E-10	6.16E-10	8.79E-07
162	KGT13_PIG_02_V_6mm	0.2	0.04	1.90E-10	4.44E-10	4.55E-07	1.90E-10	4.44E-10	4.55E-07
163	KGT13_PIG_02_V_22mm	2.6	0.12	4.94E-10	1.15E-09	2.51E-07	4.94E-10	1.15E-09	2.51E-07
164	KGT13_PIG_02_V_85mm	39	0.12	1.90E-09	4.43E-09	5.89E-08	1.90E-09	4.43E-09	5.89E-08
165	KGT13_PIG_02_V_274mm	404	0.3	5.68E-09	1.32E-08	1.02E-08	5.68E-09	1.32E-08	1.02E-08
166	KGT11_PIG_03_V_2mm	0.04	0.04	2.63E-10	6.13E-10	8.75E-07	2.63E-10	6.13E-10	8.75E-07
167	KGT11_PIG_03_V_6mm	0.3	0.04	2.28E-10	5.32E-10	4.52E-07	2.28E-10	5.32E-10	4.52E-07
168	KGT11_PIG_03_V_22mm	4.4	0.12	8.30E-10	1.94E-09	2.49E-07	8.30E-10	1.94E-09	2.49E-07
169	KGT11_PIG_03_V_85mm	66	0.3	3.06E-09	7.15E-09	5.20E-08	3.06E-09	7.15E-09	5.20E-08
170	KGT11_PIG_03_V_173mm	272	0.3	5.68E-09	1.32E-08	1.02E-08	5.68E-09	1.32E-08	1.02E-08
171	KGT11_PIG_04_V_2mm	0.04	0.04	2.63E-10	6.13E-10	8.75E-07	2.63E-10	6.13E-10	8.75E-07
172	KGT11_PIG_04_V_6mm	0.3	0.04	2.28E-10	5.32E-10	4.52E-07	2.28E-10	5.32E-10	4.52E-07
173	KGT11_PIG_04_V_22mm	4.4	0.12	8.30E-10	1.94E-09	2.49E-07	8.30E-10	1.94E-09	2.49E-07
174	KGT11_PIG_04_V_85mm	66	0.3	3.06E-09	7.15E-09	5.20E-08	3.06E-09	7.15E-09	5.20E-08
175	KGT11_PIG_04_V_173mm	272	0.3	5.68E-09	1.32E-08	1.02E-08	5.68E-09	1.32E-08	1.02E-08
176	KGT01_MPG_21_V_2mm	0.003	0.04	1.62E-06	3.78E-06	5.39E-03	1.62E-06	3.78E-06	5.39E-03
177	KGT01_MPG_21_V_6mm	0.03	0.04	6.83E-07	1.59E-06	2.27E-03	6.83E-07	1.59E-06	2.27E-03
178	KGT01_MPG_21_V_22mm	0.4	0.04	5.96E-07	1.39E-06	1.08E-03	5.96E-07	1.39E-06	1.08E-03
179	KGT01_MPG_21_V_71mm	4.4	0.12	7.45E-07	1.74E-06	2.25E-04	7.45E-07	1.74E-06	2.25E-04
180	KGT01_MPG_22_L_2mm	0.04	0.04	4.97E-07	1.16E-06	1.65E-03	4.97E-07	1.16E-06	1.65E-03
181	KGT01_MPG_22_L_6mm	0.4	0.04	3.46E-07	8.08E-07	6.52E-04	3.46E-07	8.08E-07	6.52E-04
182	KGT01_MPG_22_L_22mm	5.1	0.12	7.59E-07	1.77E-06	2.55E-04	7.59E-07	1.77E-06	2.55E-04
183	KGT01_MPG_22_L_50mm	26	0.12	9.81E-07	2.29E-06	8.06E-05	9.81E-07	2.29E-06	8.06E-05
184	KGT01_MPG_23_L_2mm	0.1	0.04	4.40E-07	1.03E-06	1.22E-03	4.40E-07	1.03E-06	1.22E-03
185	KGT01_MPG_23_L_6mm	1.1	0.12	4.51E-07	1.05E-06	5.35E-04	4.51E-07	1.05E-06	5.35E-04
186	KGT01_MPG_23_L_22mm	15	0.12	1.89E-06	4.40E-06	2.47E-04	1.89E-06	4.40E-06	2.47E-04
187	KGT01_MPG_23_L_50mm	79	0.3	2.46E-06	5.75E-06	7.48E-05	2.46E-06	5.75E-06	7.48E-05
188	KGT01_FGA_01_V_2mm	0.02	0.04	1.57E-06	3.67E-06	5.24E-03	1.57E-06	3.67E-06	5.24E-03
189	KGT01_FGA_01_V_6mm	0.2	0.04	1.00E-06	2.34E-06	2.40E-03	1.00E-06	2.34E-06	2.40E-03
190	KGT01_FGA_01_V_22mm	2.6	0.12	2.61E-06	6.10E-06	1.33E-03	2.61E-06	6.10E-06	1.33E-03
191	KGT01_FGA_01_V_85mm	39	0.12	1.01E-05	2.36E-05	3.14E-04	1.01E-05	2.36E-05	3.14E-04
192	KGT01_FGA_01_V_150mm	121	0.3	1.30E-06	3.04E-06	1.00E-05	1.30E-06	3.04E-06	1.00E-05
193	KGT01_FGA_02_V_2mm	0.02	0.04	4.53E-06	1.06E-05	1.51E-02	4.53E-06	1.06E-05	1.51E-02
194	KGT01_FGA_02_V_6mm	0.2	0.04	2.65E-06	6.19E-06	6.35E-03	2.65E-06	6.19E-06	6.35E-03
195	KGT01_FGA_02_V_22mm	2.6	0.12	6.09E-06	1.42E-05	3.10E-03	6.09E-06	1.42E-05	3.10E-03
196	KGT01_FGA_02_V_85mm	39	0.12	1.31E-05	3.06E-05	4.06E-04	1.31E-05	3.06E-05	4.06E-04
197	KGT01_FGA_02_V_150mm	121	0.3	3.19E-06	7.45E-06	2.46E-05	3.19E-06	7.45E-06	2.46E-05
198	KGT01_PGS_19_V_2mm	0.02	0.04	2.25E-06	5.25E-06	7.49E-03	2.25E-06	5.25E-06	7.49E-03
199	KGT01_PGS_19_V_6mm	0.2	0.04	1.22E-06	2.84E-06	2.91E-03	1.22E-06	2.84E-06	2.91E-03

Line No.	Release Scenario	Release Rate (kg/s)	Explosion Probability	Base Case/ Sensitivity Case 1			Sensitivity 2 (Future Operation)		
				Immediate Ignition Event Frequency	Delayed Ignition Event Frequency	Unignited Event Frequency ^{Note 1}	Immediate Ignition Event Frequency	Delayed Ignition Event Frequency	Unignited Event Frequency ^{Note 1}
200	KGT01_PGS_19_V_22mm	2.6	0.12	2.24E-06	5.23E-06	1.14E-03	2.24E-06	5.23E-06	1.14E-03
201	KGT01_PGS_19_V_50mm	13	0.12	2.81E-06	6.56E-06	2.69E-04	2.81E-06	6.56E-06	2.69E-04
202	KGT01_PGS_21_V_2mm	0.02	0.04	3.62E-06	8.45E-06	1.21E-02	3.62E-06	8.45E-06	1.21E-02
203	KGT01_PGS_21_V_6mm	0.2	0.04	1.91E-06	4.47E-06	4.58E-03	1.91E-06	4.47E-06	4.58E-03
204	KGT01_PGS_21_V_22mm	2.6	0.12	3.38E-06	7.89E-06	1.72E-03	3.38E-06	7.89E-06	1.72E-03
205	KGT01_PGS_21_V_71mm	27	0.12	8.27E-06	1.93E-05	3.79E-04	8.27E-06	1.93E-05	3.79E-04
206	KGT01_PGS_22_V_2mm	0.02	0.04	0.00E+00	0.00E+00	0.00E+00	1.46E-06	3.41E-06	4.86E-03
207	KGT01_PGS_22_V_6mm	0.2	0.04	0.00E+00	0.00E+00	0.00E+00	8.81E-07	2.06E-06	2.11E-03
208	KGT01_PGS_22_V_22mm	2.6	0.12	0.00E+00	0.00E+00	0.00E+00	2.05E-06	4.79E-06	1.04E-03
209	KGT01_PGS_22_V_85mm	39	0.12	0.00E+00	0.00E+00	0.00E+00	5.15E-06	1.20E-05	1.60E-04
210	KGT01_PGS_22_V_150mm	121	0.3	0.00E+00	0.00E+00	0.00E+00	2.22E-06	5.19E-06	1.71E-05
211	KGT01_MPG_07_L_2mm	0.1	0.04	5.60E-07	1.31E-06	1.83E-03	5.60E-07	1.31E-06	1.83E-03
212	KGT01_MPG_07_L_6mm	0.7	0.04	5.71E-07	1.33E-06	8.52E-04	5.71E-07	1.33E-06	8.52E-04
213	KGT01_MPG_07_L_22mm	10	0.12	2.39E-06	5.57E-06	4.62E-04	2.39E-06	5.57E-06	4.62E-04
214	KGT01_MPG_07_L_71mm	101	0.3	5.89E-06	1.37E-05	1.42E-04	5.89E-06	1.37E-05	1.42E-04
215	KGT01_DET_01_V_2mm	0.02	0.04	7.52E-07	1.75E-06	2.50E-03	7.52E-07	1.75E-06	2.50E-03
216	KGT01_DET_01_V_6mm	0.1	0.04	4.36E-07	1.02E-06	1.16E-03	4.36E-07	1.02E-06	1.16E-03
217	KGT01_DET_01_V_22mm	1.9	0.12	9.09E-07	2.12E-06	6.30E-04	9.09E-07	2.12E-06	6.30E-04
218	KGT01_DET_01_V_71mm	20	0.12	3.20E-06	7.48E-06	2.04E-04	3.20E-06	7.48E-06	2.04E-04
219	KGT01_PGS_04_V_2mm	0.02	0.04	5.82E-07	1.36E-06	1.94E-03	5.82E-07	1.36E-06	1.94E-03
220	KGT01_PGS_04_V_6mm	0.1	0.04	3.32E-07	7.74E-07	8.85E-04	3.32E-07	7.74E-07	8.85E-04
221	KGT01_PGS_04_V_22mm	1.9	0.12	6.78E-07	1.58E-06	4.70E-04	6.78E-07	1.58E-06	4.70E-04
222	KGT01_PGS_04_V_63mm	16	0.12	1.51E-06	3.53E-06	1.24E-04	1.51E-06	3.53E-06	1.24E-04
223	KGT01_PGS_05_V_2mm	0.02	0.04	3.12E-06	7.29E-06	1.04E-02	3.12E-06	7.29E-06	1.04E-02
224	KGT01_PGS_05_V_6mm	0.1	0.04	1.73E-06	4.03E-06	4.61E-03	1.73E-06	4.03E-06	4.61E-03
225	KGT01_PGS_05_V_22mm	1.9	0.12	3.09E-06	7.21E-06	2.14E-03	3.09E-06	7.21E-06	2.14E-03
226	KGT01_PGS_05_V_85mm	29	0.12	1.51E-05	3.52E-05	6.54E-04	1.51E-05	3.52E-05	6.54E-04
227	KGT01_PGS_05_V_173mm	118	0.3	7.74E-07	1.81E-06	6.14E-06	7.74E-07	1.81E-06	6.14E-06
228	KGT01_DEX_01_L_2mm	0.1	0.04	1.74E-06	4.07E-06	5.37E-03	1.74E-06	4.07E-06	5.37E-03
229	KGT01_DEX_01_L_6mm	0.9	0.04	1.24E-06	2.90E-06	1.74E-03	1.24E-06	2.90E-06	1.74E-03
230	KGT01_DEX_01_L_22mm	0.9	0.04	4.62E-07	1.08E-06	6.45E-04	4.62E-07	1.08E-06	6.45E-04
231	KGT01_DEX_01_L_63mm	0.9	0.04	1.05E-07	2.44E-07	1.46E-04	1.05E-07	2.44E-07	1.46E-04
232	KGT01_DEB_01_L_2mm	0.1	0.04	9.52E-07	2.22E-06	2.93E-03	9.52E-07	2.22E-06	2.93E-03
233	KGT01_DEB_01_L_6mm	0.9	0.04	9.36E-07	2.18E-06	1.31E-03	9.36E-07	2.18E-06	1.31E-03
234	KGT01_DEB_01_L_22mm	12	0.12	4.02E-06	9.38E-06	6.72E-04	4.02E-06	9.38E-06	6.72E-04
235	KGT01_DEB_01_L_85mm	172	0.3	6.37E-06	1.49E-05	1.42E-04	6.37E-06	1.49E-05	1.42E-04
236	KGT01_DEB_01_L_150mm	537	0.3	1.37E-07	3.20E-07	3.06E-06	1.37E-07	3.20E-07	3.06E-06
237	KGT01_MPG_09_L_2mm	0.1	0.04	8.30E-07	1.94E-06	2.55E-03	8.30E-07	1.94E-06	2.55E-03
238	KGT01_MPG_09_L_6mm	0.9	0.04	8.05E-07	1.88E-06	1.13E-03	8.05E-07	1.88E-06	1.13E-03
239	KGT01_MPG_09_L_22mm	12	0.12	3.63E-06	8.47E-06	6.07E-04	3.63E-06	8.47E-06	6.07E-04
240	KGT01_MPG_09_L_85mm	172	0.3	3.47E-06	8.09E-06	7.73E-05	3.47E-06	8.09E-06	7.73E-05
241	KGT01_MPG_09_L_150mm	537	0.3	3.79E-07	8.84E-07	8.45E-06	3.79E-07	8.84E-07	8.45E-06
242	KGT01_MPG_10_V_2mm	0.03	0.04	4.01E-07	9.35E-07	1.33E-03	4.01E-07	9.35E-07	1.33E-03
243	KGT01_MPG_10_V_6mm	0.2	0.04	2.71E-07	6.32E-07	5.94E-04	2.71E-07	6.32E-07	5.94E-04
244	KGT01_MPG_10_V_22mm	3.3	0.12	7.60E-07	1.77E-06	3.03E-04	7.60E-07	1.77E-06	3.03E-04
245	KGT01_MPG_10_V_71mm	35	0.12	1.94E-06	4.53E-06	6.86E-05	1.94E-06	4.53E-06	6.86E-05
246	KGT01_MPG_13_L_2mm	0.1	0.04	0.00E+00	0.00E+00	0.00E+00	2.59E-07	6.04E-07	8.46E-04
247	KGT01_MPG_13_L_6mm	0.7	0.04	0.00E+00	0.00E+00	0.00E+00	2.43E-07	5.67E-07	3.62E-04
248	KGT01_MPG_13_L_22mm	10	0.12	0.00E+00	0.00E+00	0.00E+00	9.13E-07	2.13E-06	1.77E-04
249	KGT01_MPG_13_L_85mm	145	0.3	0.00E+00	0.00E+00	0.00E+00	1.24E-06	2.90E-06	2.77E-05

Line No.	Release Scenario	Release Rate (kg/s)	Explosion Probability	Base Case/ Sensitivity Case 1			Sensitivity 2 (Future Operation)		
				Immediate Ignition Event Frequency	Delayed Ignition Event Frequency	Unignited Event Frequency ^{Note 1}	Immediate Ignition Event Frequency	Delayed Ignition Event Frequency	Unignited Event Frequency ^{Note 1}
250	KGT01_MPG_13_L_150mm	453	0.3	0.00E+00	0.00E+00	0.00E+00	8.09E-08	1.89E-07	1.80E-06
251	KGT01_STT_01_V_2mm	0.02	0.04	0.00E+00	0.00E+00	0.00E+00	1.05E-06	2.44E-06	3.48E-03
252	KGT01_STT_01_V_6mm	0.1	0.04	0.00E+00	0.00E+00	0.00E+00	5.67E-07	1.32E-06	1.51E-03
253	KGT01_STT_01_V_22mm	1.9	0.12	0.00E+00	0.00E+00	0.00E+00	1.15E-06	2.69E-06	8.00E-04
254	KGT01_STT_01_V_63mm	16	0.12	0.00E+00	0.00E+00	0.00E+00	1.31E-06	3.05E-06	1.07E-04
255	KGT01_PGS_10_V_2mm	0.02	0.04	0.00E+00	0.00E+00	0.00E+00	1.04E-06	2.42E-06	3.46E-03
256	KGT01_PGS_10_V_6mm	0.1	0.04	0.00E+00	0.00E+00	0.00E+00	5.70E-07	1.33E-06	1.52E-03
257	KGT01_PGS_10_V_22mm	1.9	0.12	0.00E+00	0.00E+00	0.00E+00	1.12E-06	2.62E-06	7.78E-04
258	KGT01_PGS_10_V_71mm	20	0.12	0.00E+00	0.00E+00	0.00E+00	2.51E-06	5.85E-06	1.59E-04
259	KGT01_PGS_11_V_2mm	0.02	0.04	0.00E+00	0.00E+00	0.00E+00	2.78E-06	6.48E-06	9.25E-03
260	KGT01_PGS_11_V_6mm	0.1	0.04	0.00E+00	0.00E+00	0.00E+00	1.54E-06	3.60E-06	4.12E-03
261	KGT01_PGS_11_V_22mm	1.9	0.12	0.00E+00	0.00E+00	0.00E+00	2.71E-06	6.32E-06	1.88E-03
262	KGT01_PGS_11_V_71mm	20	0.12	0.00E+00	0.00E+00	0.00E+00	1.03E-05	2.40E-05	6.55E-04
263	KGT01_STB_01_L_2mm	0.1	0.04	0.00E+00	0.00E+00	0.00E+00	1.30E-06	3.02E-06	3.99E-03
264	KGT01_STB_01_L_6mm	0.9	0.04	0.00E+00	0.00E+00	0.00E+00	1.24E-06	2.90E-06	1.75E-03
265	KGT01_STB_01_L_22mm	12	0.12	0.00E+00	0.00E+00	0.00E+00	5.38E-06	1.26E-05	8.99E-04
266	KGT01_STB_01_L_85mm	172	0.3	0.00E+00	0.00E+00	0.00E+00	6.16E-06	1.44E-05	1.37E-04
267	KGT01_STB_01_L_150mm	537	0.3	0.00E+00	0.00E+00	0.00E+00	5.62E-08	1.31E-07	1.25E-06
268	KGT01_DPT_11_V_2mm	0.01	0.04	9.19E-07	2.14E-06	3.06E-03	9.19E-07	2.14E-06	3.06E-03
269	KGT01_DPT_11_V_6mm	0.1	0.04	4.29E-07	1.00E-06	1.27E-03	4.29E-07	1.00E-06	1.27E-03
270	KGT01_DPT_11_V_22mm	1.4	0.12	6.55E-07	1.53E-06	6.10E-04	6.55E-07	1.53E-06	6.10E-04
271	KGT01_DPT_11_V_85mm	21	0.12	2.00E-06	4.68E-06	1.19E-04	2.00E-06	4.68E-06	1.19E-04
272	KGT01_DPT_11_V_150mm	66	0.3	3.29E-07	7.69E-07	5.53E-06	3.29E-07	7.69E-07	5.53E-06
273	KGT01_DPX_11_L_2mm	0.1	0.04	1.38E-06	3.22E-06	4.59E-03	1.38E-06	3.22E-06	4.59E-03
274	KGT01_DPX_11_L_6mm	0.7	0.04	9.55E-07	2.23E-06	1.47E-03	9.55E-07	2.23E-06	1.47E-03
275	KGT01_DPX_11_L_22mm	3.8	0.12	1.37E-06	3.19E-06	5.86E-04	1.37E-06	3.19E-06	5.86E-04
276	KGT01_DPX_11_L_71mm	3.8	0.12	2.13E-07	4.96E-07	9.11E-05	2.13E-07	4.96E-07	9.11E-05
277	KGT01_PC3_02_L_2mm	0.1	0.04	8.93E-07	2.08E-06	2.98E-03	8.93E-07	2.08E-06	2.98E-03
278	KGT01_PC3_02_L_6mm	0.7	0.04	8.65E-07	2.02E-06	1.33E-03	8.65E-07	2.02E-06	1.33E-03
279	KGT01_PC3_02_L_22mm	3.8	0.12	1.56E-06	3.64E-06	6.69E-04	1.56E-06	3.64E-06	6.69E-04
280	KGT01_PC3_02_L_50mm	3.8	0.12	4.31E-07	1.00E-06	1.84E-04	4.31E-07	1.00E-06	1.84E-04
281	KGT01_DPB_11_L_2mm	0.1	0.04	1.23E-06	2.86E-06	4.09E-03	1.23E-06	2.86E-06	4.09E-03
282	KGT01_DPB_11_L_6mm	0.7	0.04	1.19E-06	2.79E-06	1.83E-03	1.19E-06	2.79E-06	1.83E-03
283	KGT01_DPB_11_L_22mm	9.0	0.12	4.51E-06	1.05E-05	9.32E-04	4.51E-06	1.05E-05	9.32E-04
284	KGT01_DPB_11_L_85mm	135	0.3	9.20E-06	2.15E-05	2.05E-04	9.20E-06	2.15E-05	2.05E-04
285	KGT01_DPB_11_L_150mm	420	0.3	2.64E-07	6.15E-07	5.88E-06	2.64E-07	6.15E-07	5.88E-06
286	KGT01_DPT_01_V_2mm	0.01	0.04	0.00E+00	0.00E+00	0.00E+00	1.58E-06	3.68E-06	5.26E-03
287	KGT01_DPT_01_V_6mm	0.1	0.04	0.00E+00	0.00E+00	0.00E+00	7.39E-07	1.73E-06	2.19E-03
288	KGT01_DPT_01_V_22mm	1.4	0.12	0.00E+00	0.00E+00	0.00E+00	1.19E-06	2.77E-06	1.11E-03
289	KGT01_DPT_01_V_85mm	21	0.12	0.00E+00	0.00E+00	0.00E+00	2.09E-06	4.88E-06	1.24E-04
290	KGT01_DPT_01_V_150mm	66	0.3	0.00E+00	0.00E+00	0.00E+00	3.29E-07	7.69E-07	5.53E-06
291	KGT01_DPX_01_L_2mm	0.1	0.04	0.00E+00	0.00E+00	0.00E+00	1.43E-06	3.33E-06	4.75E-03
292	KGT01_DPX_01_L_6mm	0.7	0.04	0.00E+00	0.00E+00	0.00E+00	9.97E-07	2.33E-06	1.54E-03
293	KGT01_DPX_01_L_22mm	4.5	0.12	0.00E+00	0.00E+00	0.00E+00	1.66E-06	3.88E-06	6.17E-04
294	KGT01_DPX_01_L_71mm	4.5	0.12	0.00E+00	0.00E+00	0.00E+00	2.39E-07	5.58E-07	8.85E-05
295	KGT01_PC3_01_L_2mm	0.1	0.04	0.00E+00	0.00E+00	0.00E+00	7.25E-07	1.69E-06	2.41E-03
296	KGT01_PC3_01_L_6mm	0.7	0.04	0.00E+00	0.00E+00	0.00E+00	7.06E-07	1.65E-06	1.09E-03
297	KGT01_PC3_01_L_22mm	4.5	0.12	0.00E+00	0.00E+00	0.00E+00	1.46E-06	3.40E-06	5.40E-04
298	KGT01_PC3_01_L_50mm	4.5	0.12	0.00E+00	0.00E+00	0.00E+00	4.51E-07	1.05E-06	1.67E-04
299	KGT01_DPB_01_L_2mm	0.1	0.04	0.00E+00	0.00E+00	0.00E+00	1.26E-06	2.93E-06	4.18E-03

Line No.	Release Scenario	Release Rate (kg/s)	Explosion Probability	Base Case/ Sensitivity Case 1			Sensitivity 2 (Future Operation)		
				Immediate Ignition Event Frequency	Delayed Ignition Event Frequency	Unignited Event Frequency ^{Note 1}	Immediate Ignition Event Frequency	Delayed Ignition Event Frequency	Unignited Event Frequency ^{Note 1}
300	KGT01_DPB_01_L_6mm	0.7	0.04	0.00E+00	0.00E+00	0.00E+00	1.21E-06	2.82E-06	1.85E-03
301	KGT01_DPB_01_L_22mm	9.0	0.12	0.00E+00	0.00E+00	0.00E+00	4.56E-06	1.06E-05	9.42E-04
302	KGT01_DPB_01_L_85mm	135	0.3	0.00E+00	0.00E+00	0.00E+00	8.07E-06	1.88E-05	1.80E-04
303	KGT01_DPB_01_L_150mm	420	0.3	0.00E+00	0.00E+00	0.00E+00	1.65E-07	3.84E-07	3.67E-06
304	KGT01_DBT_11_V_2mm	0.01	0.04	1.07E-06	2.49E-06	3.56E-03	1.07E-06	2.49E-06	3.56E-03
305	KGT01_DBT_11_V_6mm	0.1	0.04	4.57E-07	1.07E-06	1.52E-03	4.57E-07	1.07E-06	1.52E-03
306	KGT01_DBT_11_V_22mm	0.8	0.04	5.24E-07	1.22E-06	7.56E-04	5.24E-07	1.22E-06	7.56E-04
307	KGT01_DBT_11_V_85mm	12	0.12	1.63E-06	3.79E-06	1.77E-04	1.63E-06	3.79E-06	1.77E-04
308	KGT01_DBT_11_V_150mm	37	0.12	2.17E-07	5.06E-07	7.11E-06	2.17E-07	5.06E-07	7.11E-06
309	KGT01_DBX_11_L_2mm	0.1	0.04	2.18E-06	5.10E-06	7.27E-03	2.18E-06	5.10E-06	7.27E-03
310	KGT01_DBX_11_L_6mm	0.5	0.04	1.50E-06	3.51E-06	2.56E-03	1.50E-06	3.51E-06	2.56E-03
311	KGT01_DBX_11_L_22mm	3.1	0.12	2.11E-06	4.91E-06	1.06E-03	2.11E-06	4.91E-06	1.06E-03
312	KGT01_DBX_11_L_63mm	3.1	0.12	3.83E-07	8.95E-07	1.94E-04	3.83E-07	8.95E-07	1.94E-04
313	KGT01_NGL_01_L_2mm	0.1	0.04	1.23E-06	2.88E-06	4.10E-03	1.23E-06	2.88E-06	4.10E-03
314	KGT01_NGL_01_L_6mm	0.5	0.04	1.06E-06	2.48E-06	1.81E-03	1.06E-06	2.48E-06	1.81E-03
315	KGT01_NGL_01_L_22mm	6.7	0.12	3.47E-06	8.09E-06	9.25E-04	3.47E-06	8.09E-06	9.25E-04
316	KGT01_NGL_01_L_85mm	100	0.3	7.12E-06	1.66E-05	1.74E-04	7.12E-06	1.66E-05	1.74E-04
317	KGT01_NGL_01_L_150mm	311	0.3	1.57E-07	3.67E-07	3.51E-06	1.57E-07	3.67E-07	3.51E-06
318	KGT01_NGL_02_L_2mm	0.1	0.04	1.79E-06	4.17E-06	5.96E-03	1.79E-06	4.17E-06	5.96E-03
319	KGT01_NGL_02_L_6mm	0.5	0.04	1.47E-06	3.43E-06	2.44E-03	1.47E-06	3.43E-06	2.44E-03
320	KGT01_NGL_02_L_22mm	7.2	0.12	4.39E-06	1.02E-05	1.10E-03	4.39E-06	1.02E-05	1.10E-03
321	KGT01_NGL_02_L_85mm	108	0.3	9.51E-06	2.22E-05	2.17E-04	9.51E-06	2.22E-05	2.17E-04
322	KGT01_NGL_02_L_150mm	335	0.3	8.61E-08	2.01E-07	1.92E-06	8.61E-08	2.01E-07	1.92E-06
323	KGT01_DBT_01_V_2mm	0.01	0.04	0.00E+00	0.00E+00	0.00E+00	1.17E-06	2.72E-06	3.88E-03
324	KGT01_DBT_01_V_6mm	0.1	0.04	0.00E+00	0.00E+00	0.00E+00	4.86E-07	1.13E-06	1.62E-03
325	KGT01_DBT_01_V_22mm	0.8	0.04	0.00E+00	0.00E+00	0.00E+00	5.53E-07	1.29E-06	7.99E-04
326	KGT01_DBT_01_V_71mm	8.3	0.12	0.00E+00	0.00E+00	0.00E+00	8.49E-07	1.98E-06	1.34E-04
327	KGT01_DBX_01_L_2mm	0.1	0.04	0.00E+00	0.00E+00	0.00E+00	1.56E-06	3.64E-06	5.20E-03
328	KGT01_DBX_01_L_6mm	0.5	0.04	0.00E+00	0.00E+00	0.00E+00	1.02E-06	2.38E-06	1.73E-03
329	KGT01_DBX_01_L_22mm	3.1	0.12	0.00E+00	0.00E+00	0.00E+00	1.42E-06	3.32E-06	7.19E-04
330	KGT01_DBX_01_L_63mm	3.1	0.12	0.00E+00	0.00E+00	0.00E+00	2.25E-07	5.25E-07	1.14E-04
331	KGT01_DBB_01_L_2mm	0.1	0.04	0.00E+00	0.00E+00	0.00E+00	7.84E-07	1.83E-06	2.61E-03
332	KGT01_DBB_01_L_6mm	0.5	0.04	0.00E+00	0.00E+00	0.00E+00	6.86E-07	1.60E-06	1.17E-03
333	KGT01_DBB_01_L_22mm	6.7	0.12	0.00E+00	0.00E+00	0.00E+00	2.23E-06	5.21E-06	5.96E-04
334	KGT01_DBB_01_L_85mm	100	0.3	0.00E+00	0.00E+00	0.00E+00	5.48E-06	1.28E-05	1.34E-04
335	KGT01_DBB_01_L_150mm	311	0.3	0.00E+00	0.00E+00	0.00E+00	5.62E-08	1.31E-07	1.25E-06
336	KGT01_PC4_12_L_2mm	0.1	0.04	0.00E+00	0.00E+00	0.00E+00	7.43E-07	1.73E-06	2.47E-03
337	KGT01_PC4_12_L_6mm	0.5	0.04	0.00E+00	0.00E+00	0.00E+00	6.57E-07	1.53E-06	1.12E-03
338	KGT01_PC4_12_L_22mm	6.7	0.12	0.00E+00	0.00E+00	0.00E+00	2.11E-06	4.93E-06	5.59E-04
339	KGT01_PC4_12_L_63mm	55	0.3	0.00E+00	0.00E+00	0.00E+00	4.50E-06	1.05E-05	1.91E-04
340	KGT01_PC3_13_L_2mm	0.1	0.04	0.00E+00	0.00E+00	0.00E+00	4.42E-07	1.03E-06	1.47E-03
341	KGT01_PC3_13_L_6mm	0.7	0.04	0.00E+00	0.00E+00	0.00E+00	4.10E-07	9.58E-07	6.33E-04
342	KGT01_PC3_13_L_22mm	8.9	0.12	0.00E+00	0.00E+00	0.00E+00	1.39E-06	3.25E-06	2.91E-04
343	KGT01_PC3_13_L_50mm	46	0.12	0.00E+00	0.00E+00	0.00E+00	1.47E-06	3.43E-06	7.36E-05
344	KGT01_LPG_04_L_2mm	0.1	0.04	0.00E+00	0.00E+00	0.00E+00	9.03E-07	2.11E-06	3.01E-03
345	KGT01_LPG_04_L_6mm	0.6	0.04	0.00E+00	0.00E+00	0.00E+00	8.09E-07	1.89E-06	1.30E-03
346	KGT01_LPG_04_L_22mm	7.9	0.12	0.00E+00	0.00E+00	0.00E+00	2.78E-06	6.50E-06	6.43E-04
347	KGT01_LPG_04_L_50mm	41	0.12	0.00E+00	0.00E+00	0.00E+00	2.19E-06	5.11E-06	1.22E-04
348	KGT32_NGL_05_L_2mm	0.1	0.04	2.05E-07	4.78E-07	6.82E-04	2.05E-07	4.78E-07	6.82E-04
349	KGT32_NGL_05_L_6mm	0.5	0.04	1.79E-07	4.18E-07	2.98E-04	1.79E-07	4.18E-07	2.98E-04

Line No.	Release Scenario	Release Rate (kg/s)	Explosion Probability	Base Case/ Sensitivity Case 1			Sensitivity 2 (Future Operation)		
				Immediate Ignition Event Frequency	Delayed Ignition Event Frequency	Unignited Event Frequency ^{Note 1}	Immediate Ignition Event Frequency	Delayed Ignition Event Frequency	Unignited Event Frequency ^{Note 1}
350	KGT32_NGL_05_L_22mm	7.2	0.12	5.59E-07	1.30E-06	1.40E-04	5.59E-07	1.30E-06	1.40E-04
351	KGT32_NGL_05_L_50mm	37	0.12	6.98E-07	1.63E-06	4.22E-05	6.98E-07	1.63E-06	4.22E-05
352	KGT33_NGL_06_L_2mm	0.1	0.04	4.47E-07	1.04E-06	1.49E-03	4.47E-07	1.04E-06	1.49E-03
353	KGT33_NGL_06_L_6mm	0.5	0.04	3.85E-07	8.99E-07	6.39E-04	3.85E-07	8.99E-07	6.39E-04
354	KGT33_NGL_06_L_22mm	7.2	0.12	1.27E-06	2.97E-06	3.18E-04	1.27E-06	2.97E-06	3.18E-04
355	KGT33_NGL_06_L_71mm	75	0.3	1.58E-06	3.69E-06	5.04E-05	1.58E-06	3.69E-06	5.04E-05
356	KGT34_NGL_07_L_10mm	0.01	0.04	3.00E-08	7.00E-08	9.99E-05	3.00E-08	7.00E-08	9.99E-05
357	KGT34_NGL_07_L_50mm	0.1	0.04	1.60E-09	3.74E-09	4.99E-06	1.60E-09	3.74E-09	4.99E-06
358	KGT34_NGL_07_L_FBR	1000	0.3	2.25E-08	5.25E-08	4.93E-06	2.25E-08	5.25E-08	4.93E-06
359	KGT35_NGL_09_L_2mm	0.04	0.04	1.43E-06	3.34E-06	4.77E-03	1.43E-06	3.34E-06	4.77E-03
360	KGT35_NGL_09_L_6mm	0.3	0.04	7.54E-07	1.76E-06	1.46E-03	7.54E-07	1.76E-06	1.46E-03
361	KGT35_NGL_09_L_22mm	4.7	0.12	1.33E-06	3.11E-06	4.80E-04	1.33E-06	3.11E-06	4.80E-04
362	KGT35_NGL_09_L_71mm	11	0.12	5.33E-07	1.24E-06	9.41E-05	5.33E-07	1.24E-06	9.41E-05
363	KGT36_NGL_10_L_2mm	0.04	0.04	3.73E-07	8.71E-07	1.24E-03	3.73E-07	8.71E-07	1.24E-03
364	KGT36_NGL_10_L_6mm	0.3	0.04	2.90E-07	6.77E-07	5.62E-04	2.90E-07	6.77E-07	5.62E-04
365	KGT36_NGL_10_L_22mm	4.7	0.12	8.16E-07	1.90E-06	2.94E-04	8.16E-07	1.90E-06	2.94E-04
366	KGT36_NGL_10_L_71mm	49	0.12	1.53E-06	3.58E-06	7.26E-05	1.53E-06	3.58E-06	7.26E-05
367	KGT36_NGL_11_L_10mm	1.0	0.04	4.24E-05	9.90E-05	5.71E-02	5.94E-05	1.39E-04	7.98E-02
368	KGT36_NGL_11_L_100mm	97	0.3	2.01E-04	4.69E-04	5.05E-03	2.81E-04	6.56E-04	7.06E-03
369	KGT37_PC3_05_L_2mm	0.1	0.04	3.20E-07	7.47E-07	1.07E-03	3.20E-07	7.47E-07	1.07E-03
370	KGT37_PC3_05_L_6mm	0.7	0.04	3.04E-07	7.08E-07	4.67E-04	3.04E-07	7.08E-07	4.67E-04
371	KGT37_PC3_05_L_22mm	8.9	0.12	1.07E-06	2.50E-06	2.23E-04	1.07E-06	2.50E-06	2.23E-04
372	KGT37_PC3_05_L_63mm	73	0.3	1.61E-06	3.75E-06	5.26E-05	1.61E-06	3.75E-06	5.26E-05
373	KGT39_PC3_07_V_10mm	0.2	0.04	1.94E-09	4.52E-09	4.99E-06	1.94E-09	4.52E-09	4.99E-06
374	KGT39_PC3_07_V_50mm	3.9	0.12	7.36E-10	1.72E-09	2.48E-07	7.36E-10	1.72E-09	2.48E-07
375	KGT39_PC3_07_V_FBR	1000	0.3	4.88E-08	1.14E-07	8.75E-08	4.88E-08	1.14E-07	8.75E-08
376	KGT39_PC3_08_L_10mm	1.3	0.12	4.70E-09	1.10E-08	4.98E-06	4.70E-09	1.10E-08	4.98E-06
377	KGT39_PC3_08_L_50mm	33	0.12	3.52E-09	8.20E-09	2.38E-07	3.52E-09	8.20E-09	2.38E-07
378	KGT39_PC3_08_L_FBR	1000	0.3	9.75E-09	2.28E-08	2.18E-07	9.75E-09	2.28E-08	2.18E-07
379	KGT40_PC3_09_V_10mm	0.2	0.04	1.94E-09	4.52E-09	4.99E-06	1.94E-09	4.52E-09	4.99E-06
380	KGT40_PC3_09_V_50mm	3.9	0.12	7.36E-10	1.72E-09	2.48E-07	7.36E-10	1.72E-09	2.48E-07
381	KGT40_PC3_09_V_FBR	1000	0.3	4.88E-08	1.14E-07	8.75E-08	4.88E-08	1.14E-07	8.75E-08
382	KGT40_PC3_10_L_10mm	1.3	0.12	4.70E-09	1.10E-08	4.98E-06	4.70E-09	1.10E-08	4.98E-06
383	KGT40_PC3_10_L_50mm	33	0.12	3.52E-09	8.20E-09	2.38E-07	3.52E-09	8.20E-09	2.38E-07
384	KGT40_PC3_10_L_FBR	1000	0.3	9.75E-09	2.28E-08	2.18E-07	9.75E-09	2.28E-08	2.18E-07
385	KGT41_PC4_04_L_2mm	0.1	0.04	3.98E-07	9.28E-07	1.32E-03	3.98E-07	9.28E-07	1.32E-03
386	KGT41_PC4_04_L_6mm	0.5	0.04	3.39E-07	7.92E-07	5.77E-04	3.39E-07	7.92E-07	5.77E-04
387	KGT41_PC4_04_L_22mm	6.8	0.12	1.01E-06	2.36E-06	2.67E-04	1.01E-06	2.36E-06	2.67E-04
388	KGT41_PC4_04_L_63mm	56	0.3	1.70E-06	3.97E-06	7.19E-05	1.70E-06	3.97E-06	7.19E-05
389	KGT43_PC4_06_V_10mm	0.1	0.04	1.50E-09	3.50E-09	5.00E-06	1.50E-09	3.50E-09	5.00E-06
390	KGT43_PC4_06_V_50mm	1.5	0.12	2.86E-10	6.66E-10	2.49E-07	2.86E-10	6.66E-10	2.49E-07
391	KGT43_PC4_06_V_FBR	1000	0.3	4.88E-08	1.14E-07	8.75E-08	4.88E-08	1.14E-07	8.75E-08
392	KGT43_PC4_07_L_10mm	0.7	0.04	3.38E-09	7.89E-09	4.99E-06	3.38E-09	7.89E-09	4.99E-06
393	KGT43_PC4_07_L_50mm	19	0.12	2.20E-09	5.13E-09	2.43E-07	2.20E-09	5.13E-09	2.43E-07
394	KGT43_PC4_07_L_FBR	1000	0.3	9.75E-09	2.28E-08	2.18E-07	9.75E-09	2.28E-08	2.18E-07
395	KGT44_PC4_08_V_10mm	0.1	0.04	1.50E-09	3.50E-09	5.00E-06	1.50E-09	3.50E-09	5.00E-06
396	KGT44_PC4_08_V_50mm	1.5	0.12	2.86E-10	6.66E-10	2.49E-07	2.86E-10	6.66E-10	2.49E-07
397	KGT44_PC4_08_V_FBR	1000	0.3	4.88E-08	1.14E-07	8.75E-08	4.88E-08	1.14E-07	8.75E-08
398	KGT44_PC4_09_L_10mm	0.7	0.04	3.38E-09	7.89E-09	4.99E-06	3.38E-09	7.89E-09	4.99E-06
399	KGT44_PC4_09_L_50mm	19	0.12	2.20E-09	5.13E-09	2.43E-07	2.20E-09	5.13E-09	2.43E-07

Line No.	Release Scenario	Release Rate (kg/s)	Explosion Probability	Base Case/ Sensitivity Case 1			Sensitivity 2 (Future Operation)		
				Immediate Ignition Event Frequency	Delayed Ignition Event Frequency	Unignited Event Frequency ^{Note 1}	Immediate Ignition Event Frequency	Delayed Ignition Event Frequency	Unignited Event Frequency ^{Note 1}
400	KGT44_PC4_09_L_FBR	1000	0.3	9.75E-09	2.28E-08	2.18E-07	9.75E-09	2.28E-08	2.18E-07
401	KGT45_PC3_12_L_2mm	0.1	0.04	1.85E-06	4.32E-06	6.16E-03	1.85E-06	4.32E-06	6.16E-03
402	KGT45_PC3_12_L_6mm	0.6	0.04	1.27E-06	2.97E-06	2.08E-03	1.27E-06	2.97E-06	2.08E-03
403	KGT45_PC3_12_L_22mm	7.6	0.12	3.28E-06	7.66E-06	7.88E-04	3.28E-06	7.66E-06	7.88E-04
404	KGT45_PC3_12_L_85mm	12	0.12	9.20E-07	2.15E-06	1.49E-04	9.20E-07	2.15E-06	1.49E-04
405	KGT45_PC3_12_L_173mm	12	0.12	1.29E-07	3.01E-07	2.09E-05	1.29E-07	3.01E-07	2.09E-05
406	KGT46_PC4_11_L_2mm	0.05	0.04	1.66E-06	3.88E-06	5.53E-03	1.66E-06	3.88E-06	5.53E-03
407	KGT46_PC4_11_L_6mm	0.4	0.04	9.96E-07	2.32E-06	1.80E-03	9.96E-07	2.32E-06	1.80E-03
408	KGT46_PC4_11_L_22mm	5.7	0.12	2.12E-06	4.94E-06	6.44E-04	2.12E-06	4.94E-06	6.44E-04
409	KGT46_PC4_11_L_85mm	14	0.12	7.92E-07	1.85E-06	1.14E-04	7.92E-07	1.85E-06	1.14E-04
410	KGT46_PC4_11_L_173mm	14	0.12	1.19E-07	2.79E-07	1.71E-05	1.19E-07	2.79E-07	1.71E-05
411	KGT47_LPG_01_L_2mm	0.1	0.04	2.91E-07	6.79E-07	9.70E-04	2.91E-07	6.79E-07	9.70E-04
412	KGT47_LPG_01_L_6mm	0.5	0.04	2.43E-07	5.67E-07	4.14E-04	2.43E-07	5.67E-07	4.14E-04
413	KGT47_LPG_01_L_22mm	6.7	0.12	7.67E-07	1.79E-06	2.03E-04	7.67E-07	1.79E-06	2.03E-04
414	KGT47_LPG_01_L_71mm	70	0.3	9.45E-07	2.21E-06	3.23E-05	9.45E-07	2.21E-06	3.23E-05
415	KGT47_LPG_02_L_8mm	0.9	0.04	6.27E-07	1.46E-06	8.69E-04	1.29E-06	3.01E-06	1.79E-03
416	KGT47_LPG_02_L_80mm	89	0.3	2.84E-06	6.63E-06	7.76E-05	5.84E-06	1.36E-05	1.60E-04
417	KGT47_LPG_05_L_5mm	0.3	0.04	3.21E-07	7.49E-07	6.23E-04	6.17E-07	1.44E-06	1.20E-03
418	KGT47_LPG_05_L_50mm	35	0.12	9.24E-07	2.16E-06	5.93E-05	1.78E-06	4.15E-06	1.14E-04
419	KGT70_REF_01_V_2mm	0.001	0.04	2.81E-07	6.56E-07	9.36E-04	2.81E-07	6.56E-07	9.36E-04
420	KGT70_REF_01_V_6mm	0.01	0.04	1.24E-07	2.90E-07	4.13E-04	1.24E-07	2.90E-07	4.13E-04
421	KGT70_REF_01_V_22mm	0.2	0.04	8.44E-08	1.97E-07	2.08E-04	8.44E-08	1.97E-07	2.08E-04
422	KGT70_REF_01_V_71mm	1.9	0.12	6.91E-08	1.61E-07	4.92E-05	6.91E-08	1.61E-07	4.92E-05
423	KGT70_REF_02_L_2mm	0.04	0.04	2.91E-07	6.80E-07	9.70E-04	2.91E-07	6.80E-07	9.70E-04
424	KGT70_REF_02_L_6mm	0.4	0.04	2.23E-07	5.21E-07	4.28E-04	2.23E-07	5.21E-07	4.28E-04
425	KGT70_REF_02_L_22mm	4.9	0.12	6.26E-07	1.46E-06	2.19E-04	6.26E-07	1.46E-06	2.19E-04
426	KGT70_REF_02_L_71mm	51	0.3	9.58E-07	2.23E-06	4.40E-05	9.58E-07	2.23E-06	4.40E-05
427	KGT70_REF_03_V_2mm	0.004	0.04	1.14E-06	2.66E-06	3.79E-03	1.14E-06	2.66E-06	3.79E-03
428	KGT70_REF_03_V_6mm	0.03	0.04	4.49E-07	1.05E-06	1.49E-03	4.49E-07	1.05E-06	1.49E-03
429	KGT70_REF_03_V_22mm	0.5	0.04	3.55E-07	8.28E-07	6.22E-04	3.55E-07	8.28E-07	6.22E-04
430	KGT70_REF_03_V_85mm	6.9	0.12	6.87E-07	1.60E-06	1.31E-04	6.87E-07	1.60E-06	1.31E-04
431	KGT70_REF_03_V_150mm	21	0.12	1.01E-07	2.35E-07	5.92E-06	1.01E-07	2.35E-07	5.92E-06
432	KGT70_REF_04_L_2mm	0.04	0.04	6.35E-07	1.48E-06	2.12E-03	6.35E-07	1.48E-06	2.12E-03
433	KGT70_REF_04_L_6mm	0.4	0.04	4.88E-07	1.14E-06	9.35E-04	4.88E-07	1.14E-06	9.35E-04
434	KGT70_REF_04_L_22mm	4.9	0.12	1.32E-06	3.07E-06	4.61E-04	1.32E-06	3.07E-06	4.61E-04
435	KGT70_REF_04_L_85mm	72	0.3	2.91E-06	6.78E-06	9.62E-05	2.91E-06	6.78E-06	9.62E-05
436	KGT70_REF_04_L_173mm	300	0.3	3.74E-07	8.74E-07	8.35E-06	3.74E-07	8.74E-07	8.35E-06
437	KGT70_REF_05_L_2mm	0.02	0.04	5.10E-07	1.19E-06	1.70E-03	5.10E-07	1.19E-06	1.70E-03
438	KGT70_REF_05_L_6mm	0.2	0.04	3.16E-07	7.37E-07	7.65E-04	3.16E-07	7.37E-07	7.65E-04
439	KGT70_REF_05_L_22mm	2.5	0.12	6.30E-07	1.47E-06	3.85E-04	6.30E-07	1.47E-06	3.85E-04
440	KGT70_REF_05_L_85mm	38	0.12	1.65E-06	3.85E-06	9.90E-05	1.65E-06	3.85E-06	9.90E-05
441	KGT70_REF_05_L_150mm	117	0.3	5.62E-08	1.31E-07	1.25E-06	5.62E-08	1.31E-07	1.25E-06
442	KGT70_REF_07_L_2mm	0.02	0.04	4.03E-07	9.39E-07	1.34E-03	4.03E-07	9.39E-07	1.34E-03
443	KGT70_REF_07_L_6mm	0.2	0.04	2.54E-07	5.94E-07	6.16E-04	2.54E-07	5.94E-07	6.16E-04
444	KGT70_REF_07_L_22mm	2.5	0.12	4.96E-07	1.16E-06	3.03E-04	4.96E-07	1.16E-06	3.03E-04
445	KGT70_REF_07_L_85mm	38	0.12	1.66E-06	3.88E-06	9.99E-05	1.66E-06	3.88E-06	9.99E-05
446	KGT70_REF_07_L_150mm	117	0.3	6.96E-08	1.62E-07	1.55E-06	6.96E-08	1.62E-07	1.55E-06
447	KGT70_REF_11_V_2mm	0.001	0.04	1.47E-06	3.44E-06	4.90E-03	1.47E-06	3.44E-06	4.90E-03
448	KGT70_REF_11_V_6mm	0.01	0.04	5.97E-07	1.39E-06	1.99E-03	5.97E-07	1.39E-06	1.99E-03
449	KGT70_REF_11_V_22mm	0.2	0.04	3.66E-07	8.54E-07	9.00E-04	3.66E-07	8.54E-07	9.00E-04

Line No.	Release Scenario	Release Rate (kg/s)	Explosion Probability	Base Case/ Sensitivity Case 1			Sensitivity 2 (Future Operation)		
				Immediate Ignition Event Frequency	Delayed Ignition Event Frequency	Unignited Event Frequency ^{Note 1}	Immediate Ignition Event Frequency	Delayed Ignition Event Frequency	Unignited Event Frequency ^{Note 1}
450	KGT70_REF_11_V_85mm	2.7	0.12	2.98E-07	6.95E-07	1.48E-04	2.98E-07	6.95E-07	1.48E-04
451	KGT70_REF_11_V_212mm	17	0.12	3.91E-07	9.13E-07	3.01E-05	3.91E-07	9.13E-07	3.01E-05
452	KGT70_REF_14_V_2mm	0.004	0.04	5.39E-06	1.26E-05	1.80E-02	5.39E-06	1.26E-05	1.80E-02
453	KGT70_REF_14_V_6mm	0.03	0.04	2.45E-06	5.71E-06	8.15E-03	2.45E-06	5.71E-06	8.15E-03
454	KGT70_REF_14_V_22mm	0.5	0.04	2.19E-06	5.11E-06	3.84E-03	2.19E-06	5.11E-06	3.84E-03
455	KGT70_REF_14_V_85mm	6.9	0.12	4.20E-06	9.81E-06	7.99E-04	4.20E-06	9.81E-06	7.99E-04
456	KGT70_REF_14_V_194mm	36	0.12	6.68E-06	1.56E-05	2.26E-04	6.68E-06	1.56E-05	2.26E-04
457	KGT70_REF_15_L_2mm	0.04	0.04	1.20E-06	2.81E-06	4.00E-03	1.20E-06	2.81E-06	4.00E-03
458	KGT70_REF_15_L_6mm	0.4	0.04	7.90E-07	1.84E-06	1.51E-03	7.90E-07	1.84E-06	1.51E-03
459	KGT70_REF_15_L_22mm	4.9	0.12	1.83E-06	4.26E-06	6.40E-04	1.83E-06	4.26E-06	6.40E-04
460	KGT70_REF_15_L_85mm	72	0.3	2.83E-06	6.60E-06	9.35E-05	2.83E-06	6.60E-06	9.35E-05
461	KGT70_REF_15_L_173mm	300	0.3	4.29E-07	1.00E-06	9.56E-06	4.29E-07	1.00E-06	9.56E-06
462	KGT70_REF_06_L_2mm	0.02	0.04	0.00E+00	0.00E+00	0.00E+00	6.40E-07	1.49E-06	2.13E-03
463	KGT70_REF_06_L_6mm	0.2	0.04	0.00E+00	0.00E+00	0.00E+00	3.90E-07	9.11E-07	9.45E-04
464	KGT70_REF_06_L_22mm	2.5	0.12	0.00E+00	0.00E+00	0.00E+00	7.51E-07	1.75E-06	4.59E-04
465	KGT70_REF_06_L_85mm	38	0.12	0.00E+00	0.00E+00	0.00E+00	1.94E-06	4.53E-06	1.16E-04
466	KGT70_REF_06_L_150mm	117	0.3	0.00E+00	0.00E+00	0.00E+00	2.80E-07	6.53E-07	6.25E-06
467	KGT50_EMC_01_L_2mm	0.02	0.04	1.73E-06	4.04E-06	5.76E-03	1.73E-06	4.04E-06	5.76E-03
468	KGT50_EMC_01_L_6mm	0.02	0.04	5.86E-07	1.37E-06	1.95E-03	5.86E-07	1.37E-06	1.95E-03
469	KGT50_EMC_01_L_12mm	0.02	0.04	2.93E-07	6.84E-07	9.76E-04	2.93E-07	6.84E-07	9.76E-04
470	KGT50_EMC_02_L_5mm	0.2	0.04	4.68E-08	1.09E-07	1.20E-04	4.68E-08	1.09E-07	1.20E-04
471	KGT50_EMC_02_L_10mm	0.6	0.04	1.84E-08	4.30E-08	2.87E-05	1.84E-08	4.30E-08	2.87E-05
472	KGT50_EMC_02_L_FBR	1000	0.3	1.56E-07	3.64E-07	3.48E-06	1.56E-07	3.64E-07	3.48E-06
473	KGT51_BMC_05_L_5mm	0.4	0.04	5.53E-10	1.29E-09	9.98E-07	5.53E-10	1.29E-09	9.98E-07
474	KGT51_BMC_05_L_10mm	1.7	0.12	2.81E-10	6.55E-10	2.39E-07	2.81E-10	6.55E-10	2.39E-07
475	KGT51_BMC_05_L_FBR	1000	0.3	7.80E-08	1.82E-07	1.74E-06	7.80E-08	1.82E-07	1.74E-06
476	KGT52_BMC_01_L_10mm	0.6	0.04	6.25E-09	1.46E-08	9.98E-06	6.25E-09	1.46E-08	9.98E-06
477	KGT52_BMC_01_L_50mm	15	0.12	3.66E-09	8.53E-09	4.88E-07	3.66E-09	8.53E-09	4.88E-07
478	KGT52_BMC_01_L_FBR	1000	0.3	1.95E-08	4.55E-08	4.35E-07	1.95E-08	4.55E-08	4.35E-07
479	KGT52_BMC_02_L_2mm	0.001	0.04	1.33E-06	3.10E-06	4.42E-03	1.33E-06	3.10E-06	4.42E-03
480	KGT52_BMC_02_L_6mm	0.001	0.04	5.90E-07	1.38E-06	1.97E-03	5.90E-07	1.38E-06	1.97E-03
481	KGT52_BMC_02_L_12mm	0.001	0.04	4.75E-07	1.11E-06	1.58E-03	4.75E-07	1.11E-06	1.58E-03
482	KGT52_BMC_03_L_5mm	0.2	0.04	1.02E-08	2.37E-08	2.66E-05	1.02E-08	2.37E-08	2.66E-05
483	KGT52_BMC_03_L_50mm	15	0.12	1.95E-08	4.54E-08	2.60E-06	1.95E-08	4.54E-08	2.60E-06
484	KGT55_MOH_01_L_10mm	0.01	0.04	1.20E-08	2.80E-08	4.00E-05	1.20E-08	2.80E-08	4.00E-05
485	KGT55_MOH_01_L_50mm	0.1	0.04	6.49E-10	1.52E-09	2.00E-06	6.49E-10	1.52E-09	2.00E-06
486	KGT55_MOH_01_L_FBR	1000	0.3	9.00E-09	2.10E-08	1.97E-06	9.00E-09	2.10E-08	1.97E-06
487	KGT55_MOH_02_L_2mm	0.01	0.04	2.76E-06	6.44E-06	9.19E-03	2.76E-06	6.44E-06	9.19E-03
488	KGT55_MOH_02_L_6mm	0.01	0.04	1.24E-06	2.88E-06	4.12E-03	1.24E-06	2.88E-06	4.12E-03
489	KGT55_MOH_02_L_16mm	0.01	0.04	1.00E-06	2.33E-06	3.33E-03	1.00E-06	2.33E-06	3.33E-03
490	KGT55_MOH_03_L_4mm	0.01	0.04	2.52E-06	5.88E-06	8.39E-03	3.60E-06	8.40E-06	1.20E-02
491	KGT55_MOH_03_L_40mm	1.1	0.12	6.78E-07	1.58E-06	8.38E-04	9.69E-07	2.26E-06	1.20E-03
492	KGT80_AMM_01_V_2mm	0.01	-	Toxic	Toxic	8.30E-03	Toxic	Toxic	8.30E-03
493	KGT80_AMM_01_V_6mm	0.1	-	Toxic	Toxic	3.77E-03	Toxic	Toxic	3.77E-03
494	KGT80_AMM_01_V_22mm	0.9	-	Toxic	Toxic	1.75E-03	Toxic	Toxic	1.75E-03
495	KGT80_AMM_01_V_85mm	14	-	Toxic	Toxic	3.93E-04	Toxic	Toxic	3.93E-04
496	KGT80_AMM_01_V_150mm	43	-	Toxic	Toxic	1.18E-04	Toxic	Toxic	1.18E-04
497	KGT80_AMM_11_V_2mm	0.01	-	Toxic	Toxic	8.46E-03	Toxic	Toxic	8.46E-03
498	KGT80_AMM_11_V_6mm	0.1	-	Toxic	Toxic	3.82E-03	Toxic	Toxic	3.82E-03
499	KGT80_AMM_11_V_22mm	0.9	-	Toxic	Toxic	1.77E-03	Toxic	Toxic	1.77E-03

Line No.	Release Scenario	Release Rate (kg/s)	Explosion Probability	Base Case/ Sensitivity Case 1			Sensitivity 2 (Future Operation)		
				Immediate Ignition Event Frequency	Delayed Ignition Event Frequency	Unignited Event Frequency ^{Note 1}	Immediate Ignition Event Frequency	Delayed Ignition Event Frequency	Unignited Event Frequency ^{Note 1}
500	KGT80_AMM_11_V_85mm	14	-	Toxic	Toxic	3.88E-04	Toxic	Toxic	3.88E-04
501	KGT80_AMM_11_V_150mm	43	-	Toxic	Toxic	1.18E-04	Toxic	Toxic	1.18E-04
502	KGT80_AMM_02_V_2mm	0.01	-	Toxic	Toxic	1.43E-03	Toxic	Toxic	1.43E-03
503	KGT80_AMM_02_V_6mm	0.1	-	Toxic	Toxic	6.42E-04	Toxic	Toxic	6.42E-04
504	KGT80_AMM_02_V_18mm	0.6	-	Toxic	Toxic	4.21E-04	Toxic	Toxic	4.21E-04
505	KGT80_AMM_03_L_2mm	0.1	-	Toxic	Toxic	1.21E-02	Toxic	Toxic	1.21E-02
506	KGT80_AMM_03_L_6mm	0.8	-	Toxic	Toxic	4.42E-03	Toxic	Toxic	4.42E-03
507	KGT80_AMM_03_L_22mm	11	-	Toxic	Toxic	1.58E-03	Toxic	Toxic	1.58E-03
508	KGT80_AMM_03_L_71mm	115	-	Toxic	Toxic	4.20E-04	Toxic	Toxic	4.20E-04
509	KGT80_AMM_04_L_2mm	0.1	-	Toxic	Toxic	1.83E-02	Toxic	Toxic	1.83E-02
510	KGT80_AMM_04_L_6mm	0.8	-	Toxic	Toxic	6.86E-03	Toxic	Toxic	6.86E-03
511	KGT80_AMM_04_L_22mm	11	-	Toxic	Toxic	2.55E-03	Toxic	Toxic	2.55E-03
512	KGT80_AMM_04_L_71mm	115	-	Toxic	Toxic	6.85E-04	Toxic	Toxic	6.85E-04
513	KGT80_AMM_07_L_2mm	0.1	-	Toxic	Toxic	2.48E-03	Toxic	Toxic	2.48E-03
514	KGT80_AMM_07_L_6mm	0.8	-	Toxic	Toxic	1.12E-03	Toxic	Toxic	1.12E-03
515	KGT80_AMM_07_L_16mm	5.9	-	Toxic	Toxic	7.33E-04	Toxic	Toxic	7.33E-04
516	KGT80_AMM_08_V_2mm	0.000	-	Toxic	Toxic	3.27E-03	Toxic	Toxic	3.27E-03
517	KGT80_AMM_08_V_6mm	0.001	-	Toxic	Toxic	1.40E-03	Toxic	Toxic	1.40E-03
518	KGT80_AMM_08_V_22mm	0.01	-	Toxic	Toxic	6.46E-04	Toxic	Toxic	6.46E-04
519	KGT80_AMM_08_V_85mm	0.1	-	Toxic	Toxic	1.89E-04	Toxic	Toxic	1.89E-04
520	KGT80_AMM_08_V_194mm	0.7	-	Toxic	Toxic	5.75E-06	Toxic	Toxic	5.75E-06
521	KGT80_AMM_09_V_2mm	0.000	-	Toxic	Toxic	1.64E-02	Toxic	Toxic	1.64E-02
522	KGT80_AMM_09_V_6mm	0.001	-	Toxic	Toxic	6.07E-03	Toxic	Toxic	6.07E-03
523	KGT80_AMM_09_V_22mm	0.01	-	Toxic	Toxic	2.23E-03	Toxic	Toxic	2.23E-03
524	KGT80_AMM_09_V_63mm	0.1	-	Toxic	Toxic	5.46E-04	Toxic	Toxic	5.46E-04
525	KGT90_CO2_01_V_2mm	0.01	-	Toxic	Toxic	9.50E-03	Toxic	Toxic	9.50E-03
526	KGT90_CO2_01_V_6mm	0.1	-	Toxic	Toxic	4.37E-03	Toxic	Toxic	4.37E-03
527	KGT90_CO2_01_V_22mm	1.7	-	Toxic	Toxic	2.09E-03	Toxic	Toxic	2.09E-03
528	KGT90_CO2_01_V_71mm	18	-	Toxic	Toxic	6.75E-04	Toxic	Toxic	6.75E-04
529	KGT90_CO2_02_V_2mm	0.01	-	Toxic	Toxic	9.52E-03	Toxic	Toxic	9.52E-03
530	KGT90_CO2_02_V_6mm	0.1	-	Toxic	Toxic	4.38E-03	Toxic	Toxic	4.38E-03
531	KGT90_CO2_02_V_22mm	1.7	-	Toxic	Toxic	2.10E-03	Toxic	Toxic	2.10E-03
532	KGT90_CO2_02_V_71mm	18	-	Toxic	Toxic	6.80E-04	Toxic	Toxic	6.80E-04
533	KGT90_CO2_03_V_2mm	0.01	-	Toxic	Toxic	3.37E-03	Toxic	Toxic	3.37E-03
534	KGT90_CO2_03_V_6mm	0.1	-	Toxic	Toxic	1.60E-03	Toxic	Toxic	1.60E-03
535	KGT90_CO2_03_V_22mm	1.7	-	Toxic	Toxic	8.57E-04	Toxic	Toxic	8.57E-04
536	KGT90_CO2_03_V_71mm	18	-	Toxic	Toxic	3.41E-04	Toxic	Toxic	3.41E-04
537	KGT90_CO2_07_V_2mm	0.01	-	Toxic	Toxic	4.78E-03	Toxic	Toxic	4.78E-03
538	KGT90_CO2_07_V_6mm	0.1	-	Toxic	Toxic	2.05E-03	Toxic	Toxic	2.05E-03
539	KGT90_CO2_07_V_22mm	1.7	-	Toxic	Toxic	9.86E-04	Toxic	Toxic	9.86E-04
540	KGT90_CO2_07_V_63mm	14	-	Toxic	Toxic	2.49E-04	Toxic	Toxic	2.49E-04
541	KGT90_CO2_08_L_2mm	0.1	-	Toxic	Toxic	8.75E-03	Toxic	Toxic	8.75E-03
542	KGT90_CO2_08_L_6mm	1.0	-	Toxic	Toxic	3.25E-03	Toxic	Toxic	3.25E-03
543	KGT90_CO2_08_L_22mm	2.1	-	Toxic	Toxic	1.37E-03	Toxic	Toxic	1.37E-03
544	KGT90_CO2_08_L_71mm	2.1	-	Toxic	Toxic	4.04E-04	Toxic	Toxic	4.04E-04
545	KGT90_CO2_16_V_2mm	0.001	-	Toxic	Toxic	2.50E-02	Toxic	Toxic	2.50E-02
546	KGT90_CO2_16_V_6mm	0.01	-	Toxic	Toxic	1.02E-02	Toxic	Toxic	1.02E-02
547	KGT90_CO2_16_V_22mm	0.2	-	Toxic	Toxic	4.48E-03	Toxic	Toxic	4.48E-03
548	KGT90_CO2_16_V_85mm	2.5	-	Toxic	Toxic	8.92E-04	Toxic	Toxic	8.92E-04
549	KGT90_CO2_16_V_212mm	15	-	Toxic	Toxic	1.99E-04	Toxic	Toxic	1.99E-04

Line No.	Release Scenario	Release Rate (kg/s)	Explosion Probability	Base Case/ Sensitivity Case 1			Sensitivity 2 (Future Operation)		
				Immediate Ignition Event Frequency	Delayed Ignition Event Frequency	Unignited Event Frequency ^{Note 1}	Immediate Ignition Event Frequency	Delayed Ignition Event Frequency	Unignited Event Frequency ^{Note 1}
550	KGT90_CO2_18_V_2mm	0.000	-	Toxic	Toxic	1.63E-03	Toxic	Toxic	1.63E-03
551	KGT90_CO2_18_V_6mm	0.003	-	Toxic	Toxic	7.45E-04	Toxic	Toxic	7.45E-04
552	KGT90_CO2_18_V_22mm	0.04	-	Toxic	Toxic	3.80E-04	Toxic	Toxic	3.80E-04
553	KGT90_CO2_18_V_50mm	0.2	-	Toxic	Toxic	1.36E-04	Toxic	Toxic	1.36E-04
554	KGT90_CO2_19_V_2mm	0.000	-	Toxic	Toxic	6.14E-03	Toxic	Toxic	6.14E-03
555	KGT90_CO2_19_V_6mm	0.003	-	Toxic	Toxic	2.55E-03	Toxic	Toxic	2.55E-03
556	KGT90_CO2_19_V_22mm	0.05	-	Toxic	Toxic	1.23E-03	Toxic	Toxic	1.23E-03
557	KGT90_CO2_19_V_63mm	0.4	-	Toxic	Toxic	2.57E-04	Toxic	Toxic	2.57E-04
558	KGT90_CO2_23_V_2mm	0.001	-	0.00E+00	0.00E+00	0.00E+00	Toxic	Toxic	8.01E-04
559	KGT90_CO2_23_V_6mm	0.01	-	0.00E+00	0.00E+00	0.00E+00	Toxic	Toxic	3.82E-04
560	KGT90_CO2_23_V_22mm	0.2	-	0.00E+00	0.00E+00	0.00E+00	Toxic	Toxic	2.04E-04
561	KGT90_CO2_23_V_85mm	2.5	-	0.00E+00	0.00E+00	0.00E+00	Toxic	Toxic	4.31E-05
562	KGT90_CO2_23_V_212mm	15	-	0.00E+00	0.00E+00	0.00E+00	Toxic	Toxic	1.78E-05
563	KGT90_CO2_09_L_10mm	2.8	-	Toxic	Toxic	1.00E-05	Toxic	Toxic	1.00E-05
564	KGT90_CO2_09_L_50mm	70	-	Toxic	Toxic	5.00E-07	Toxic	Toxic	5.00E-07
565	KGT90_CO2_09_L_FBR	1000	-	Toxic	Toxic	5.00E-07	Toxic	Toxic	5.00E-07
566	KGT90_CO2_10_L_10mm	2.8	-	Toxic	Toxic	1.00E-05	Toxic	Toxic	1.00E-05
567	KGT90_CO2_10_L_50mm	70	-	Toxic	Toxic	5.00E-07	Toxic	Toxic	5.00E-07
568	KGT90_CO2_10_L_FBR	1000	-	Toxic	Toxic	5.00E-07	Toxic	Toxic	5.00E-07
569	KGT90_CO2_11_L_10mm	2.8	-	Toxic	Toxic	1.00E-05	Toxic	Toxic	1.00E-05
570	KGT90_CO2_11_L_50mm	70	-	Toxic	Toxic	5.00E-07	Toxic	Toxic	5.00E-07
571	KGT90_CO2_11_L_FBR	1000	-	Toxic	Toxic	5.00E-07	Toxic	Toxic	5.00E-07
572	KGT90_CO2_12_L_10mm	2.8	-	Toxic	Toxic	1.00E-05	Toxic	Toxic	1.00E-05
573	KGT90_CO2_12_L_50mm	70	-	Toxic	Toxic	5.00E-07	Toxic	Toxic	5.00E-07
574	KGT90_CO2_12_L_FBR	1000	-	Toxic	Toxic	5.00E-07	Toxic	Toxic	5.00E-07
575	KGT90_CO2_24_L_2mm	0.1	-	Toxic	Toxic	6.53E-03	Toxic	Toxic	6.53E-03
576	KGT90_CO2_24_L_6mm	1.0	-	Toxic	Toxic	2.19E-03	Toxic	Toxic	2.19E-03
577	KGT90_CO2_24_L_22mm	14	-	Toxic	Toxic	7.77E-04	Toxic	Toxic	7.77E-04
578	KGT90_CO2_24_L_71mm	142	-	Toxic	Toxic	1.89E-04	Toxic	Toxic	1.89E-04
579	KGT90_CO2_25_L_2mm	0.1	-	Toxic	Toxic	2.85E-03	Toxic	Toxic	2.85E-03
580	KGT90_CO2_25_L_6mm	1.0	-	Toxic	Toxic	1.35E-03	Toxic	Toxic	1.35E-03
581	KGT90_CO2_25_L_22mm	14	-	Toxic	Toxic	7.40E-04	Toxic	Toxic	7.40E-04
582	KGT90_CO2_25_L_50mm	70	-	Toxic	Toxic	5.17E-04	Toxic	Toxic	5.17E-04
583	KGT90_CO2_26_V_2mm	0.01	-	Toxic	Toxic	8.01E-04	Toxic	Toxic	8.01E-04
584	KGT90_CO2_26_V_6mm	0.1	-	Toxic	Toxic	3.57E-04	Toxic	Toxic	3.57E-04
585	KGT90_CO2_26_V_22mm	1.7	-	Toxic	Toxic	1.74E-04	Toxic	Toxic	1.74E-04
586	KGT90_CO2_26_V_50mm	8.8	-	Toxic	Toxic	6.00E-05	Toxic	Toxic	6.00E-05
587	KGT90_CO2_27_V_2mm	0.01	-	Toxic	Toxic	8.77E-04	Toxic	Toxic	8.77E-04
588	KGT90_CO2_27_V_6mm	0.1	-	Toxic	Toxic	3.78E-04	Toxic	Toxic	3.78E-04
589	KGT90_CO2_27_V_16mm	0.9	-	Toxic	Toxic	2.25E-04	Toxic	Toxic	2.25E-04
590	KGT90_CO2_28_L_5mm	0.7	-	Toxic	Toxic	6.00E-03	Toxic	Toxic	6.00E-03
591	KGT90_CO2_28_L_50mm	70	-	Toxic	Toxic	6.00E-04	Toxic	Toxic	6.00E-04
592	KGT90_CO2_29_V_2.5mm	0.02	-	Toxic	Toxic	2.40E-02	Toxic	Toxic	2.40E-02
593	KGT90_CO2_29_V_25mm	2.2	-	Toxic	Toxic	2.40E-03	Toxic	Toxic	2.40E-03
594	KGT90_CO2_30_L_8mm	1.8	-	Toxic	Toxic	2.40E-02	Toxic	Toxic	2.40E-02
595	KGT90_CO2_30_L_80mm	180	-	Toxic	Toxic	2.40E-03	Toxic	Toxic	2.40E-03
596	KGT90_CO2_31_V_2.5mm	0.02	-	Toxic	Toxic	4.60E-03	Toxic	Toxic	4.60E-03
597	KGT90_CO2_31_V_25mm	2.2	-	Toxic	Toxic	4.60E-04	Toxic	Toxic	4.60E-04
598	KGT90_CO2_32_L_5mm	0.7	-	Toxic	Toxic	4.60E-03	Toxic	Toxic	4.60E-03
599	KGT90_CO2_32_L_50mm	70	-	Toxic	Toxic	4.60E-04	Toxic	Toxic	4.60E-04

Line No.	Release Scenario	Release Rate (kg/s)	Explosion Probability	Base Case/ Sensitivity Case 1			Sensitivity 2 (Future Operation)		
				Immediate Ignition Event Frequency	Delayed Ignition Event Frequency	Unignited Event Frequency ^{Note 1}	Immediate Ignition Event Frequency	Delayed Ignition Event Frequency	Unignited Event Frequency ^{Note 1}
600	KGT36_NGL_12_L_100mm	97	0.3	2.87E-09	6.69E-09	8.16E-08	4.01E-09	9.35E-09	1.14E-07
601	KGT36_NGL_12_L_Cat	1000	0.3	3.18E-09	7.43E-09	8.16E-08	4.45E-09	1.04E-08	1.14E-07
602	KGT47_LPG_03_L_80mm	89	0.3	5.41E-09	1.26E-08	1.66E-07	1.11E-08	2.59E-08	3.41E-07
603	KGT47_LPG_03_L_Cat	1000	0.3	6.46E-09	1.51E-08	1.66E-07	1.33E-08	3.10E-08	3.41E-07
604	KGT47_LPG_06_L_50mm	35	0.12	1.32E-11	3.08E-11	8.90E-10	2.54E-11	5.92E-11	1.71E-09
605	KGT47_LPG_06_L_Cat	1000	0.3	3.47E-11	8.10E-11	8.90E-10	6.68E-11	1.56E-10	1.71E-09
606	KGT52_BMC_04_L_50mm	15	0.12	2.78E-13	6.48E-13	3.80E-11	2.78E-13	6.48E-13	3.80E-11
607	KGT52_BMC_04_L_Cat	1000	0.3	2.97E-11	6.92E-11	7.60E-10	2.97E-11	6.92E-11	7.60E-10
608	KGT55_MOH_04_L_40mm	1	0.12	9.68E-12	2.26E-11	1.20E-08	1.38E-11	3.23E-11	1.71E-08
609	KGT55_MOH_04_L_Cat	1000	0.3	9.35E-09	2.18E-08	2.40E-07	1.34E-08	3.12E-08	3.42E-07
610	KGT90_CO2_33_L_50mm	70	-	Toxic	Toxic	8.56E-09	Toxic	Toxic	8.56E-09
611	KGT90_CO2_33_L_Cat	1000	-	Toxic	Toxic	8.56E-09	Toxic	Toxic	8.56E-09
612	KGT90_CO2_34_L_80mm	180	-	Toxic	Toxic	3.42E-08	Toxic	Toxic	3.42E-08
613	KGT90_CO2_34_L_Cat	1000	-	Toxic	Toxic	3.42E-08	Toxic	Toxic	3.42E-08
614	KGT90_CO2_35_L_50mm	70	-	Toxic	Toxic	6.56E-09	Toxic	Toxic	6.56E-09
615	KGT90_CO2_35_L_Cat	1000	-	Toxic	Toxic	6.56E-09	Toxic	Toxic	6.56E-09

Notes:

1. Unignited frequency is the remaining portion of the leak frequency that is not ignited, i.e. Immediate ignition frequency + delayed ignition frequency + unignited frequency = total leak frequency

For scenarios which consist of toxic materials, the unignited frequency is the toxic event frequency.

TODD ENERGY LTD

Kapuni Wellsites QRA Assumptions Register

610114-RPT-R0001
July 2022

Worley New Zealand Ltd
25 Gill Street, New Plymouth 4310
PO Box 705, New Plymouth 4340

Telephone +64-6-759 6300
Facsimile +64-6-759 6301
www.worley.com

Rev	Description	Originator	Reviewer	Worley Approver	Date	Client Approval	Date
A	Issued for Review/Comment	Y Lee	E Gloy	Y Lee	05/2020		
0	Approved for Use	Y Lee	L Ong	Y Lee	08/2020		
1	Re-Approved for Use	Y Lee	O Kilian	Y Lee	07/2022		

TABLE OF CONTENTS

1.	ABBREVIATIONS	1
2.	INTRODUCTION	2
2.1	Objective	2
2.2	Scope.....	2
2.3	Facility Description.....	4
3.	MODELLING INPUTS AND ASSUMPTIONS	8
3.1	Assessment Tool	8
3.2	Definition of Parts Count Sections	8
3.3	Failure Frequency Data and Hole Size Distributions	9
3.4	Blowout Events	12
3.5	Ignition Probabilities	13
3.6	Material Composition	14
3.7	Release Scenarios.....	14
3.8	Congested Area.....	15
3.9	Atmospheric Conditions for Modelling	15
3.10	Fatality Criteria.....	17
3.11	Risk Criteria	20
4.	REFERENCES	22

1. ABBREVIATIONS

API	American Petroleum Institute
AWS	Automatic Weather Station
BLEVE	Boiling Liquid Expanding Vapour Explosion
BOP	Blowout Preventer
DNV GL	Det Norske Veritas Germanischer Lloyd
EI	Energy Institute
ESDV	Emergency Shutdown Valve
FBR	Full Bore Rupture
GOR	Gas Oil Ratio
HCRD	Hydrocarbon Release Database
HIPAP4	NSW Hazardous Industry Planning Advisory Paper No. 4
HMB	Heat and Material Balance
HPKO	High Pressure Knock Out
IOGP	International Association of Oil and Gas Producers
IRPA	Individual Risk Per Annum
KPS	Kapuni Production Station
LFL	Lower Flammable Limit
LPG	Liquefied Petroleum Gas
LSIR	Location Specific Individual Risk
LTS	Low Temperature Separator
PFD	Process Flow Diagram
PFPP	Passive Fire Protection
P&ID	Piping & Instrumentation Diagram
PLL	Potential Loss of Life
QRA	Quantitative Risk Assessment
RADD	Risk Assessment Data Directory
STDC	South Taranaki District Council
UK HSE	United Kingdom Health and Safety Executive
VCE	Vapour Cloud Explosion
WSO	Water Shut-off

2. INTRODUCTION

This document sets out the assumptions to be used for the Todd Energy (Todd) Kapuni wellsites Quantitative Risk Assessment (QRA).

2.1 Objective

The objective of the QRA is to develop risk contours to meet the risk assessment requirements of the South Taranaki District Council (STDC) District Plan, Section 11: Hazardous Substances.

2.2 Scope

The scopes include:

- 1) Conduct risk assessment for seven (7) Kapuni wellsites with 17 wells; and
- 2) Update the existing KA-4/14 and KA-13 wellsites QRA [Ref. 1] and hence supersedes the results from the QRA.

The final report will be a combined QRA report for all nine (9) Kapuni wellsites with 20 wells.

Currently, seven (7) wellsites are producing, KA-3 is out of service and KA-9 is designed for water disposal only. The wellsite details are summarised in Table 2-1. Only producing wells will be considered in the QRA.

Table 2-1: Kapuni Wellsites

Wellsite	Number of wells	Producing	Scheduled for Abandonment ^{Note 1}	Suspended ^{Note 2}	Shut in ^{Note 3}	Observation / water ^{Note 4}	Notes
KA-1, KA-7, KA-19 and KA-20	4	1			1 (KA-7)	2 (KA-1 and KA-20)	
KA-2	1	1					
KA-3	1			1			
KA-4 and KA-14	2	2					KA-14 is only operating once (for 24 hours) every 10 days [Ref. 20].
KA-5 and KA-10	2	1				1 (KA-10)	
KA-6, KA-11 and KA-17	3	2		1 (KA-11)			
KA-8, KA-12, KA-15 and KA-18	4	2	1 (KA-12)		1 (KA-15)		
KA-9	2					2	A new well, KW03, is drilled in May 2021 for further water injection purposes.

Wellsite	Number of wells	Producing	Scheduled for Abandonment <small>Note 1</small>	Suspended <small>Note 2</small>	Shut in <small>Note 3</small>	Observation / water <small>Note 4</small>	Notes
KA-13	1	1					KA-13 is only operating in 1 out of every 3 months.
Total	20	10	1	2	2	5	

Notes:

1. Wells that are scheduled for abandonment are plugged with abandonment plans underway.
2. Suspended wells are plugged and major intervention is required to bring the well back to service.
3. Shut in wells are isolated but could be brought back into service. Note that KA-7 and KA-15 were considered as producing well in the Kapuni Safety Case [Ref. 2], however, the wells are currently shut-in and hence will not be included in the risk assessment [Ref. 3 and Ref. 4].
4. Water wells are for water injection only and will not be used for hydrocarbon / producing. Observation wells are only for monitoring reservoir conditions and informing development of reserves estimates. They are designed for instrumentation only and cannot inject or produce.

There is no plan to bring the non-producing wells back online in the future. In the unlikely event that this changes, the QRA will be updated to verify any impact on the risk contours. Engagement with STDC will be completed as part of this process and a new resource consent will be required.

2.2.1 Exclusions

The following will be excluded from the QRA scope:

- Risk from the gathering pipelines to Kapuni Production Station (KPS). The scope for each wellsite will include up to the pipeline isolation valves (if available) or when the pipelines go underground. Pipelines passing through the wellsites (e.g., at KA-4/14 and KA-5) are not considered in the base case. The pipeline sections will be assessed in the sensitivity case. Note that the pipeline (P/L) to PECPR on the P&ID will be used in some sections to identify the pipeline boundary;
- Risk other than hydrocarbon / process risk (e.g., transportation risk, seismic risk and volcanic risks);
- Decommissioned and/or mothballed equipment;
- Utilities such as produced water and instrument air as they do not contain any hydrocarbon inventory;
- Individual risk calculations, including Individual Risk Per Annum (IRPA) and Potential Loss of Life (PLL) as the wellsites are normally unmanned;
- Societal risk (F-N curve) as the wellsites are located as remote area with low populations;
- Corrosion Inhibitors present at the wellsites as they are not flammable;
- Methanol injecting pumps as they are only used during start-up (except for KA-8/12/15/18 wellsite where methanol dosing is required throughout the year). Note that methanol tanks are always full and connected to the methanol pumps, with the pumps turn off when methanol is not being injected [Ref. 19], hence the methanol tanks and tubing to the methanol pumps will be included.
- Toxic effect of carbon dioxide.

2.3 Facility Description

Kapuni is an onshore gas and condensate field located in South Taranaki, approximately 50 km south of New Plymouth. 20 Kapuni wells are located on nine (9) separate wellsites in the area surrounding the Kapuni Production Station (KPS). The production wellsite process is a simple separation of gas and liquids involving the direction of wellstream gas and liquids to a low temperature separator (LTS) unit on the wellsite. The LTS separates the gas and liquids by means of pressure reduction to cause cooling.

An aerial overview of the wellsites location with reference to KPS is shown in Figure 2-1.

The wellsites access are via vehicle gates which are normally adjacent to the main wellsite control huts for the wellsites. Each wellsite hut is a single storey building which contains the wellsite control logic systems, emergency and communications equipment.

The wellsites have an open layout with areas separated from each other to prevent knock-on effects. The open area reduces the potential for overpressure from an explosion and reduces fire damage / escalation potential.

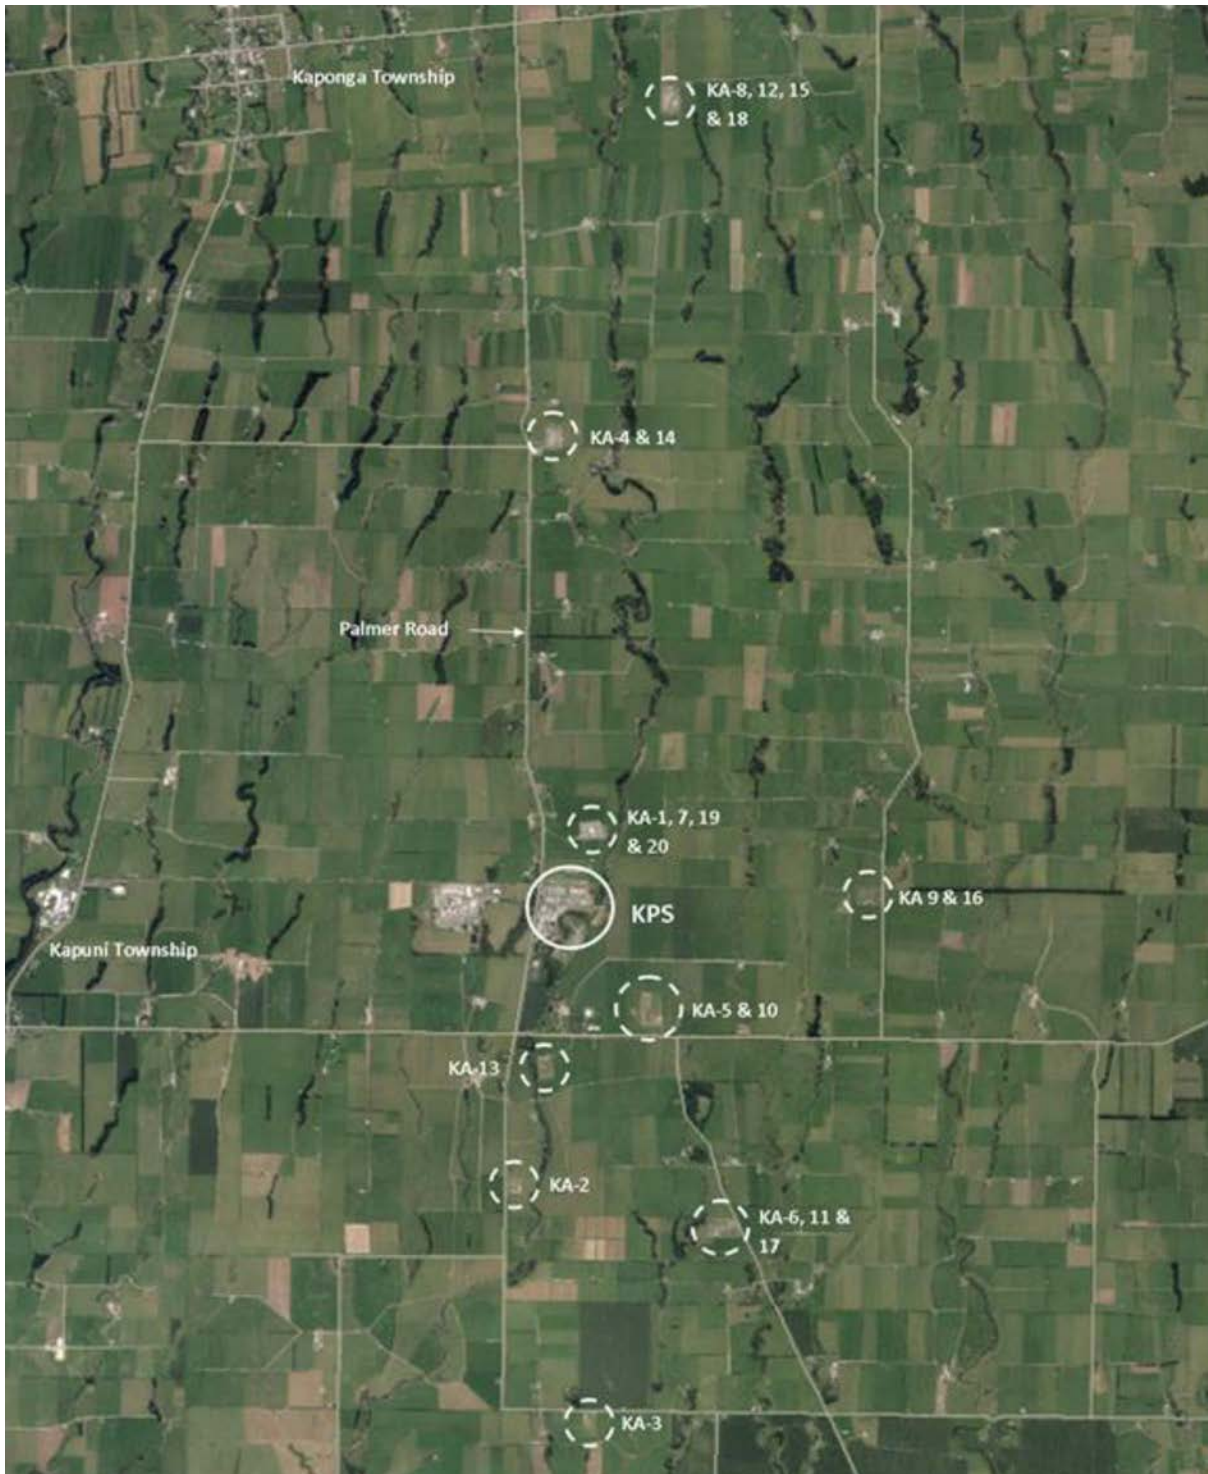


Figure 2-1: Kapuni Wellsites Location with reference to Kapuni Production Station

The details of each of the wellsite is as below.

2.3.1 Wellsite KA-1, KA-7, KA-19 and KA-20

Located just off Palmer Road, the site contains 4 wells. A wellstream heater is fitted to the KA-19 well. KA-1 well is suspended, KA-7 is not operational following the recent unsuccessful Water Shut-off (WSO) [Ref. 3] and KA-20 well is an observation well.

This site also acts as a distribution point for gas from the northern wells. It re-routes gas arriving from the gathering lines from wellsite KA-4/14 and KA-8/12/15/18 to KPS.

2.3.2 Wellsite KA-2

Located on Palmer Road, the site has an LTS unit and the flowline is equipped with two wellstream coolers.

2.3.3 Wellsite KA-3

This wellsite has been suspended and plugged.

2.3.4 Wellsite KA-4 and KA-14

Located just off Palmer Road, the site contains two wells, two LTS units, and a wellstream heater.

2.3.5 Wellsite KA-5 and KA-10

Located just off Skeet Road, this site contains one producing well (KA-5) and one observation well (KA-10), with a Desander unit for solids separation, and a PCV used on start-up.

2.3.6 Wellsite KA-6, KA-11 and KA-17

Located on Ahipaipa Road, this site contains two in service wells, and one suspended well (KA-11). KA-6 and KA-17 wellstream fluids are co-mingled, routed through a wellstream cooler and then to an LTS Unit.

2.3.7 Wellsite KA-8, KA-12, KA-15 and KA-18

Located just off Eltham Road, this site contains two (2) producing wells. KA-12 well is plugged and scheduled for abandonment and KA-15 well is shut-in and isolated [Ref. 4]. Two wellstream process skids and two wellhead compression units are fitted to the wells.

2.3.8 Wellsite KA-13

Located just off Skeet Road, this site contains one well, Desander, a flowline choke valve and a High Pressure Knock Out (HPKO) vessel. It connects into the KA-6/5 gathering lines.

2.3.9 Wellsite KA-9

Located on Lower Duthie Road, two wells were drilled on the site, KA-9 (referred to as KW-2) and KA-16. KA-16 is suspended and KW-2 is currently in service as a water injection well. There is very little equipment left on the wellsite, only the water injection line, a filter, and two pig receivers.

The wellsites flow schematic is presented in Figure 2-2.

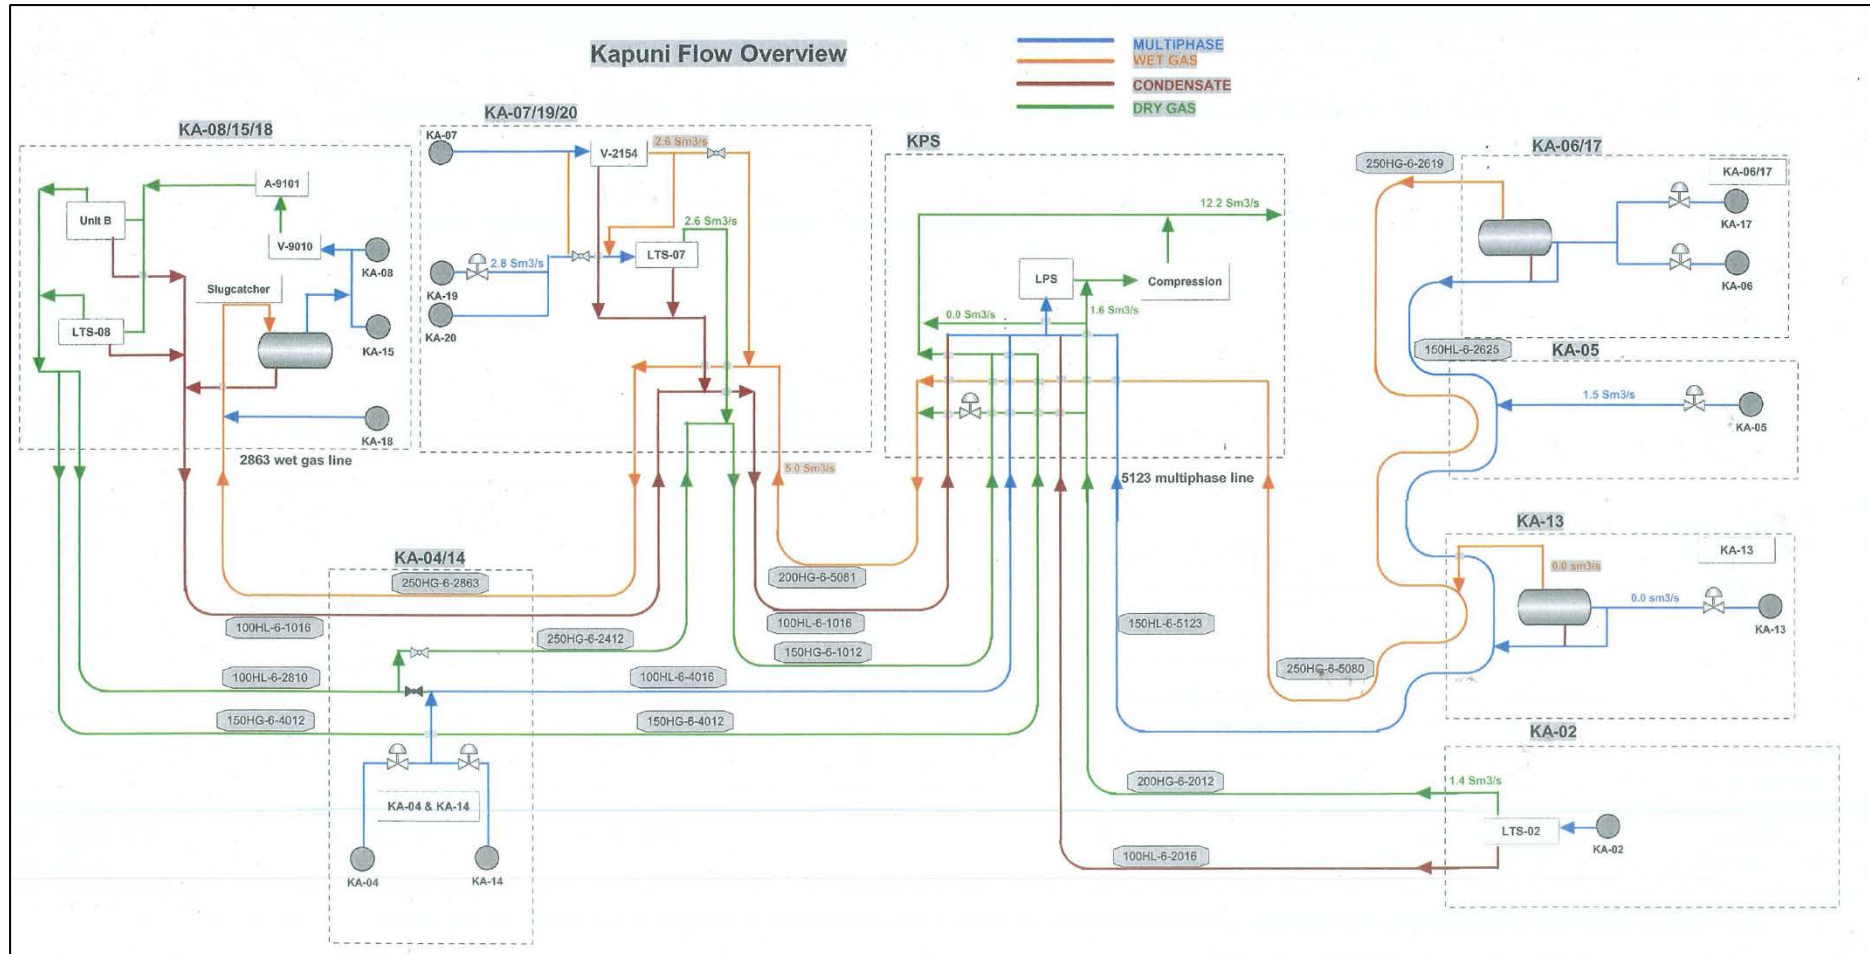


Figure 2-2: Kapuni Wellsites Flow Schematic

3. MODELLING INPUTS AND ASSUMPTIONS

This section outlines all modelling inputs and assumptions that will be used in the QRA. The assumptions and methodology will be consistent with those in the Todd Energy's Fire and Gas Analysis and Quantitative Risk Assessment Methodology Guideline [Ref. 5].

3.1 Assessment Tool

The risk assessment model will be set up using DNV GL Safeti version 8.22 [Ref. 6].

3.2 Definition of Parts Count Sections

3.2.1 Isolatable Inventory

Sectionalisation will be performed to segregate the facilities into a number of isolatable sections. Each potential leak source will be associated with a particular isolatable inventory. Primarily, the isolatable inventories will be defined by emergency shutdown valve (ESDV) boundaries. These sections will be split further where required, and the entire contained inventory was considered as available for release. Further segregations are based on:

- Significant change in operating parameters (temperature and pressure);
- Significant change in stream composition;
- Change in stream phase; and
- Equipment location.

The probability of successful detection and isolation is assumed to be 100%. At isolatable boundaries, the valve will be assumed as the last component of the upstream inventory. If a cap or blind flange is shown against a valve, it will be assumed to be closed, even if not indicated as such.

Node sections will be highlighted in the Process Flow Diagrams (PFDs) and will be detailed in a Node Definition table in the QRA report which presents details of all the nodes including unique identification code, definition of boundaries, operating temperature and pressure, maximum pipe diameter, etc.

Following sectionalisation, a parts counts will be conducted to perform the frequency analysis for the QRA.

3.2.2 Components

The definition of components within the parts count will be aligned with failure rate data published in the International Association of Oil and Gas Producers (IOGP) Risk Assessment Data Directory (RADD) Process Release Frequency [Ref. 7]. The parts count will consider the following:

- Equipment items;
- Valves;
- Flanges;
- Instrumentation and small-bore fittings; and
- Pipework.

The parts count will be recorded in an MS Excel spreadsheet, with each section broken down based on the piping and instrumentation diagrams (P&IDs). Marked up P&IDs will be attached with the QRA report.

3.3 Failure Frequency Data and Hole Size Distributions

3.3.1 General Leak Frequency

The leak frequencies for process equipment and piping will be taken from the IOGP Process Release Frequency [Ref. 7]. The release frequencies of the main process equipment items from IOGP are based on the UK HSE (UK Health and Safety Executive) hydrocarbon release database (HCRD) which has been compiled by the UK HSE over a 20-year period. Two sets of data are presented in IOGP Process Release Frequency, which include the 1992 – 2015 data and 2006 – 2015 data.

The recommended values based on experience in the period 2006 – 2015 (inclusive) will be used. The IOGP release notes state that the number of incidents recorded per year in the database has been steadily decreasing, and it is considered appropriate to base the frequency on more recent data on the assumption that this is more representative of what will occur in the future.

Failure frequency data from the HCRD contains detailed historical information on offshore hydrocarbon release incidents occurring in the UK offshore environment and is considered an industry standard for offshore QRA applications. The database categorises failure rates on a detailed basis of equipment type and size and provides a probabilistic hole size distribution associated with the failure.

The HCRD data are also normally used for QRA at onshore facilities, although the use of offshore failure rate may be considered to be conservative for use in most onshore applications, on the basis that:

- Offshore environments tend to be harsher, both external (saliferous environment) and internal (produced sand), increasing the rate of equipment corrosion and erosion;
- Congestion at offshore facilities increases the likelihood of damage through impact; and
- Restricted access to offshore facilities may limit maintenance campaigns, increasing the likelihood of failure.

Atmospheric Storage Tank

The IOGP Release Frequency Data does not provide the frequencies for atmospheric storage tanks. Therefore, the following leak frequencies as shown in Table 3-1 from the TNO Purple Book [Ref. 23] will be used for methanol tanks.

Table 3-1: Release Frequencies for Atmospheric Storage Tank

Type of Release	Storage Tanks, Atmospheric
Instantaneous release of the complete inventory	5.0E-06 per year
Continuous release of the complete inventory in 10 minutes at a constant rate	5.0E-06 per year
Continuous release from a hole with an effective diameter of 10 mm	1.0E-04 per year

3.3.2 Pigging

Pig traps are located at the wellsites to clean, condition and/or monitor the pipelines. The pigging frequency will be used to calculate a modification factor for the leak frequency from the pig receivers.

Table 3-2: Pigging Frequencies and Modification Factor [Ref. 19]

Tag	Description	To		Pigging Frequency (per year)	Average pigging duration (hours)	Modification Factor
<i>KA-06/17</i>						
A-2613	Hydrocarbon gas to gathering line	A-5001	KPS	4	1.5	0.001
A-2614	Hydrocarbon liquid to gathering line	A-5003	KPS	4	1.5	0.001
<i>KA-02</i>						
A-0101B	Hydrocarbon liquid to A-0501A (KPS)	A-0501A	KPS	2	8	0.002
A-0103	Hydrocarbon gas to A-0503 (KPS)	A-0503	KPS	4	1.5	0.001
<i>KA-08/18</i>						
A-2863	Wet gas from KA-4/14	A-2165	KA-19	4	1.5	0.001
A-2813	Dry gas to KA-4	A-0502D	KPS	2	1	0.0002
A-2814	Dry gas to KA-4	A-2440	KA-4/14	4	1.5	0.001
A-2864	Condensate to KA-1&7	A-0501B	KPS	4	7	0.003
<i>KA-4/14</i>						
A-2440	Dry gas to KA-7	A-2167	KA-19	1	1	0.0001
<i>KA-19</i>						
A-2165	Wet gas to KA-8/18 via KA-4/14	A-2863	KA-8/18	4	1	0.0005
A-2167	Dry gas from KA-4/14 wellsites	A-2440	KA-4/14	1	1	0.0001
A-2163	Wet gas from A-5002	A-5002	KPS	4	0.5	0.0002
A-2166	Dry gas to KPS A-502A	A-0502A	KPS	1	0.5	0.0001
A-2164	Vector Treated Gas from KPS A-5004	A-5004	KPS	1	0.5	0.0001
A-2169	(Hydrocarbon gas) To Kiwi Dairy Co. & Taranaki Byproducts Co.	N/A	Other	1	6	0.001

Note: No pig traps at KA-05 and KA-13.

3.3.3 Release Hole Sizes

For every component failure, there is a range of credible hole sizes ranging from pinhole leak to full bore rupture (FBR). The representative hole sizes to be used for process sites are as shown in Table 3-3.

The geometric mean for hole diameter will be used to represent a range in hole sizes as this approach has a mathematical basis that aligns with numbers that are exponential in nature, such as is the case for hole sizes where the consequence is dependent on the area of the hole size or square of the diameter. For example, the representative hole size for the range 10 – 50 mm is calculated as $(10 \times 50)^{0.5} = 22$ mm. The use of geometric mean is also aligned with the recommendation in the latest IOGP Process Release Frequency [Ref. 7].

Table 3-3: Hole Size Distribution

IOGP Hole Size Group (mm)	Representative Hole Size (mm)
1 - 3	2
3 - 10	6
10 - 50	22
50 - 150	85
> 150	Range geometric mean

22 mm will be used as the maximum hole size for small bore fittings as per the Todd Energy’s Methodology Guideline [Ref. 5].

The same approach will be taken to select the representative hole size for rupture cases (release > 150 mm). The selected hole size will be the geometric mean of 150 and the largest line size in the section. This is consistent with the approach used for other release size categories and may be appropriate given the limited FBR base data that is used by the algorithm to calculate frequency.

It is noted for methanol tanks that will reference to TNO Purple Book [Ref. 23] failure data, actual hole sizes following the failure data will be used as there are no sufficient leak size distribution data in Purple Book to calculate the geometric mean.

3.3.4 Leak Frequency Modification Factor

Several leak frequency modification factors will be applied to the release frequency database as per the Todd Energy’s Methodology Guideline [Ref. 5]. These are listed below:

- Piping Release Frequency
 - Pipework will be split into categories: process (on skid) piping and interskid piping as described in the definition for equipment type 1: steel process pipes of IOGP Process Release Frequencies [Ref. 7].
 - For interskid piping, the modification factor for “inter-unit piping” (section 3.3.3 of IOGP Process Release Frequencies) which is 0.9 will be applied, i.e. there will be a 90% reduction in frequencies.
- Rupture Release Frequency
 - A review of the UK HSE Hydrocarbon Release Database (HCRD) from 1992 to 2015 has been performed and it was determined that there were 31 incidents in the full-bore release category within 24 years. These were reviewed by Todd to determine the applicability of these cases in comparison with Todd Energy facilities. For wellsites, 22 of the incidents can be discounted on the basis that the release scenarios cannot occur on an onshore wellsite. The frequency for rupture release will be reduced by 65%.

The maximum flange release hole size will also be limited to 22 mm as a release from a flange is normally limited to a segment of a gasket between bolts [Ref. 5].

3.4 Blowout Events

For normal operations, it is assumed that a blowout may occur during either production, well workover or well wireline activities. The categories applied for classifying the incidents [Ref. 11 and 12] are shown in Table 3-4.

Table 3-4: Categories of Blowout Incidents

Main	Category	Description
Blowout and well release	Blowout (surface flow)	<ul style="list-style-type: none"> Uncontrolled incidents with surface flow, including subsea releases, e.g., from topside or subsea wellhead, drill floor or Christmas tree. Considered as a full blowout event from the full well bore size. This will be modelled based on the expected maximum well fluid flowrate that the reservoir can supply to the wellbore instead of the wellhead pressure to avoid over-estimating the release rate and creating unrealistic results.
	Blowout (underground flow)	<ul style="list-style-type: none"> Underground flow only or with limited surface flow where minor flow occurred and typically the Blowout Preventer (BOP) has been activated. Considered to have no consequences on the surface and will therefore not be considered in this study.
	Diverted well release	<ul style="list-style-type: none"> An incident where the diverter system functioned as intended. Assumed to be a well release that can be shut-in or diverted to flare in a short period of time. This event will not be included as the event frequency as given in Table 3-4 is equal to zero.
	Well release	<ul style="list-style-type: none"> An incident where hydrocarbons (oil or gas) flow from the well at some point where flow was not intended, and the flow was stopped by use of the barrier system that was available on the well at the time the incident started. Assumed to be release from the wellhead and Christmas trees. It will be modelled as a horizontal well fluid release at well pressures. Release sizes will be based on the same hole size distribution used for other release cases.

The blowout likelihood from the IOGP Blowout Frequencies [Ref. 11] will be used, specifically data for offshore operations in areas not operating according to North Sea Standard (Table 2-3 in the IOGP). It is noted that the Kapuni wellsites are located onshore, however, IOGP recommends the use of offshore data presented in Section 2 in the IOGP but noted that there will be a greater degree of uncertainty. The frequency for well wirelining considered in the KA-4/14 and KA-13 QRA [Ref. 1] is once per well per year, and no workover will be performed in the wells' life time. These assumptions will be used in this QRA as well.

Table 3-5: Blowout and Well Release Frequencies for Production Operation

Operation	Category	Frequency
Production (Excluding external causes ^{Note 1})	Blowout (surface flow)	3.3E-05 per well year
	Diverted well release	0 per well year
	Well release	2.9E-05 per well year
Wireline	Blowout (surface flow)	9.0E-06 per well year
	Diverted well release	0 per well year
	Well release	2.6E-05 per well year

Note 1: External causes are external loads such as storms or fire leading to blowout or well release.

3.5 Ignition Probabilities

The probability of ignition of a release is a function of the release rate, the nature of the material being released and the conditions of the surrounding plant. For this QRA, The Energy Institute (EI) ignition probability model referenced in IOGP Ignition Probabilities [Ref. 8] will be used for the estimation of overall ignition probability of loss of containment scenarios.

For wellsite, ignition probabilities should be taken from Scenarios 5 and 6 and they are assumed to particularly apply to a 'plant' where processing takes place. This is considered conservative for use at wellsites as not much processing takes place.

The scenarios are described as:

- Scenario 5 – Small Plant Gas LPG (Gas or LPG release from small onshore plant) - Releases of flammable gases, vapour or liquids significantly above their normal boiling point from small onshore plants (plant area up to 1200 m², site area up to 35,000 m²).
- Scenario 6 - Small Plant Liquid (Liquid release from small onshore plant) - Releases of flammable liquids that do not have any significant flash fraction (10% or less) if released from small onshore plants (plant area up to 1200 m², site area up to 35,000 m²) and which are not banded or otherwise contained.

The graphs of ignition probabilities as a function of mass release rate are shown in Figure 3-1.

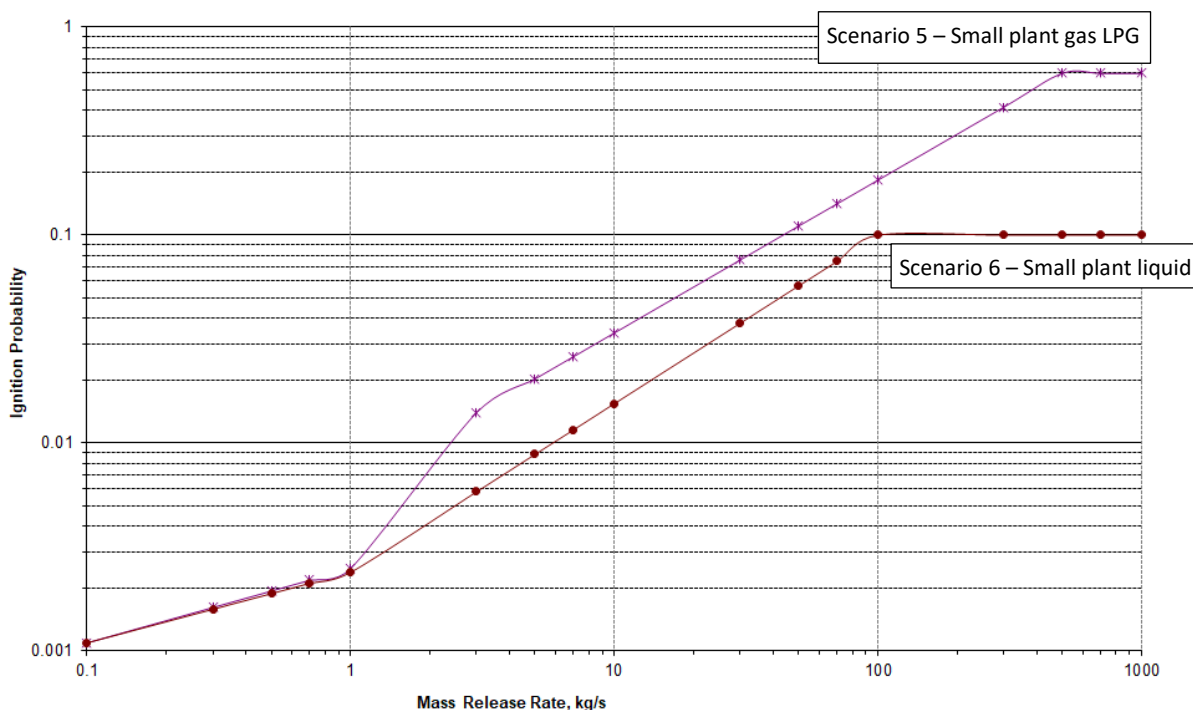


Figure 3-1: Ignition Probability

Early and Delayed Ignition Probabilities

The graph represents the total ignition probability. An overall distribution for early to delayed ignition ratio of 30:70 to 50:50 split is considered reasonable. The timing of ignition is used as a means to predict the nature of the ignited event. Early ignition is taken to indicate a jet fire or pool fire depending on the material released. Delayed ignition is taken to indicate that the ignition would initially result in a flash fire or explosion.

For this study, a 30:70 split for early to delayed ignition probability will be used. Given the maturity of the hazardous area for all wellsites, it can be assumed that probability of early ignition would be low.

3.6 Material Composition

The Heat and Material Balances (HMBs) will be provided by Todd Energy's process engineer [Ref. 9]. The wellstream fluid from each well have different flowrates, material compositions and operating conditions. Any stream that has unique consequences will be represented by dedicated sections. For sections with similar operating conditions or fluid composition that have similar consequence results, the worst-case scenario will be selected as representative, to rationalise the number of scenarios performed. This is to avoid the averaging out of inputs of different wellstreams, as it may create a stream with 'brand new' operating conditions, material compositions and flowrates which does not represent the actual release conditions.

As far as is reasonable, the compositions in each stream are simplified, i.e. isomers are summed together and the C6+ hypothetical materials (KP01, up to KP30) are represented by different heavy alkanes. The following alkanes are selected to represent different ranges of hypothetical materials found in the streams based on their properties:

- KP01 to KP10 are assumed to be C7;
- KP11 to KP20 are assumed to be C10; and
- KP21 to KP30 are assumed to be C20.

Note that the hypothetical materials in the Todd Energy's Methodology Guideline are represented in ST01 to ST30; whereas the hypothetical materials in the HMB provided by the process engineer are represented in KP01 to KP30. The hypotheticals STXX are the same as KPXX [Ref. 19].

The important characteristic of molecular weight is kept close to the actual value to ensure the release rate is representative.

The effects of water cut of the hydrocarbon on fire hazards will be considered to identify the streams that are considered not flammable due to high water content. According to Oil and Gas UK Fire and Explosion Guidance [Ref. 10], for water cuts under 50%, no significant reduction in heat fluxes to engulfed objects can be expected (<10%). However, for water cuts over 50%, the flames are significantly less radiative, and the overall heat flux to an obstacle can be reduced by 40% or more. To be in line with Oil and Gas UK Fire and Explosion Guidance, it is assumed that a mixture remains flammable if it has a water cut of up to 125% (defined as mass of water/ mass of fuel x 100%), although not necessarily capable of supporting a stable flame in the absence of some other supporting mechanisms.

Similarly, increasing concentrations of CO₂ were found to reduce the likelihood of ignition of a methane jet release. At CO₂ concentrations of 22–40% (v/v) it was possible for a self-sustaining flame to exist, but beyond these concentrations a pilot flame was required to aid combustion. Beyond 60% CO₂ the pilot flame had no effect and the mixture was completely inert [Ref. 22].

The average flammability of the mixtures will be calculated by Safeti software, considering the effects of the inert components (e.g., CO₂, N₂ and H₂O).

3.7 Release Scenarios

Release rates will be calculated based on the release hole size and operating pressure. All releases will be modelled at initial process conditions until the entire isolatable inventory has been depleted and will not take account of the depressurisation that occurs over time.

All wellsites have automated ESD on fire detection, and KA-8/18 has automatic ESD on gas detection as well. Hydrocarbon leaks at the wellsites or along the pipelines (other than minor leaks) will lead to pressure and/or liquid level drop at KPS, which will alert the operators to perform a check at the wellsite(s).

Given the proximity to the KPS, operators can generally arrive at the wellsites within 15 minutes. As such, 15 minutes delayed detection will be assumed, and 15 minutes of released inventory will be added. Full bore rupture cases are only considered credible when there is major work on site, and the wellsite would be manned to detect the leak immediately. Hence undetected full bore rupture is not considered credible.

The inventory for well blowout and well release events will be considered as unlimited because they can be supplied from the downhole reservoirs.

The wellsites bunding and drainage systems are designed to contain hazardous materials within the boundaries of the wellsite. Therefore, condensate pools are assumed to remain confined within the site.

Other assumptions to be applied in the QRA include:

- The height of release from all scenarios will be assumed to be at 1 m above ground, although some equipment may be located at the elevation higher than the ground level.
- For wellsite releases, 70% of the releases should be modelled as horizontal releases and 30% of the releases as vertical releases. Well blowout will be modelled as 100% vertical release.
- All outdoor releases are modelled as non-impinged (free) releases and are monitored at the downwind direction.
- A free-field condition is assumed although in real facility situations, multiple obstructions beyond the leak source could shield or deflect the jet fire. Obstructions in the path of the vapour cloud could also alter the concentration of gas in the cloud
- Fire durations are estimated based on the assumption that isolation and shutdown are immediate.
- In estimating piping length, a safety factor of 1.25 will be applied to all lengths measured from the map to account for bends and elevations which could not be determined from the 2D map.
- For liquid releases from pressurised sources, if the rainout is significant then a pool fire will result. If not, a spray fire (equivalent to a jet fire) will result. It is suggested in the Oil and Gas UK Fire and Explosion Guidance [Ref. 10] that for ignited two-phase releases:
 - If the Gas Oil Ratio (GOR) is low, at drive pressures above 10 bar(abs) a spray fire will result;
 - If the GOR is high, at drive pressures above 5 bar(abs) a spray fire will result.

Note: Gas oil ratio is the ratio of gas to oil within the hydrocarbon fluid. A high GOR indicates a high gas content which has implications for the potential for gas fires from a depressurisation and release [Ref. 10].

3.8 Congested Area

A flammable vapour cloud accumulation at congested area(s) is the prerequisite to a vapour cloud explosion (VCE). There is limited equipment at the wellsites, and these areas are generally open with good ventilation expected throughout the year. The possibility of flammable vapour accumulating and developing into subsequent vapour cloud explosions, are considered not credible. Hence, VCE modelling will not be carried out.

3.9 Atmospheric Conditions for Modelling

Meteorological conditions impact the outcomes of release modelling, including downwind flammable and toxic vapour cloud dispersion distance (influenced by atmospheric stability and wind speed), rate of pool vaporisation (ambient temperature), and atmospheric attenuation of radiant heat (temperature and relative humidity).

3.9.1 Wind Speed and Direction

Wind speed and direction data are taken from NIWA’s Cliflo database [Ref. 16] for the Hawera Automatic Weather Station (AWS) to represent the atmospheric conditions at Kapuni. Data for 5-year period from January 2008 to December 2012 are taken, with wind speed and direction measurements taken every hour. The wind rose is shown in Figure 3-2.

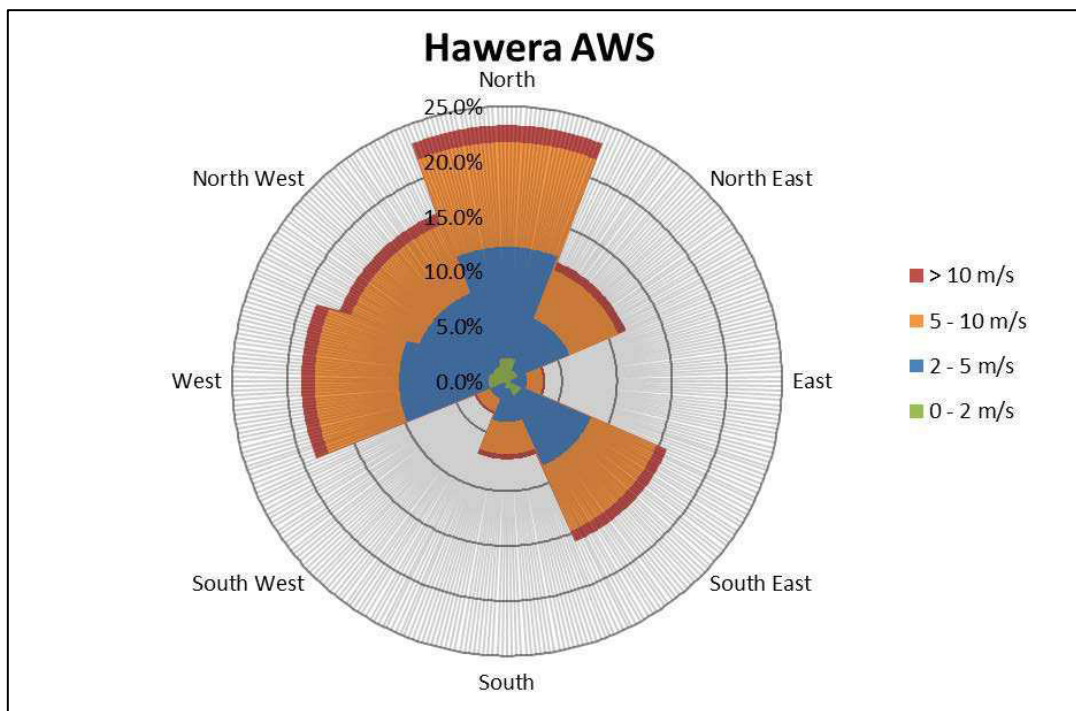


Figure 3-2: Hawera AWS Windrose

The following combinations of wind speed and atmospheric stability will be considered in the QRA that represents the typical wind speed conditions around the wellsites:

- 2/F – wind speed of 2 m/s with Pasquill Stability class F – stable, night with moderate clouds and light/moderate wind
- 5/D – wind speed of 5 m/s with Pasquill Stability class D – neutral, little sun and high wind or overcast/windy night
- 10/D – wind speed of 10 m/s with Pasquill Stability class D

For the modelling, wind speed reference height (the height at which the wind impacts a release) will be set at 1 m (i.e., so as to match the release height). The Power Law wind profile will be applied where the wind speed varies with height according to power-law profile.

By consideration of the Pasquill Stability class relationship with day and night and wind speeds, the wind data for use in the QRA model is calculated as shown in Table 3-6.

Table 3-6: Hawera AWS Wind Data

Wind Speed / Pasquill Stability	North	North East	East	South East	South	South West	West	North West	Total
0 - 2 m/s / F	2.1%	1.1%	0.3%	1.4%	0.6%	0.3%	1.7%	1.5%	9.0%

Wind Speed / Pasquill Stability	North	North East	East	South East	South	South West	West	North West	Total
2 - 5 m/s / D	10.1%	5.1%	1.5%	6.9%	3.1%	1.4%	8.2%	7.2%	43.5%
> 5 m/s / D	11.1%	5.6%	1.7%	7.5%	3.4%	1.5%	8.9%	7.9%	47.5%
Total	23.3%	11.8%	3.5%	15.9%	7.1%	3.2%	18.7%	16.5%	100.0%

3.9.2 Ambient Temperature and Relative Humidity

The following ambient temperature and relative humidity as consistent with those used in the KPS QRA [Ref. 18] will be used in the QRA:

- Ambient temperature: 14°C
- Relative humidity: 83%

3.9.3 Solar Radiation

The allowance for solar radiation will not be included in the thermal radiation effects consideration.

3.9.4 Surface Roughness

Safeti cannot take into account the effects of the local undulating topography for the gas dispersion. The surface roughness of 30 mm will be applied, which generally represents an area of “open flat terrain; grass, few isolated objects” to represent the open area of the wellsites.

3.10 Fatality Criteria

The physical effects from these consequences can have different impacts on humans. The variation of harm from different effects is reflected in a parameter known as the harm probability. In this study, human harm relates to high potential for fatality.

3.10.1 Heat Radiation

The method of calculating the probability of fatality for an individual, given known exposure duration and thermal heat radiation levels, is undertaken by using a Probit function. The Probit function is a general formula which takes the same form, but with various constants used. The Probit used for lethality calculations is taken from the TNO Green Book [Ref. 17]. The Probit function is defined as follows:

$$\text{Probit} = -36.38 + 2.56 \ln (t \times q^{4/3})$$

Where:

t = exposure duration in seconds

q = thermal radiation level in W/m²

Safeti calculates the Probit values during the analysis.

An exposure duration of 20 seconds has been used as a base case, although it is noted that personnel are likely to find some form of shielding protection within this time frame.

3.10.2 Flash Fire

If personnel are within the 100% lower flammable limit (LFL) of the gas plume, 100% fatality is assumed. LFL is the lower end of the concentration range over which the flammable mixture of vapour in air can be ignited.

A flash fire occurs when a dispersed cloud of flammable vapour and air mixture is ignited within its flammable regions, causing a wall of flame to spread throughout the flammable region and back to the release point. The flame propagates through the cloud in a manner such that negligible or no damaging overpressure is generated. This flash is almost instantaneous as the flame propagates at high speed through the cloud and back to the source.

An assumption of 100% fatality rate within the footprint of the cloud is conservative and does not allow for potential risk reducing considerations such as:

- uneven mixing of flammable vapour and air in the cloud resulting in uneven propagation of the flame,
- topography,
- sparsely populated rural land use adjoining the site,
- availability of shelter,
- opportunity for escape, and
- clothing worn by persons exposed to the flash fire.

Thermal radiation outside of the flash fire footprint, reduces rapidly and is not sustained due to the instantaneous nature of the event. The potential for fatality outside the flash fire footprint is not considered credible.

3.10.3 BLEVE

Boiling Liquid Expanding Vapour Explosion (BLEVE) is an escalation scenario that occurs as a result of prolonged flame impingement on above ground pressurised vessels containing materials such as liquefied petroleum gas (LPG) or light end hydrocarbon. BLEVE would result in an explosion overpressure together with a fireball and missile generation over some distance. As the fireball tends to drift upward and to avoid double counting, only fatalities from the explosion overpressure effects are considered in this risk assessment. The probability of BLEVE depends on various factors, including the types of flammable material and liquid inventory in the vessel, material of construction of the vessel, types and number of fire protection systems (e.g. relief valves, cooling systems), mechanism of vessel failure (external impact, jet fire impingement or pool fire impingement), etc. Passive Fire Protection (PFP) can be provided on pressurised vessels to minimise the probability of BLEVE. There is no clear guideline or criteria to determine the likelihood of a BLEVE on a pressurised vessel. For this risk assessment, BLEVE will be considered credible if a pressurised vessel containing at least 4 m³ of volatile hydrocarbon (liquid butane or lighter) is exposed to direct flame impingement for 5 minutes or longer.

Liquid volume calculation for the vessels at the wellsites are shown in Table 3-7.

Table 3-7: Kapuni Wellsites Vessels Liquid Volume Estimation

Tag	Description	Diameter (m)	Length / Height (m)	Volume (m ³)	Liquid Level (mm)	Liquid Volume (m ³)
KA-02						
V-201A	HP Knockout	0.686	4.572	1.69	343	0.84
V-204A	Secondary Knockout	0.914	3.048	2.00	457	1.00
V-0202A	LT Separator	1.219	3.810	4.45	1905	2.22
KA-05						
V-0516	KA-5 Desander	0.406	4.572	0.59	406	0.59

Tag	Description	Diameter (m)	Length / Height (m)	Volume (m ³)	Liquid Level (mm)	Liquid Volume (m ³)
KA-19						
V-2154	Wellhead Knockout	1.068	4.572	4.10	534	2.05
KA-8/18						
V-2803	HP Knockout Drum	0.685	4.570	1.68	342.5	0.84
V-9010	Wellstream Separator (2 phase)	1.600	4.500	9.05	800	4.52
V-9020	Wellstream Separator (2 phase)	1.600	4.500	9.05	800	4.52
V-2808	LT Separator	1.830	5.640	14.83	915	7.42
V-2804	Low Temperature Separator	1.220	3.810	4.45	1905	2.23
V-2805	Secondary Knockout	915	3.050	2.01	457.5	1.00

Based on the table, the liquid volume for the KA-8/18 Wellstream Separators (V-9010 & V-9020) and LT Separator (V-2808) might be greater than 4 m³. However, based on the Heat and Material Balance, the composition of the liquid sections from the Wellstream Separators is mainly water (approx. 88 vol%), and the liquid from the LT Separator is mostly heavy hydrocarbons with volatile hydrocarbons making up only 15 vol% of the total composition. Therefore, it is considered that all vessels in Kapuni Wellsite do not have BLEVE potential.

3.10.4 Toxic Effects

Fatality probability when exposed to toxic gas as a function of exposure concentration and duration can be calculated by using a probit function of the form given below:

$$\text{Probit} = a + b \ln(C^n \times t)$$

where:

t = exposure duration in minutes

C = concentration in ppm

a, b and n = material specific probit constants

Toxic effect from methanol will be considered in the QRA. UK HSE gives the following toxic load values for methanol:

- SLOF = 8.02×10^5 ppmⁿ · min (1% fatality probability)
- SLOD = 2.67×10^6 ppmⁿ · min (50% fatality probability)

By solving the simultaneous equation, the other constants a and b can be calculated. The probit constants for methanol are:

$$a = -23.67$$

$$b = 1.94$$

$$n = 1$$

3.11 Risk Criteria

Risk is the combination of the likelihood and consequence of such accidents. It is defined as the probability of a specific adverse event occurring in a specific period or in specified circumstances. The likelihood may be expressed either as a frequency (i.e. the rate of events per unit time) or a probability (i.e. the chance of the event occurring in specified circumstances). The consequence is the degree of harm caused by the event.

Escape and evacuation fatalities are generally not considered for an onshore plant due to the open site layout and personnel’s ready accessibility to the muster area. Hence, only immediate fatalities will be taken into account when performing the risk analysis to onsite workers.

Key deliverable for this study is the location specific individual risk (LSIR) in the form of risk contour. LSIR is the risk of fatality at a point in space to a hypothetical individual at a location for 365 days per year, 24 hours a day, unprotected and unable to escape. In real situation, people do not constantly remain in one location, so this risk value does not provide a realistic representation of the true level of risk.

However, this value allows different areas to be compared on the same basis and is a useful measure for establishing the most hazardous areas of the plant, or for the comparison of facility risk profiles against standard criteria. The LSIR can be expressed as follows:

$$LSIR = \sum F \times P$$

Where:

F = Frequency of an event outcome per year

P = Probability of death due to the event at the location

∑ = Sum over all modelled events

LSIR is usually presented as risk contours or by defining risks at selected locations (e.g. site boundary).

As there are no standard risk criteria which have been developed for the NZ context, this deliverable will be assessed against the suggested risk criteria in the NSW Hazardous Industry Planning Advisory Paper No. 4 (HIPAP4) “Risk Criteria for Land Use Planning” as shown in Table 3-8.

Table 3-8: HIPAP 4 Individual Fatality Risk criteria

Land Use	Risk Criteria Adopted (per annum)	Interpretation for QRA
Hospitals, schools, childcare facilities, old age housing	0.5×10^{-6} (or 5×10^{-7}) (1 in 2 million)	5×10^{-7} risk contour should not extend to these areas
Residential, hotels, motels, tourist resorts	1×10^{-6} (1 in 1 million)	1×10^{-6} risk contour should not extend to these areas
Commercial developments including retail centres, offices and entertainment centres	5×10^{-6} (1 in 200,000)	5×10^{-6} risk contour should not extend to these areas
Sporting complexes and active open space	10×10^{-6} (or 1×10^{-5}) (1 in 100,000)	1×10^{-5} risk contour should not extend to these areas
Industrial	50×10^{-6} (or 5×10^{-5}) (1 in 20,000)	5×10^{-5} risk contour should, as a target, be contained within the boundaries of the industrial site where applicable

NSW HIPAP 4 states that where these criteria are initially exceeded, commercial and industrial land development may be appropriate where mitigating measures can be implemented to reduce risk exposure to less than the target individual fatality risk level.

4. REFERENCES

1. QRA Results – KA-4/14 & KA-13 Wellsites Memorandum, 620053-MMO-R0001, dated 17 July 2019.
2. Safety Case – Kapuni Production Station, Doc. No. NPL649981, Rev. 1, January 2018.
3. Email correspondence with Roisin Johnson, Mike Brophy and Rafeal Moreno (Todd Energy) and Yvette Lee (Worley New Zealand), Sub.: RE: 610114 Kapuni Wellsites QRA Clarification - KA-7 dated 6 May 2020.
4. Email correspondence with Roisin Johnson, Mike Brophy and Rafeal Moreno (Todd Energy) and Yvette Lee (Worley New Zealand), Sub.: RE: KA-15 well flow check dated 18 May 2020.
5. Todd Energy Fire and Gas Analysis and Quantitative Risk Assessment Methodology Guideline, NZ-1005-TECD721654, Rev. 0.
6. DNV GL Safeti software package version 8.22.
7. IOGP Risk Assessment Data Directory, Process Release Frequencies (OGP 434-1), September 2019.
8. IOGP Risk Assessment Data Directory, Ignition Probabilities (OGP 434-6), September 2019.
9. Email correspondence with Rebekah Heperi (Todd Energy) and Yvette Lee (Worley), Sub.: 610114 Wellsites QRA information request - heat and material balance dated 27 May 2020.
10. Oil and Gas UK, Fire and Explosion Guidance, Issue 1 May 2007.
11. IOGP Risk Assessment Data Directory, Blowout Frequencies, September 2019.
12. SINTEF Offshore Blowout Database website, <https://www.sintef.no/en/projects/sintef-offshore-blowout-database/>
13. New South Wales Hazardous Industry Planning Advisory Paper No. 4 (HIPAP4), Risk Criteria for Land Use Safety Planning, January 2011.
14. Australian Standard, The Storage and Handling of Flammable and Combustible Liquids, AS 1940:2017.
15. Pressure-relieving and Depressuring Systems, API Standard 521, 6th Edition, January 2014.
16. New Zealand National Climate Database (<http://cliflo.niwa.co.nz/>).
17. Methods for the Determination of Possible Damage to People and Objects Resulting from Release of Hazardous Materials ('TNO Green Book').
18. Kapuni Production Station, Quantitative Risk Assessment Report, 610052-RPT-R0002, Rev. 1, April 2020.
19. Email correspondence between Mike Brophy (Todd Energy) and Yvette Lee (Worley New Zealand), Sub.: RE: KA-18 Questions dated 13 July 2020.
20. Email correspondence between Mike Brophy (Todd Energy) and Yvette Lee (Worley New Zealand), Sub.: RE: 610114 Wellsites QRA information request - heat and material balance dated 13 July 2020.
21. Discussion between Mike Brophy and Yvette Lee on 31 July 2020.
22. Flammability of Hydrocarbon / CO₂ mixtures: Part 1, Ignition and Explosion Characteristic, Symposium Series No. 156, 2011.
23. TNO Purple Book, Guidelines for Quantitative Risk Assessment, December 2005.